

Teepie Architects INC.

Package 10 - Level 9

Reviewed
 Reviewed as noted




Revise and resubmit
 Not Reviewed



Date: Aug 9/15
 Reviewed by: M. Barron

This review by Teepie Architects Inc. is for the sole purpose of ascertaining conformance with the general design concept. This review shall not mean that Teepie Architects Inc. approves the detailed design inherent in the shop drawings, responsibility for which shall remain with the Contractor submitting same, and such review shall not absolve the Contractor of the responsibility for errors or omissions in the shop drawings or of the responsibility for meeting all requirements of the Contract Documents. The Contractor is responsible for dimensions to be confirmed and coordinated at the job site, for information that pertains solely to fabrication processes or to techniques of construction and installation, and for coordination of the work of all trades.

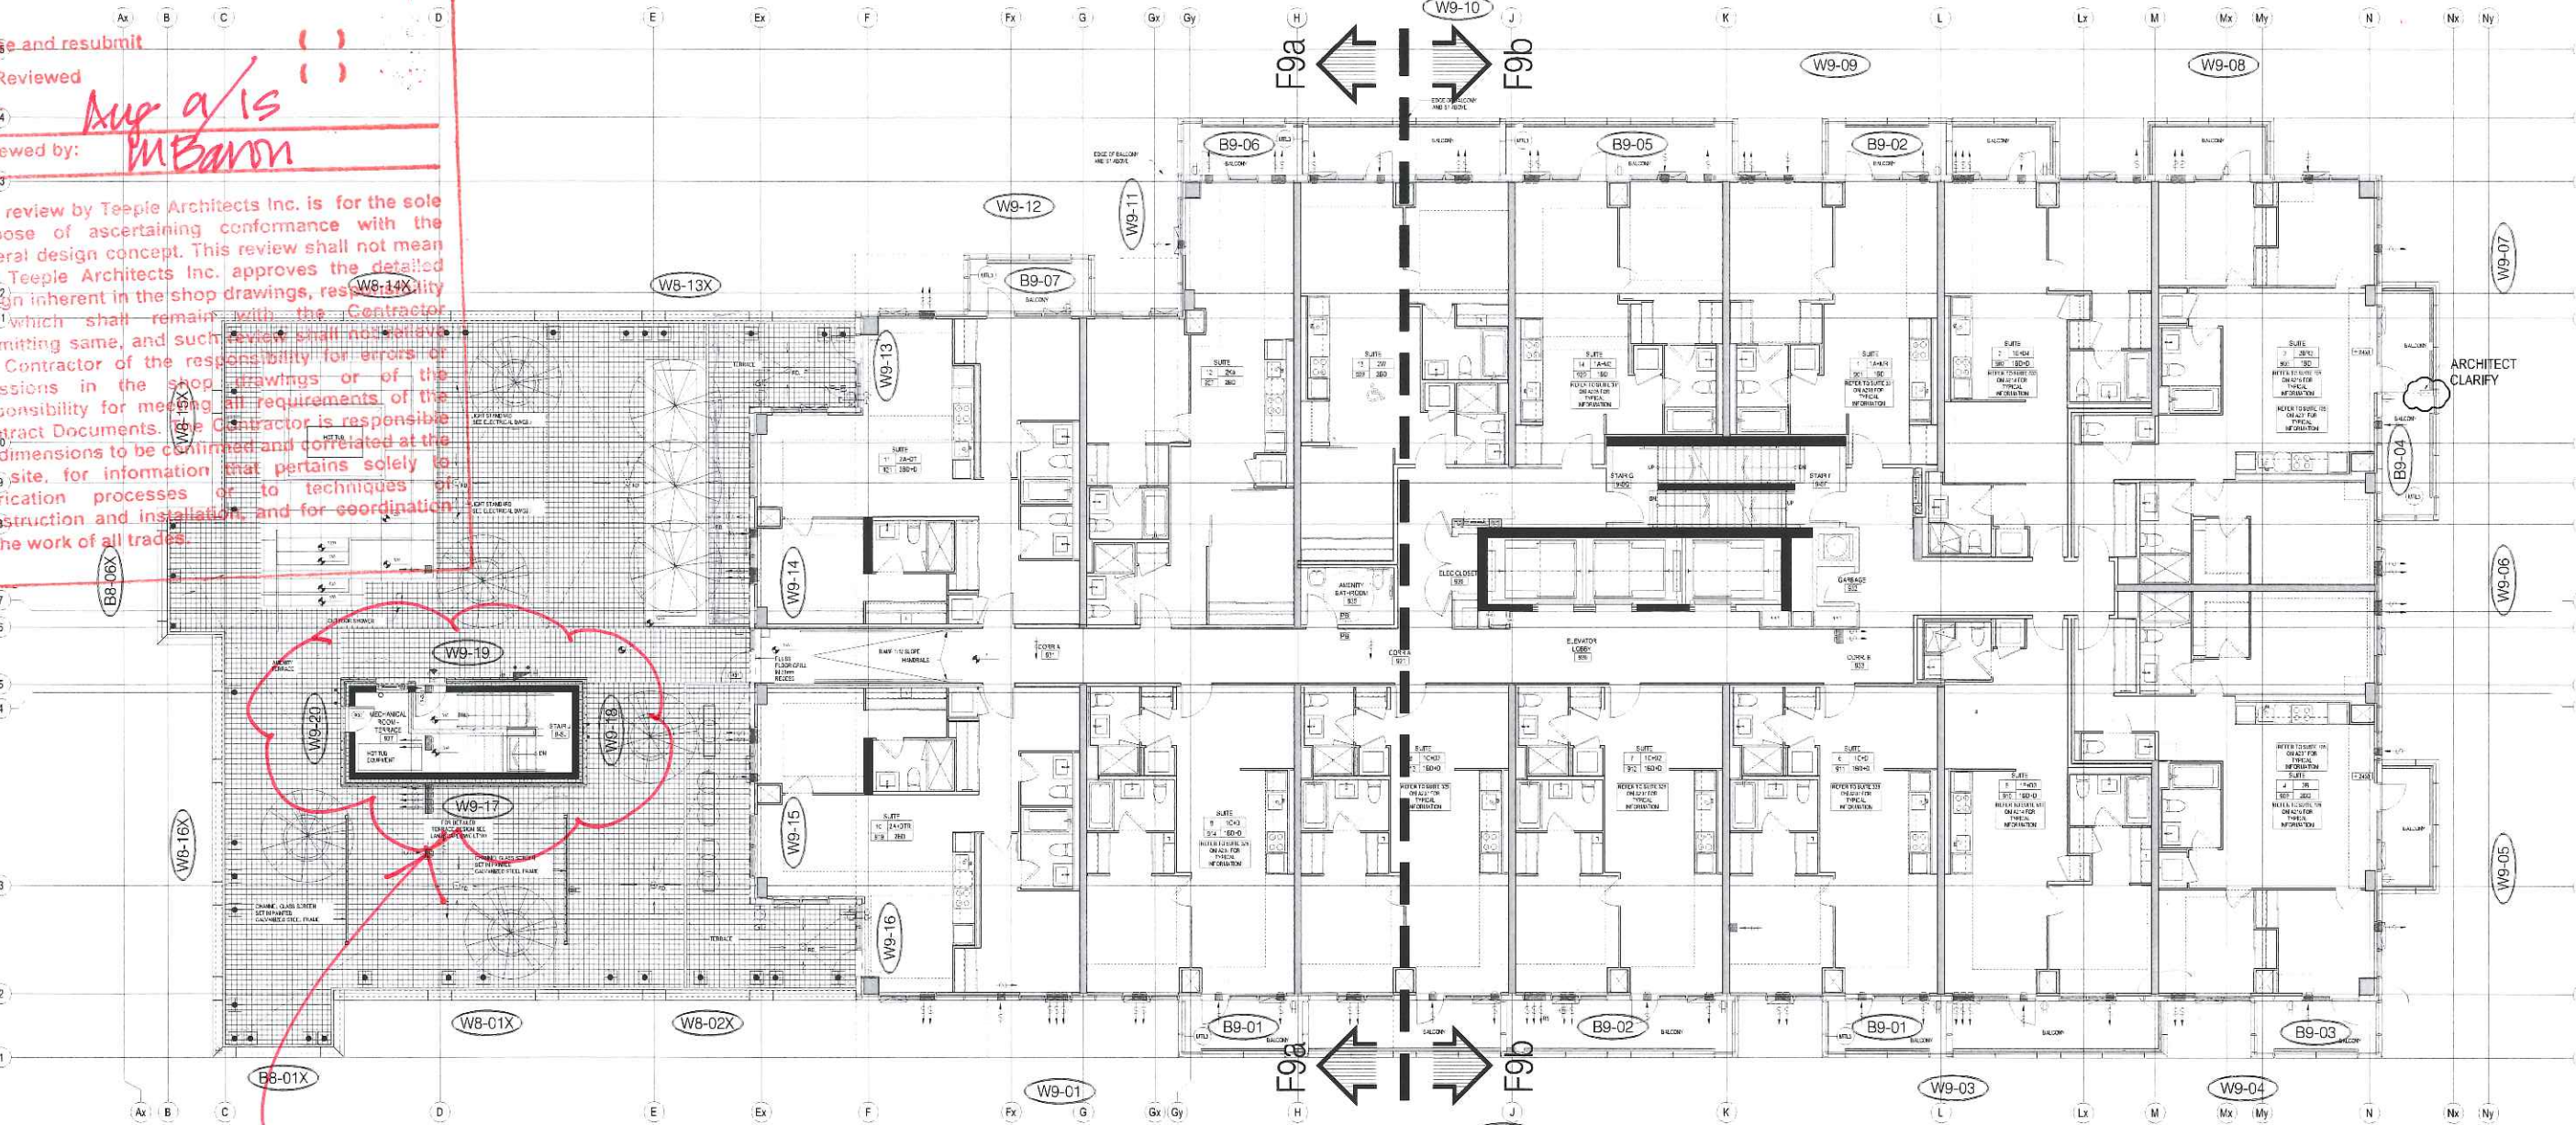


REVIEW PENDING



No.	REVISION	BY	DATE

PROJECT NAME	SQ ALEXANDRA PARK - BLOCK11		
DRAWING TITLE	9th FLOOR KEY PLAN		
ARCHITECT	TEEPLE ARCHITECTS		
CONTRACTOR	TRIDEL		
SCALE	N/T/S	DRAWN BY:	S.C.
DATE	MARCH 4, 2015		
DRAWING No.			F9

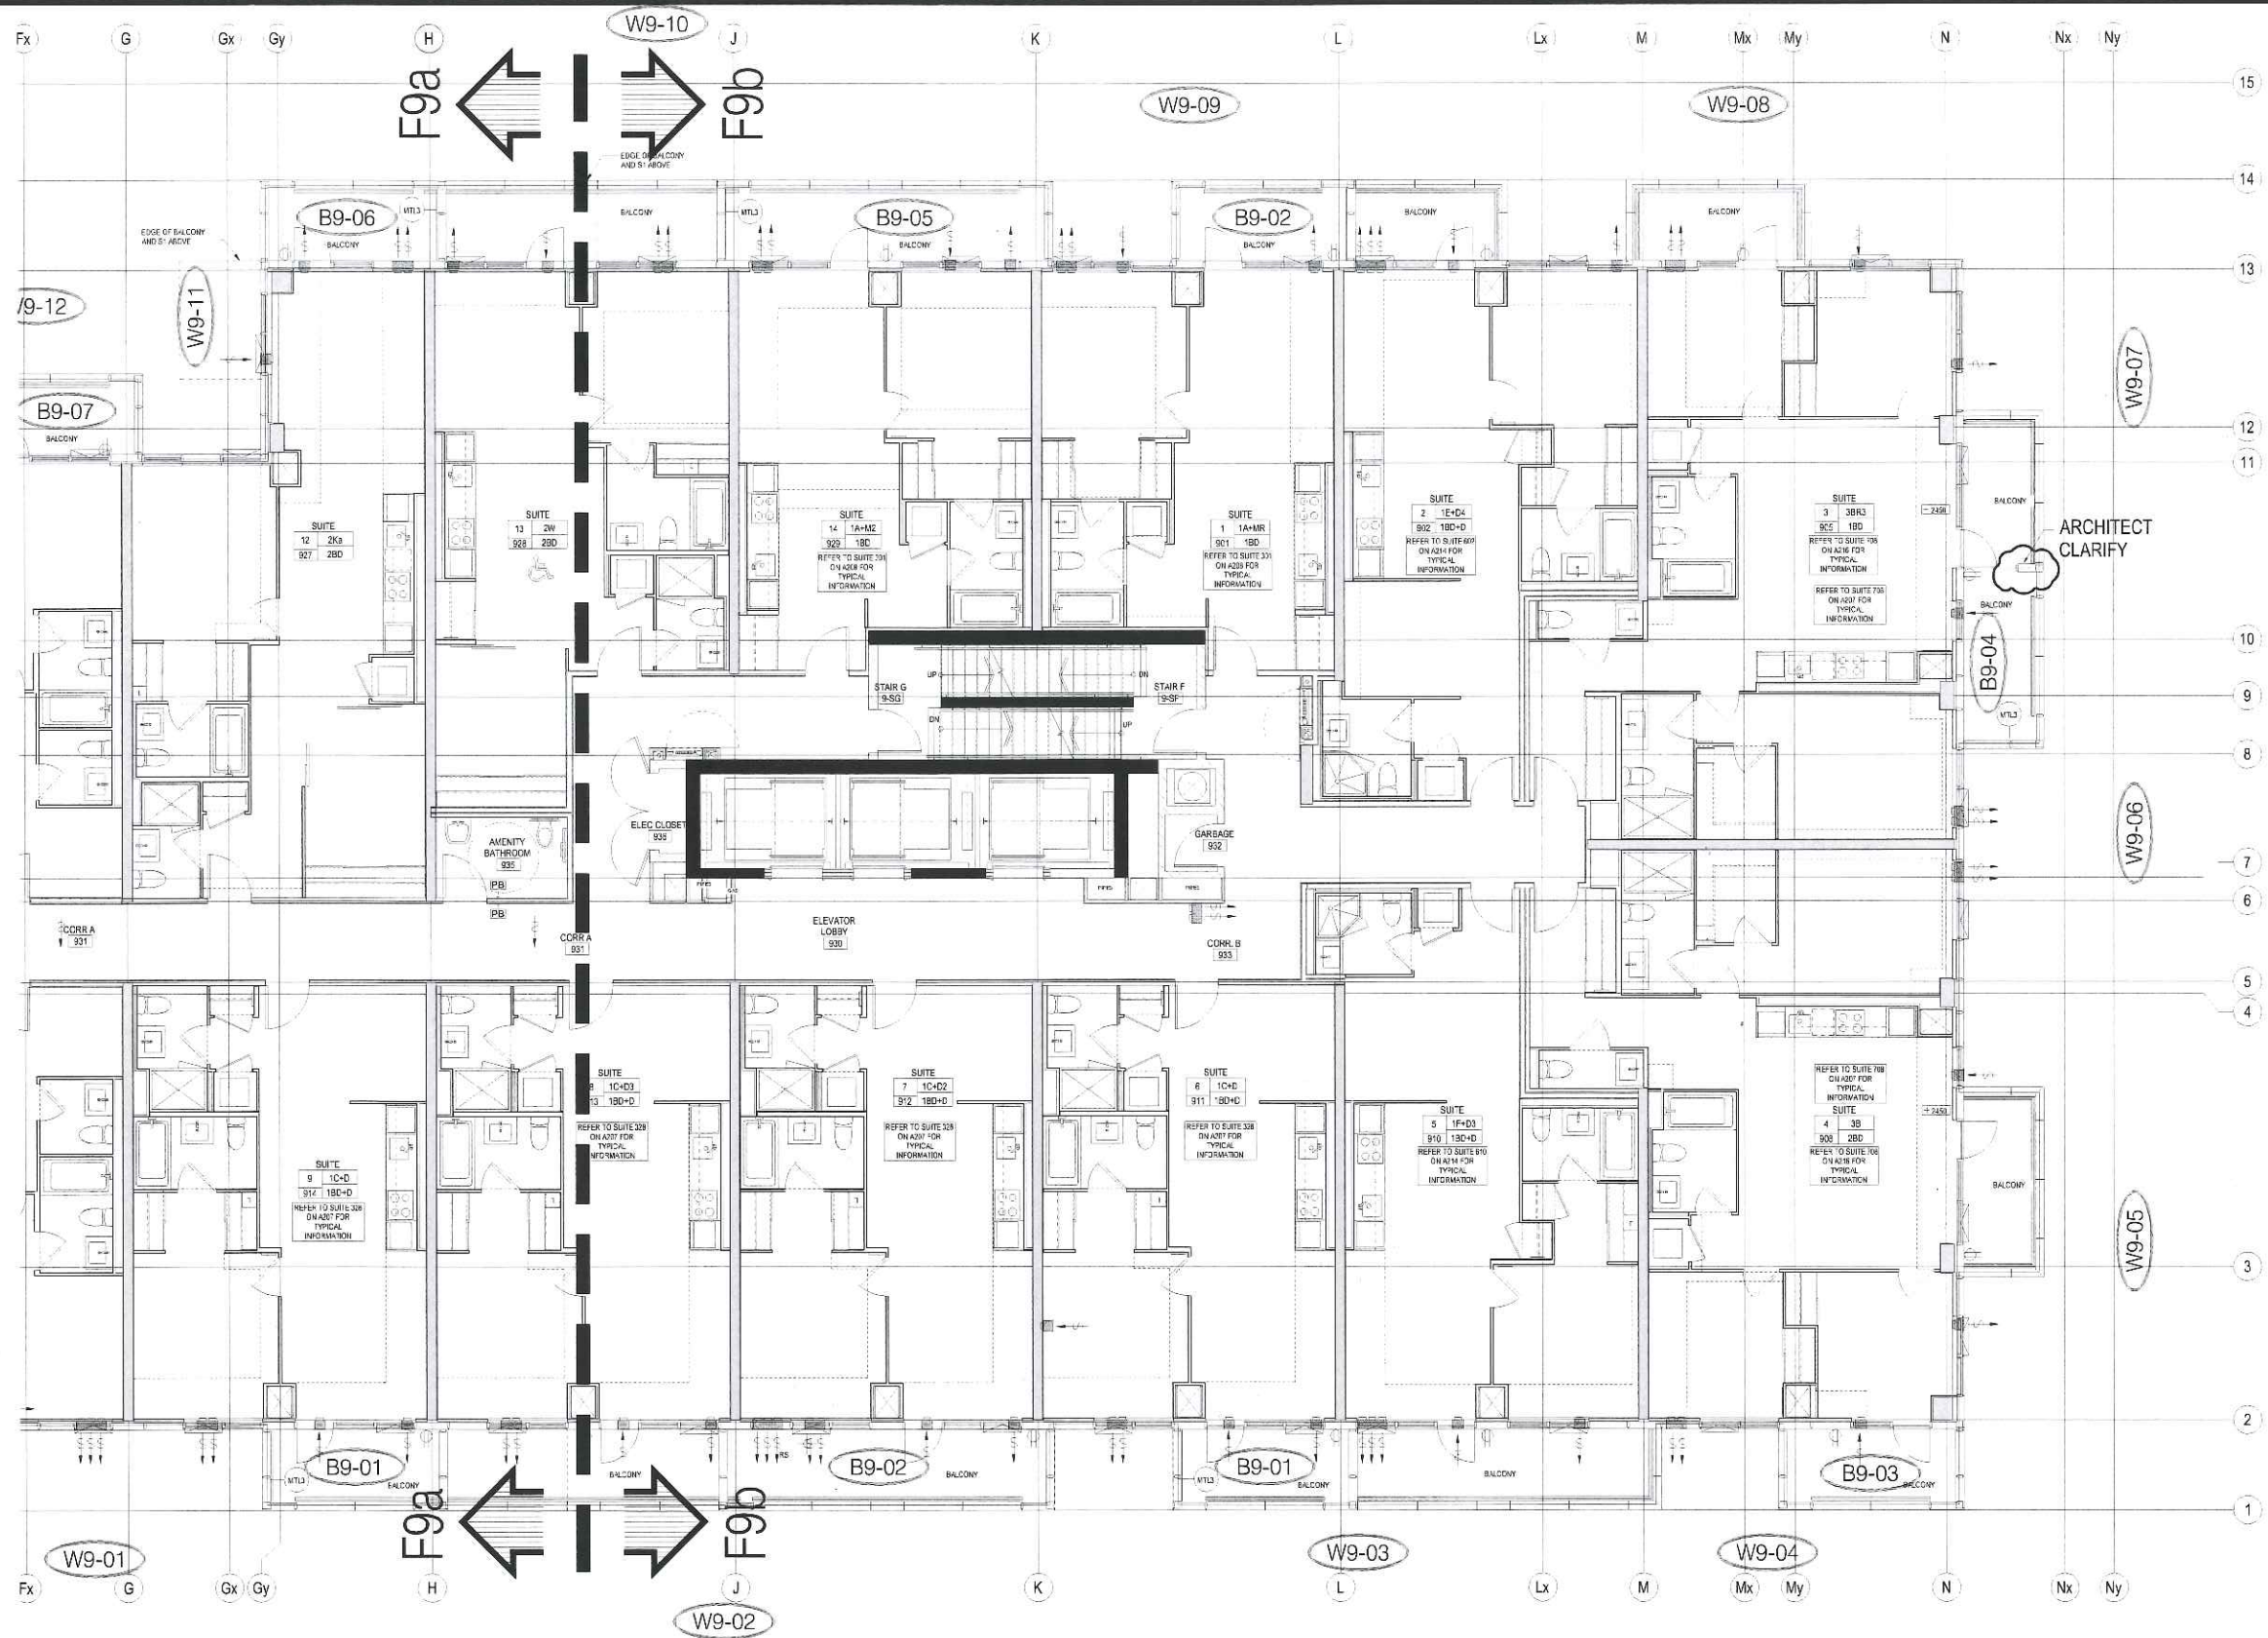

PROJECT NAME SQ ALEXANDRA PARK - BLOCK 11

DRAWING TITLE 9th FLOOR PARTIAL PLAN

ARCHITECT: TEEPLE ARCHITECTS

CONTRACTOR: TRIDEL


SCALE: N/T/S

DRAWN BY: S.C.

DATE: MARCH 4, 2015

DRAWING No
F9b



No.	REVISION	BY	DATE

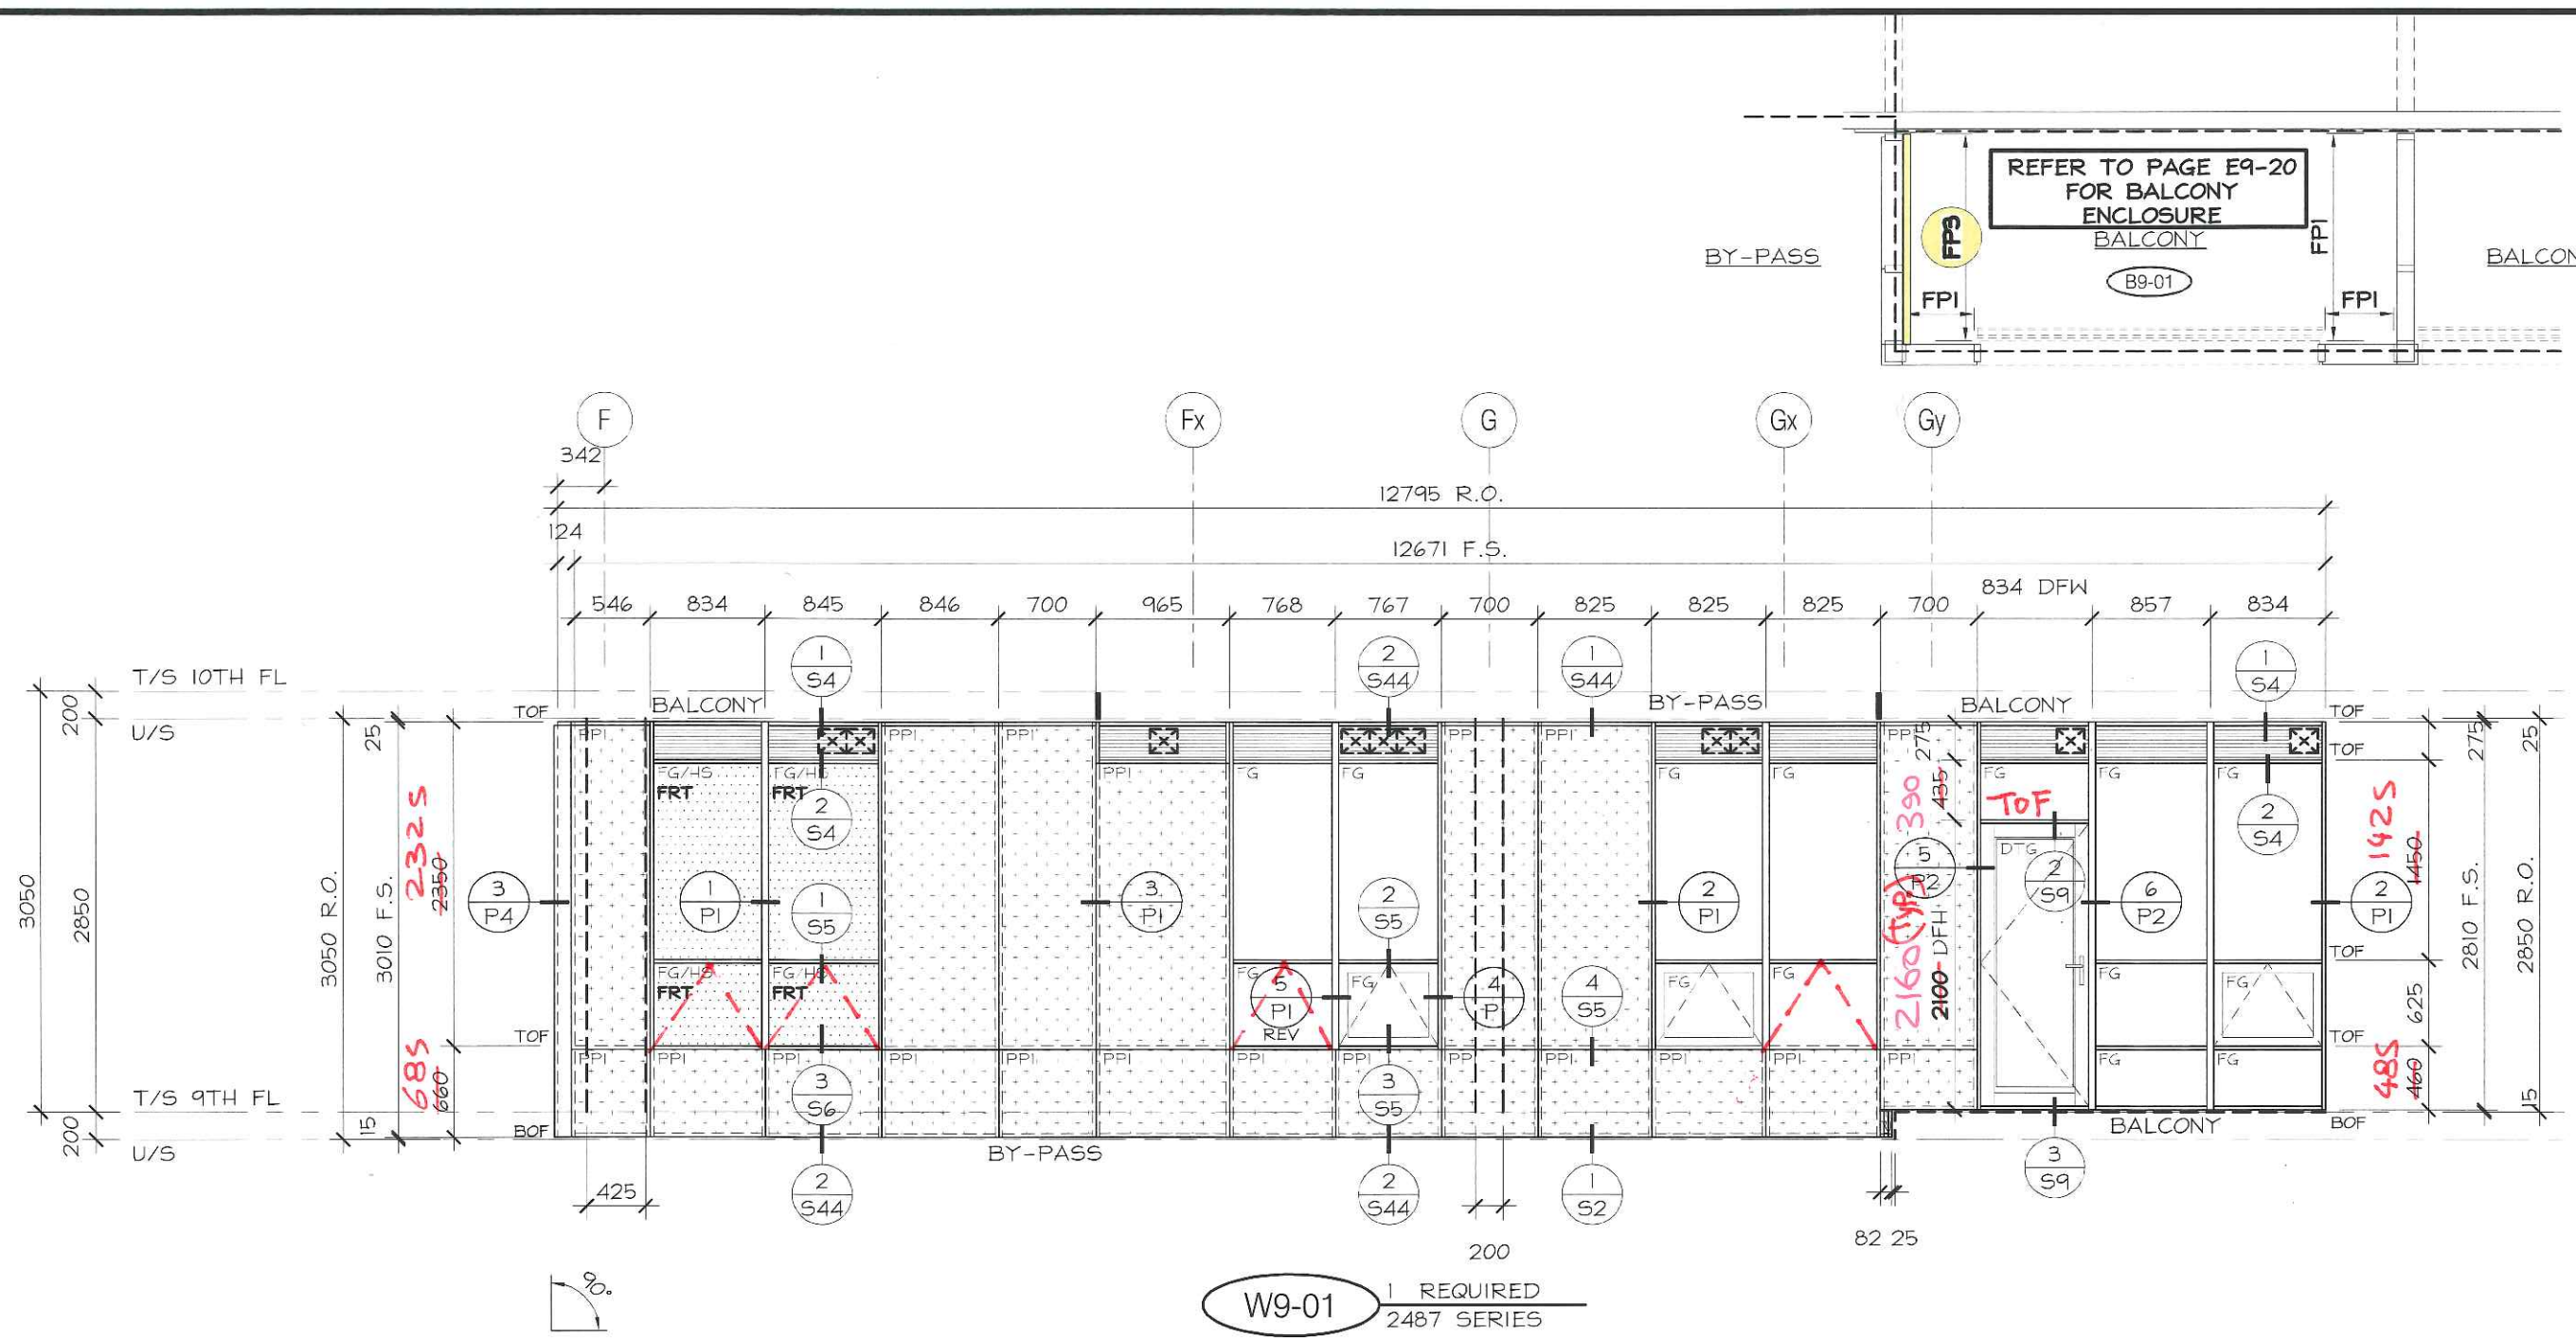

No.	REVISION	BY	DATE

PROJECT NAME: SQ ALEXANDRA PARK - BLOCK11
 DRAWING TITLE: 9th FLOOR ELEVATIONS
 ARCHITECT: TEEPLE ARCHITECTS
 CONTRACTOR: TRIDEL
 SCALE: 1:50
 DRAWN BY: S.C.
 DATE: MARCH 4, 2015


DRAWING No.:
E9-1

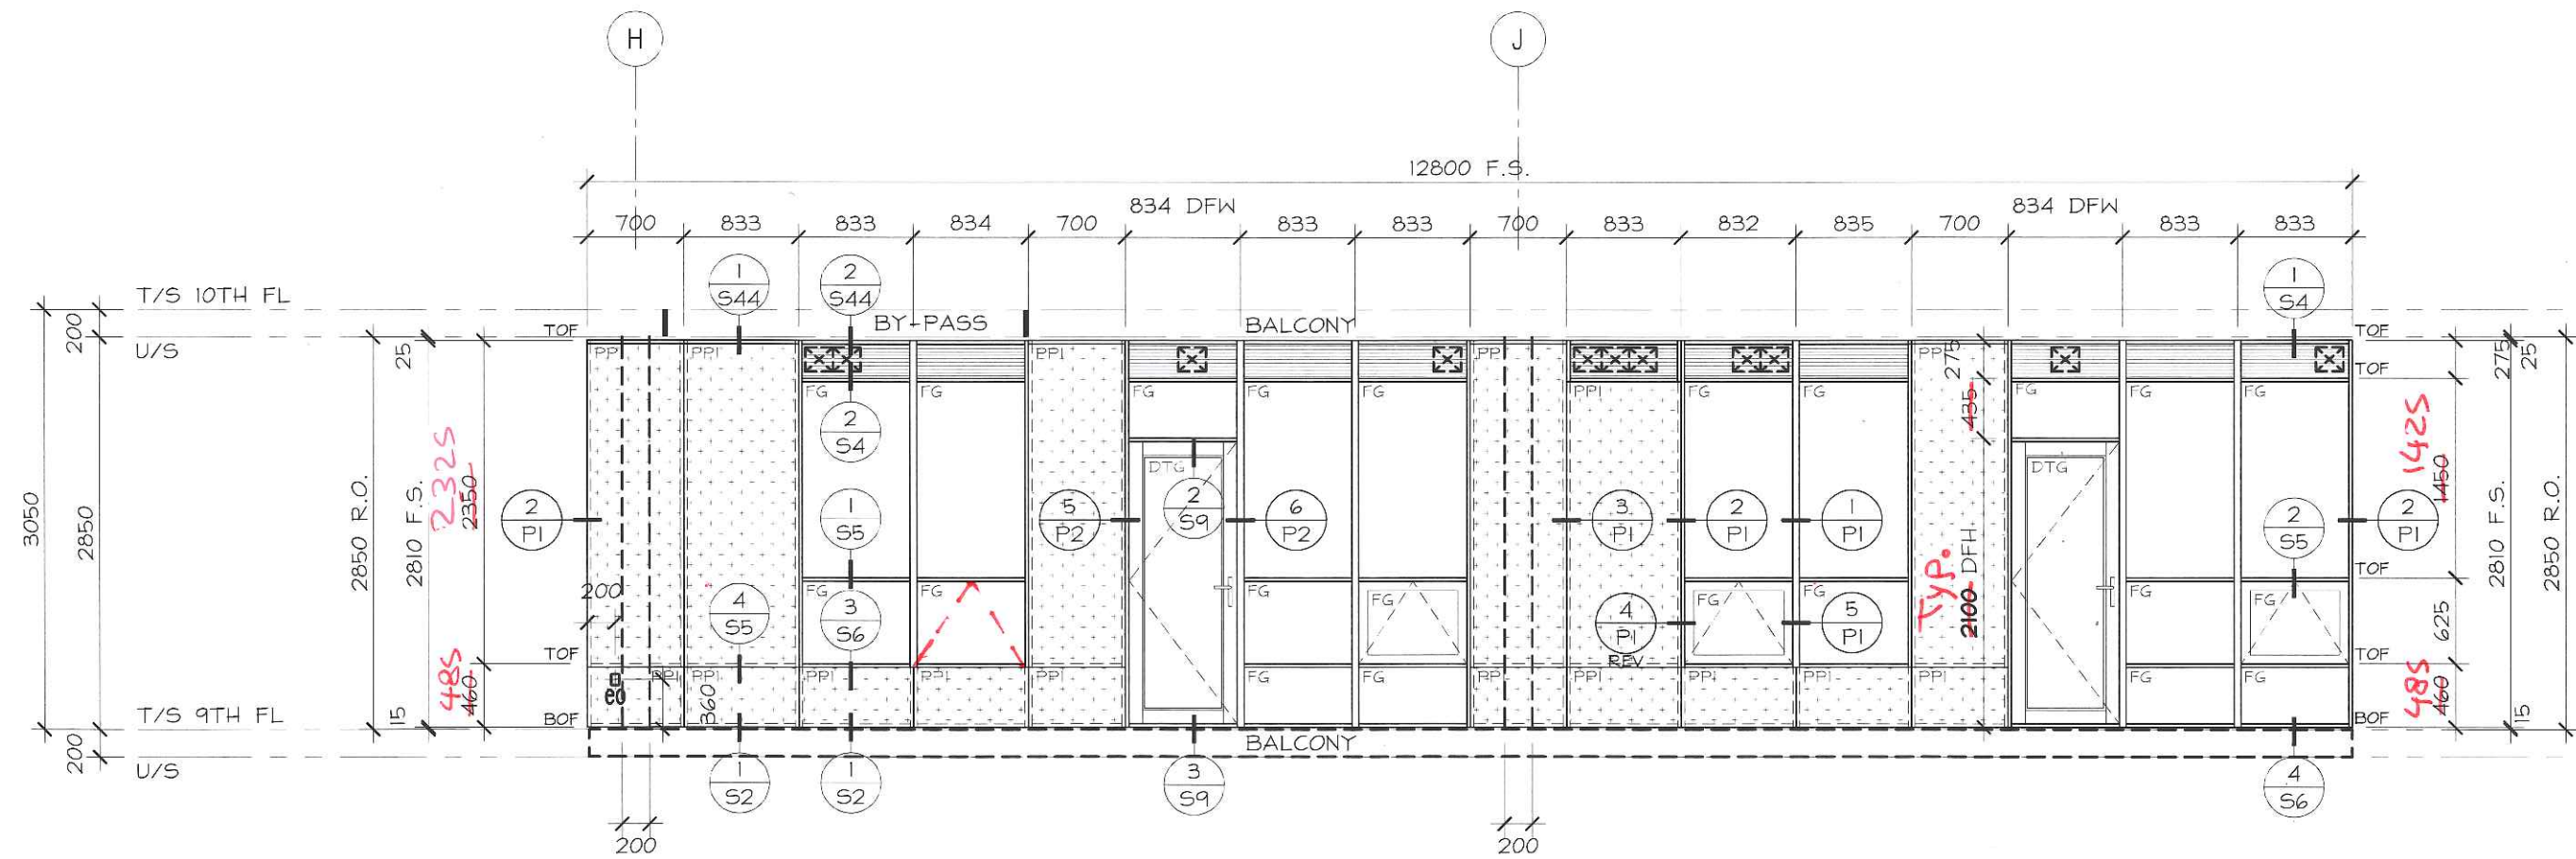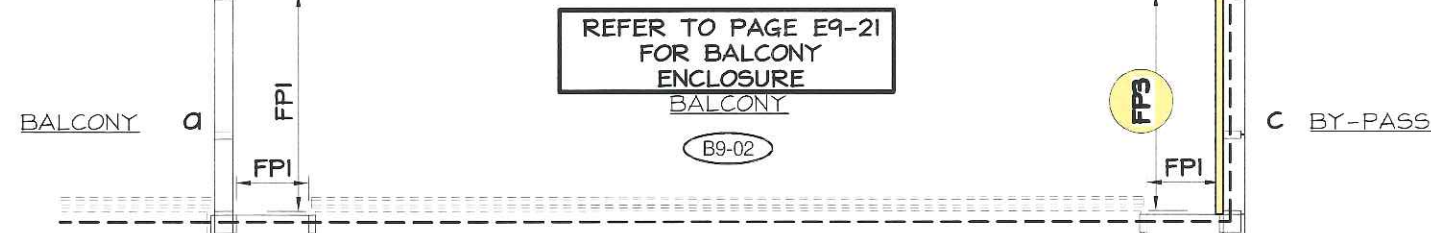

No.	REVISION	BY	DATE

PROJECT NAME:	SQ ALEXANDRA PARK - BLOCK11		
DRAWING TITLE:	9th FLOOR ELEVATIONS		
ARCHITECT:	TEEPLE ARCHITECTS		
CONTRACTOR:	TRIDEL		
SCALE:	1:50	DRAWN BY:	S.C.
		DATE:	MARCH 4, 2015

DRAWING No.:
E9-2

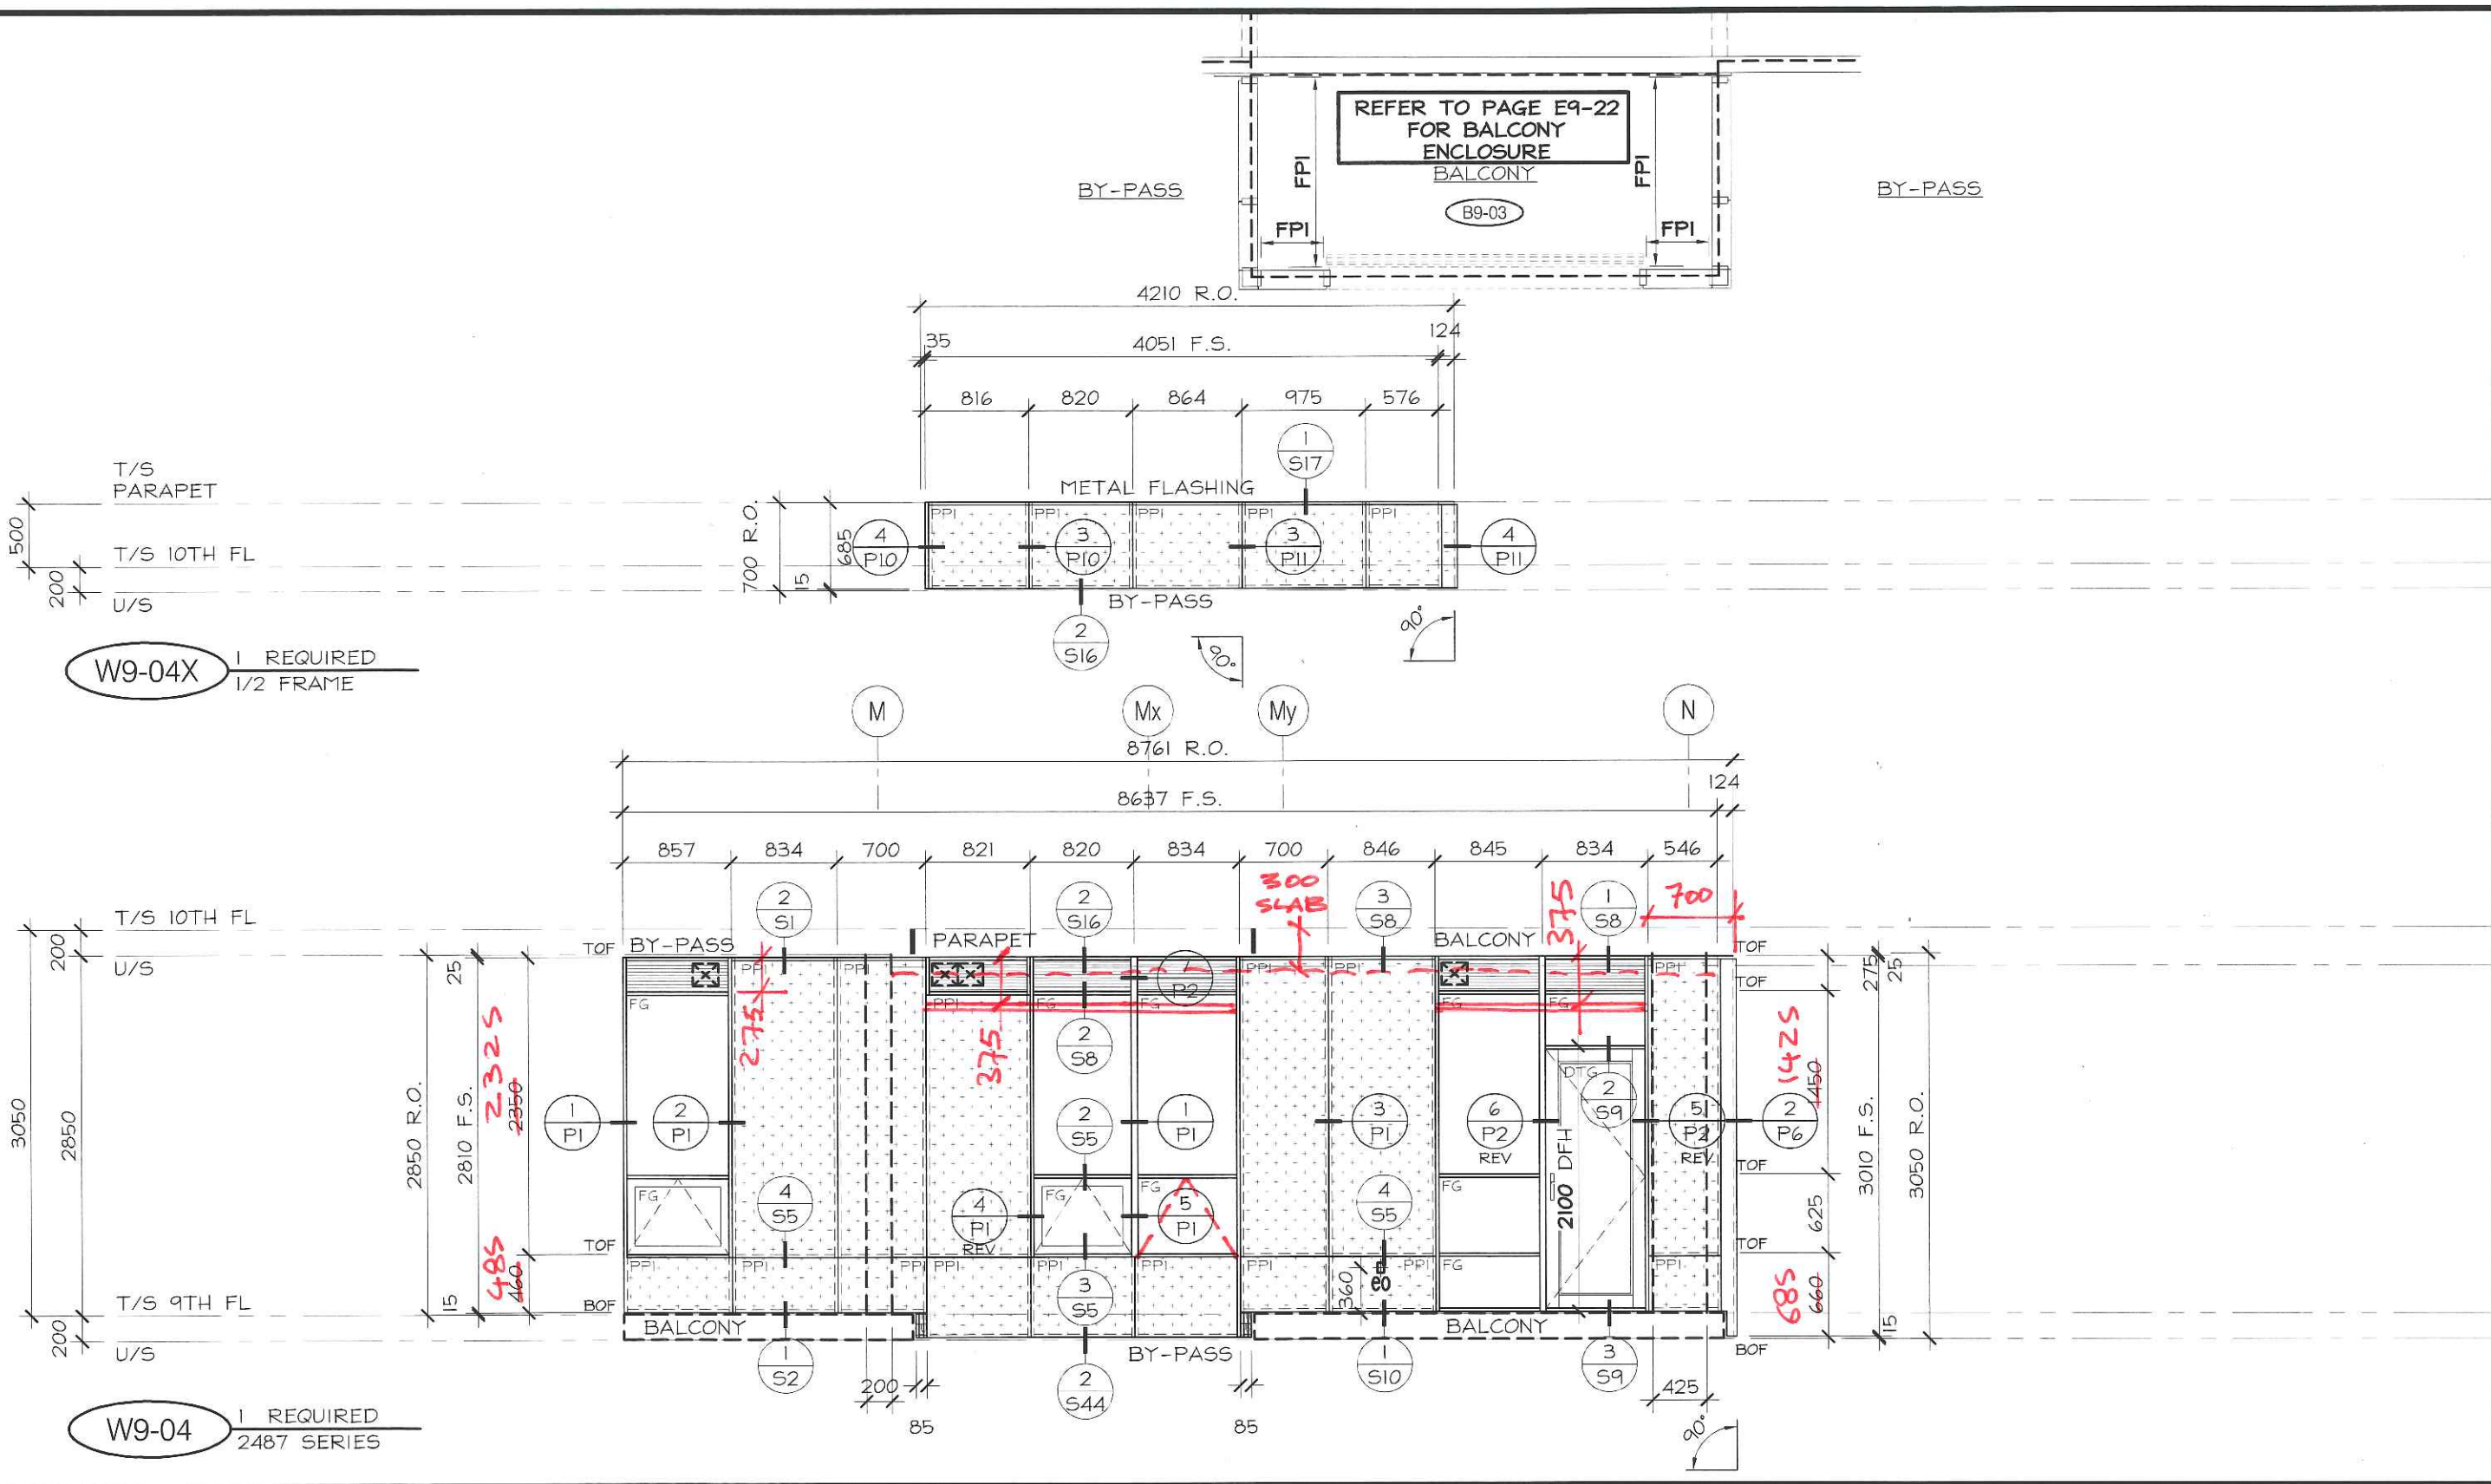

W9-04X 1 REQUIRED 1/2 FRAME

W9-04 1 REQUIRED 2487 SERIES

TORO ALUMINUM
 COMMERCIAL INDUSTRIAL RESIDENTIAL
 330 APPLEWOOD CRESCENT TEL: (905) 738-5220
 CONCORD, ON, CANADA FAX: (905) 738-5481
 L4K 4V2 WWW.TOROALUMINUM.COM

LICENSED PROFESSIONAL ENGINEER
 06-27-15
 D.T. PROHASKA
 37549917
 PROVINCE OF ONTARIO

No.	REVISION	BY	DATE

PROJECT NAME:	SQ ALEXANDRA PARK - BLOCK11		
DRAWING TITLE:	9th FLOOR ELEVATIONS		
ARCHITECT:	TEEPLE ARCHITECTS		
CONTRACTOR:	TRIDEL		
SCALE:	1:50	DRAWN BY:	S.C.
DATE:	MARCH 4, 2015		
DRAWING No.:	E9-4		

T/S PARAPET
 500
 T/S 10TH FL
 200
 U/S

W9-06X 1 REQUIRED
 1/2 FRAME

T/S 10TH FL
 300
 U/S
 3050
 2750
 T/S 9TH FL
 200
 U/S




W9-06 1 REQUIRED
 2487 SERIES

BY-PASS

REFER TO PAGE E9-23
 FOR BALCONY
 ENCLOSURE

B9-04


4889 F.S.

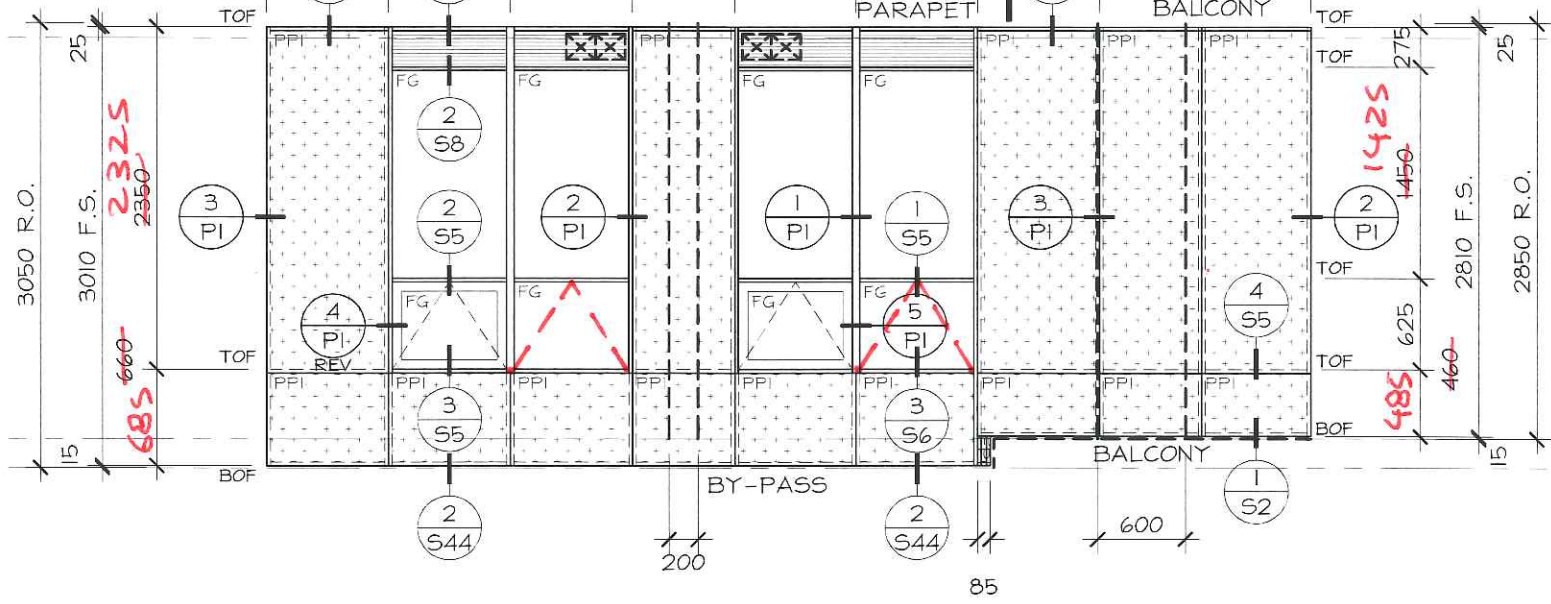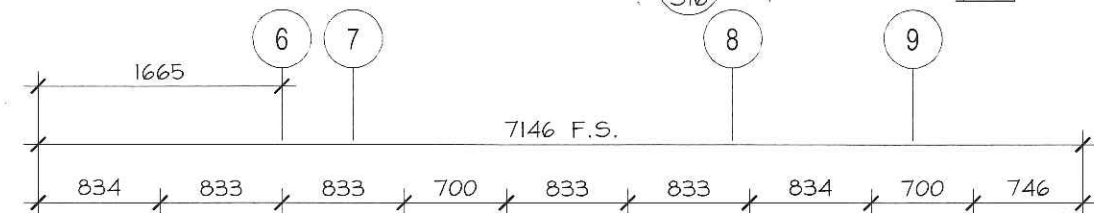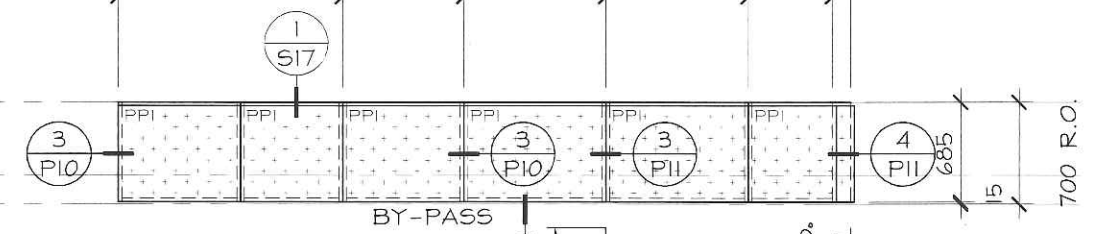

No.	REVISION	BY	DATE


PROJECT NAME: SQ ALEXANDRA PARK - BLOCK11
 DRAWING TITLE: 9th FLOOR ELEVATIONS
 ARCHITECT: TEEPLE ARCHITECTS
 CONTRACTOR: TRIDEL
 SCALE: 1:50
 DRAWN BY: S.C.
 DATE: MARCH 4, 2015

DRAWING No.:
E9-6

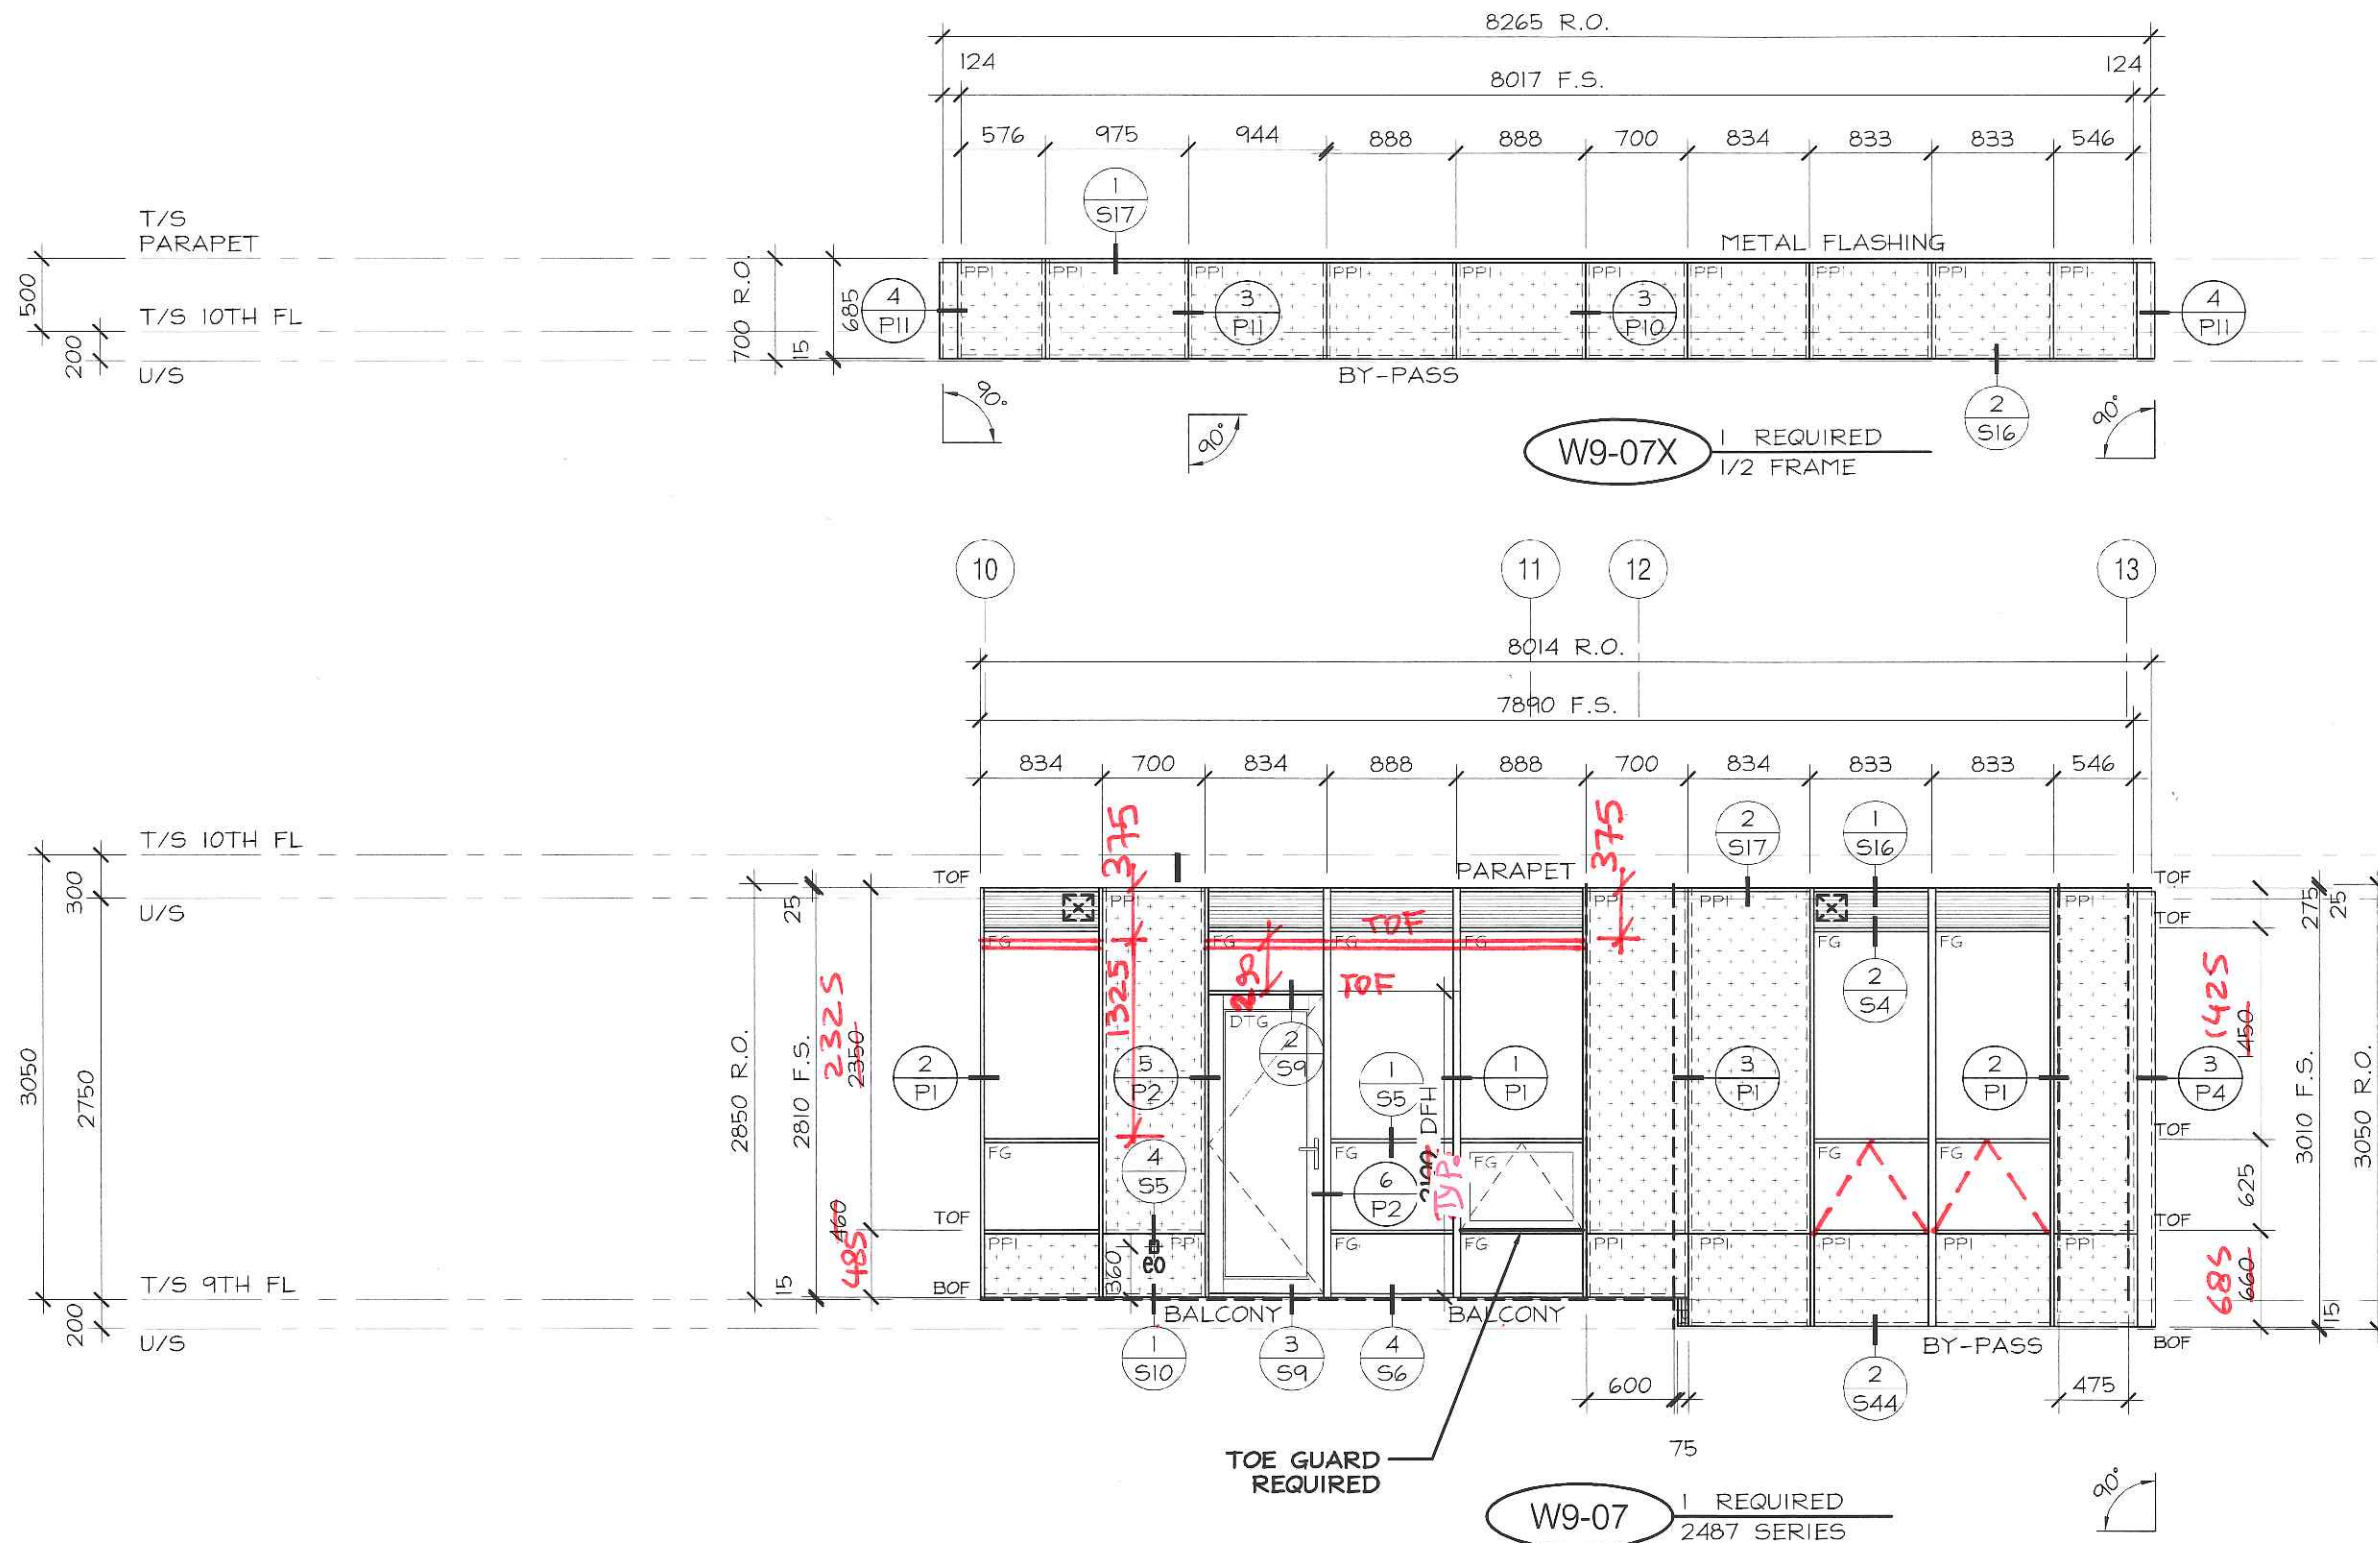

No.	REVISION	BY	DATE

PROJECT NAME: SQ ALEXANDRA PARK - BLOCK 11		DRAWING No.: E9-7
DRAWING TITLE: 9th FLOOR ELEVATIONS		
ARCHITECT: TEEPLE ARCHITECTS		DRAWN BY: S.C.
CONTRACTOR: TRIDEL		
SCALE: 1:50		DATE: MARCH 4, 2015

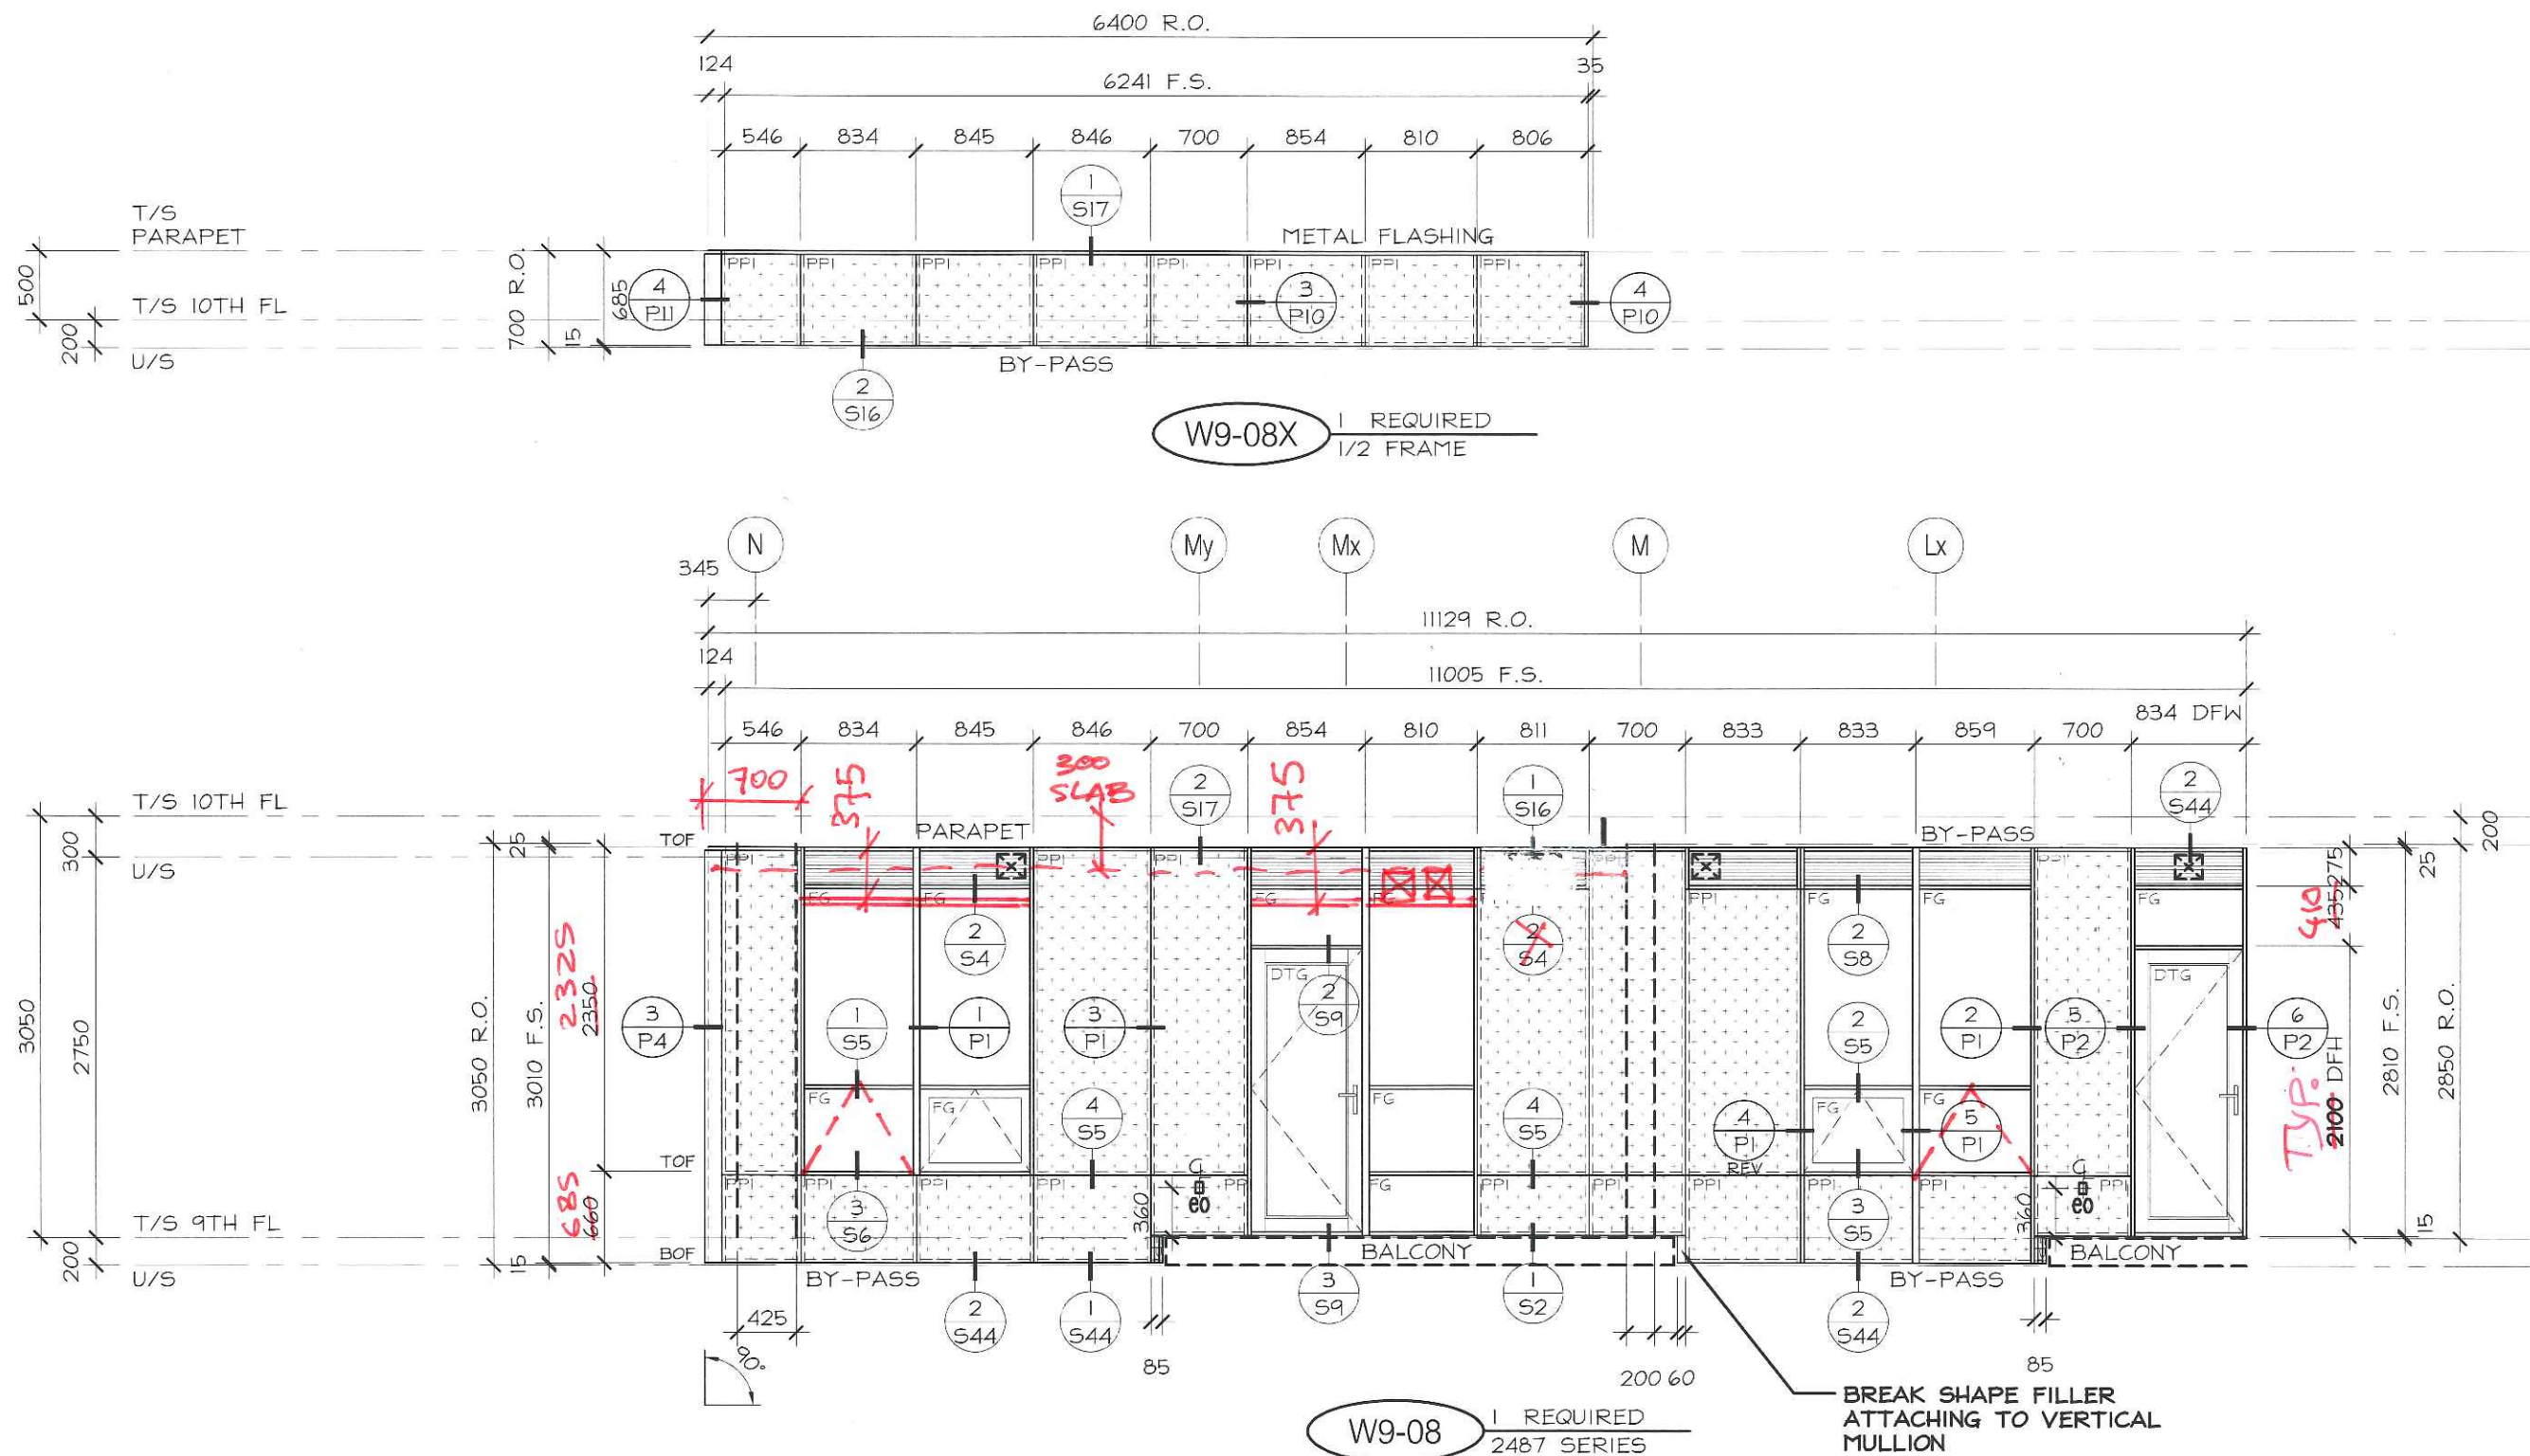

W9-08X 1 REQUIRED
1/2 FRAME

W9-08 1 REQUIRED
2487 SERIES

BREAK SHAPE FILLER
ATTACHING TO VERTICAL
MULLION



TORO ALUMINUM
COMMERCIAL INDUSTRIAL RESIDENTIAL
330 APPLEWOOD CRESCENT TEL: (905) 738-5220
CONCORD, ON, CANADA FAX: (905) 738-5481
L4K 4V2 WWW.TOROALUMINUM.COM

LICENSED PROFESSIONAL ENGINEER
06-27-15
D.T. PROHASKA
3754901
PROVINCE OF ONTARIO

No.	REVISION	BY	DATE


PROJECT NAME:	SQ ALEXANDRA PARK - BLOCK 11		
DRAWING TITLE:	9th FLOOR ELEVATIONS		
ARCHITECT:	TEEPLE ARCHITECTS		
CONTRACTOR:	TRIDEL		
SCALE:	1:50	DRAWN BY:	S.C.
DATE:	MARCH 4, 2015		

DRAWING No.:
E9-8

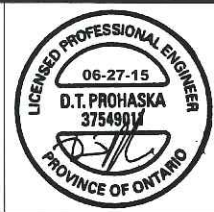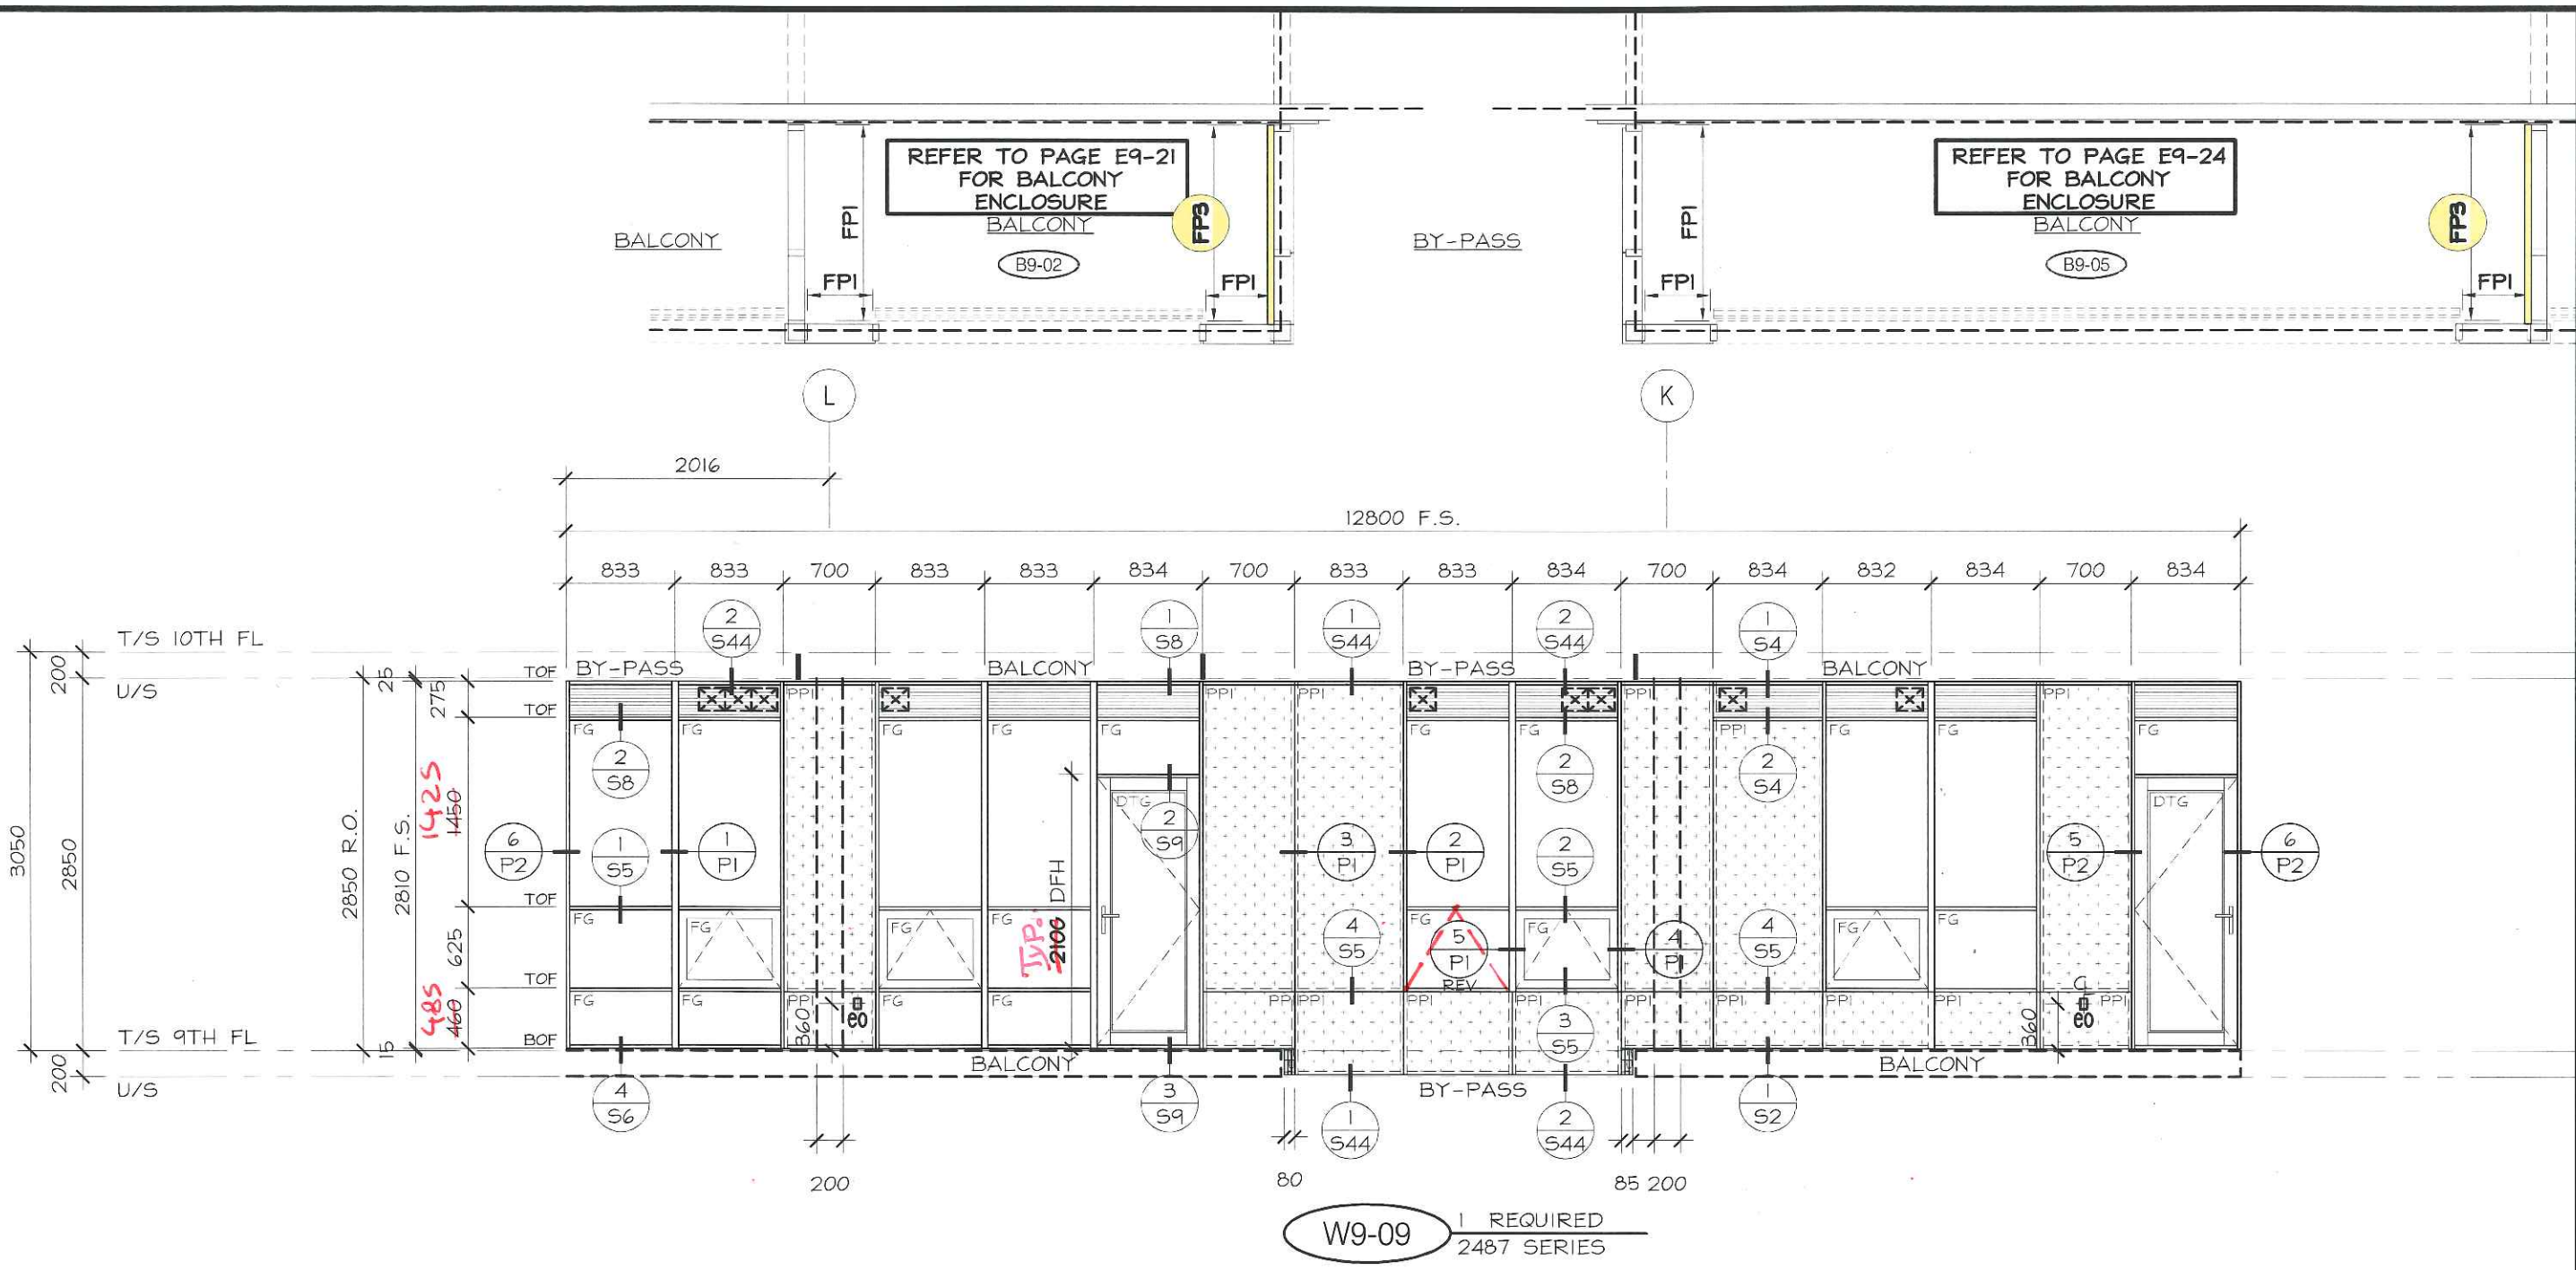


No.	REVISION	BY	DATE

PROJECT NAME: SQ ALEXANDRA PARK - BLOCK 11		DRAWING No.: E9-9
DRAWING TITLE: 9th FLOOR ELEVATIONS		
ARCHITECT: TEEPLE ARCHITECTS		DATE: MARCH 4, 2015
CONTRACTOR: TRIDEL		
SCALE: 1:50	DRAWN BY: S.C.	

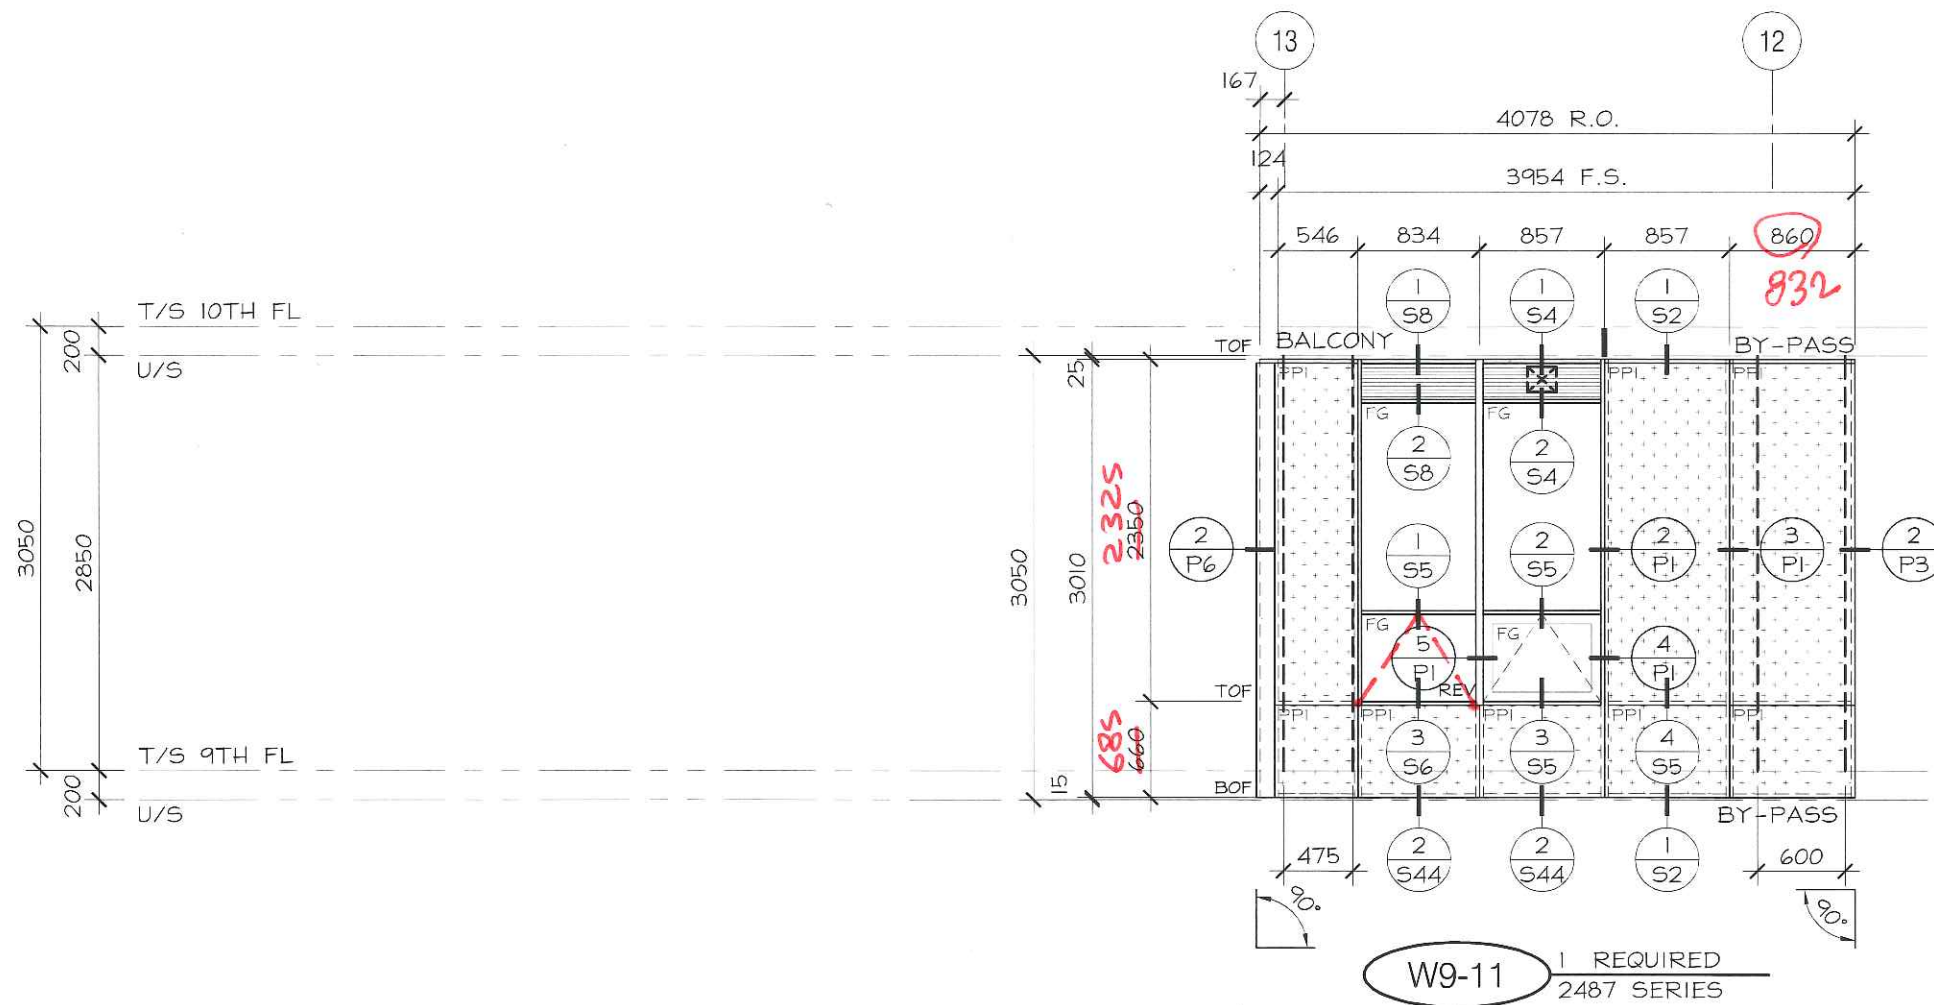



No.	REVISION	BY	DATE

PROJECT NAME: SQ ALEXANDRA PARK - BLOCK11		DRAWING No.: E9-11
DRAWING TITLE: 9th FLOOR ELEVATIONS		
ARCHITECT: TEEPLE ARCHITECTS		DATE: MARCH 4, 2015
CONTRACTOR: TRIDEL		
SCALE: 1:50	DRAWN BY: S.C.	

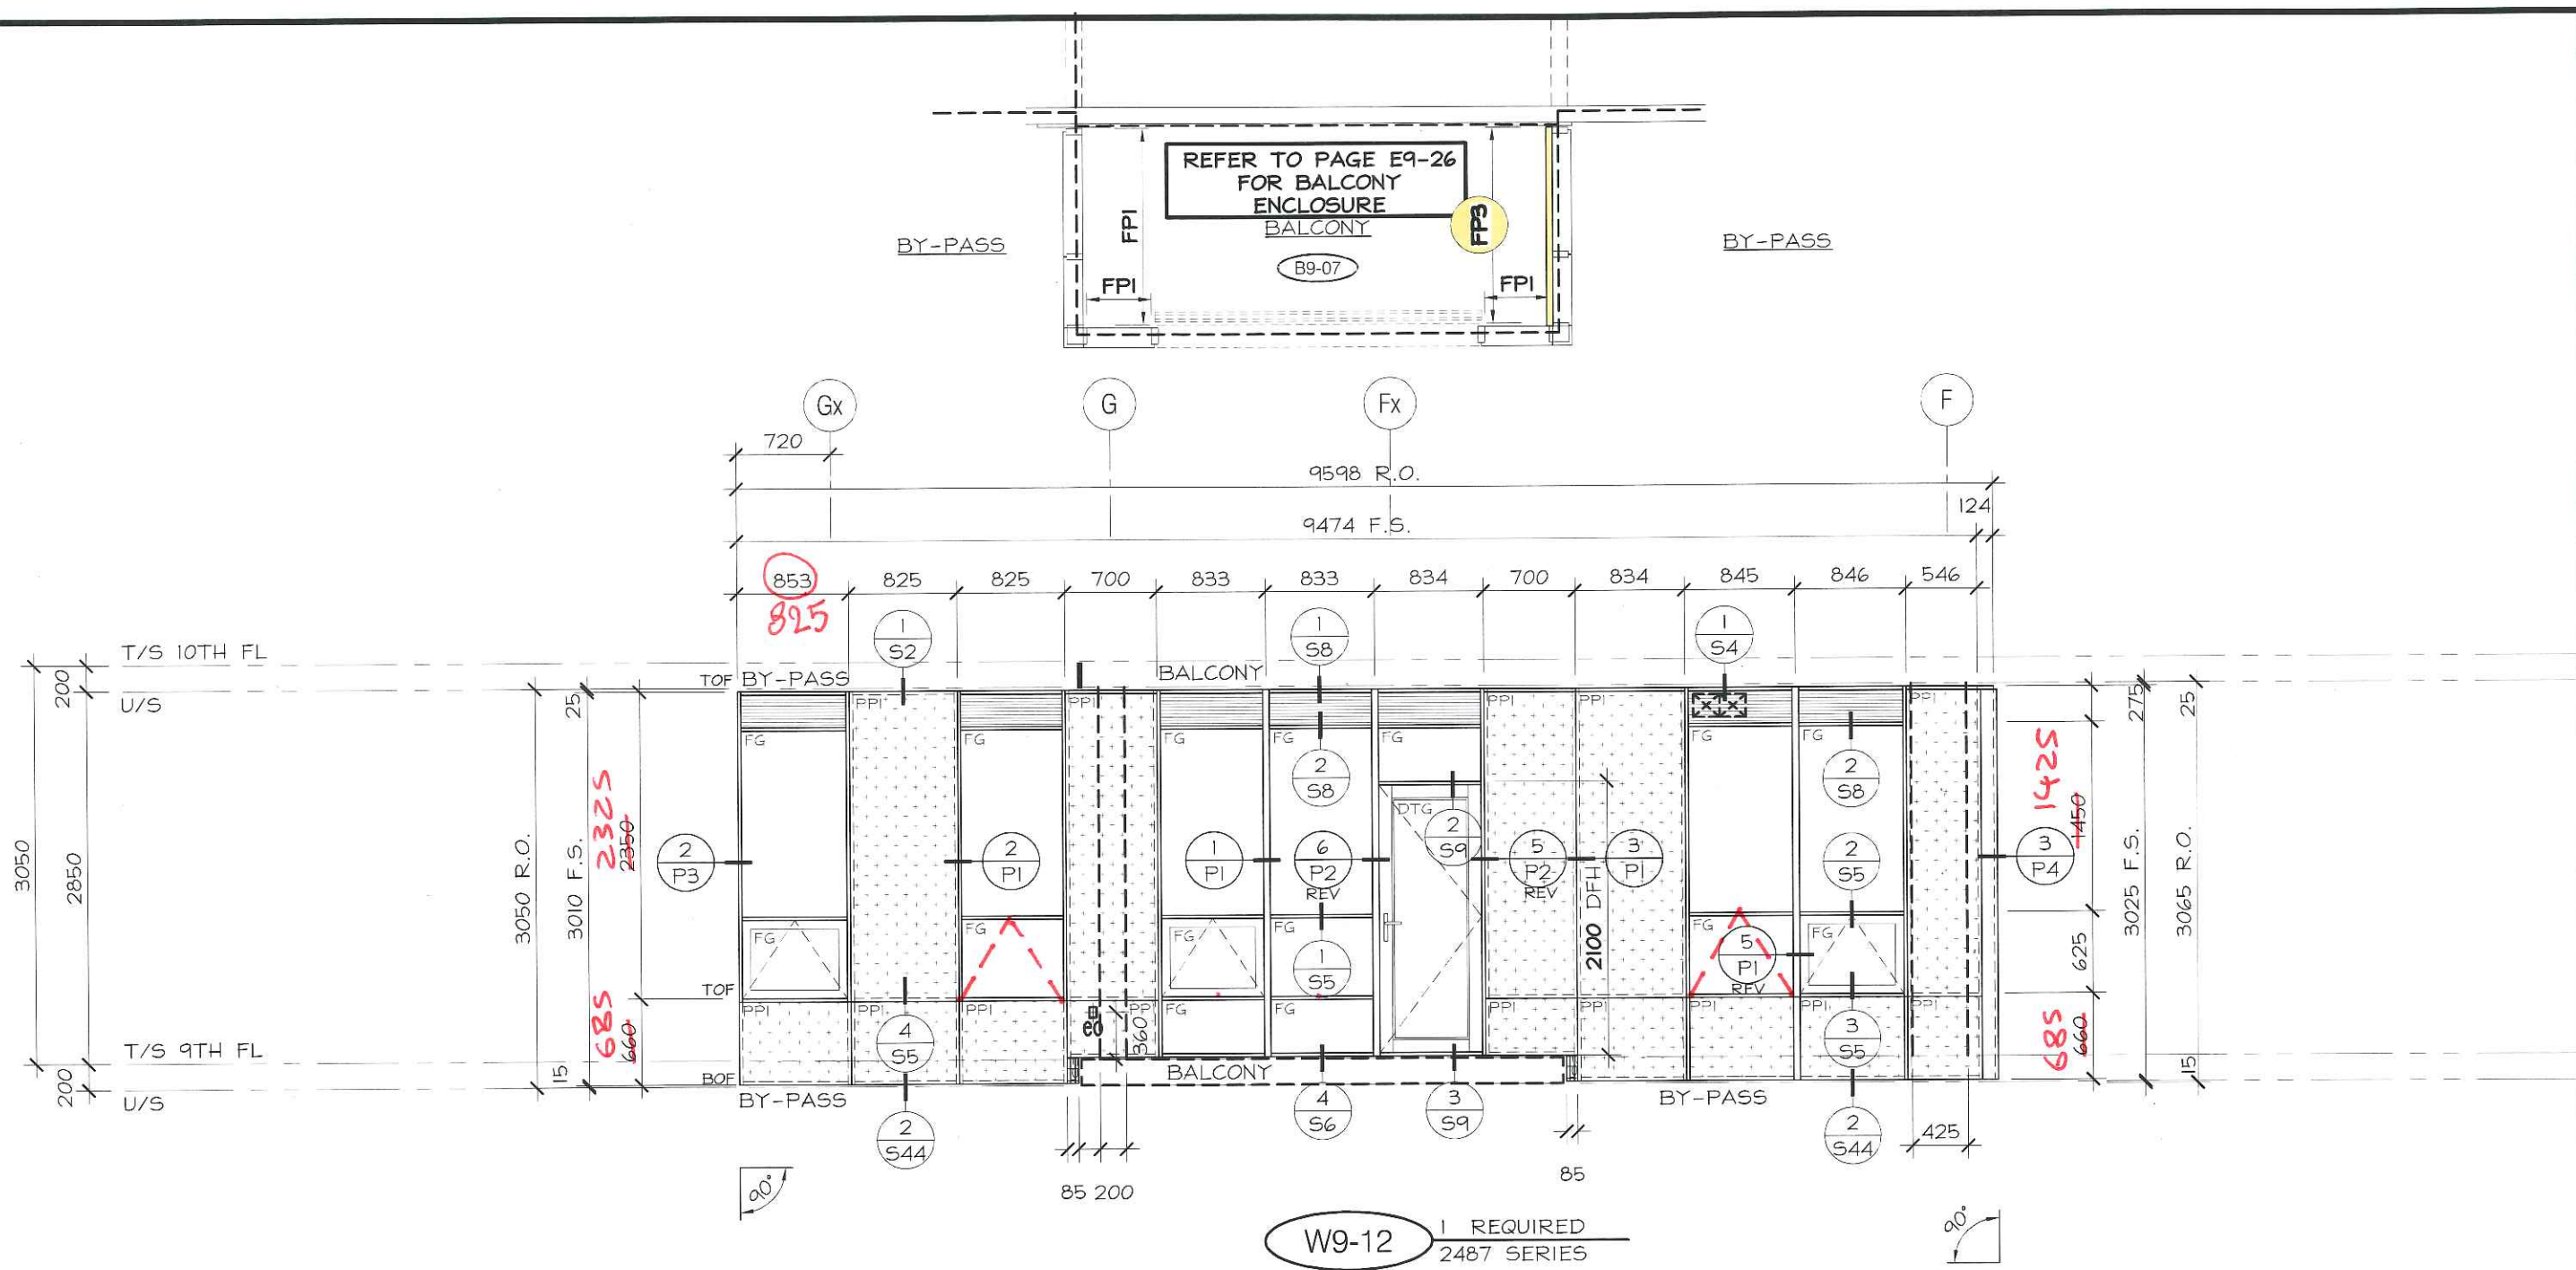

No.	REVISION	BY	DATE

PROJECT NAME: SQ ALEXANDRA PARK - BLOCK11		DRAWING No.: E9-12
DRAWING TITLE: 9th FLOOR ELEVATIONS		
ARCHITECT: TEEPLE ARCHITECTS	DRAWN BY: S.C.	
CONTRACTOR: TRIDEL	DATE: MARCH 4, 2015	
SCALE: 1:50		

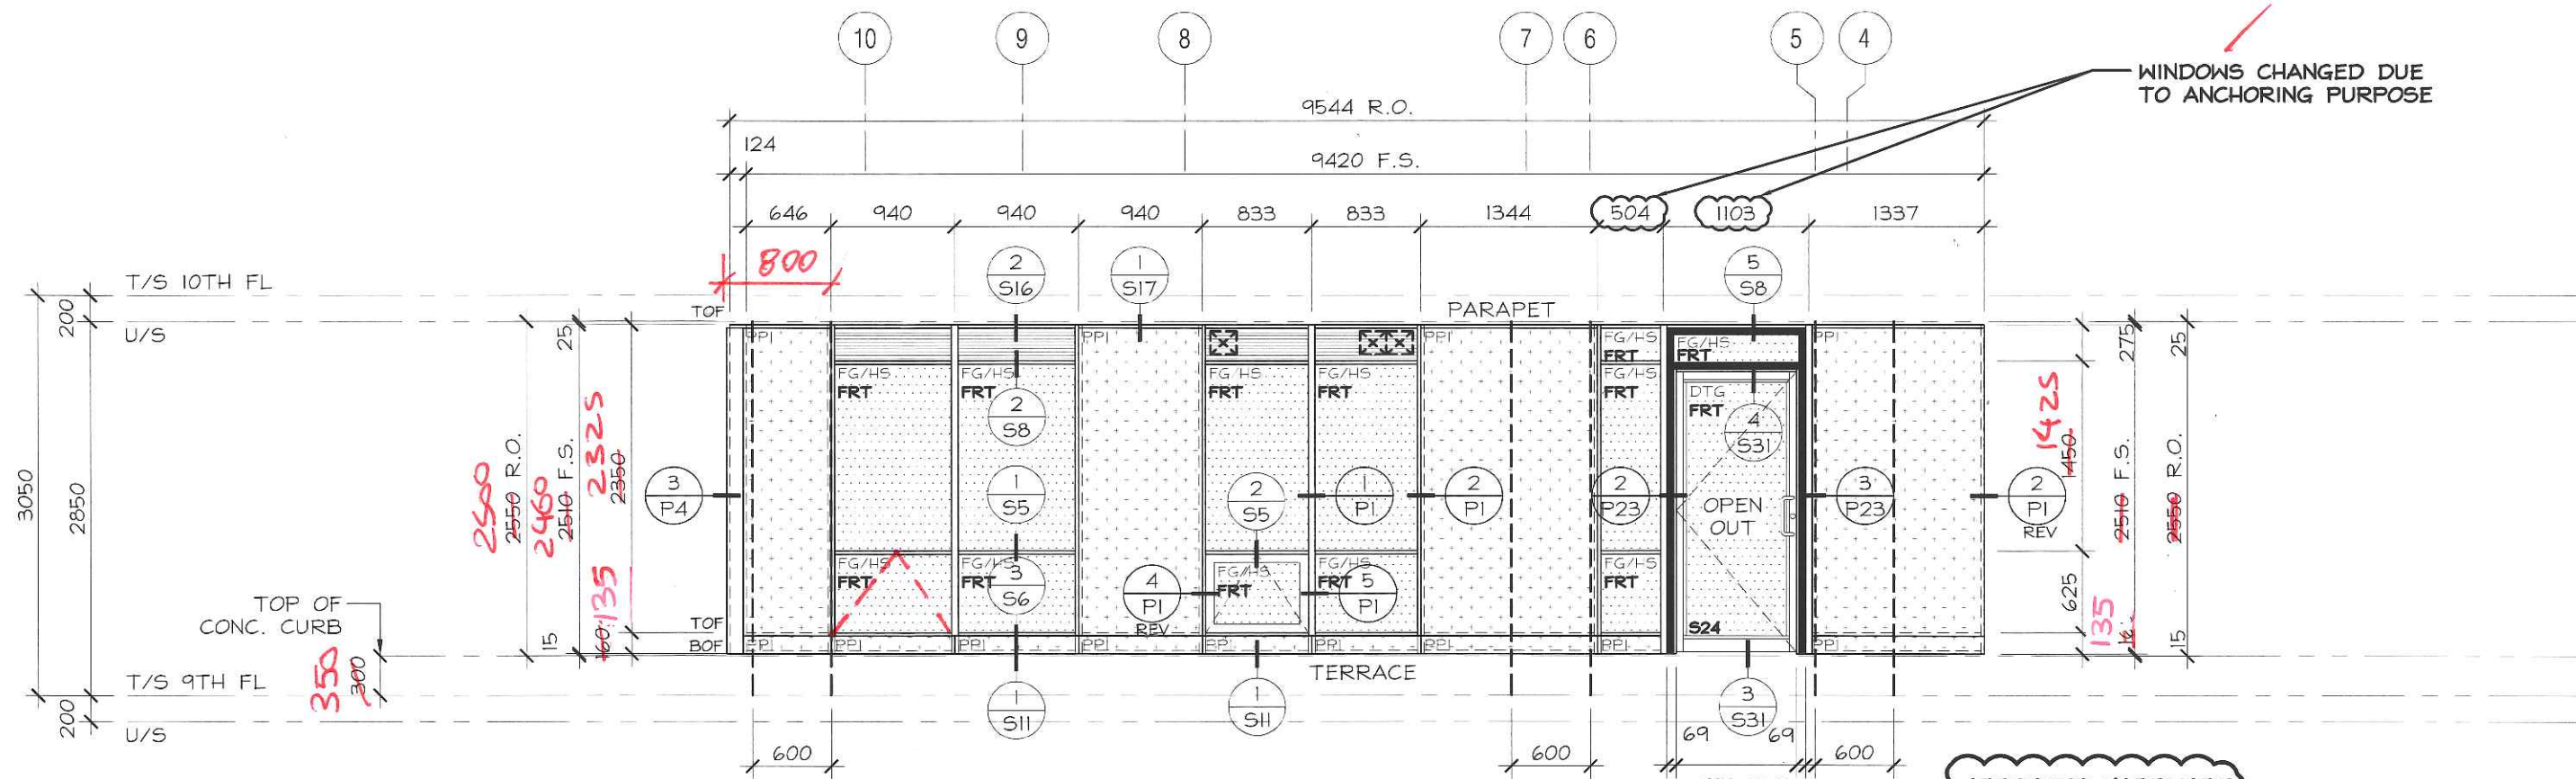
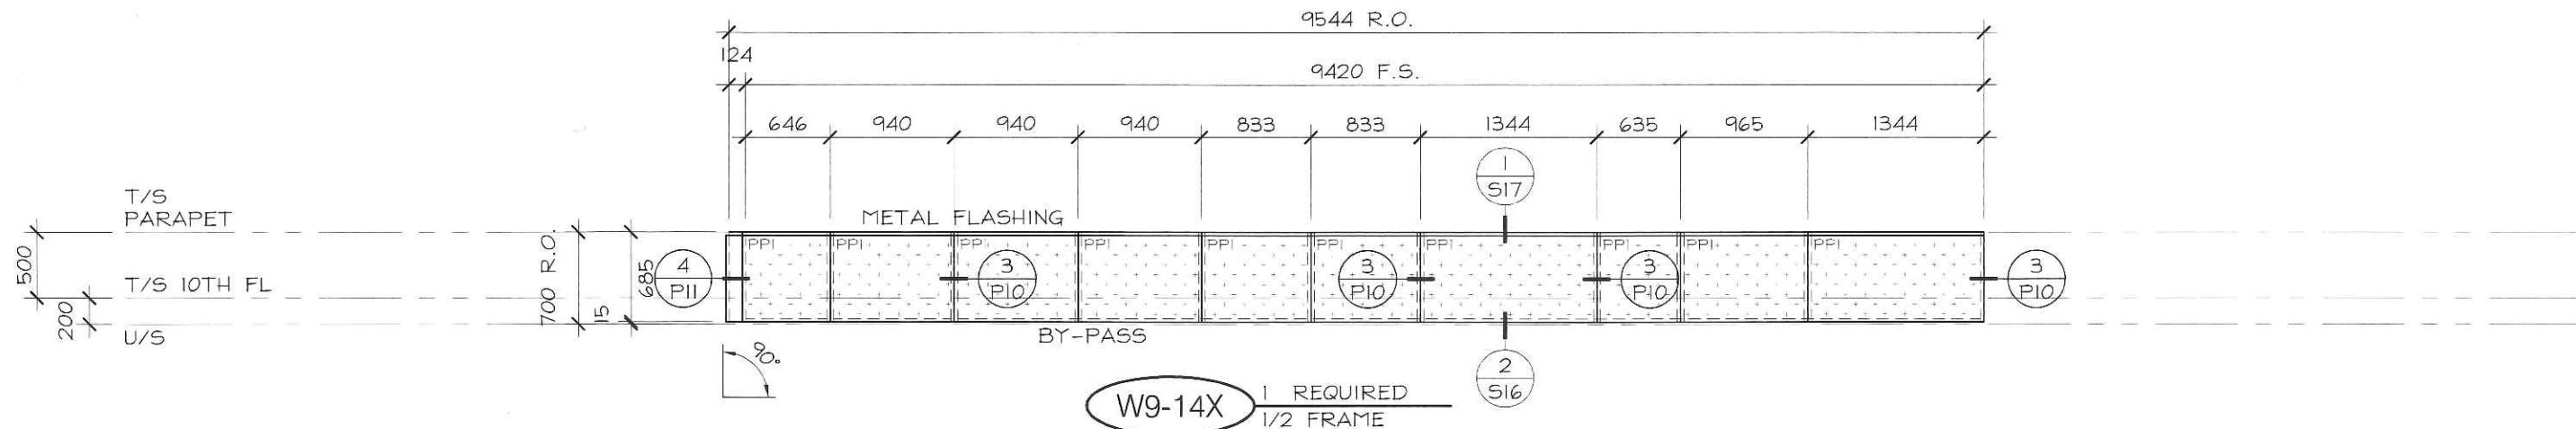


APPROVED HARDWARE SCHEDULE MUST BE PROVIDED BY CONTRACTOR TO PROCEED WITH ANY DOOR ORDER



No.	REVISION	BY	DATE



PROJECT NAME:	SQ ALEXANDRA PARK - BLOCK11		
DRAWING TITLE:	9th FLOOR ELEVATIONS		
ARCHITECT:	TEEPLE ARCHITECTS		
CONTRACTOR:	TRIDEL		
SCALE:	1:50	DRAWN BY:	S.C.
DATE:	MARCH 4, 2015		
DRAWING No.:	E9-14		

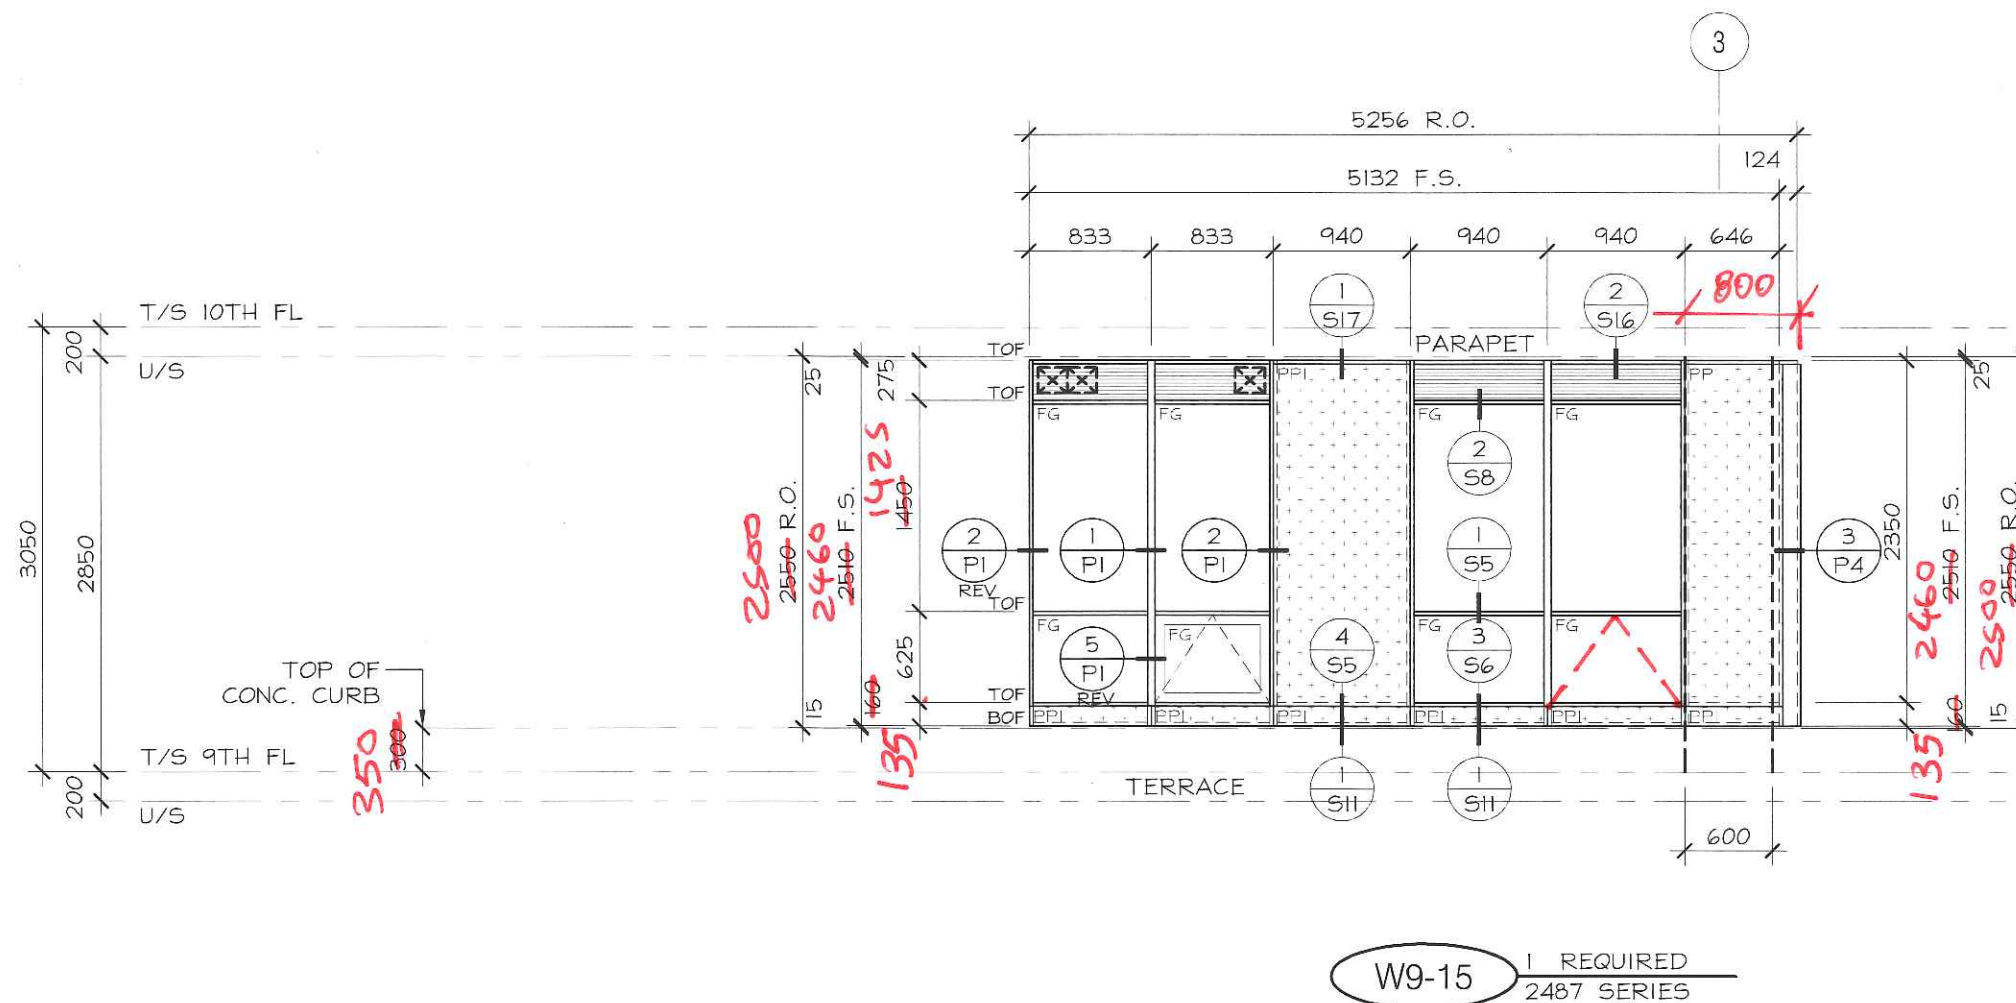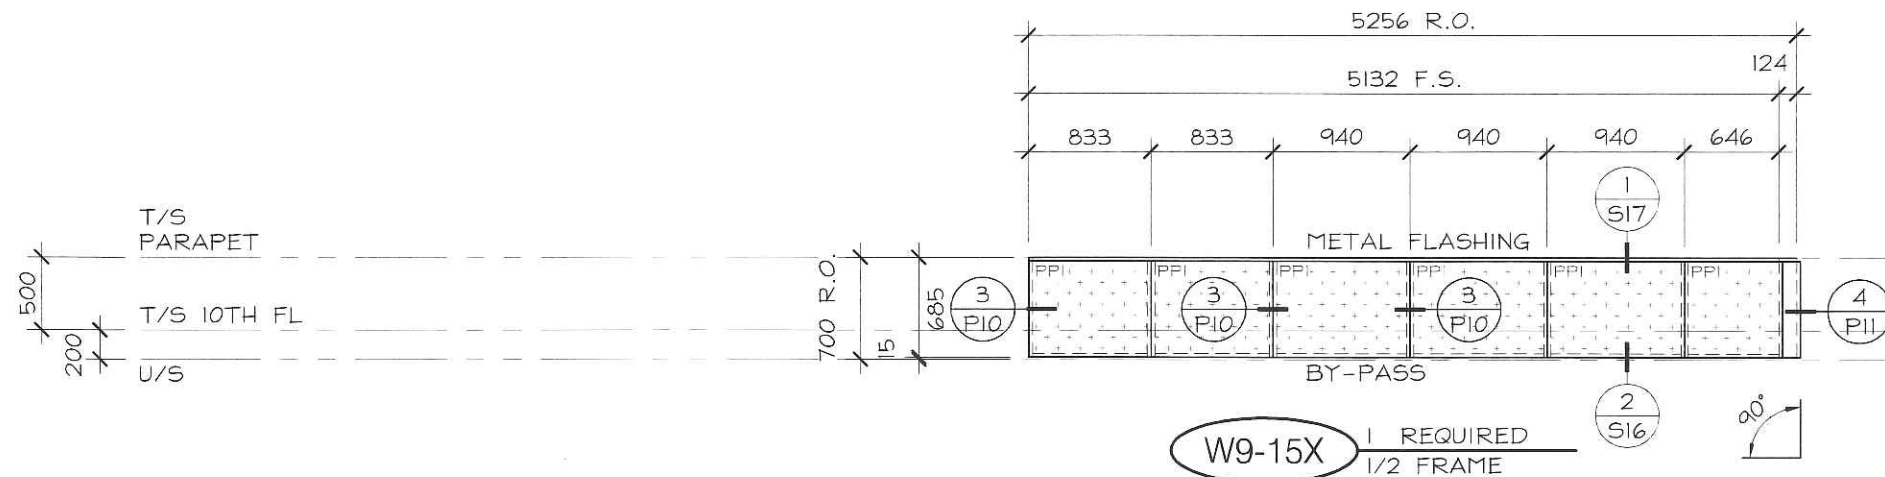

No.	REVISION	BY	DATE

PROJECT NAME:	SQ ALEXANDRA PARK - BLOCK11
DRAWING TITLE:	9th FLOOR ELEVATIONS
ARCHITECT:	TEEPLE ARCHITECTS
CONTRACTOR:	TRIDEL
SCALE:	1:50
DRAWN BY:	S.C.
DATE:	MARCH 4, 2015


DRAWING No.:
E9-15

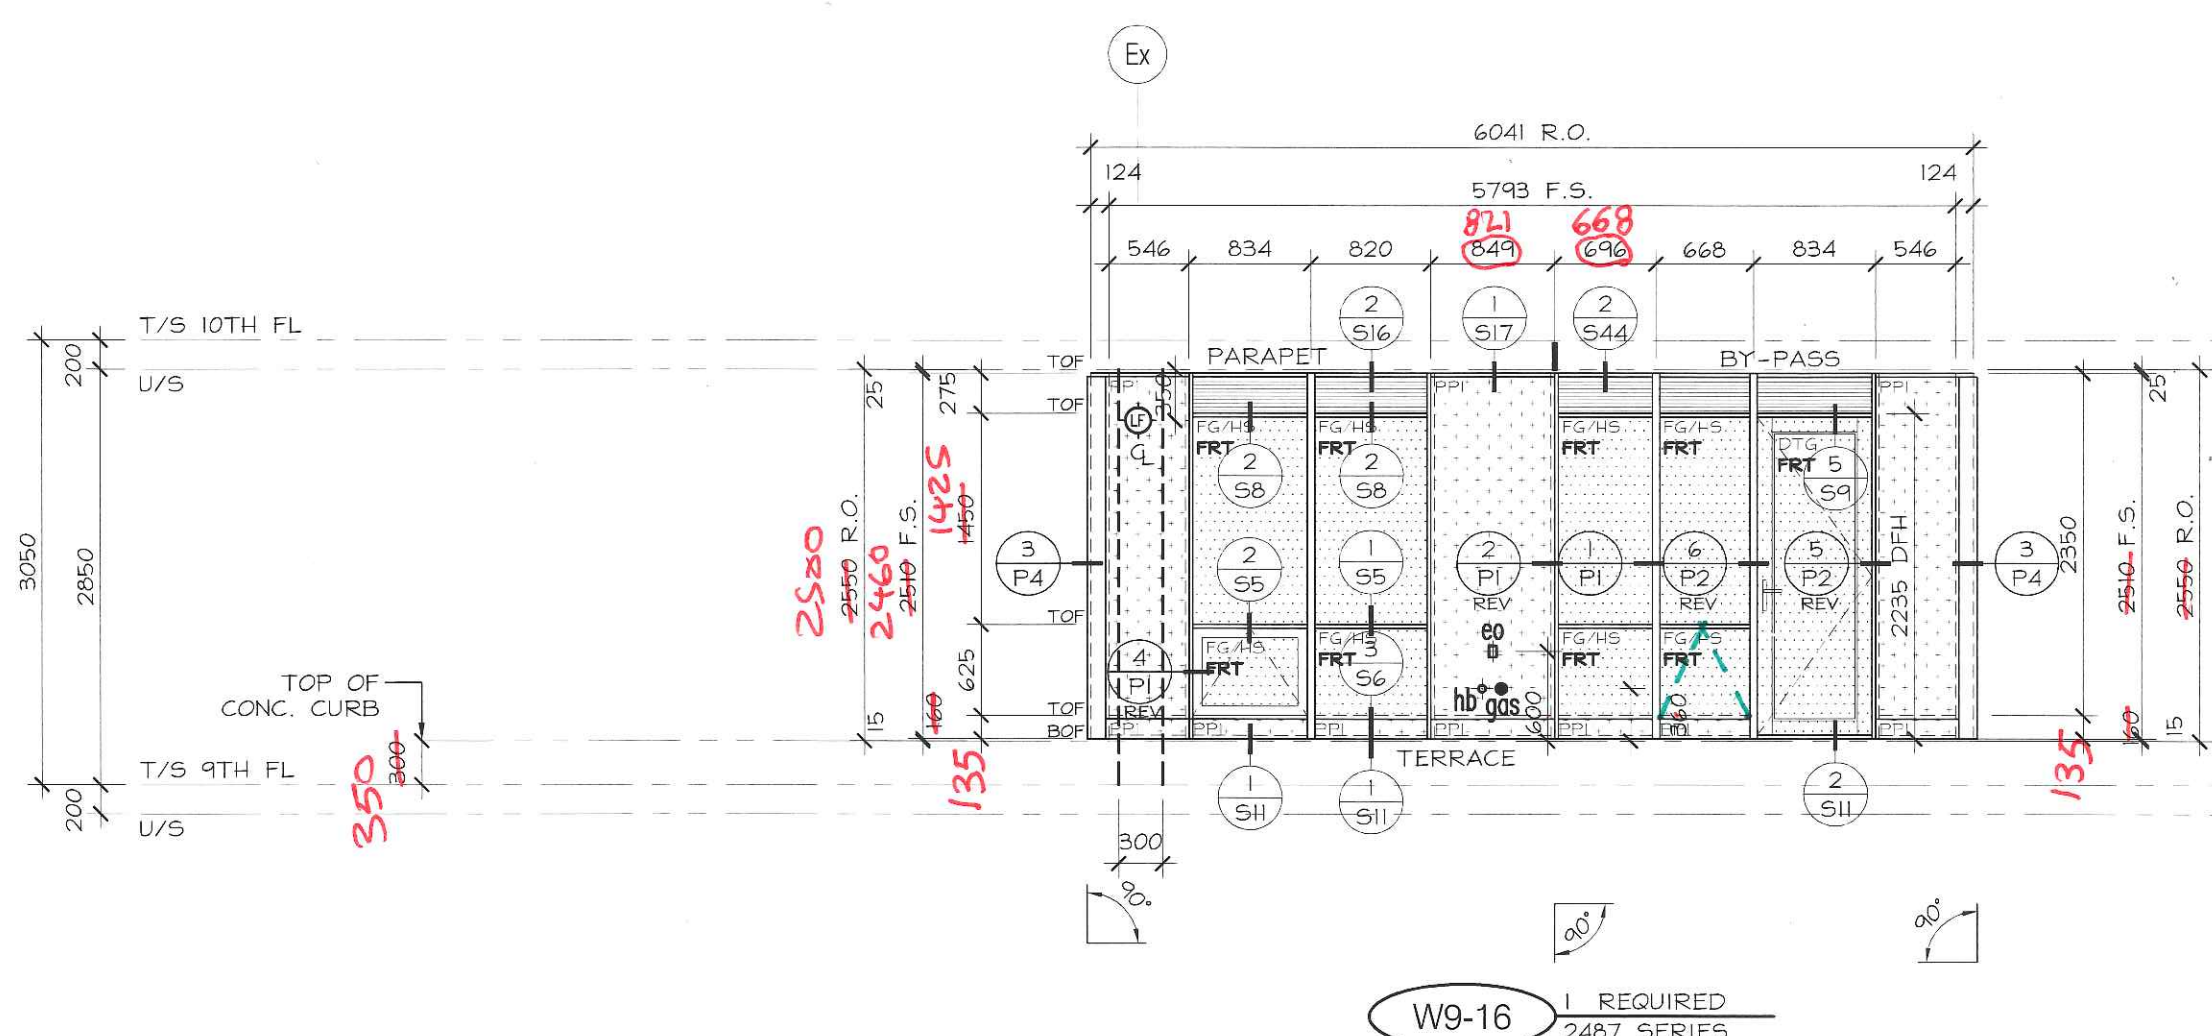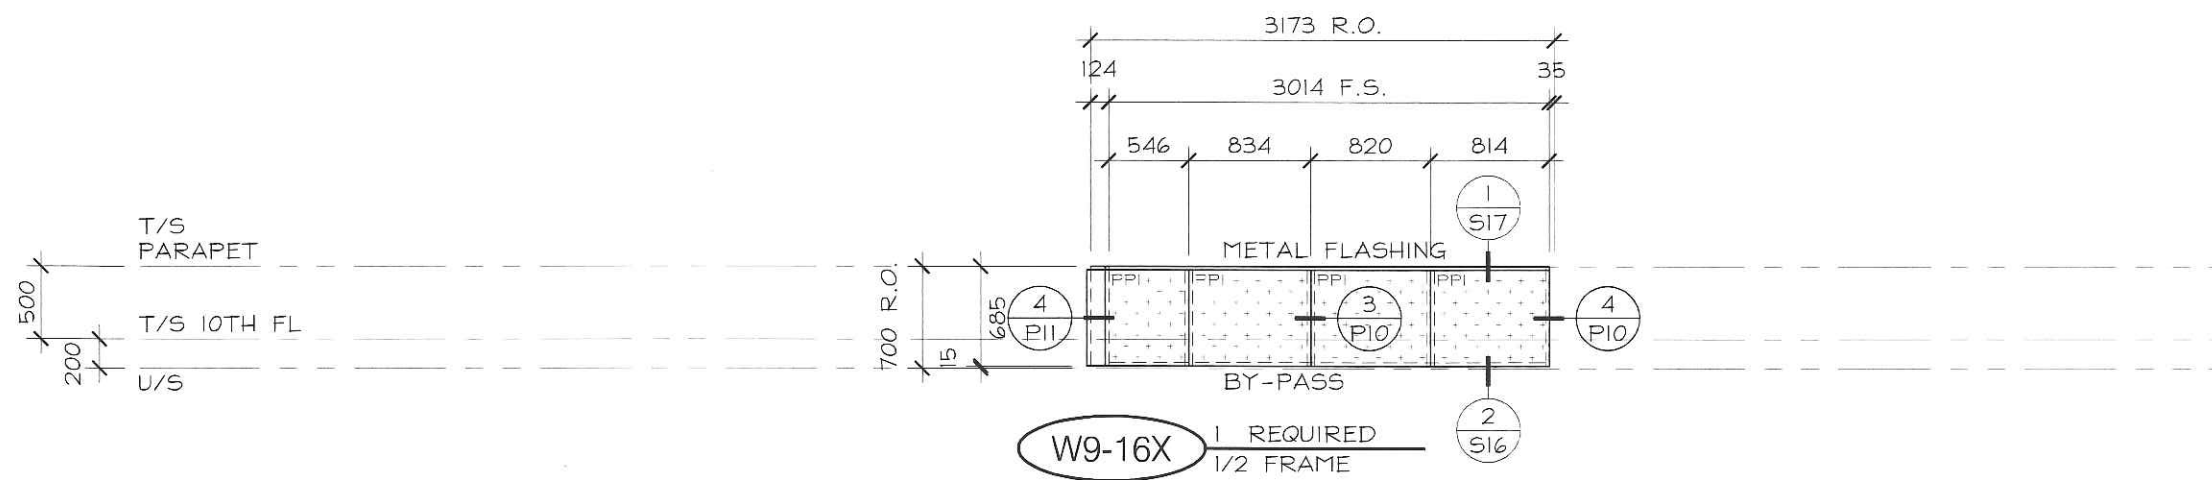

No.	REVISION	BY	DATE

PROJECT NAME:	SQ ALEXANDRA PARK - BLOCK11		
DRAWING TITLE:	9th FLOOR ELEVATIONS		
ARCHITECT:	TEEPLE ARCHITECTS		
CONTRACTOR:	TRIDEL		
SCALE:	1:50	DRAWN BY:	S.C.
DATE:	MARCH 4, 2015		
DRAWING No.:	E9-16		

REVIEW PENDING

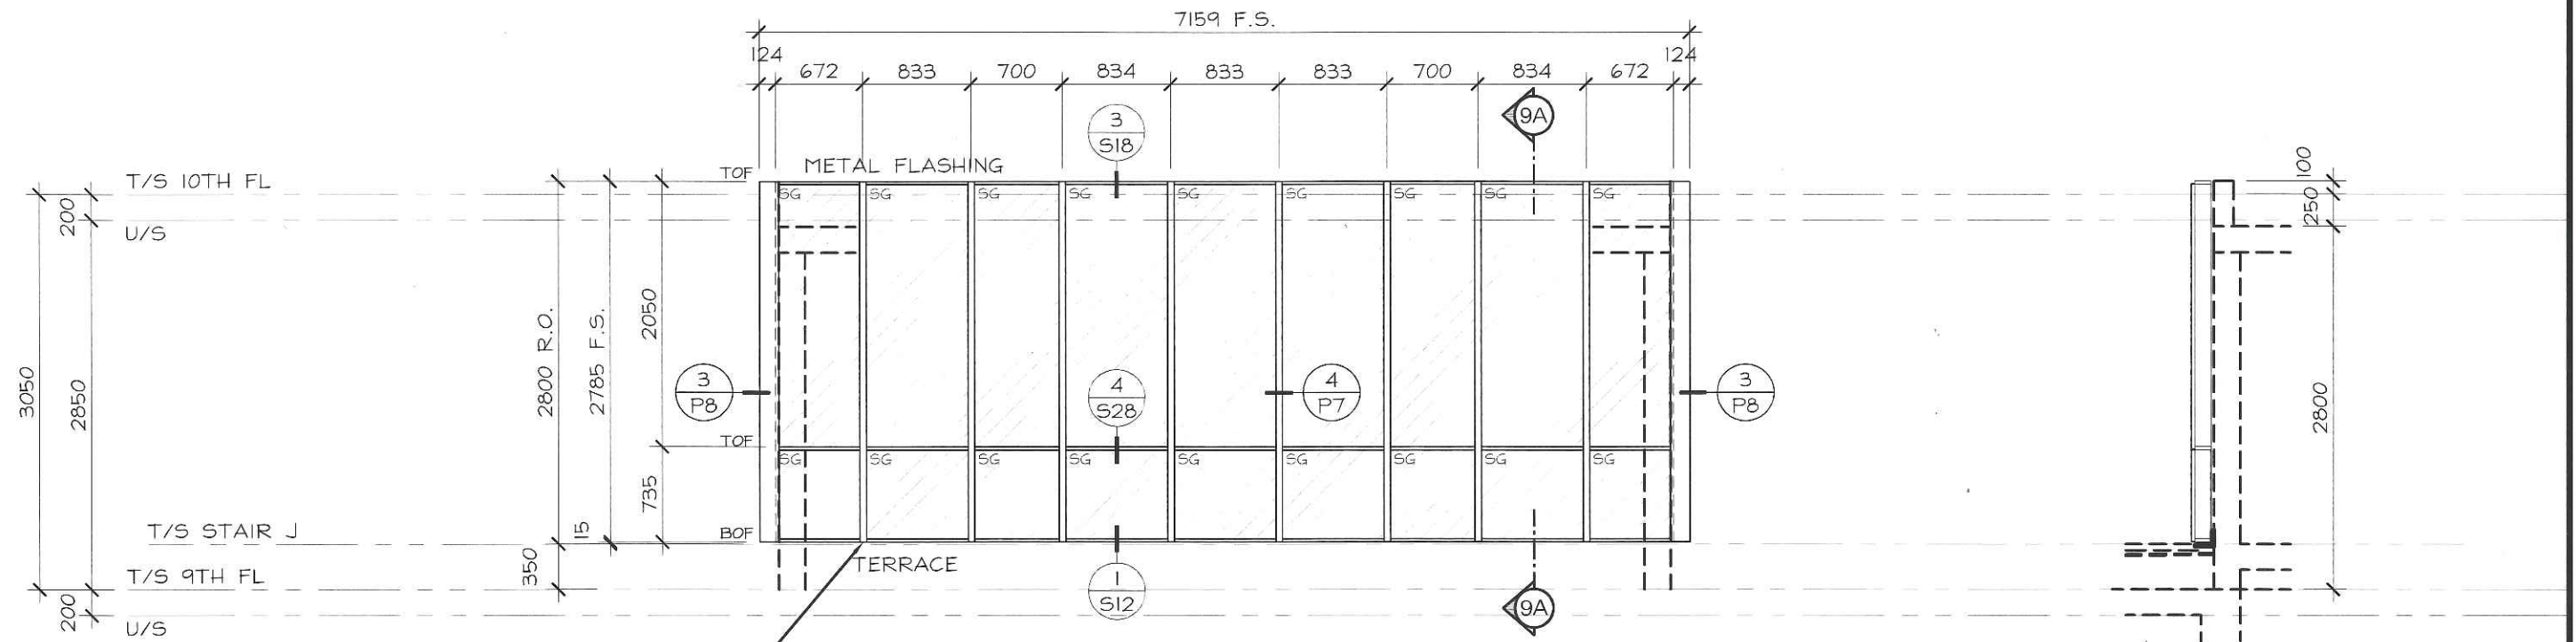

ARCHITECT: PROVIDE
CONCRETE CURB FOR
WINDOW SUPPORT.
REFER TO
ARCHITECTURE
DETAILS
7/A609

W9-17 1 REQUIRED
2487 SERIES


9A-9A
CROSS SECTION
ARCH. REF. 1/A505



No.	REVISION	BY	DATE

PROJECT NAME: SQ ALEXANDRA PARK - BLOCK11		DRAWING No.: E9-17
DRAWING TITLE: 9th FLOOR ELEVATIONS		
ARCHITECT: TEEPLE ARCHITECTS		DATE: MARCH 4, 2015
CONTRACTOR: TRIDEL		
SCALE: 1:50	DRAWN BY: S.C.	

REVIEW PENDING

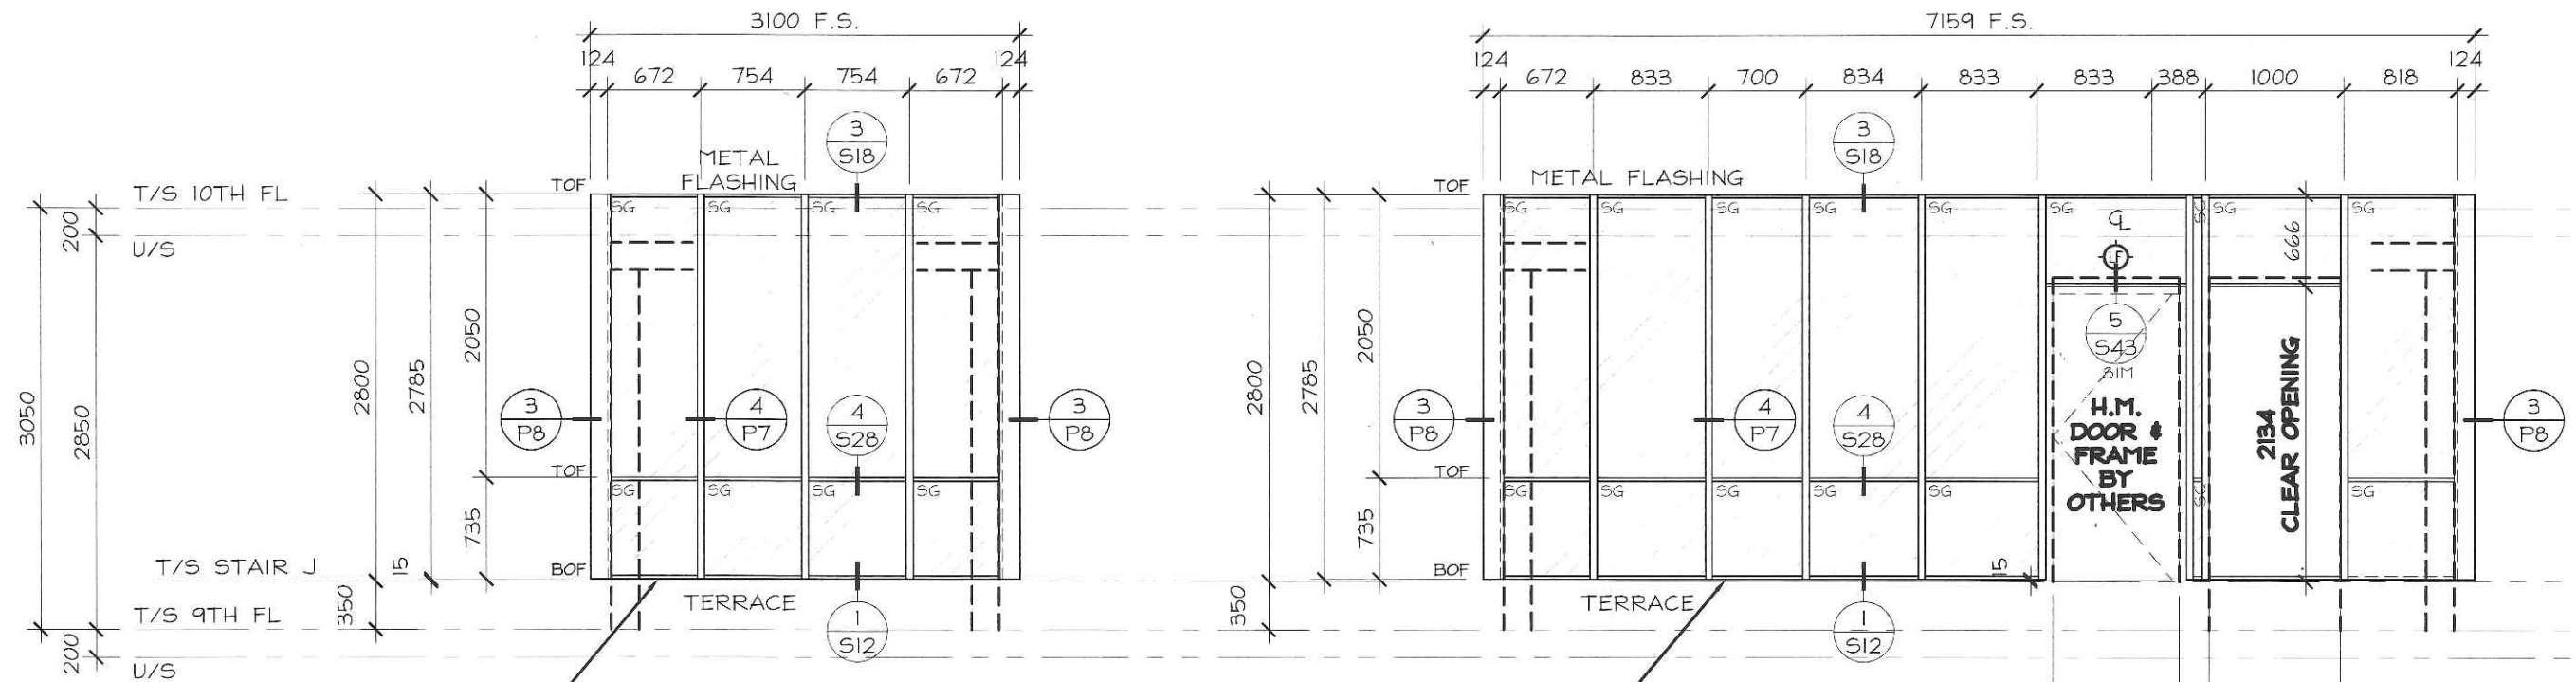

ARCHITECT: PROVIDE CONCRETE CURB FOR WINDOW SUPPORT. REFER TO ARCHITECTURE DETAILS 7/A609

W9-18 1 REQUIRED 2487 SERIES

ARCHITECT: PROVIDE CONCRETE CURB FOR WINDOW SUPPORT. REFER TO ARCHITECTURE DETAILS 7/A609

W9-19 1 REQUIRED 2487 SERIES




No.	REVISION	BY	DATE

PROJECT NAME:	SQ ALEXANDRA PARK - BLOCK11
DRAWING TITLE:	9th FLOOR ELEVATIONS
ARCHITECT:	TEEPLE ARCHITECTS
CONTRACTOR:	TRIDEL
SCALE:	1:50
DRAWN BY:	S.C.
DATE:	MARCH 4, 2015

DRAWING No.: E9-18

REVIEW PENDING

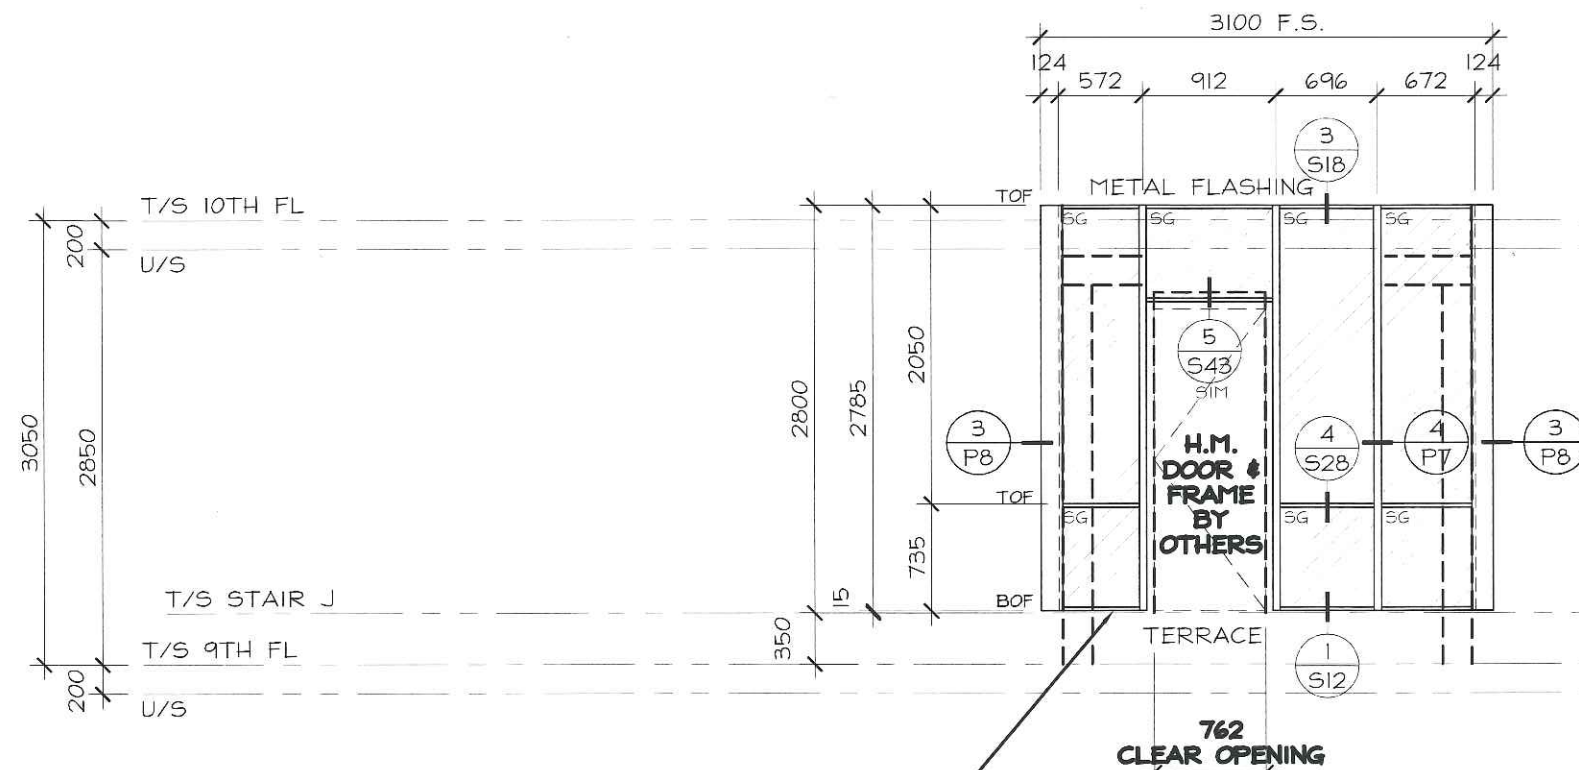

ARCHITECT: PROVIDE
CONCRETE CURB FOR
WINDOW SUPPORT.
REFER TO
ARCHITECTURE
DETAILS
7/A609

W9-20 | REQUIRED
2487 SERIES



TORO ALUMINUM
COMMERCIAL INDUSTRIAL RESIDENTIAL
330 APPLEWOOD CRESCENT TEL: (905) 738-5220
CONCORD, ON, CANADA FAX: (905) 738-5481
L4K 4V2 WWW.TOROALUMINUM.COM

LICENSED PROFESSIONAL ENGINEER
06-27-15
D.T. PROHASKA
3754901
PROVINCE OF ONTARIO


No.	REVISION	BY	DATE

PROJECT NAME: SQ ALEXANDRA PARK - BLOCK11		DRAWING No.: E9-19
DRAWING TITLE: 9th FLOOR ELEVATIONS		
ARCHITECT: TEEPLE ARCHITECTS		DATE: MARCH 4, 2015
CONTRACTOR: TRIDEL		
SCALE: 1:50	DRAWN BY: S.C.	

FOR ALUMINUM BALCONY
 & TERRACE RAILINGS
 REFER TO TORO
 ALUMINUM RAILING SHOP
 DRAWINGS

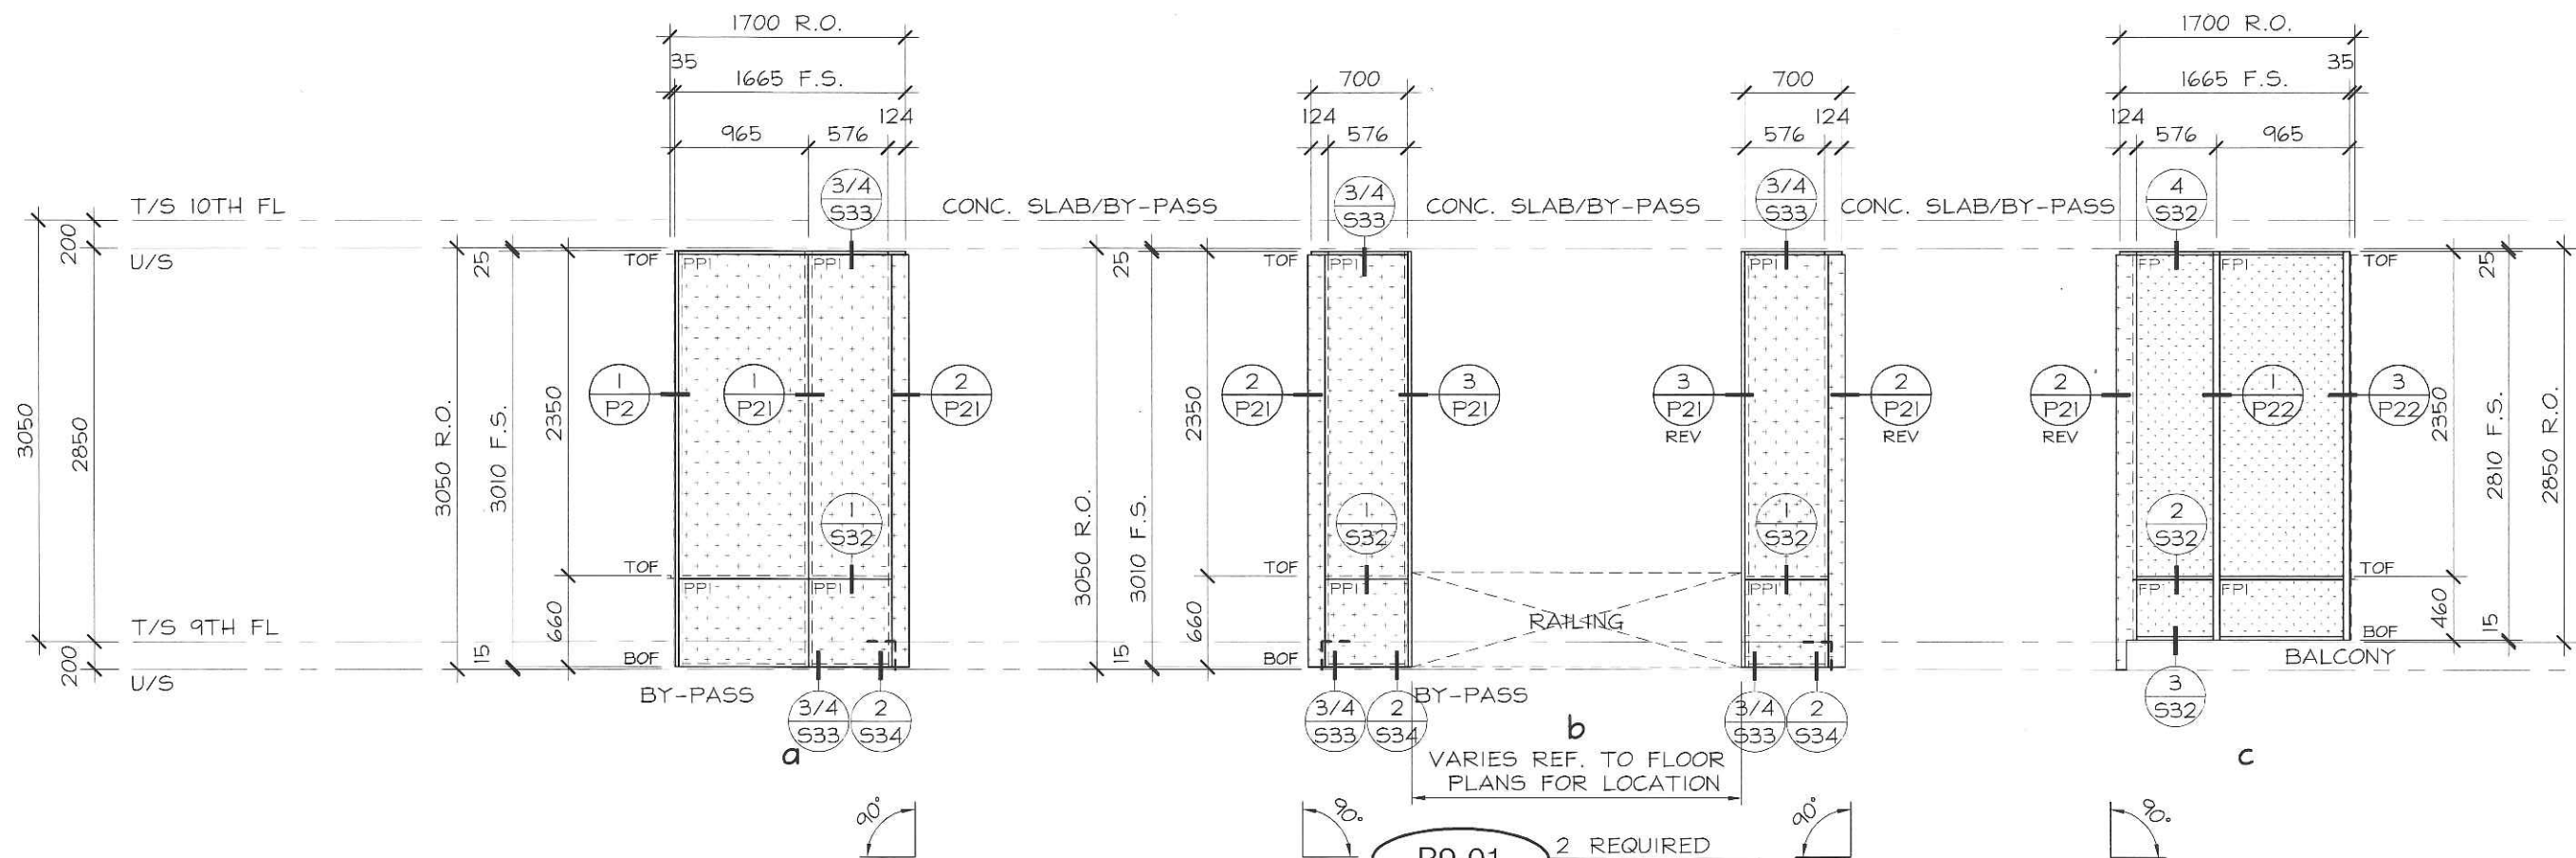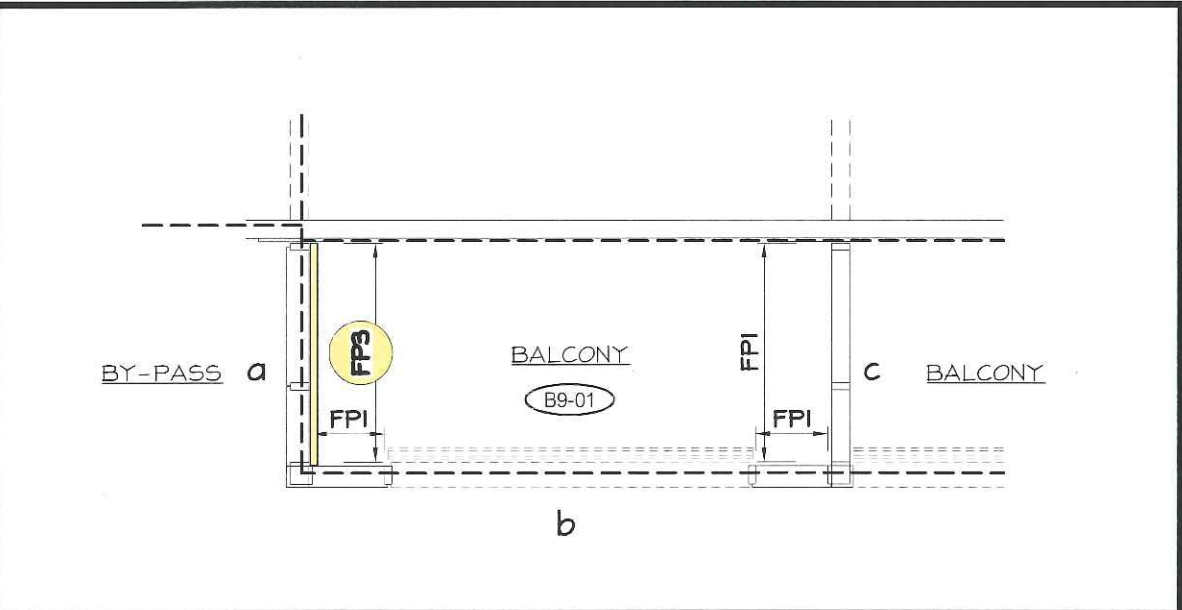



B9-01 2 REQUIRED
 2487 SERIES
 EXT. FINISH: PPG ACRYNAR PLATINUM UCFX1185
 INT. FINISH: PPG ACRYNAR PLATINUM UCFX1185
 a INT. FINISH: PPG ACRYNAR T.B.D.

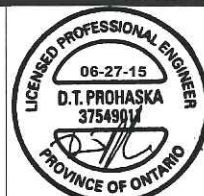


No.	REVISION	BY	DATE

PROJECT NAME: SQ ALEXANDRA PARK - BLOCK11		DRAWING No.: E9-20
DRAWING TITLE: 9th FLOOR ELEVATIONS		
ARCHITECT: TEEPLE ARCHITECTS		DATE: MARCH 4, 2015
CONTRACTOR: TRIDEL		
SCALE: 1:50	DRAWN BY: S.C.	

FOR ALUMINUM BALCONY & TERRACE RAILINGS REFER TO TORO ALUMINUM RAILING SHOP DRAWINGS

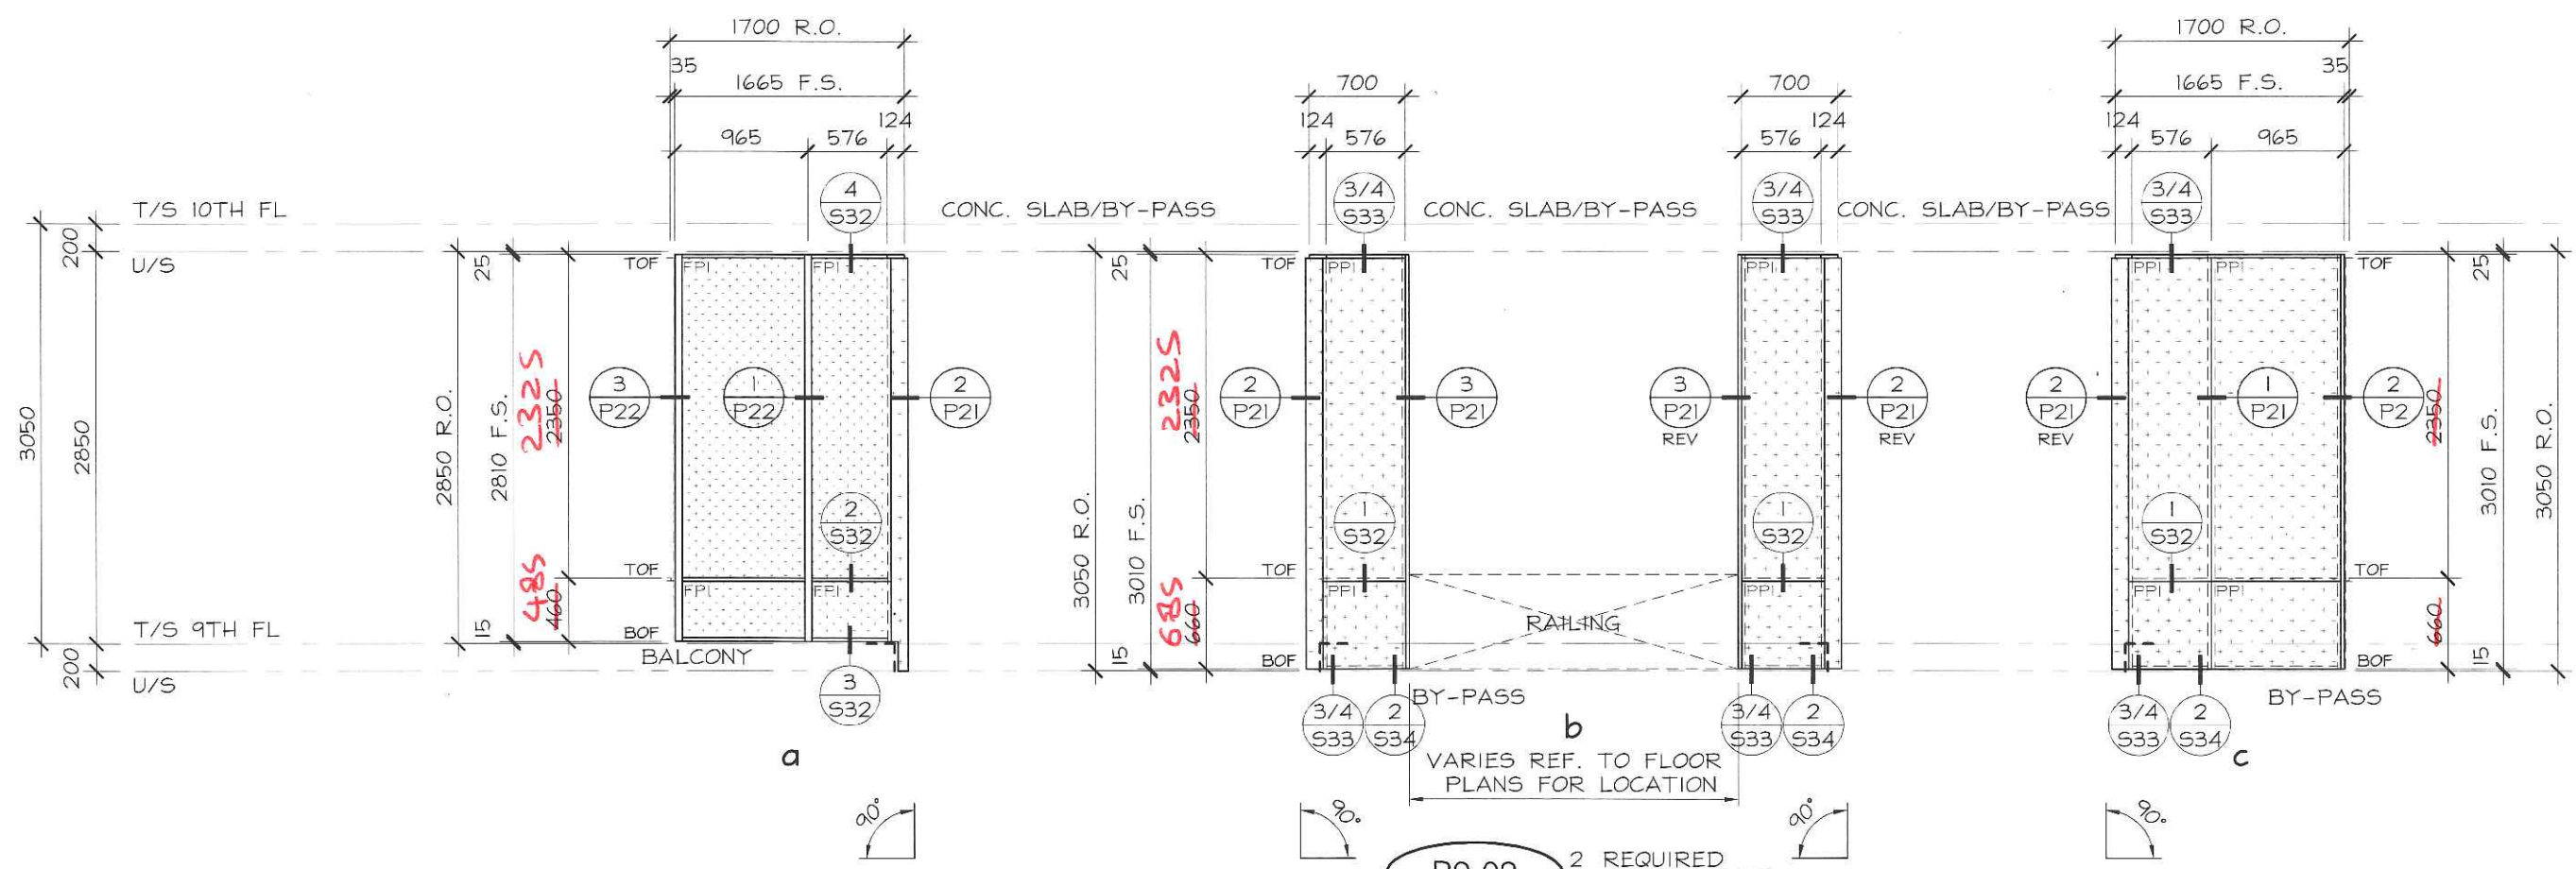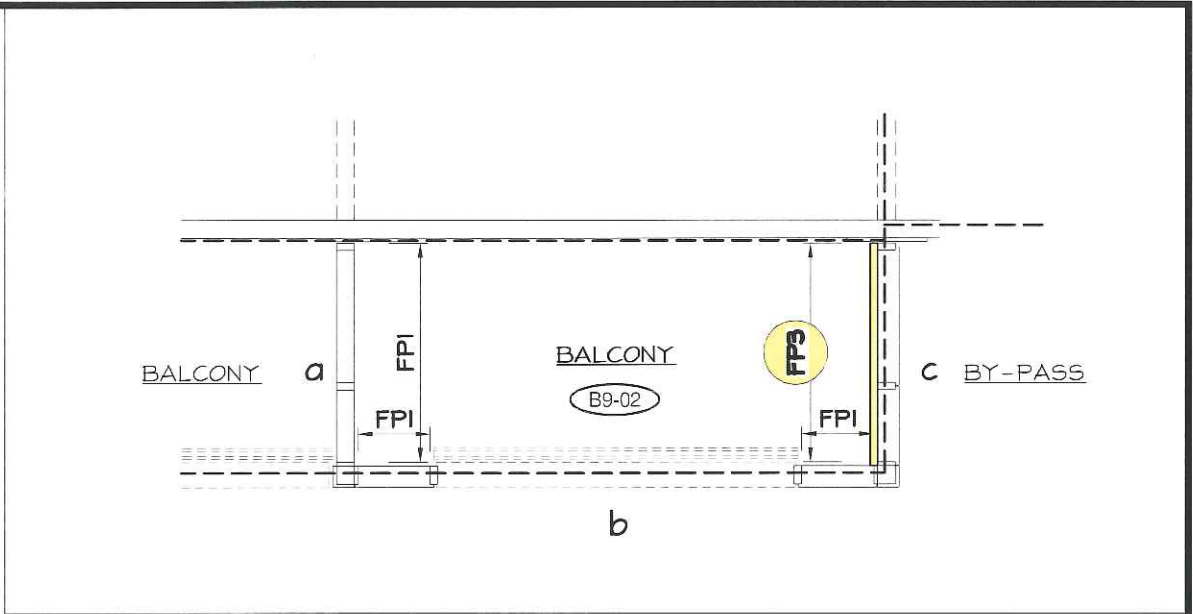



B9-02 2 REQUIRED
 2487 SERIES
 EXT. FINISH: PPG ACRYNAR PLATINUM UCFX11185
 INT. FINISH: PPG ACRYNAR PLATINUM UCFX11185
 INT. FINISH: PPG ACRYNAR T.B.D.

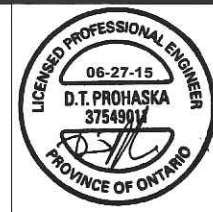

No.	REVISION	BY	DATE


PROJECT NAME:	SQ ALEXANDRA PARK - BLOCK11		
DRAWING TITLE:	9th FLOOR ELEVATIONS		
ARCHITECT:	TEEPLE ARCHITECTS		
CONTRACTOR:	TRIDEL		
SCALE:	1:50	DRAWN BY:	S.C.
DATE:	MARCH 4, 2015		

DRAWING No.:
E9-21

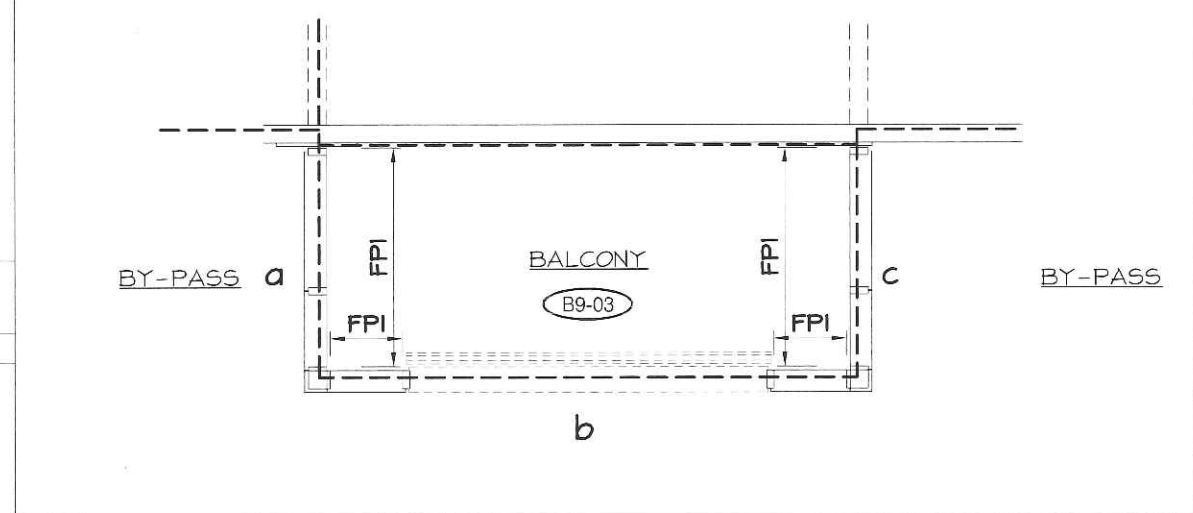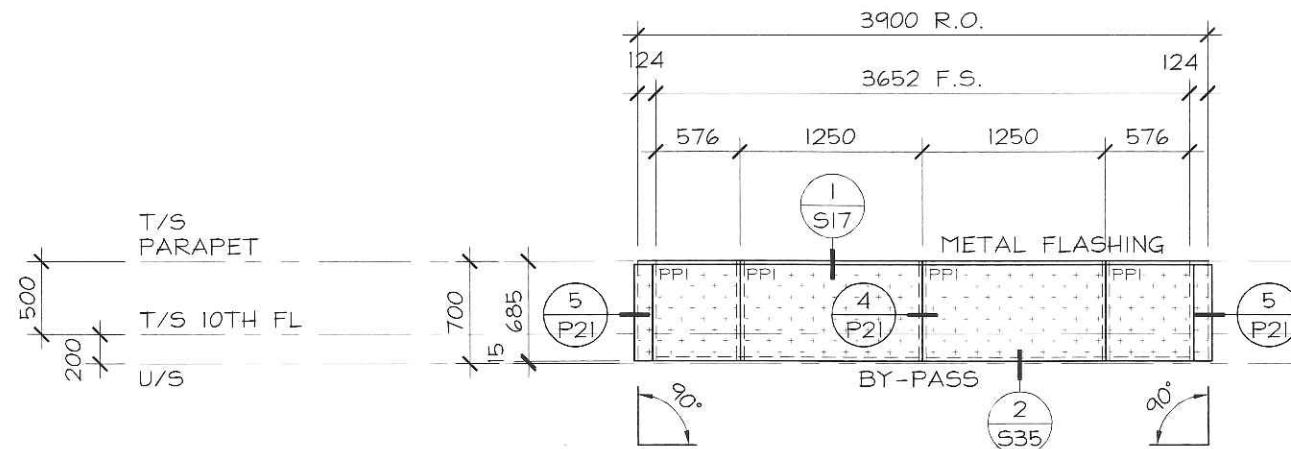


FOR ALUMINUM BALCONY & TERRACE RAILINGS REFER TO TORO ALUMINUM RAILING SHOP DRAWINGS

B9-03X 2 REQUIRED 1/2 FRAME


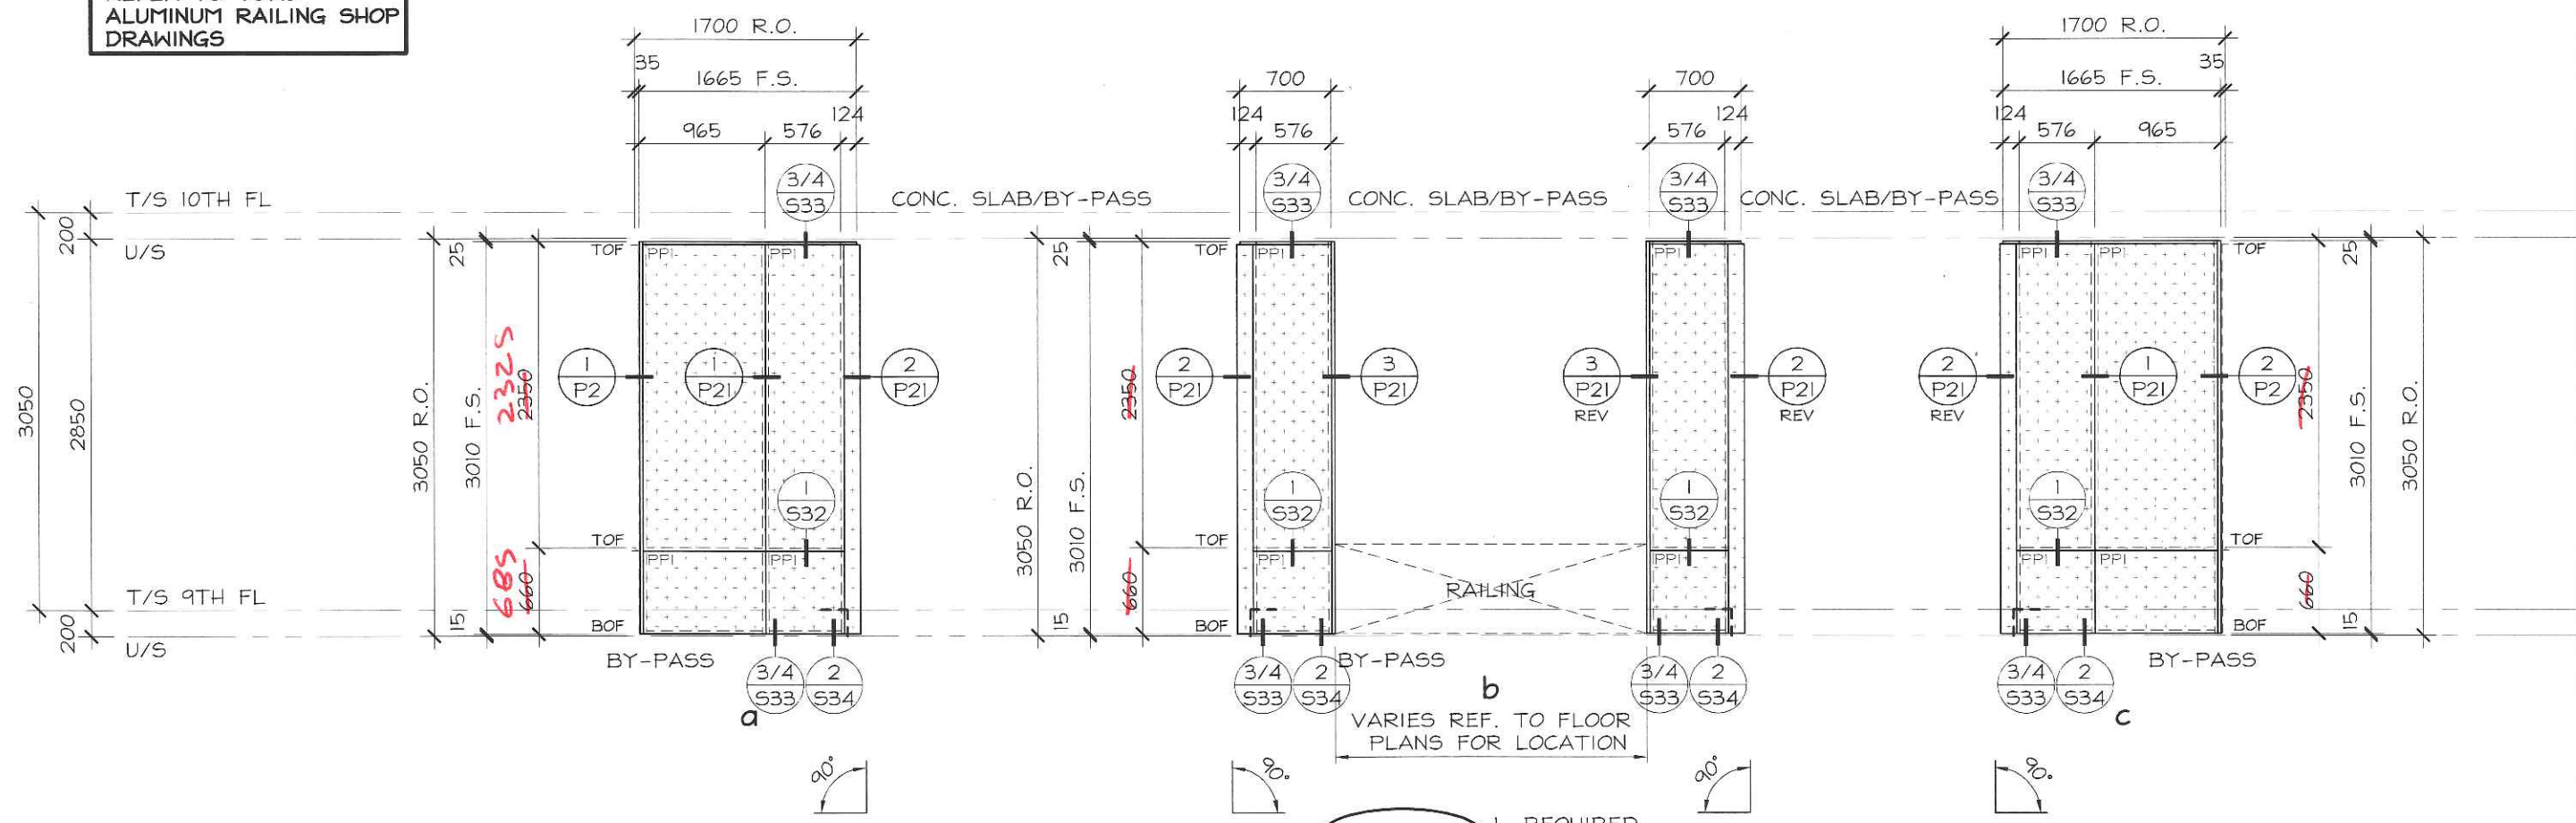


B9-03 1 REQUIRED
2487 SERIES
EXT. FINISH: PPG ACRYNAR PLATINUM UCFXIII85
INT. FINISH: PPG ACRYNAR PLATINUM UCFXIII85

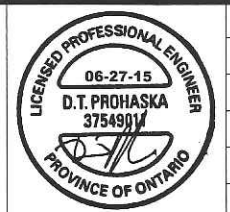

No.	REVISION	BY	DATE


PROJECT NAME:	SQ ALEXANDRA PARK - BLOCK11		
DRAWING TITLE:	9th FLOOR ELEVATIONS		
ARCHITECT:	TEEPLE ARCHITECTS		
CONTRACTOR:	TRIDEL		
SCALE:	1:50	DRAWN BY:	S.C.
DATE:	MARCH 4, 2015		
DRAWING No.:	E9-22		

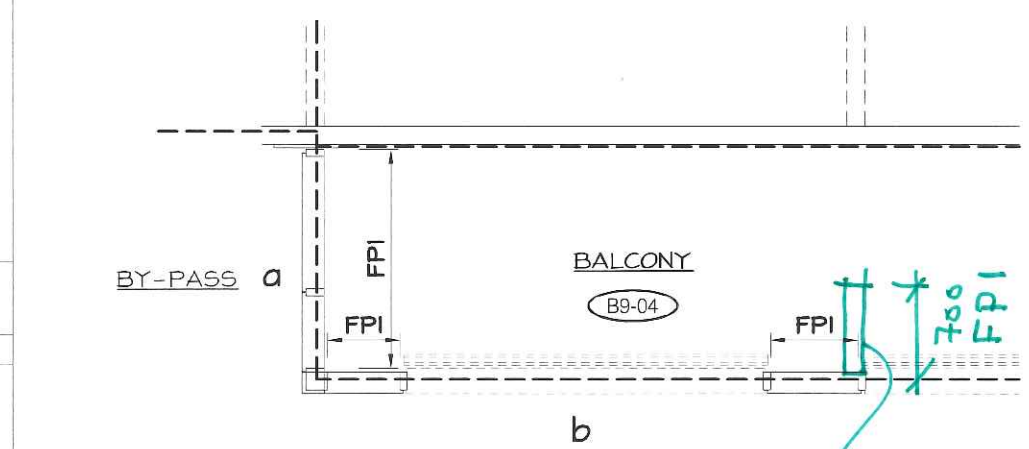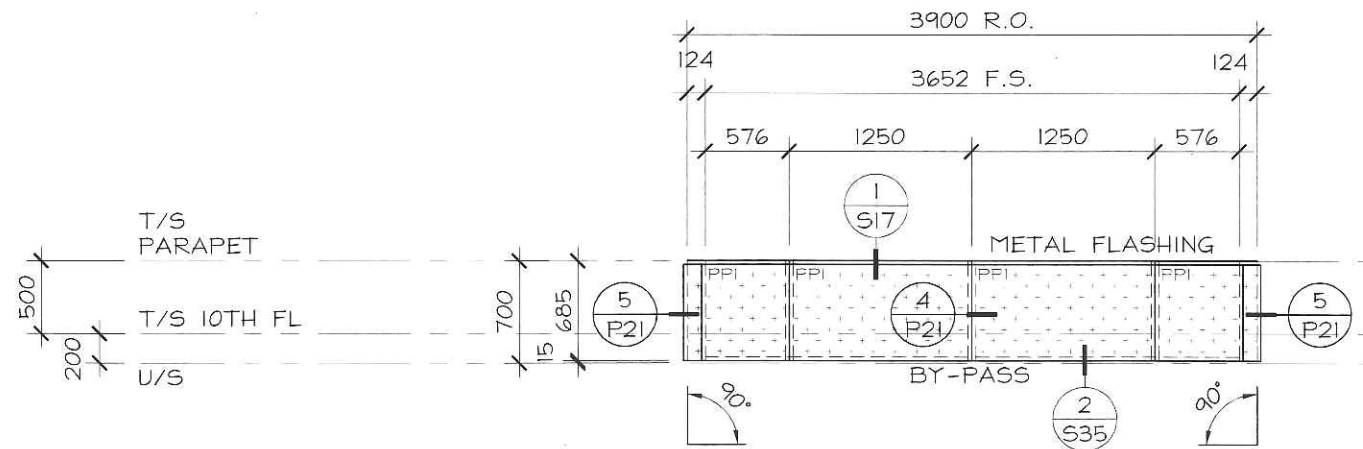


Same C Panel @ E6-04 Dwg. No. E6-21

FOR ALUMINUM BALCONY & TERRACE RAILINGS REFER TO TORO ALUMINUM RAILING SHOP DRAWINGS

B9-04X 2 REQUIRED 1/2 FRAME

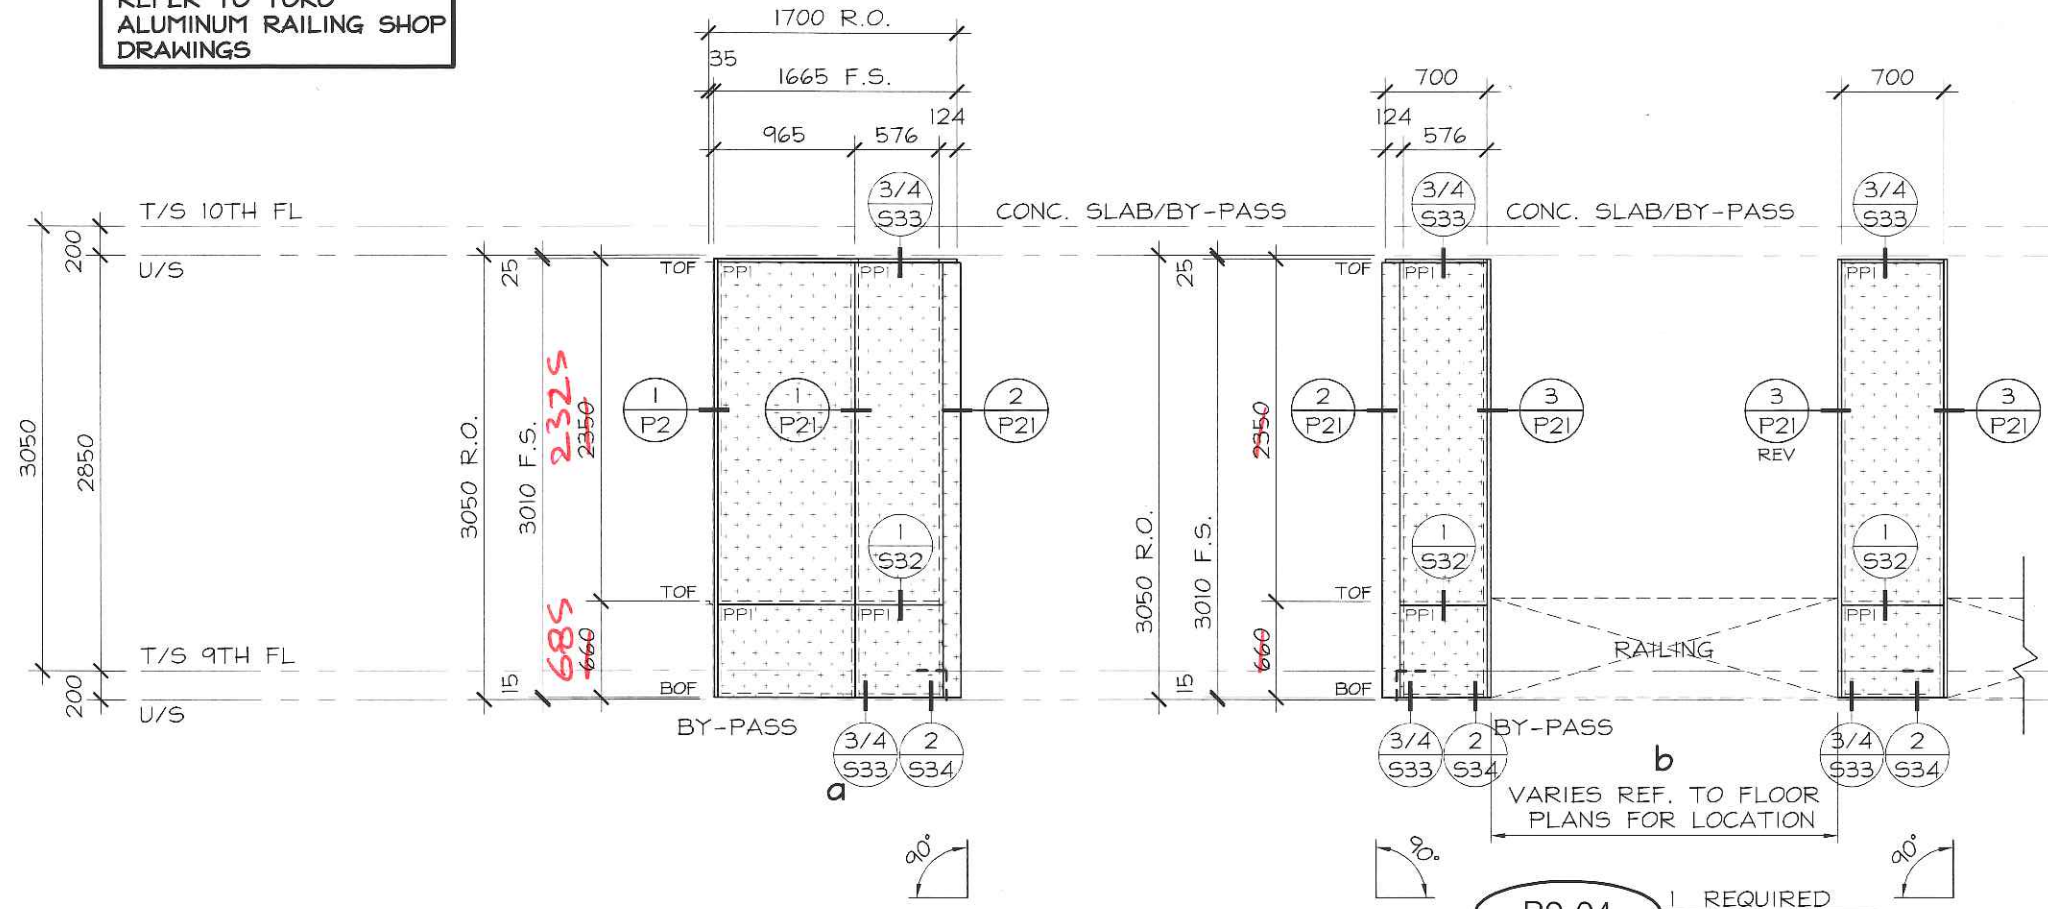



B9-04 1 REQUIRED
 2487 SERIES
 EXT. FINISH: PPG ACRYNAR PLATINUM UCFXIII85
 INT. FINISH: PPG ACRYNAR PLATINUM UCFXIII85

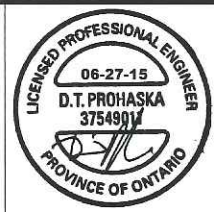

No.	REVISION	BY	DATE

PROJECT NAME:	SQ ALEXANDRA PARK - BLOCK 11		
DRAWING TITLE:	9th FLOOR ELEVATIONS		
ARCHITECT:	TEEPLE ARCHITECTS	DRAWING No.:	E9-23
CONTRACTOR:	TRIDEL	SCALE: 1:50	
SCALE:	1:50	DRAWN BY:	S.C.
DATE:	MARCH 4, 2015		

FOR ALUMINUM BALCONY
 & TERRACE RAILINGS
 REFER TO TORO
 ALUMINUM RAILING SHOP
 DRAWINGS

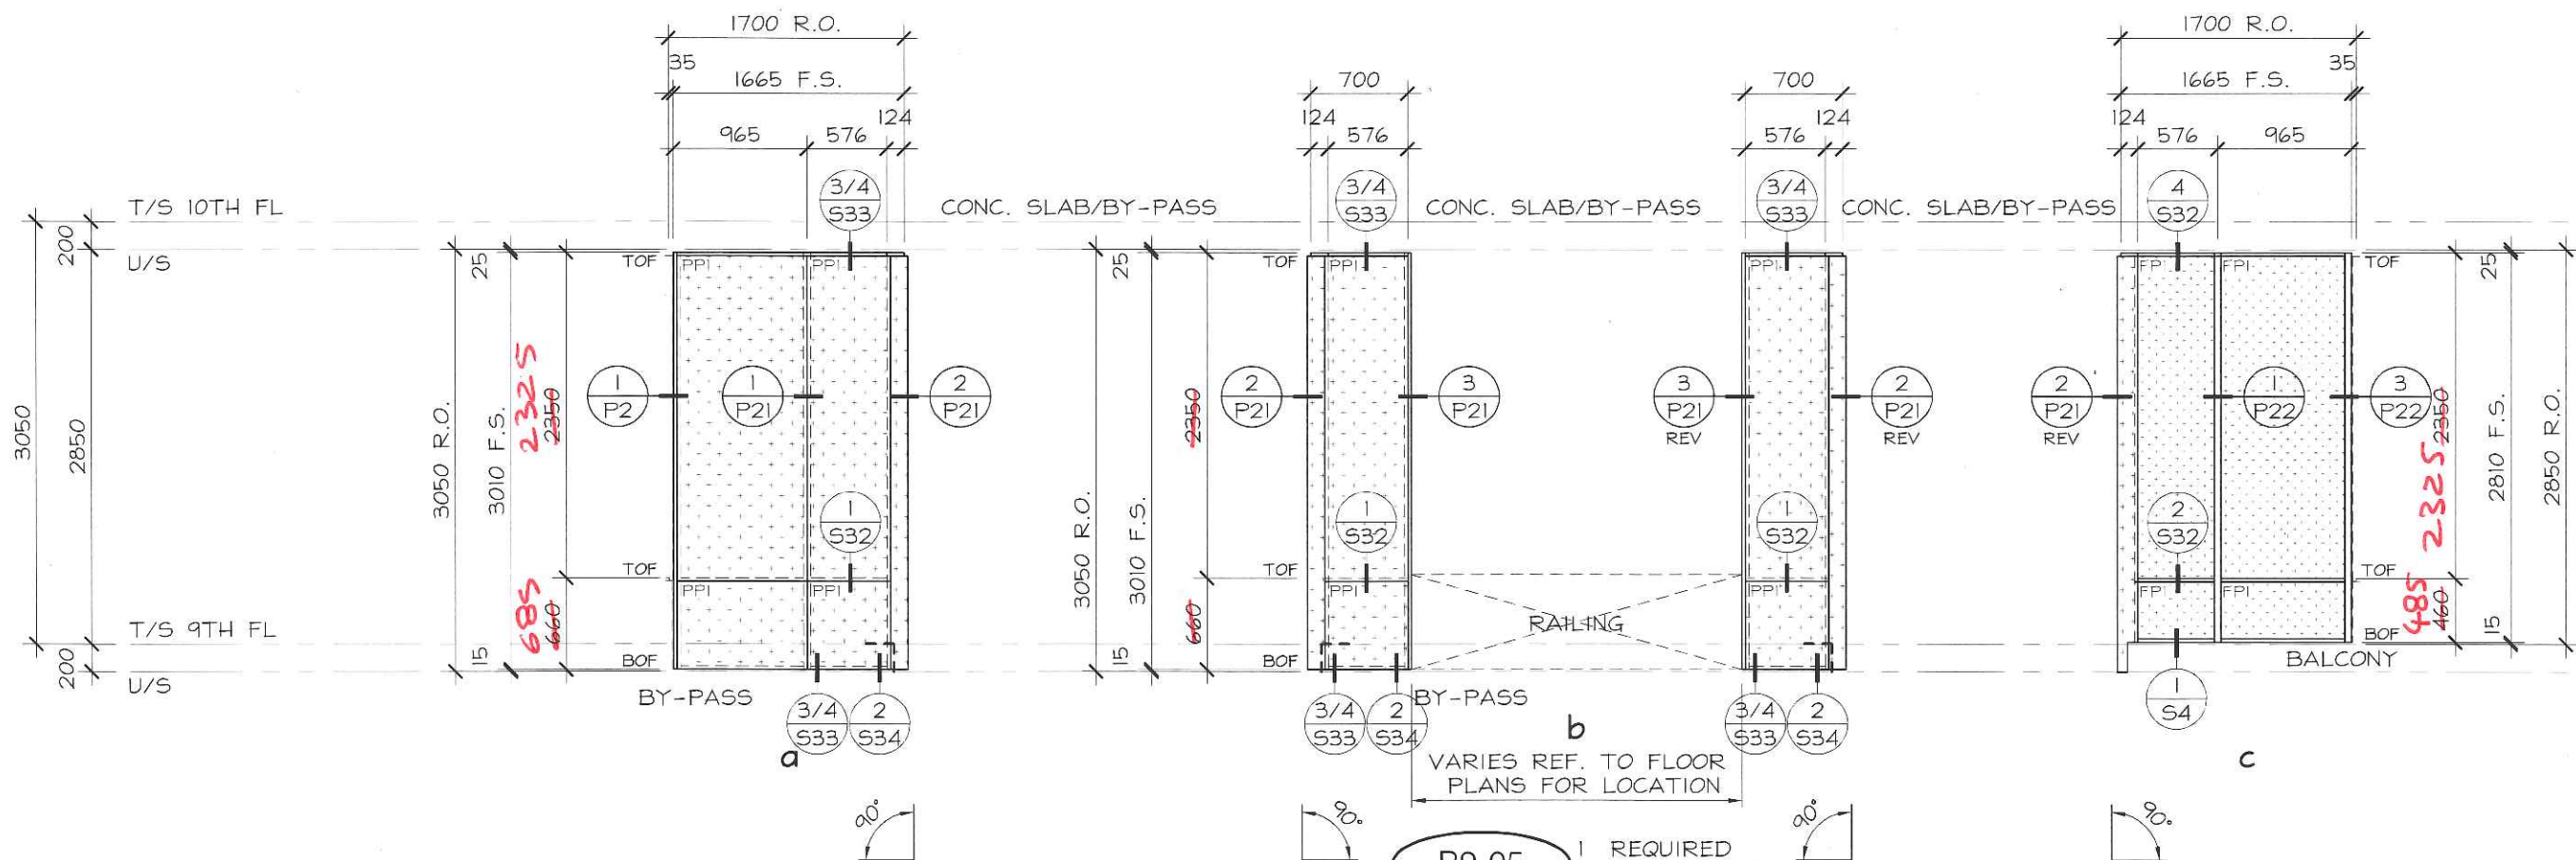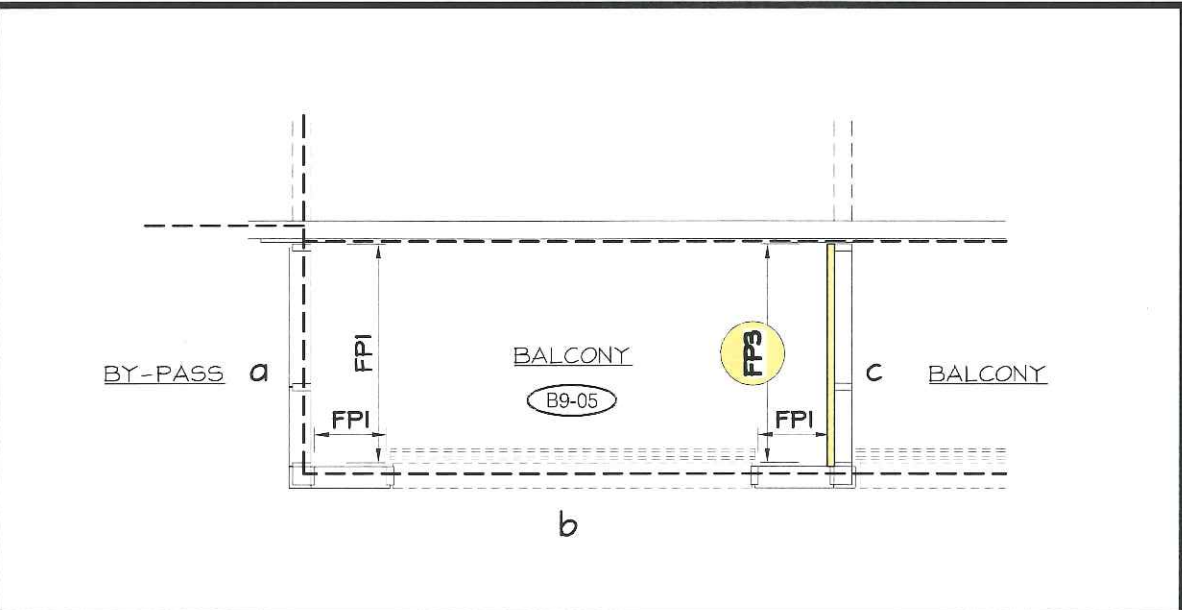



B9-05 1 REQUIRED
 2487 SERIES
 EXT. FINISH: PPG ACRYNAR PLATINUM UCFX11185
 INT. FINISH: PPG ACRYNAR PLATINUM UCFX11185
 C INT. FINISH: PPG ACRYNAR T.B.D.



No.	REVISION	BY	DATE

PROJECT NAME:	SQ ALEXANDRA PARK - BLOCK11		
DRAWING TITLE:	9th FLOOR ELEVATIONS		
ARCHITECT:	TEEPLE ARCHITECTS		DRAWING No.:
CONTRACTOR:	TRIDEL		E9-24
SCALE:	1:50	DRAWN BY:	S.C.
DATE:	MARCH 4, 2015		

FOR ALUMINUM BALCONY
& TERRACE RAILINGS
REFER TO TORO
ALUMINUM RAILING SHOP
DRAWINGS

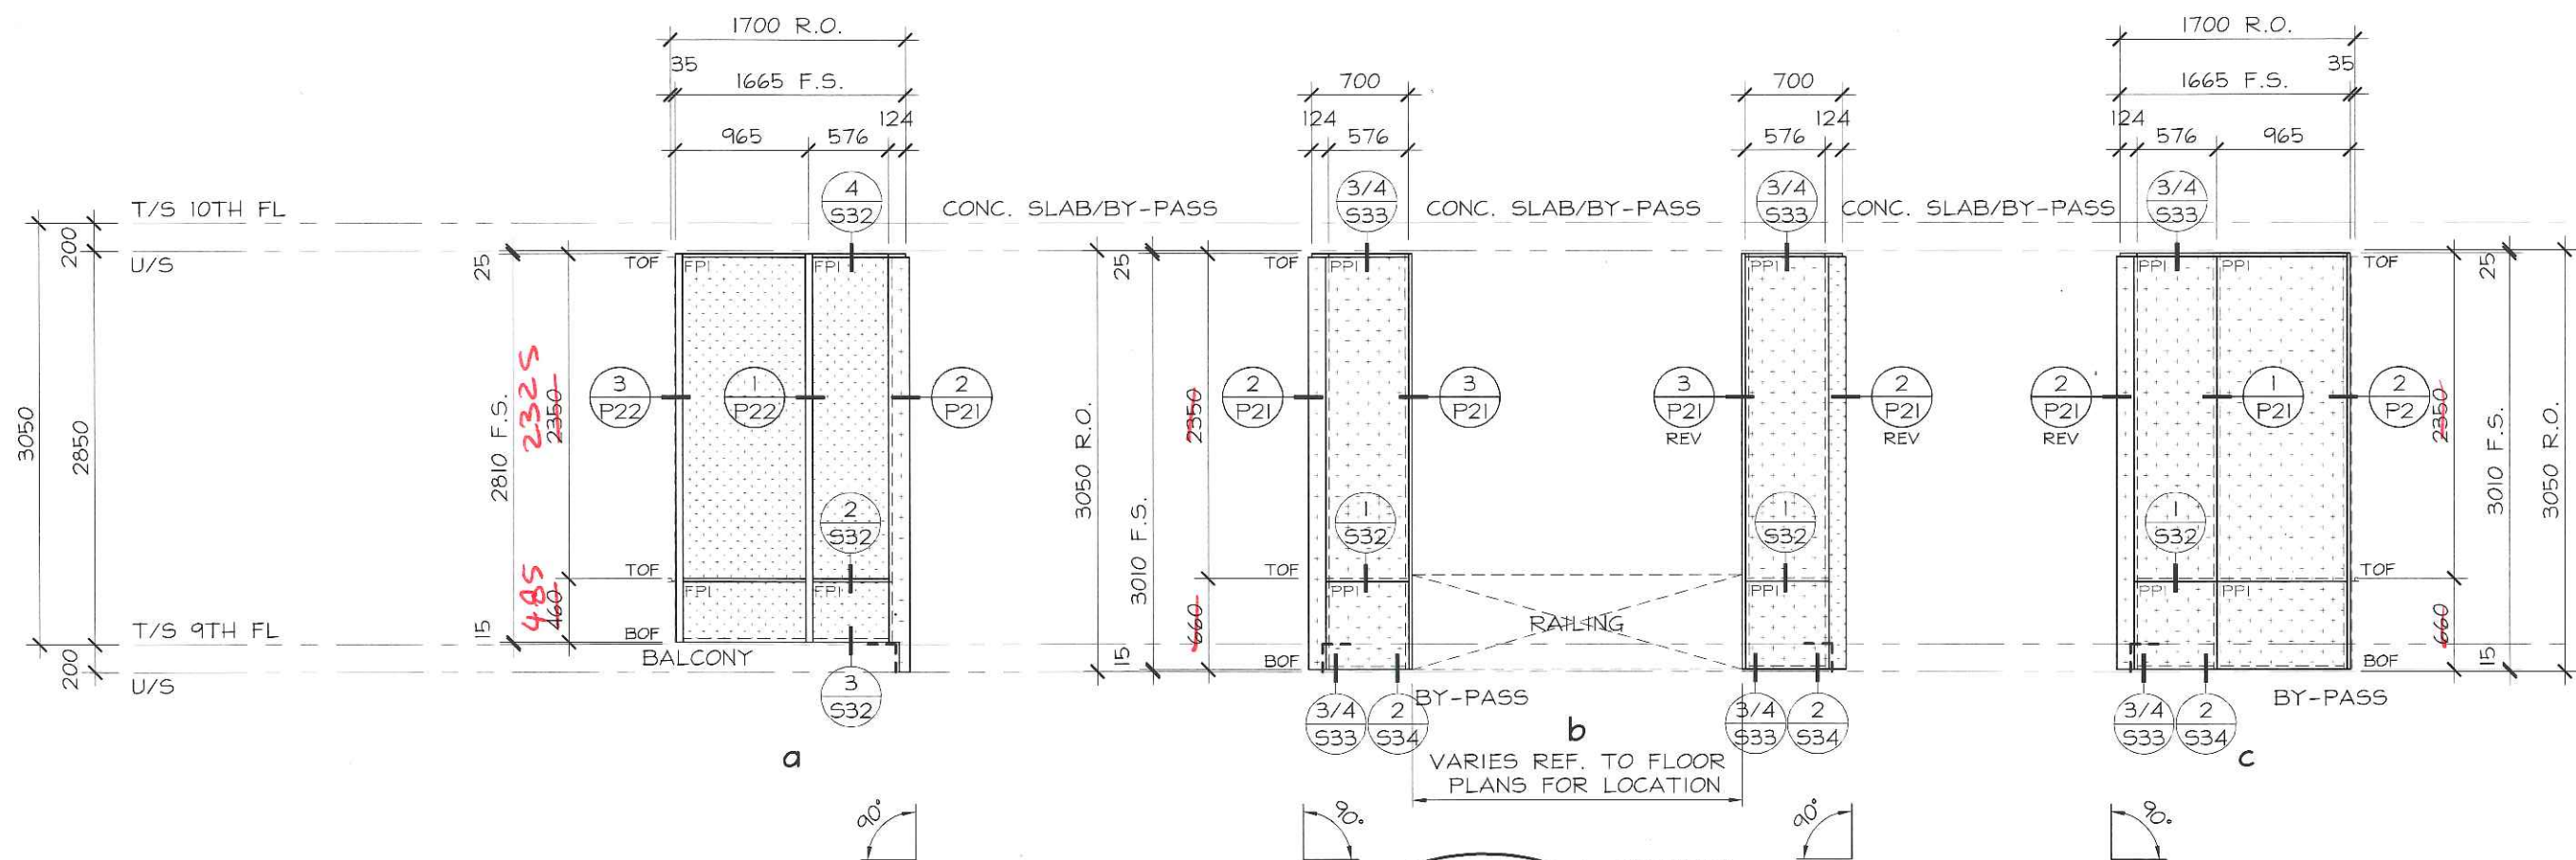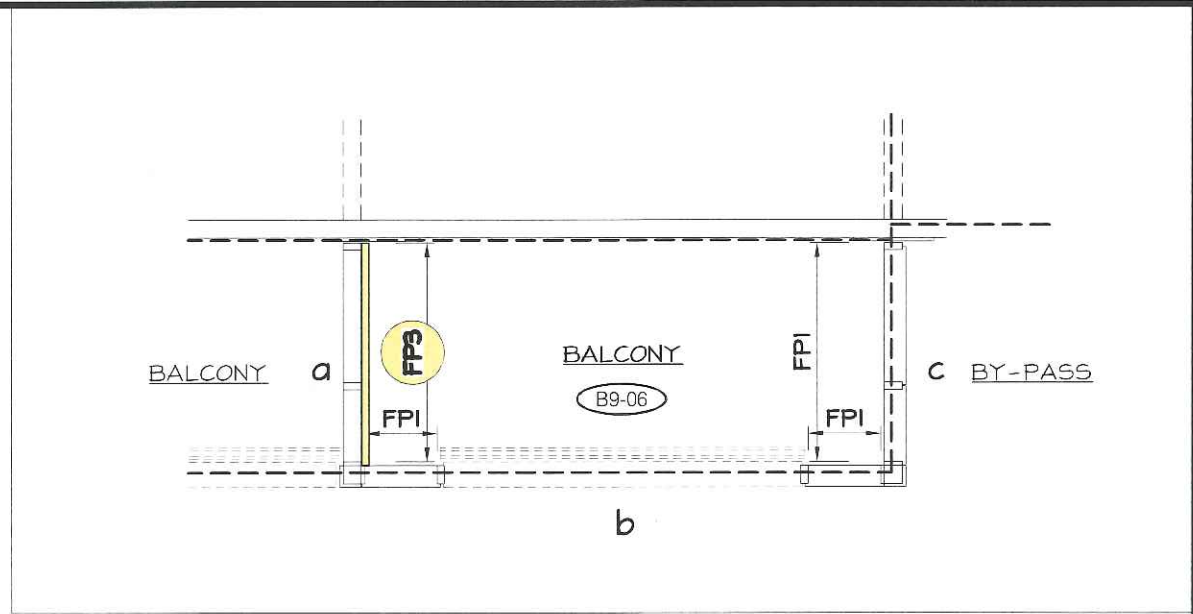



B9-06 1 REQUIRED
2487 SERIES
EXT. FINISH: PPG ACRYNAR PLATINUM UCFX11185
INT. FINISH: PPG ACRYNAR PLATINUM UCFX11185
a INT. FINISH: PPG ACRYNAR T.B.D.



No.	REVISION	BY	DATE

PROJECT NAME: SQ ALEXANDRA PARK - BLOCK11		DRAWING No.: E9-25
DRAWING TITLE: 9th FLOOR ELEVATIONS		
ARCHITECT: TEEPLE ARCHITECTS		DATE: MARCH 4, 2015
CONTRACTOR: TRIDEL		
SCALE: 1:50	DRAWN BY: S.C.	

FOR ALUMINUM BALCONY
 & TERRACE RAILINGS
 REFER TO TORO
 ALUMINUM RAILING SHOP
 DRAWINGS

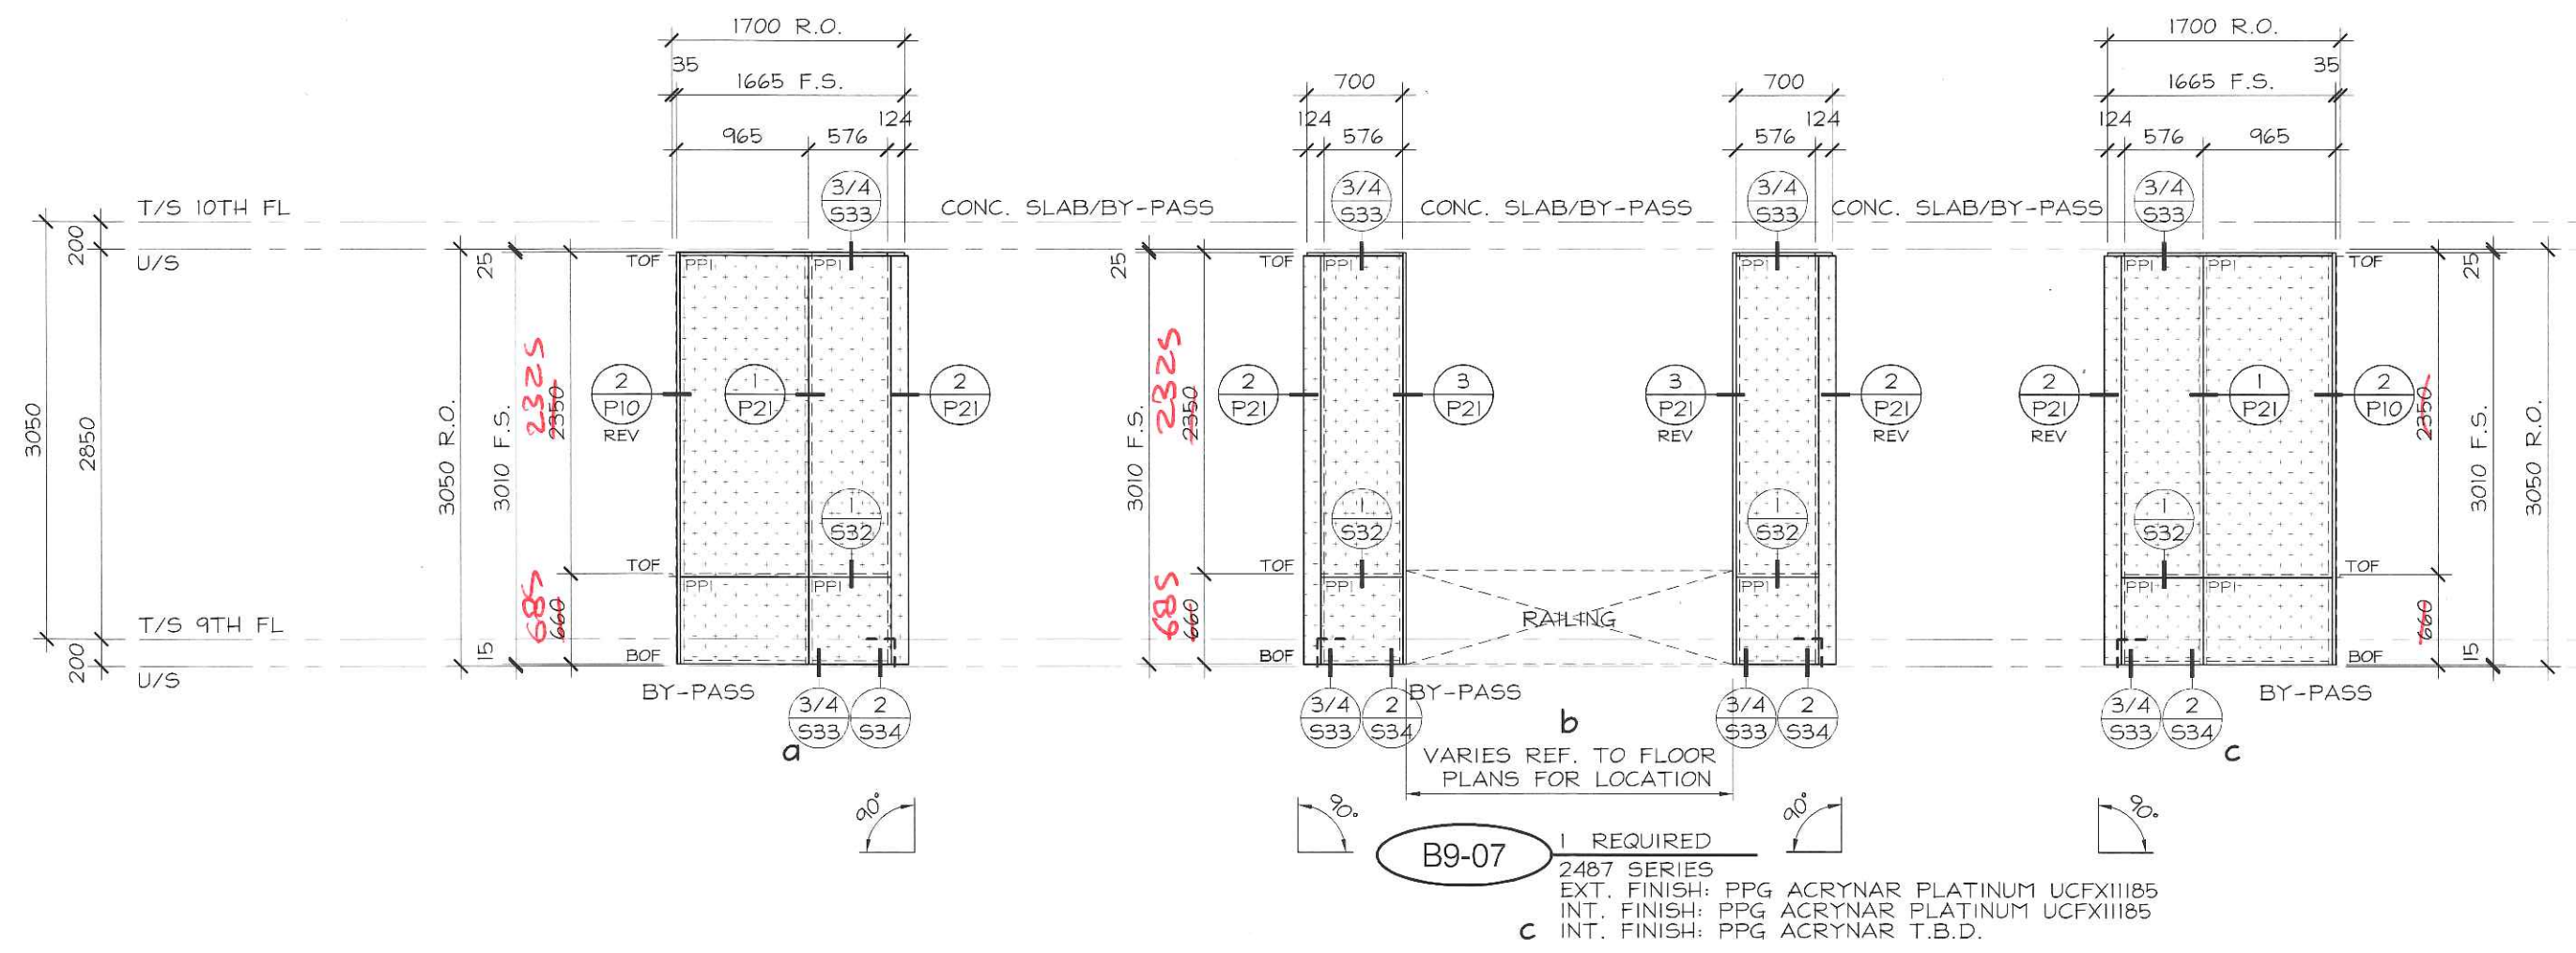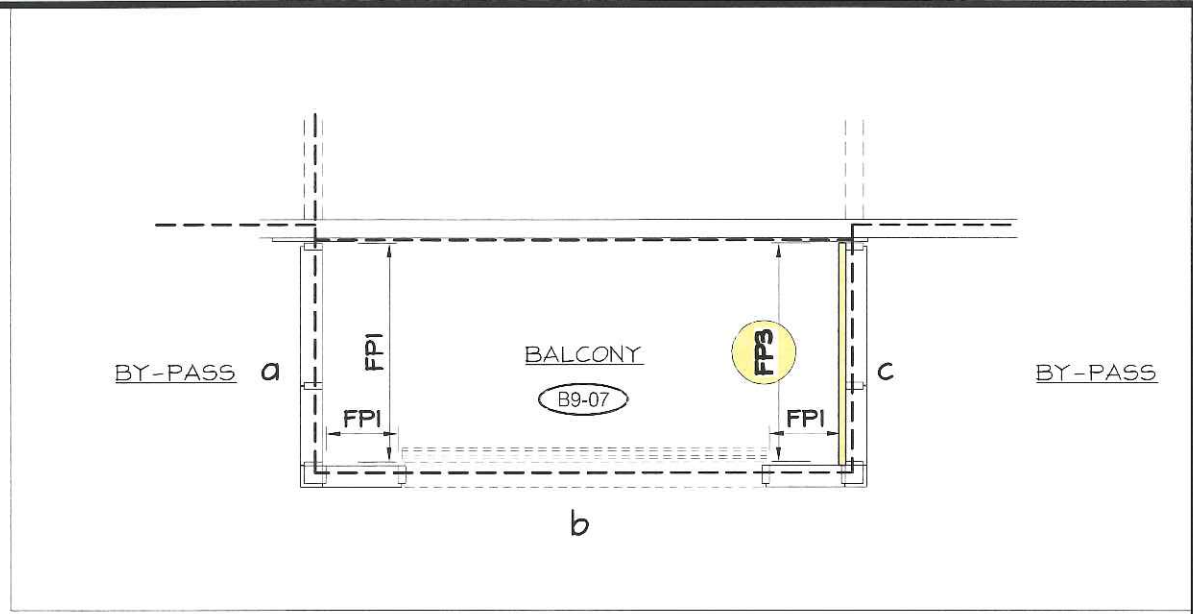

No.	REVISION	BY	DATE

PROJECT NAME:	SQ ALEXANDRA PARK - BLOCK11		
DRAWING TITLE:	9th FLOOR ELEVATIONS		
ARCHITECT:	TEEPLE ARCHITECTS		
CONTRACTOR:	TRIDEL		
SCALE:	1:50	DRAWN BY:	S.C.
DATE:	MARCH 4, 2015		
DRAWING No.:			E9-26