

Teeple Architects INC.

Reviewed

Reviewed as noted

Revise and resubmit

Not Reviewed

Date:


Aug 2/15

Reviewed by:


MS/AMM

This review by Teeple Architects Inc. is for the sole purpose of ascertaining conformance with the general design concept. This review shall not mean that Teeple Architects Inc. approves the detailed design inherent in the shop drawings, responsibility for which shall remain with the Contractor submitting same, and such review shall not relieve the Contractor of the responsibility for errors or omissions in the shop drawings or of the responsibility for meeting all requirements of the Contract Documents. The Contractor is responsible for dimensions to be confirmed and correlated at the job site, for information that pertains solely to fabrication processes or to techniques of construction and installation, and for coordination of the work of all trades.

Package 12 - Level 11.

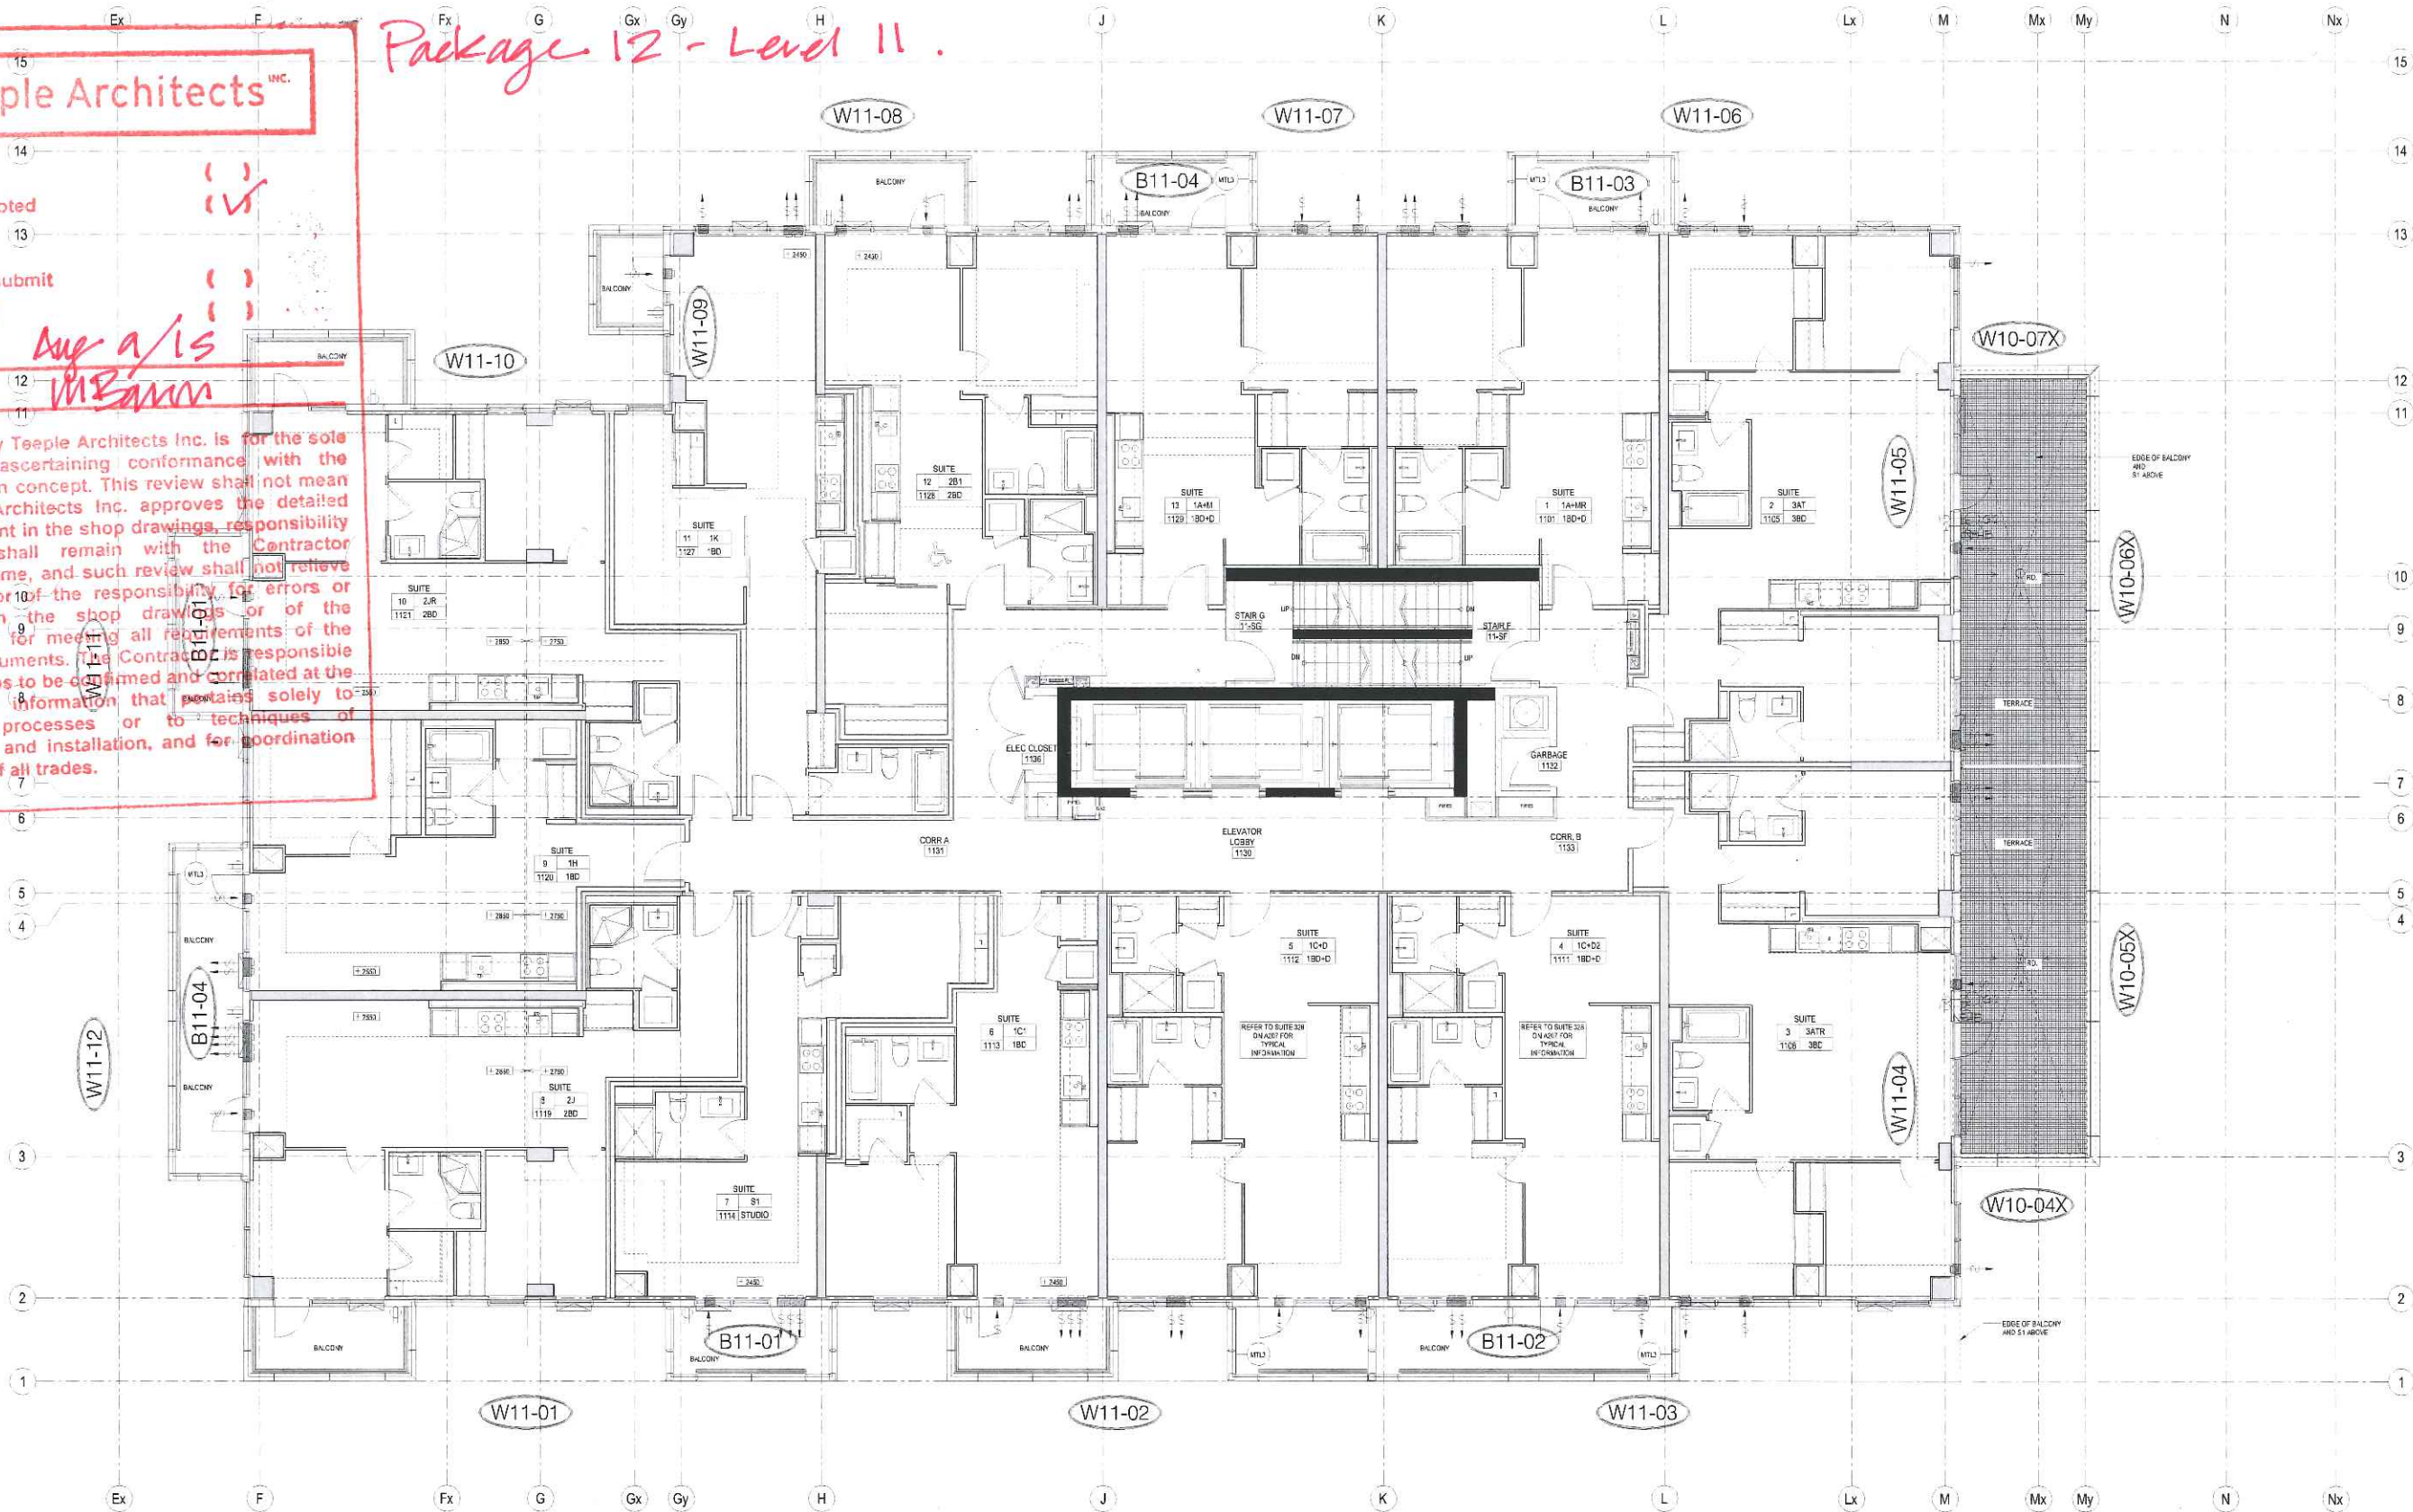


PROJECT NAME: SQ ALEXANDRA PARK - BLOCK 11		DRAWING NO: F11	
DRAWING TITLE: 11th FLOOR PLAN		DRAWN BY: S.C.	
ARCHITECT: TEEPLE ARCHITECTS		DATE: MARCH 4, 2015	
CONTRACTOR: TRIDEL		SCALE: N/T/S	
NO.	REVISION	BY	DATE

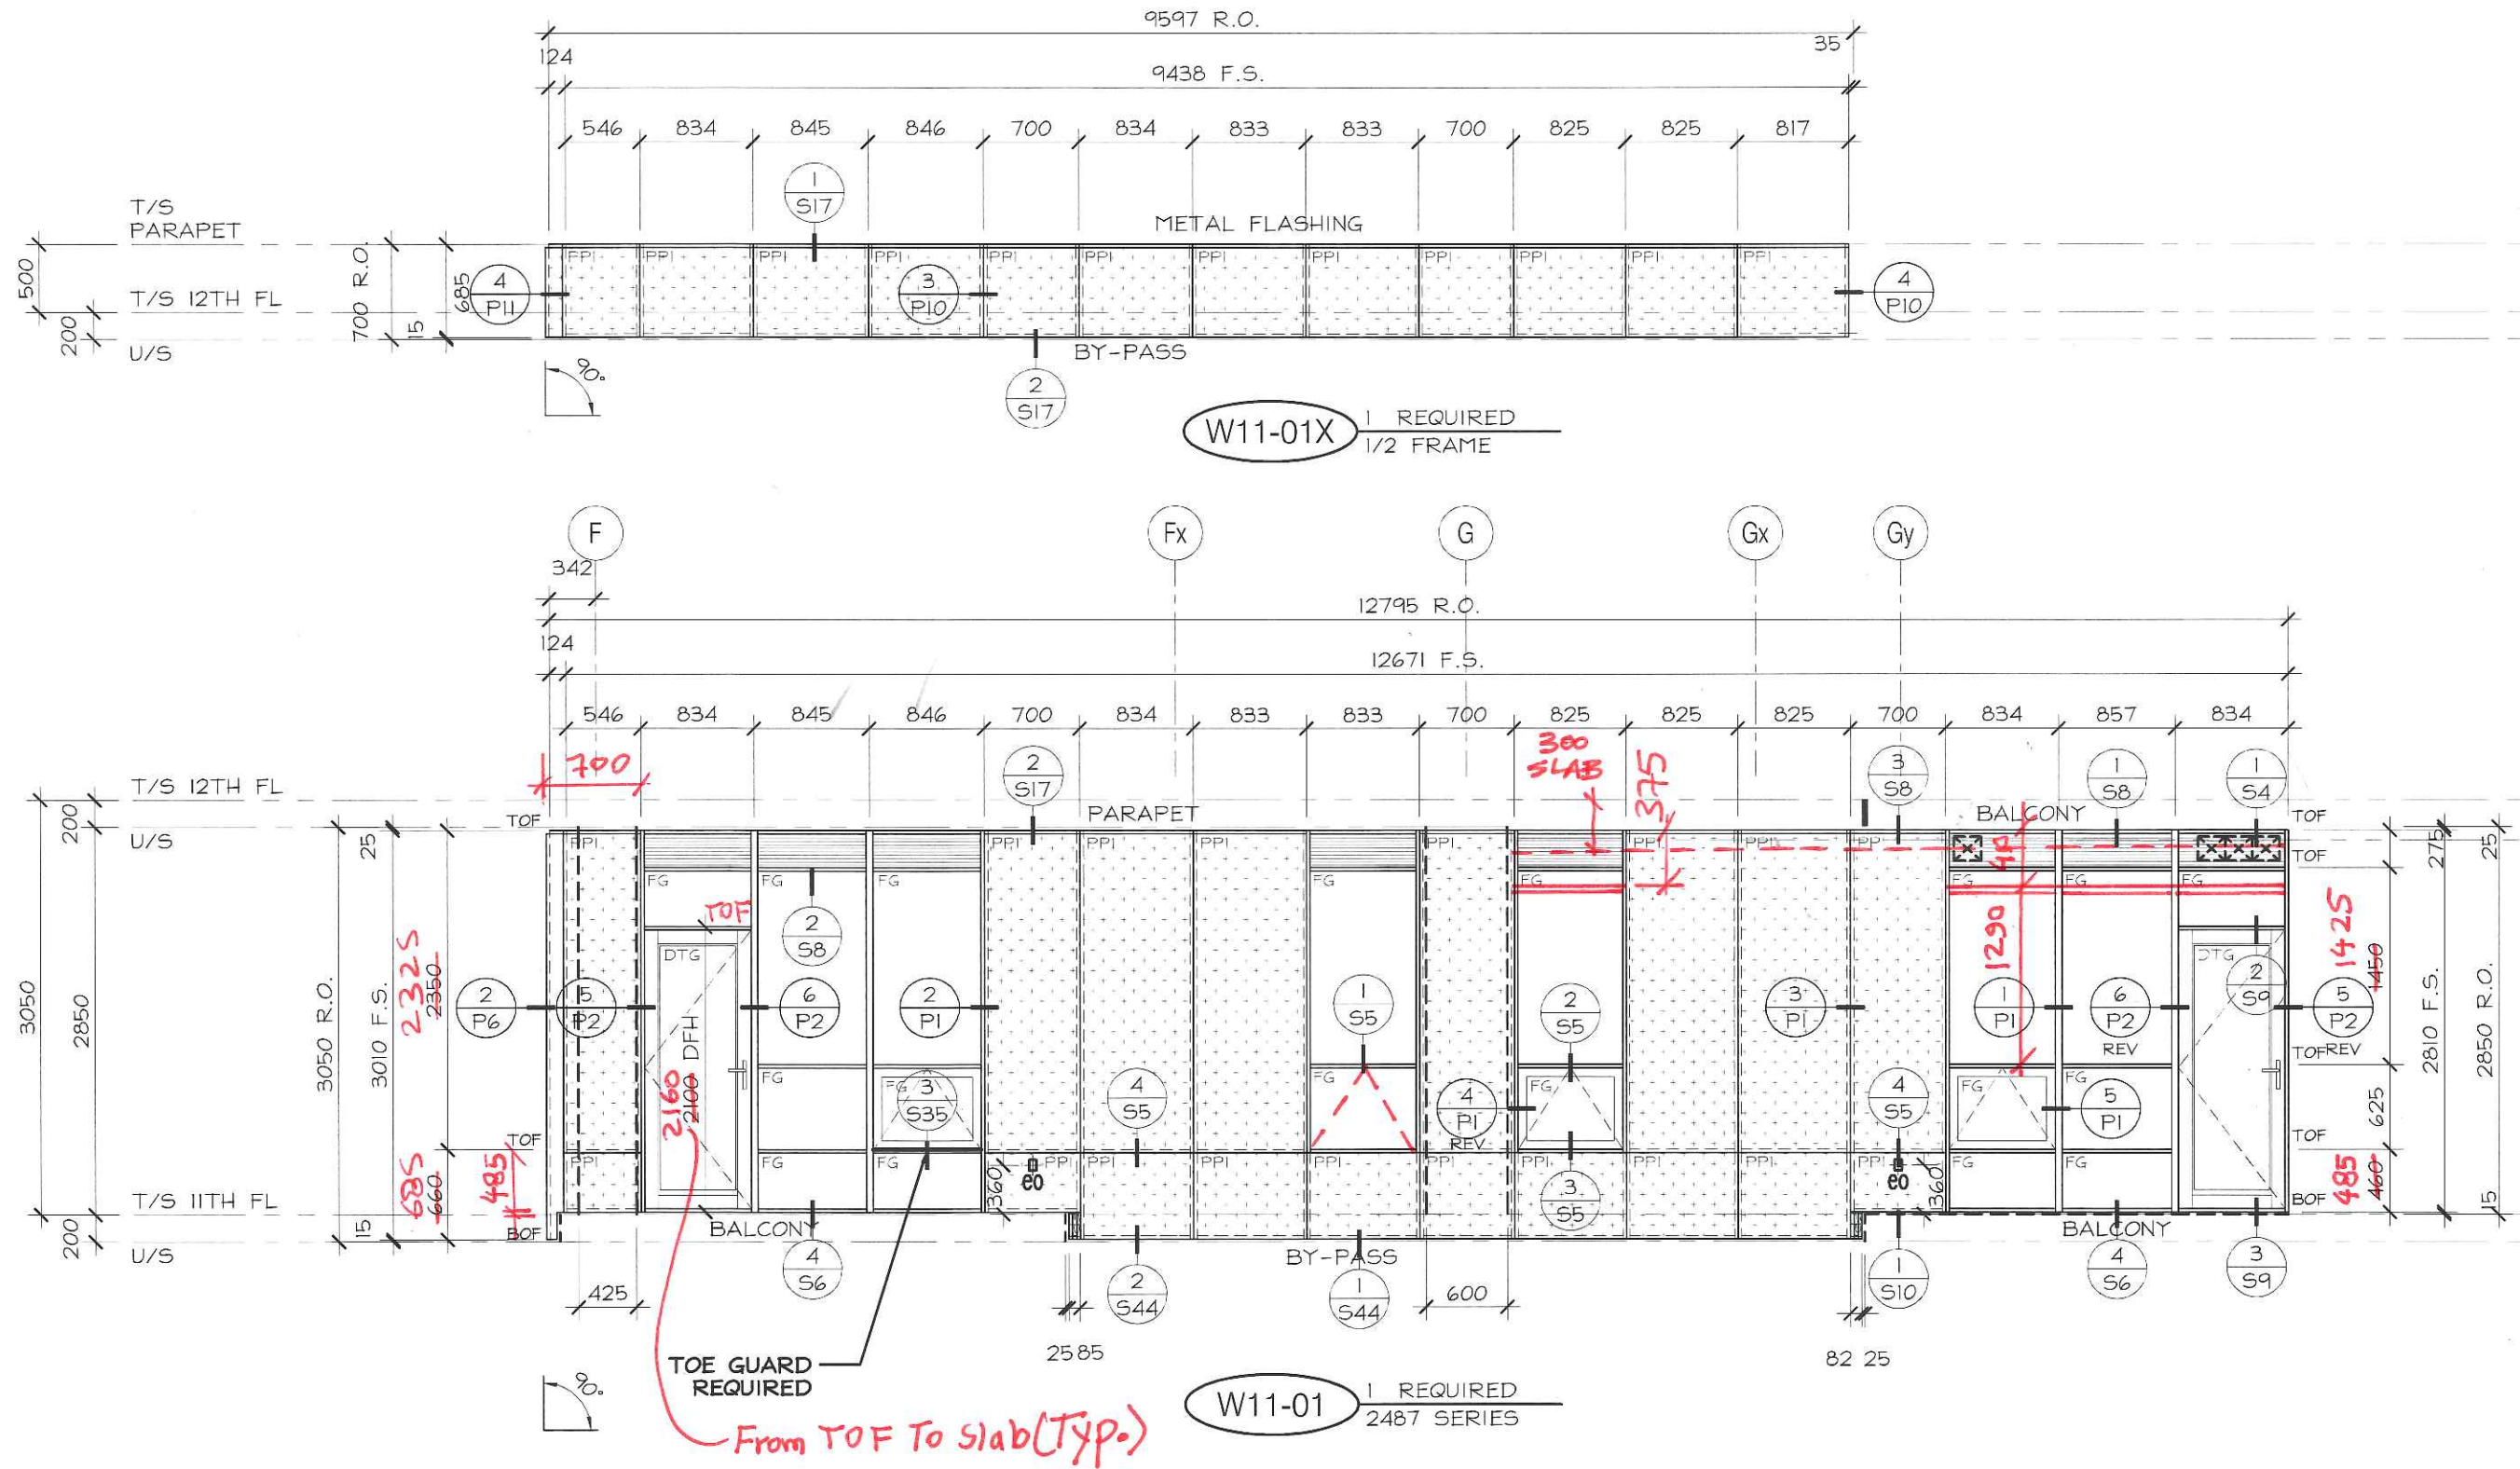

No.	REVISION	BY	DATE

PROJECT NAME:	SQ ALEXANDRA PARK - BLOCK11		
DRAWING TITLE:	11th FLOOR ELEVATIONS		
ARCHITECT:	TEEPLE ARCHITECTS		
CONTRACTOR:	TRIDEL		
SCALE:	1:50	DRAWN BY:	S.C.
DATE:	MARCH 4, 2015		


DRAWING No.:
E11-1

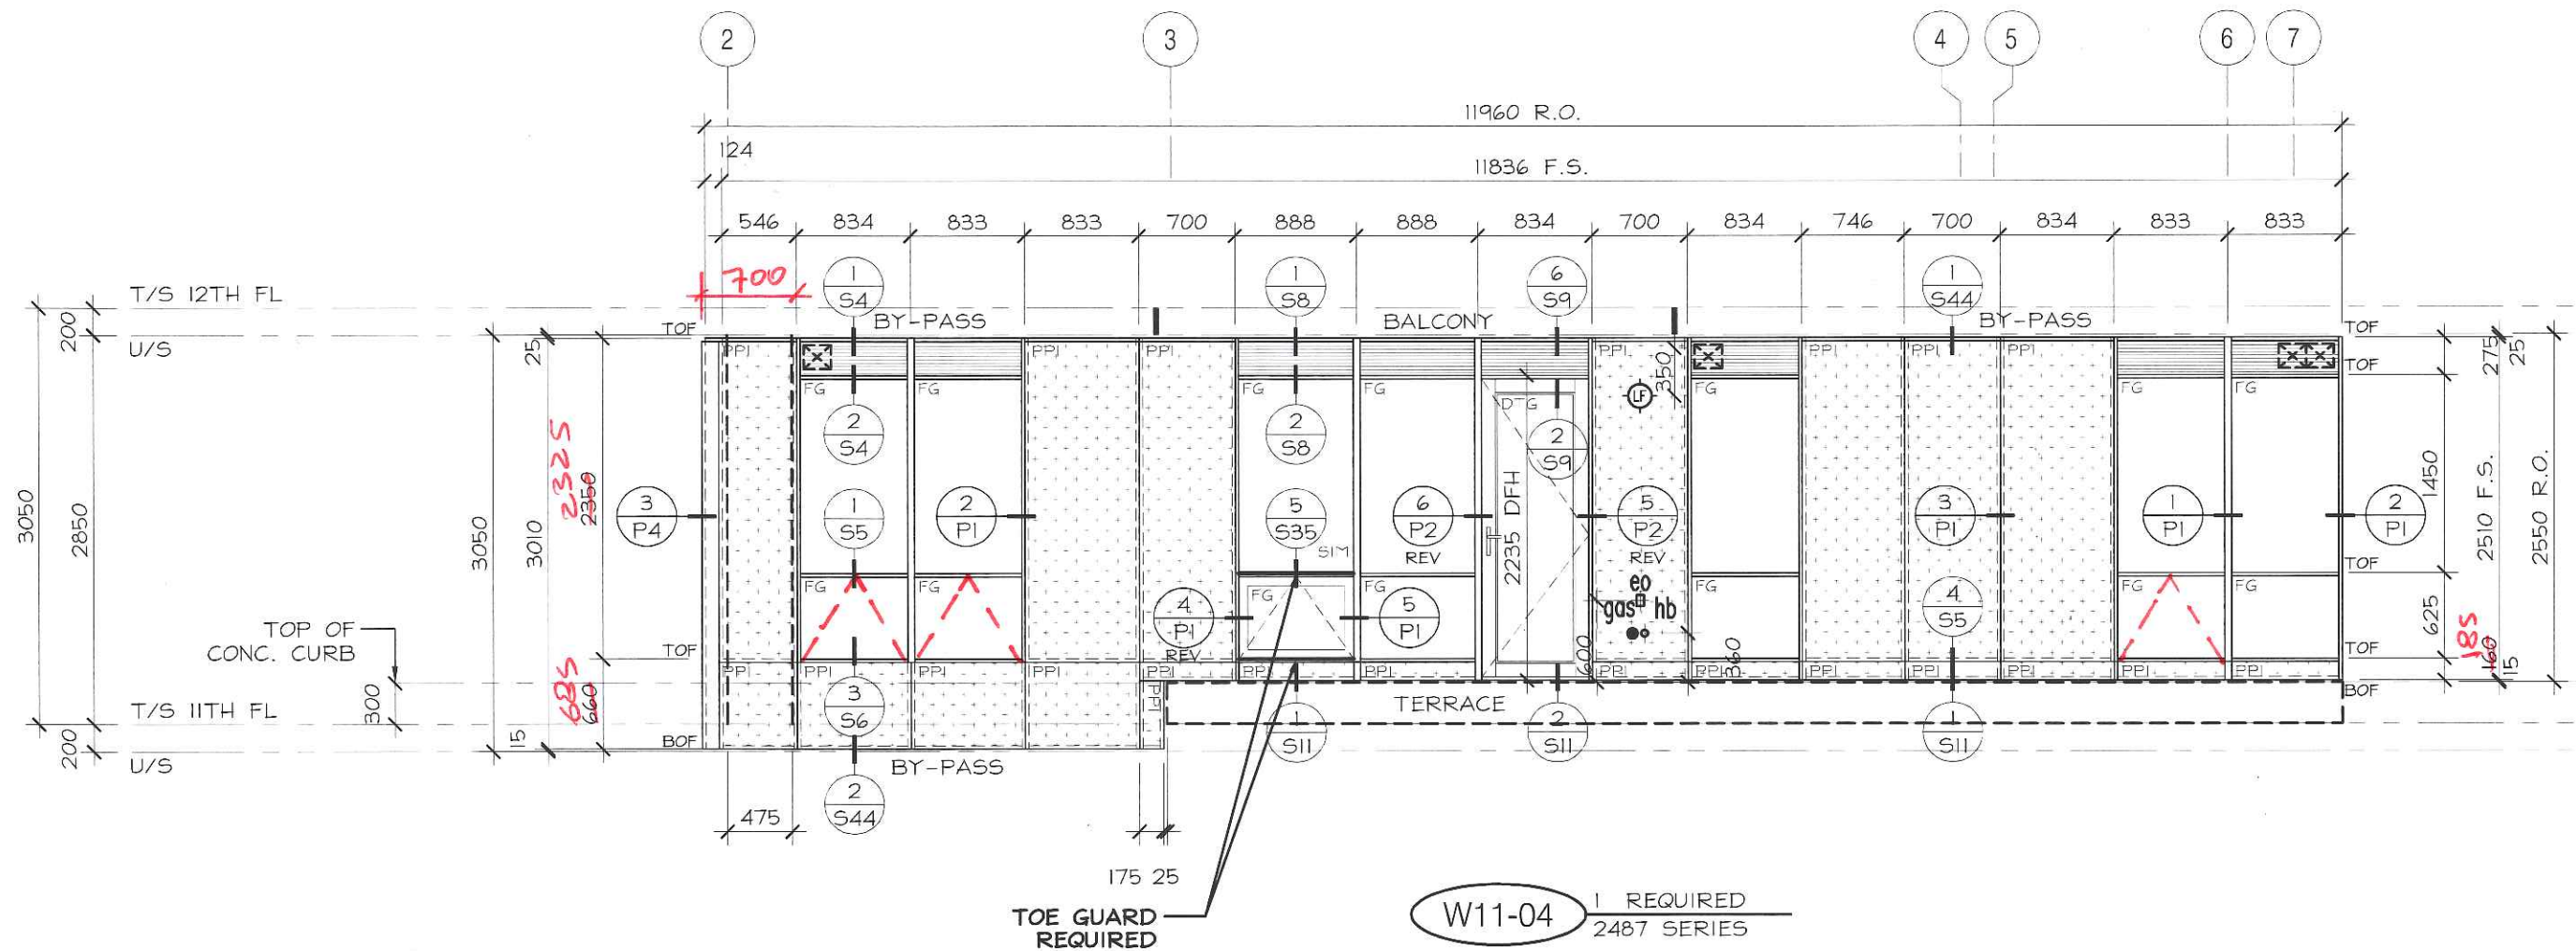

No.	REVISION	BY	DATE



PROJECT NAME: SQ ALEXANDRA PARK - BLOCK 11
 DRAWING TITLE: 11th FLOOR ELEVATIONS
 ARCHITECT: TEEPLE ARCHITECTS
 CONTRACTOR: TRIDEL
 SCALE: 1:50
 DRAWN BY: S.C.
 DATE: MARCH 4, 2015

DRAWING No.: E11-4

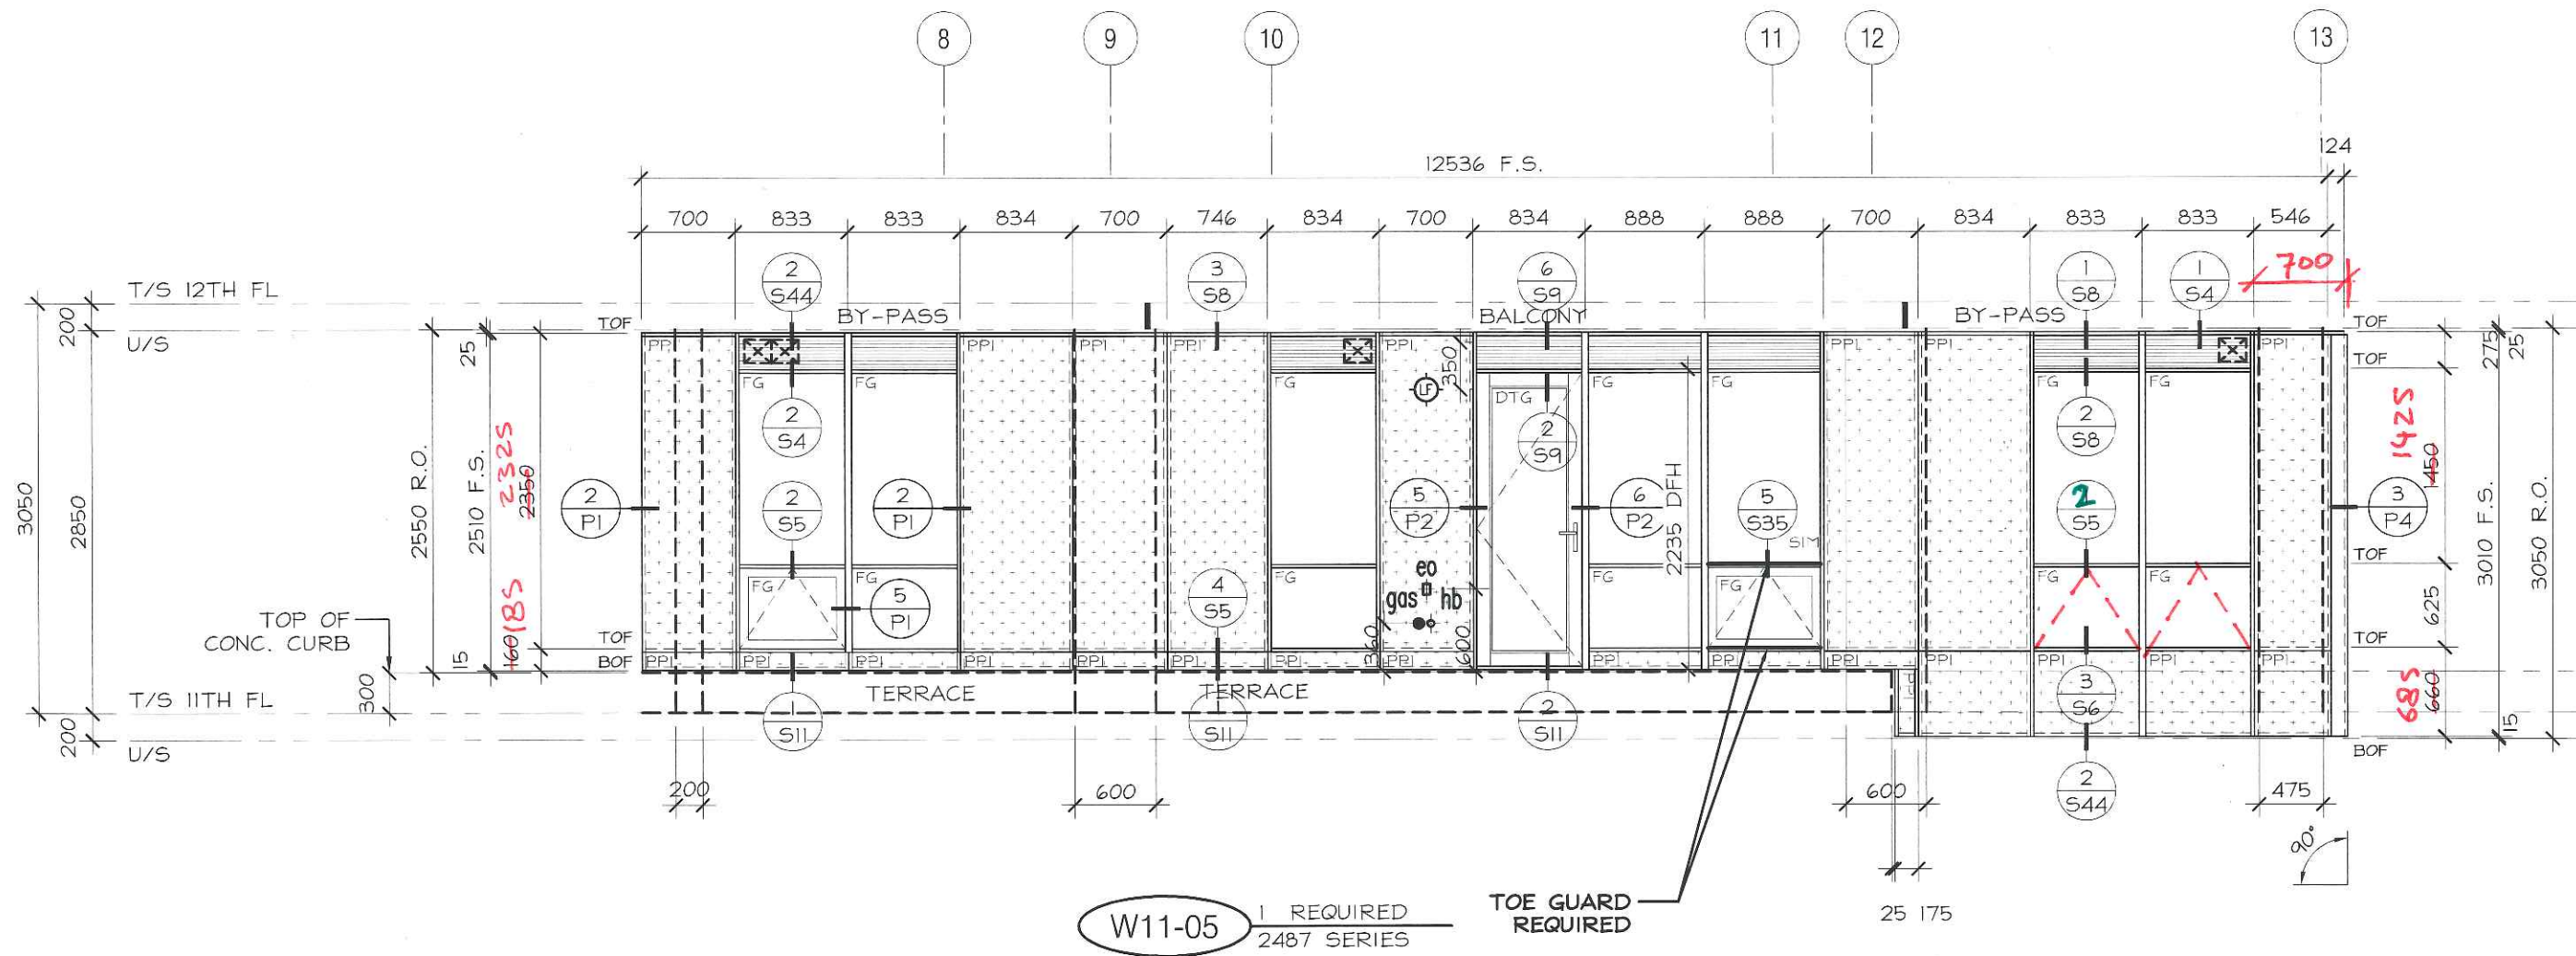


No.	REVISION	BY	DATE

PROJECT NAME: SQ ALEXANDRA PARK - BLOCK 11		DRAWING No.: E11-5
DRAWING TITLE: 11th FLOOR ELEVATIONS		
ARCHITECT: TEEPLE ARCHITECTS		DRAWN BY: S.C.
CONTRACTOR: TRIDEL		
SCALE: 1:50	DATE: MARCH 4, 2015	

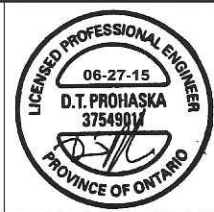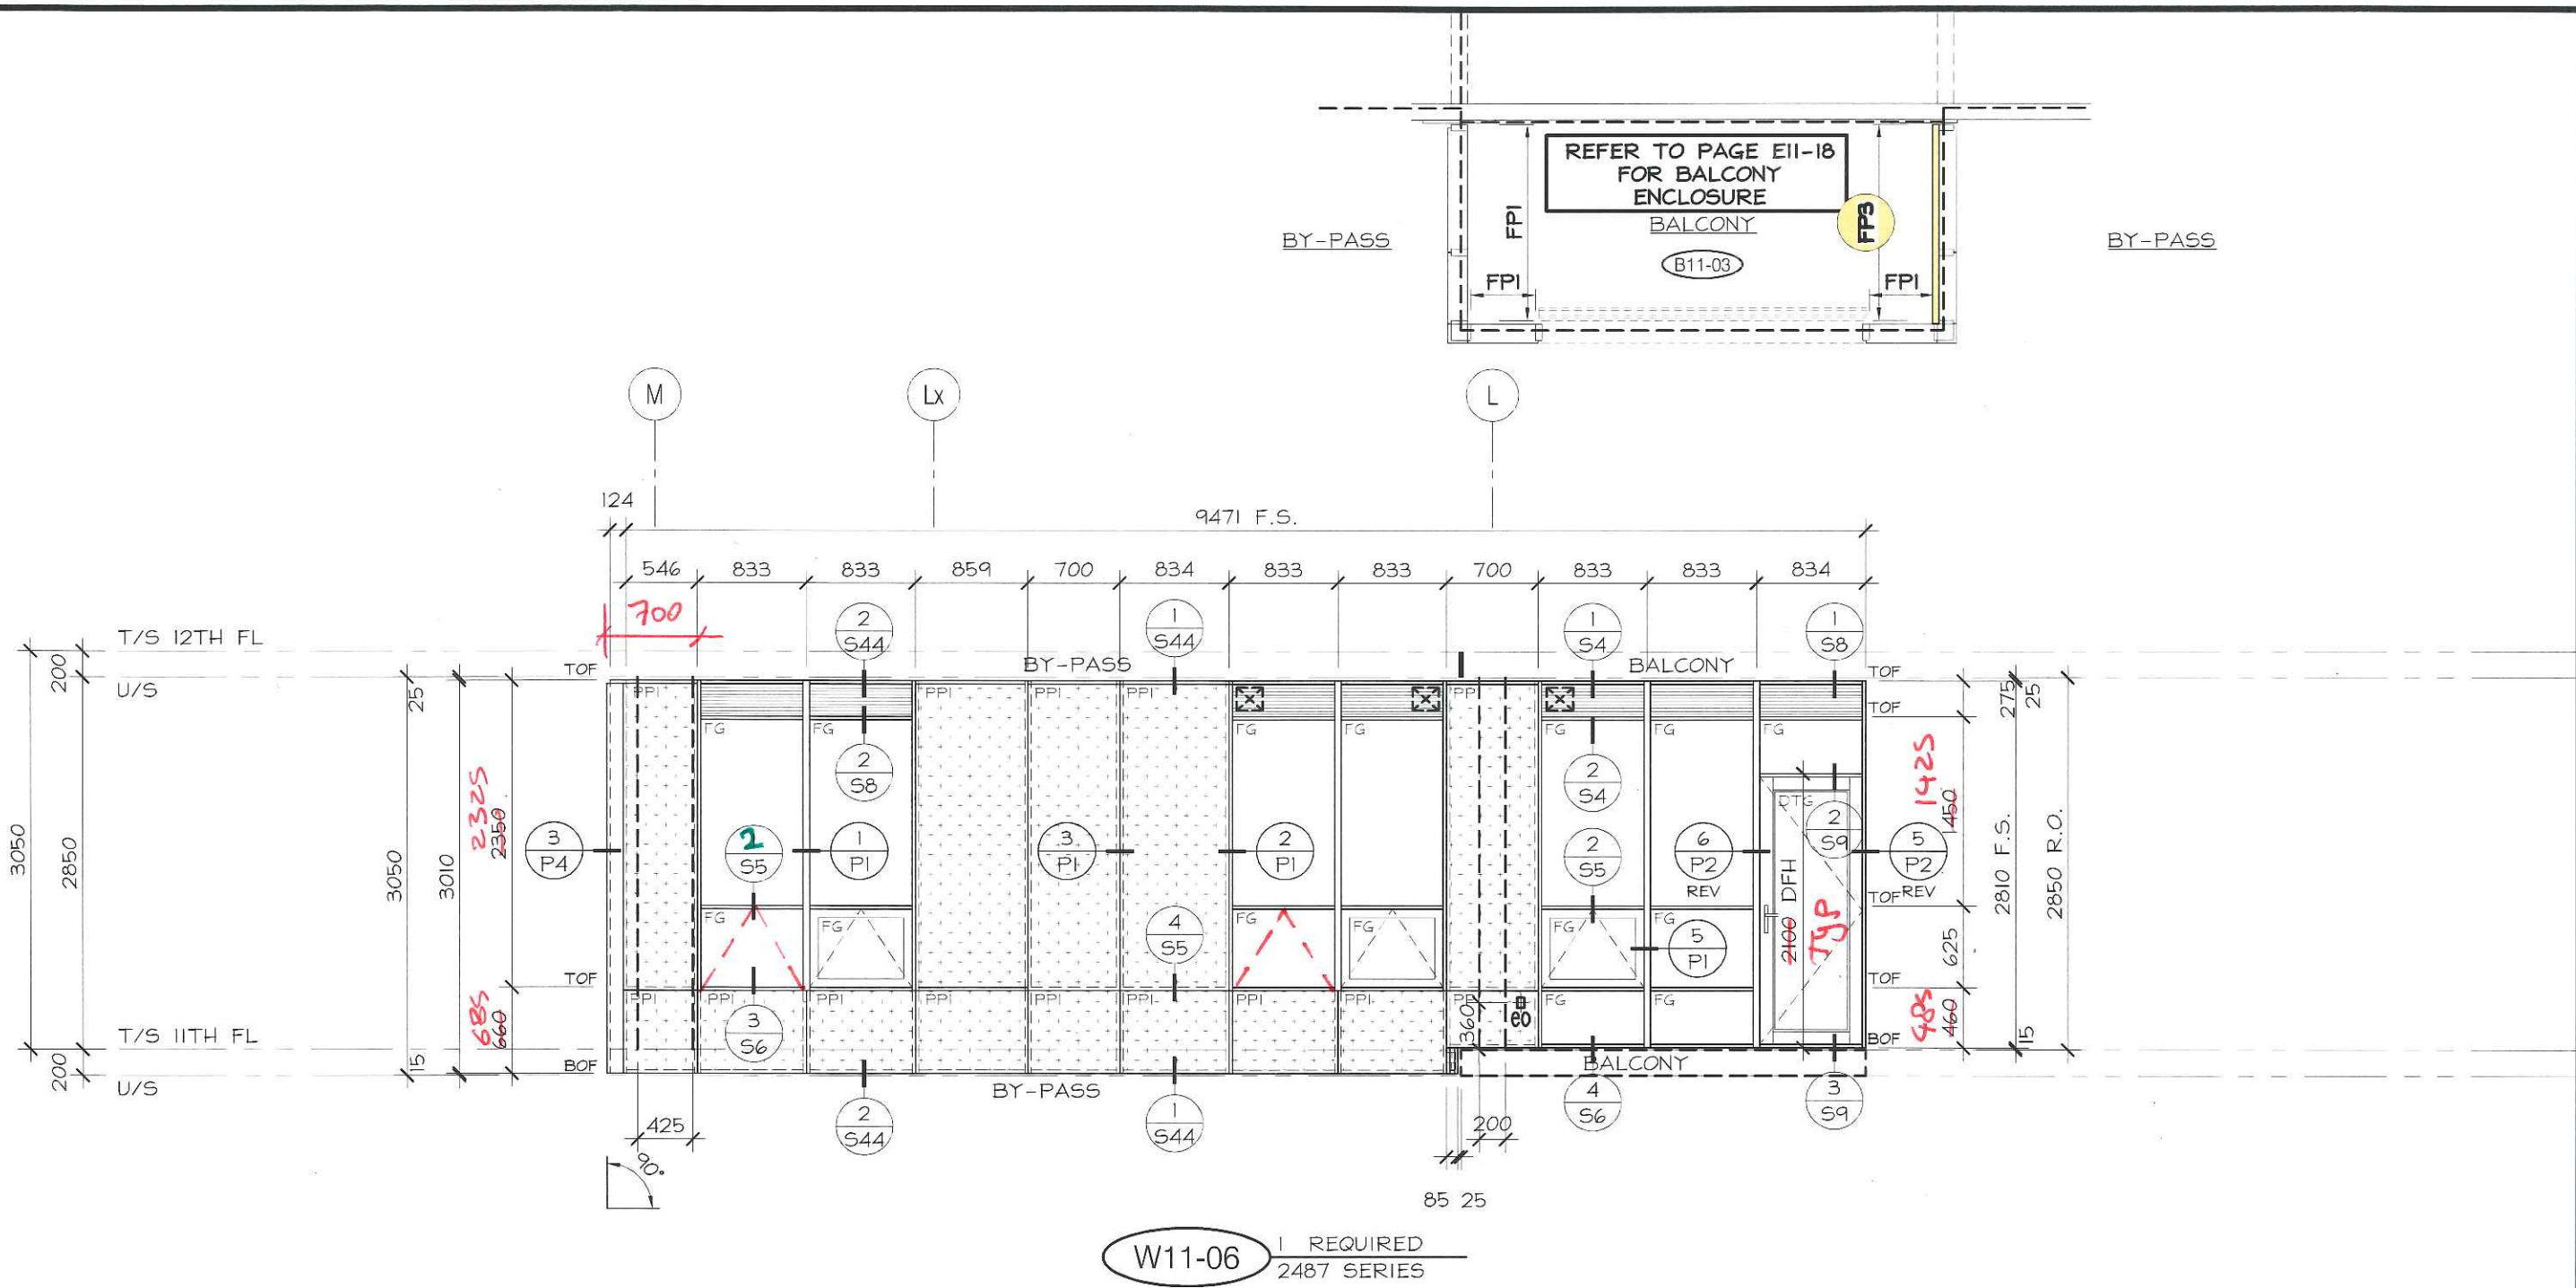

No.	REVISION	BY	DATE

PROJECT NAME: SQ ALEXANDRA PARK - BLOCK 11		DRAWING No.: E11-6
DRAWING TITLE: 11th FLOOR ELEVATIONS		
ARCHITECT: TEEPLE ARCHITECTS		DATE: MARCH 4, 2015
CONTRACTOR: TRIDEL		
SCALE: 1:50	DRAWN BY: S.C.	

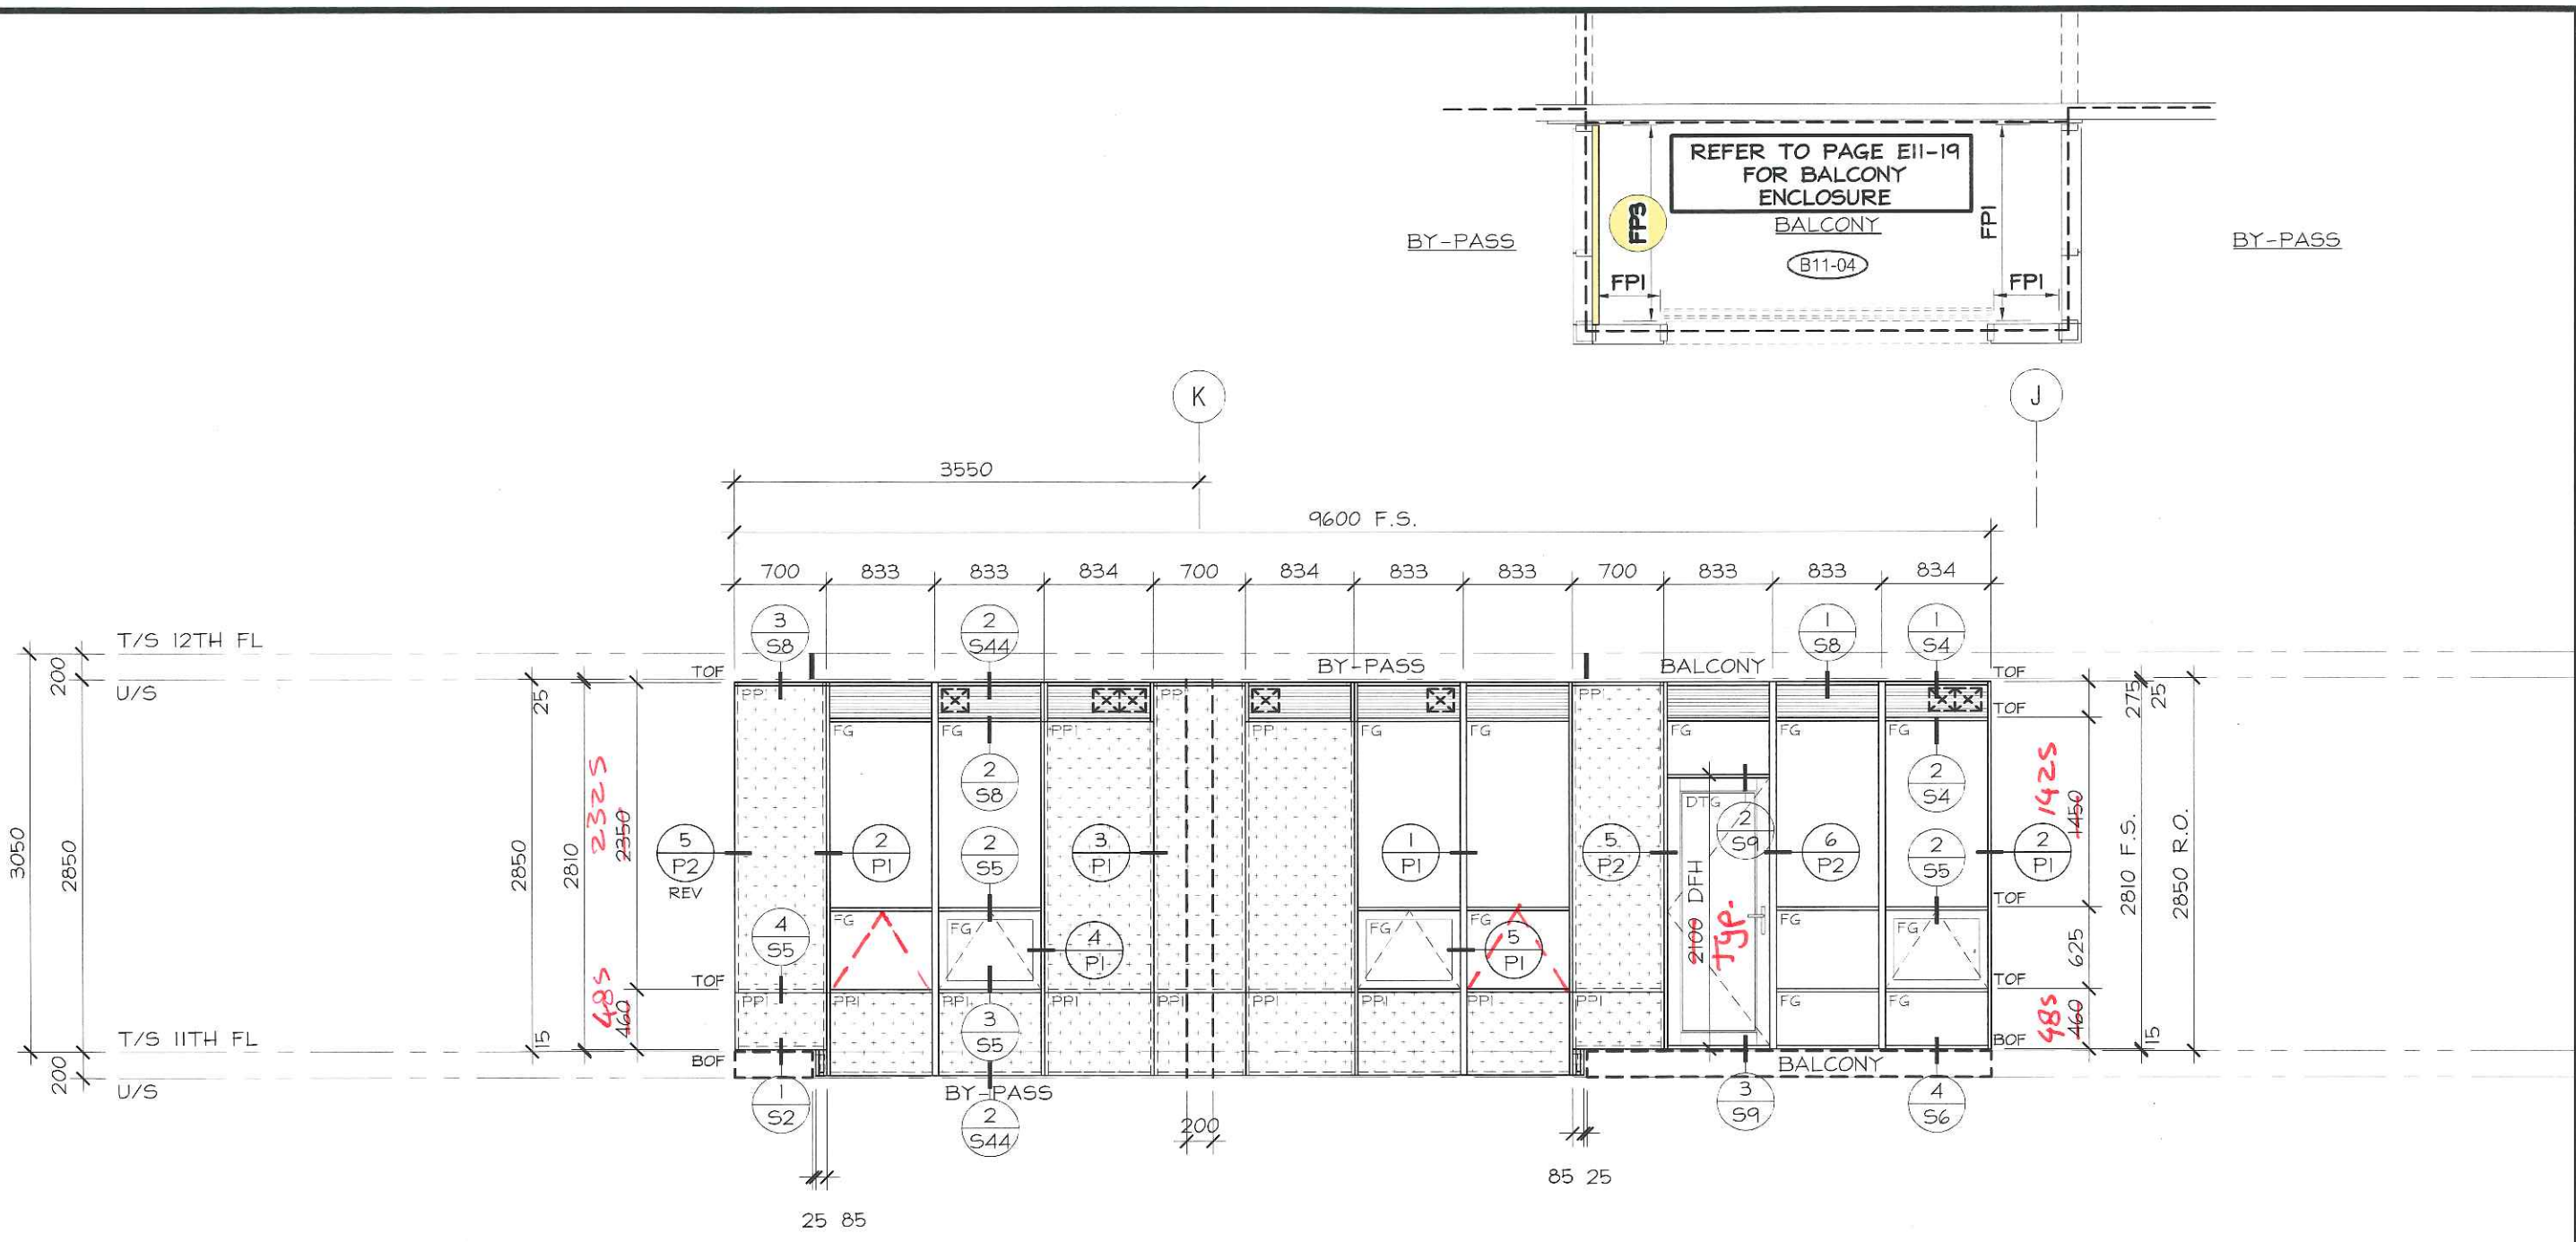


W11-07 1 REQUIRED
2487 SERIES



No.	REVISION	BY	DATE

PROJECT NAME: SQ ALEXANDRA PARK - BLOCK 11		DRAWING No.: E11-7
DRAWING TITLE: 11th FLOOR ELEVATIONS		
ARCHITECT: TEEPLE ARCHITECTS		DATE: MARCH 4, 2015
CONTRACTOR: TRIDEL		
SCALE: 1:50	DRAWN BY: S.C.	

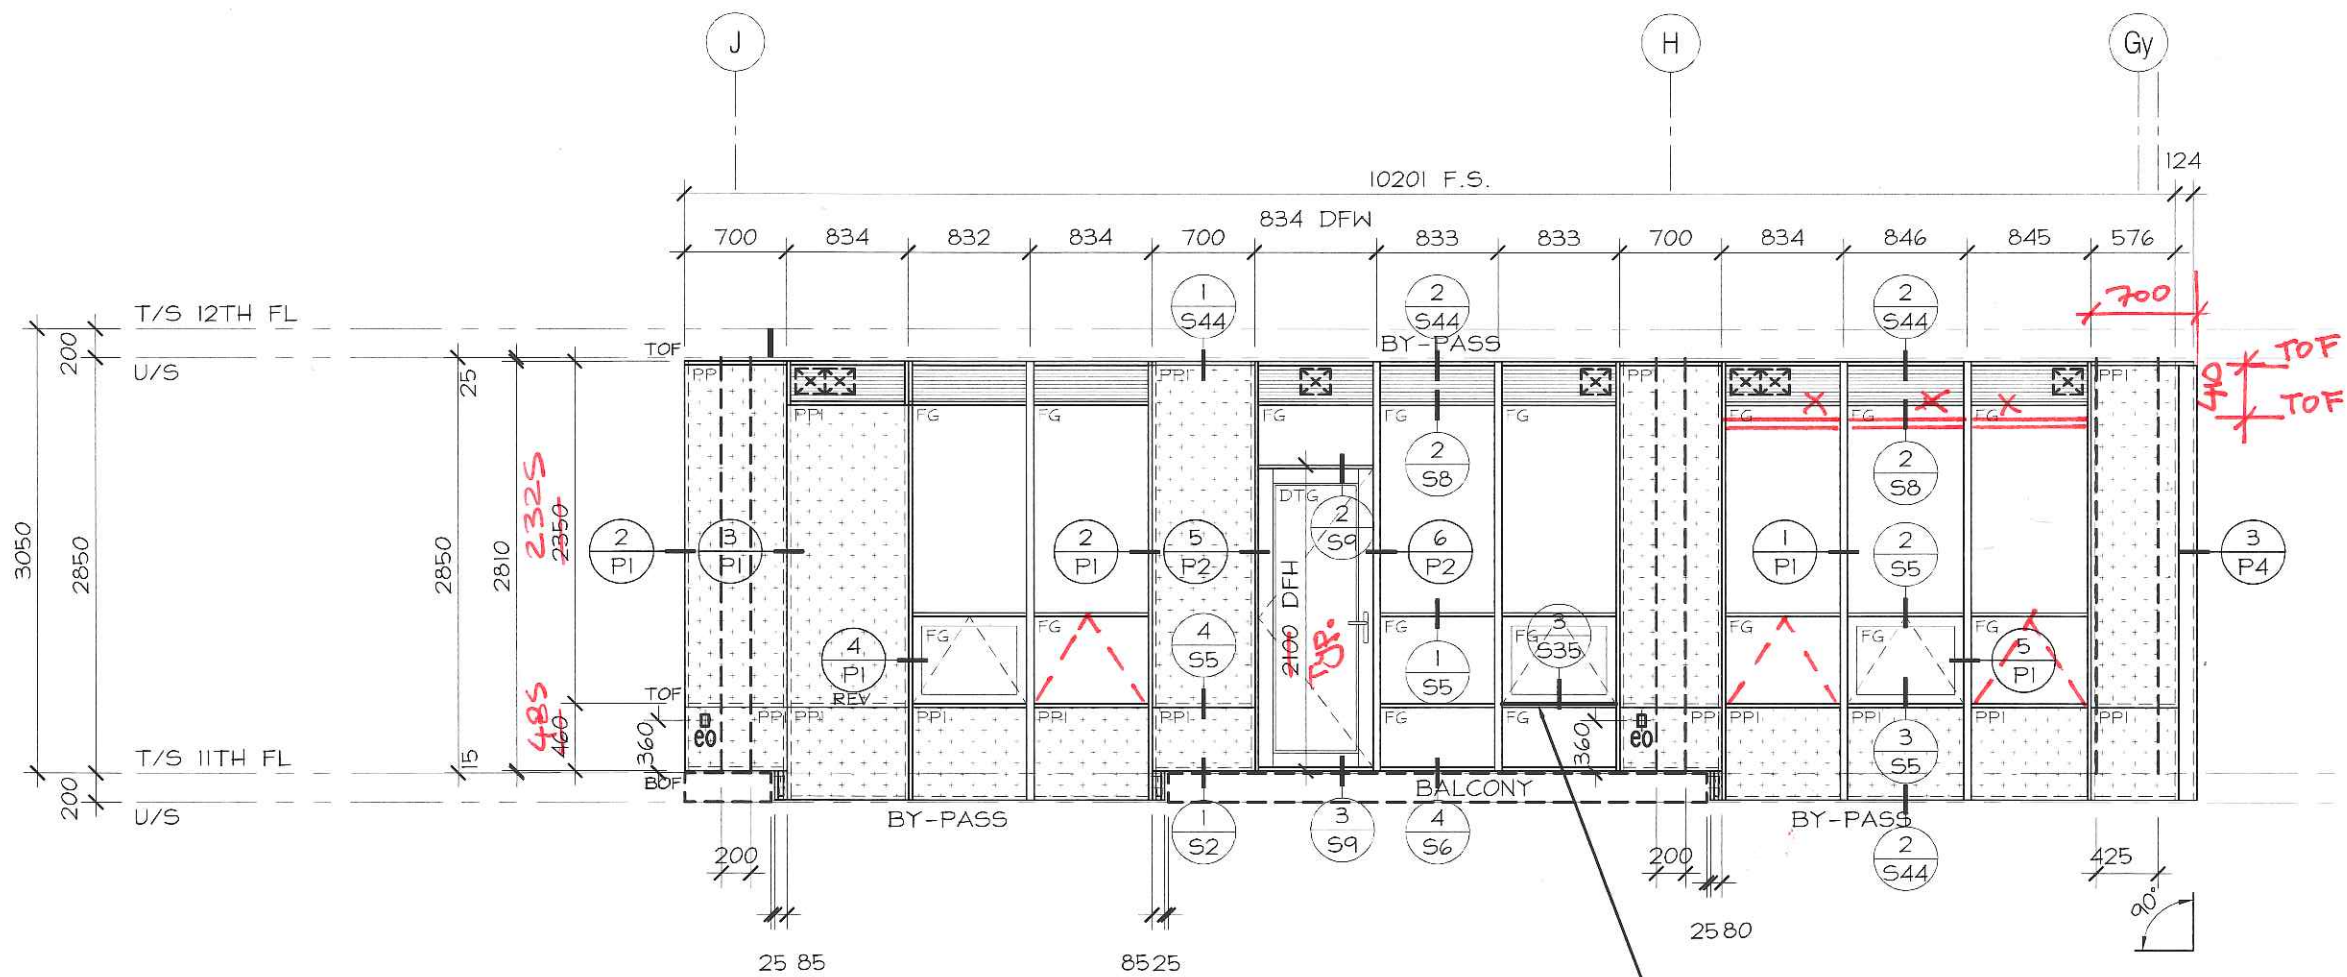


W11-08 1 REQUIRED 2487 SERIES TOE GUARD REQUIRED



No.	REVISION	BY	DATE

PROJECT NAME:	SQ ALEXANDRA PARK - BLOCK11		
DRAWING TITLE:	11th FLOOR ELEVATIONS		
ARCHITECT:	TEEPLE ARCHITECTS		
CONTRACTOR:	TRIDEL		
SCALE:	1:50	DRAWN BY:	S.C.
DATE:	MARCH 4, 2015		

DRAWING No.:
E11-8


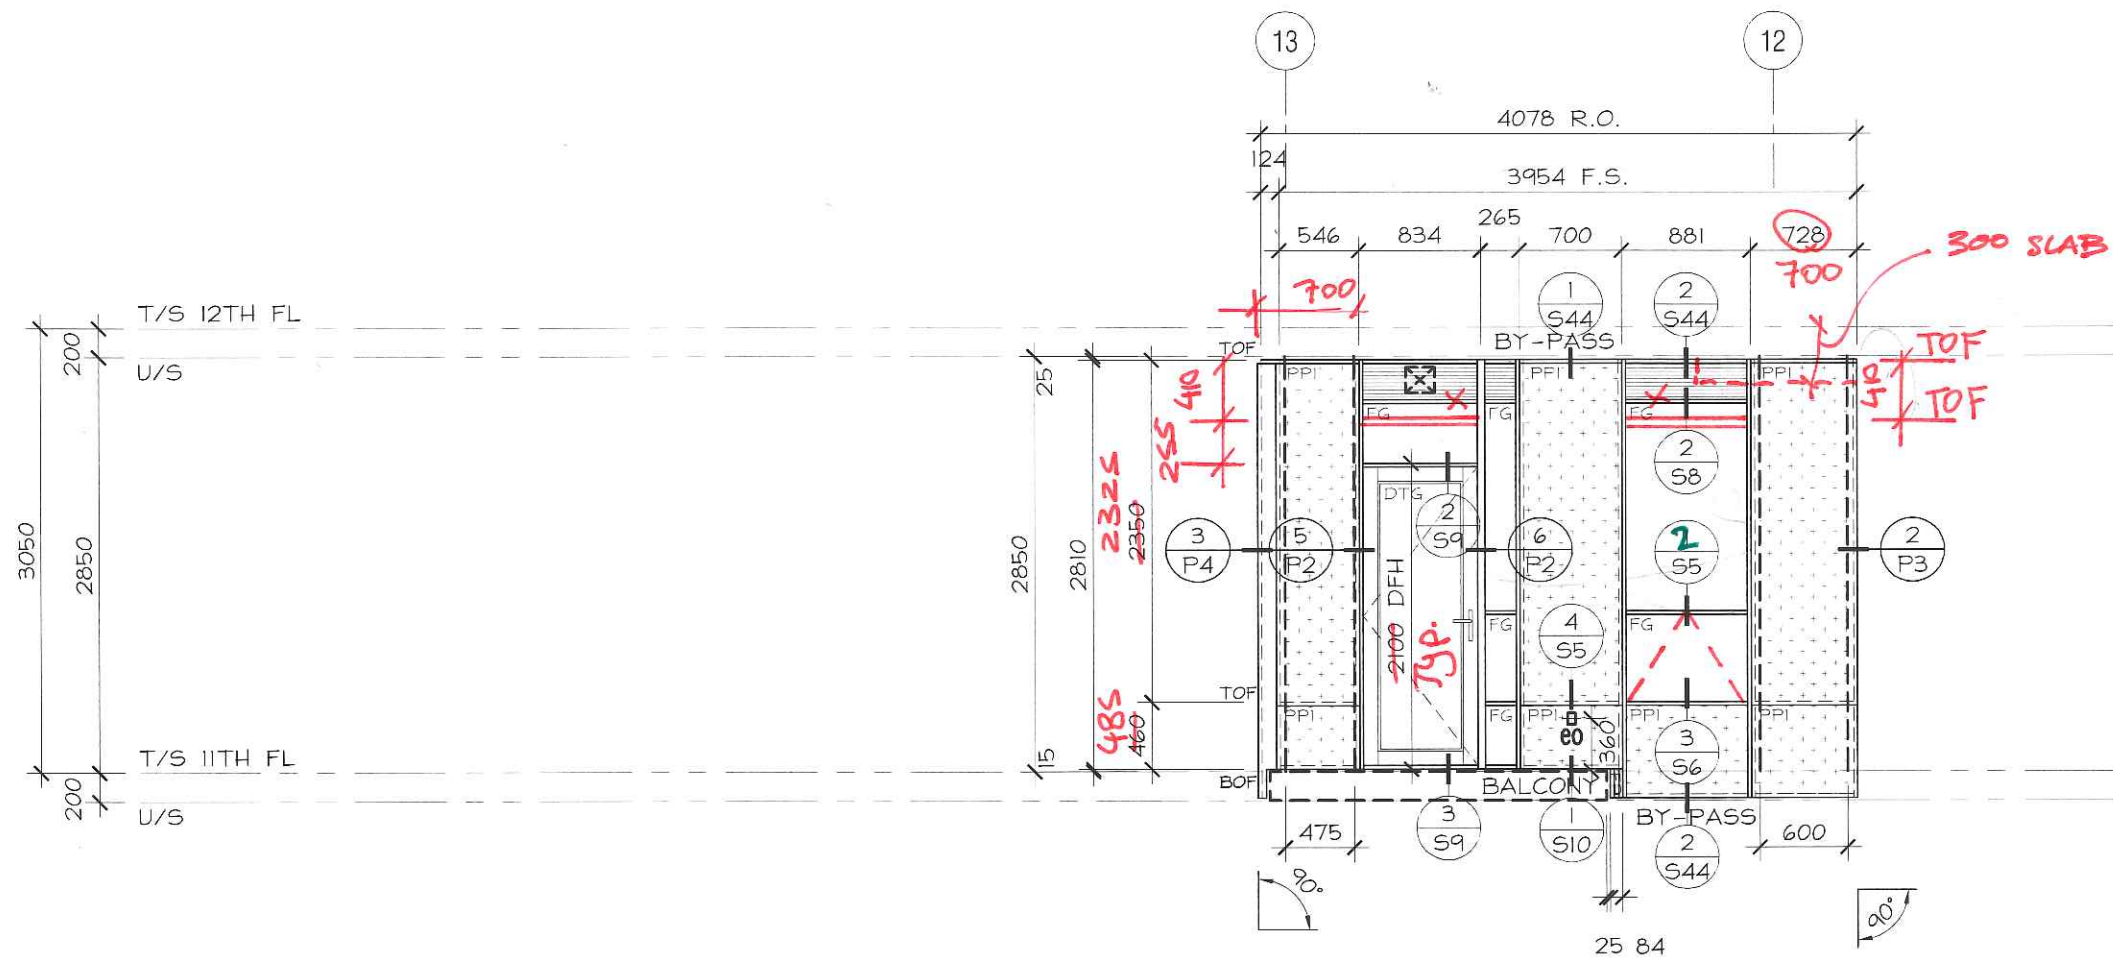


W11-09 1 REQUIRED
2487 SERIES





No.	REVISION	BY	DATE

PROJECT NAME: SQ ALEXANDRA PARK - BLOCK 11		DRAWING No.: E11-9
DRAWING TITLE: 11th FLOOR ELEVATIONS		
ARCHITECT: TEEPLE ARCHITECTS		SCALE: 1:50
CONTRACTOR: TRIDEL		
DRAWN BY: S.C.		
DATE: MARCH 4, 2015		

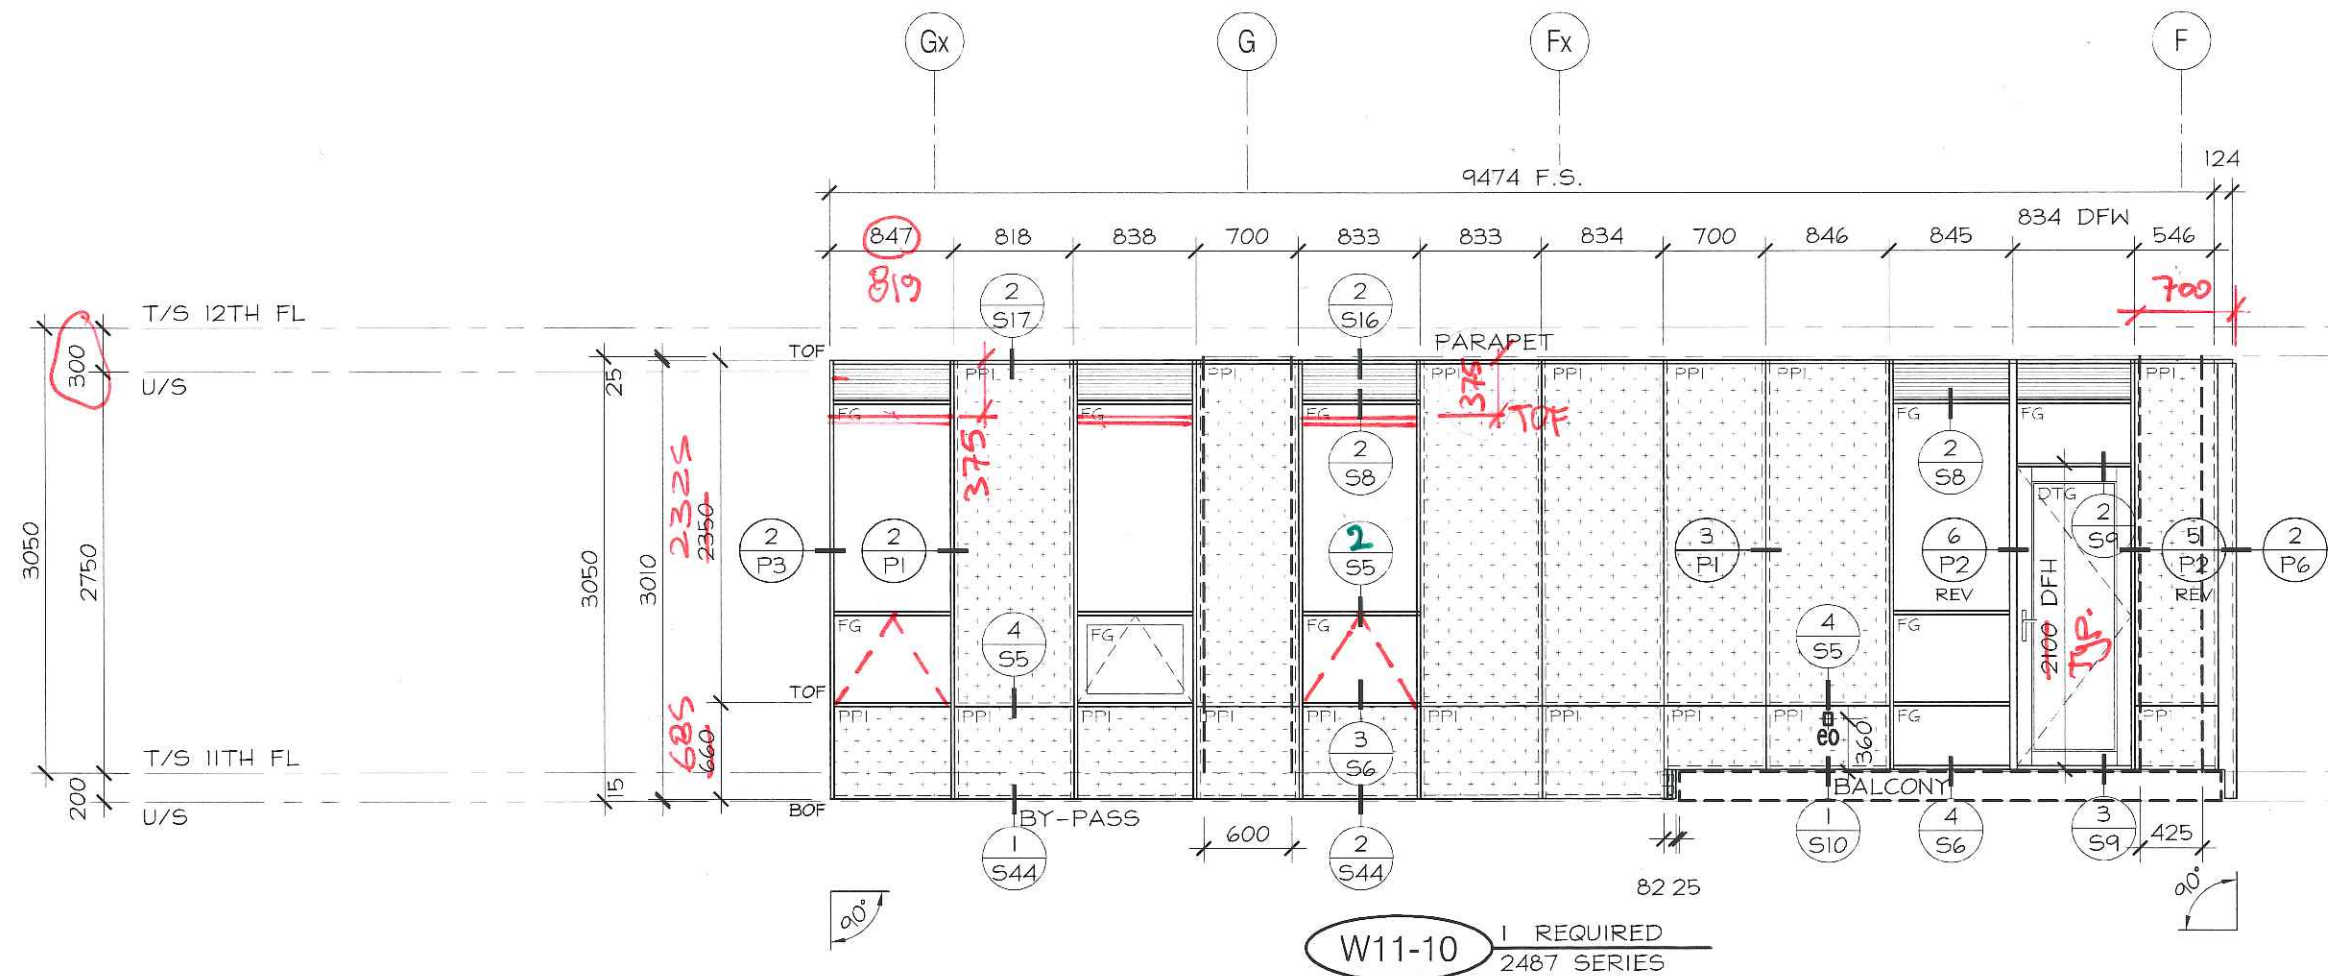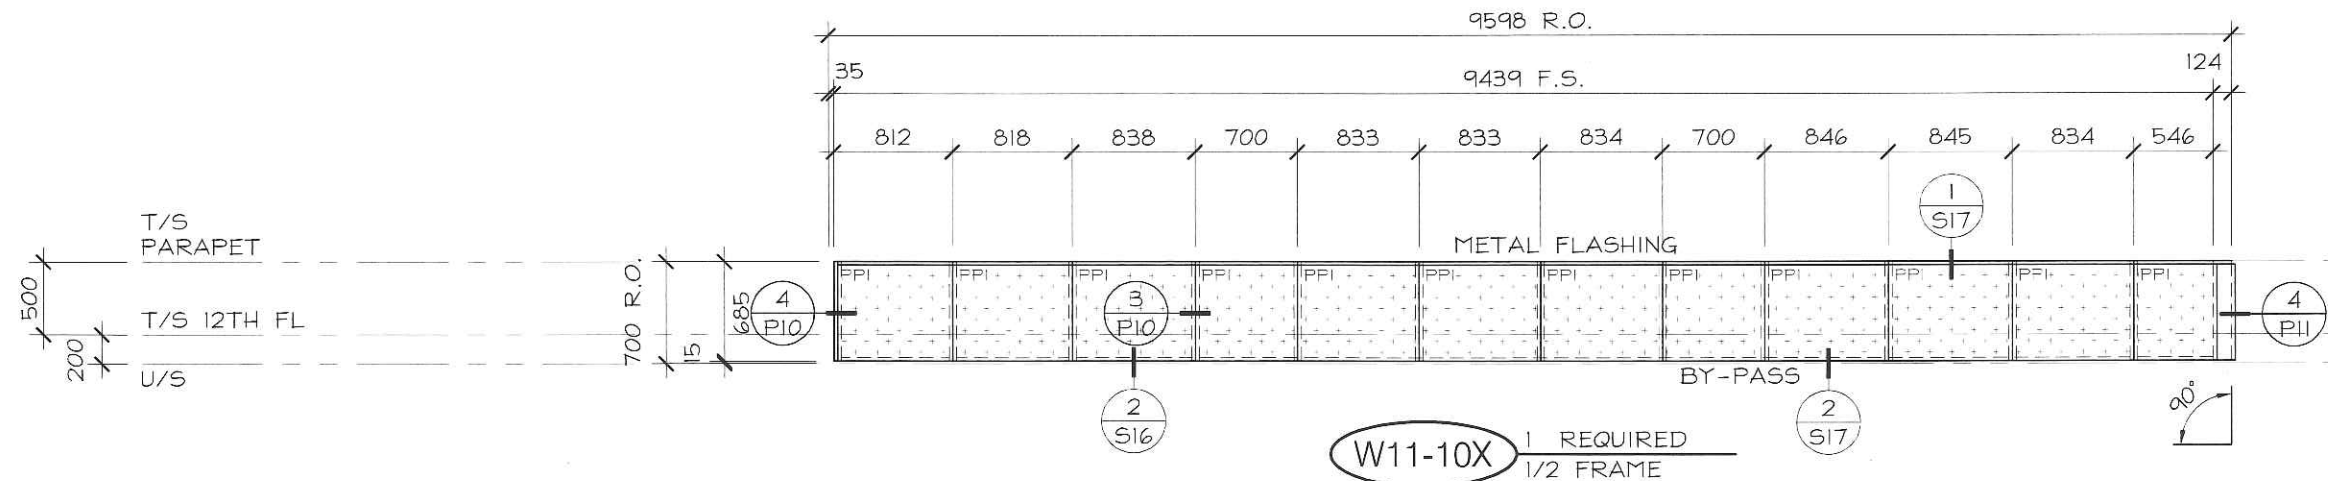


No.	REVISION	BY	DATE

PROJECT NAME: SQ ALEXANDRA PARK - BLOCK11		DRAWING No.: E11-10
DRAWING TITLE: 11th FLOOR ELEVATIONS		
ARCHITECT: TEEPLE ARCHITECTS		DATE: MARCH 4, 2015
CONTRACTOR: TRIDEL		
SCALE: 1:50	DRAWN BY: S.C.	

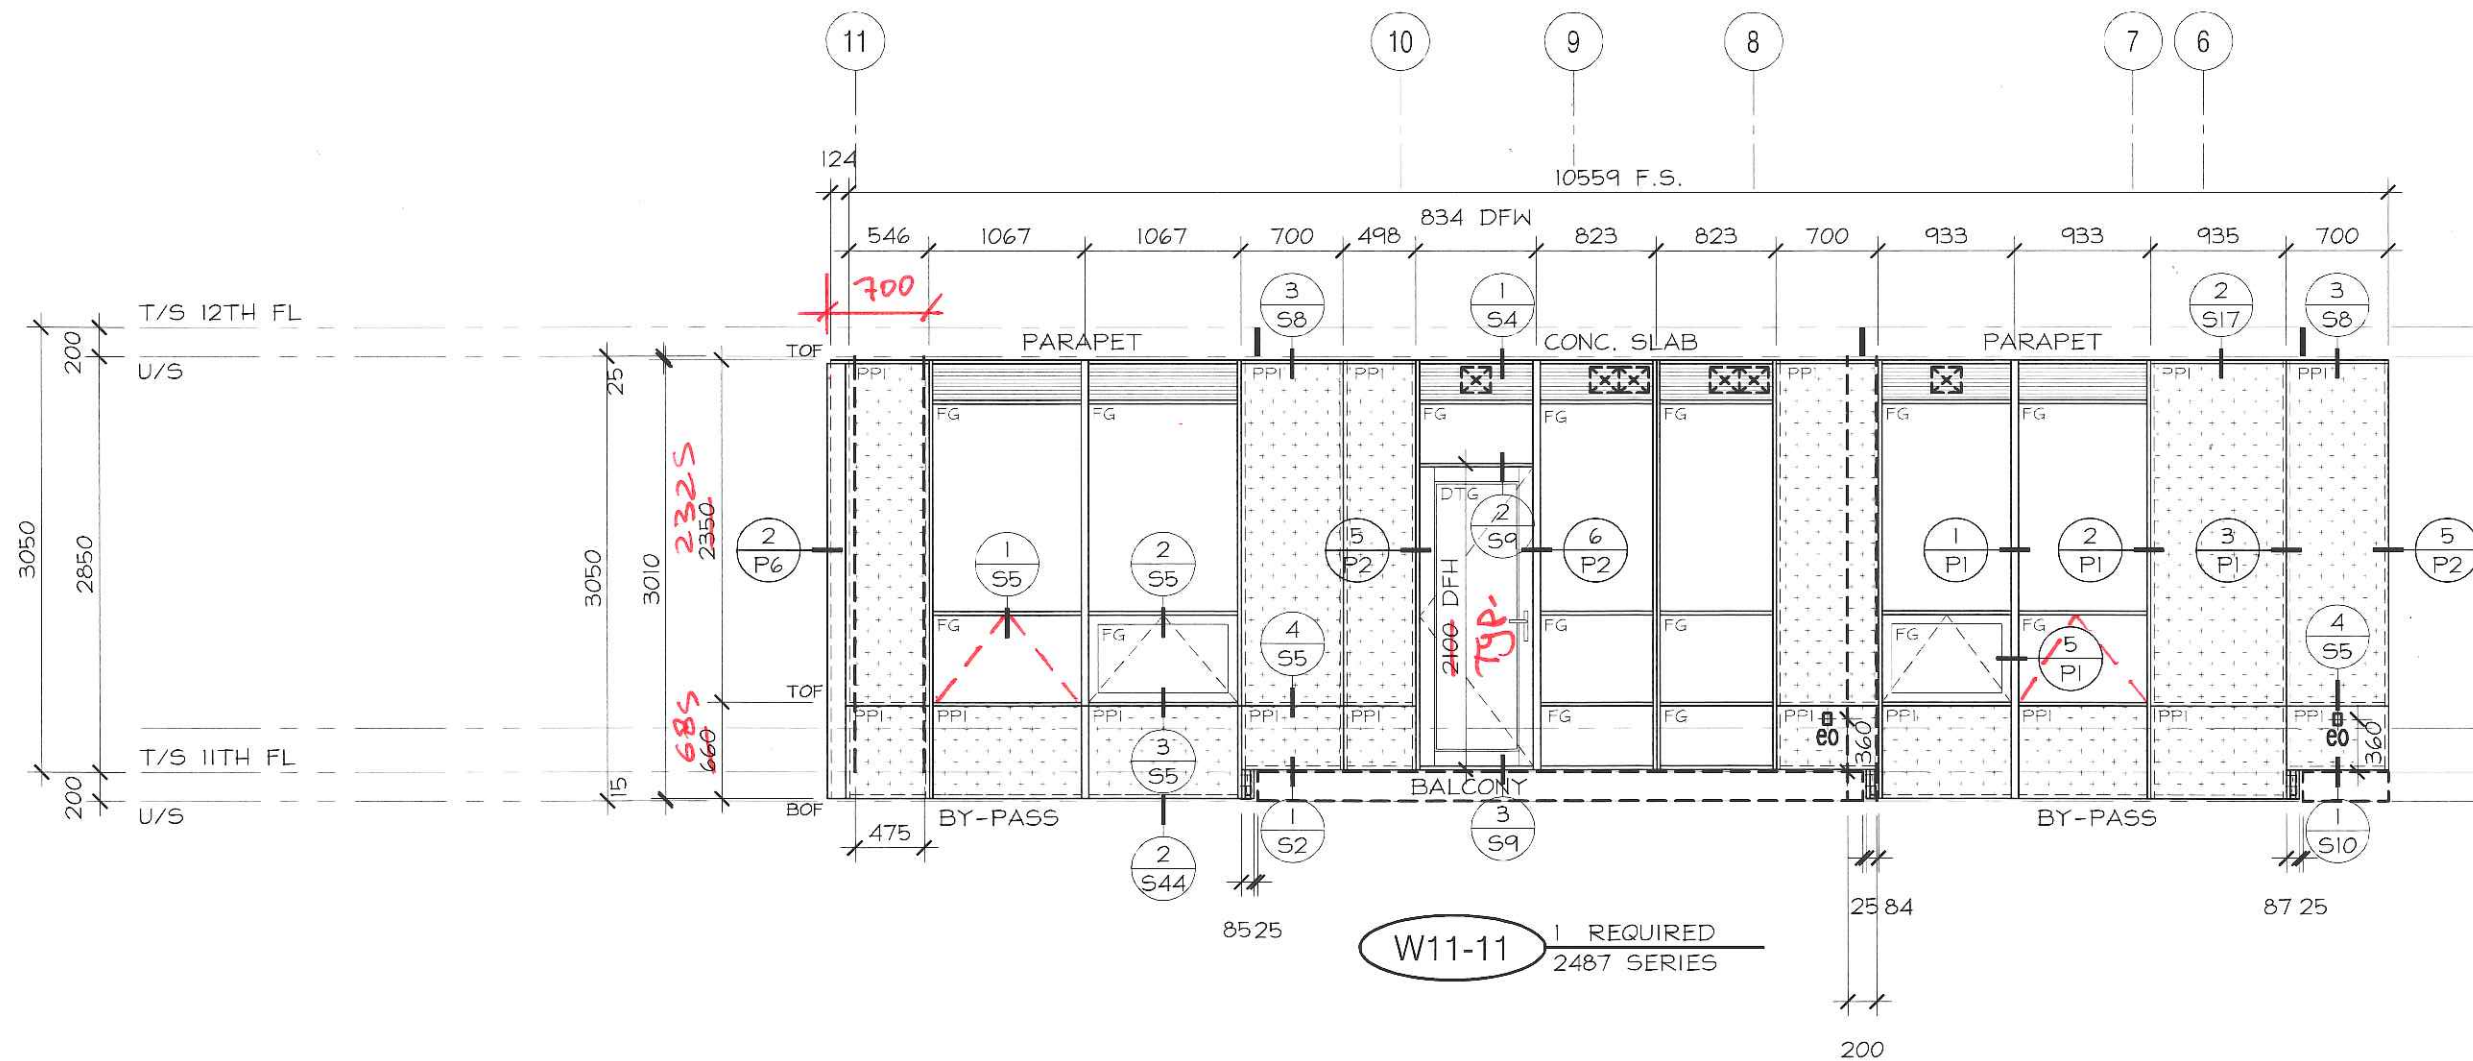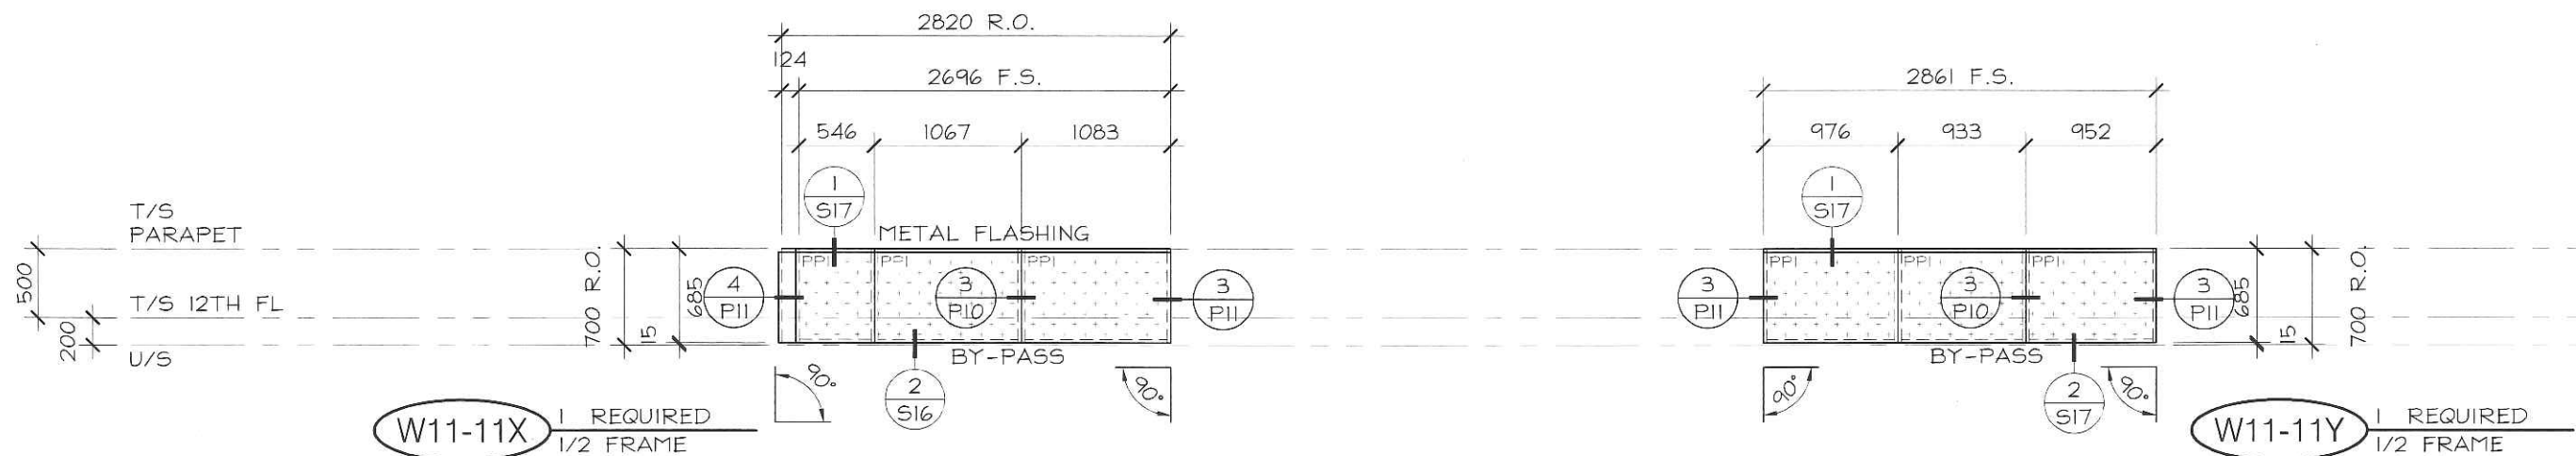

No.	REVISION	BY	DATE

PROJECT NAME: SQ ALEXANDRA PARK - BLOCK11		DRAWING No.:	
DRAWING TITLE: 11th FLOOR ELEVATIONS		E11-11	
ARCHITECT: TEEPLE ARCHITECTS		DRAWN BY: S.C.	
CONTRACTOR: TRIDEL		DATE: MARCH 4, 2015	
SCALE: 1:50			

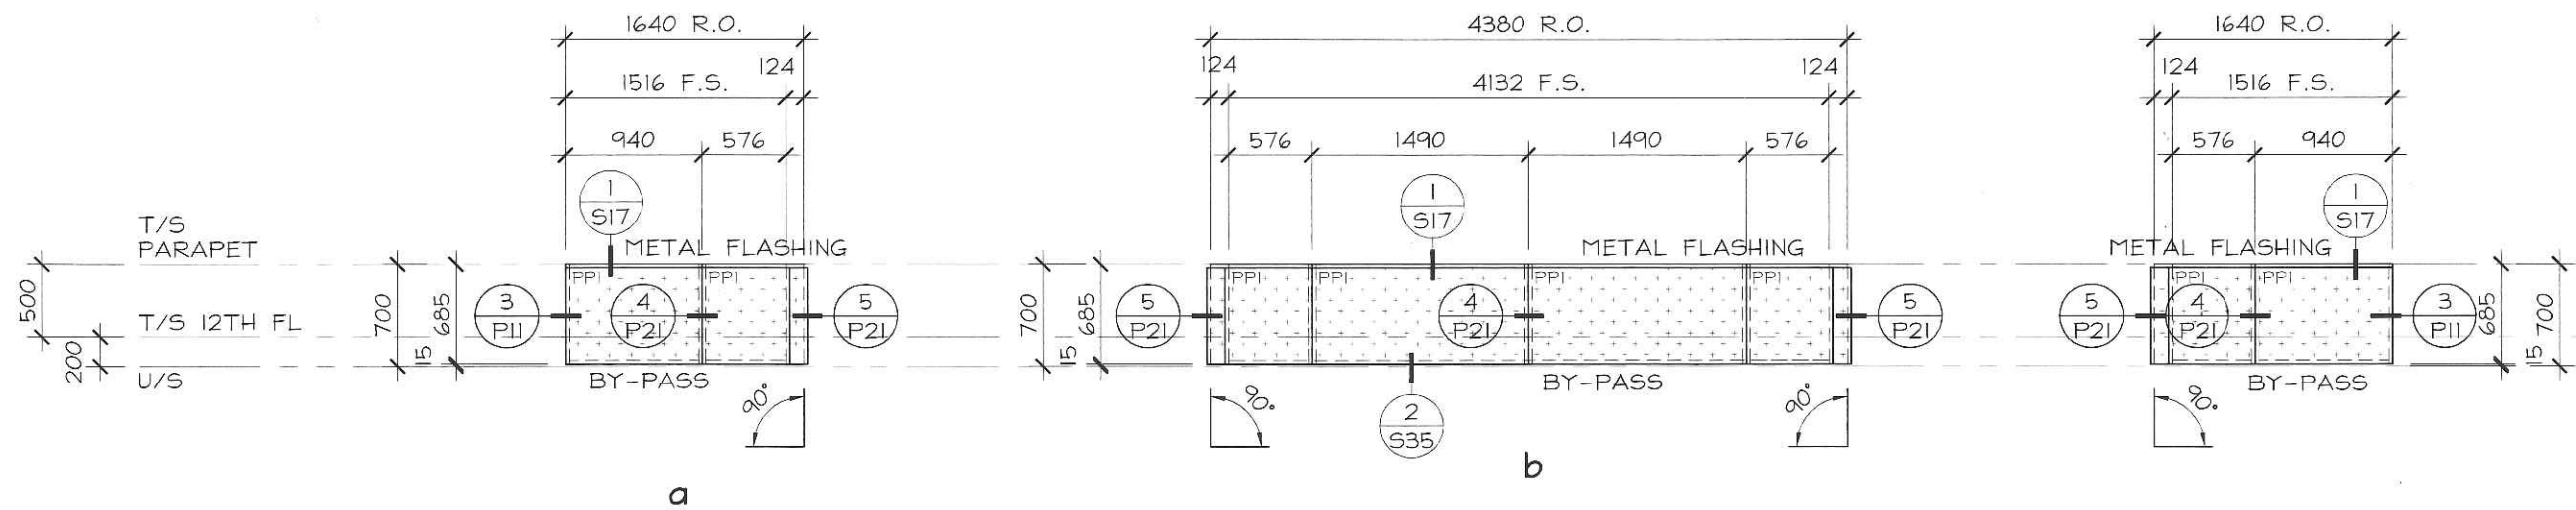


B11-01X 1 REQUIRED
1/2 FRAME



No.	REVISION	BY	DATE

PROJECT NAME: SQ ALEXANDRA PARK - BLOCK11		DRAWING No.: E11-13
DRAWING TITLE: 11th FLOOR ELEVATIONS		
ARCHITECT: TEEPLE ARCHITECTS		DATE: MARCH 4, 2015
CONTRACTOR: TRIDEL		
SCALE: 1:50	DRAWN BY: S.C.	

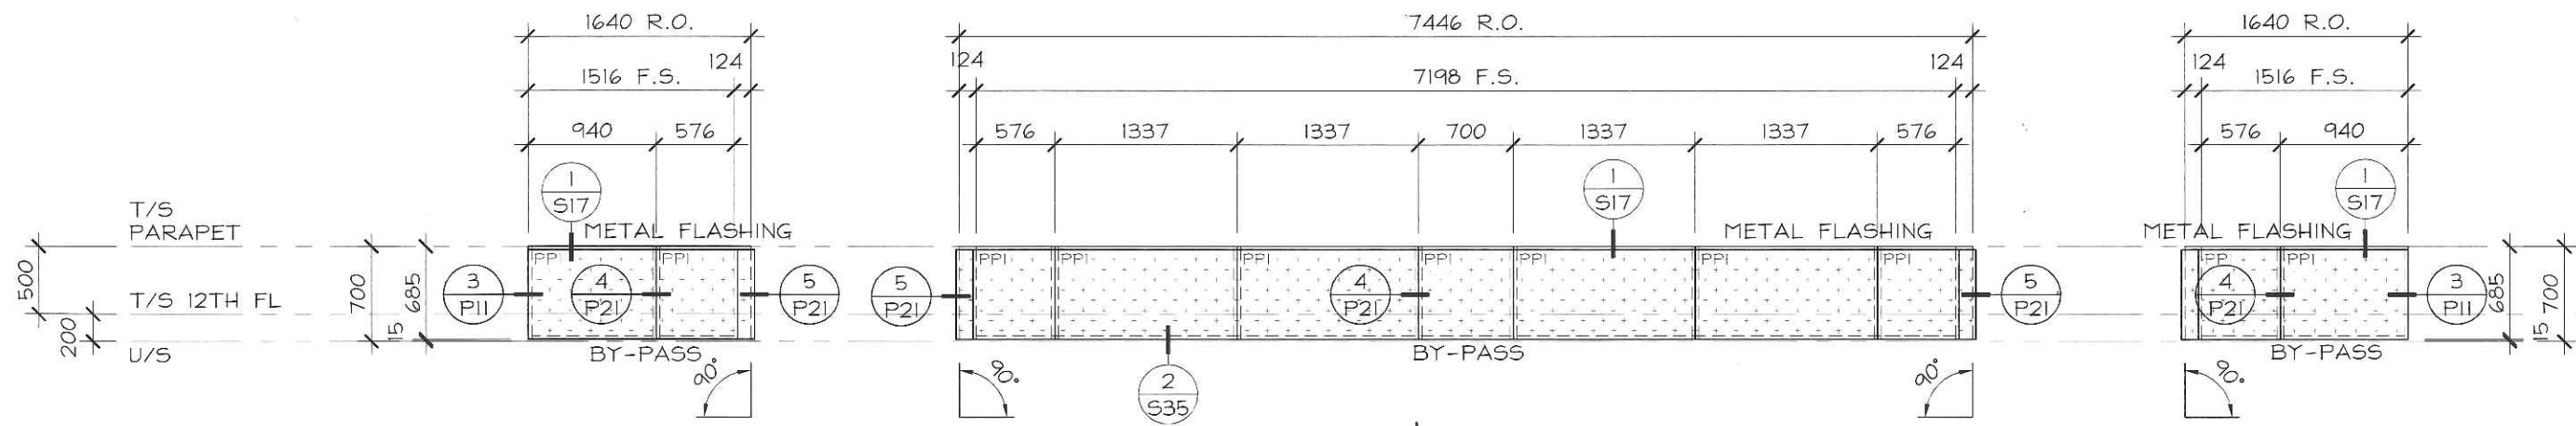



B11-04X 1 REQUIRED
1/2 FRAME




No.	REVISION	BY	DATE

PROJECT NAME: SQ ALEXANDRA PARK - BLOCK 11		DRAWING No.: E11-14
DRAWING TITLE: 11th FLOOR ELEVATIONS		
ARCHITECT: TEEPLE ARCHITECTS		DATE: MARCH 4, 2015
CONTRACTOR: TRIDEL		
SCALE: 1:50	DRAWN BY: S.C.	

FOR ALUMINUM BALCONY
 & TERRACE RAILINGS
 REFER TO TORO
 ALUMINUM RAILING SHOP
 DRAWINGS

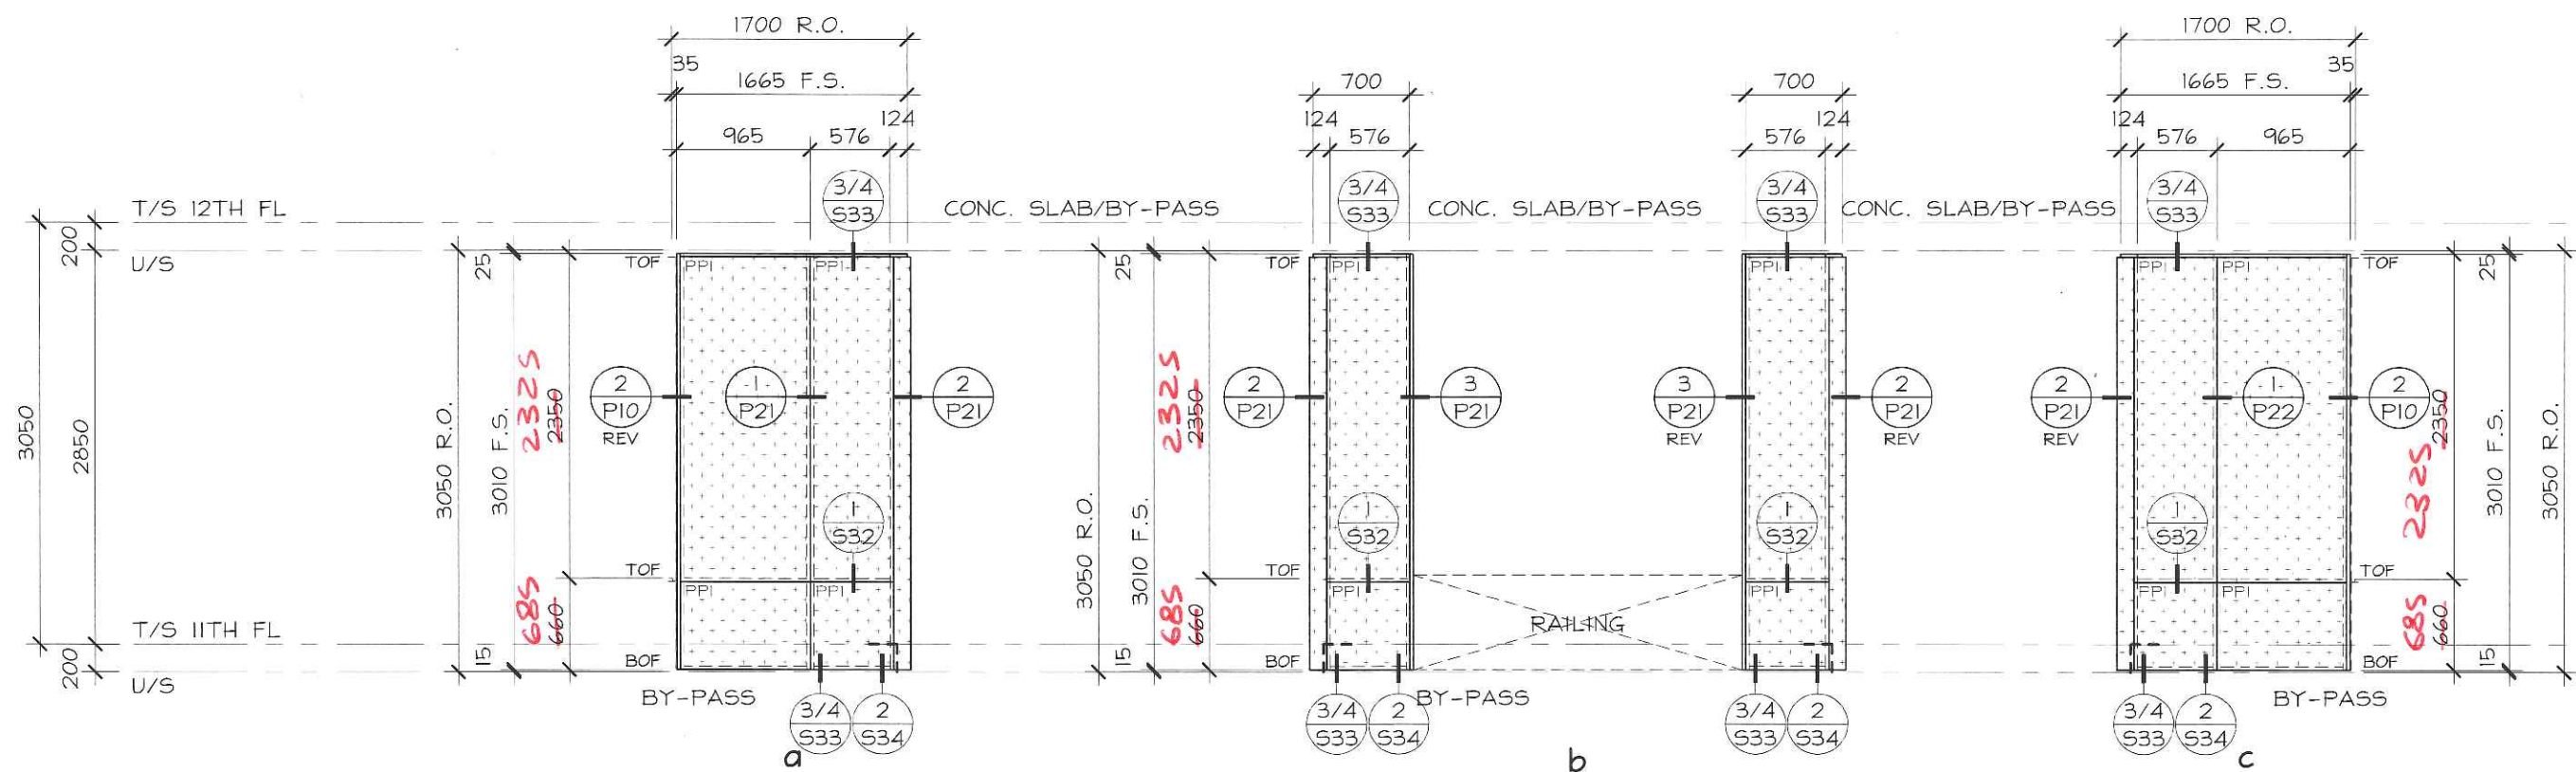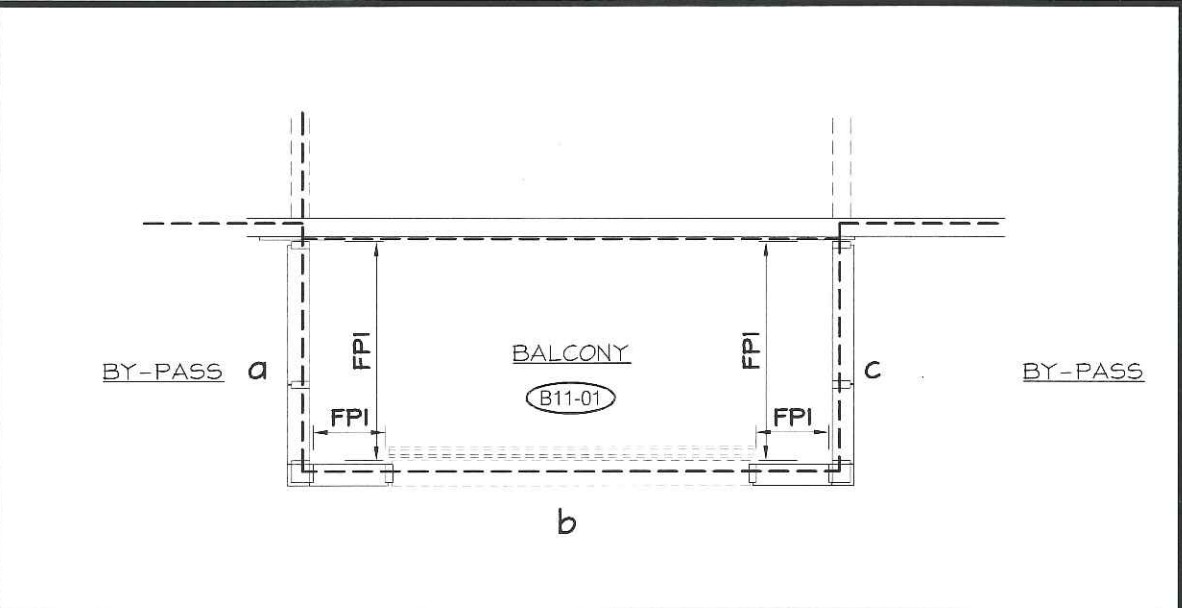



B11-01 2 REQUIRED
 2487 SERIES
 EXT. FINISH: PPG ACRYNAR PLATINUM UCFX11185
 INT. FINISH: PPG ACRYNAR PLATINUM UCFX11185

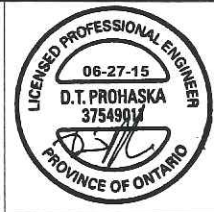


No.	REVISION	BY	DATE

PROJECT NAME:	SQ ALEXANDRA PARK - BLOCK11		
DRAWING TITLE:	11th FLOOR ELEVATIONS		
ARCHITECT:	TEEPLE ARCHITECTS		
CONTRACTOR:	TRIDEL		
SCALE:	1:50	DRAWN BY:	S.C.
DATE:	MARCH 4, 2015		
DRAWING No.:	E11-15		

FOR ALUMINUM BALCONY & TERRACE RAILINGS REFER TO TORO ALUMINUM RAILING SHOP DRAWINGS

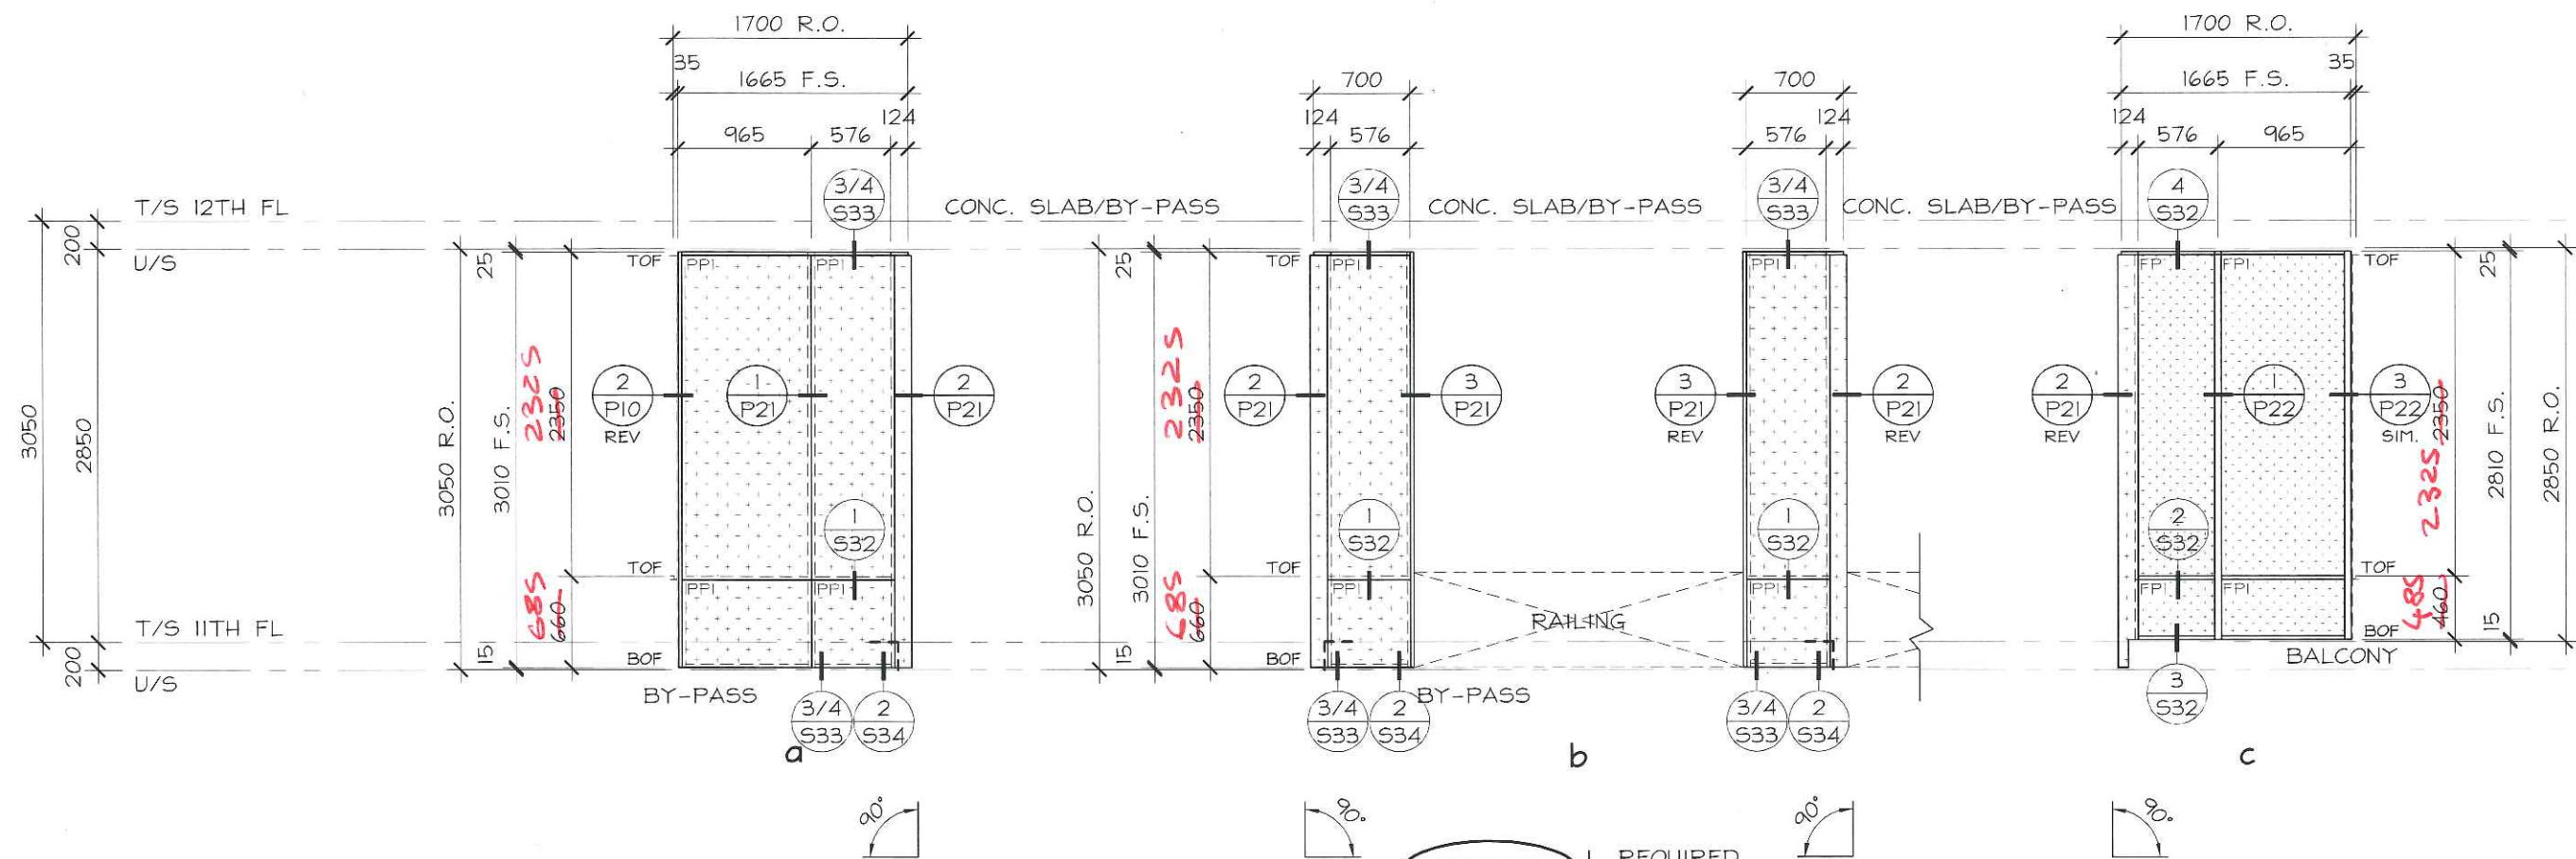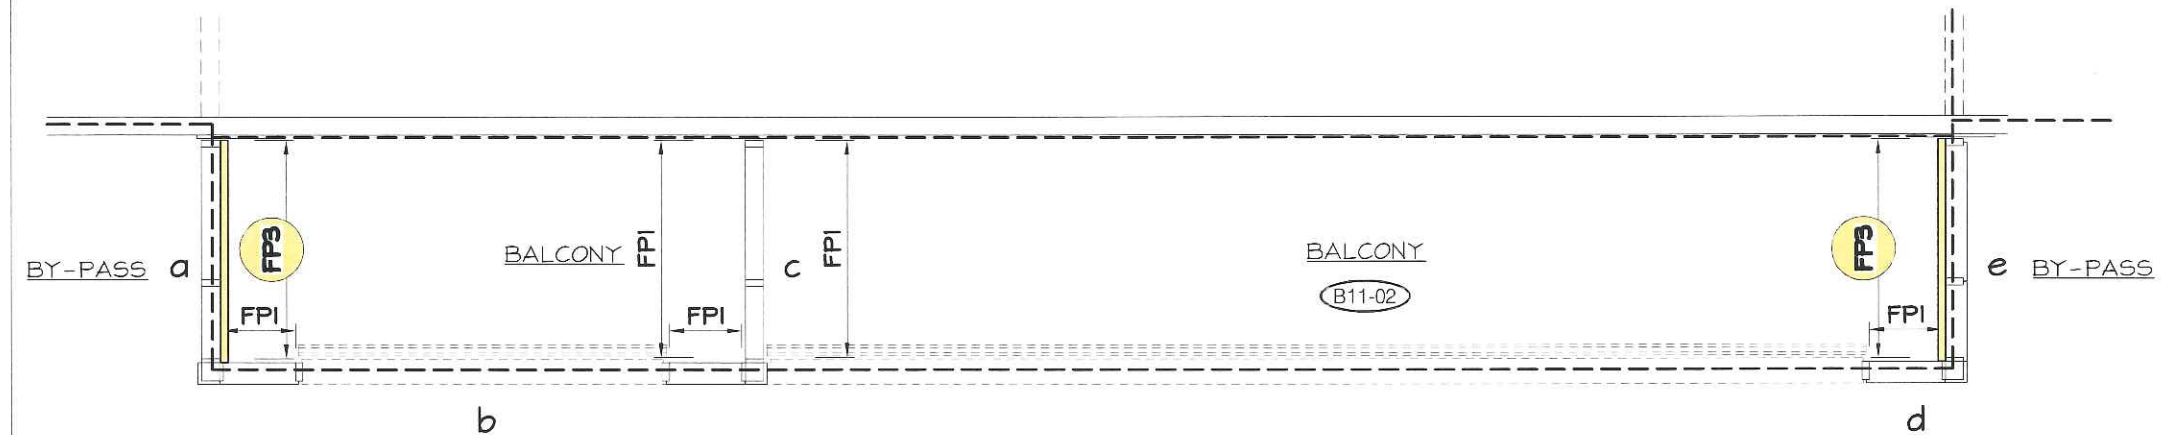


B11-02 1 REQUIRED
 2487 SERIES
 EXT. FINISH: PPG ACRYNAR PLATINUM UCFXIII85
 INT. FINISH: PPG ACRYNAR PLATINUM UCFXIII85
 e INT. FINISH: PPG ACRYNAR T.B.D.

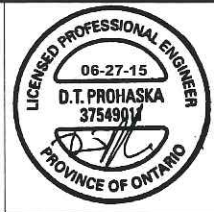

No.	REVISION	BY	DATE

PROJECT NAME:	SQ ALEXANDRA PARK - BLOCK 11		
DRAWING TITLE:	11th FLOOR ELEVATIONS		
ARCHITECT:	TEEPLE ARCHITECTS		
CONTRACTOR:	TRIDEL		
SCALE:	1:50	DRAWN BY:	S.C.
DATE:	MARCH 4, 2015		
DRAWING No.:	E11-16		



FOR ALUMINUM BALCONY
 & TERRACE RAILINGS
 REFER TO TORO
 ALUMINUM RAILING SHOP
 DRAWINGS

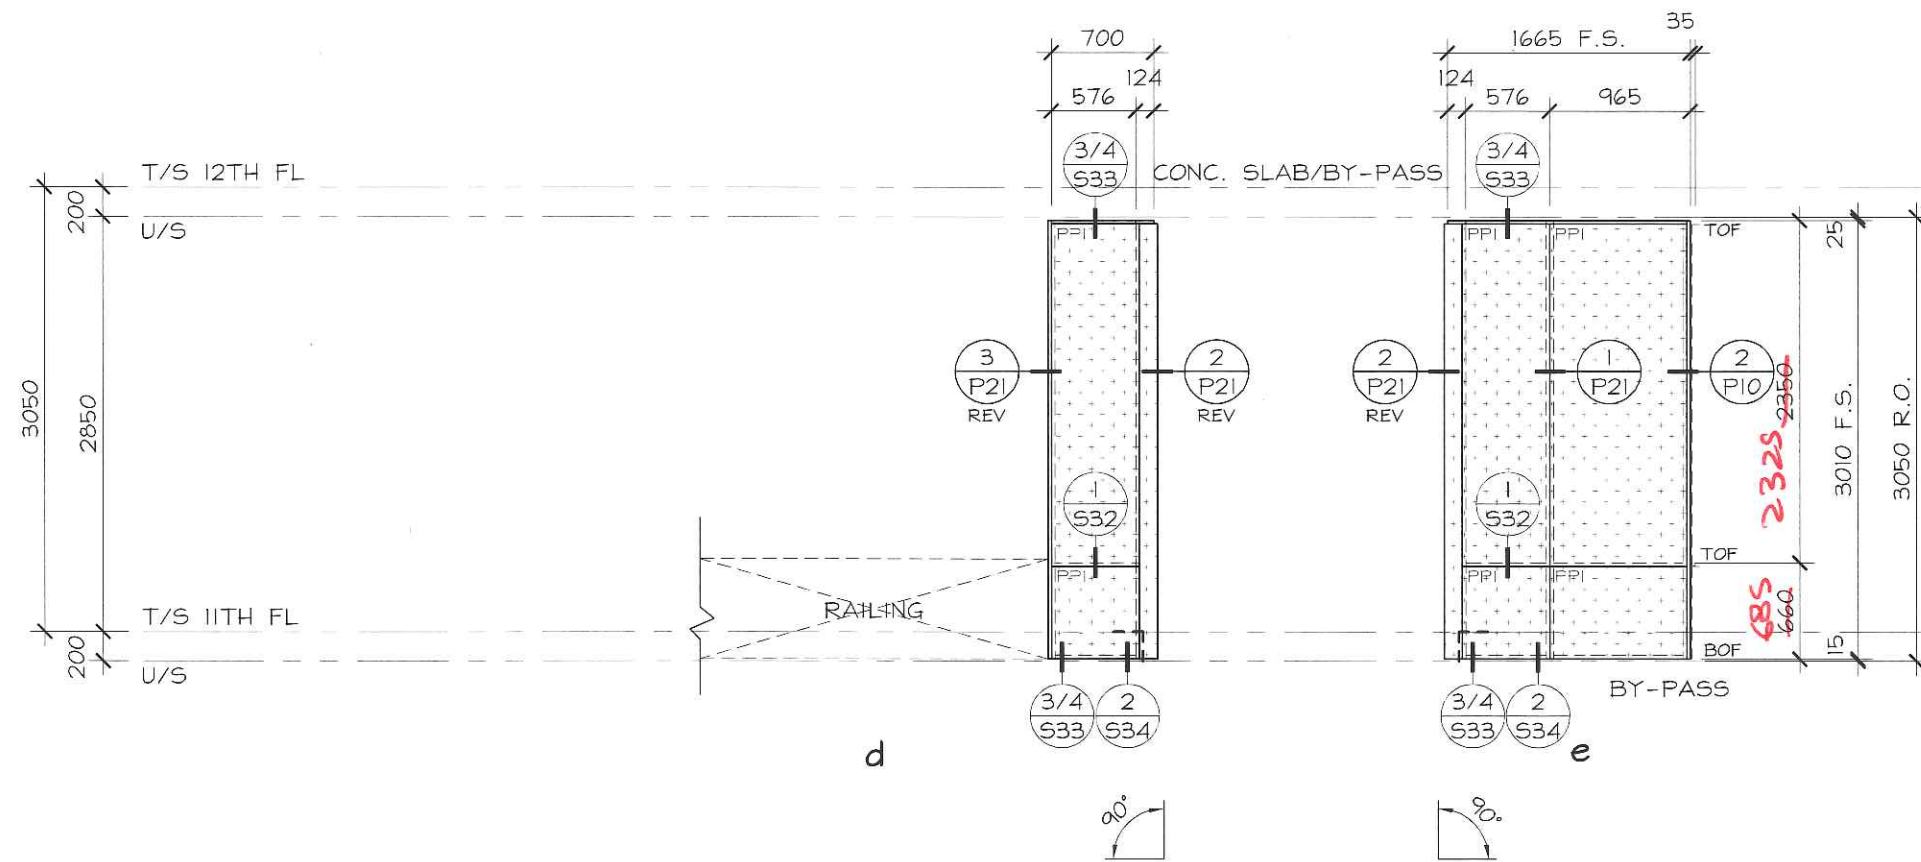

No.	REVISION	BY	DATE

PROJECT NAME:	SQ ALEXANDRA PARK - BLOCK11		
DRAWING TITLE:	11th FLOOR ELEVATIONS		
ARCHITECT:	TEEPLE ARCHITECTS		
CONTRACTOR:	TRIDEL		
SCALE:	1:50	DRAWN BY:	S.C.
DATE:	MARCH 4, 2015		
DRAWING No.:	E11-17		

FOR ALUMINUM BALCONY
 & TERRACE RAILINGS
 REFER TO TORO
 ALUMINUM RAILING SHOP
 DRAWINGS

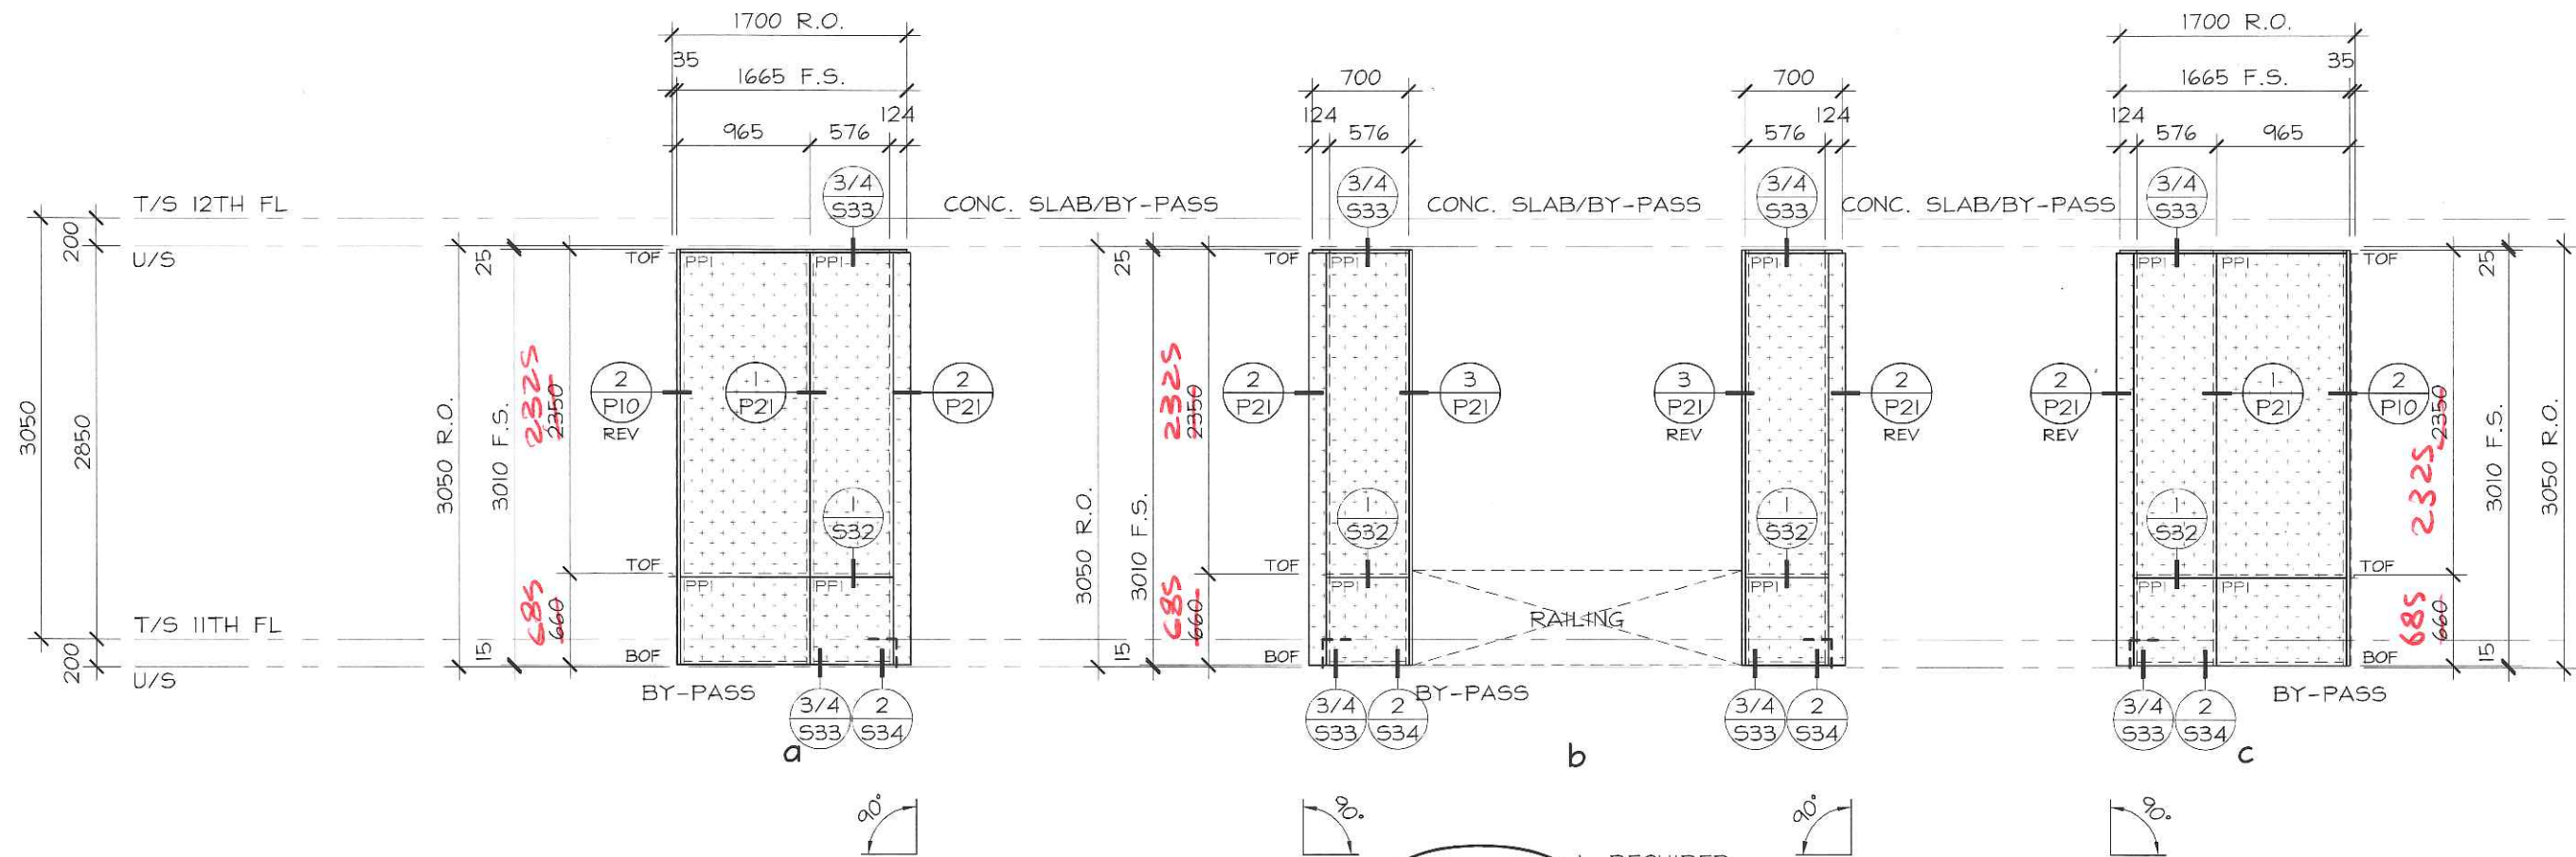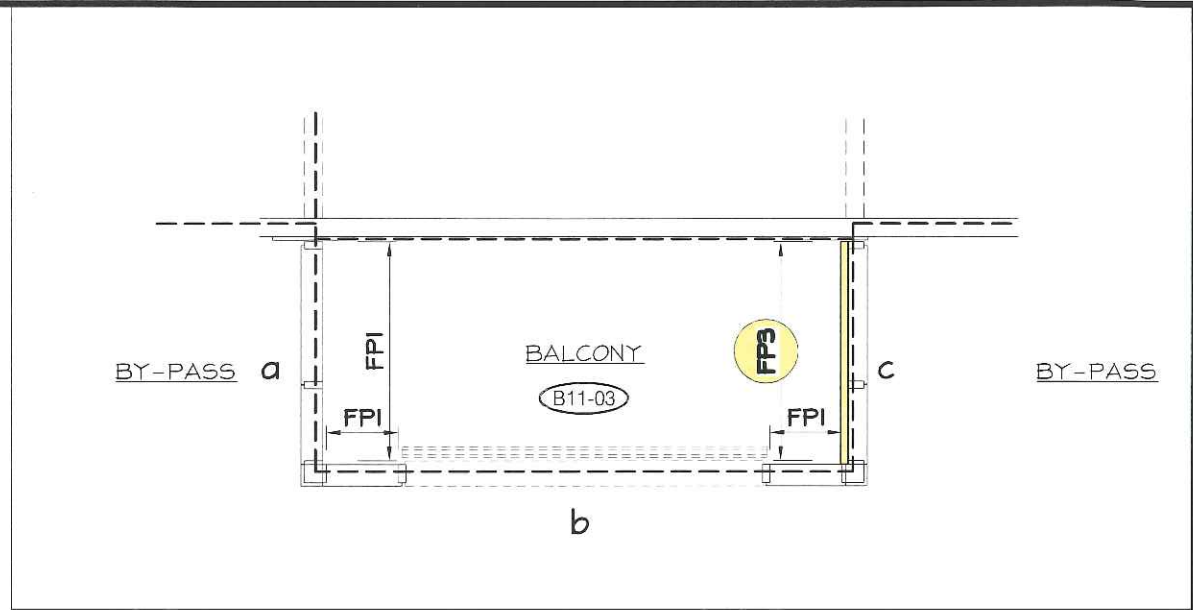



B11-03 1 REQUIRED
 2487 SERIES
 EXT. FINISH: PPG ACRYNAR PLATINUM UCFX11185
 INT. FINISH: PPG ACRYNAR PLATINUM UCFX11185
 c INT. FINISH: PPG ACRYNAR T.B.D.



No.	REVISION	BY	DATE

PROJECT NAME:	SQ ALEXANDRA PARK - BLOCK11		
DRAWING TITLE:	11th FLOOR ELEVATIONS		
ARCHITECT:	TEEPLE ARCHITECTS		
CONTRACTOR:	TRIDEL		
SCALE:	1:50	DRAWN BY:	S.C.
DATE:	MARCH 4, 2015		
DRAWING No.:	E11-18		

FOR ALUMINUM BALCONY
& TERRACE RAILINGS
REFER TO TORO
ALUMINUM RAILING SHOP
DRAWINGS

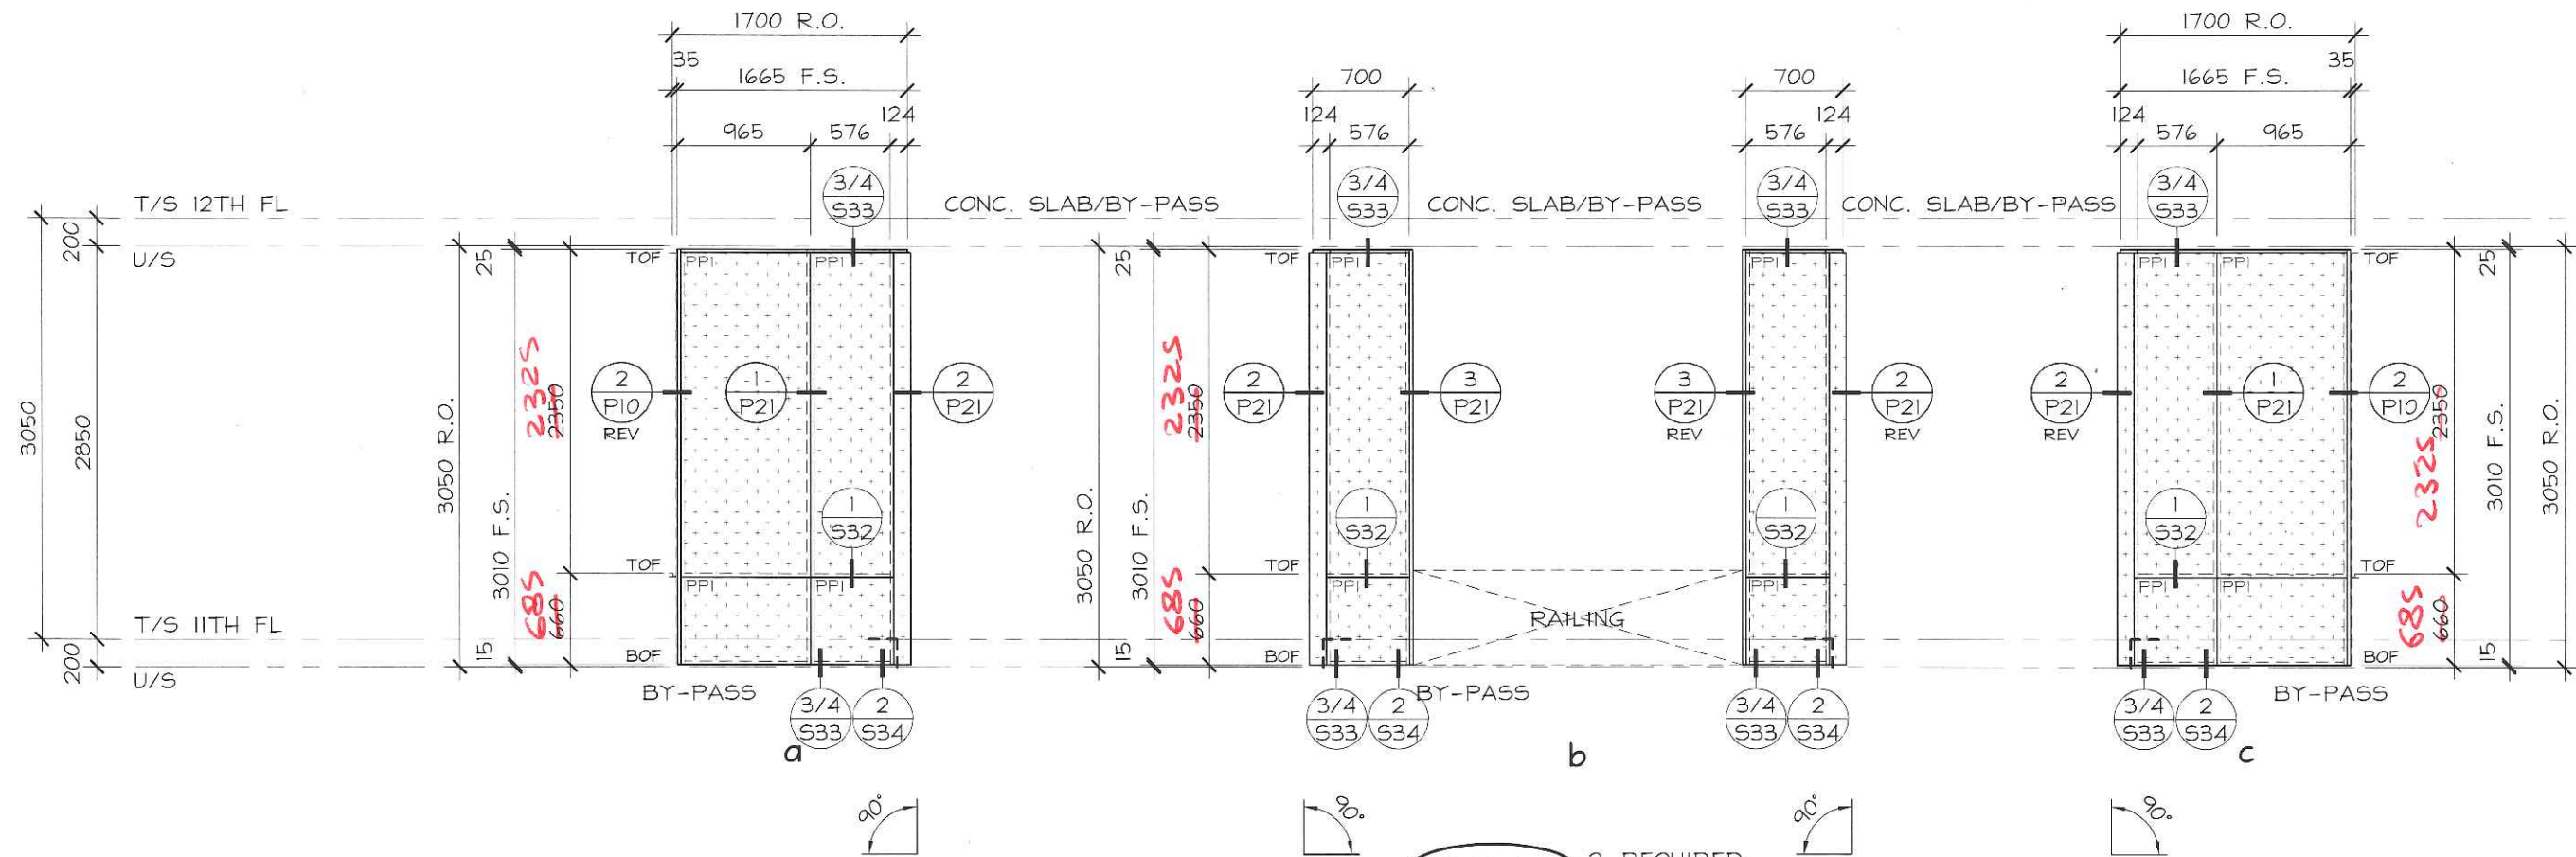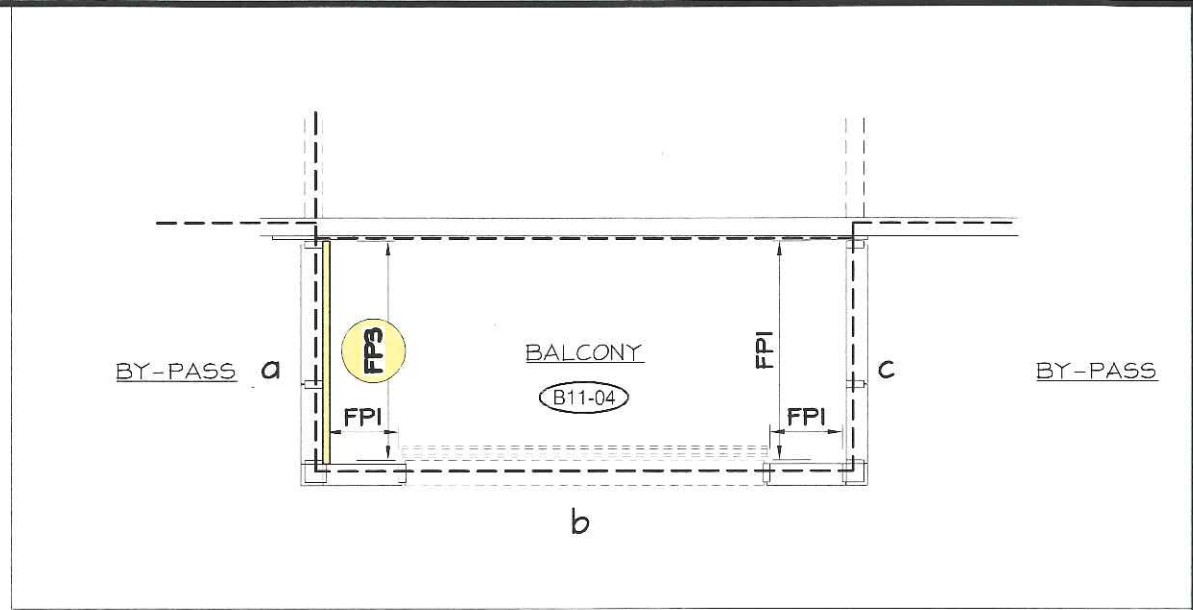

B11-04 2 REQUIRED
2487 SERIES
EXT. FINISH: PPG ACRYNAR PLATINUM UCFX11185
INT. FINISH: PPG ACRYNAR PLATINUM UCFX11185
a INT. FINISH: PPG ACRYNAR T.B.D.



No.	REVISION	BY	DATE

PROJECT NAME:	SQ ALEXANDRA PARK - BLOCK11		
DRAWING TITLE:	11th FLOOR ELEVATIONS		
ARCHITECT:	TEEPLE ARCHITECTS		
CONTRACTOR:	TRIDEL		
SCALE:	1:50	DRAWN BY:	S.C.
DATE:	MARCH 4, 2015		
DRAWING No.:	E11-19		