

Package 13 - Level 12

Teeple Architects INC.


Reviewed
 Reviewed as noted

Revise and resubmit
 Not Reviewed

Date: Aug 9/15

Reviewed by: M. Barton



This review by Teeple Architects Inc. is for the purpose of ascertaining conformance with general design concept. This review shall not mean that Teeple Architects Inc. approves the detailed design inherent in the shop drawings, responsibility for which shall remain with the Contractor submitting same, and such review shall not release the Contractor of the responsibility for errors or omissions in the shop drawings or the responsibility for meeting all requirements of the Contract Documents. The Contractor is responsible for dimensions to be confirmed and correlated at job site, for information that pertains solely to fabrication processes or to techniques of construction and installation, and for coordinating the work of all trades.

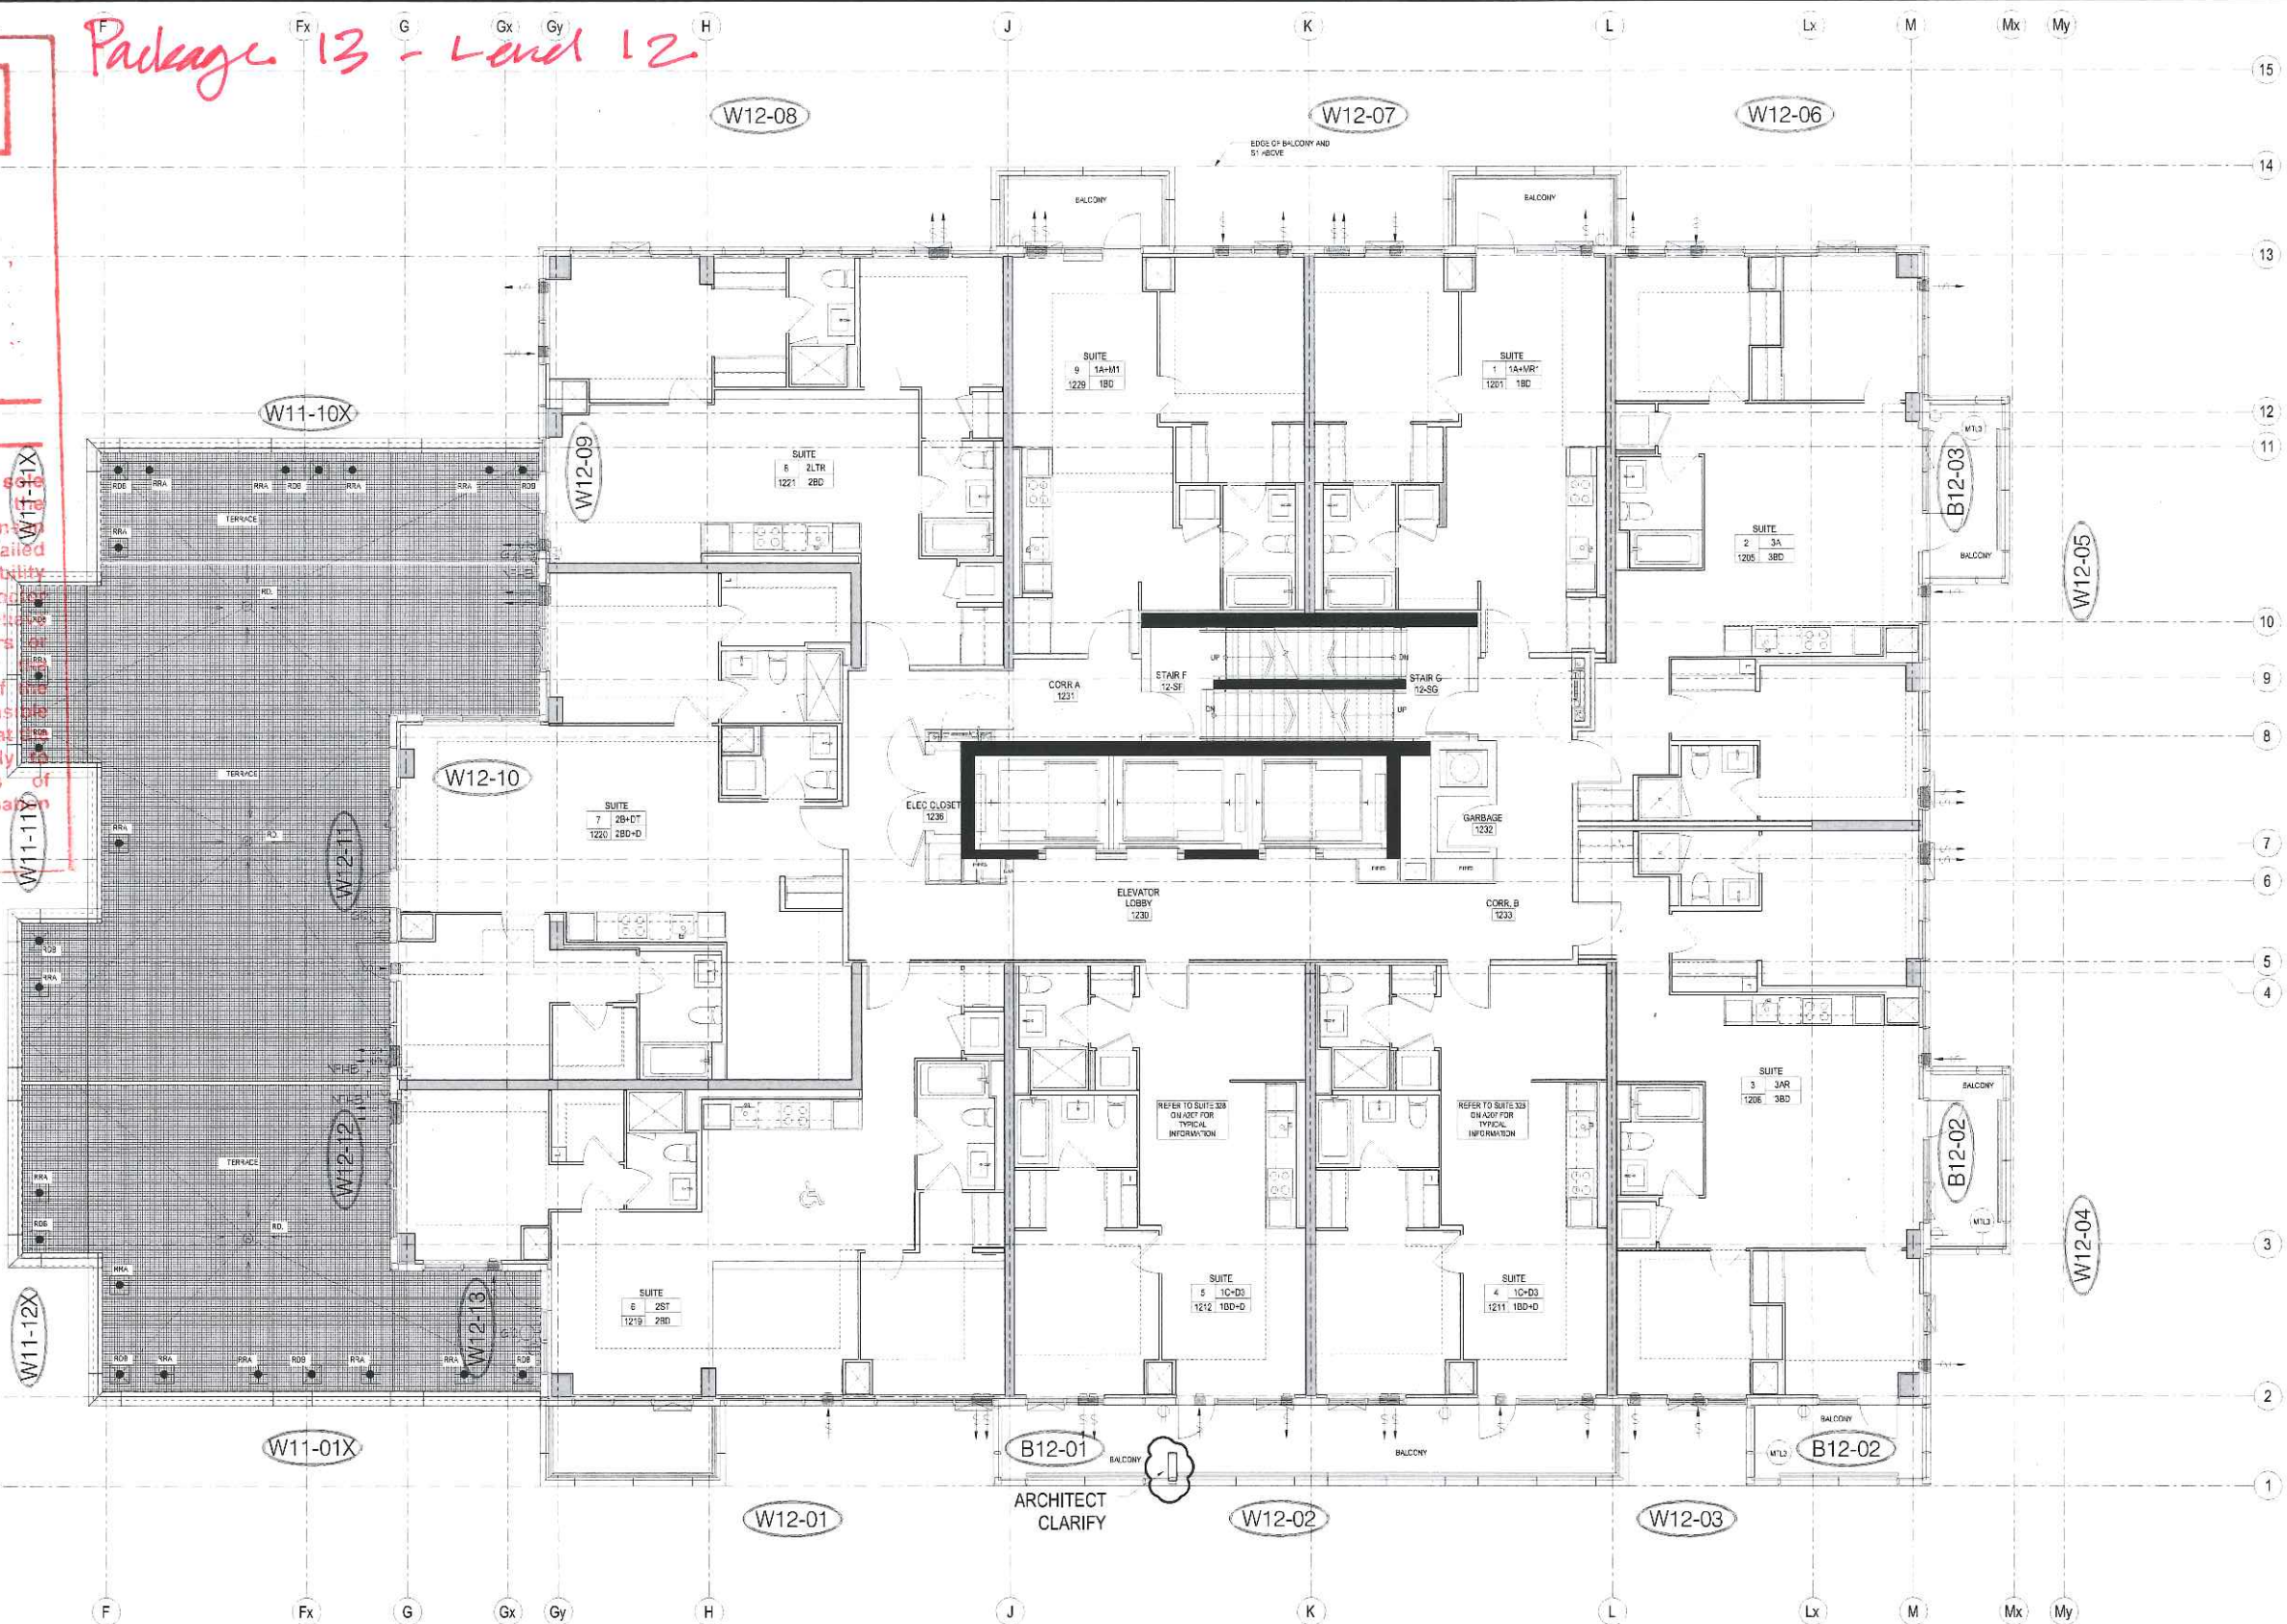

330 APPLEWOOD CRESCENT TEL: (905) 738-5220
 CONCORD, ON, CANADA FAX: (905) 738-5491
 L4K 4V2 WWW.TOROALUMINUM.COM

No.	REVISION	BY	DATE


PROJECT NAME:	SQ ALEXANDRA PARK - BLOCK 11		
DRAWING TITLE:	12th FLOOR PLAN		
ARCHITECT:	TEEPLA ARCHITECTS		
CONTRACTOR:	TRIDEL		
SCALE:	N/T/S	DRAWN BY:	S.C.
DATE:	MARCH 4, 2015		
DRAWING No.			F12

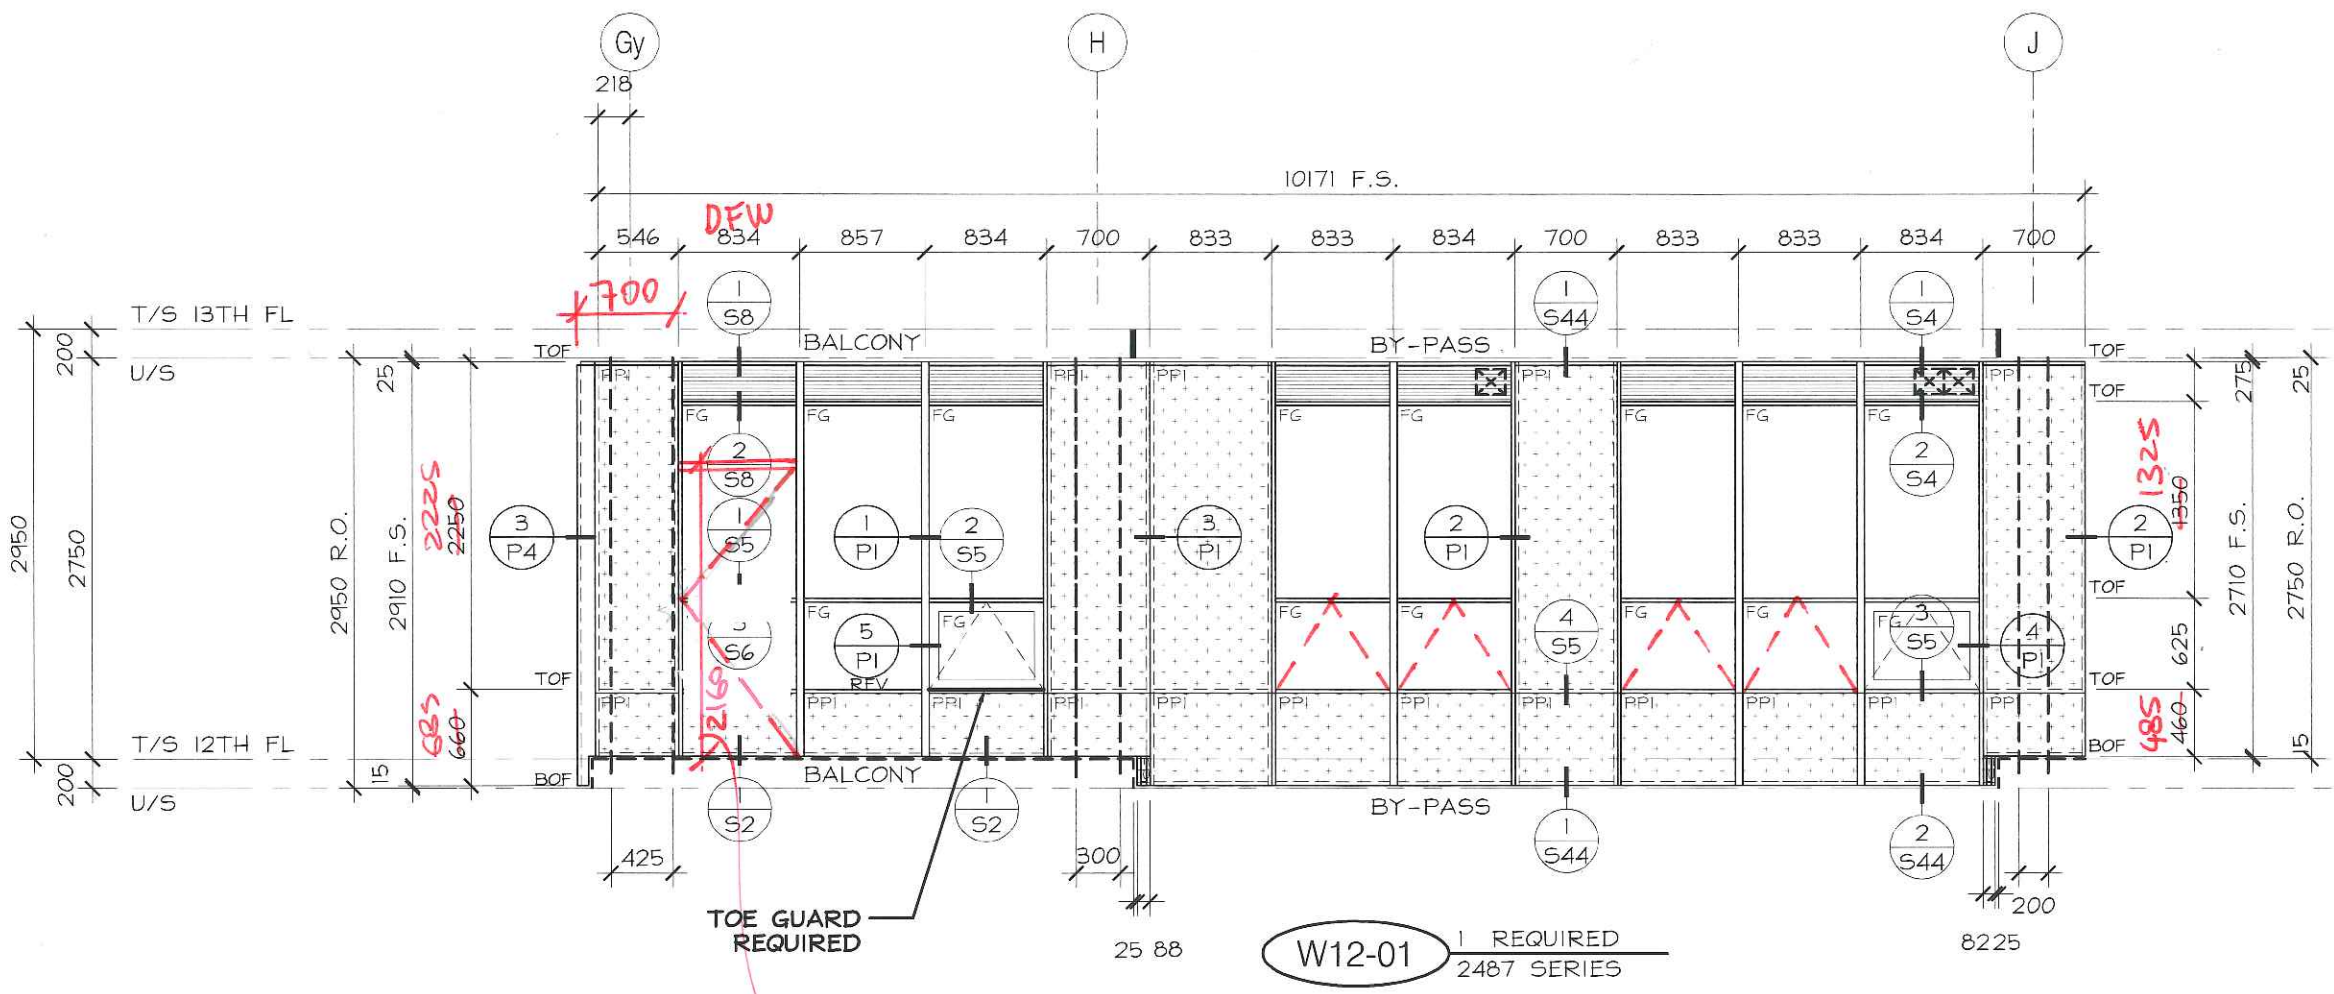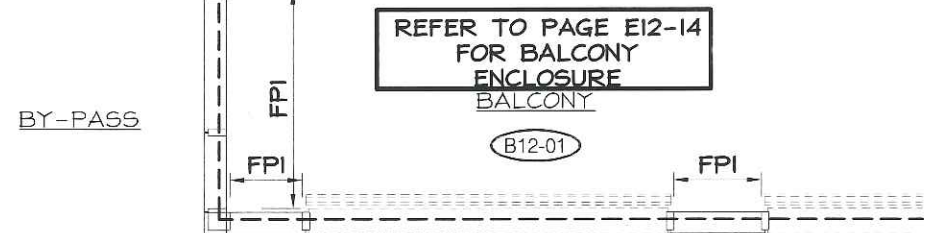

No.	REVISION	BY	DATE

PROJECT NAME:	SQ ALEXANDRA PARK - BLOCK11
DRAWING TITLE:	12th FLOOR ELEVATIONS
ARCHITECT:	TEEPLE ARCHITECTS
CONTRACTOR:	TRIDEL
SCALE:	1:50
DRAWN BY:	S.C.
DATE:	MARCH 4, 2015

DRAWING No.:
E12-1


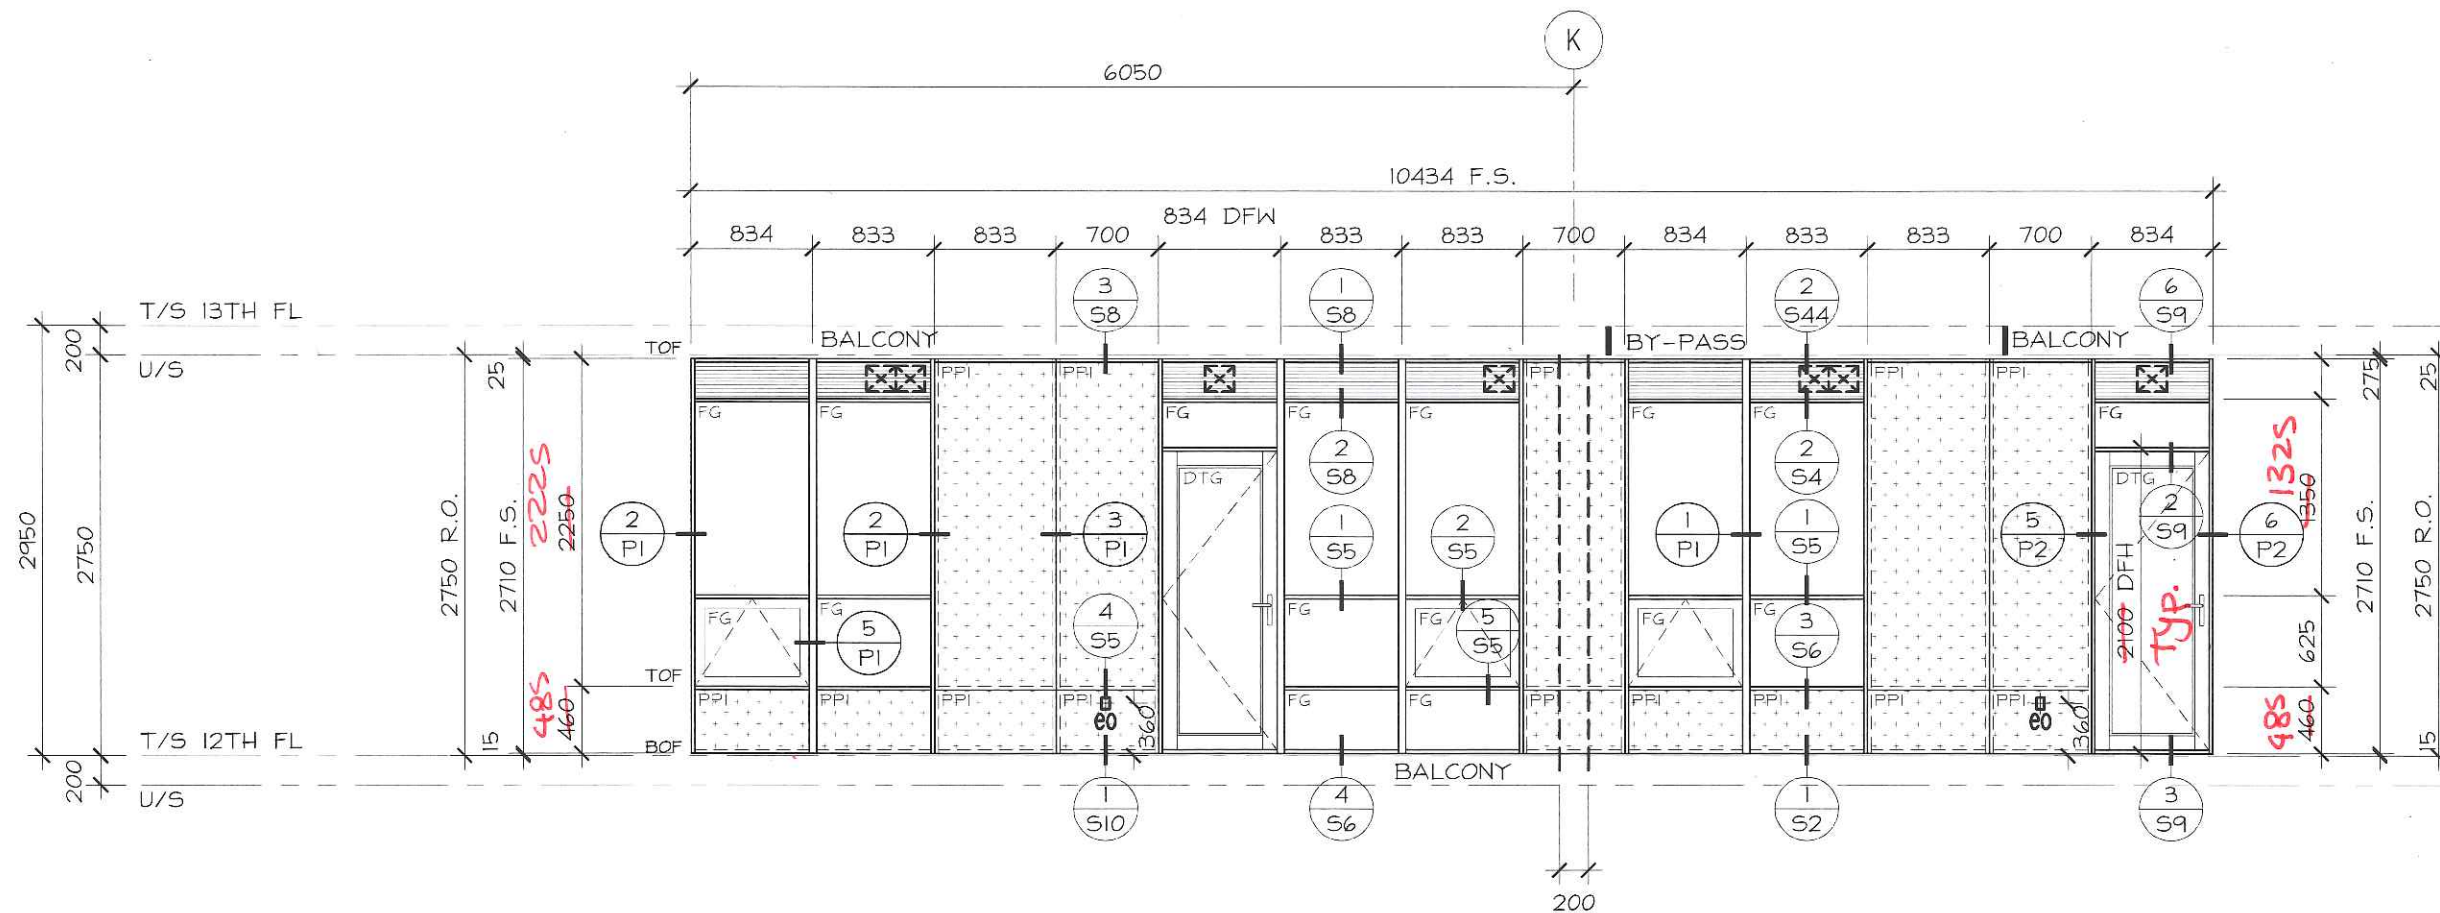


W12-02 1 REQUIRED
2487 SERIES



No.	REVISION	BY	DATE

PROJECT NAME: SQ ALEXANDRA PARK - BLOCK11		DRAWING No.:
DRAWING TITLE: 12th FLOOR ELEVATIONS		
ARCHITECT: TEEPLE ARCHITECTS		E12-2
CONTRACTOR: TRIDEL		
SCALE: 1:50	DRAWN BY: S.C.	DATE: MARCH 4, 2015

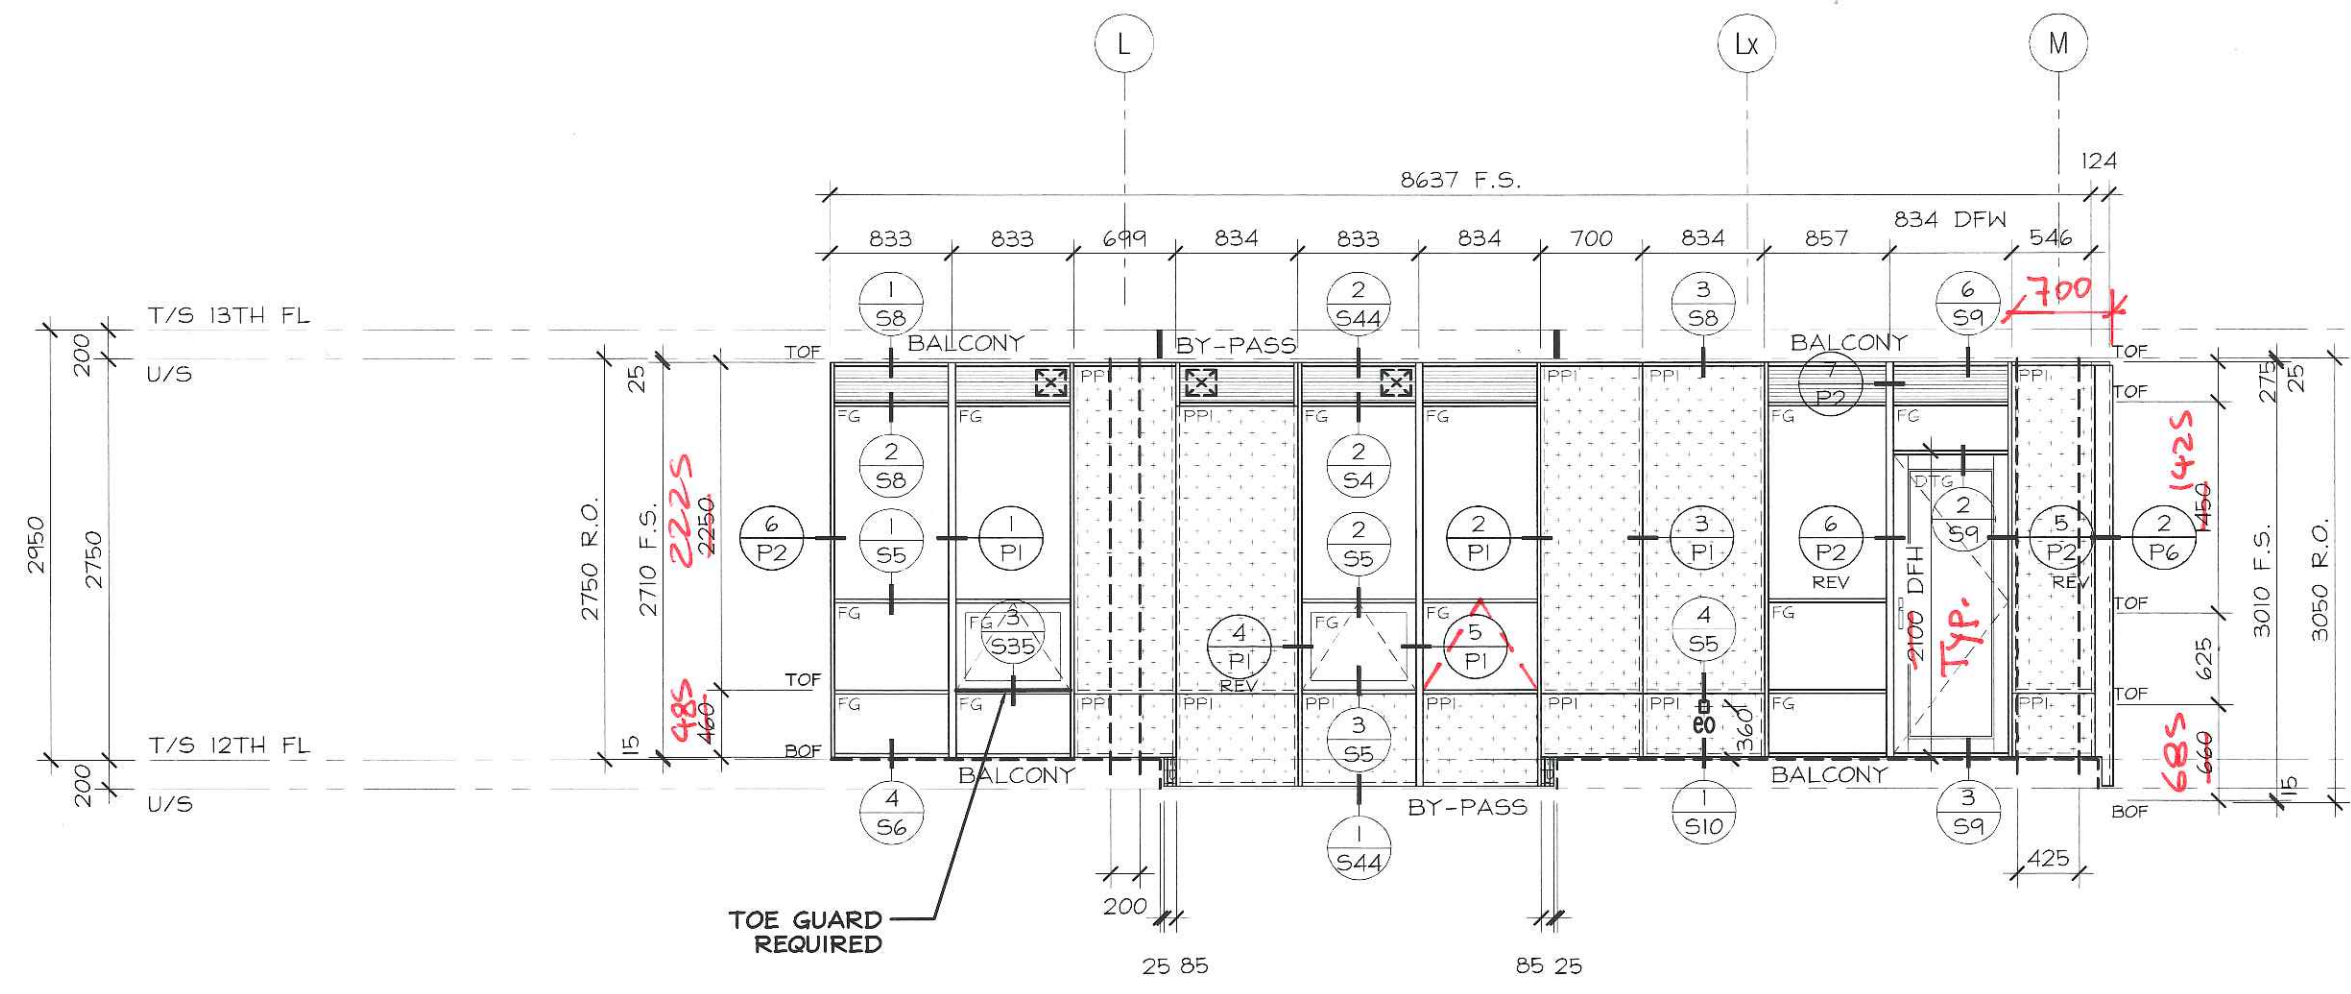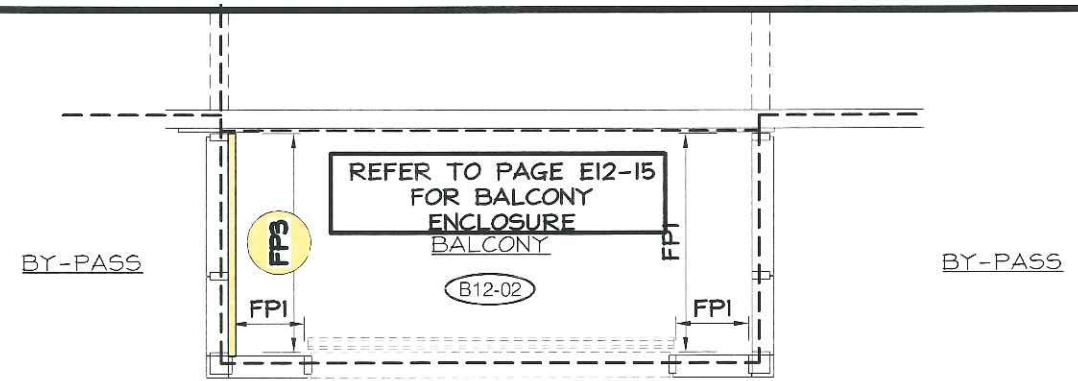

No.	REVISION	BY	DATE

PROJECT NAME:	SQ ALEXANDRA PARK - BLOCK11		
DRAWING TITLE:	12th FLOOR ELEVATIONS		
ARCHITECT:	TEEPLE ARCHITECTS		
CONTRACTOR:	TRIDEL		
SCALE:	1:50	DRAWN BY:	S.C.
DATE:	MARCH 4, 2015		

DRAWING No.:
E12-3

REFER TO PAGE E12-15
FOR BALCONY
ENCLOSURE
BALCONY

BY-PASS

BY-PASS

B12-02

FPS

FPI

FPI

2

3

4

5

6

7

11960 R.O.

11836 F.S.

834 DFW

T/S 13TH FL

U/S

TOF

BY-PASS

BALCONY

BY-PASS

TOF

200

2950

200

T/S 12TH FL

U/S

BOF

BY-PASS

BALCONY

BY-PASS

BOF

2950

2910

2225

2250

685

660

1325

1350

685

660

2910 F.S.

2950 R.O.

124

546

834

833

833

700

888

888

834 DFW

700

834

746

700

834

833

833

1 S44

3 S8

6 S9

2 S44

2 P6

1 P1

2 P1

4 S5

2 S8

2 S5

6 P2 REV

2 S9

5 P2 REV

3 P1

2 S4

2 S5

2 P1

4 S5

5 P1

3 S9

3 S6

475

1 S44

4 S6

3 S9

1 S44

99 25

600

25 70

W12-04

1 REQUIRED
2487 SERIES

BREAK SHAPE FILLER
ATTACHING TO VERTICAL
MULLION




TORO ALUMINUM
COMMERCIAL INDUSTRIAL RESIDENTIAL
330 APPLEWOOD CRESCENT TEL: (905) 738-5220
CONCORD, ON, CANADA FAX: (905) 738-5481
L4K 4V2 WWW.TOROALUMINUM.COM



LICENSED PROFESSIONAL ENGINEER
06-27-15
D.T. PROHASKA
37549017
PROVINCE OF ONTARIO

No.	REVISION	BY	DATE


PROJECT NAME:	SQ ALEXANDRA PARK - BLOCK 11		
DRAWING TITLE:	12th FLOOR ELEVATIONS		
ARCHITECT:	TEEPLE ARCHITECTS		
CONTRACTOR:	TRIDEL		
SCALE:	1:50	DRAWN BY:	S.C.
DATE:	MARCH 4, 2015		
DRAWING No.:	E12-4		

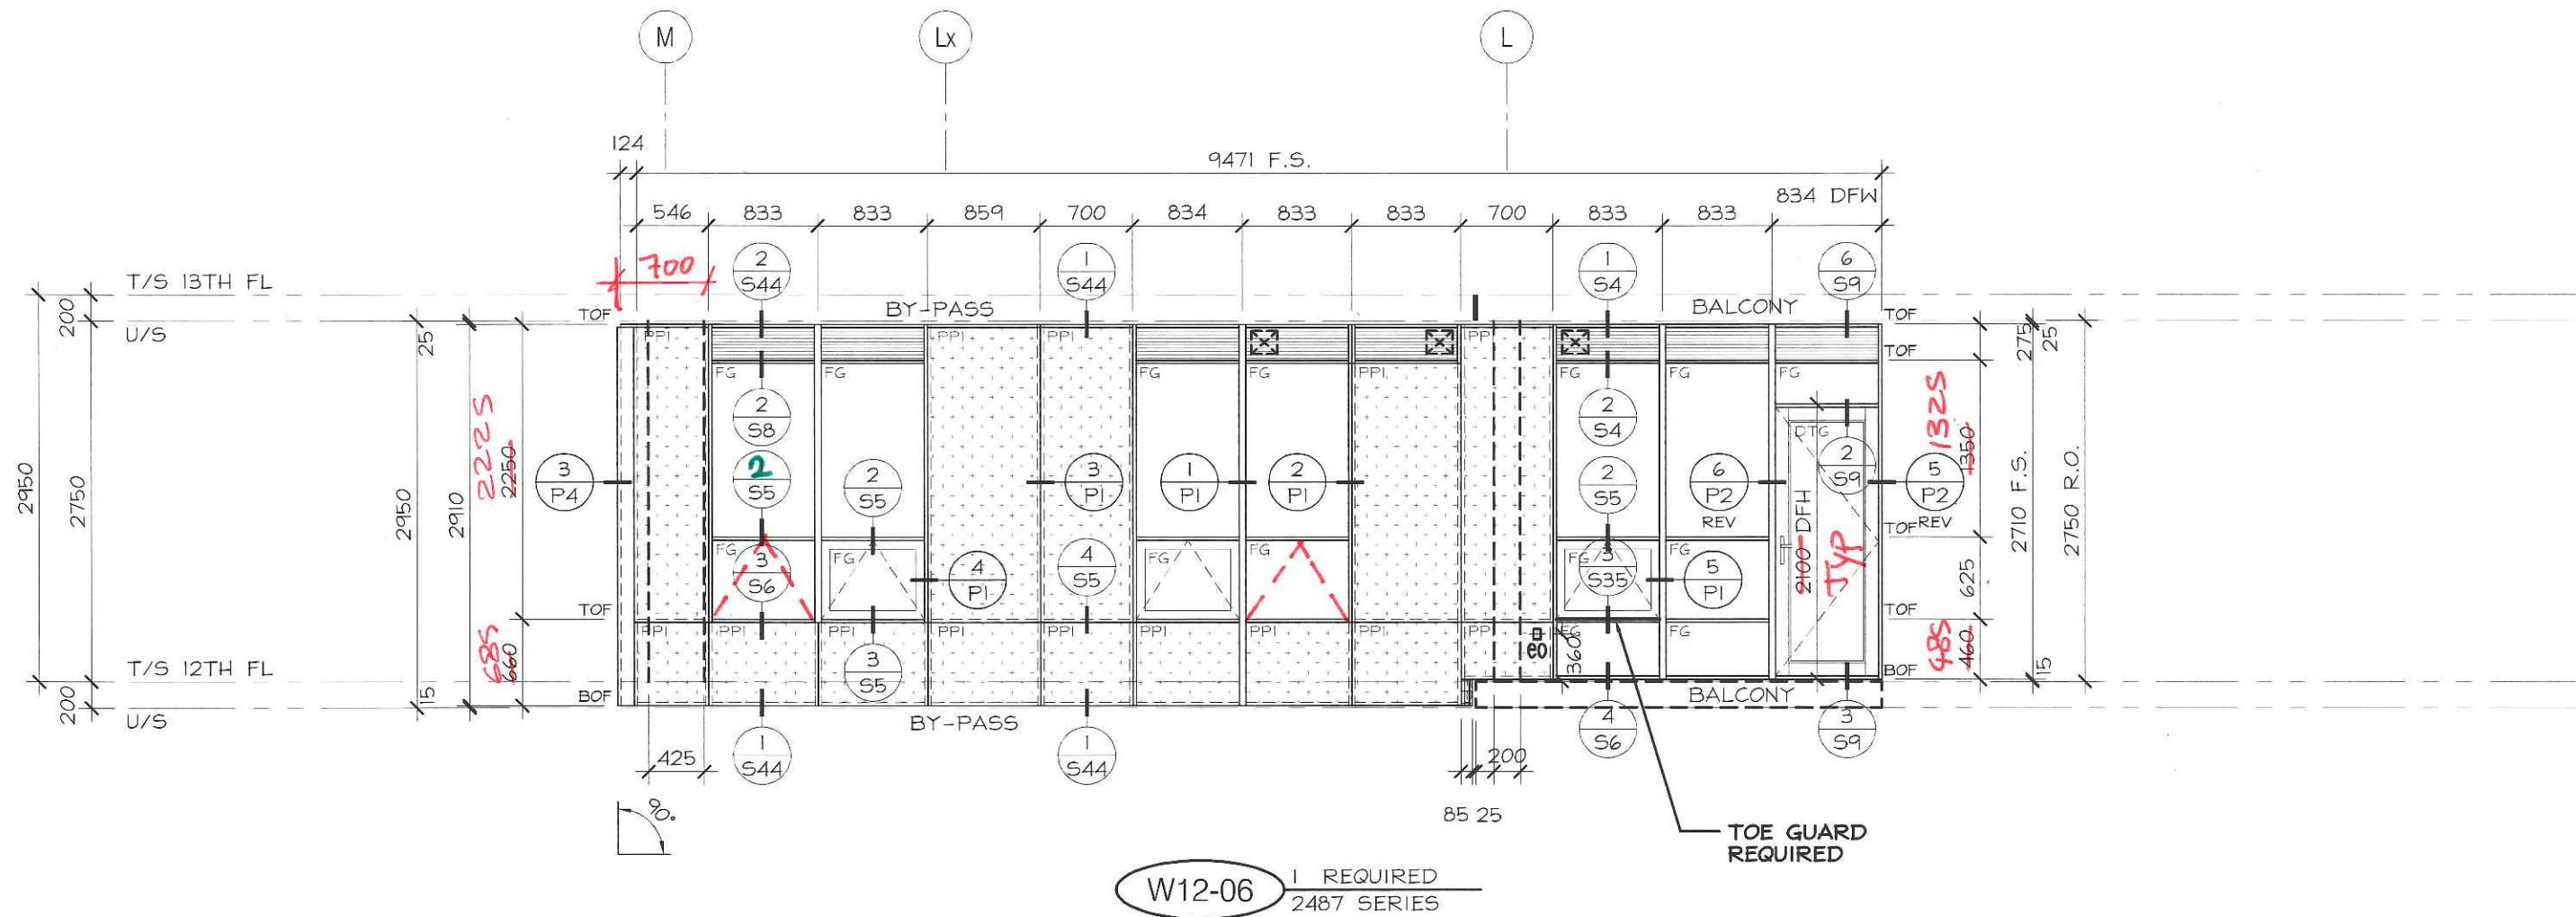

No.	REVISION	BY	DATE

PROJECT NAME:	SQ ALEXANDRA PARK - BLOCK11
DRAWING TITLE:	12th FLOOR ELEVATIONS
ARCHITECT:	TEEPLE ARCHITECTS
CONTRACTOR:	TRIDEL
SCALE:	1:50
DRAWN BY:	S.C.
DATE:	MARCH 4, 2015


DRAWING No.:
E12-6

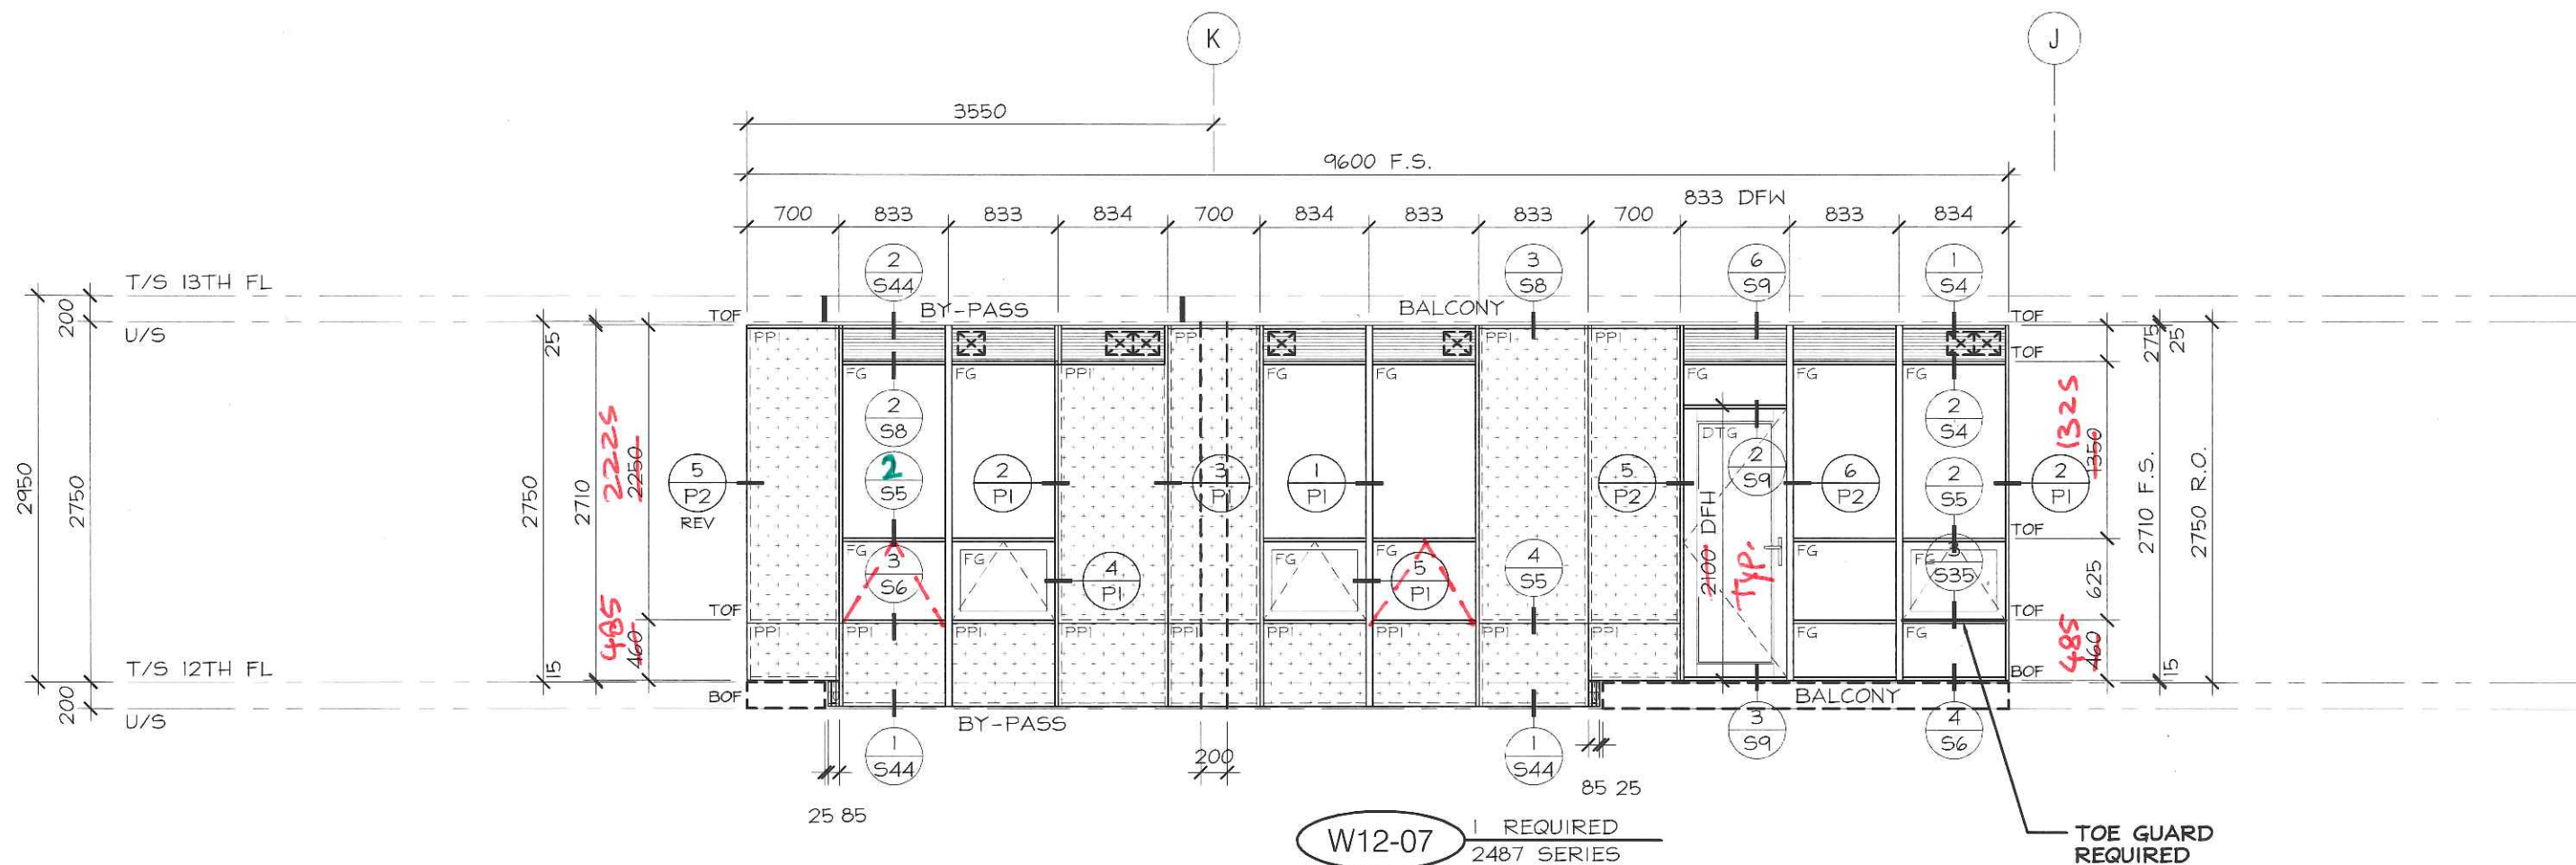

No.	REVISION	BY	DATE

PROJECT NAME: SQ ALEXANDRA PARK - BLOCK 11
 DRAWING TITLE: 12th FLOOR ELEVATIONS
 ARCHITECT: TEEPLE ARCHITECTS
 CONTRACTOR: TRIDEL
 SCALE: 1:50
 DRAWN BY: S.C.
 DATE: MARCH 4, 2015


DRAWING No.:
E12-7

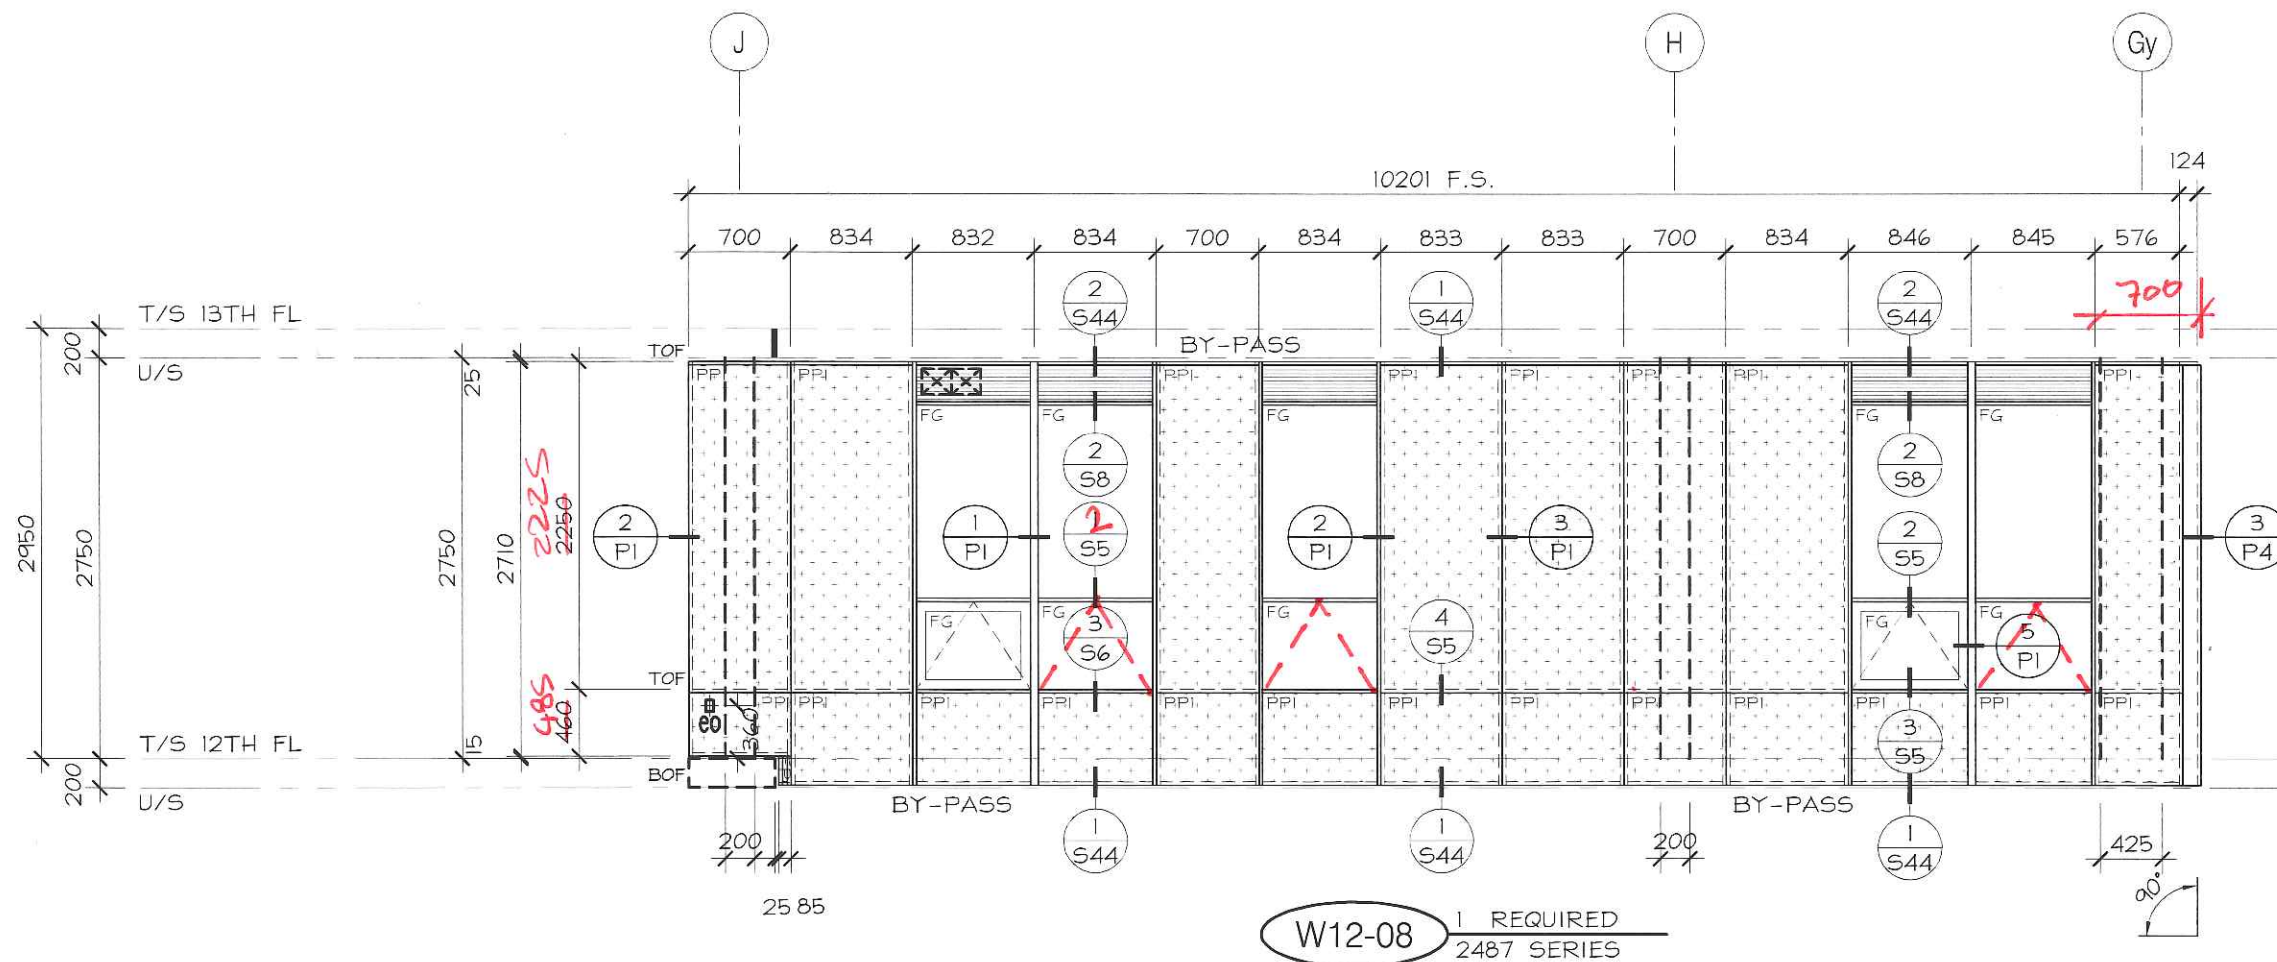

No.	REVISION	BY	DATE

PROJECT NAME: SQ ALEXANDRA PARK - BLOCK11
 DRAWING TITLE: 12th FLOOR ELEVATIONS
 ARCHITECT: TEEPLE ARCHITECTS
 CONTRACTOR: TRIDEL
 SCALE: 1:50
 DRAWN BY: S.C.
 DATE: MARCH 4, 2015

DRAWING No.:
E12-8

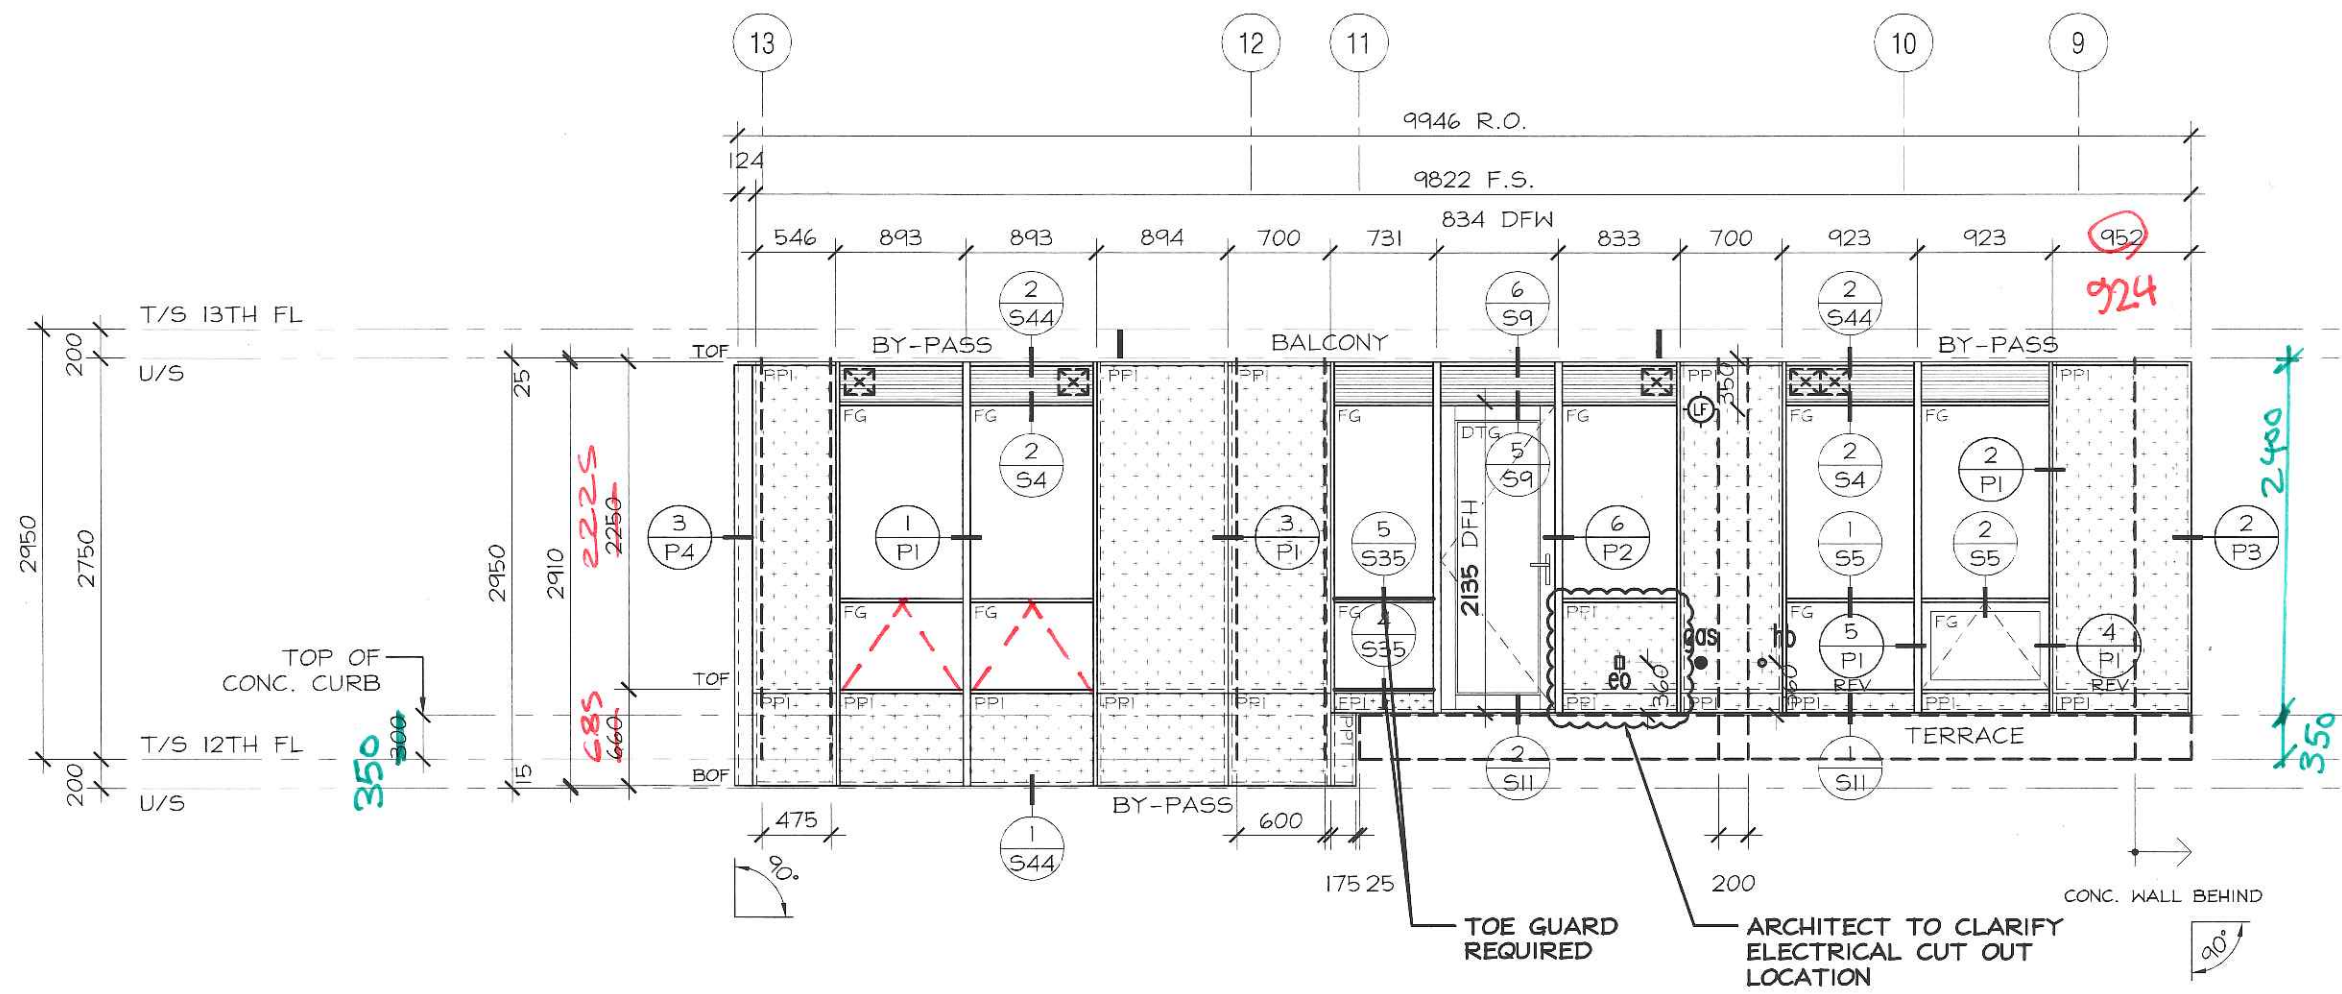

W12-09 1 REQUIRED
2487 SERIES



TORO ALUMINUM
 COMMERCIAL INDUSTRIAL RESIDENTIAL
 330 APPLEWOOD CRESCENT TEL: (905) 738-5220
 CONCORD, ON, CANADA FAX: (905) 738-5481
 L4K 4V2 WWW.TOROALUMINUM.COM

LICENSED PROFESSIONAL ENGINEER
 06-27-15
 D.T. PROHASKA
 37549011
 PROVINCE OF ONTARIO

No.	REVISION	BY	DATE



PROJECT NAME:	SQ ALEXANDRA PARK - BLOCK 11
DRAWING TITLE:	12th FLOOR ELEVATIONS
ARCHITECT:	TEEPLE ARCHITECTS
CONTRACTOR:	TRIDEL
SCALE:	1:50
DRAWN BY:	S.C.
DATE:	MARCH 4, 2015

DRAWING No.:
E12-9

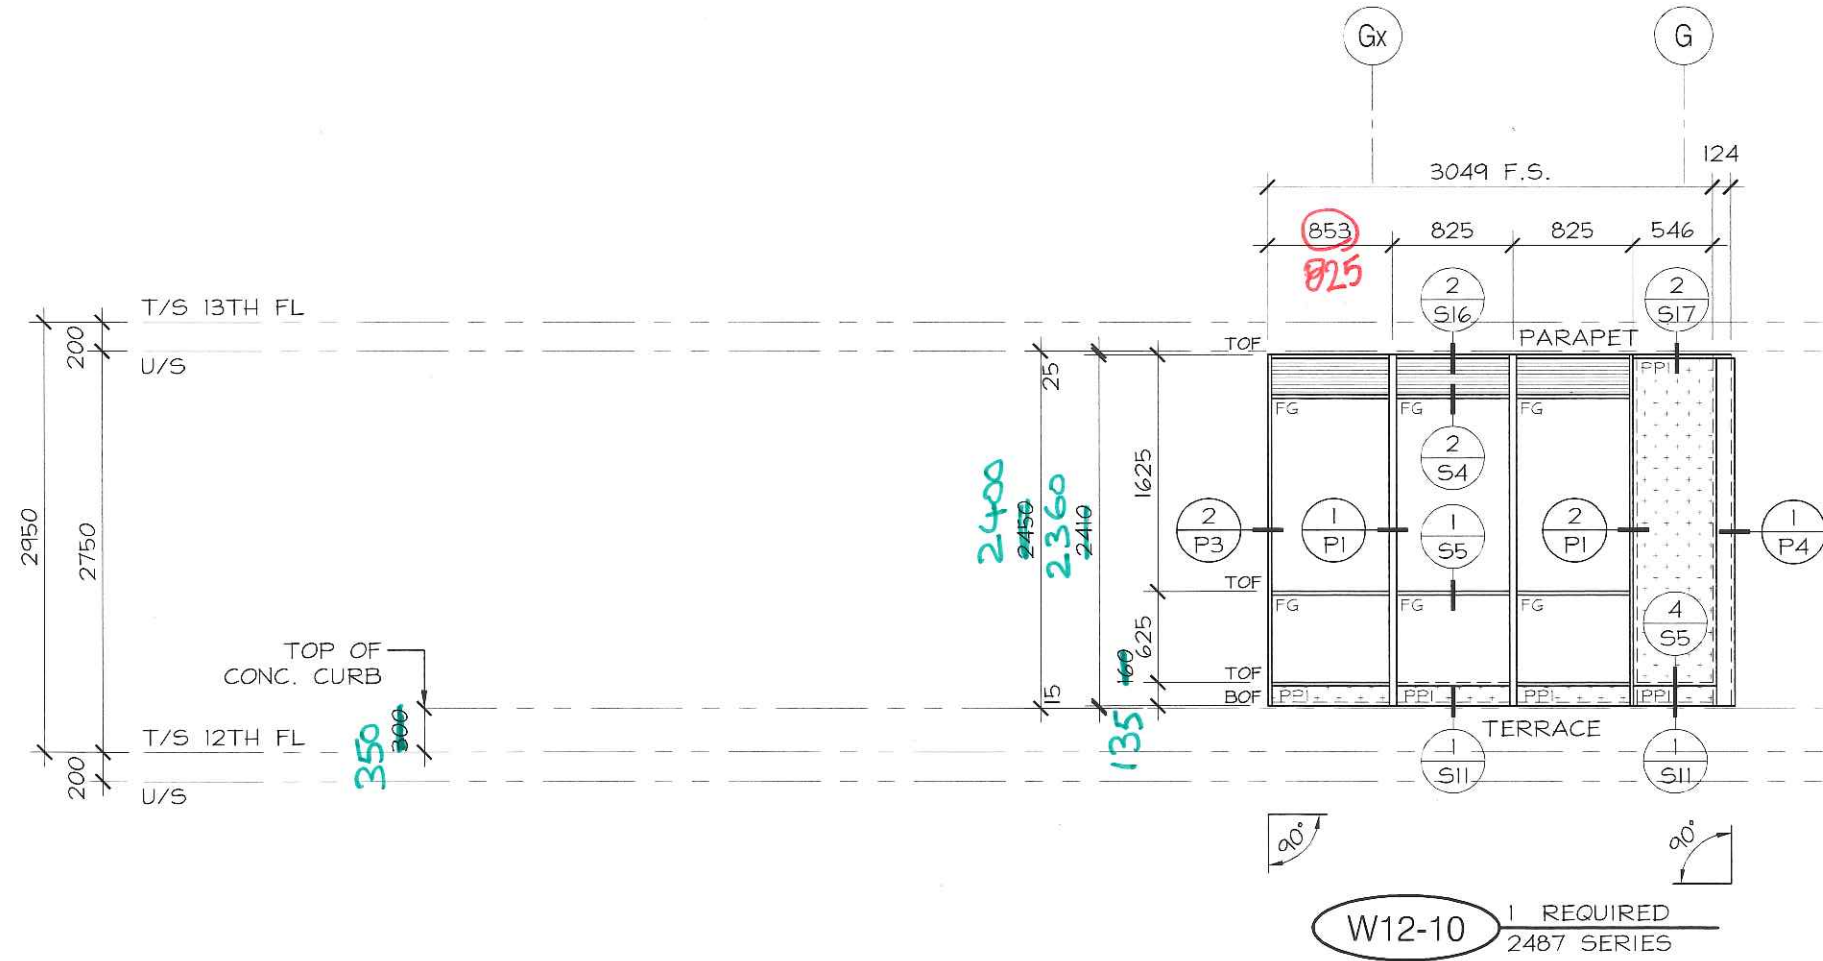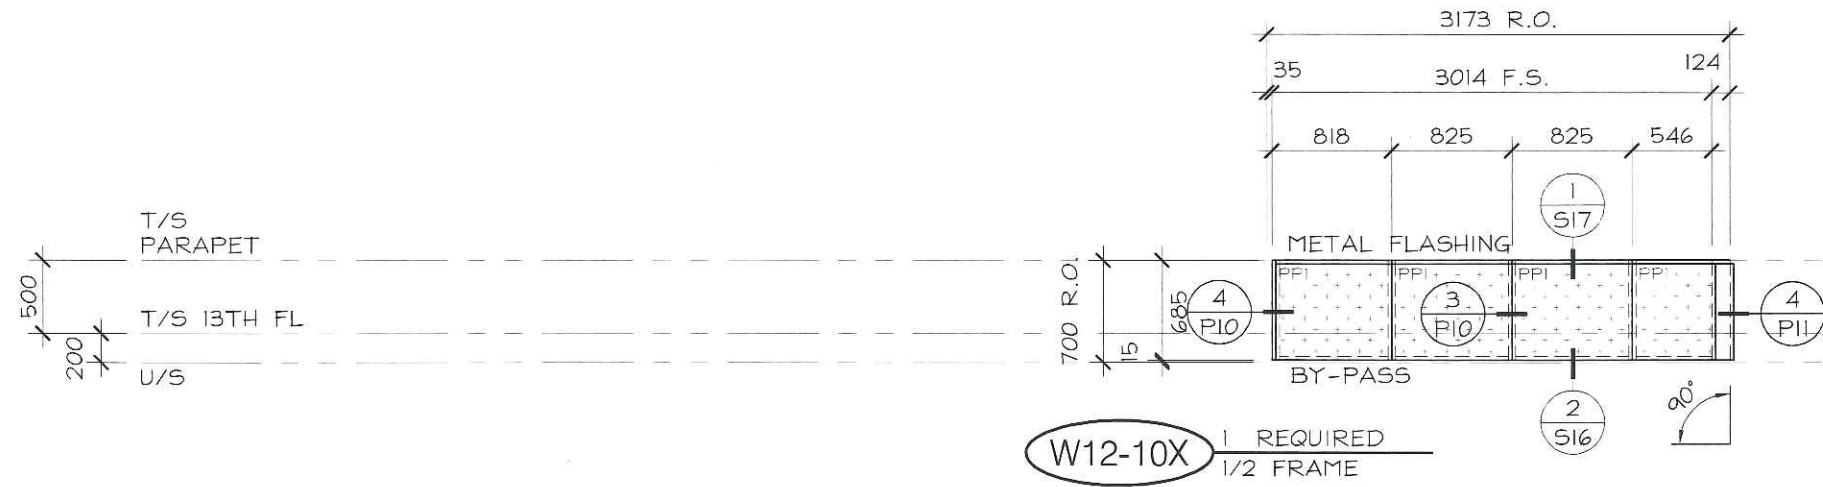



No.	REVISION	BY	DATE

PROJECT NAME: SQ ALEXANDRA PARK - BLOCK11	
DRAWING TITLE: 12th FLOOR ELEVATIONS	
ARCHITECT: TEEPLE ARCHITECTS	DRAWING No.: E12-10
CONTRACTOR: TRIDEL	SCALE: 1:50
DRAWN BY: S.C.	DATE: MARCH 4, 2015

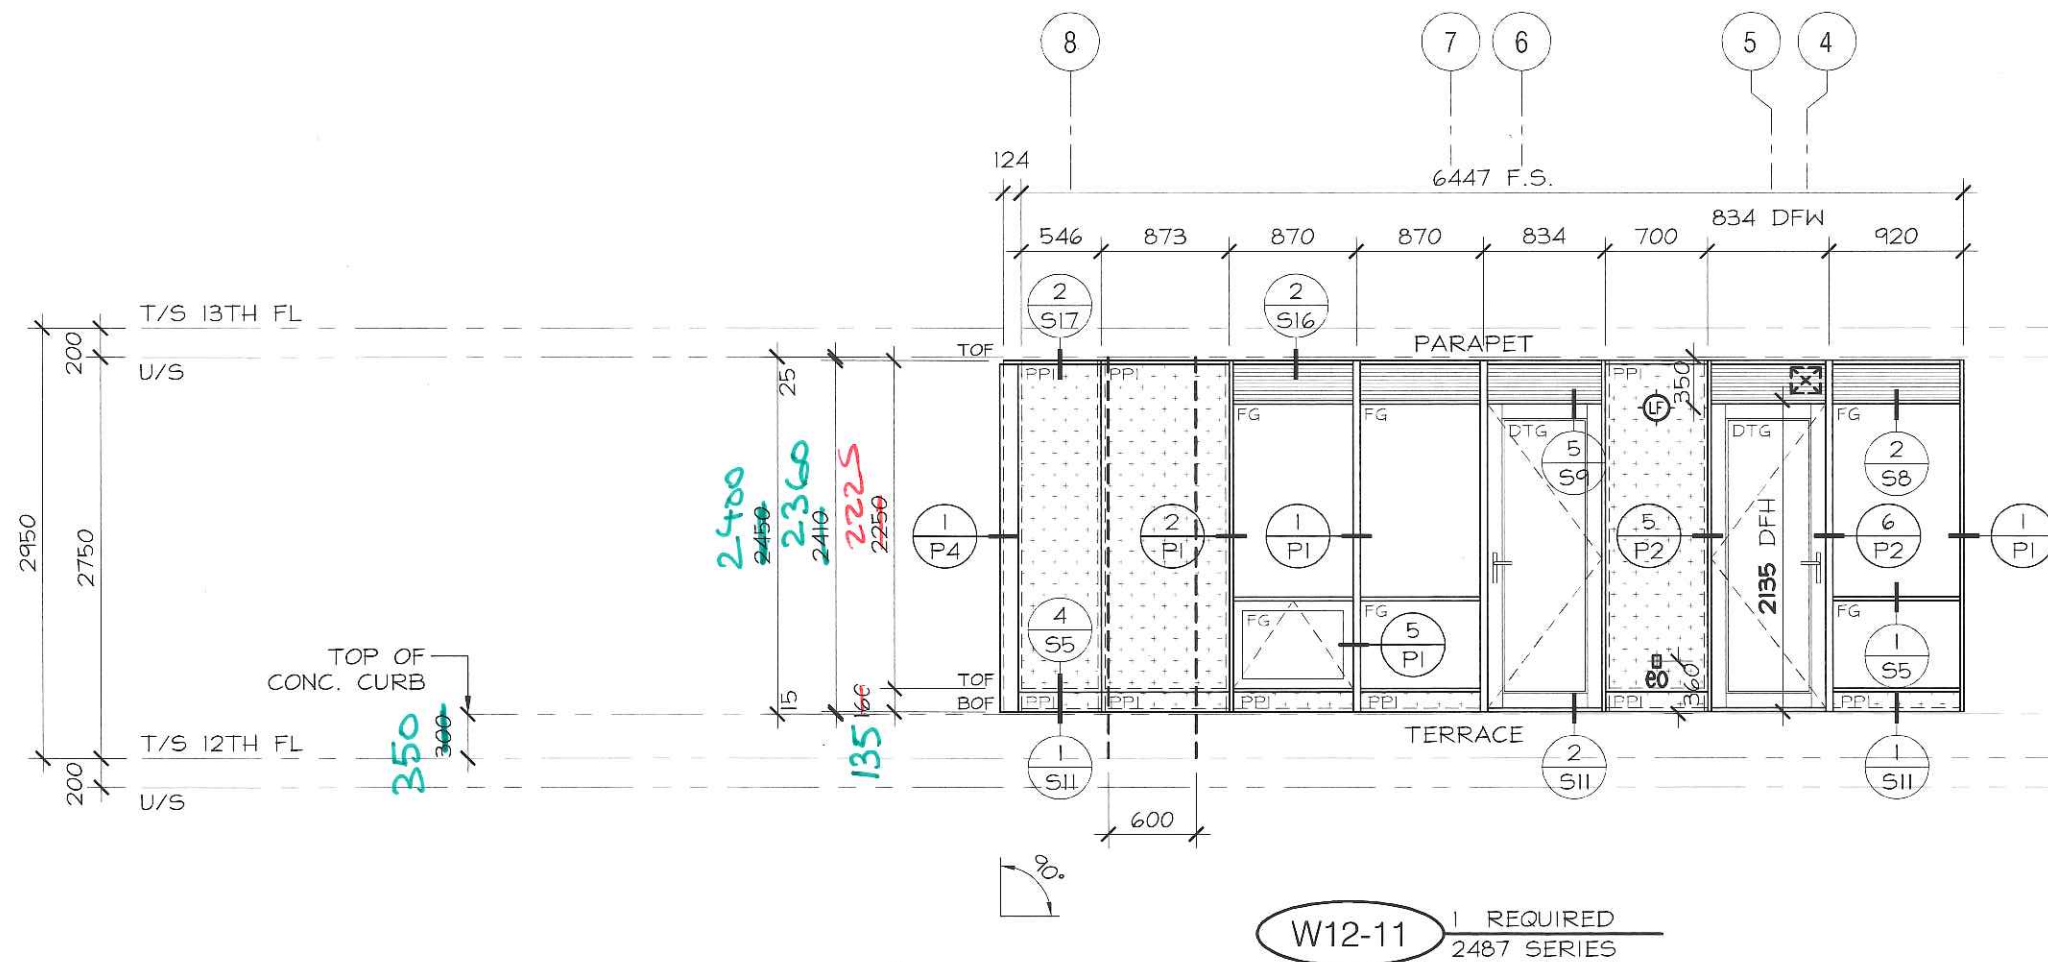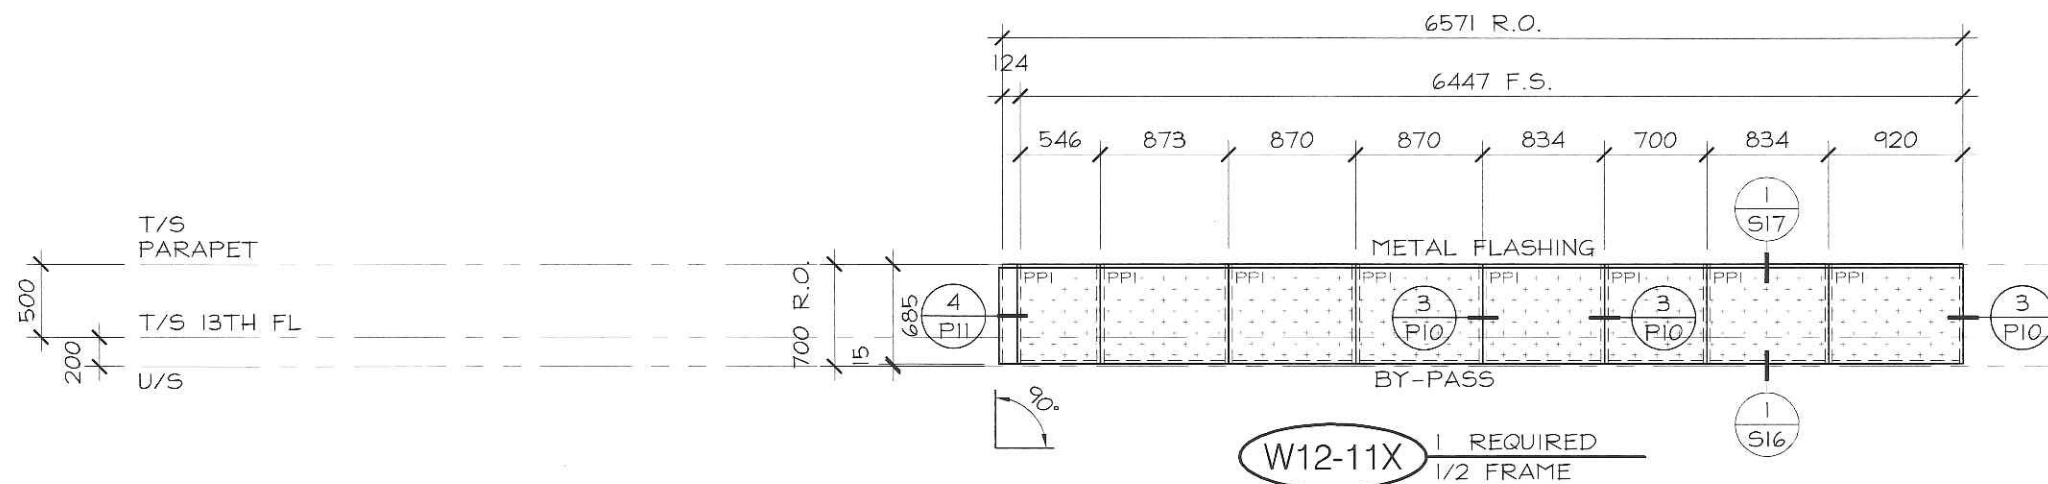


No.	REVISION	BY	DATE

PROJECT NAME: SQ ALEXANDRA PARK - BLOCK11		DRAWING No.: E12-11
DRAWING TITLE: 12th FLOOR ELEVATIONS		
ARCHITECT: TEEPLE ARCHITECTS		DATE: MARCH 4, 2015
CONTRACTOR: TRIDEL		
SCALE: 1:50	DRAWN BY: S.C.	

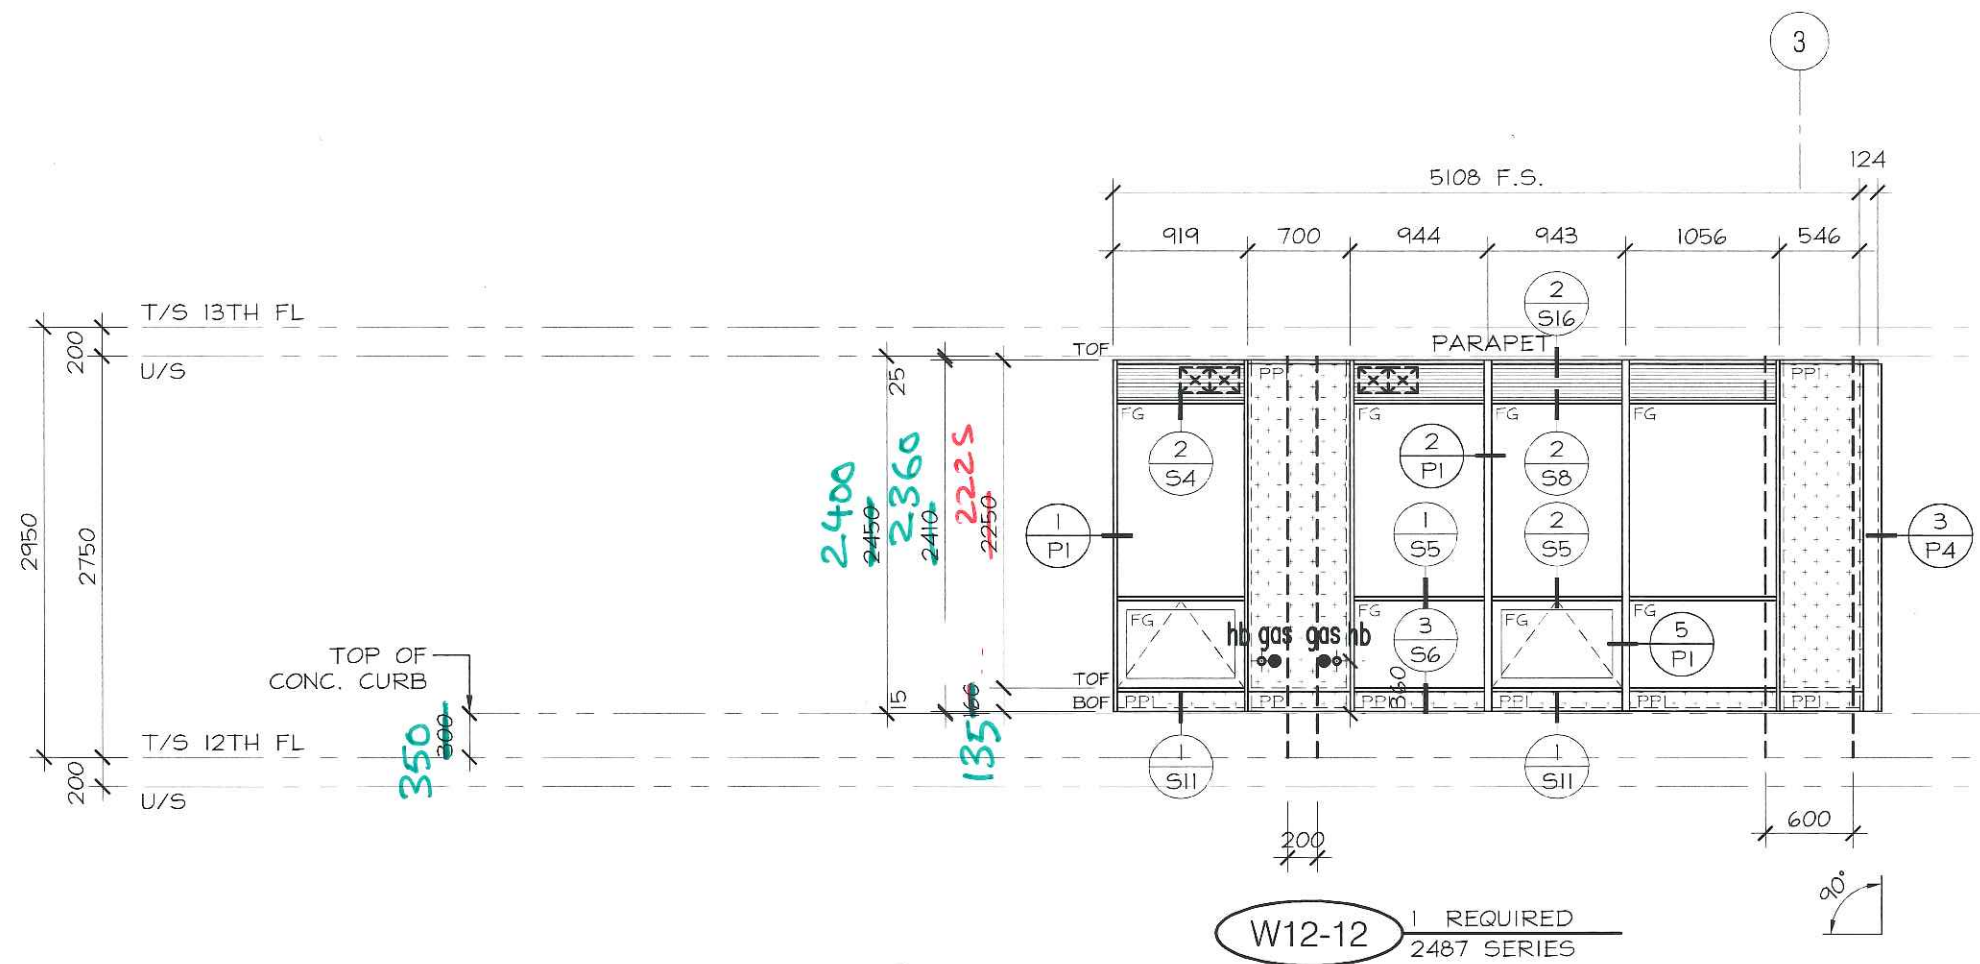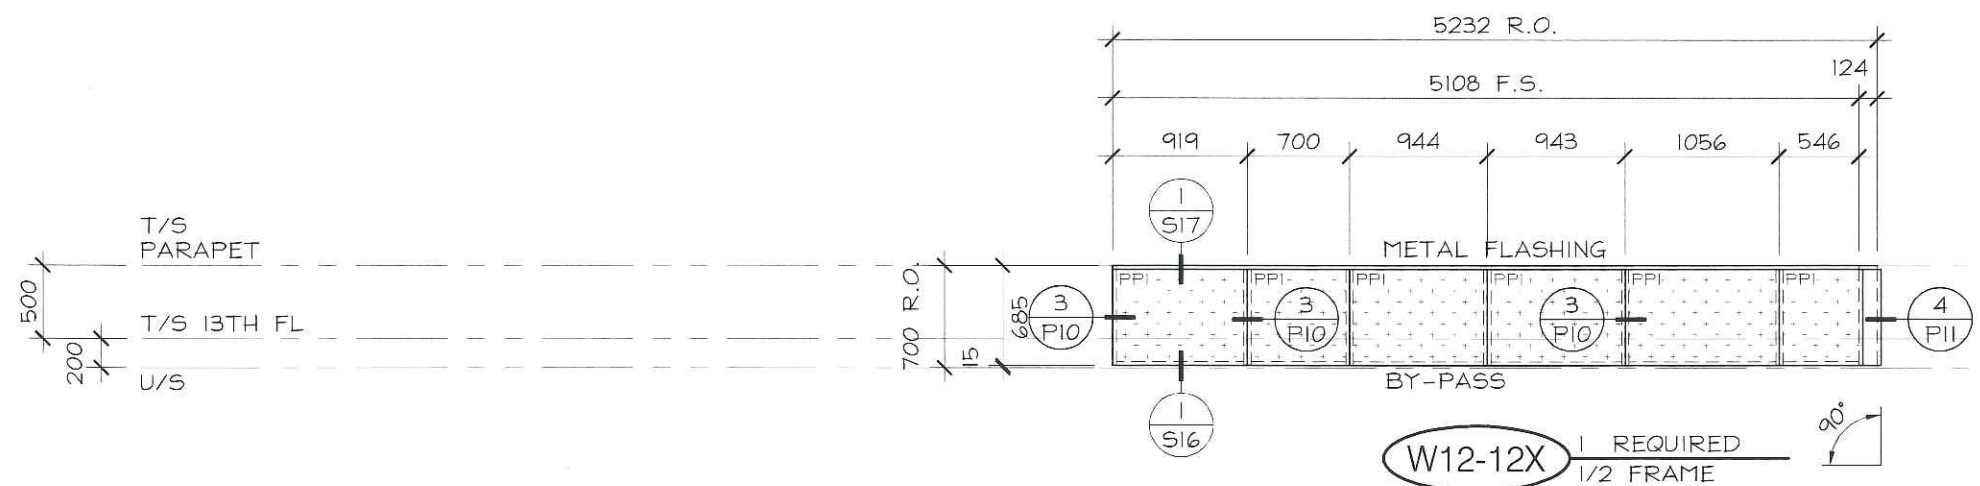

No.	REVISION	BY	DATE



PROJECT NAME: SQ ALEXANDRA PARK - BLOCK11	
DRAWING TITLE: 12th FLOOR ELEVATIONS	
ARCHITECT: TEEPLE ARCHITECTS	DRAWING No.: E12-12
CONTRACTOR: TRIDEL	SCALE: 1:50
DRAWN BY: S.C.	DATE: MARCH 4, 2015

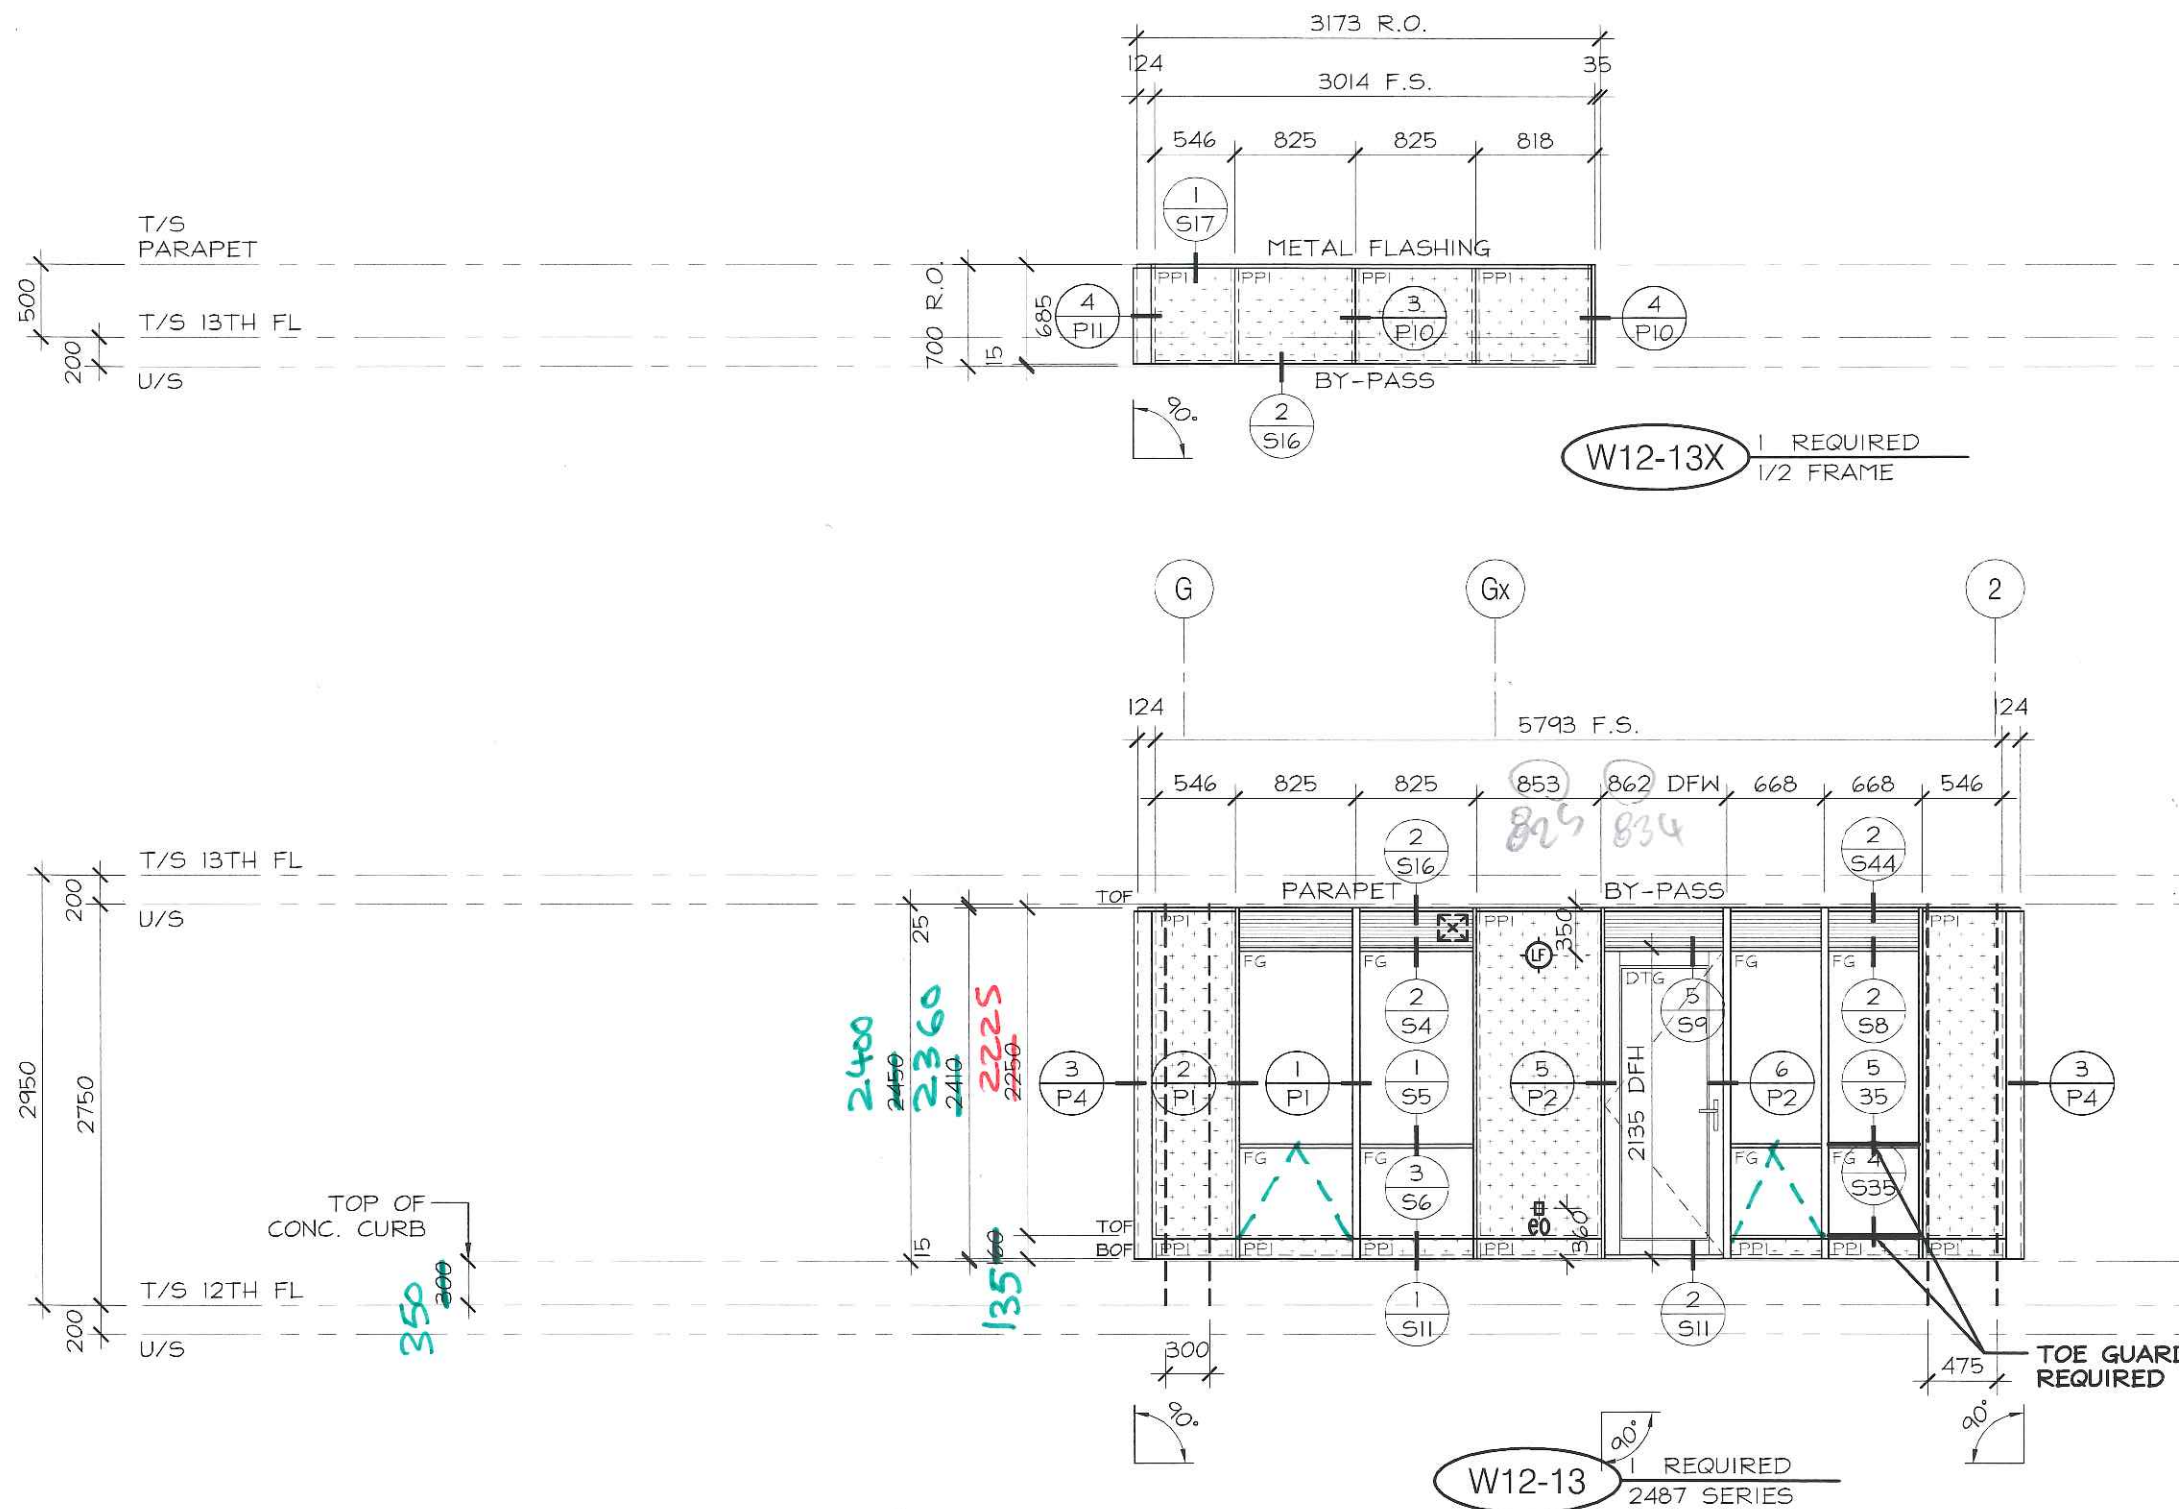

No.	REVISION	BY	DATE

PROJECT NAME: SQ ALEXANDRA PARK - BLOCK 11	
DRAWING TITLE: 12th FLOOR ELEVATIONS	
ARCHITECT: TEEPLE ARCHITECTS	DRAWING No.: E12-13
CONTRACTOR: TRIDEL	SCALE: 1:50
DRAWN BY: S.C.	DATE: MARCH 4, 2015

FOR ALUMINUM BALCONY
& TERRACE RAILINGS
REFER TO TORO
ALUMINUM RAILING SHOP
DRAWINGS

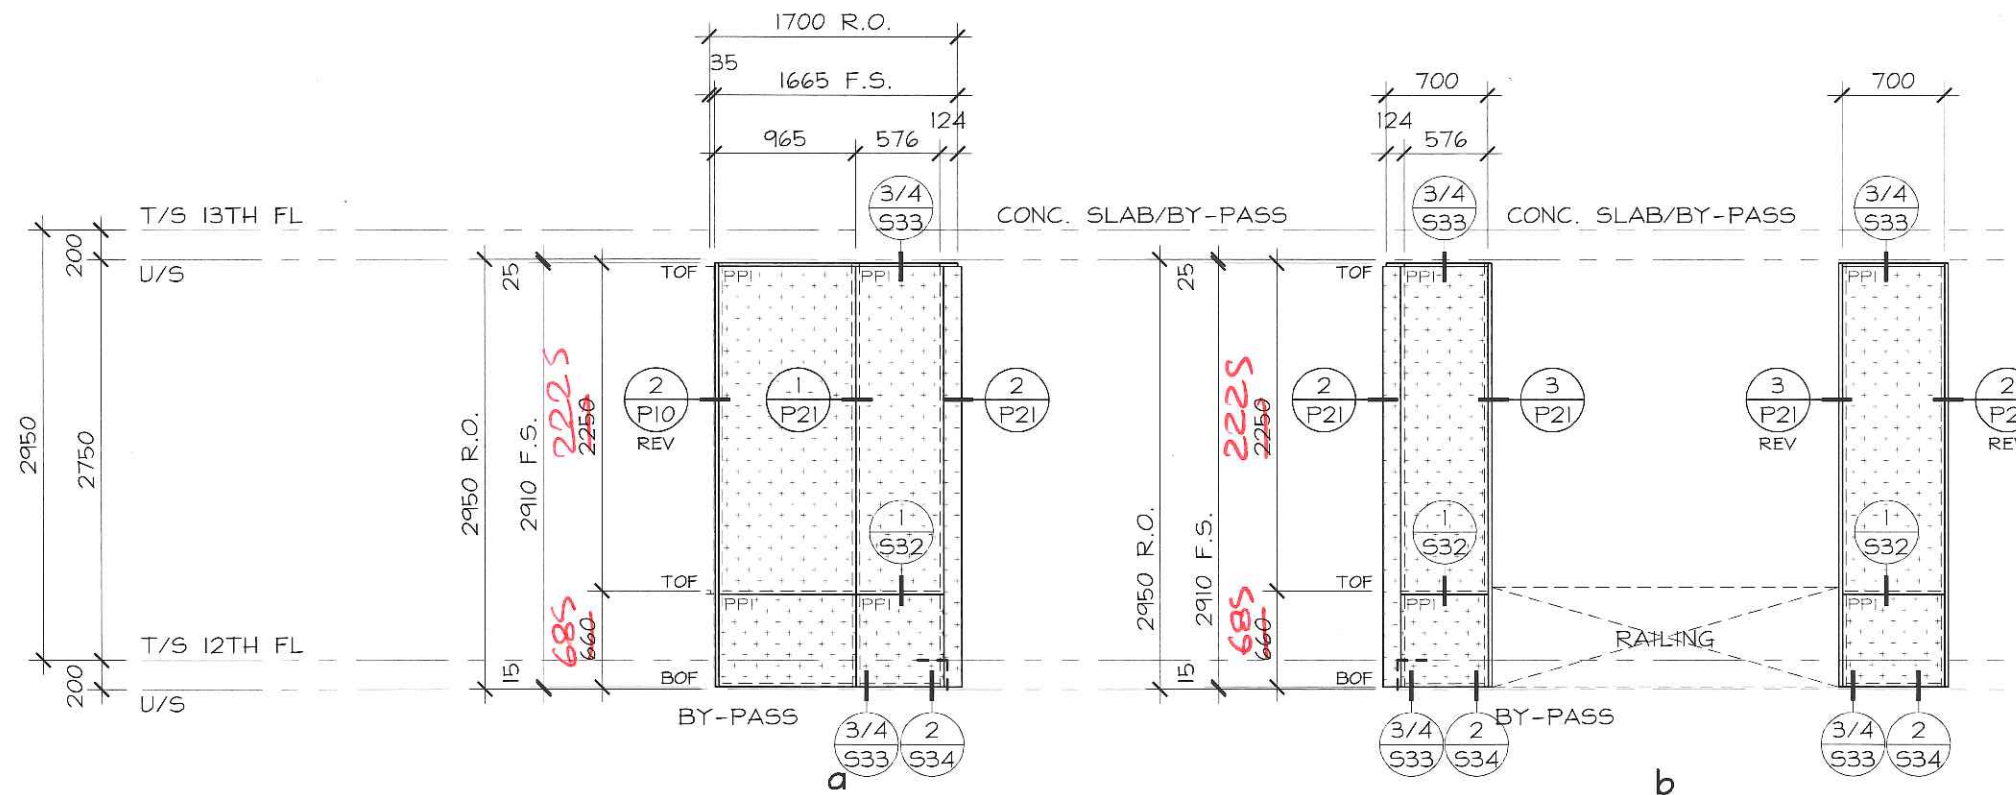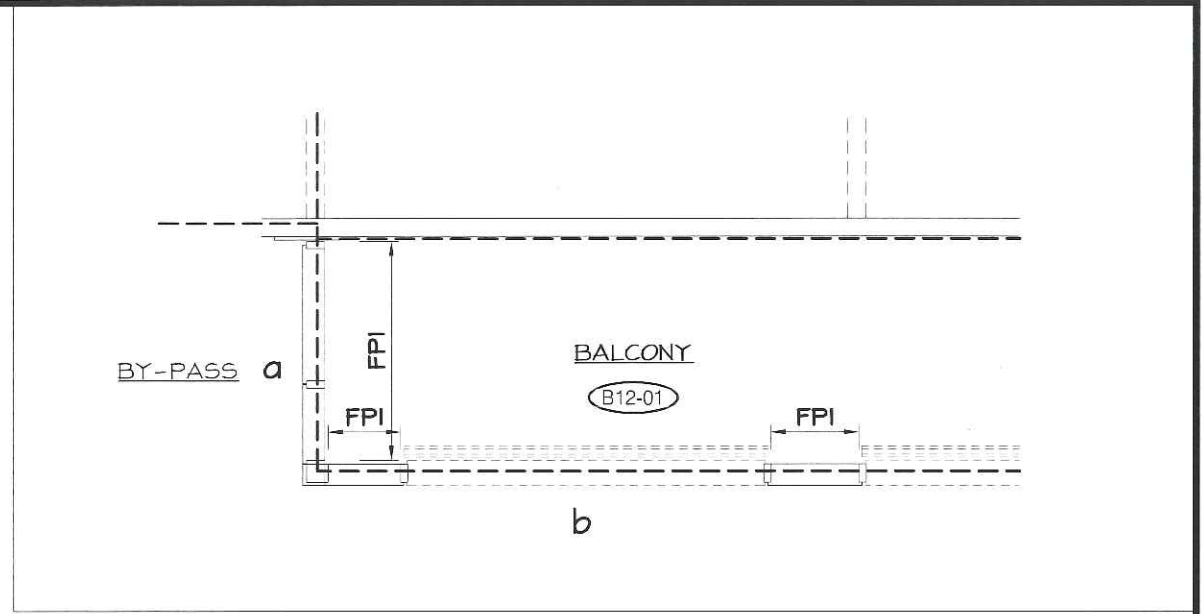



B12-01 1 REQUIRED
2487 SERIES
EXT. FINISH: PPG ACRYNAR PLATINUM UCFX11185
INT. FINISH: PPG ACRYNAR PLATINUM UCFX11185



No.	REVISION	BY	DATE

PROJECT NAME:	SQ ALEXANDRA PARK - BLOCK 11		
DRAWING TITLE:	12th FLOOR ELEVATIONS		
ARCHITECT:	TEEPLE ARCHITECTS		DRAWING No.:
CONTRACTOR:	TRIDEL		E12-14
SCALE:	1:50	DRAWN BY:	S.C.
DATE:		MARCH 4, 2015	

FOR ALUMINUM BALCONY
& TERRACE RAILINGS
REFER TO TORO
ALUMINUM RAILING SHOP
DRAWINGS

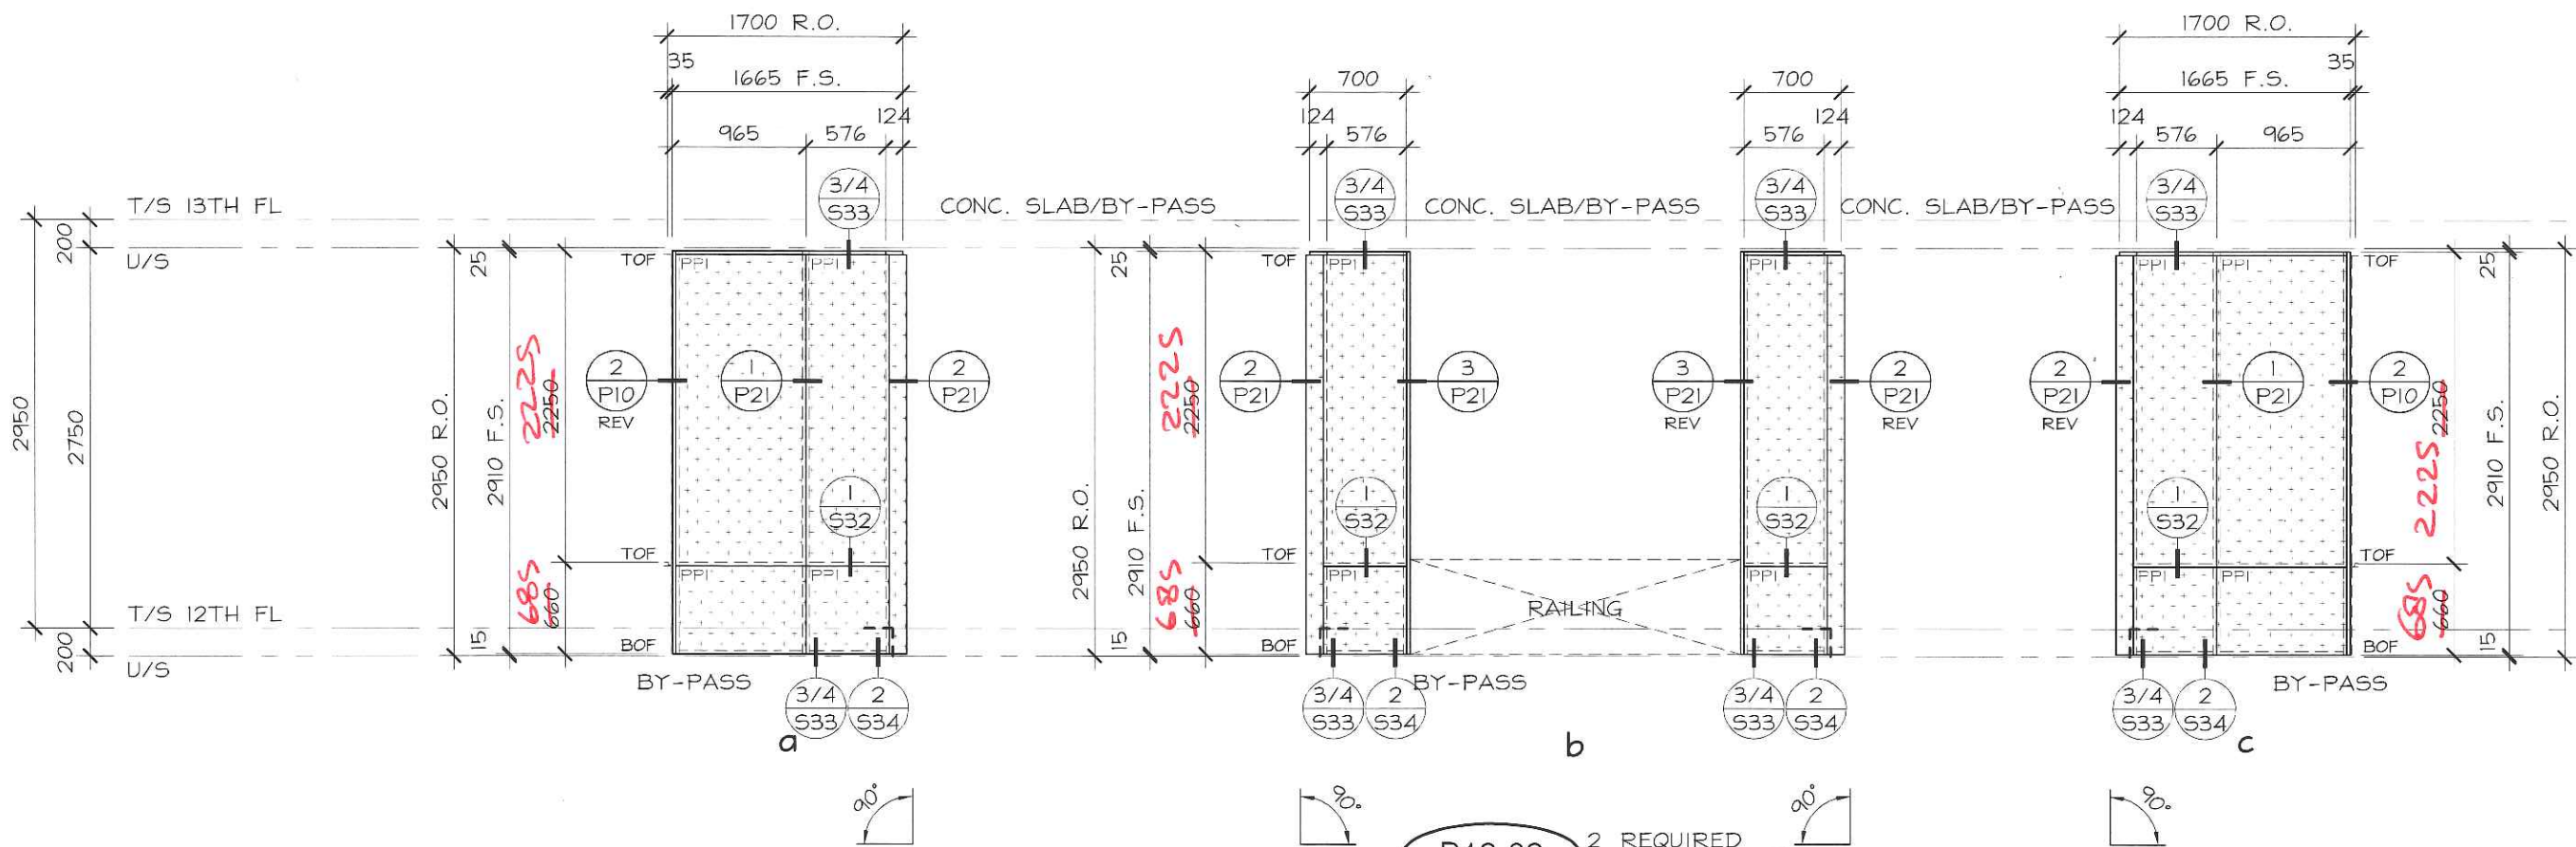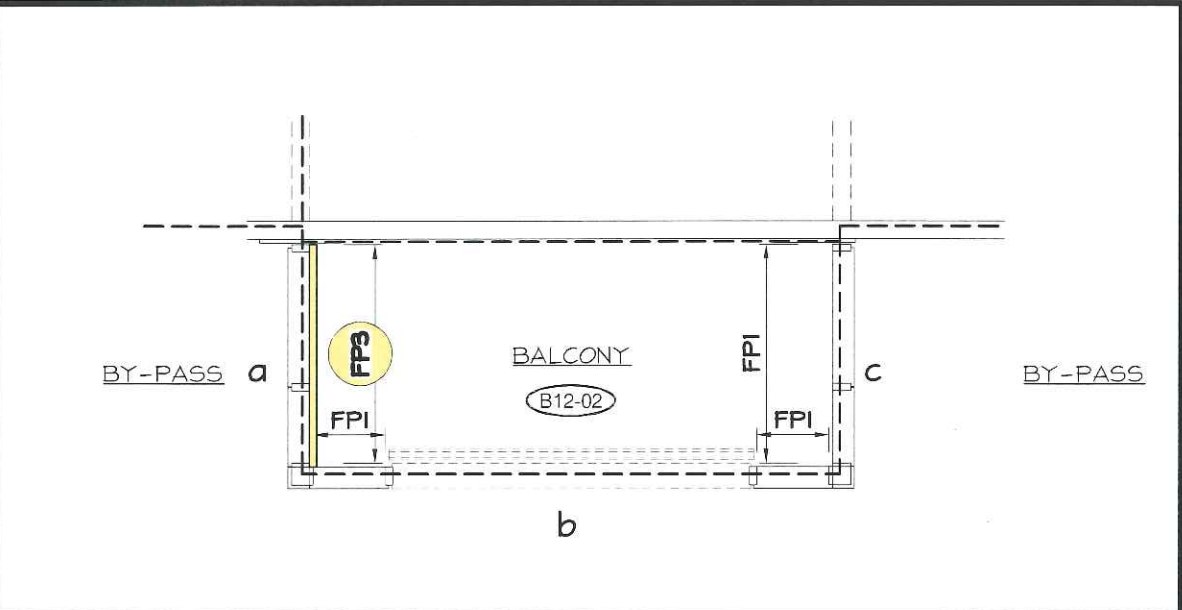



B12-02 2 REQUIRED
2487 SERIES
EXT. FINISH: PPG ACRYNAR PLATINUM UCFX11185
INT. FINISH: PPG ACRYNAR PLATINUM UCFX11185
a INT. FINISH: PPG ACRYNAR T.B.D.



No.	REVISION	BY	DATE

PROJECT NAME: SQ ALEXANDRA PARK - BLOCK11		DRAWING No.:	
DRAWING TITLE: 12th FLOOR ELEVATIONS		E12-15	
ARCHITECT: TEEPLE ARCHITECTS		DRAWN BY: S.C.	
CONTRACTOR: TRIDEL		DATE: MARCH 4, 2015	
SCALE: 1:50			

FOR ALUMINUM BALCONY
 & TERRACE RAILINGS
 REFER TO TORO
 ALUMINUM RAILING SHOP
 DRAWINGS

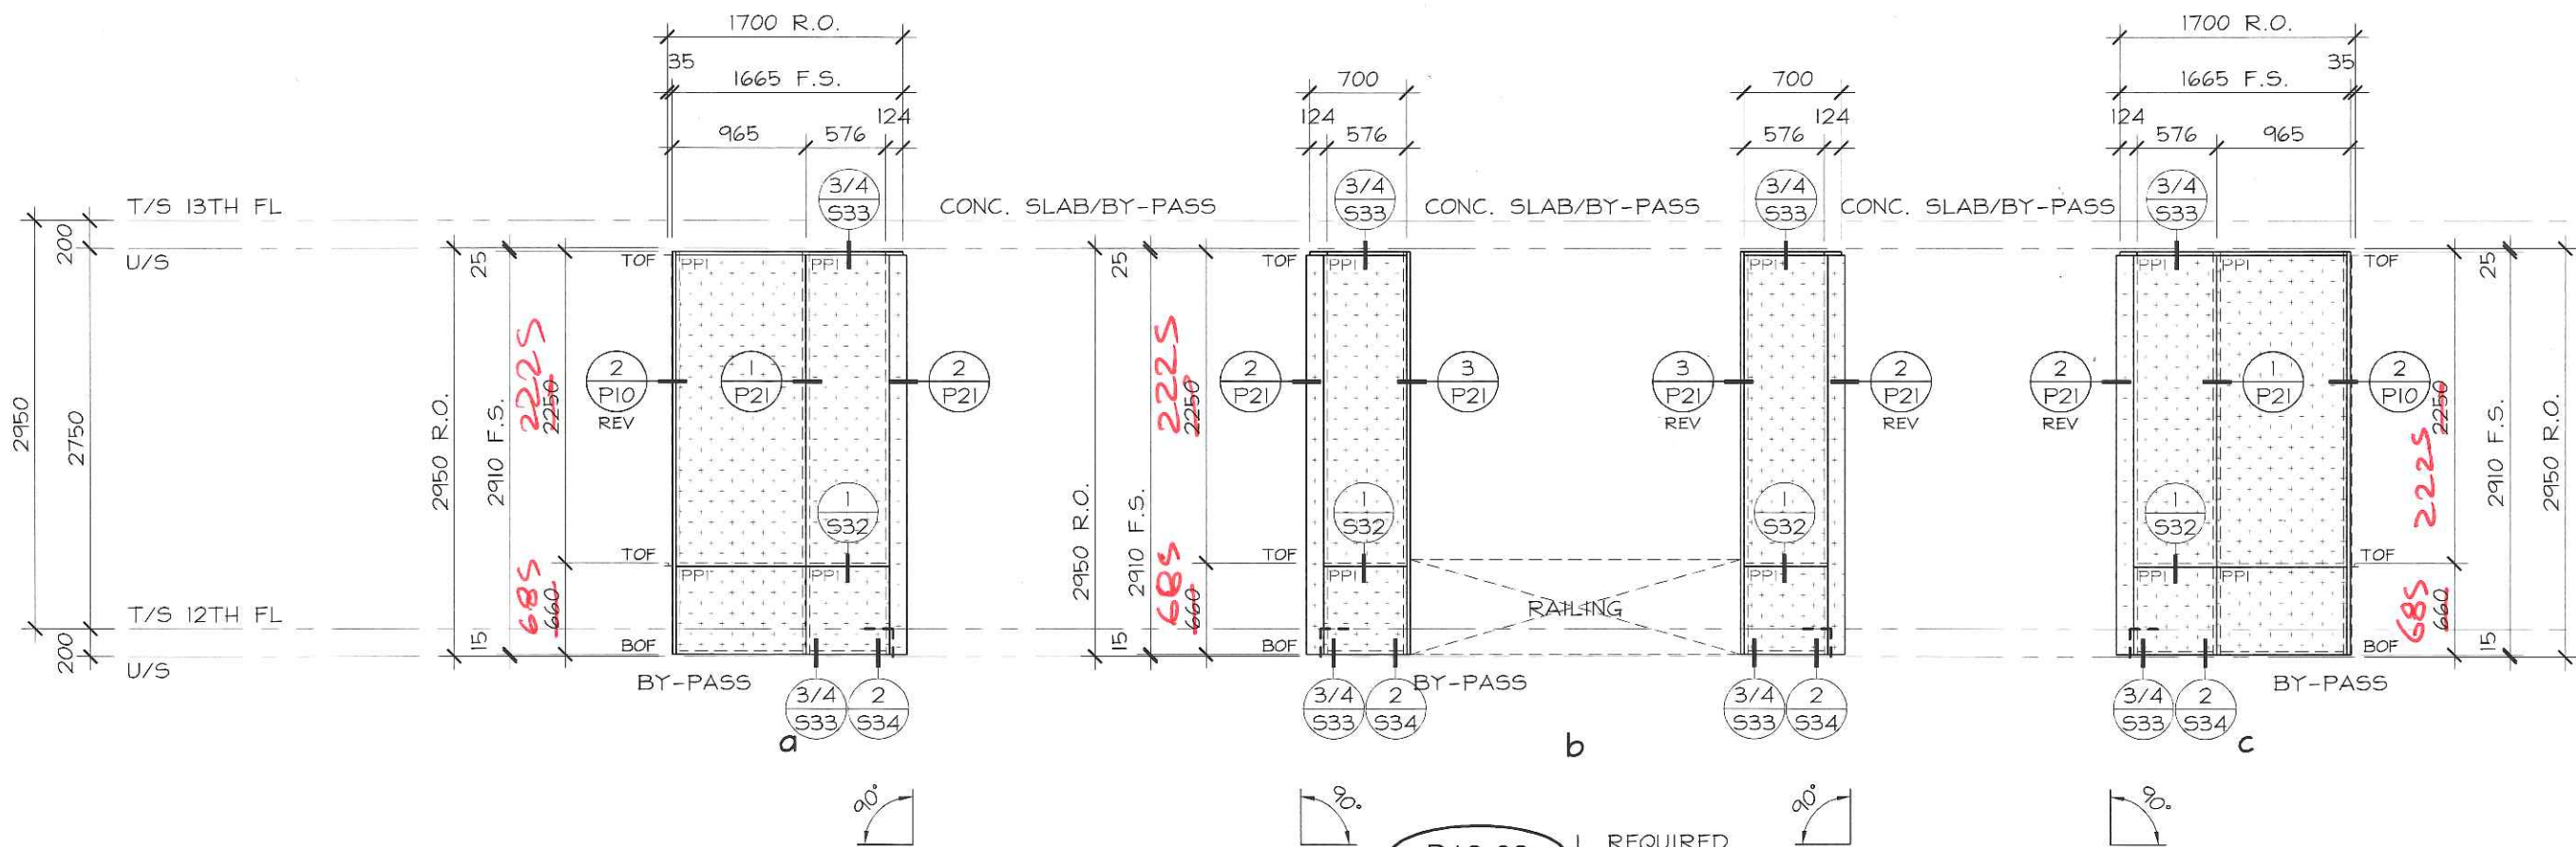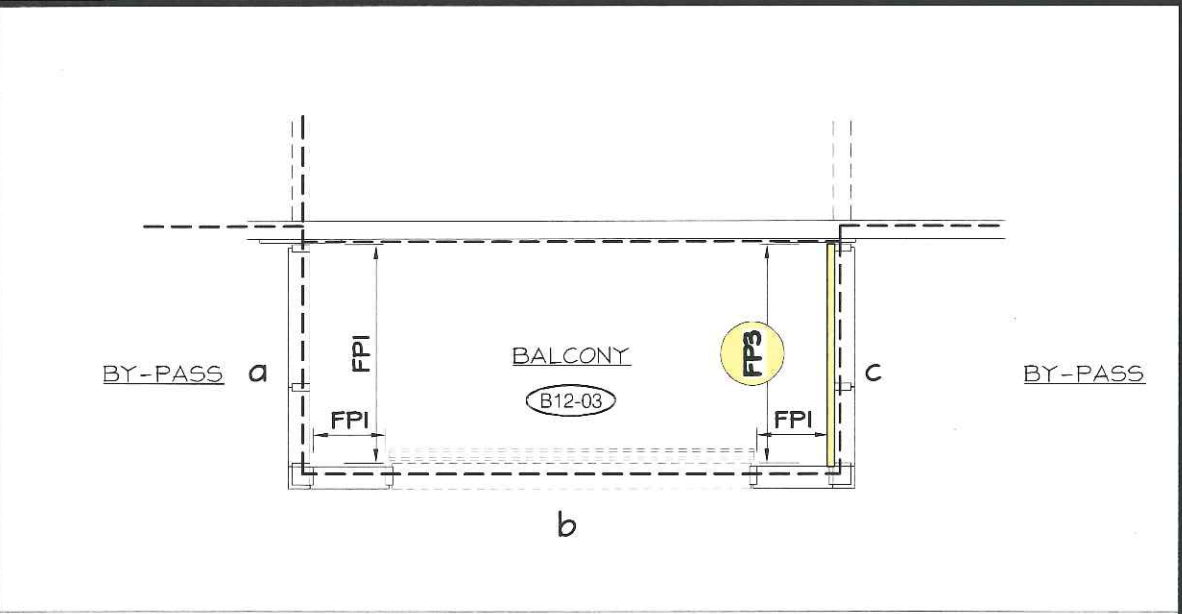

B12-03 1 REQUIRED
 2487 SERIES
 EXT. FINISH: PPG ACRYNAR PLATINUM UCFXIII85
 INT. FINISH: PPG ACRYNAR PLATINUM UCFXIII85
 c INT. FINISH: PPG ACRYNAR T.B.D.



No.	REVISION	BY	DATE

PROJECT NAME:	SQ ALEXANDRA PARK - BLOCK 11		
DRAWING TITLE:	12th FLOOR ELEVATIONS		
ARCHITECT:	TEEPLE ARCHITECTS		
CONTRACTOR:	TRIDEL		
SCALE:	1:50	DRAWN BY:	S.C.
DATE:	MARCH 4, 2015		
DRAWING No.:	E12-16		