

Teeple Architects INC.


Reviewed
Reviewed as noted

Revise and resubmit
Not Reviewed

Date: *Aug 2/15*
Reviewed by: *M. Barton*

This review by Teeple Architects Inc. is for the sole purpose of ascertaining conformance with the general design concept. This review shall not mean that Teeple Architects Inc. approves the detailed design inherent in the shop drawings, responsibility for which shall remain with the Contractor submitting same, and such review shall not relieve the Contractor of the responsibility for errors or omissions in the shop drawings or of the responsibility for meeting all requirements of the Contract Documents. The Contractor is responsible for dimensions to be confirmed and correlated at the job site, for information that pertains solely to fabrication processes or to techniques of construction and installation, and for coordination of the work of all trades.

Package 15 - Level 14 # Elevator Machine Room

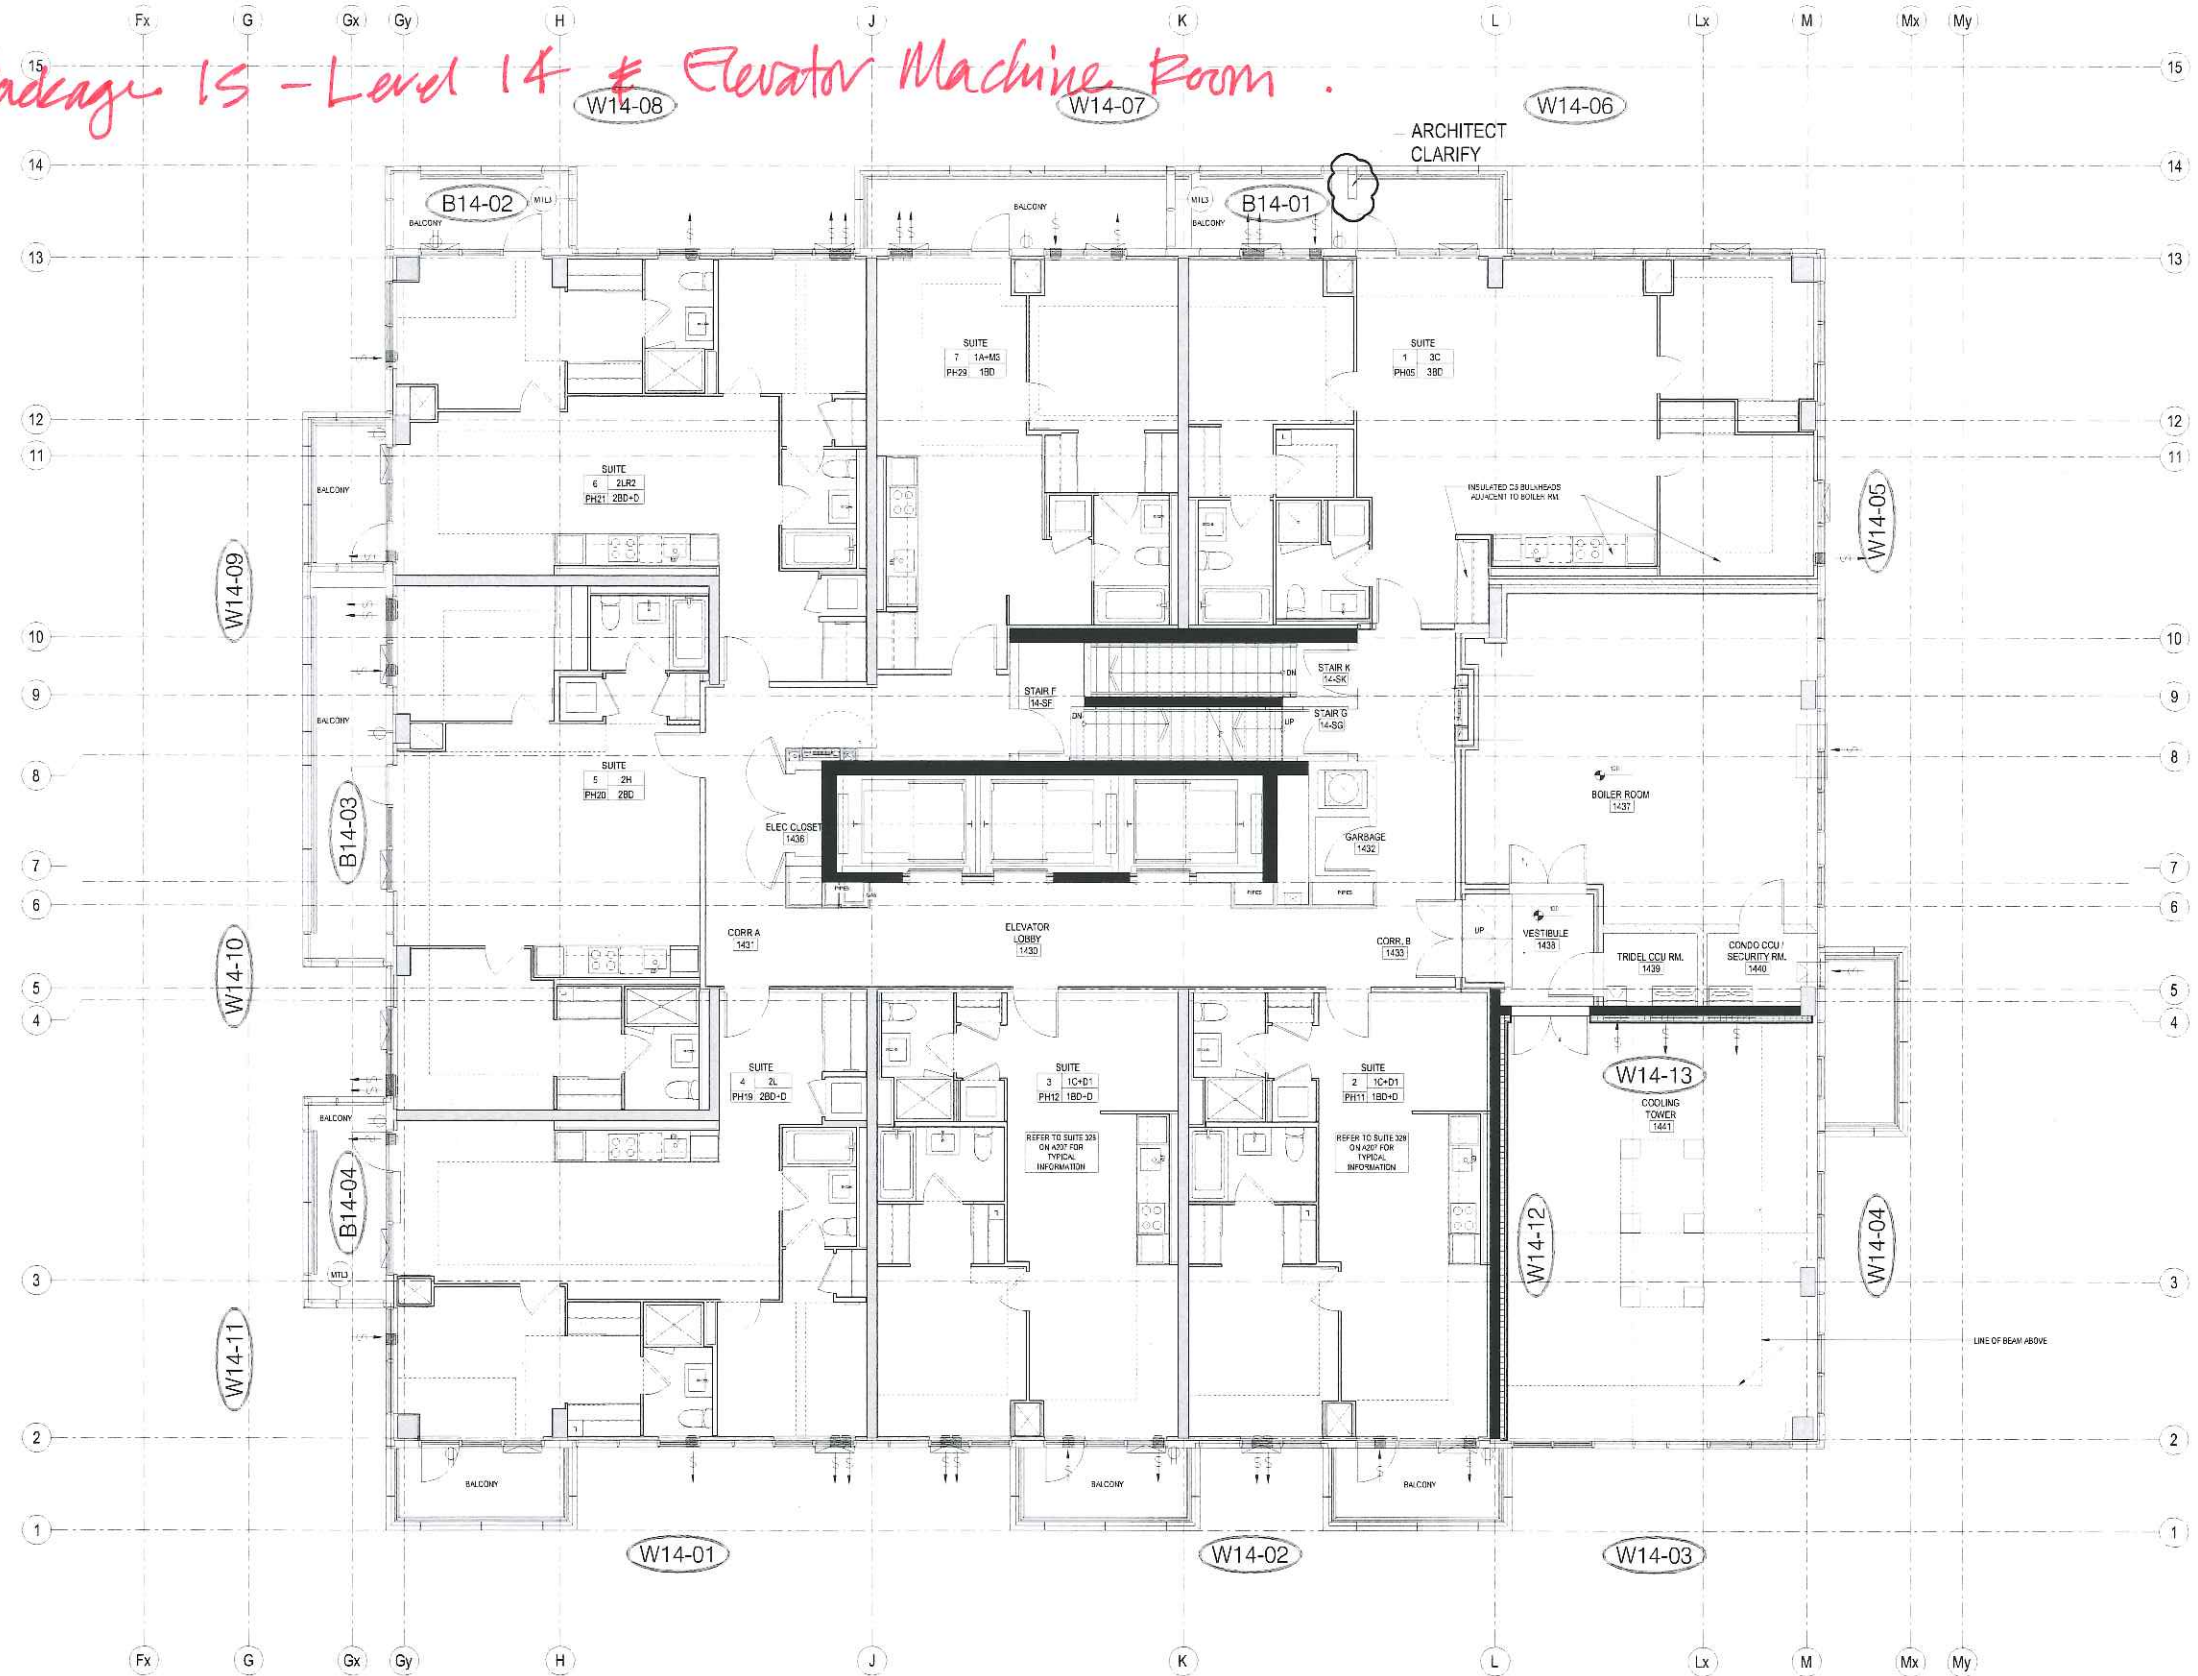

PROJECT NAME: SQ ALEXANDRA PARK - BLOCK 11

DRAWING TITLE: 14th FLOOR PLAN

ARCHITECT: TEEPLE ARCHITECTS


CONTRACTOR: TRIDEL

DRAWING No.

F14

No.	REVISION	BY	DATE


SCALE: N/T/S DRAWN BY: S.C. DATE: MARCH 4, 2015

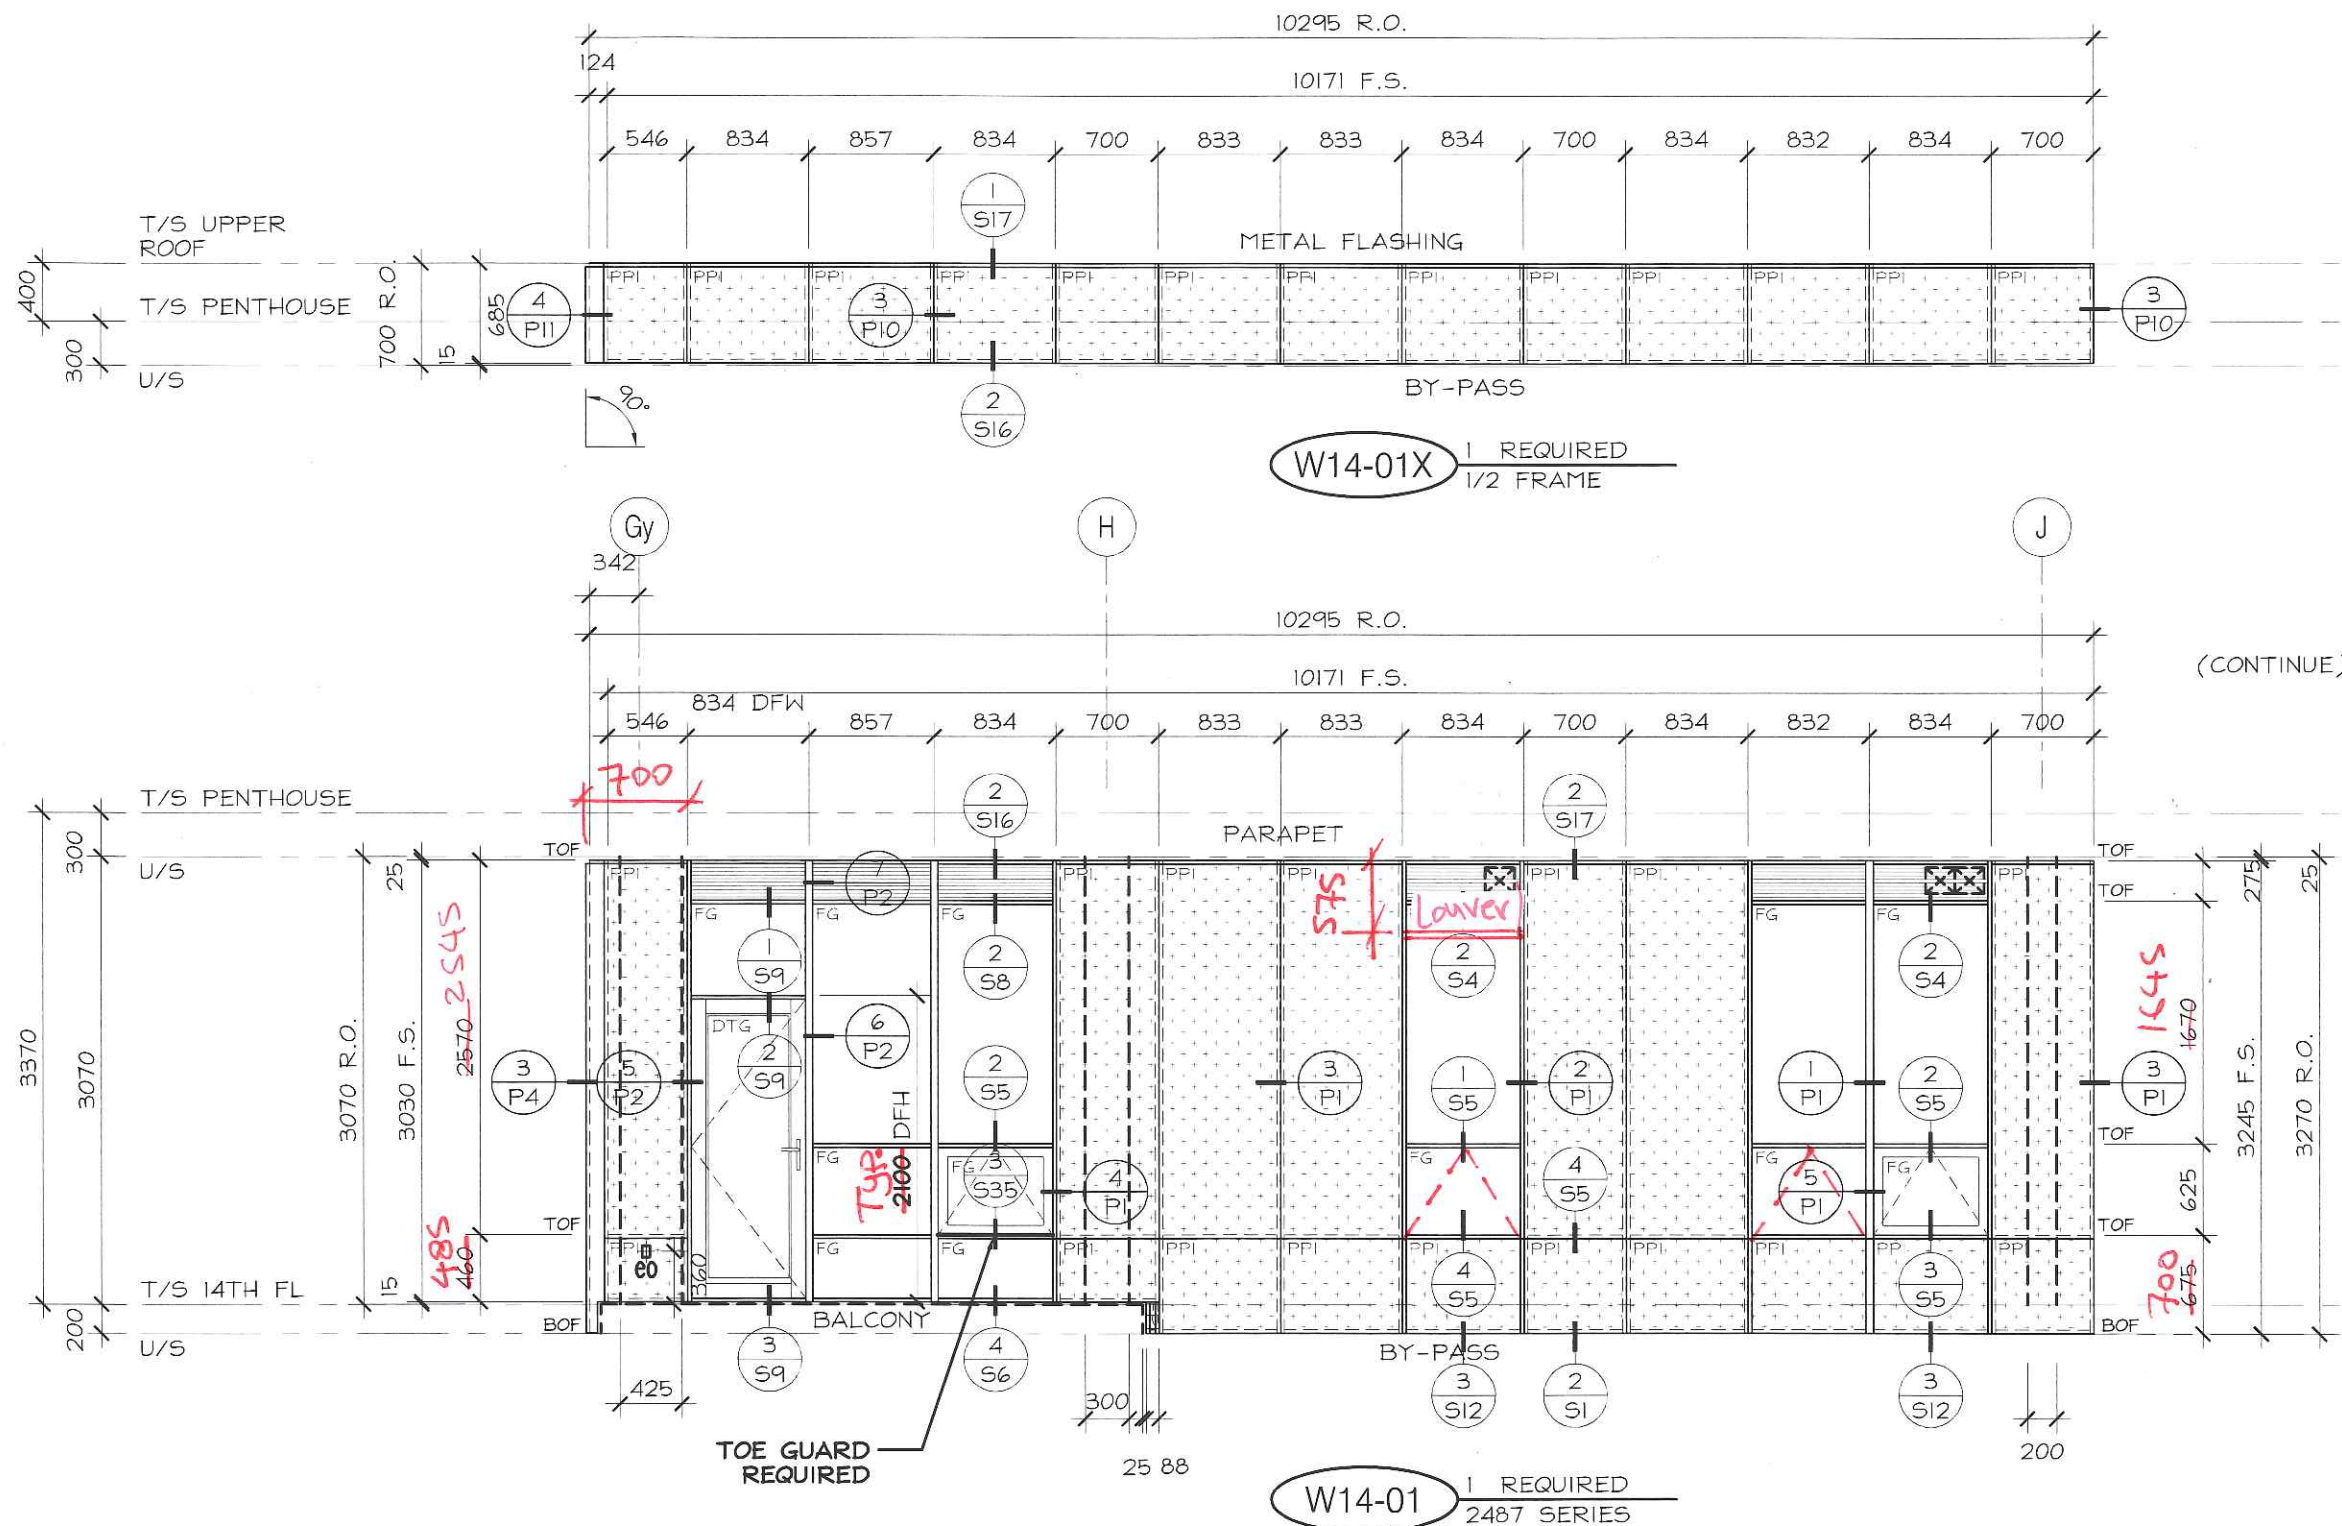

No.	REVISION	BY	DATE

PROJECT NAME:	SQ ALEXANDRA PARK - BLOCK 11
DRAWING TITLE:	14th FLOOR ELEVATIONS
ARCHITECT:	TEEPLE ARCHITECTS
CONTRACTOR:	TRIDEL
SCALE:	1:50
DRAWN BY:	S.C.
DATE:	MARCH 4, 2015


DRAWING No.:
E14-1

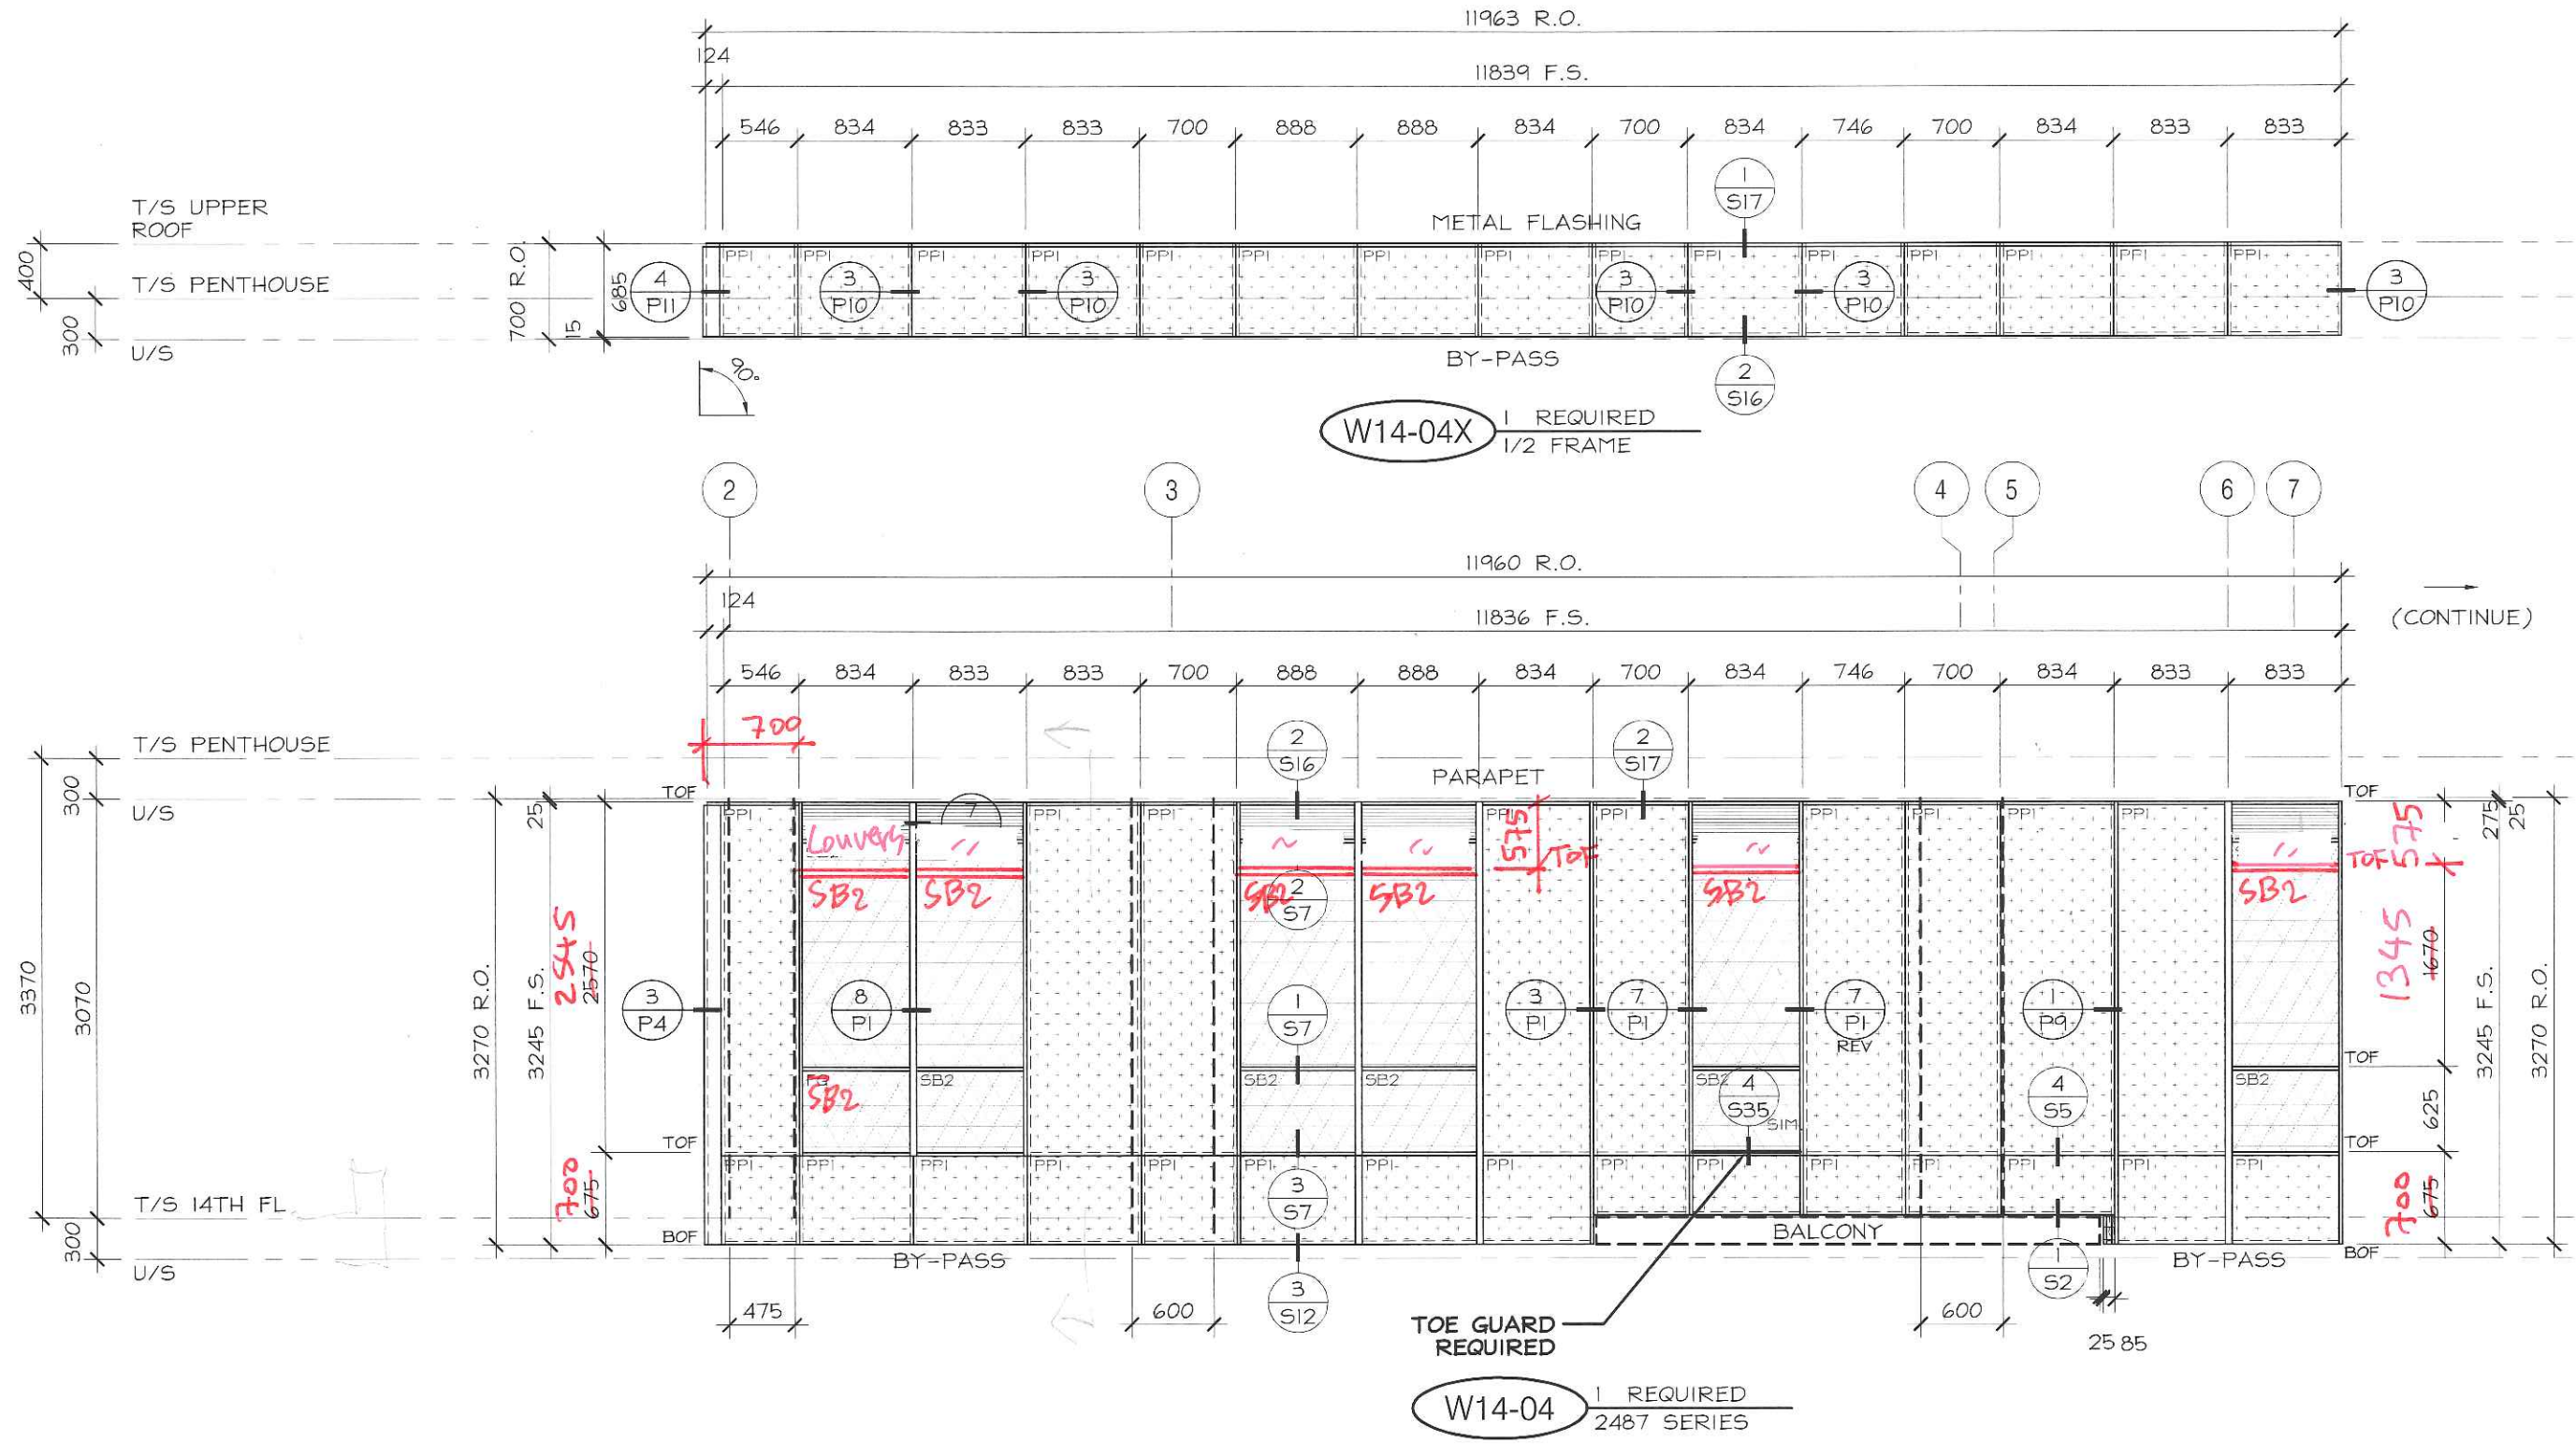

No.	REVISION	BY	DATE

PROJECT NAME:	SQ ALEXANDRA PARK - BLOCK 11
DRAWING TITLE:	14th FLOOR ELEVATIONS
ARCHITECT:	TEEPLE ARCHITECTS
CONTRACTOR:	TRIDEL
SCALE:	1:50
DRAWN BY:	S.C.
DATE:	MARCH 4, 2015

DRAWING No.:
E14-4

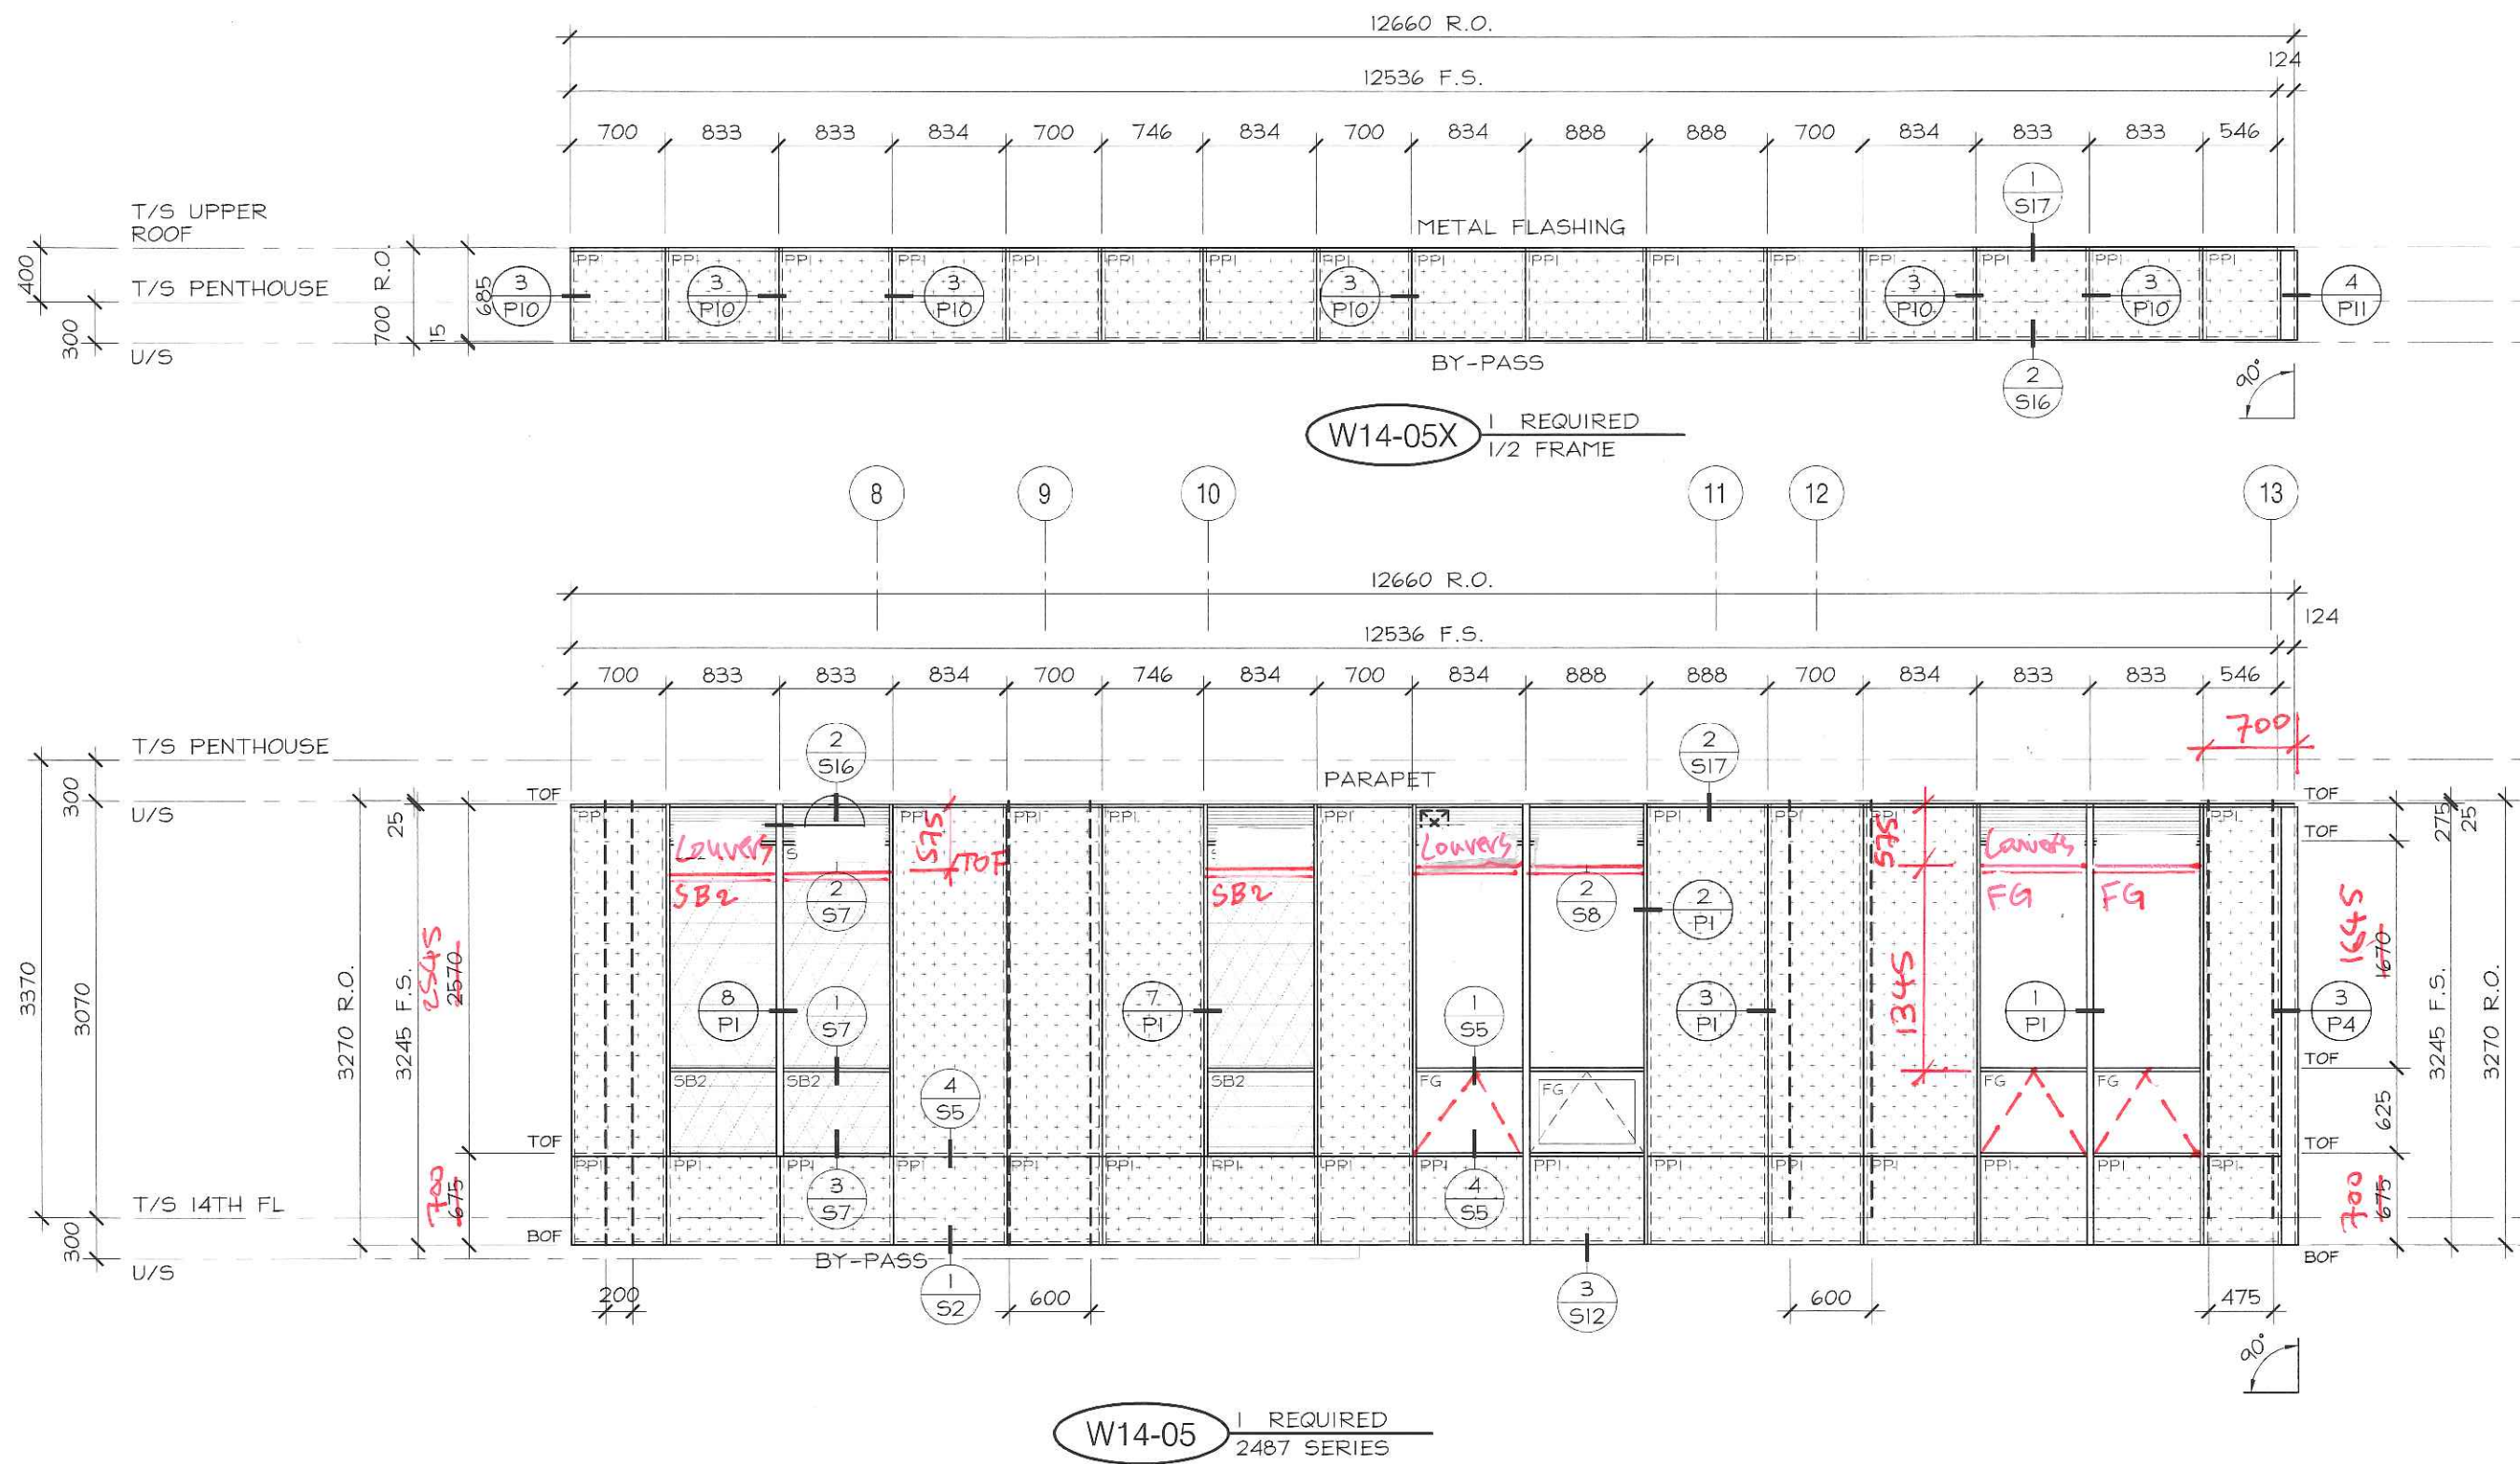


W14-05 1 REQUIRED
2487 SERIES



No.	REVISION	BY	DATE


PROJECT NAME:	SQ ALEXANDRA PARK - BLOCK 11		
DRAWING TITLE:	14th FLOOR ELEVATIONS		
ARCHITECT:	TEEPLE ARCHITECTS		
CONTRACTOR:	TRIDEL		
SCALE:	1:50	DRAWN BY:	S.C.
DATE:	MARCH 4, 2015		

DRAWING No.:
E14-5

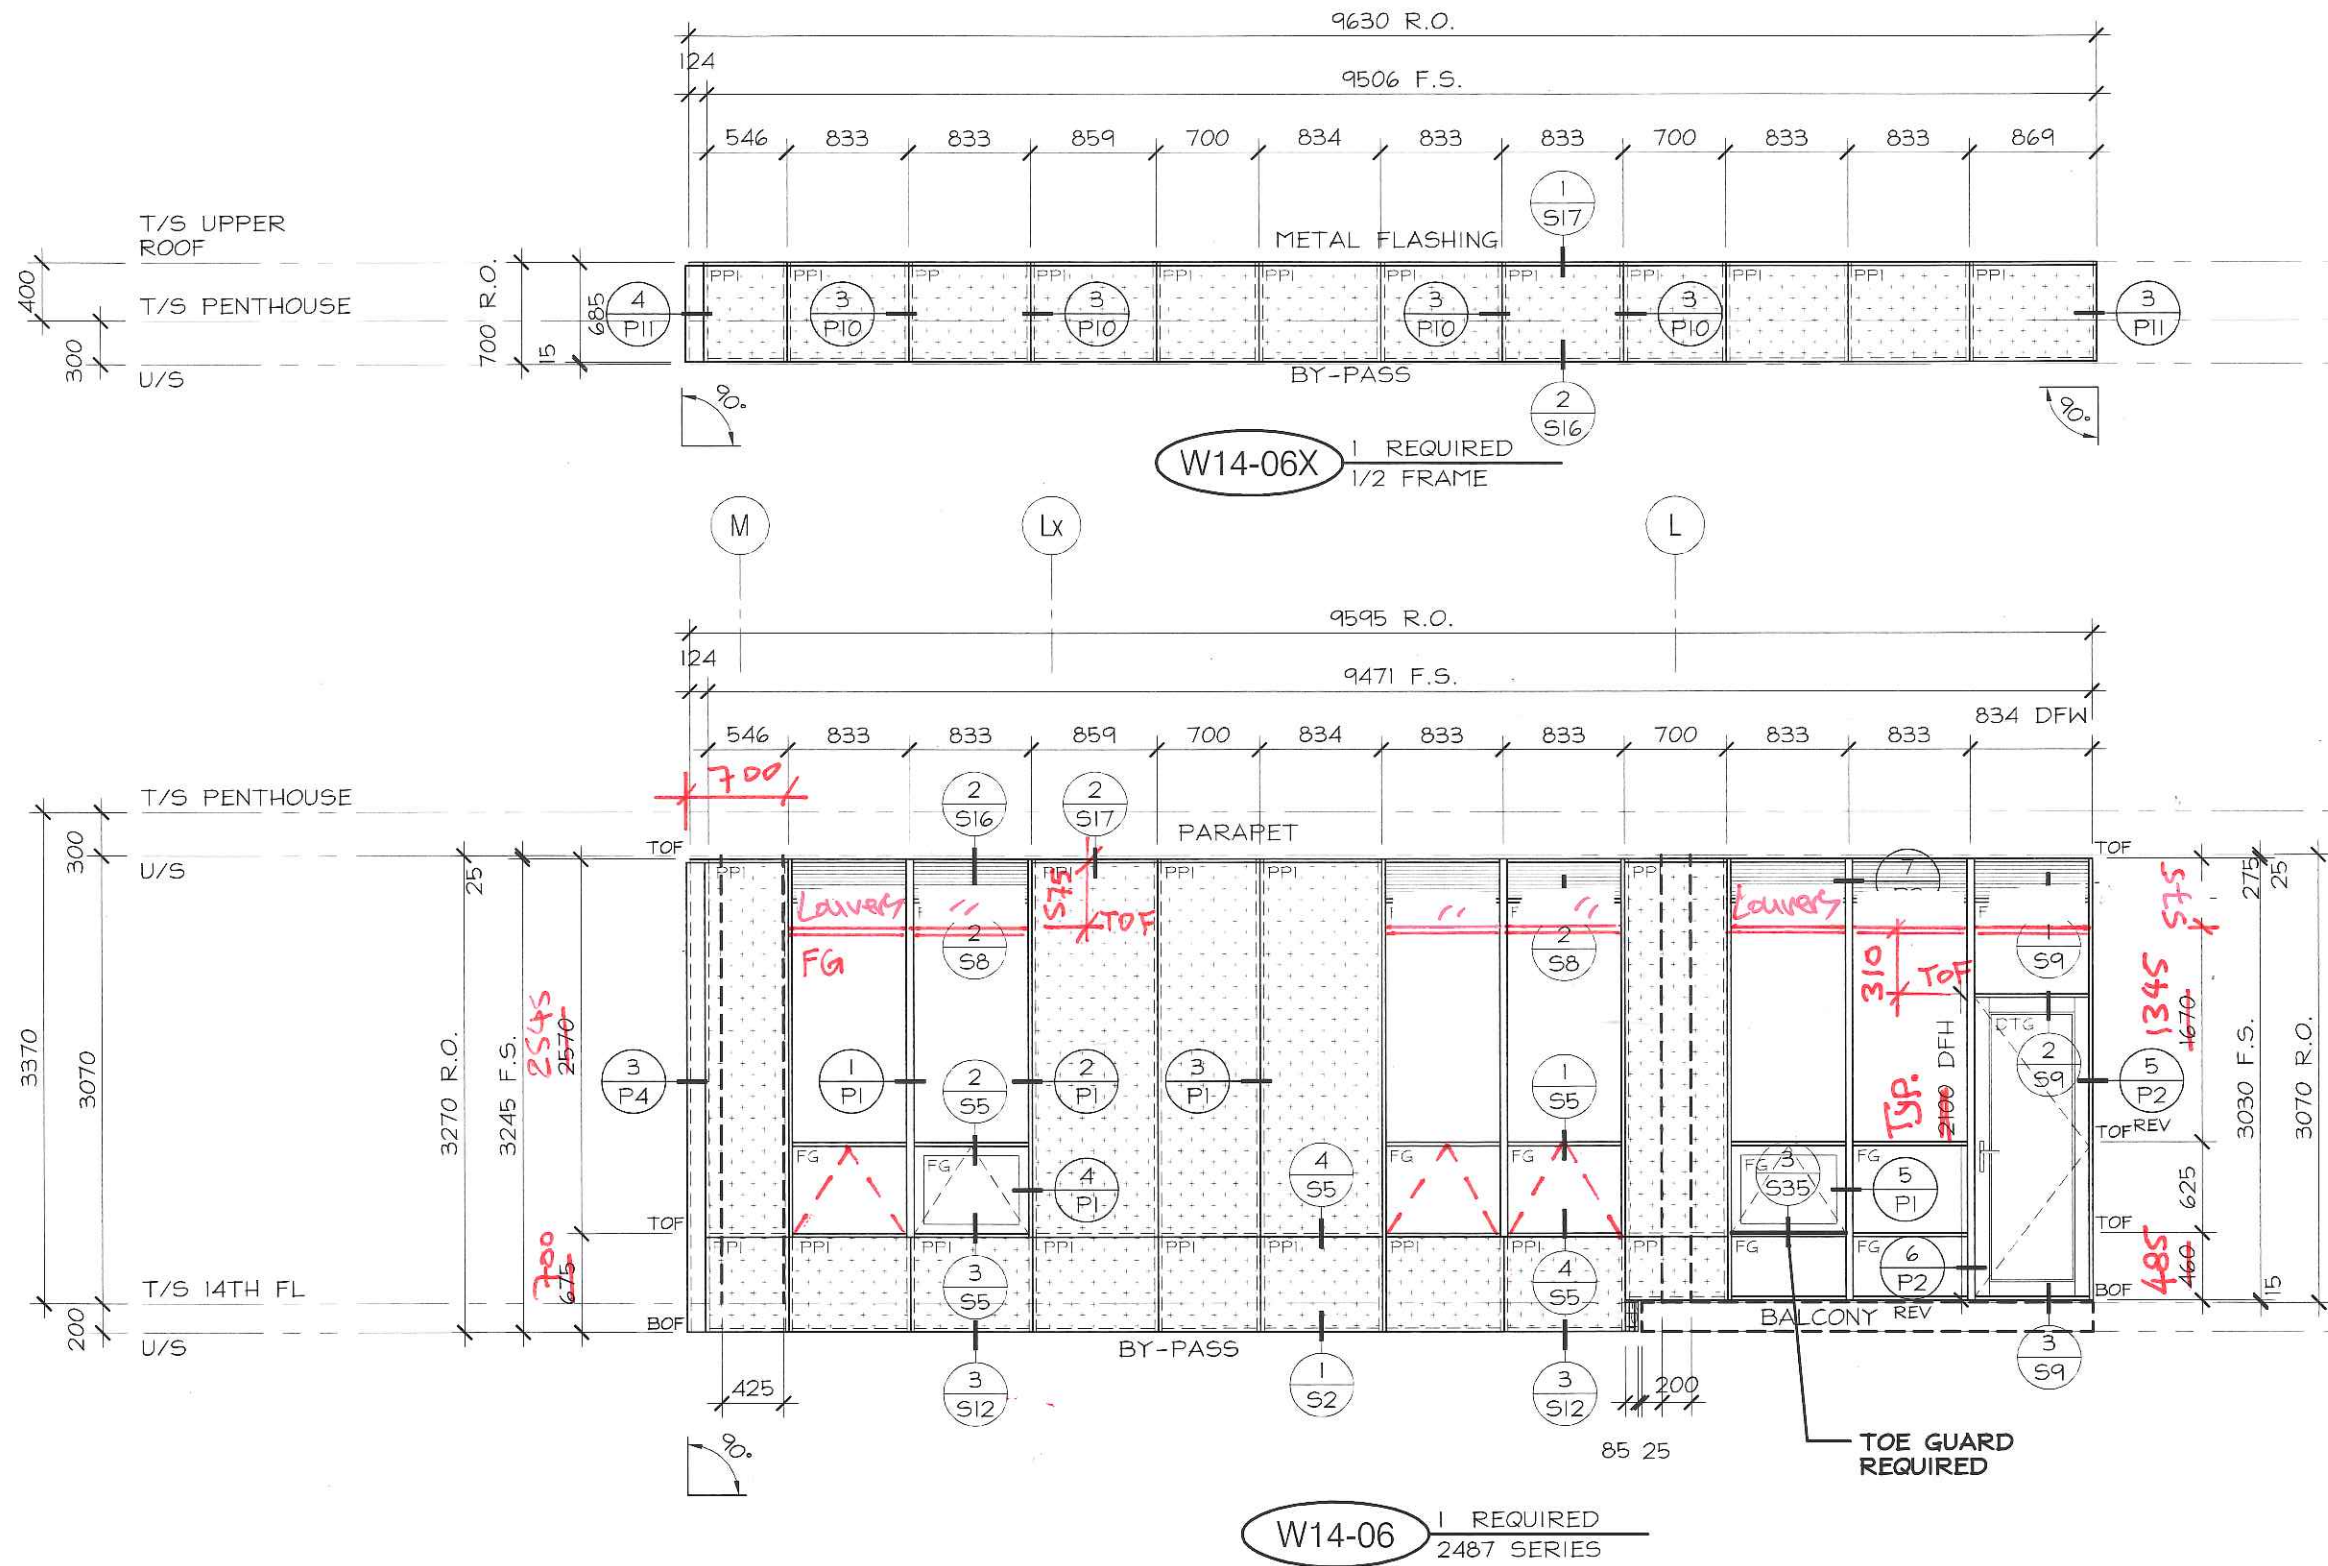


No.	REVISION	BY	DATE

PROJECT NAME: SQ ALEXANDRA PARK - BLOCK 11		DRAWING No.: E14-6
DRAWING TITLE: 14th FLOOR ELEVATIONS		
ARCHITECT: TEEPLE ARCHITECTS		SCALE: 1:50
CONTRACTOR: TRIDEL		
DRAWN BY: S.C.		DATE: MARCH 4, 2015

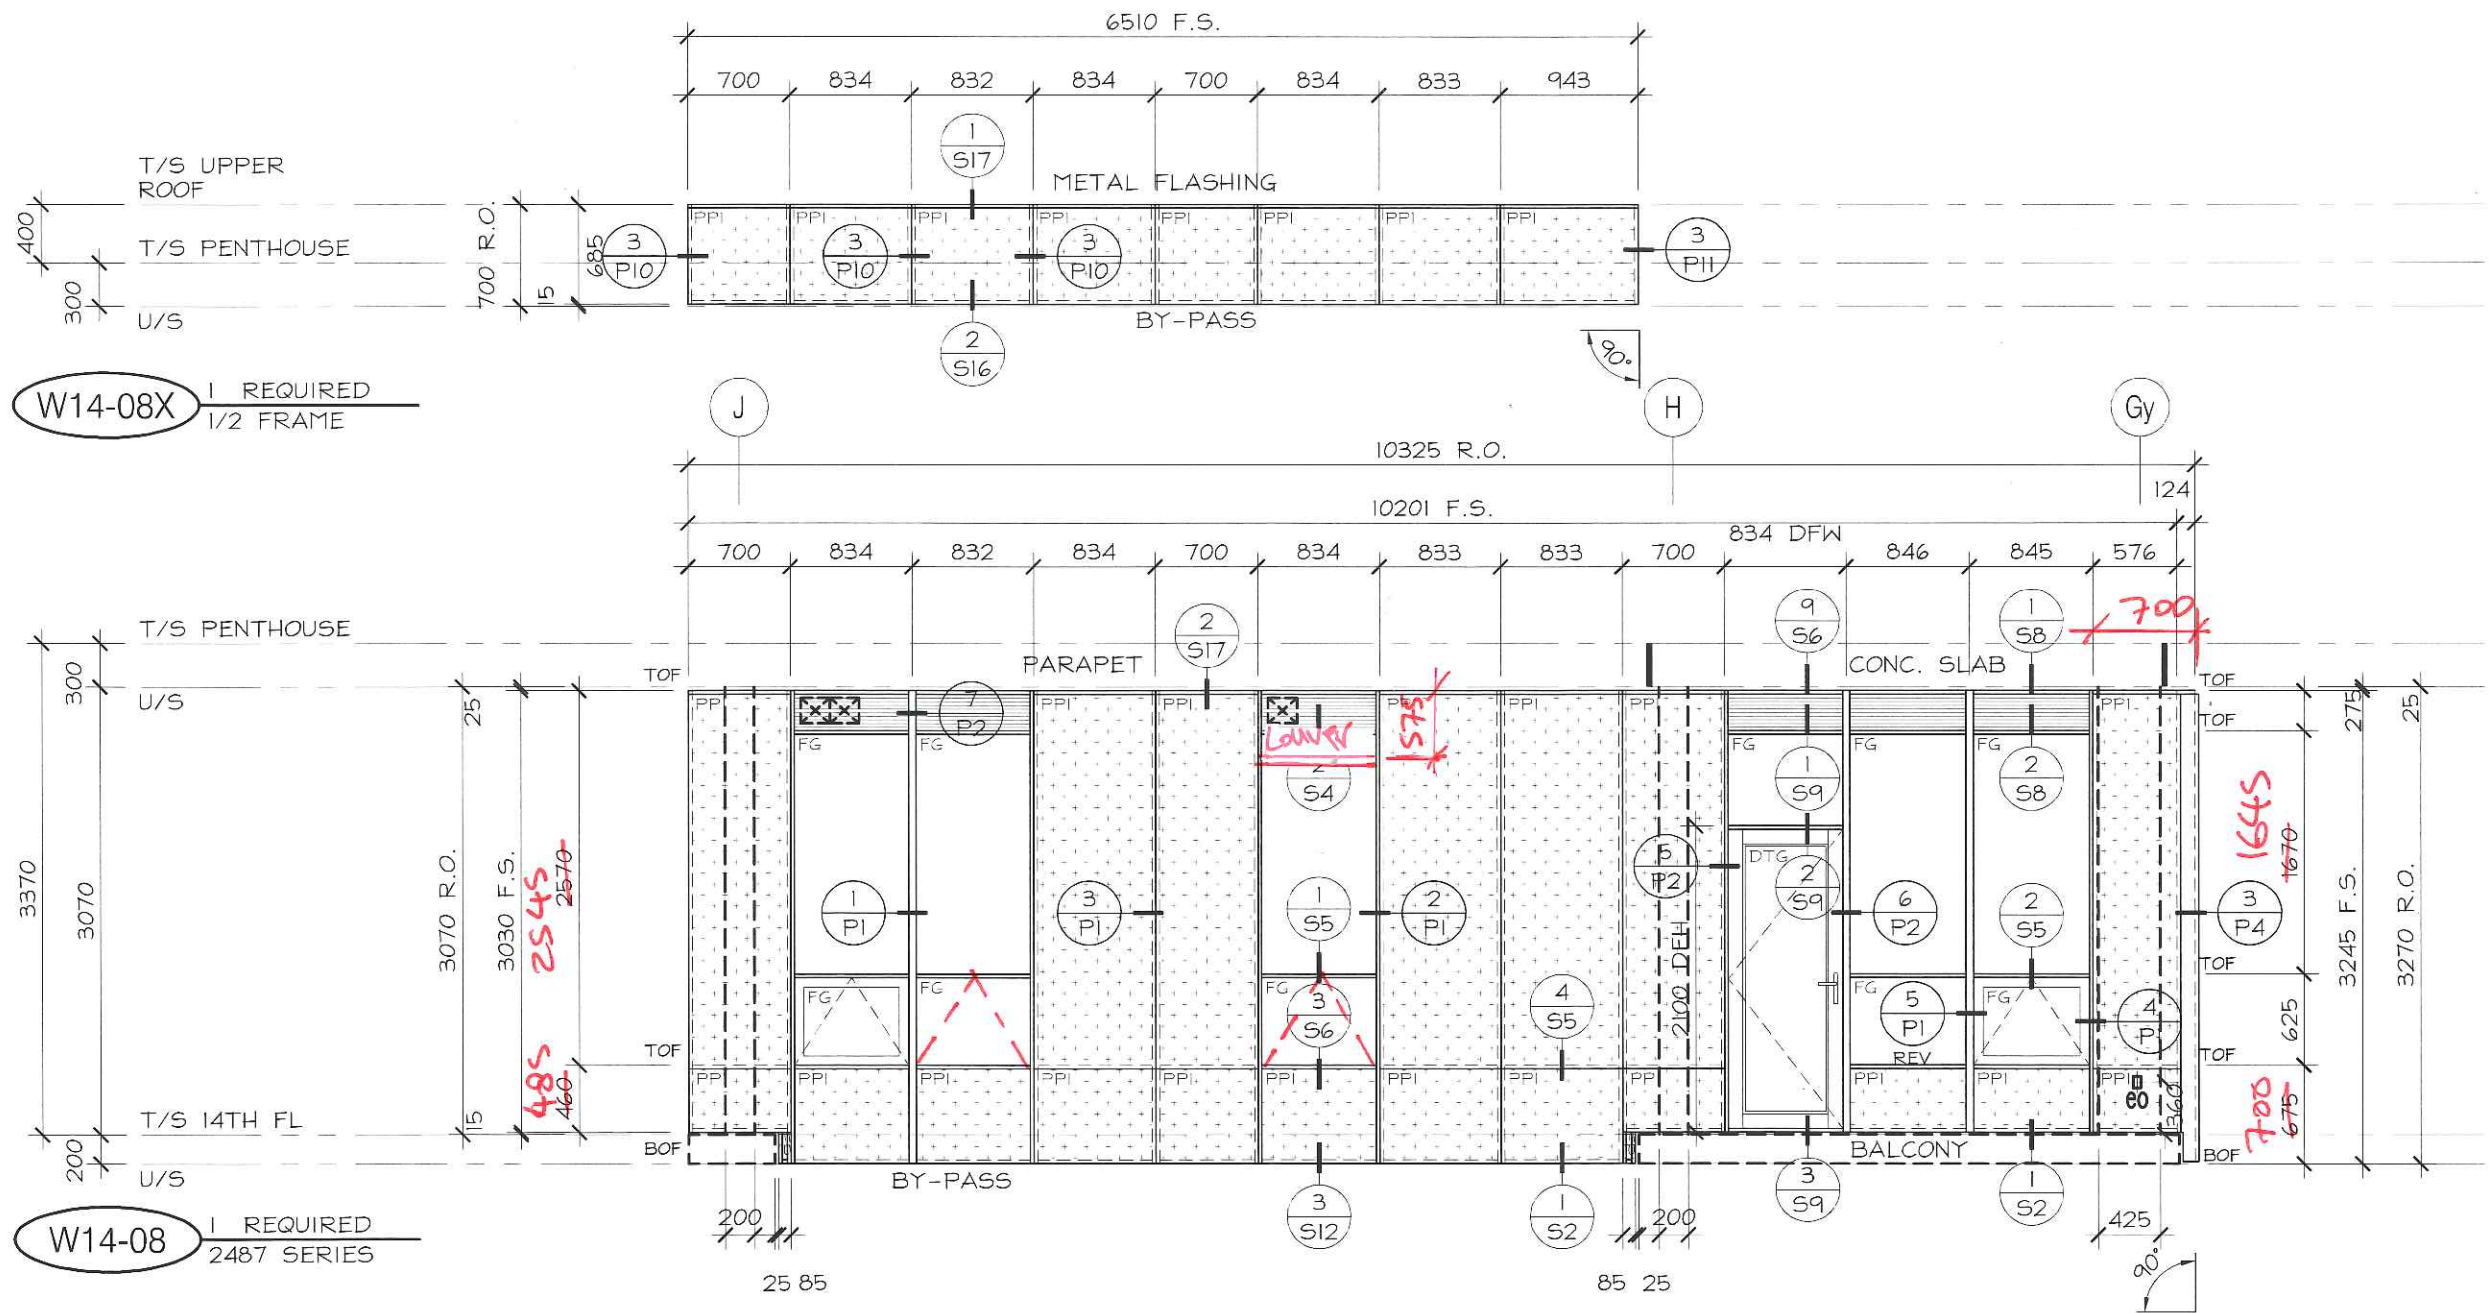

No.	REVISION	BY	DATE


PROJECT NAME: SQ ALEXANDRA PARK - BLOCK 11		DRAWING No.: E14-8
DRAWING TITLE: 14th FLOOR ELEVATIONS		
ARCHITECT: TEEPLE ARCHITECTS		DATE: MARCH 4, 2015
CONTRACTOR: TRIDEL		
SCALE: 1:50	DRAWN BY: S.C.	

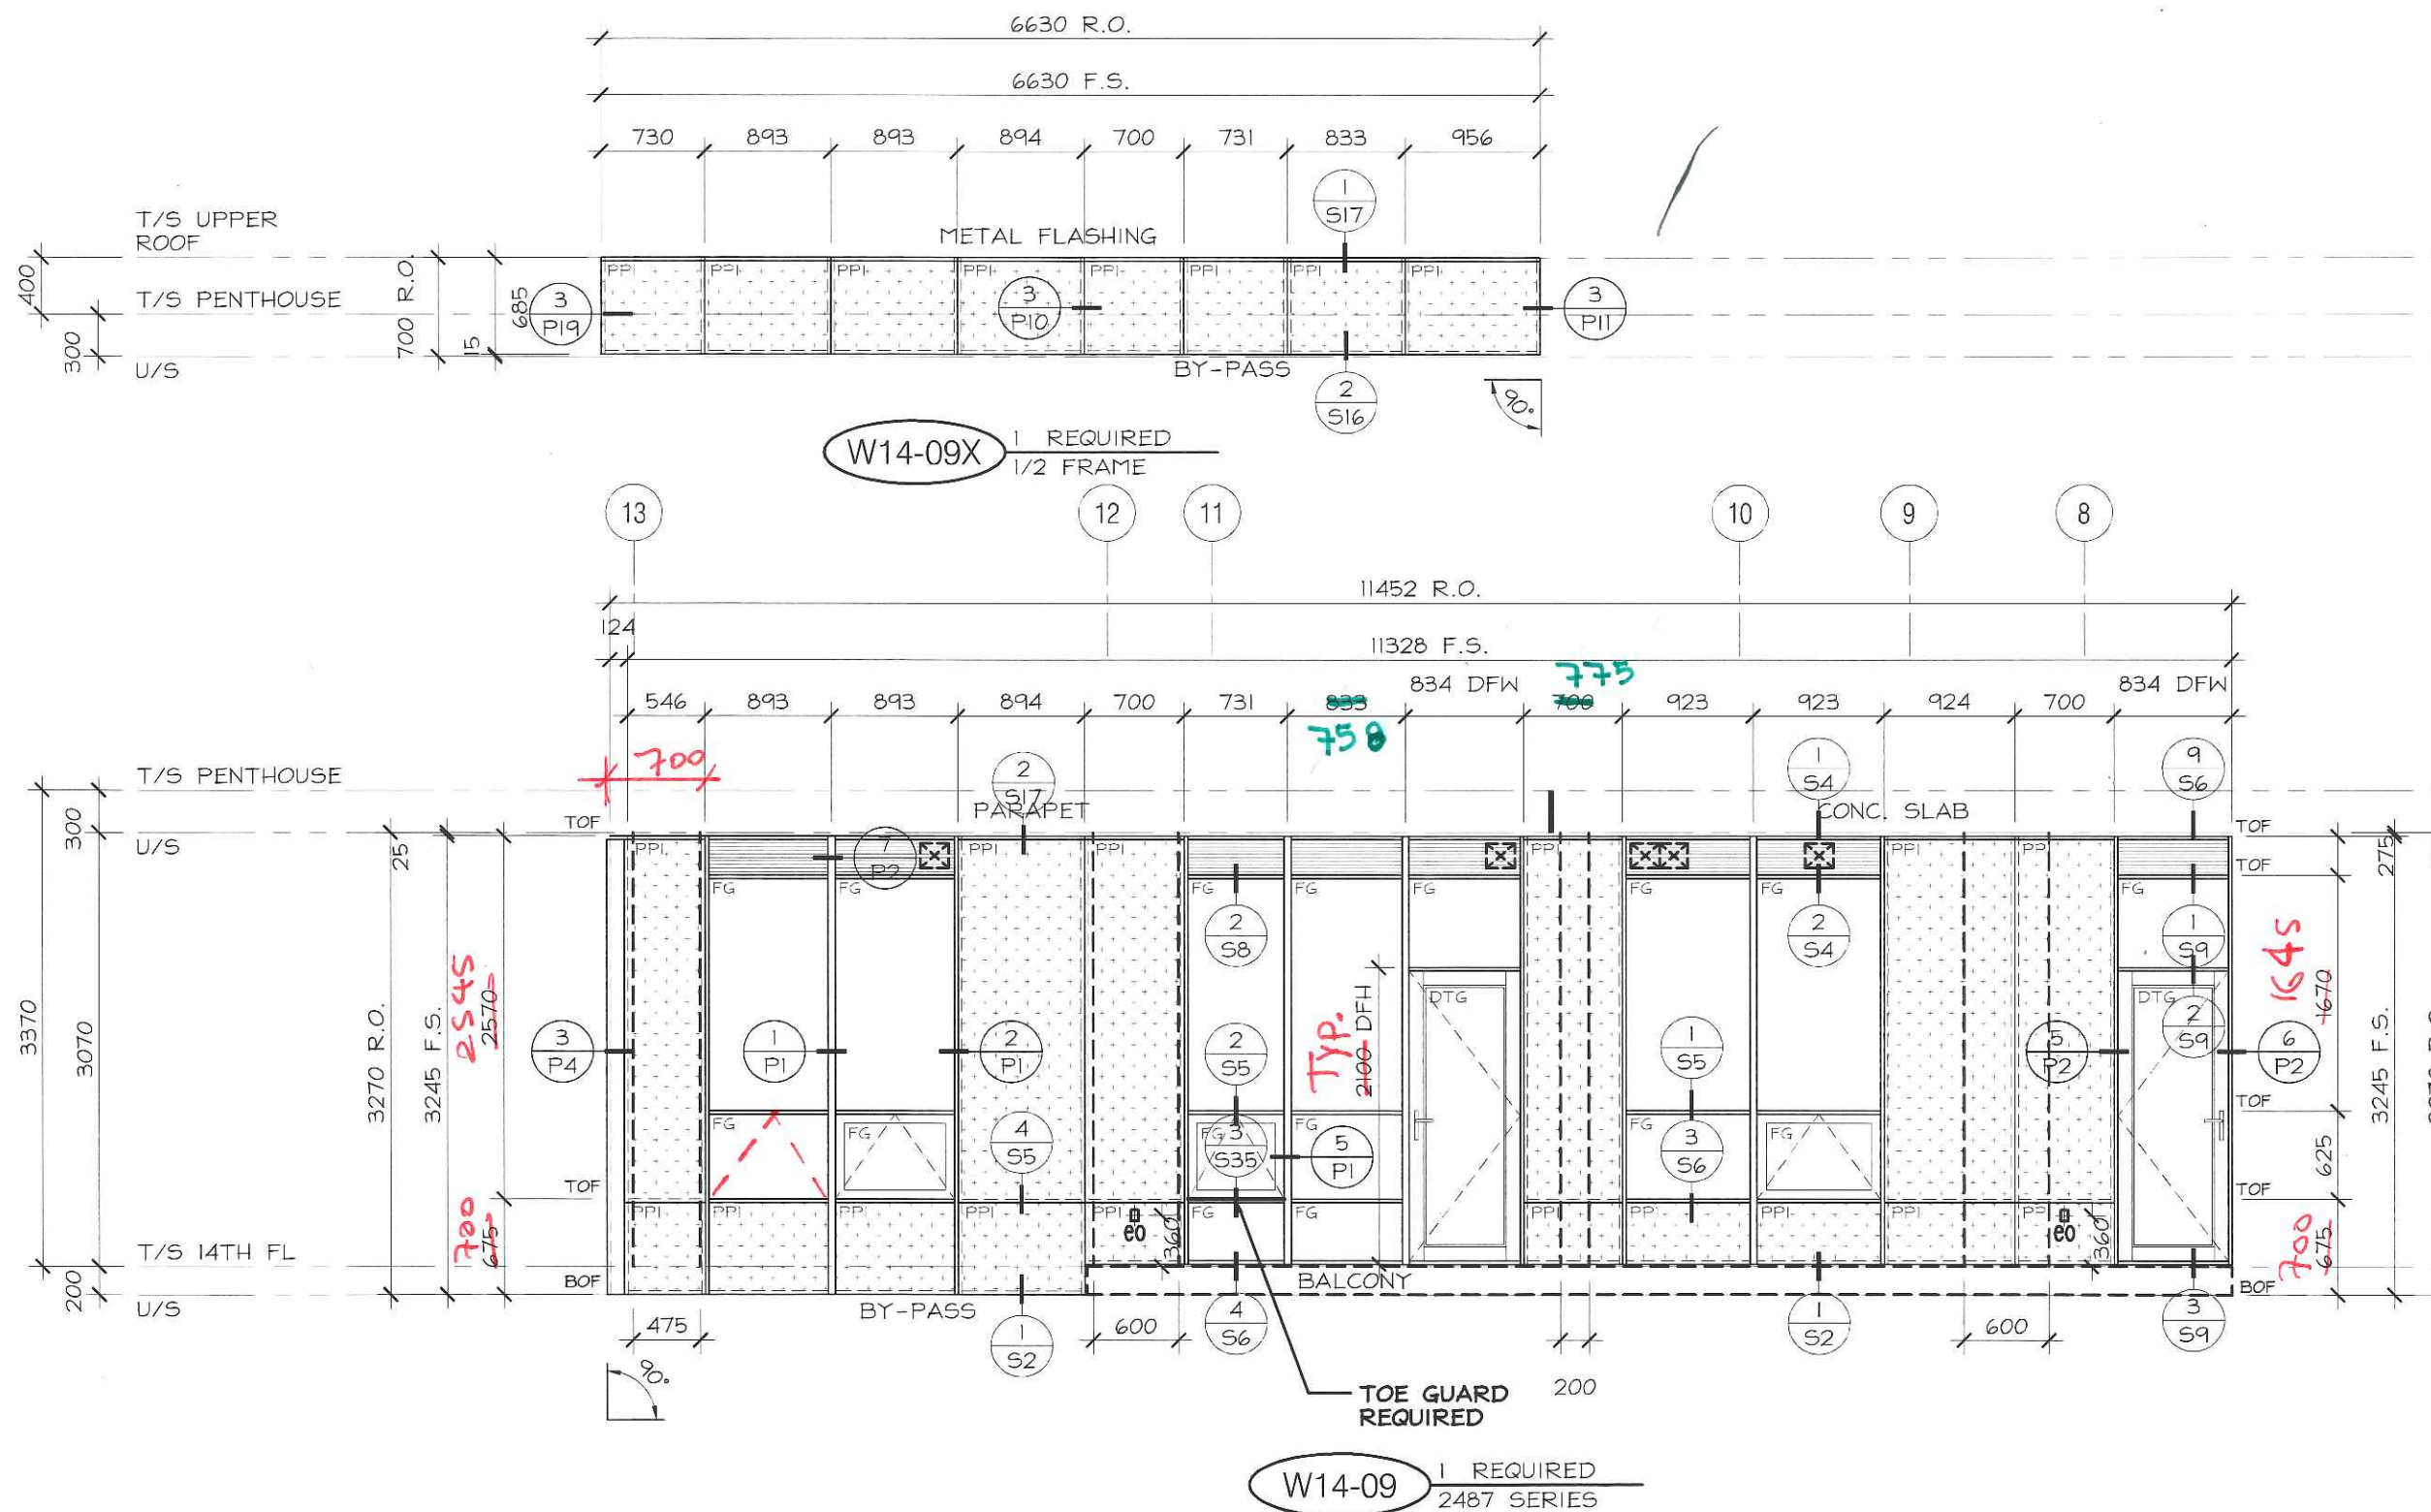

No.	REVISION	BY	DATE


PROJECT NAME:	SQ ALEXANDRA PARK - BLOCK 11
DRAWING TITLE:	14th FLOOR ELEVATIONS
ARCHITECT:	TEEPLE ARCHITECTS
CONTRACTOR:	TRIDEL
SCALE:	1:50
DRAWN BY:	S.C.
DATE:	MARCH 4, 2015

DRAWING No.:
E14-9

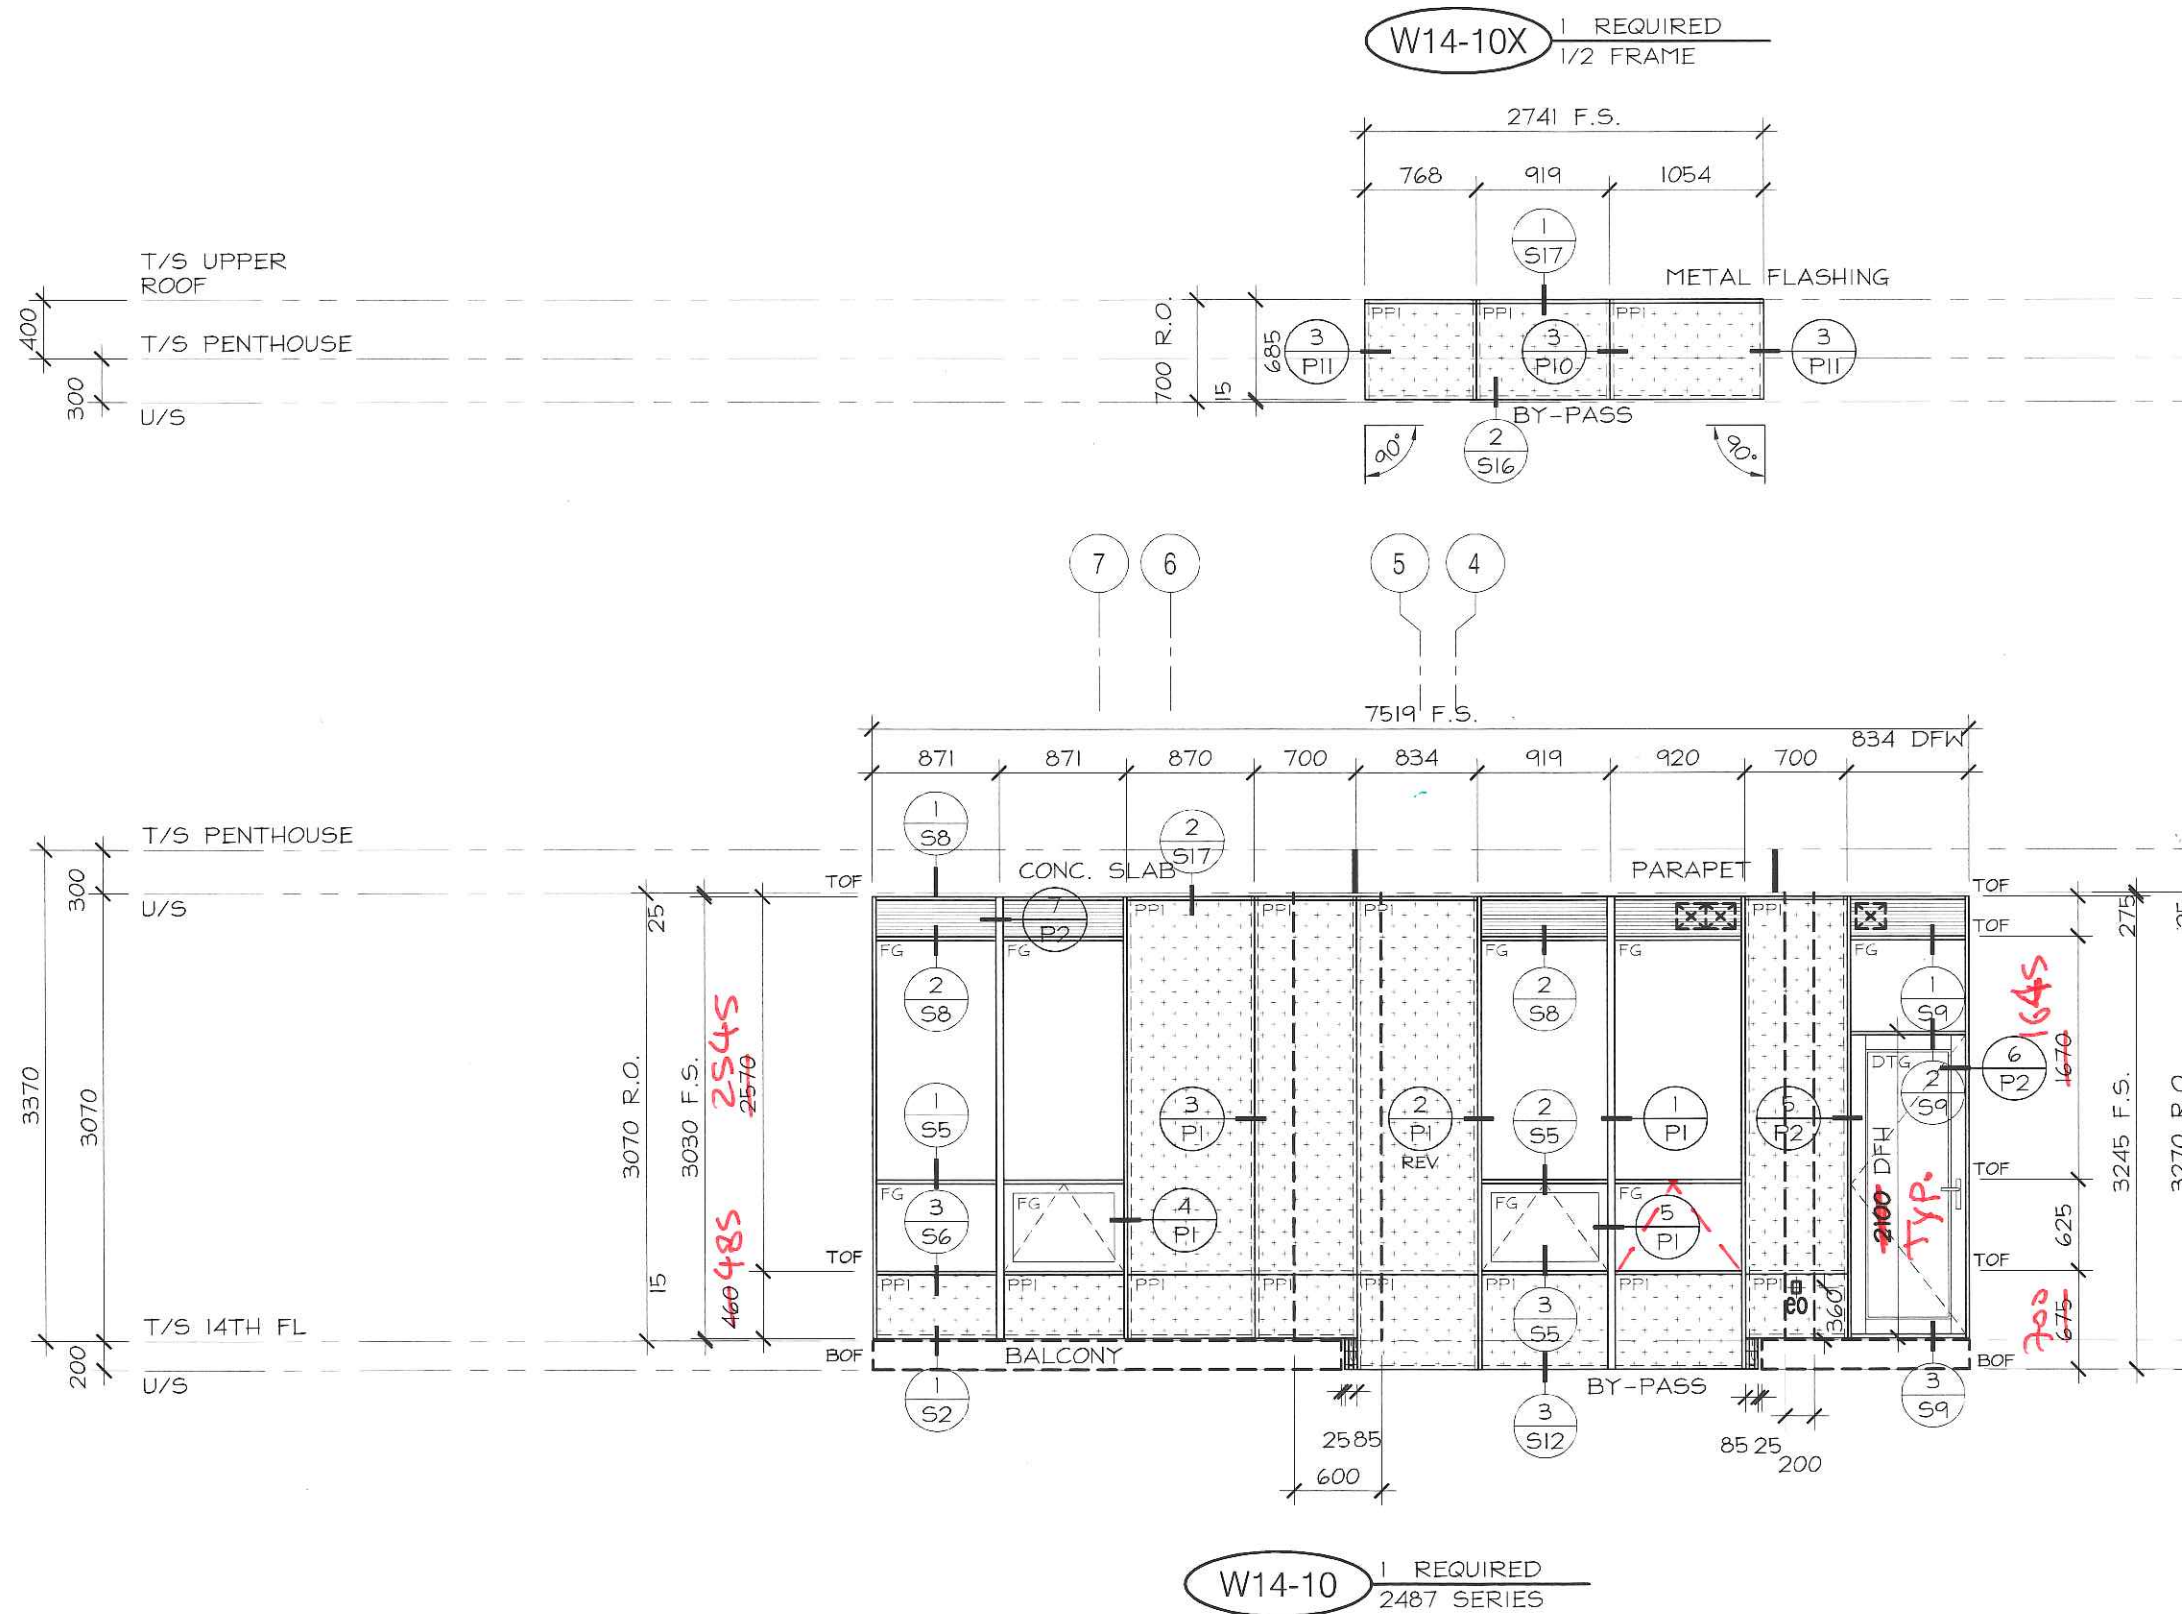



No.	REVISION	BY	DATE

PROJECT NAME:	SQ ALEXANDRA PARK - BLOCK11		
DRAWING TITLE:	14th FLOOR ELEVATIONS		
ARCHITECT:	TEEPLE ARCHITECTS		
CONTRACTOR:	TRIDEL		
SCALE:	1:50	DRAWN BY:	S.C.
DATE:	MARCH 4, 2015		
DRAWING No.:	E14-10		

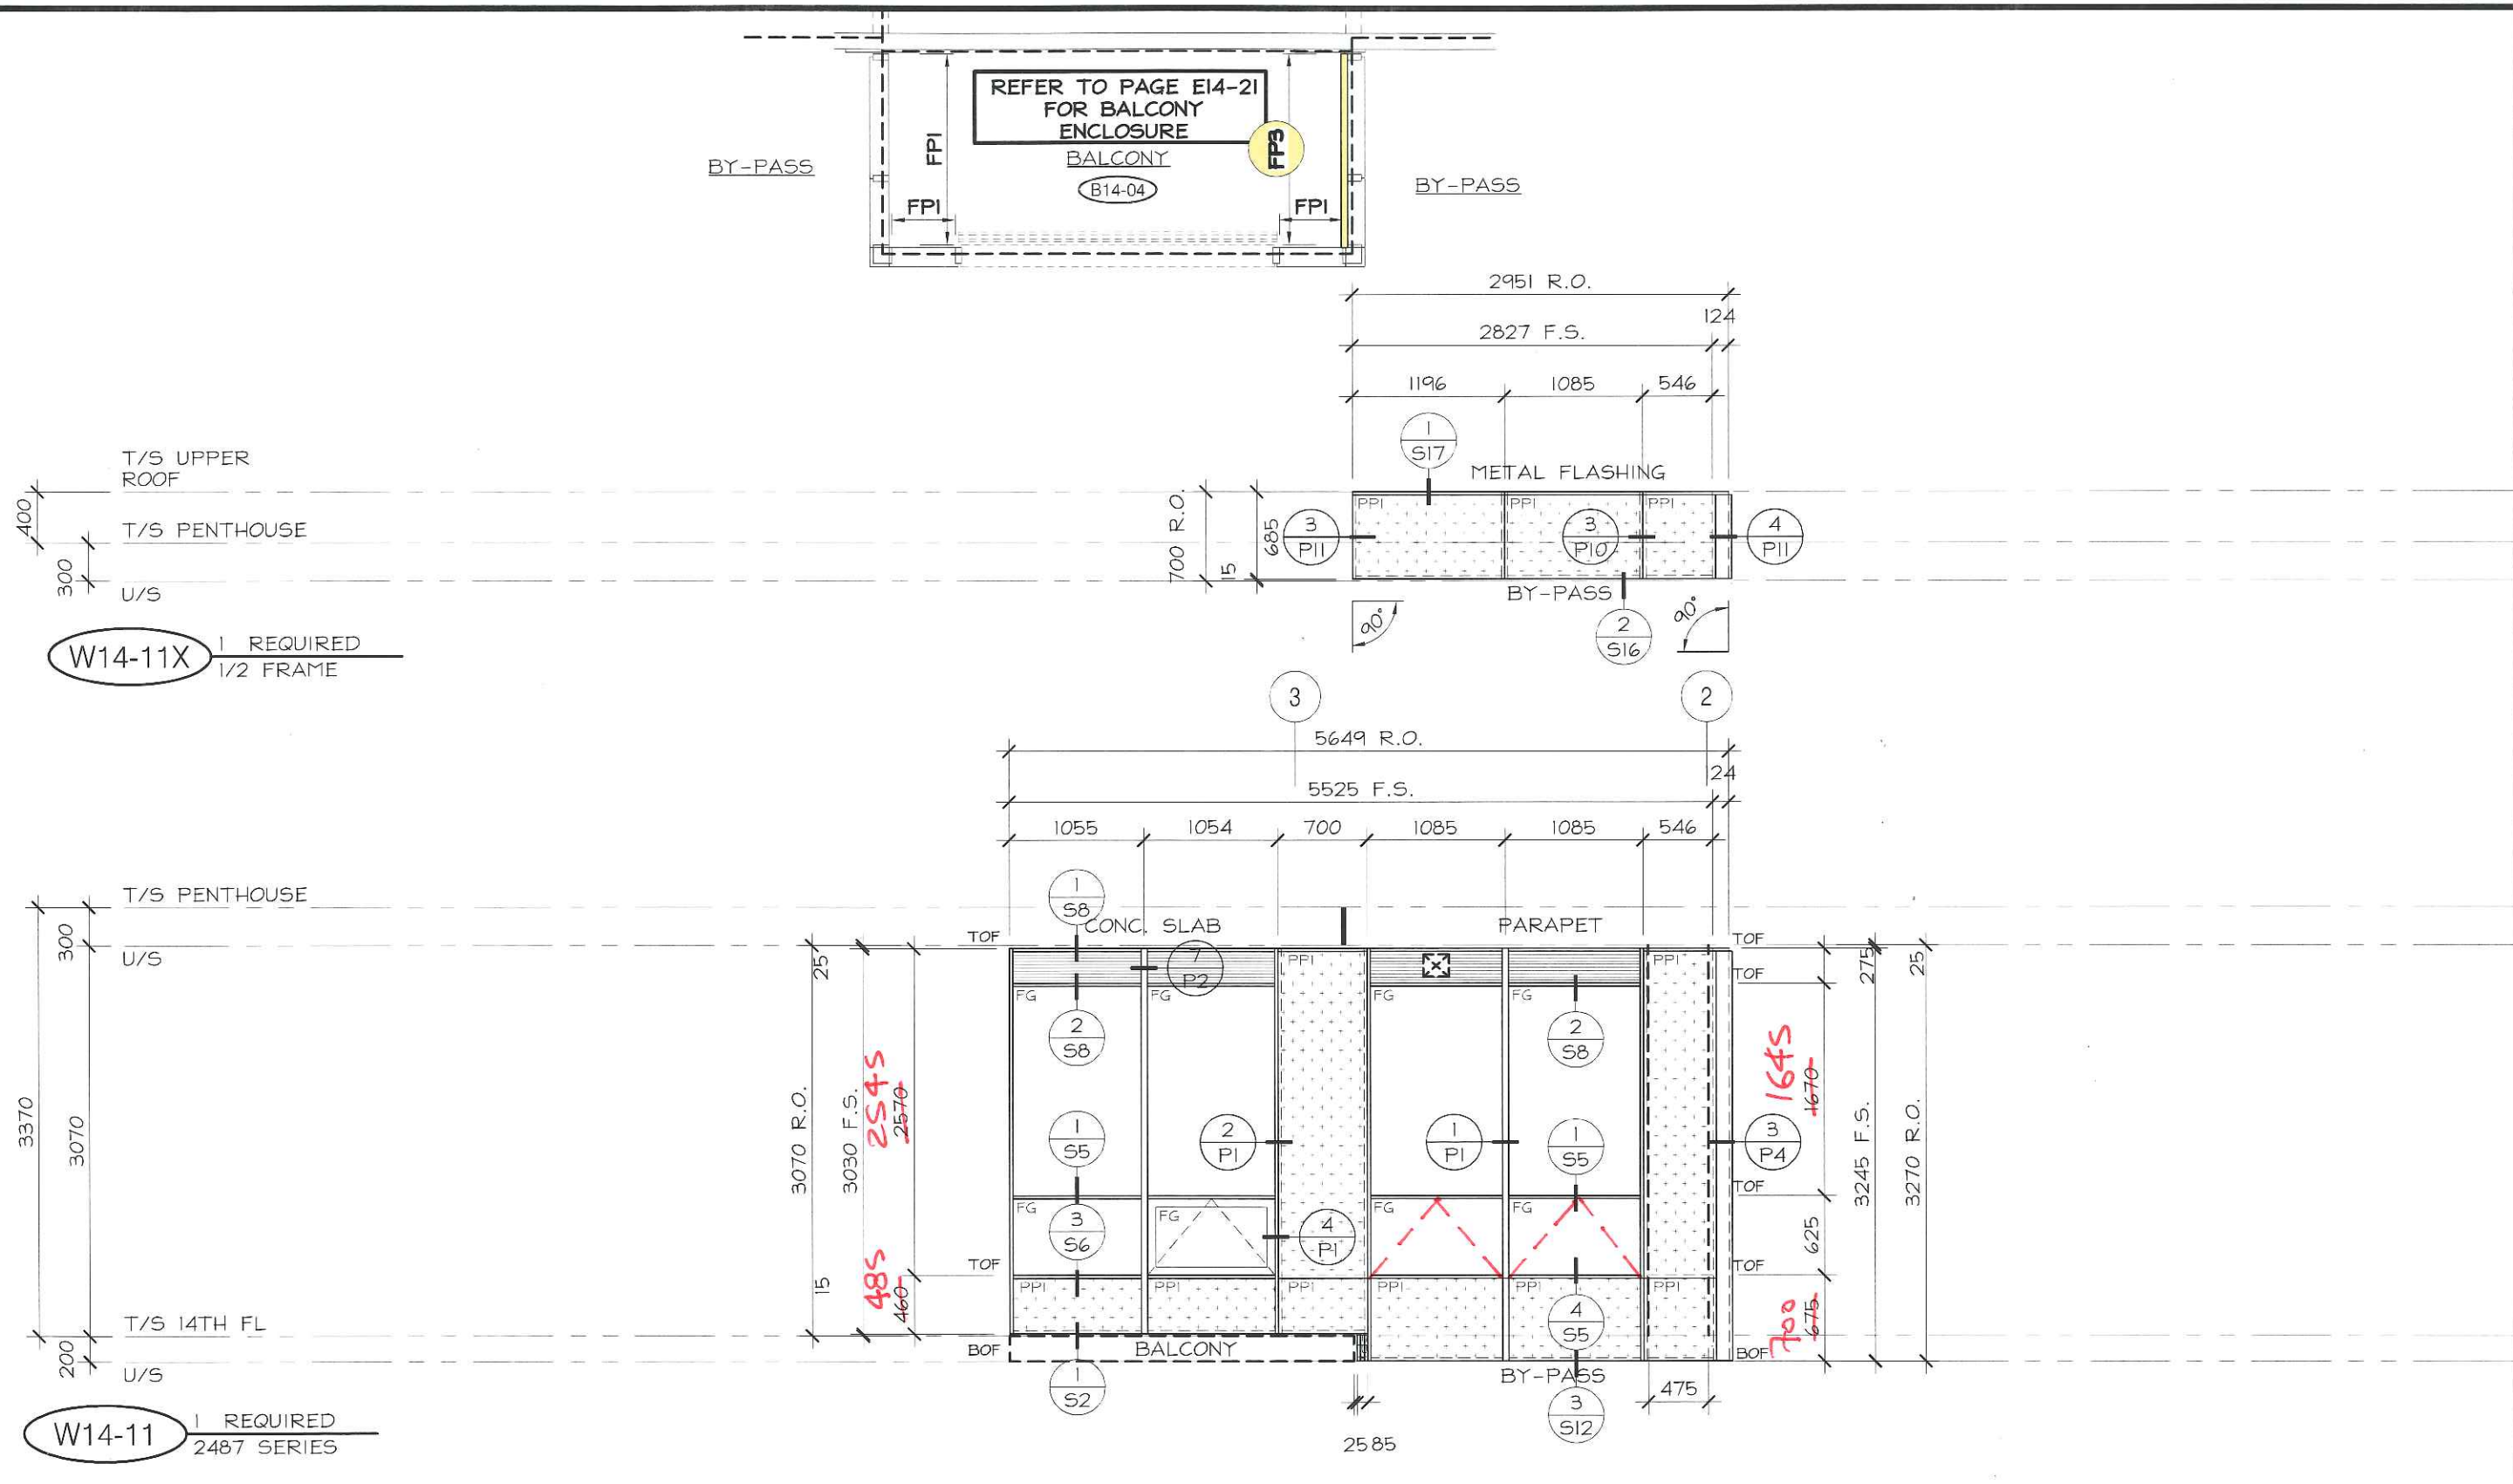



No.	REVISION	BY	DATE

PROJECT NAME: SQ ALEXANDRA PARK - BLOCK11		DRAWING No.: E14-11
DRAWING TITLE: 14th FLOOR ELEVATIONS		
ARCHITECT: TEEPLE ARCHITECTS		DATE: MARCH 4, 2015
CONTRACTOR: TRIDEL		
SCALE: 1:50	DRAWN BY: S.C.	

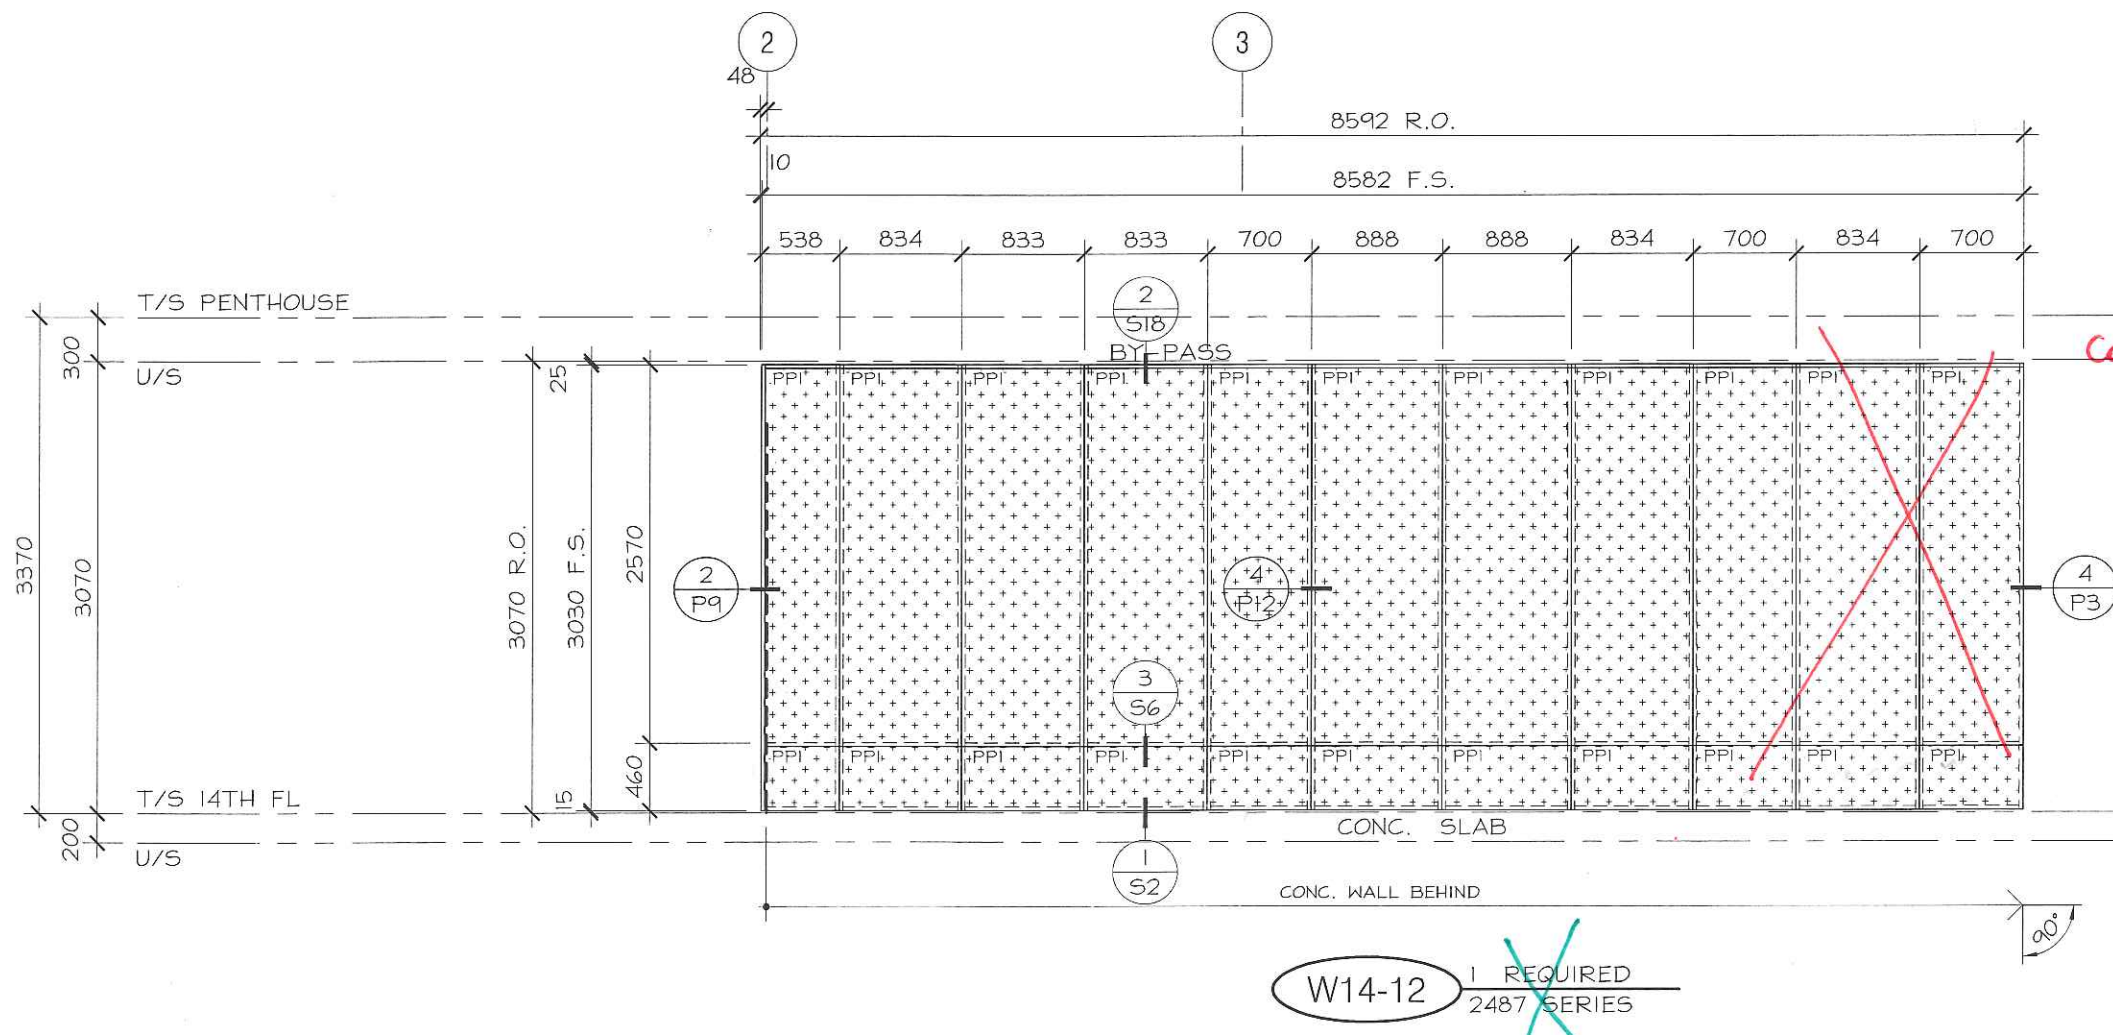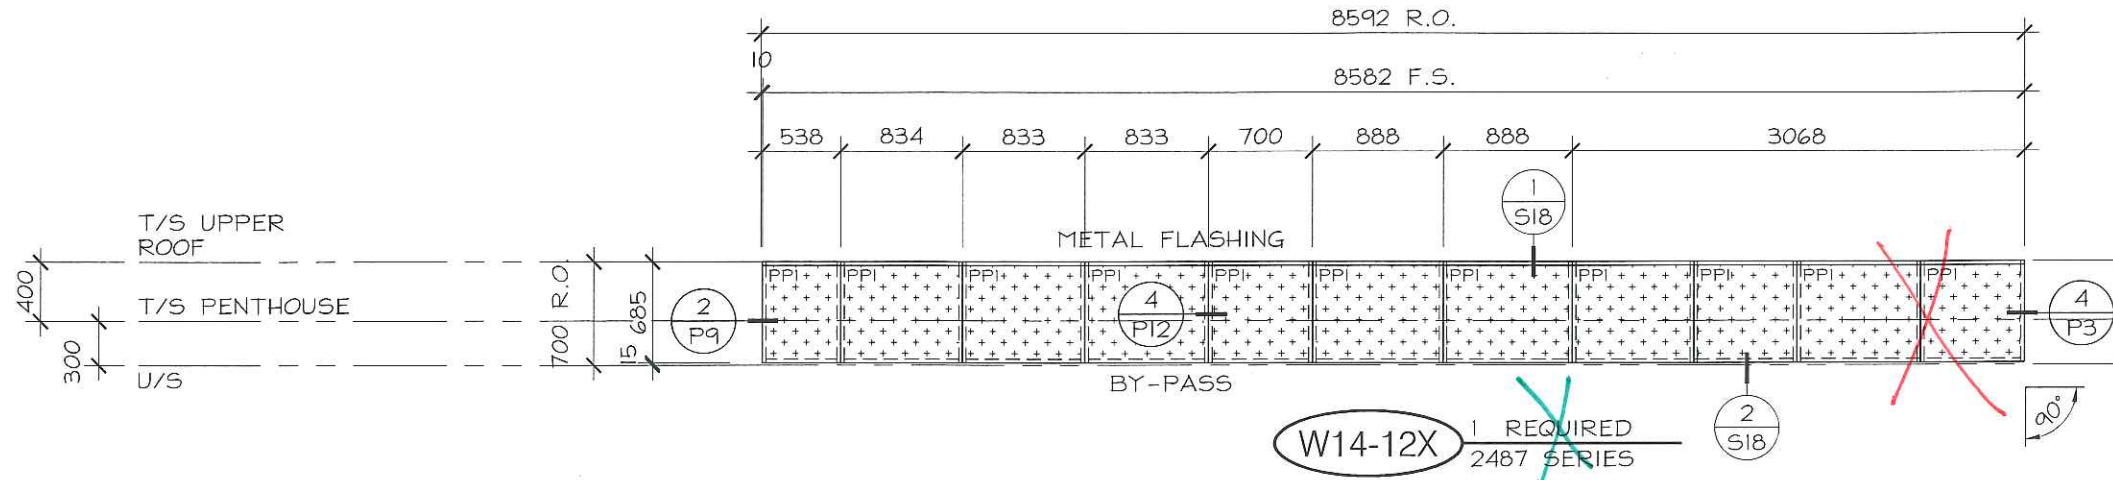


No.	REVISION	BY	DATE

PROJECT NAME: SQ ALEXANDRA PARK - BLOCK11		DRAWING No.: E14-12	
DRAWING TITLE: 14th FLOOR ELEVATIONS		ARCHITECT: TEEPLE ARCHITECTS	
CONTRACTOR: TRIDEL		DRAWN BY: S.C.	
SCALE: 1:50		DATE: MARCH 4, 2015	

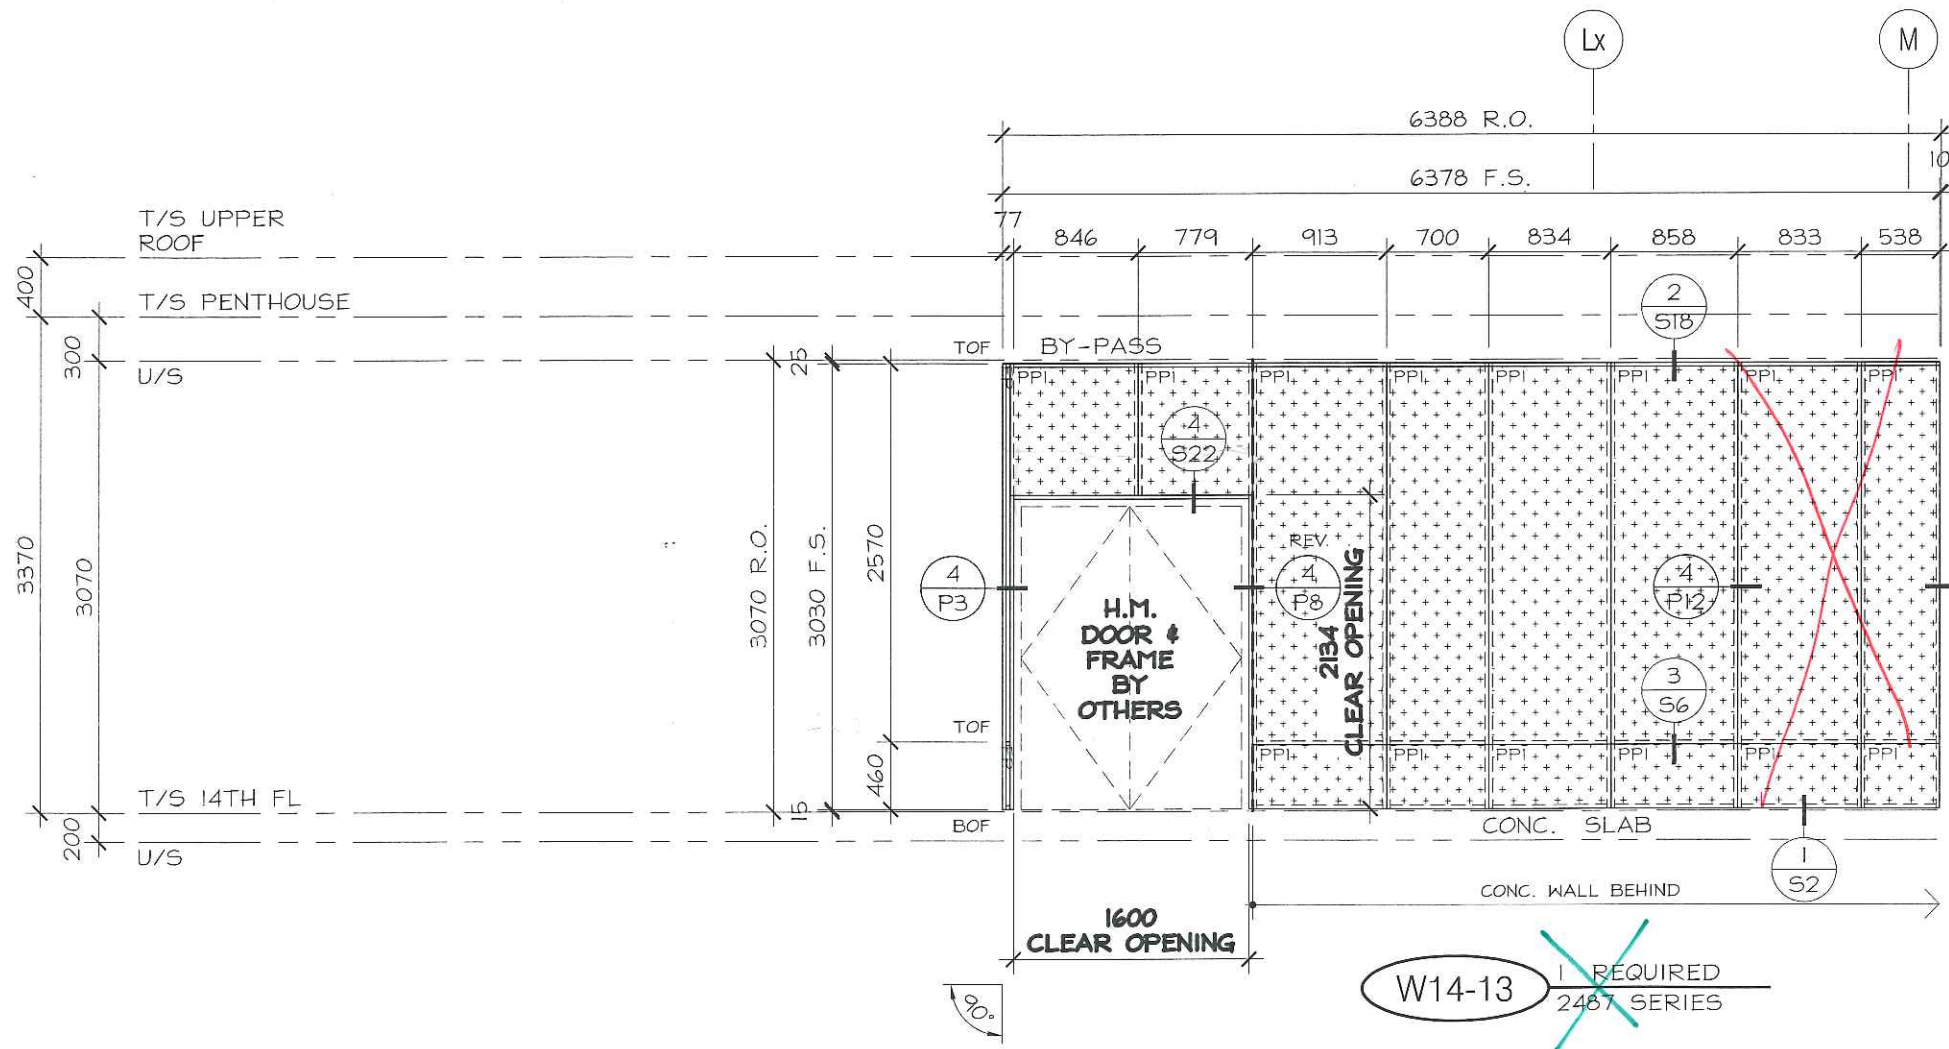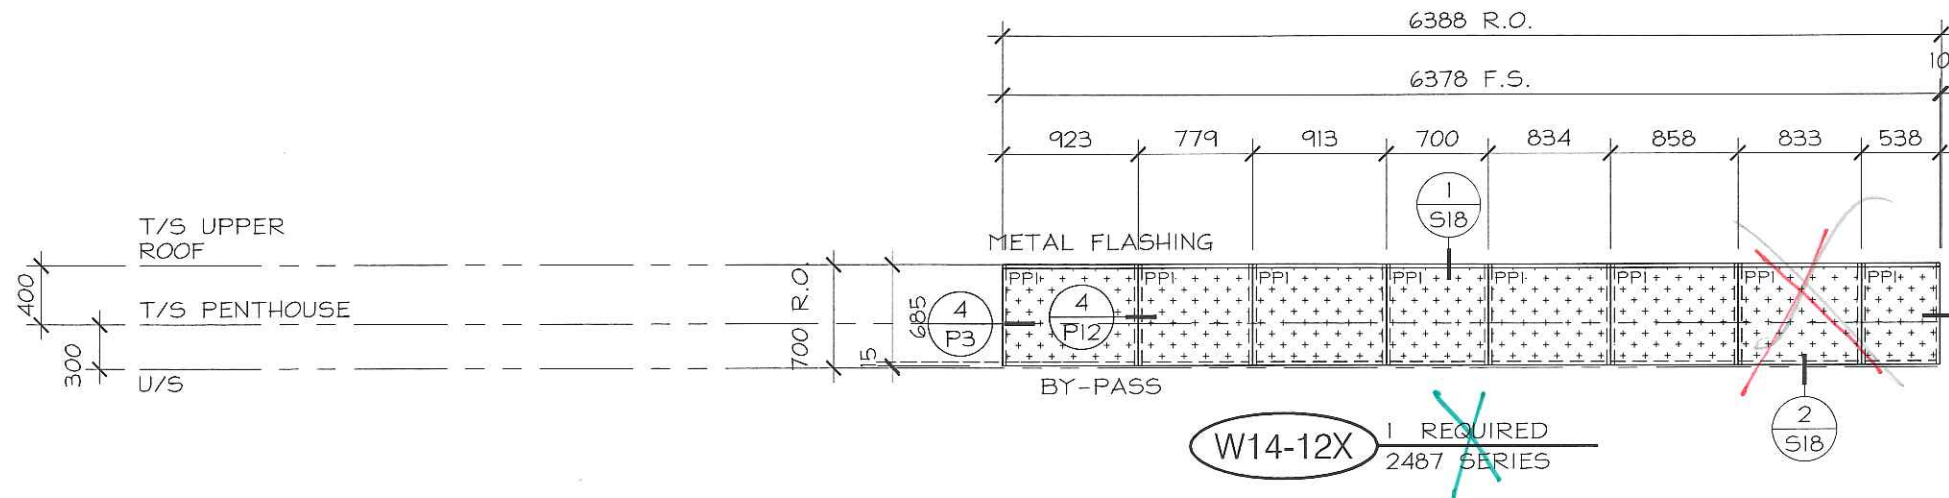

No.	REVISION	BY	DATE

PROJECT NAME: SQ ALEXANDRA PARK - BLOCK11		DRAWING No.: E14-13
DRAWING TITLE: 14th FLOOR ELEVATIONS		
ARCHITECT: TEEPLE ARCHITECTS		DATE: MARCH 4, 2015
CONTRACTOR: TRIDEL		
SCALE: 1:50	DRAWN BY: S.C.	

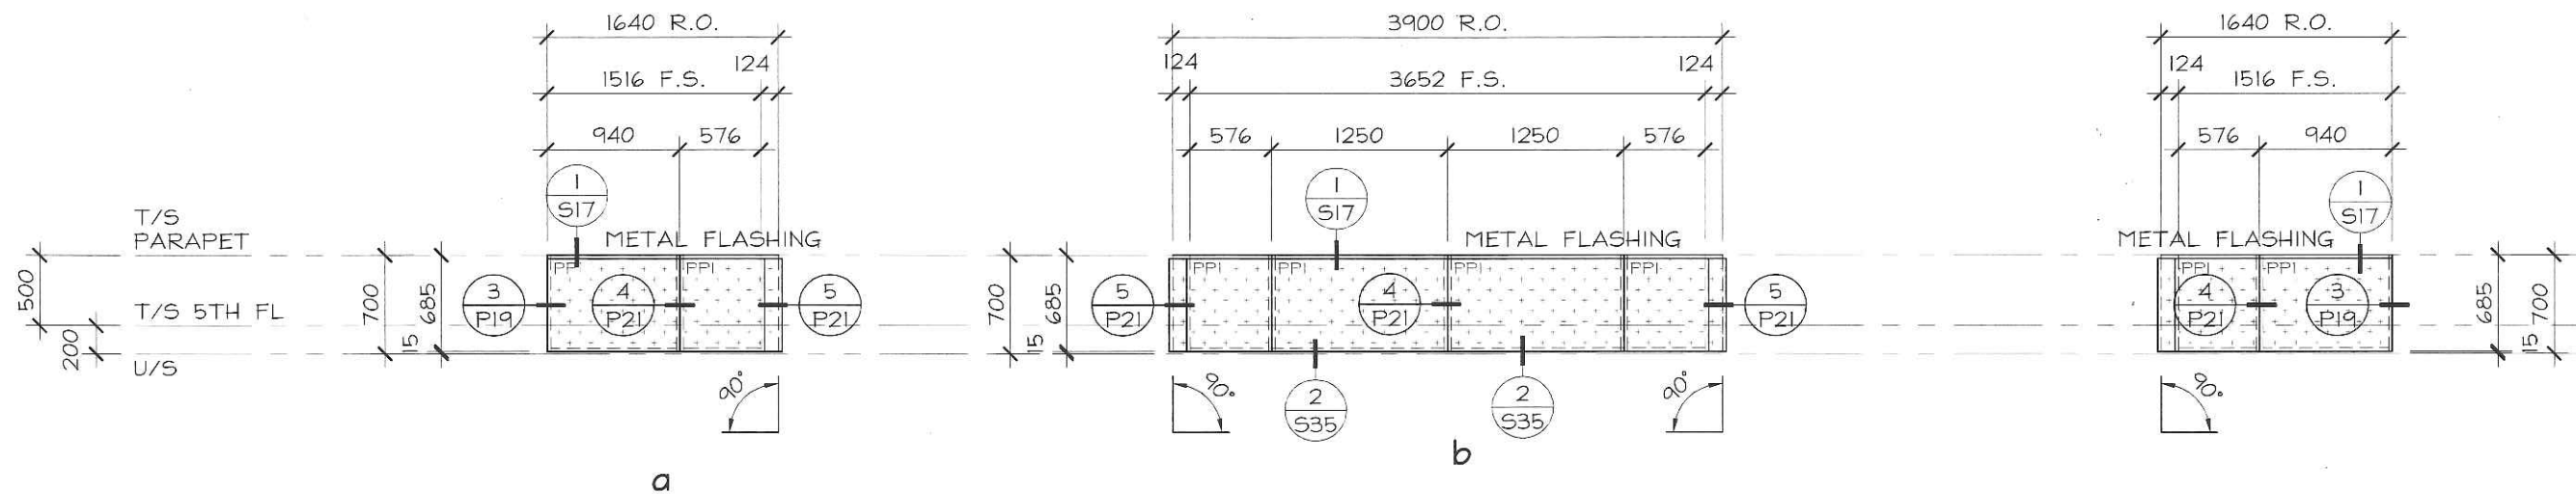


B14-01X 1 REQUIRED
1/2 FRAME



No.	REVISION	BY	DATE

PROJECT NAME: SQ ALEXANDRA PARK - BLOCK11	
DRAWING TITLE: 14th FLOOR ELEVATIONS	
ARCHITECT: TEEPLE ARCHITECTS	DRAWING No.: E14-14
CONTRACTOR: TRIDEL	SCALE: 1:50
DRAWN BY: S.C.	DATE: MARCH 4, 2015

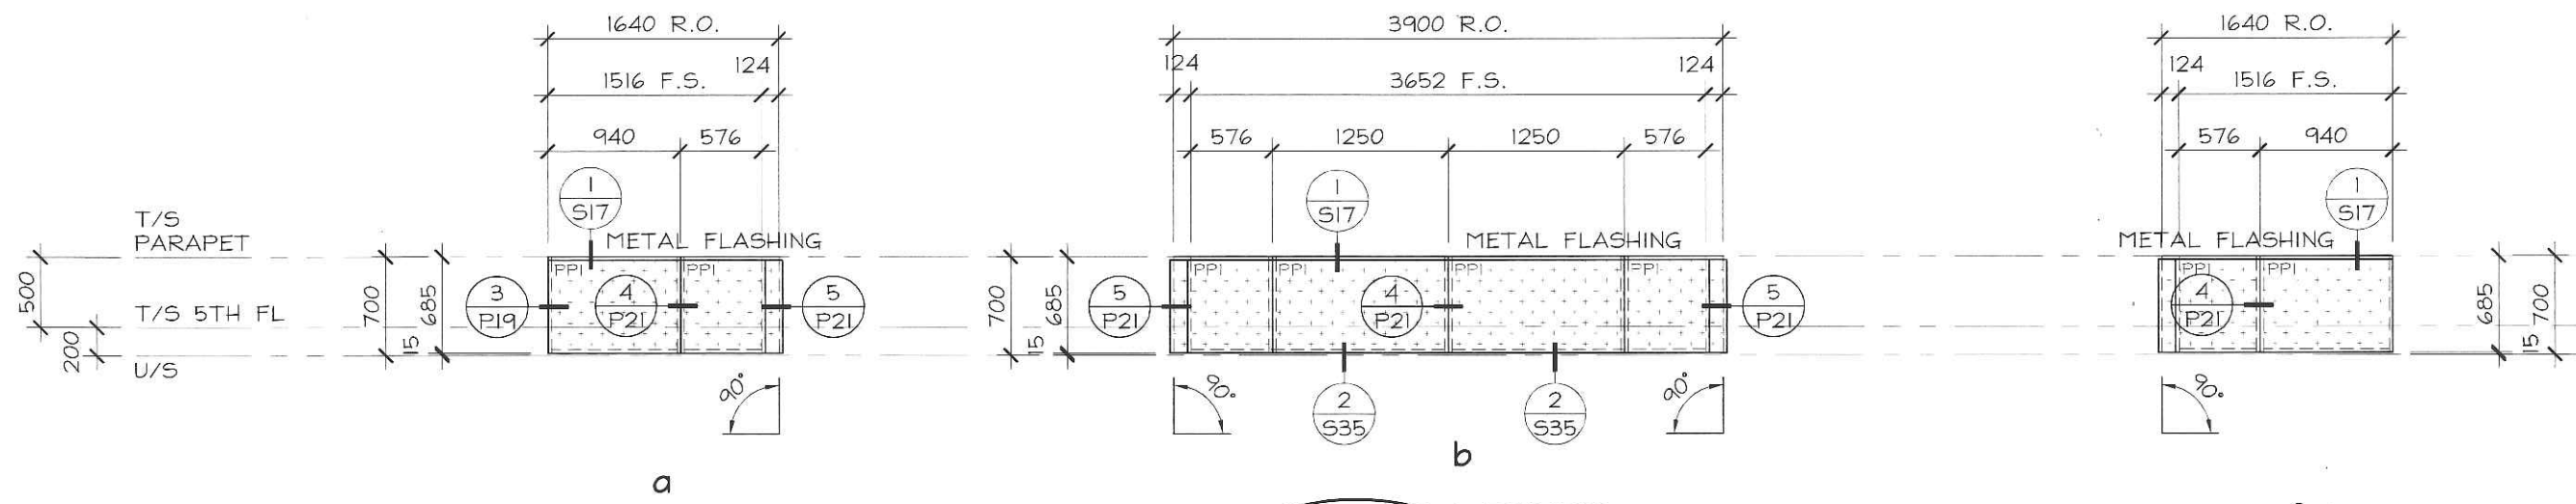


B14-02X 1 REQUIRED
1/2 FRAME




No.	REVISION	BY	DATE

PROJECT NAME: SQ ALEXANDRA PARK - BLOCK 11		DRAWING No.: E14-15
DRAWING TITLE: 14th FLOOR ELEVATIONS		
ARCHITECT: TEEPLE ARCHITECTS		DATE: MARCH 4, 2015
CONTRACTOR: TRIDEL		
SCALE: 1:50	DRAWN BY: S.C.	

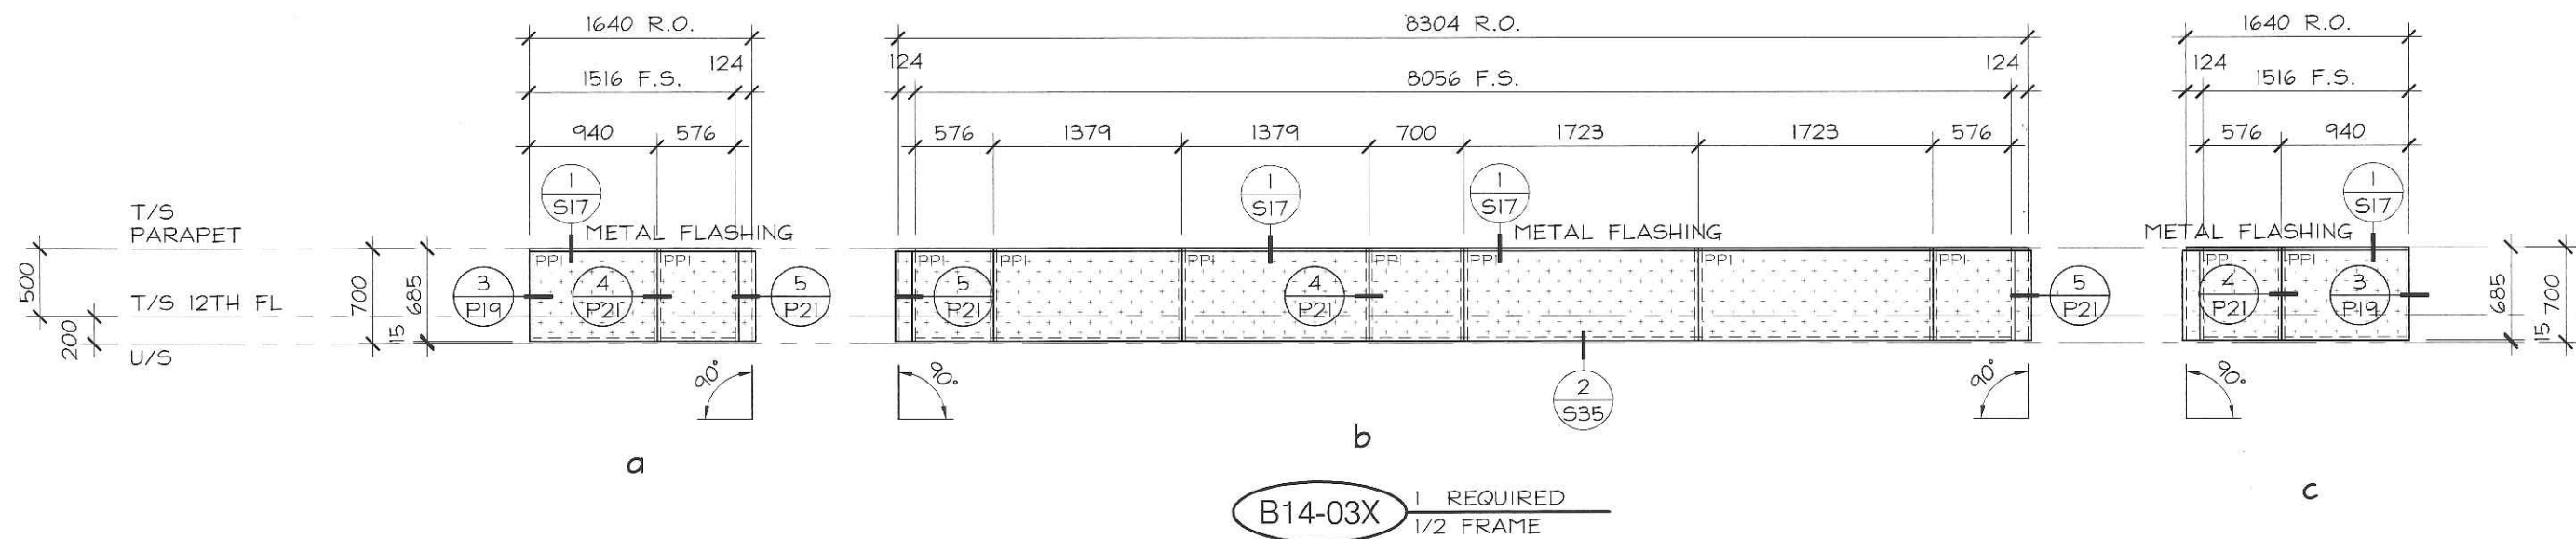

No.	REVISION	BY	DATE

PROJECT NAME: SQ ALEXANDRA PARK - BLOCK11		DRAWING No.: E14-16
DRAWING TITLE: 14th FLOOR ELEVATIONS		
ARCHITECT: TEEPLE ARCHITECTS		DATE: MARCH 4, 2015
CONTRACTOR: TRIDEL		
SCALE: 1:50	DRAWN BY: S.C.	

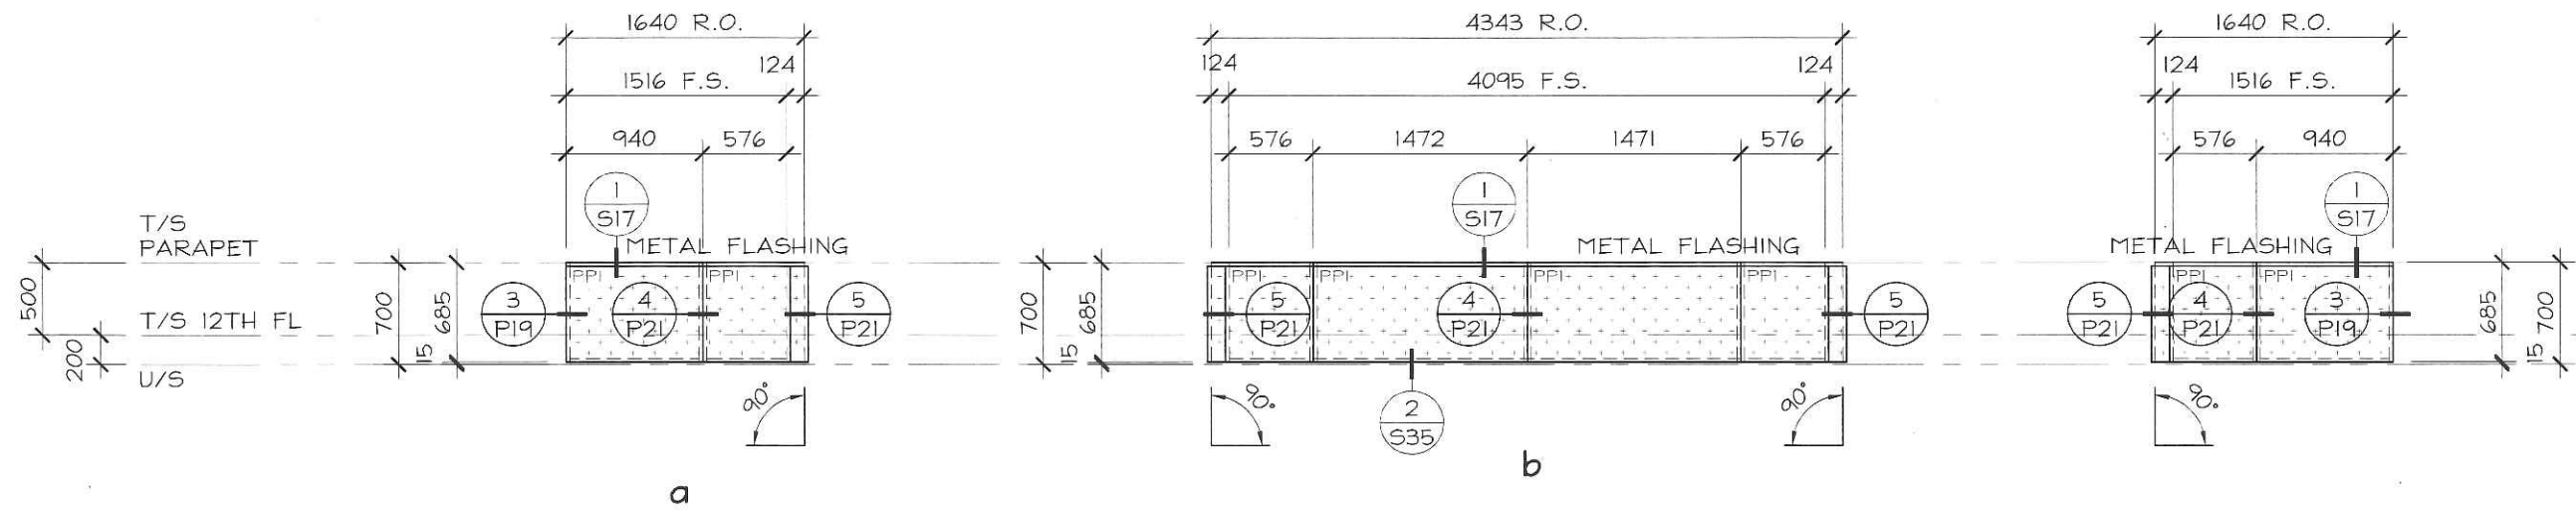

B14-04X 1 REQUIRED
1/2 FRAME





No.	REVISION	BY	DATE

PROJECT NAME:	SQ ALEXANDRA PARK - BLOCK11		
DRAWING TITLE:	14th FLOOR ELEVATIONS		
ARCHITECT:	TEEPLE ARCHITECTS		
CONTRACTOR:	TRIDEL		
SCALE:	1:50	DRAWN BY:	S.C.
DATE:	MARCH 4, 2015		

DRAWING No.:
E14-17

FOR ALUMINUM BALCONY
 & TERRACE RAILINGS
 REFER TO TORO
 ALUMINUM RAILING SHOP
 DRAWINGS

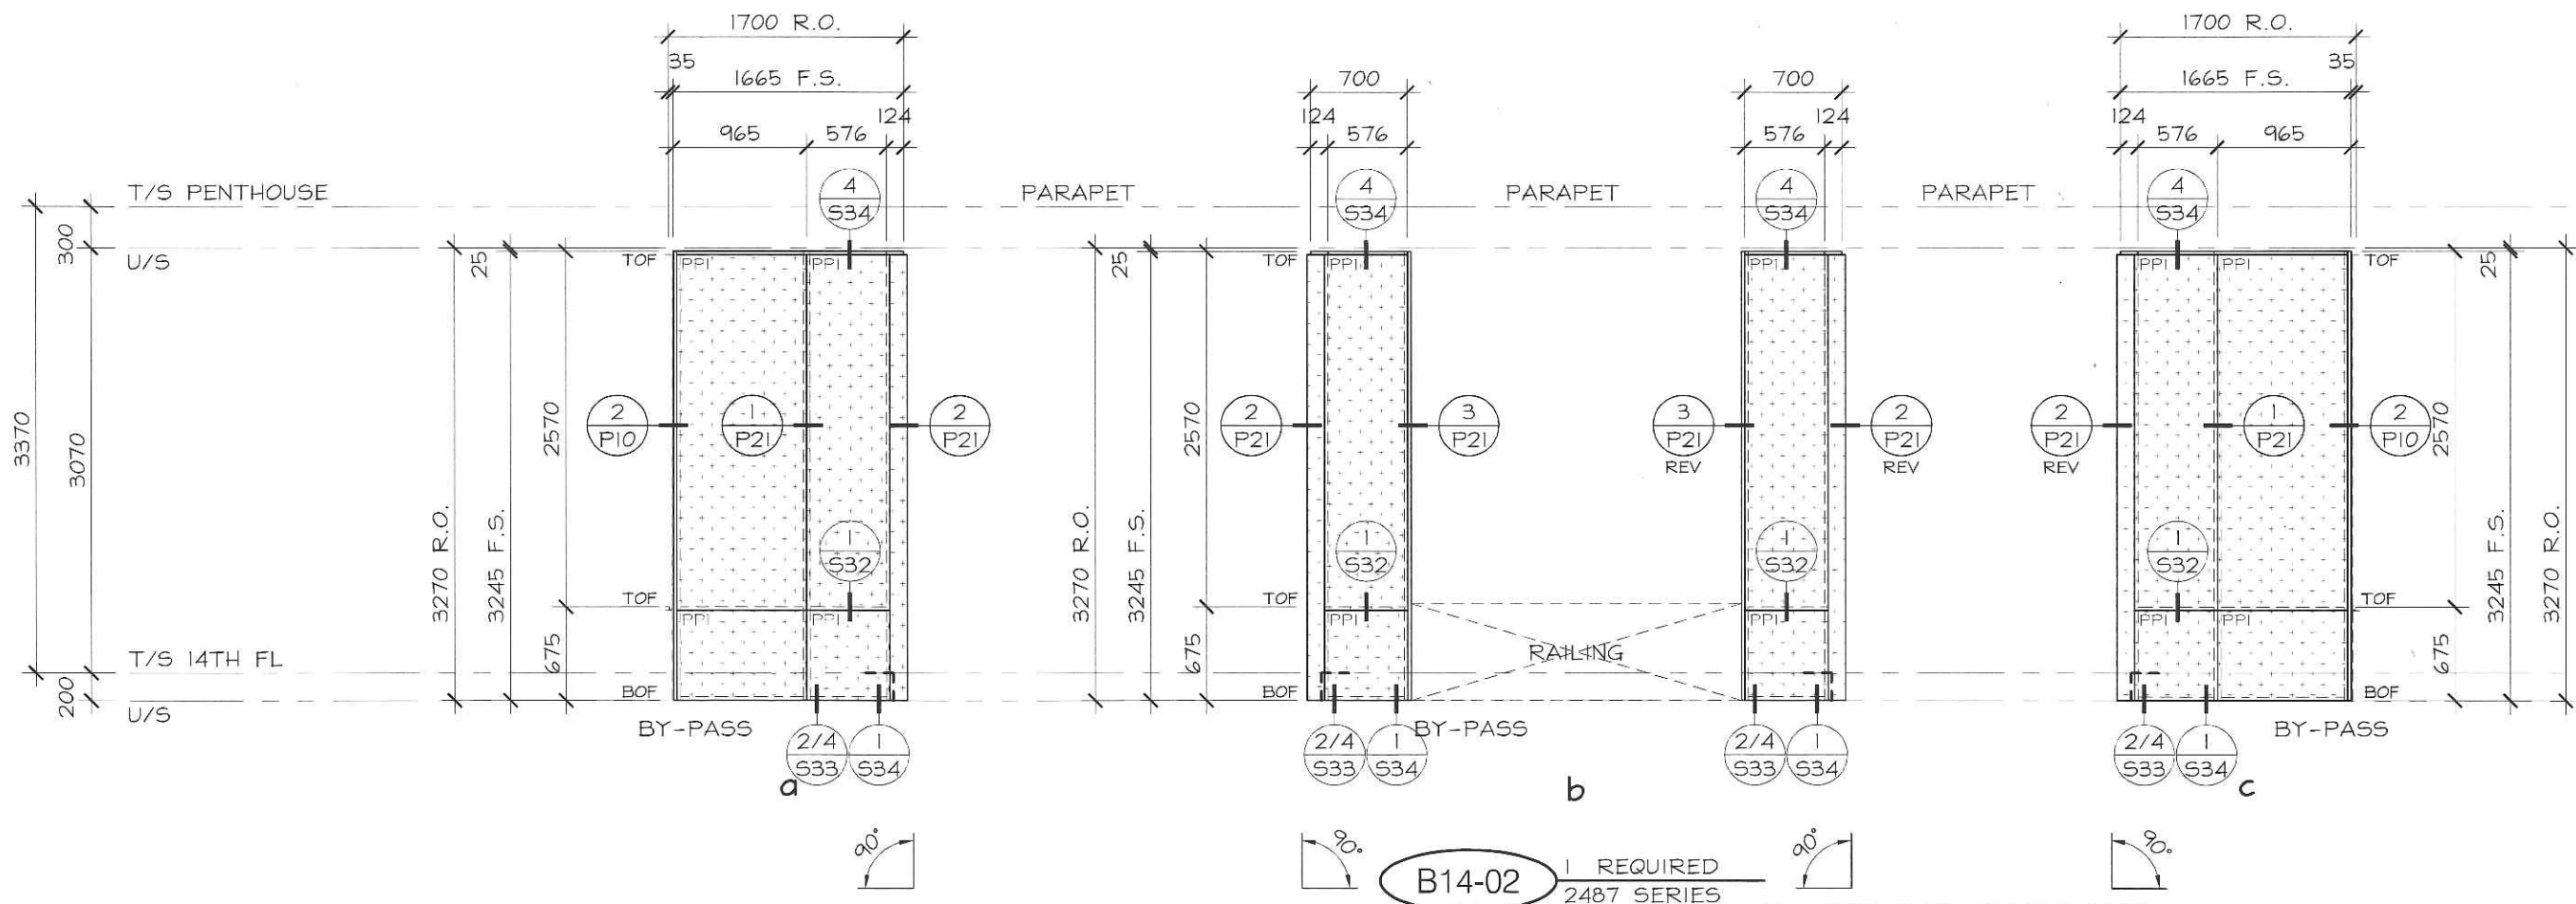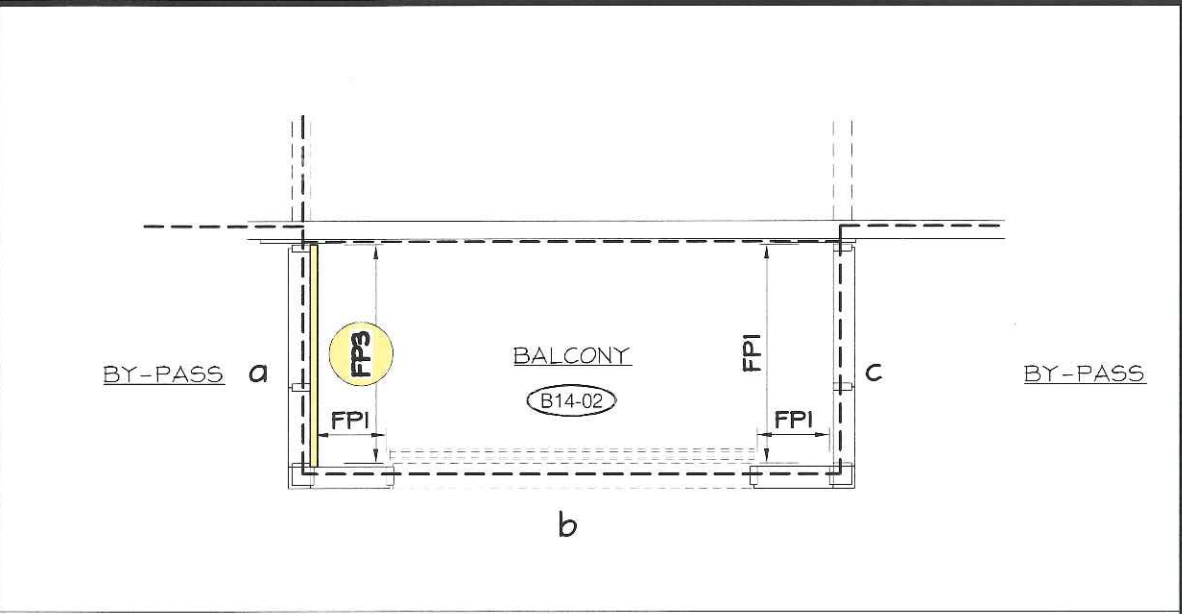



B14-02 1 REQUIRED
 2487 SERIES
 EXT. FINISH: PPG ACRYNAR PLATINUM UCFXIII85
 INT. FINISH: PPG ACRYNAR PLATINUM UCFXIII85
 INT. FINISH: PPG ACRYNAR T.B.D.



No.	REVISION	BY	DATE

PROJECT NAME:	SQ ALEXANDRA PARK - BLOCK 11		
DRAWING TITLE:	14th FLOOR ELEVATIONS		
ARCHITECT:	TEEPLE ARCHITECTS		
CONTRACTOR:	TRIDEL		
SCALE:	1:50	DRAWN BY:	S.C.
DATE:	MARCH 4, 2015		
DRAWING No.:	E14-19		

FOR ALUMINUM BALCONY
 & TERRACE RAILINGS
 REFER TO TORO
 ALUMINUM RAILING SHOP
 DRAWINGS

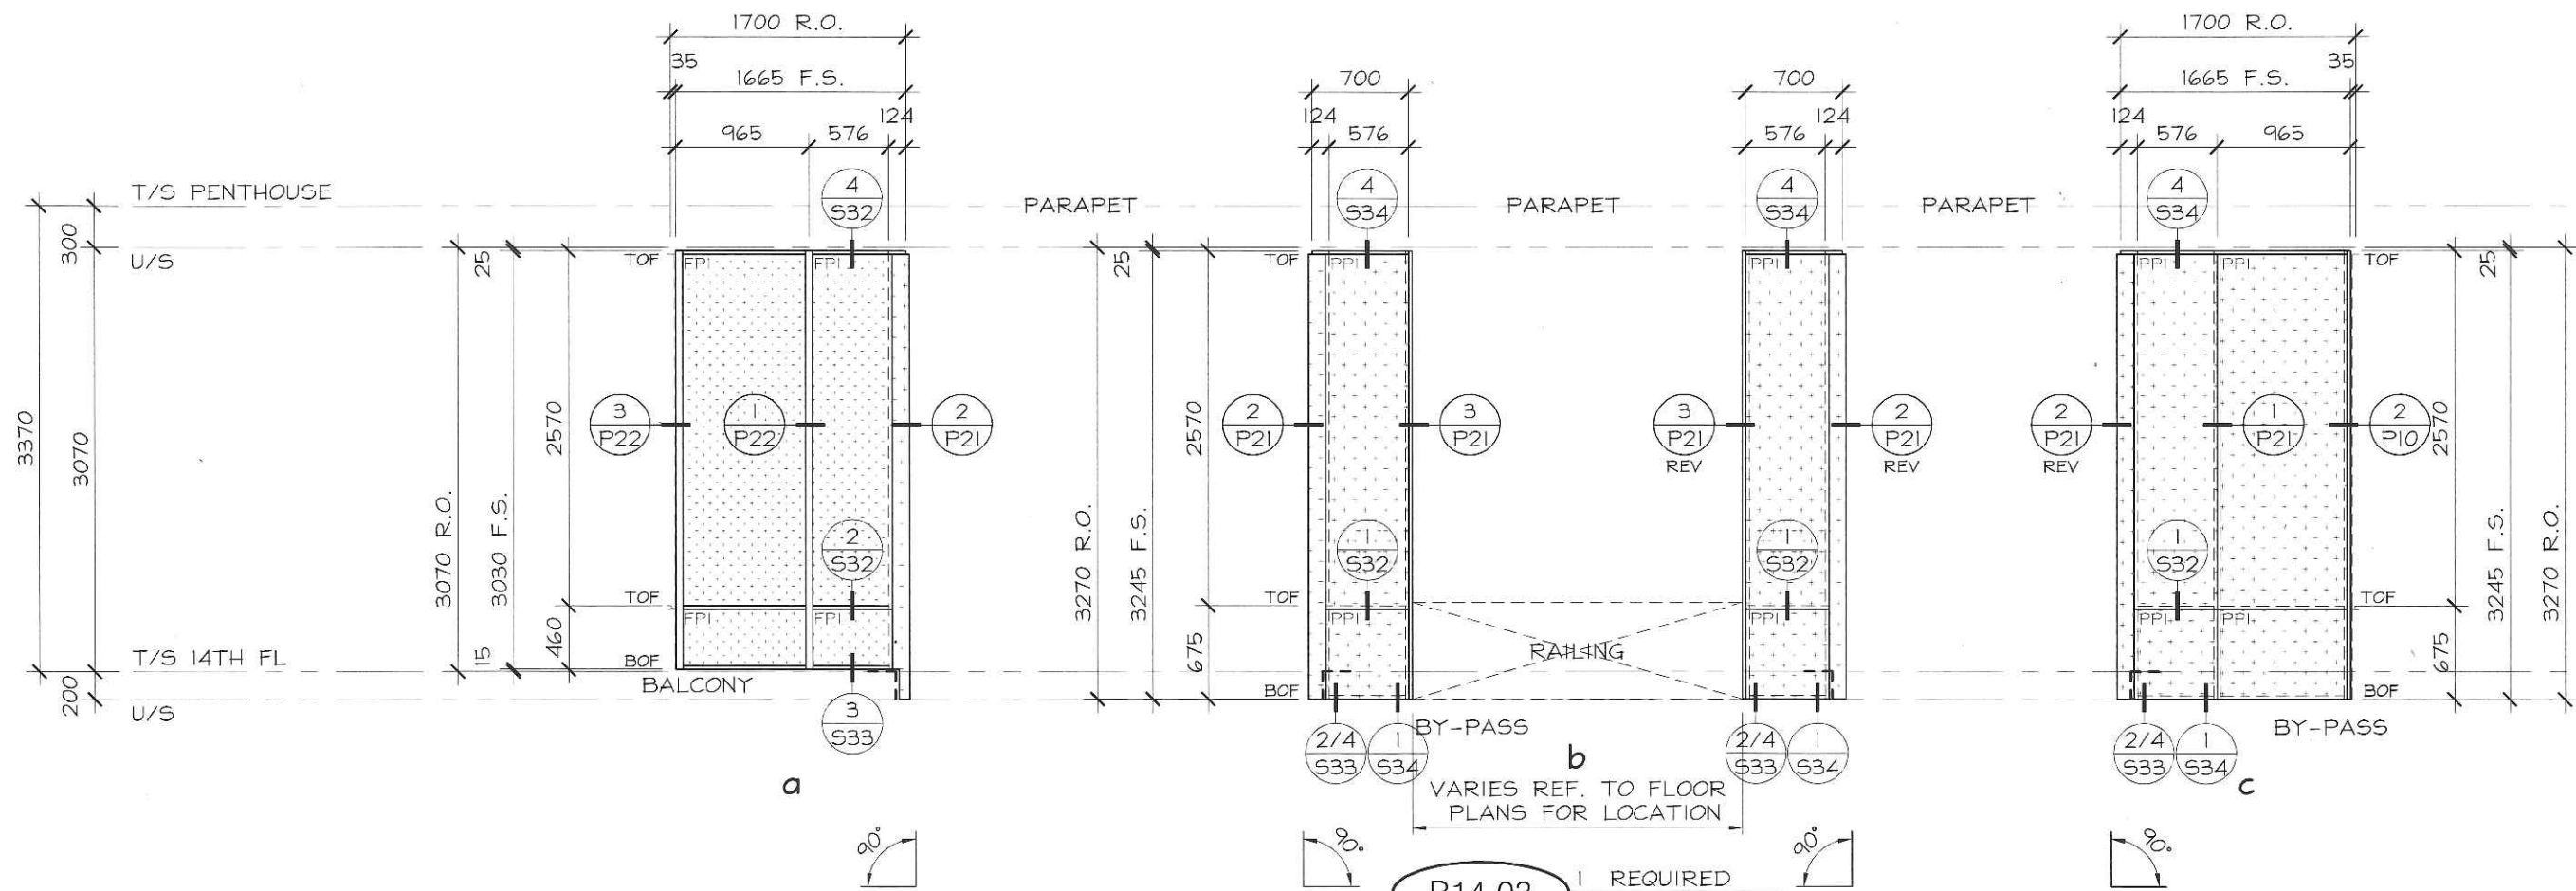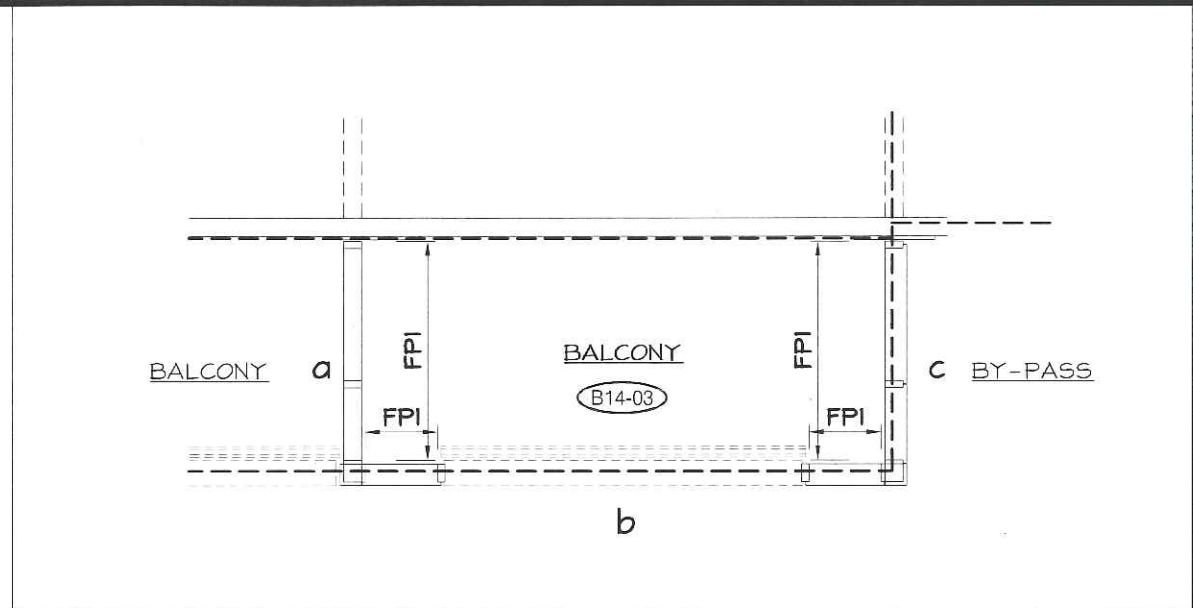



B14-03 1 REQUIRED
 2487 SERIES
 EXT. FINISH: PPG ACRYNAR PLATINUM UCFXIII85
 INT. FINISH: PPG ACRYNAR PLATINUM UCFXIII85



No.	REVISION	BY	DATE

PROJECT NAME: SQ ALEXANDRA PARK - BLOCK11		DRAWING No.: E14-20
DRAWING TITLE: 14th FLOOR ELEVATIONS		
ARCHITECT: TEEPLE ARCHITECTS		SCALE: 1:50
CONTRACTOR: TRIDEL		
DRAWN BY: S.C.		DATE: MARCH 4, 2015

FOR ALUMINUM BALCONY
 & TERRACE RAILINGS
 REFER TO TORO
 ALUMINUM RAILING SHOP
 DRAWINGS

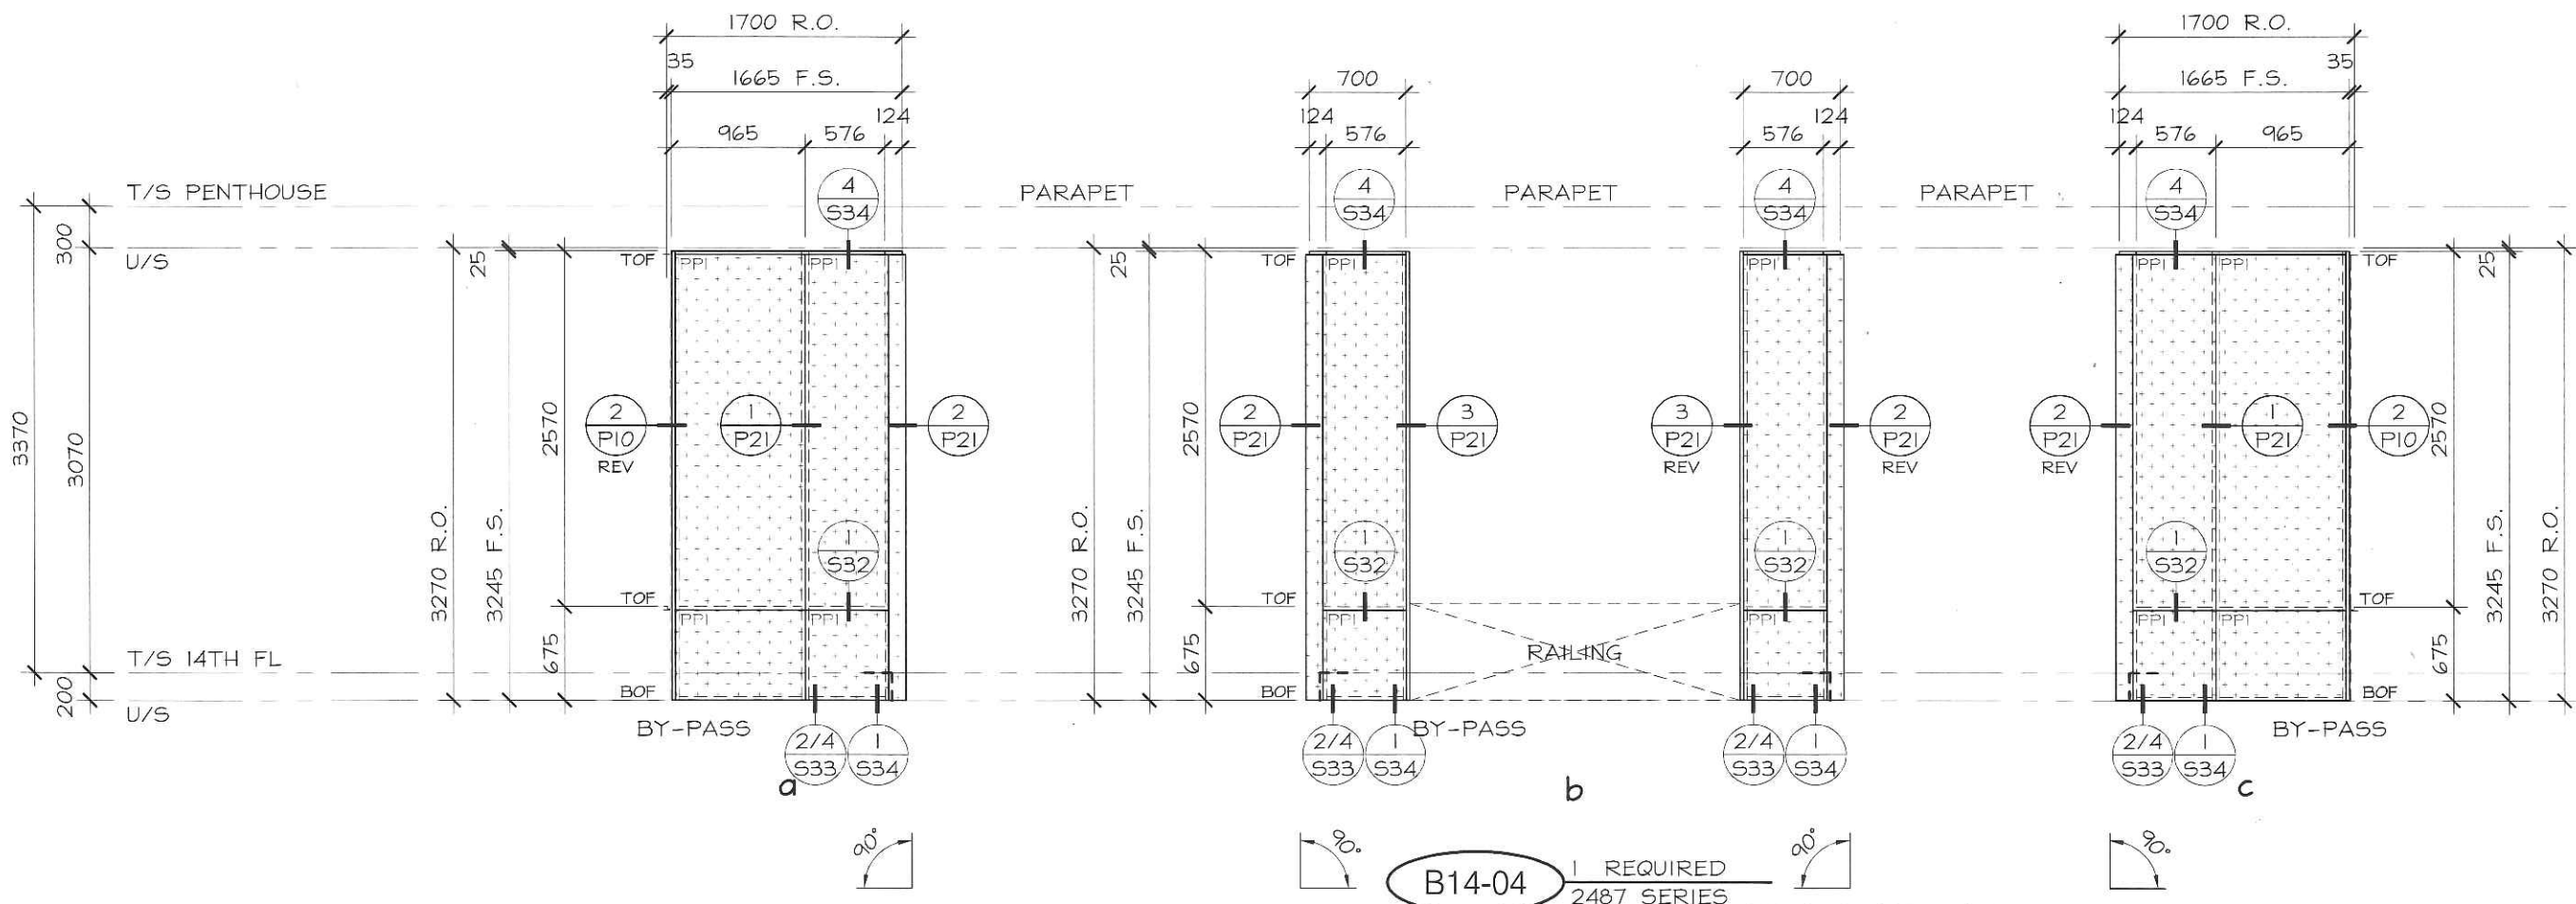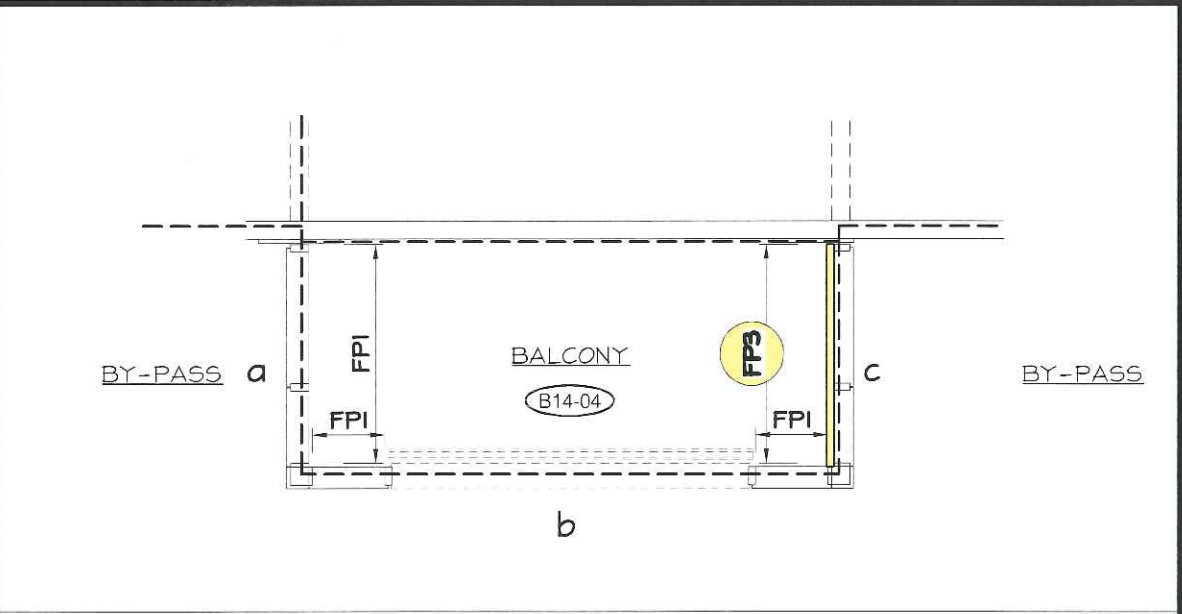


B14-04 1 REQUIRED
 2487 SERIES
 EXT. FINISH: PPG ACRYNAR PLATINUM UCFX11185
 INT. FINISH: PPG ACRYNAR PLATINUM UCFX11185
 INT. FINISH: PPG ACRYNAR T.B.D.



No.	REVISION	BY	DATE

PROJECT NAME: SQ ALEXANDRA PARK - BLOCK11		DRAWING No.: E14-21
DRAWING TITLE: 14th FLOOR ELEVATIONS		
ARCHITECT: TEEPLE ARCHITECTS		DATE: MARCH 4, 2015
CONTRACTOR: TRIDEL		
SCALE: 1:50	DRAWN BY: S.C.	

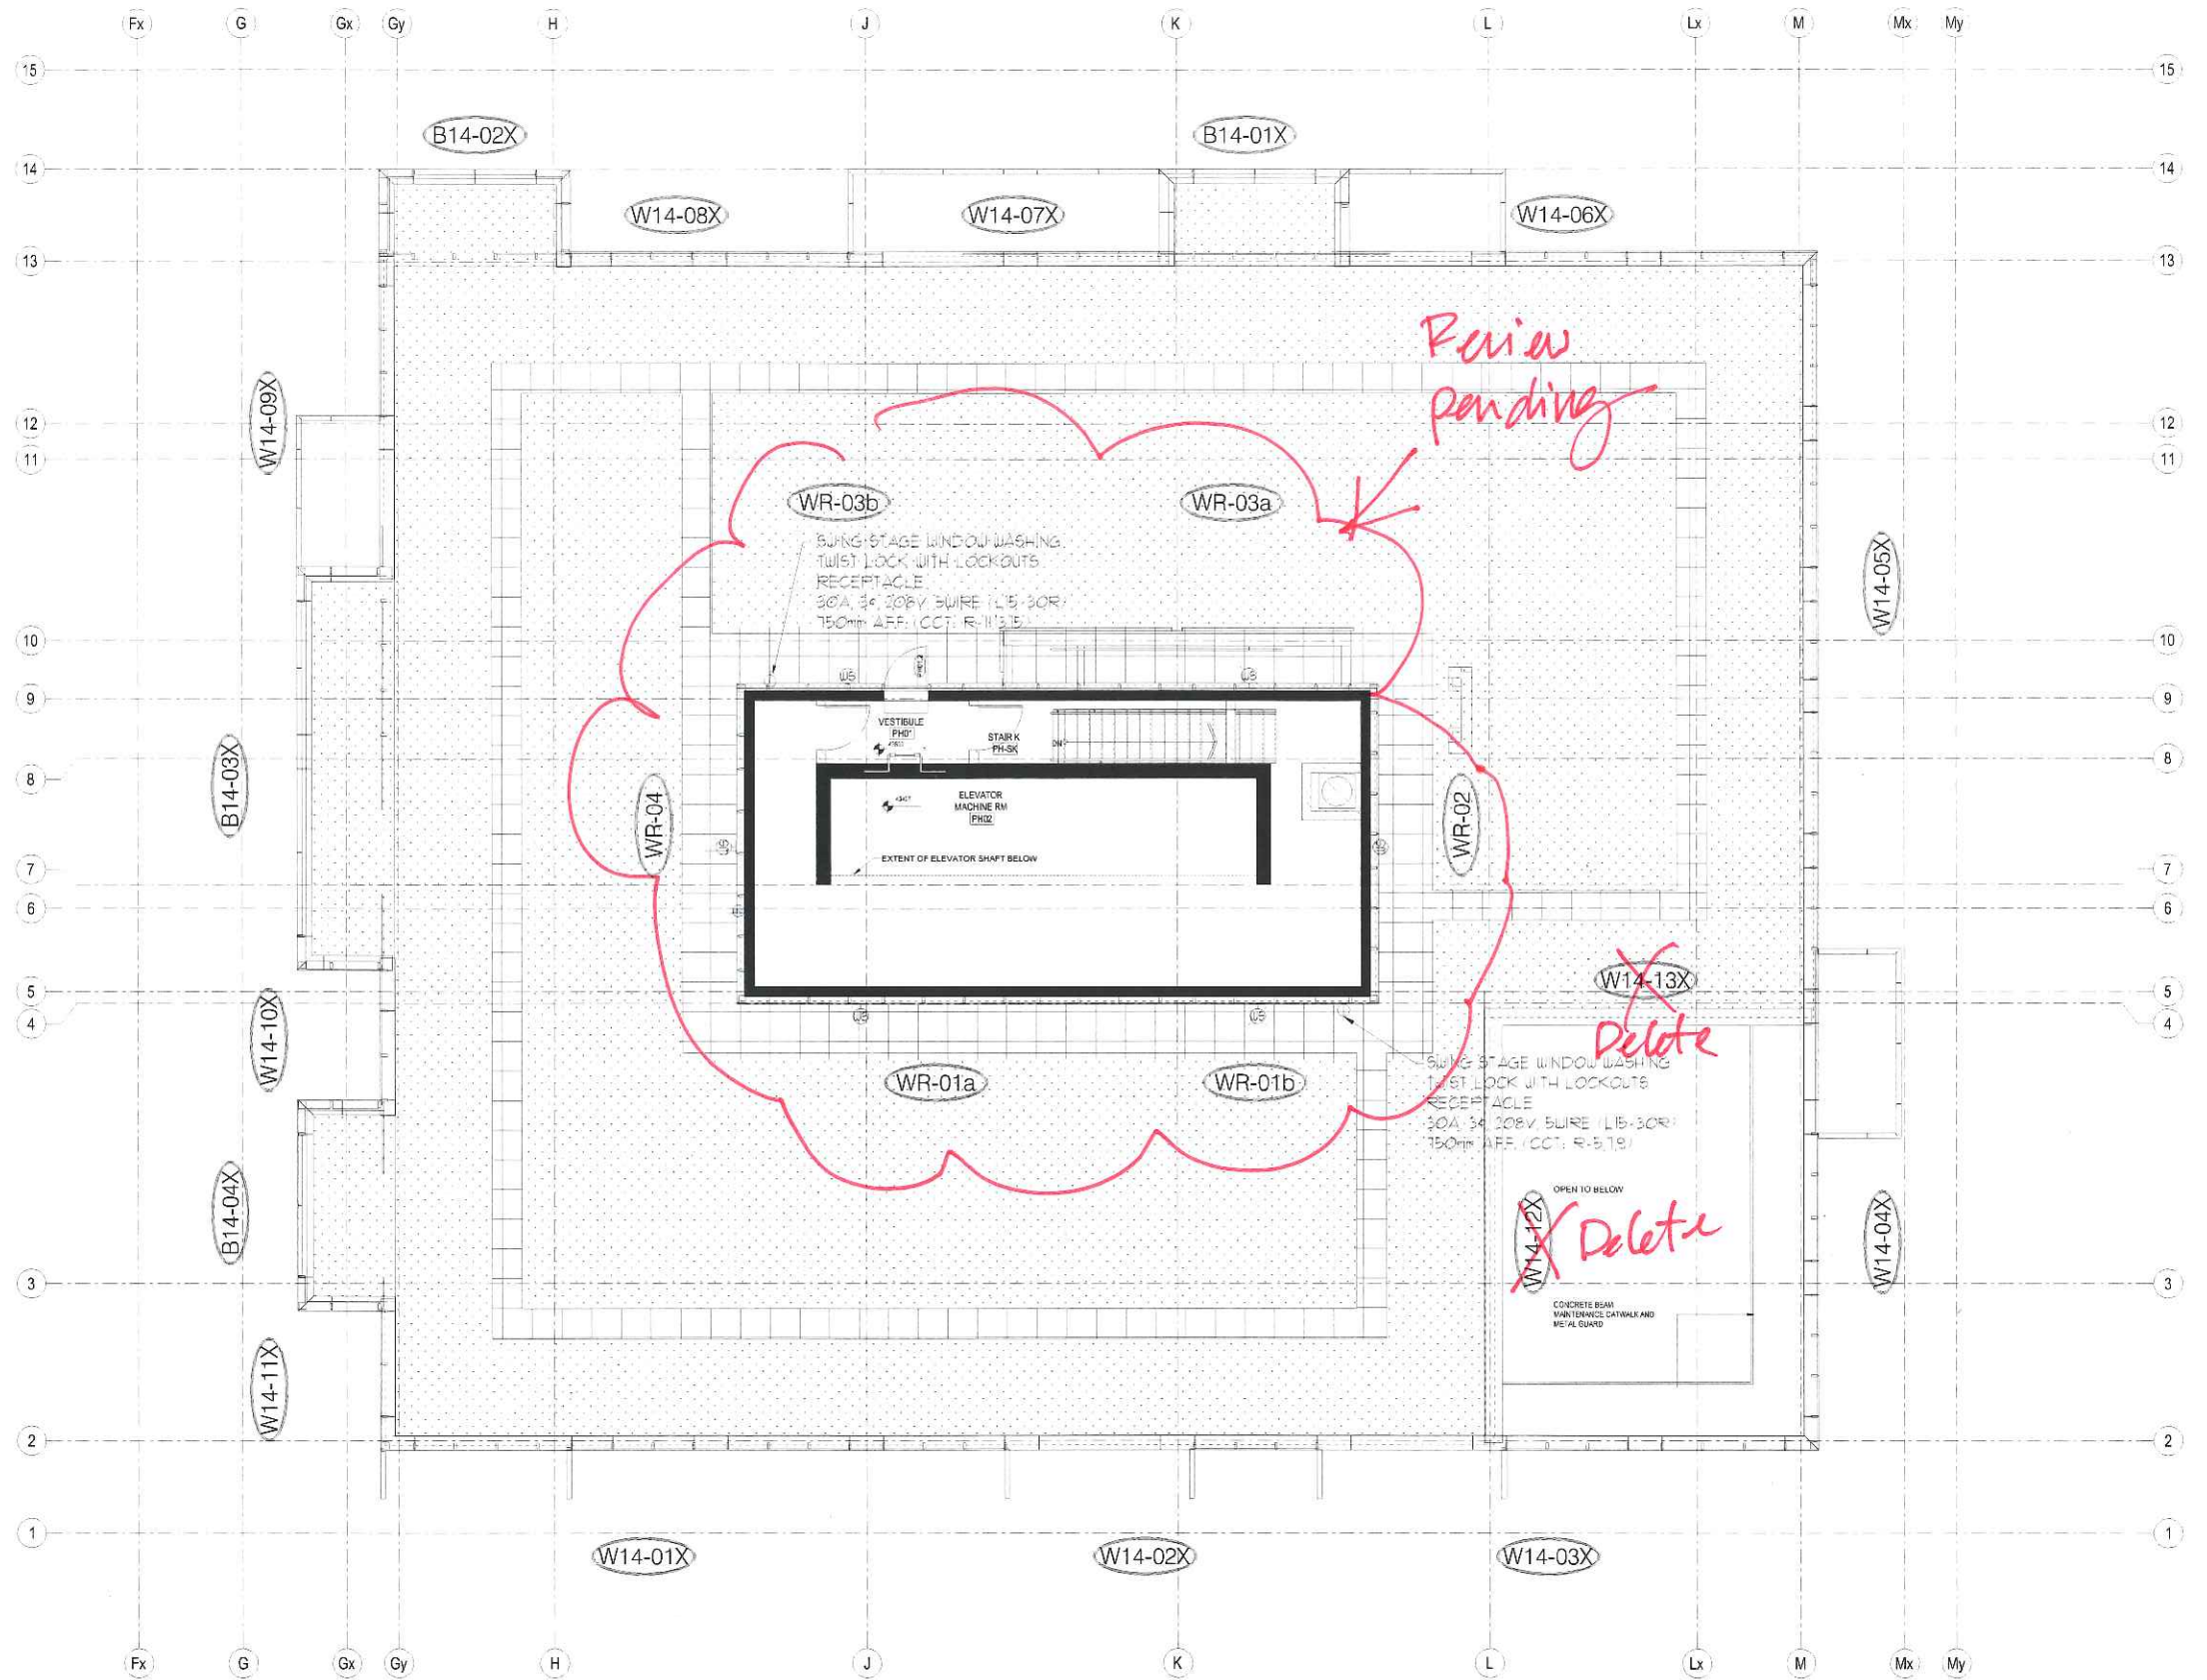

PROJECT NAME: SQ ALEXANDRA PARK - BLOCK 11

DRAWING TITLE: LOWER ROOF FLOOR PLAN


ARCHITECT: TEEPLE ARCHITECTS

CONTRACTOR: TRIDEL

DRAWING No.

FLR

No.	REVISION	BY	DATE	SCALE: N/T/S	DRAWN BY: S.C.	DATE: MARCH 4, 2015

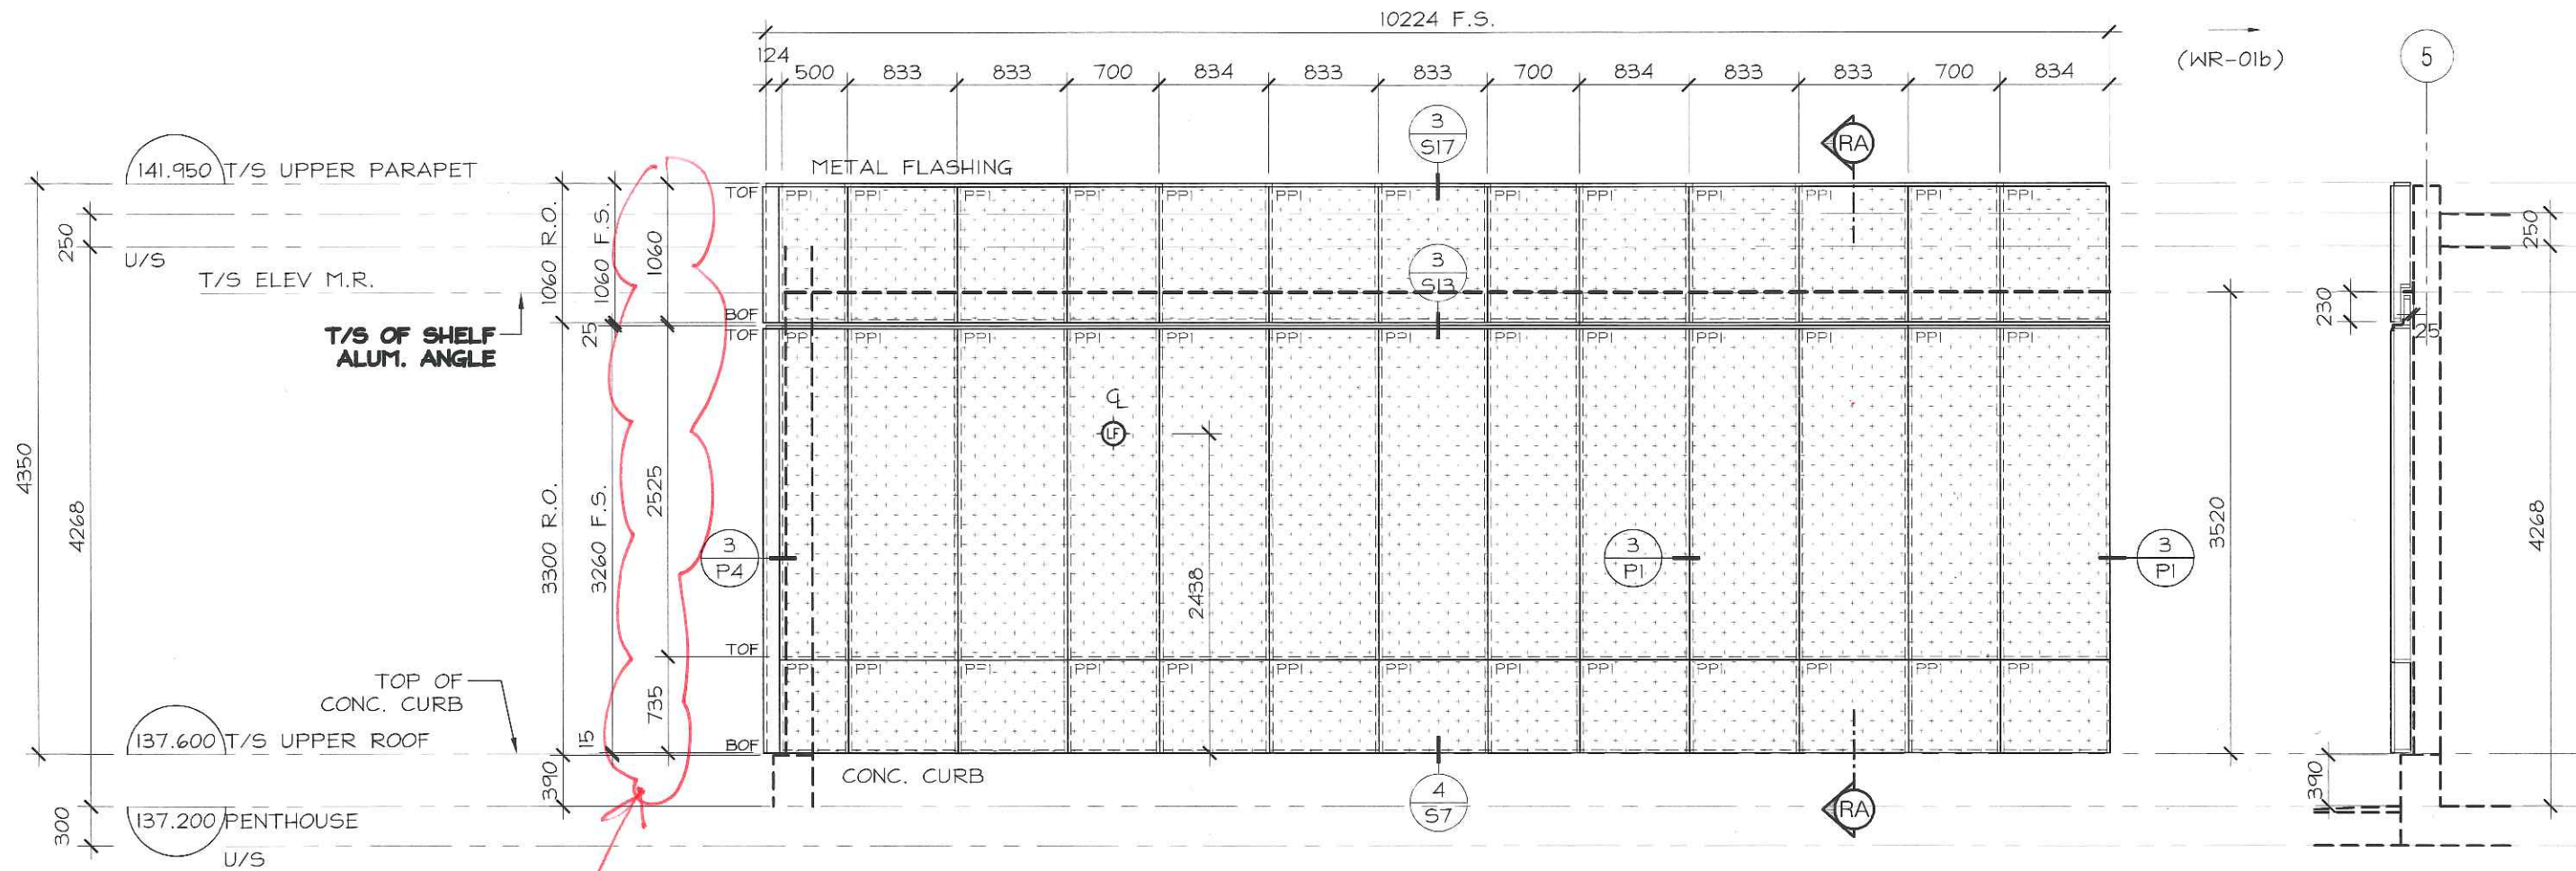

What is generating these dimensions?

WR-01a 1 REQUIRED 2487 SERIES

RA-RA CROSS SECTION ARCH. REF. 2/A507


TORO ALUMINUM
 COMMERCIAL INDUSTRIAL RESIDENTIAL
 330 APPLEWOOD CRESCENT TEL: (905) 738-5220
 CONCORD, ON, CANADA FAX: (905) 738-5481
 L4K 4V2 WWW.TOROALUMINUM.COM

LICENSED PROFESSIONAL ENGINEER
 06-27-15
 D.T. PROHASKA
 37549011
 PROVINCE OF ONTARIO

No.	REVISION	BY	DATE

PROJECT NAME: SQ ALEXANDRA PARK - BLOCK11
 DRAWING TITLE: LOWER ROOF FLOOR ELEVATIONS
 ARCHITECT: TEEPLE ARCHITECTS
 CONTRACTOR: TRIDEL
 SCALE: 1:50 DRAWN BY: S.C. DATE: MARCH 4, 2015

DRAWING No.: ELR-1

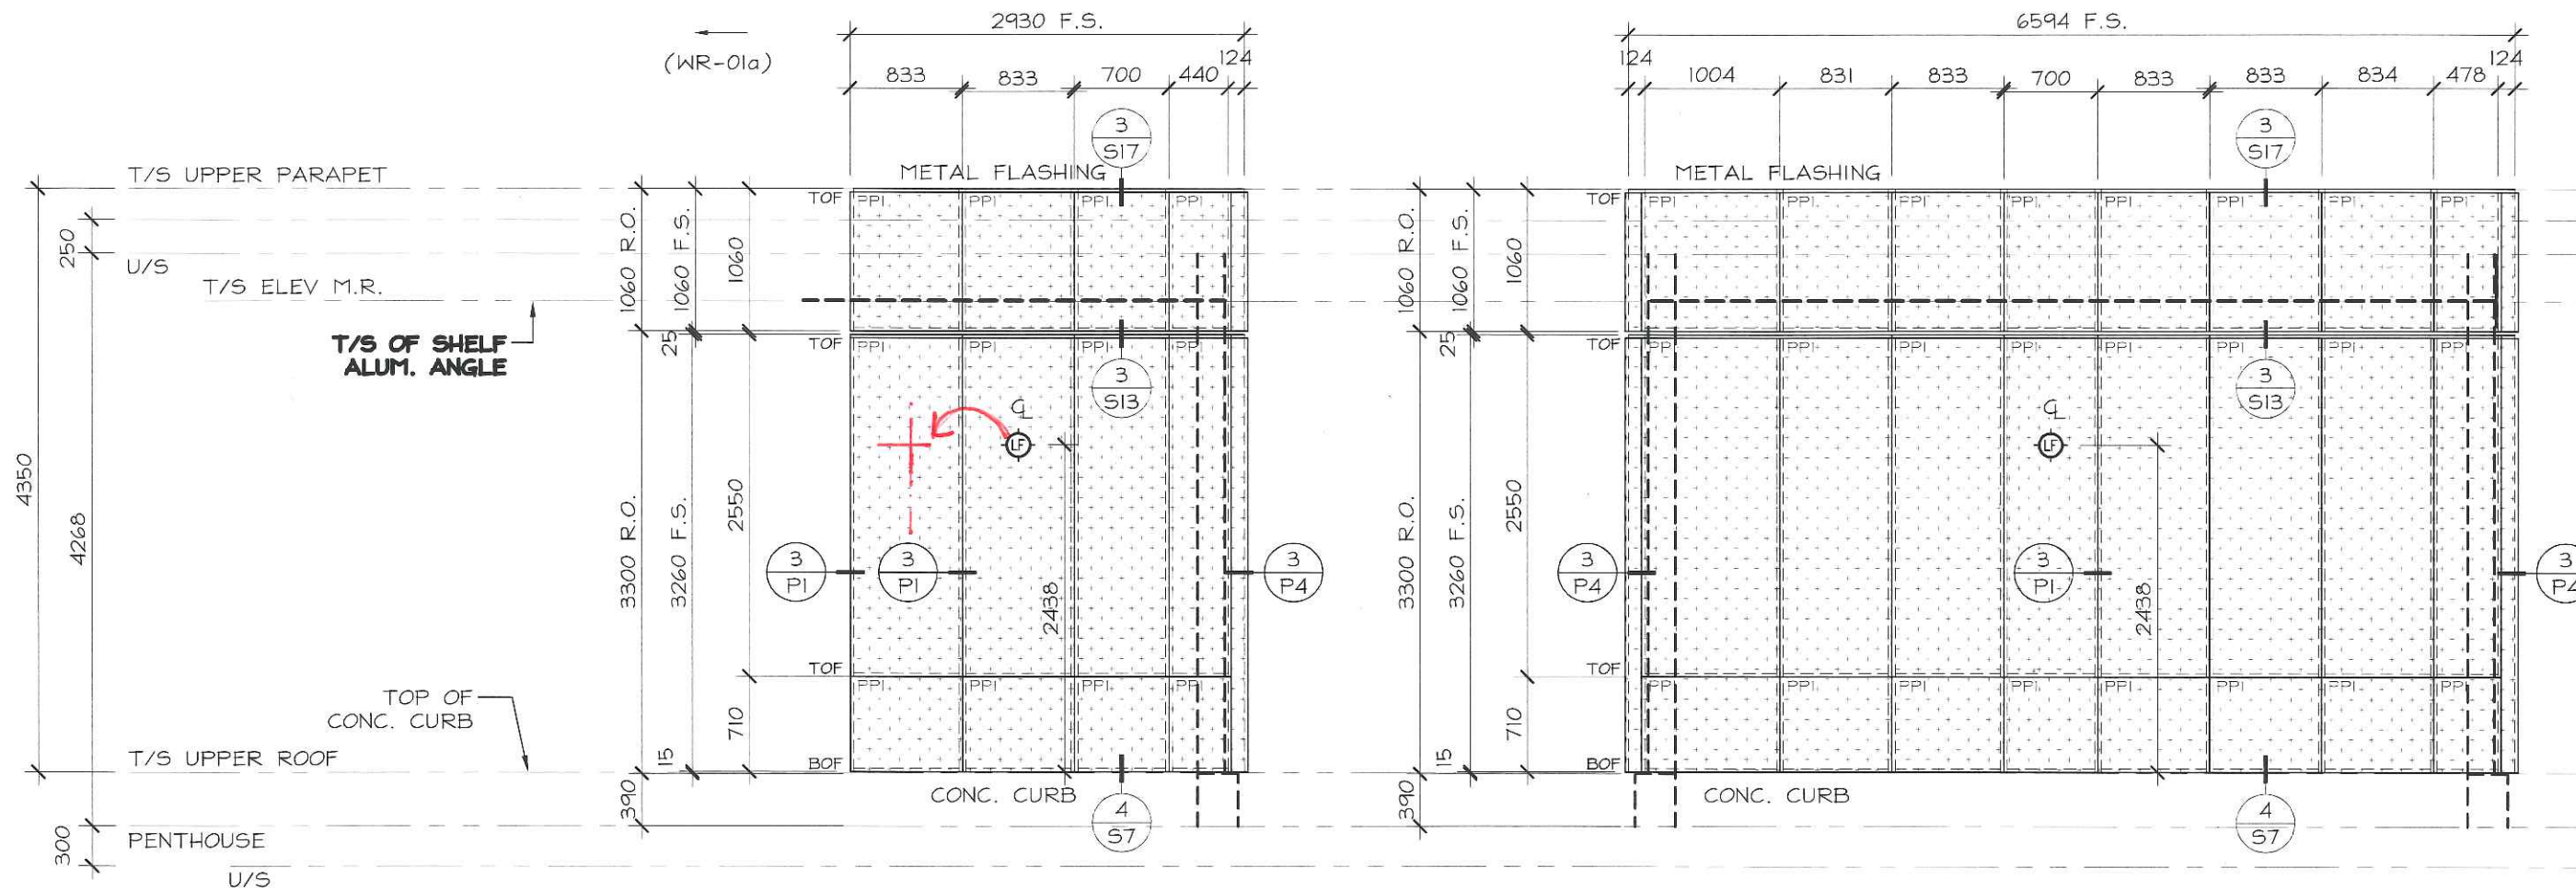

WR-01b 1 REQUIRED
2487 SERIES


WR-02 1 REQUIRED
2487 SERIES



No.	REVISION	BY	DATE

PROJECT NAME:	SQ ALEXANDRA PARK - BLOCK11
DRAWING TITLE:	LOWER ROOF FLOOR ELEVATIONS
ARCHITECT:	TEEPLE ARCHITECTS
CONTRACTOR:	TRIDEL
SCALE:	1:50
DRAWN BY:	S.C.
DATE:	MARCH 4, 2015

DRAWING No.:
ELR-2

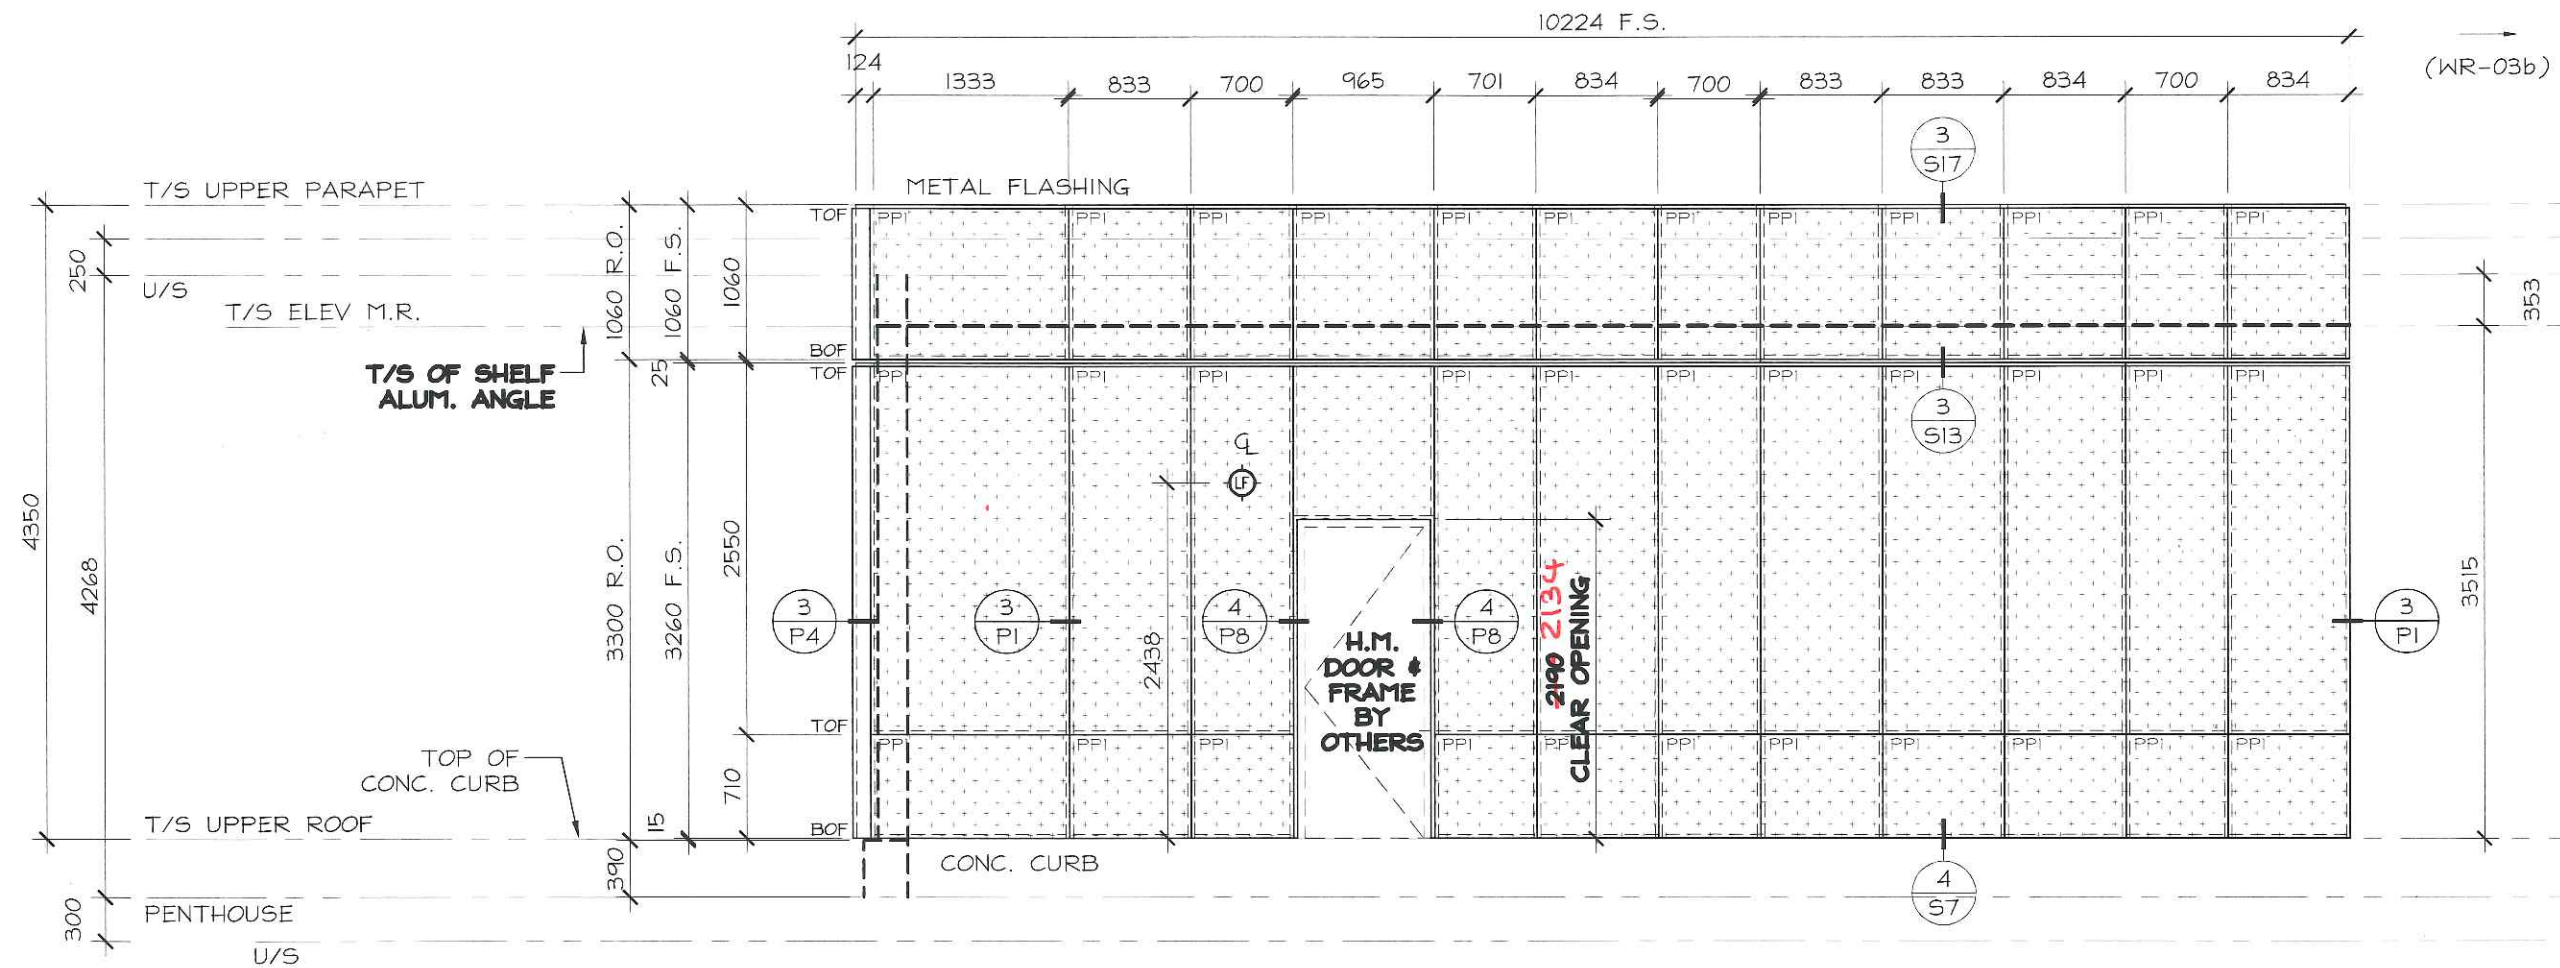


WR-03a 1 REQUIRED
2487 SERIES



No.	REVISION	BY	DATE

PROJECT NAME:	SQ ALEXANDRA PARK - BLOCK11		
DRAWING TITLE:	LOWER ROOF FLOOR ELEVATIONS		
ARCHITECT:	TEEPLE ARCHITECTS		
CONTRACTOR:	TRIDEL		
SCALE:	1:50	DRAWN BY:	S.C.
DATE:		MARCH 4, 2015	

DRAWING No.:
ELR-3

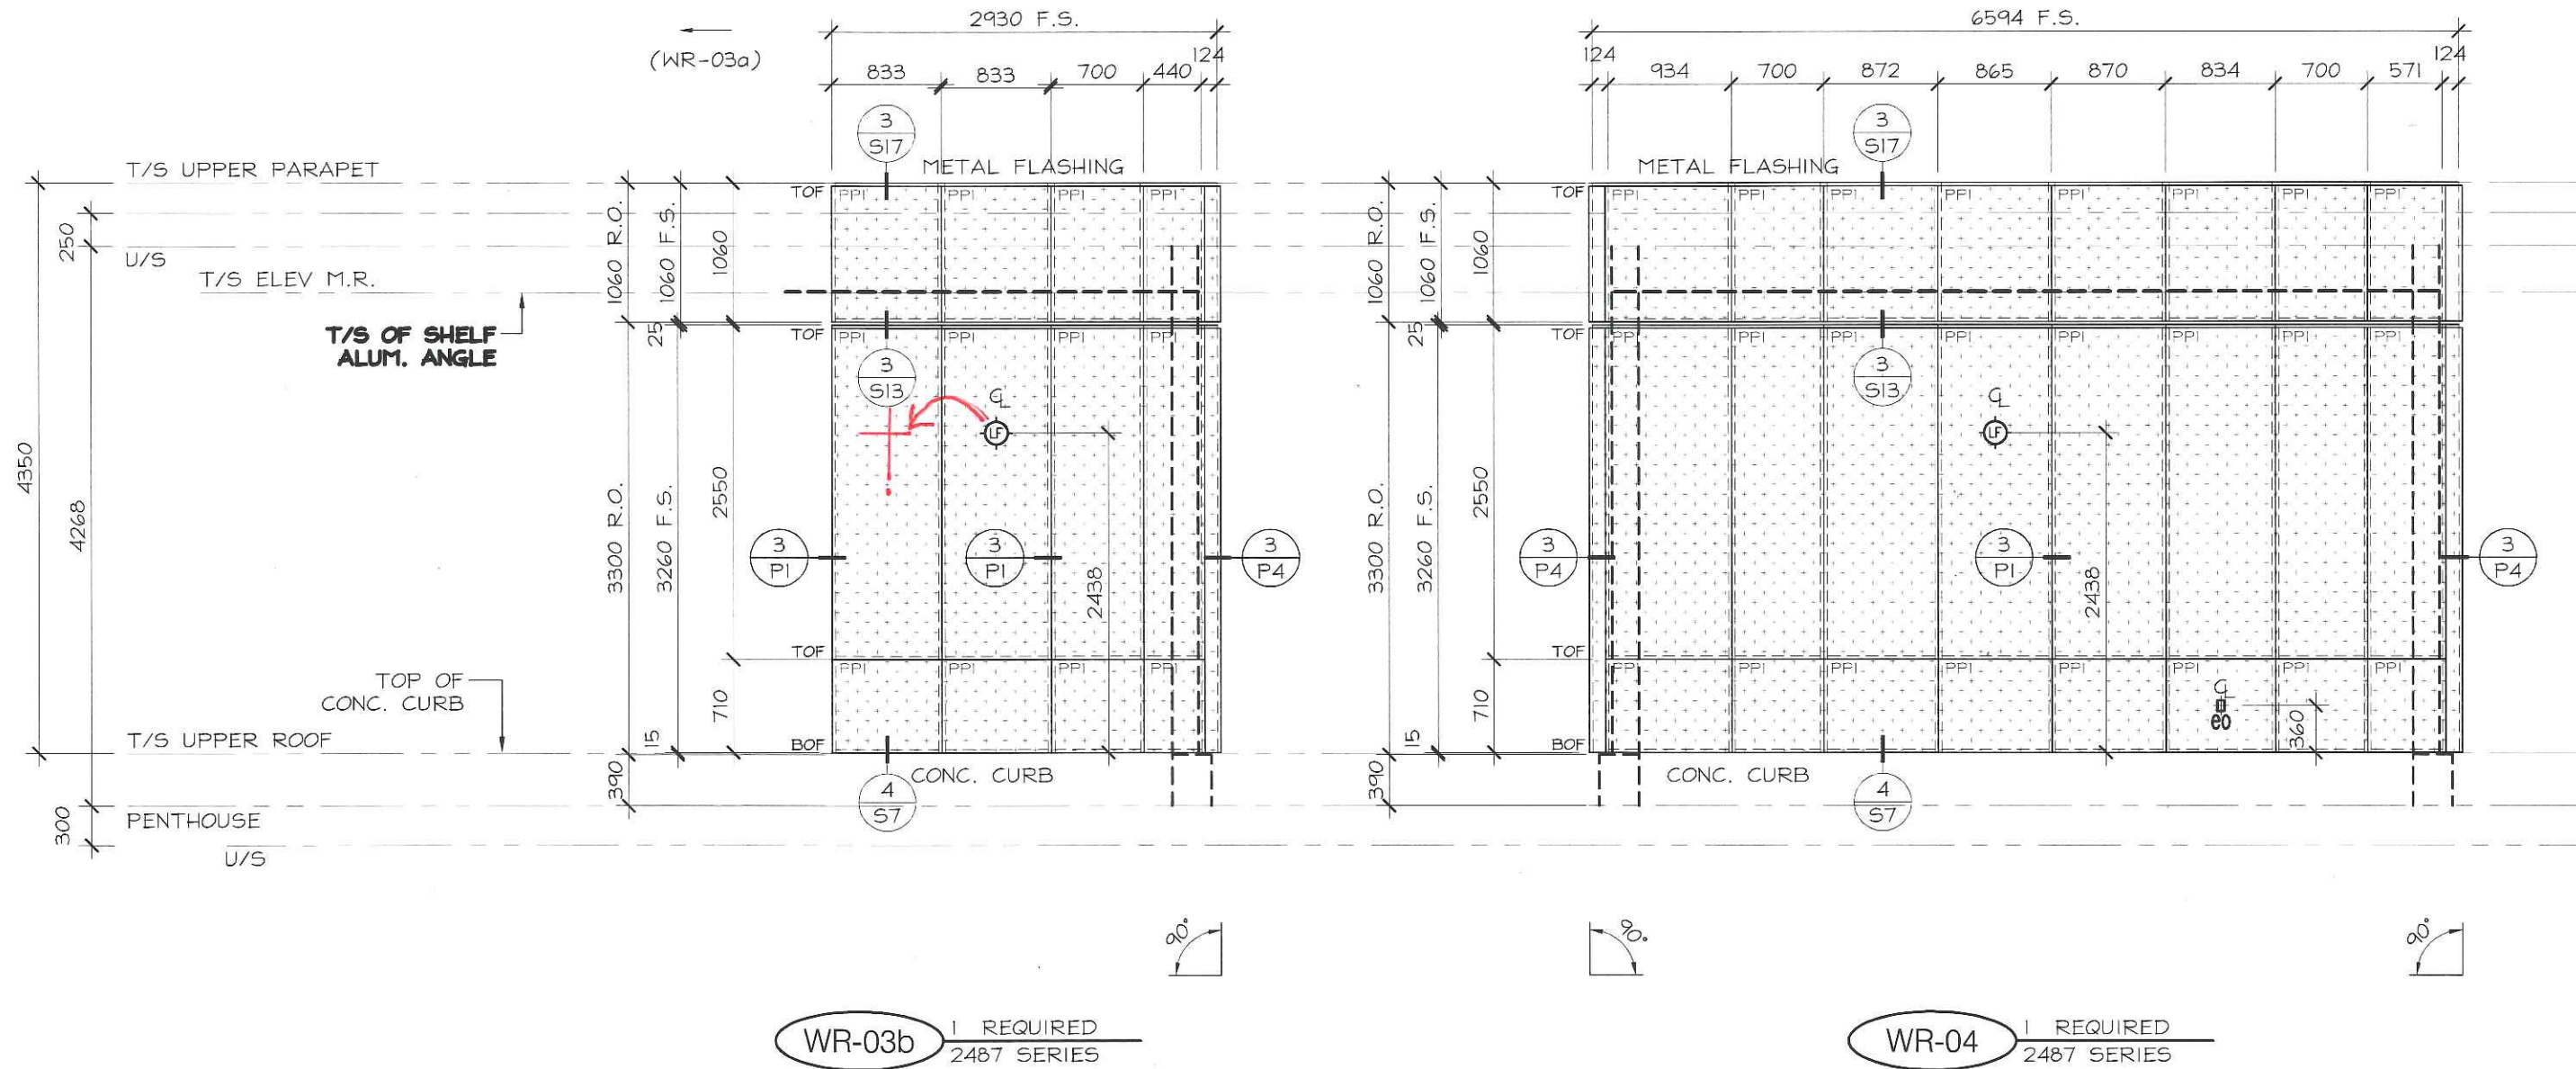

No.	REVISION	BY	DATE

PROJECT NAME:	SQ ALEXANDRA PARK - BLOCK11		
DRAWING TITLE:	LOWER ROOF FLOOR ELEVATIONS		
ARCHITECT:	TEEPLE ARCHITECTS		
CONTRACTOR:	TRIDEL		
SCALE:	1:50	DRAWN BY:	S.C.
DATE:	MARCH 4, 2015		

DRAWING No.:
ELR-4