

Teeple Architects INC.

Package 9 - Level 8

Reviewed
Reviewed as noted

(✓)

Revise and resubmit
Not Reviewed

()

Date:


Aug 9/15

Reviewed by:

MBamm.


This review by Teeple Architects Inc. is for the sole purpose of ascertaining conformance with the general design concept. This review shall not mean that Teeple Architects Inc. approves the detailed design inherent in the shop drawings, responsibility for which shall remain with the Contractor submitting same, and such review shall not relieve the Contractor of the responsibility for errors or omissions in the shop drawings or of the responsibility for meeting all requirements of the Contract Documents. The Contractor is responsible for dimensions to be confirmed and correlated at the job site, for information that pertains solely to fabrication processes or to techniques of construction and installation, and for coordination of the work of all trades.

ARCHITECT
CLARIFY

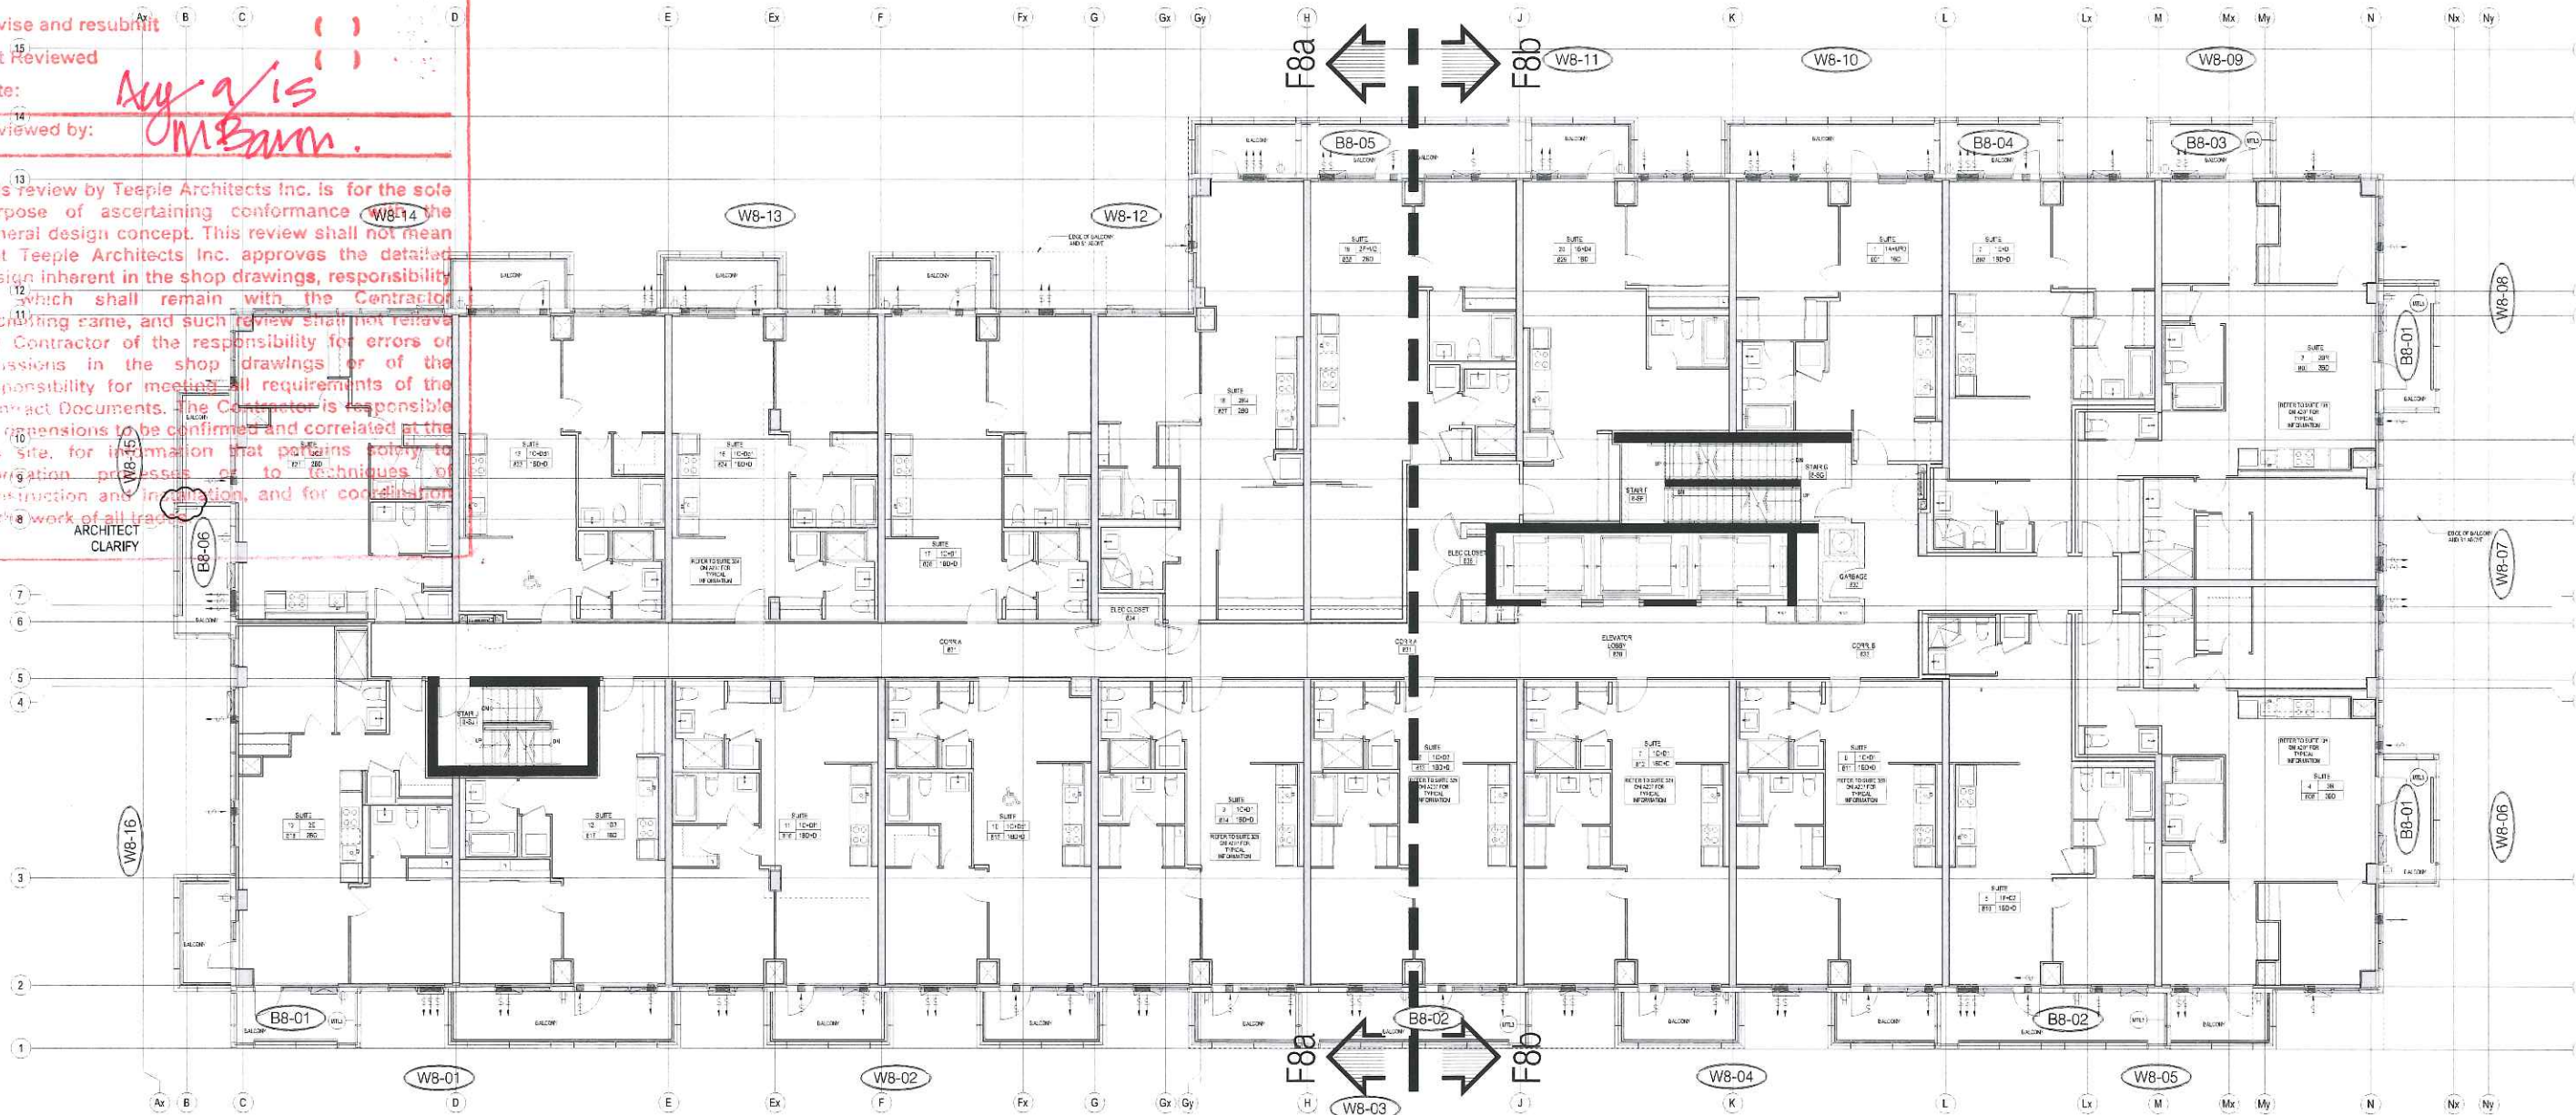

NO.	REVISION	BY	DATE


PROJECT NAME:	SQ ALEXANDRA PARK - BLOCK11		
DRAWING TITLE:	8th FLOOR KEY PLAN		
ARCHITECT:	TEEPLA ARCHITECTS		
CONTRACTOR:	TRIDEL		
SCALE:	N/T/S	DRAWN BY:	S.C.
DATE:	MARCH 4, 2015		
DRAWING No:	F8		

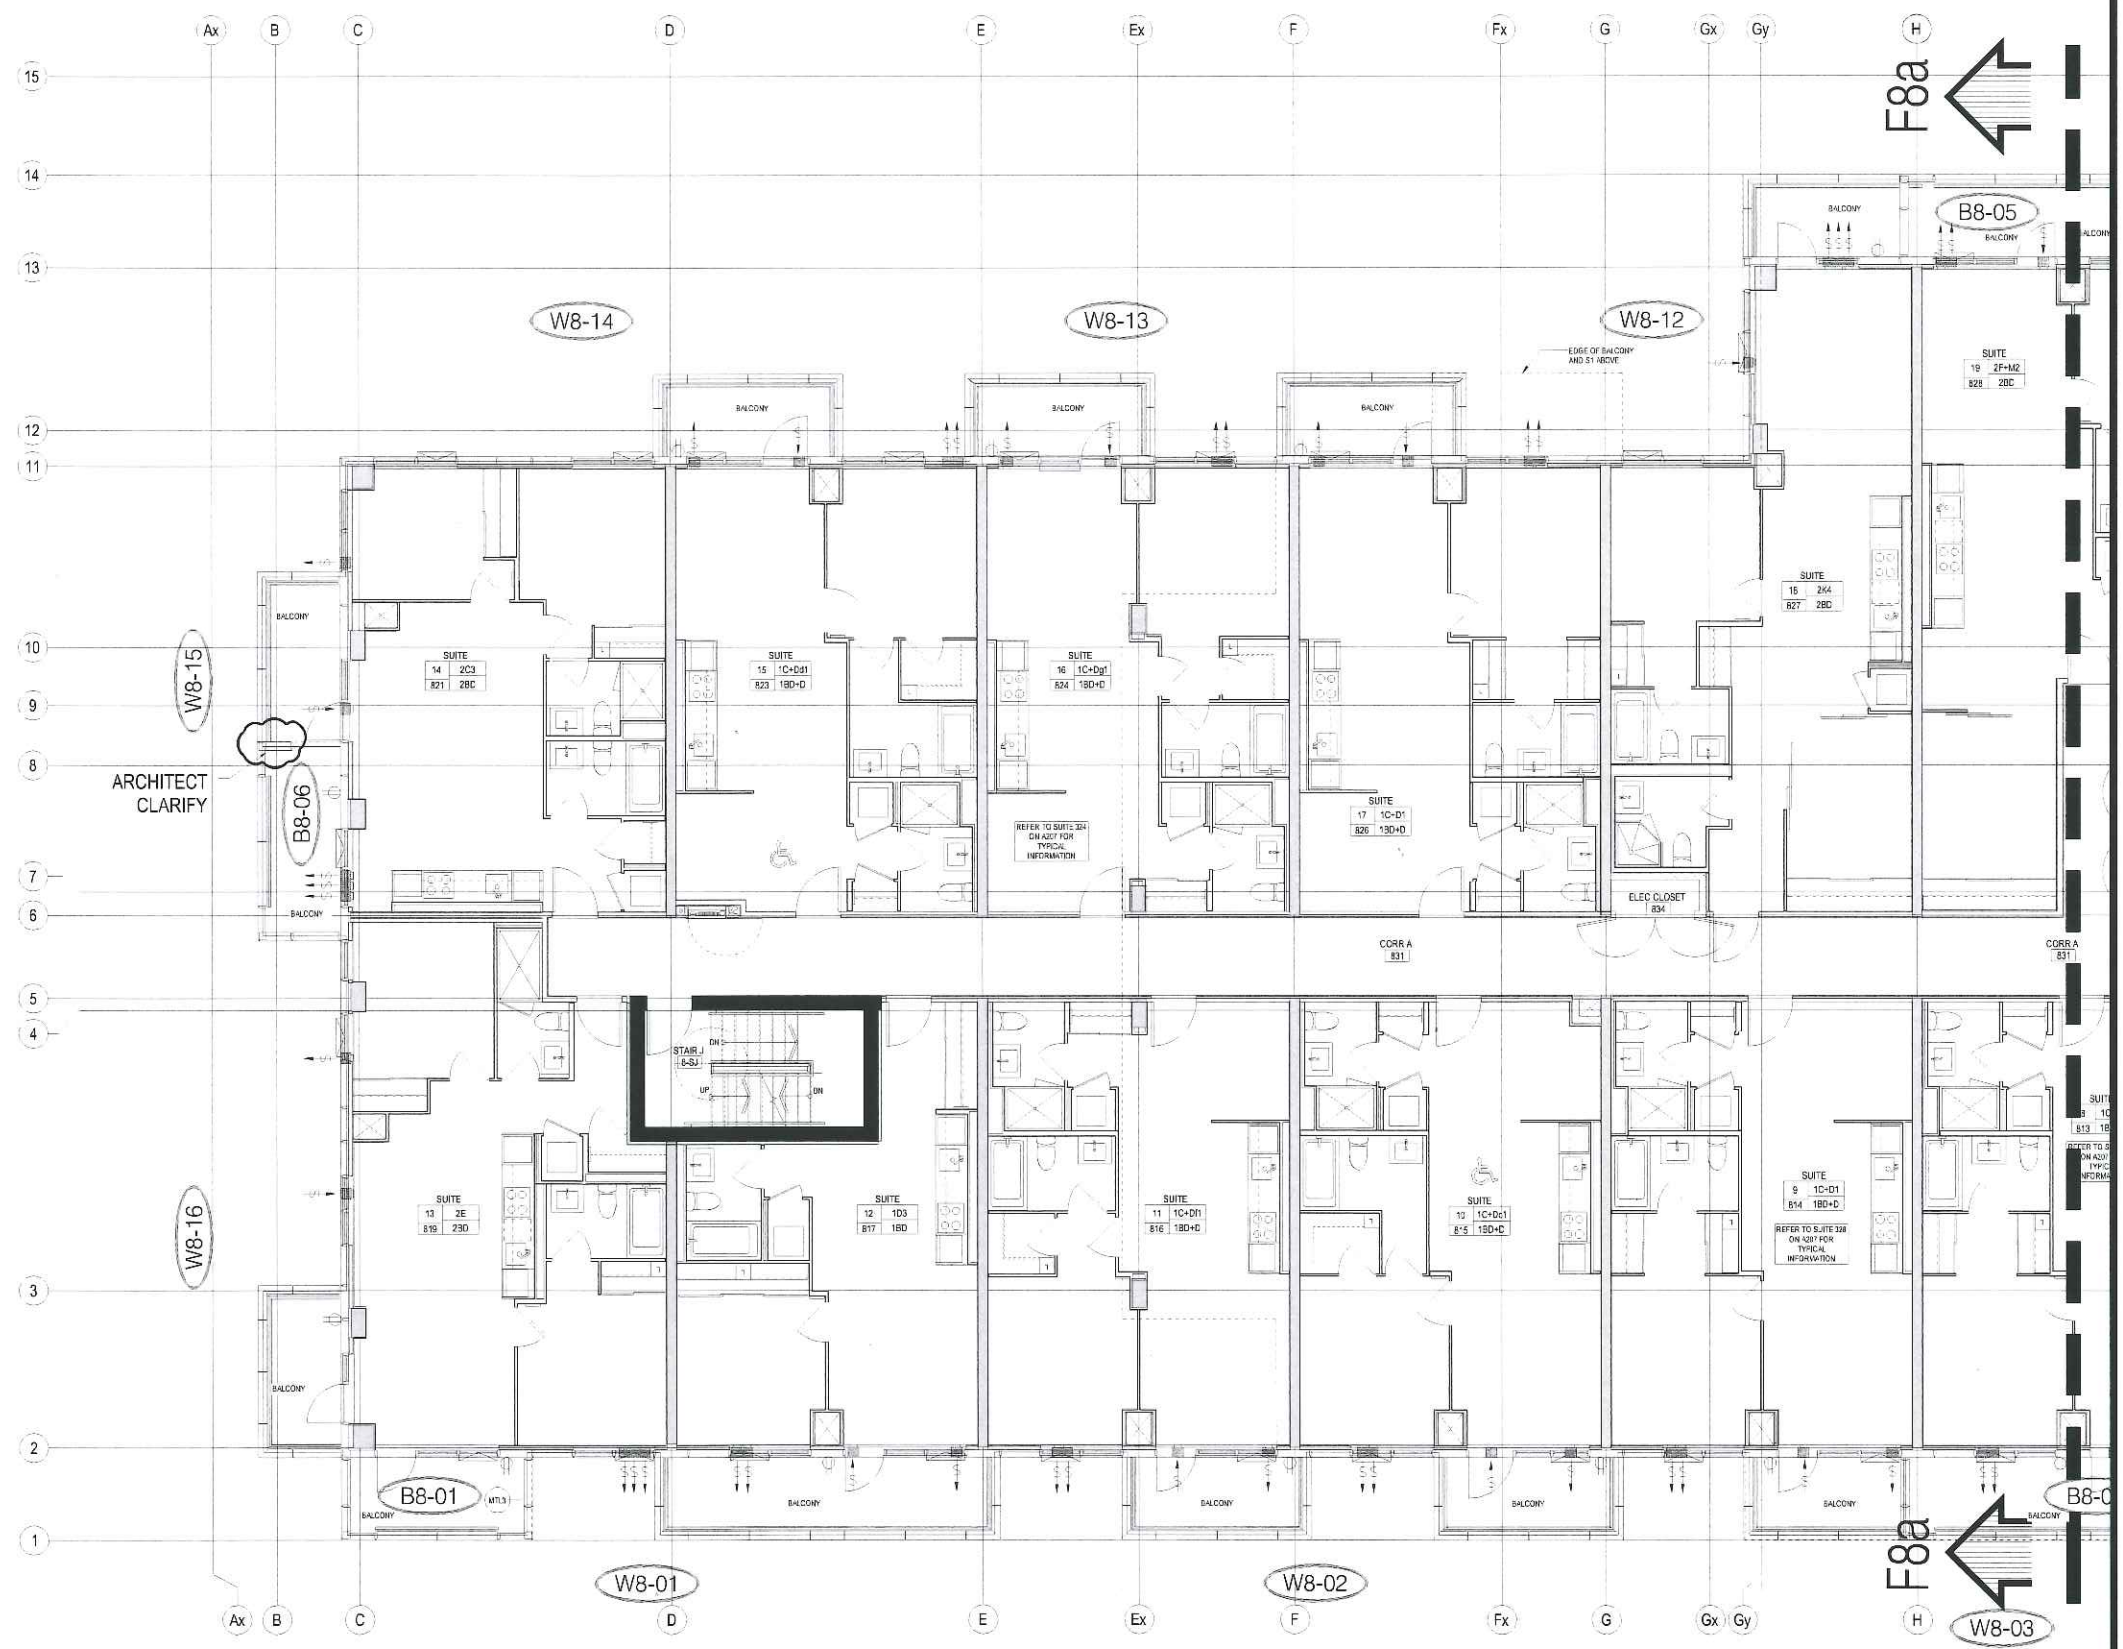

No.	REVISION	BY	DATE



PROJECT NAME:	SQ ALEXANDRA PARK - BLOCK 11
DRAWING TITLE:	8th FLOOR PARTIAL PLAN
ARCHITECT:	TEEPLE ARCHITECTS
CONTRACTOR:	TRIDEL
SCALE:	N/T/S
DRAWN BY:	S.C.
DATE:	MARCH 4, 2016

DRAWING No
F8a

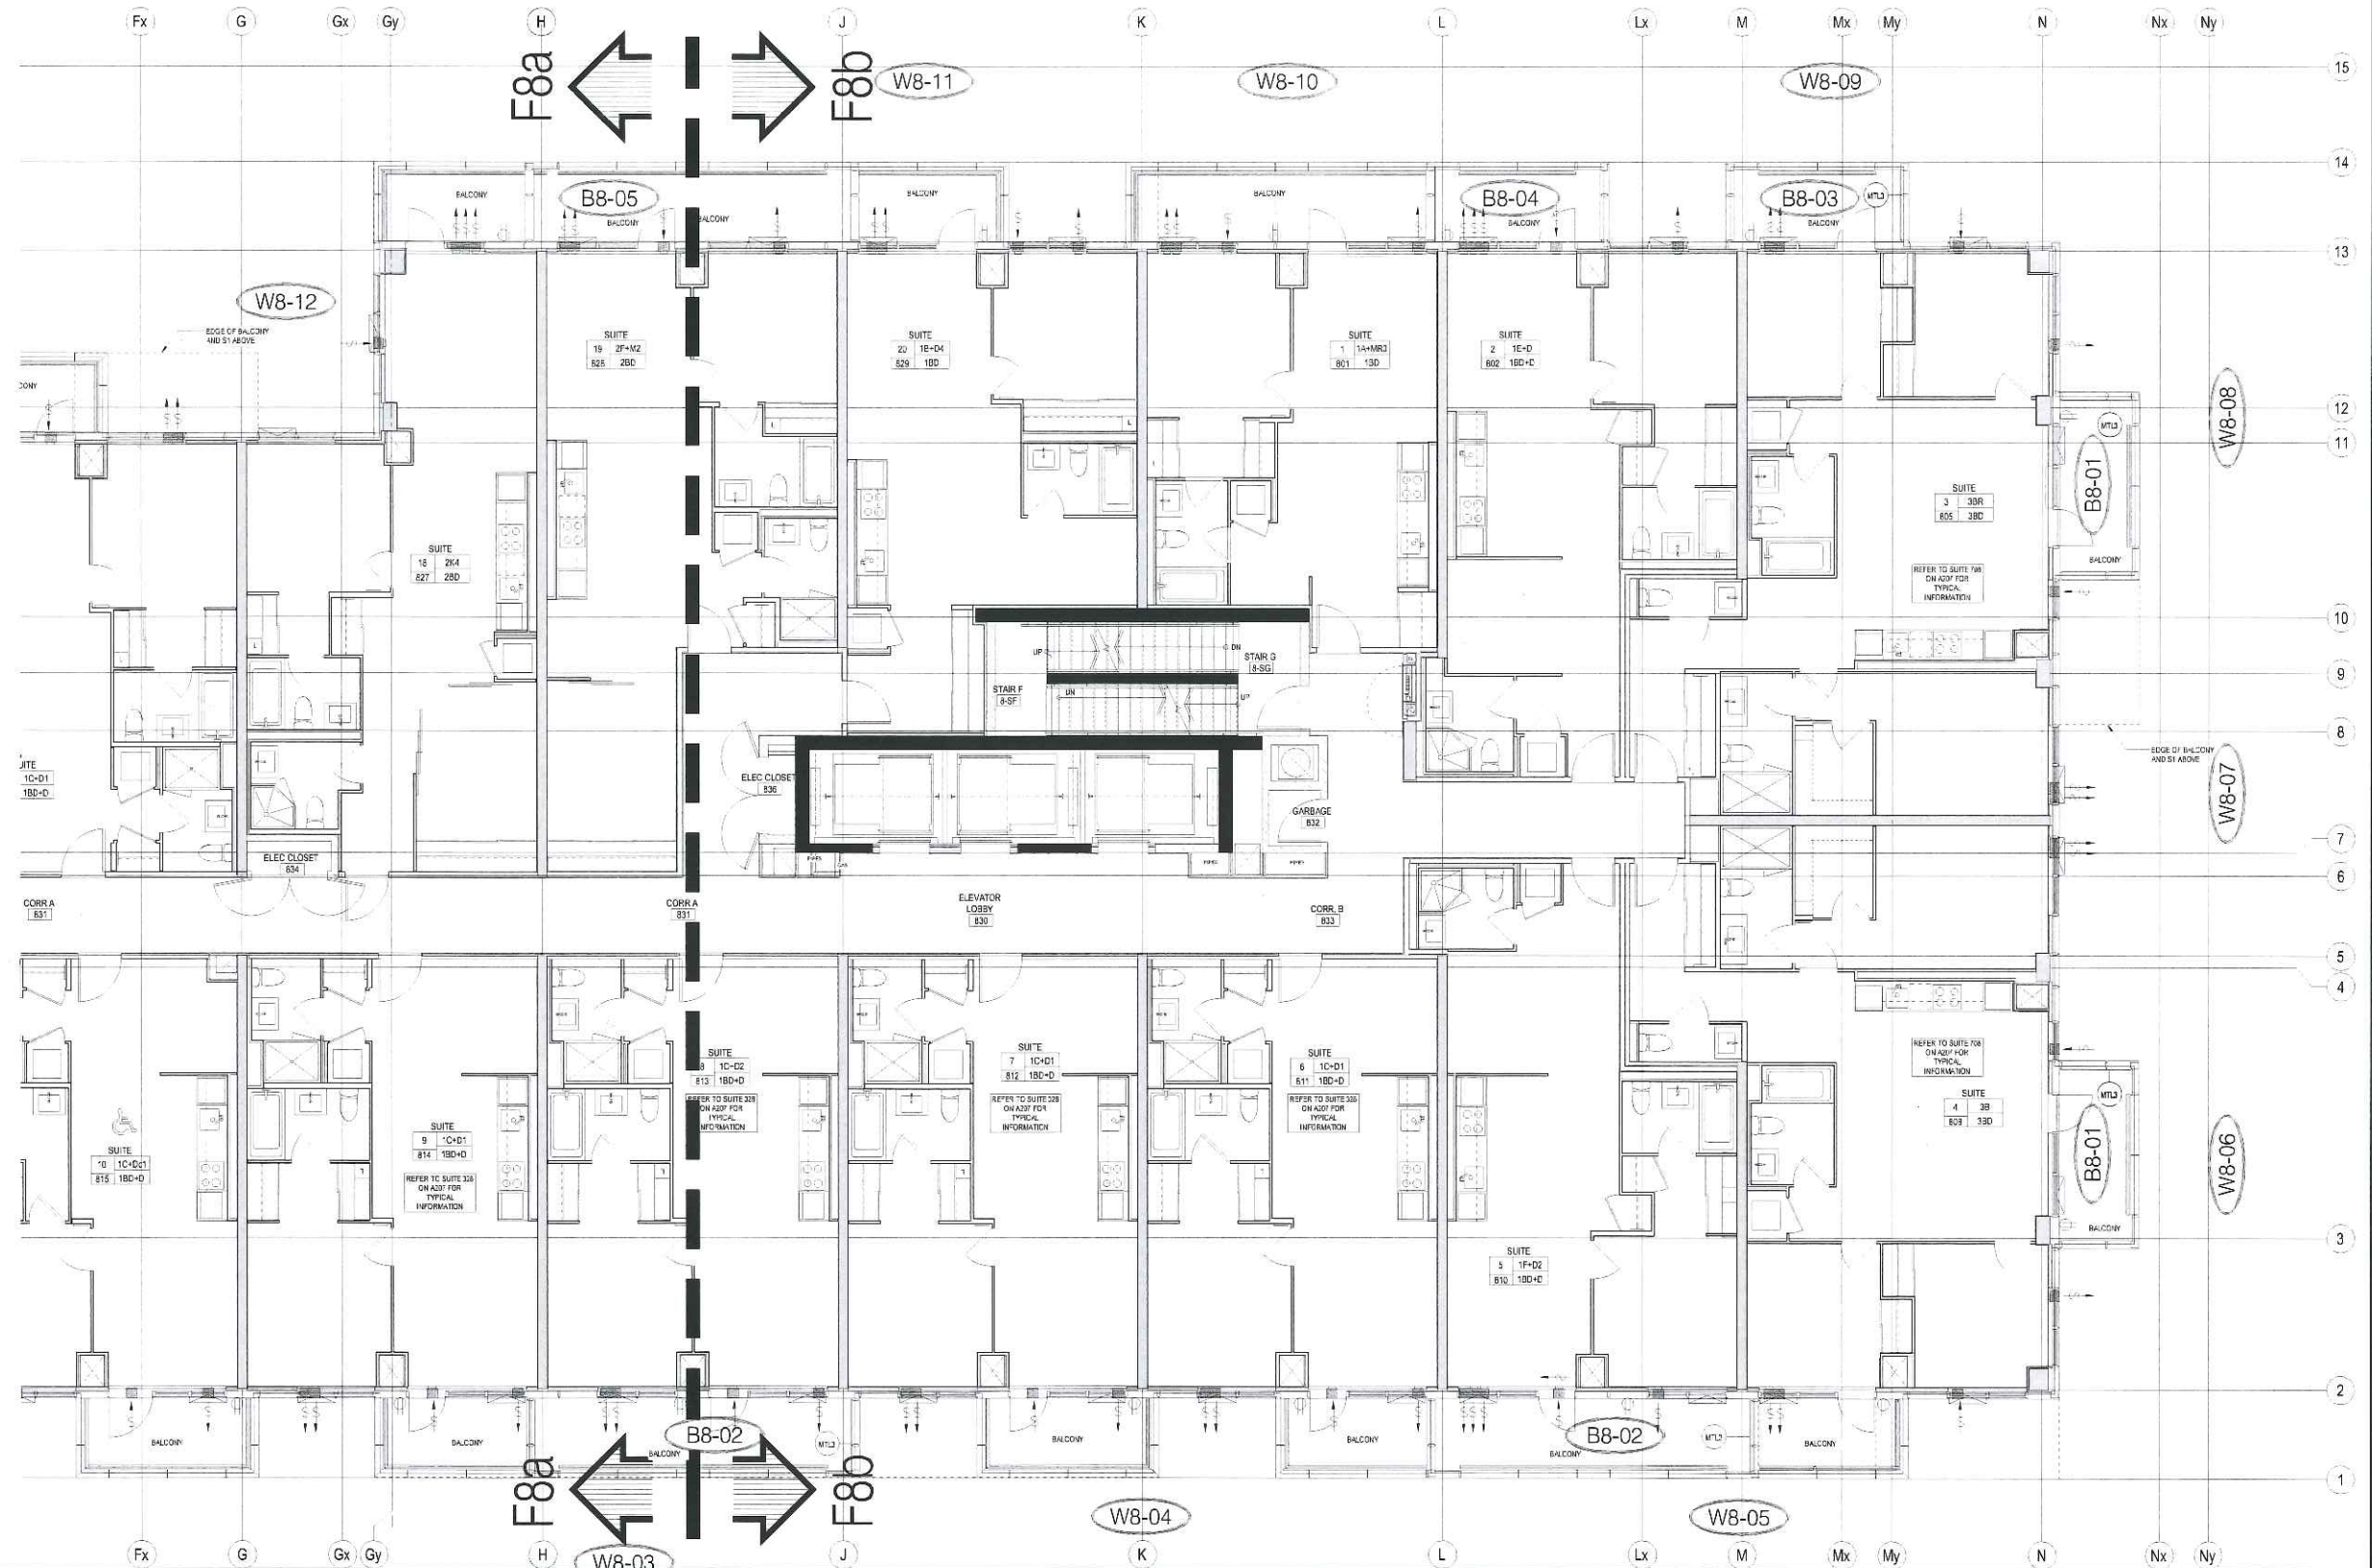

No.	REVISION	BY	DATE


PROJECT NAME	SQ ALEXANDRA PARK - BLOCK 11		
DRAWING TITLE	8th FLOOR PARTIAL PLAN		
ARCHITECT	TEEPLE ARCHITECTS		
CONTRACTOR	TRIDEL		
SCALE	N/T/S	DRAWN BY	S.C.
DATE	MARCH 4, 2018		
DRAWING No.			F8b

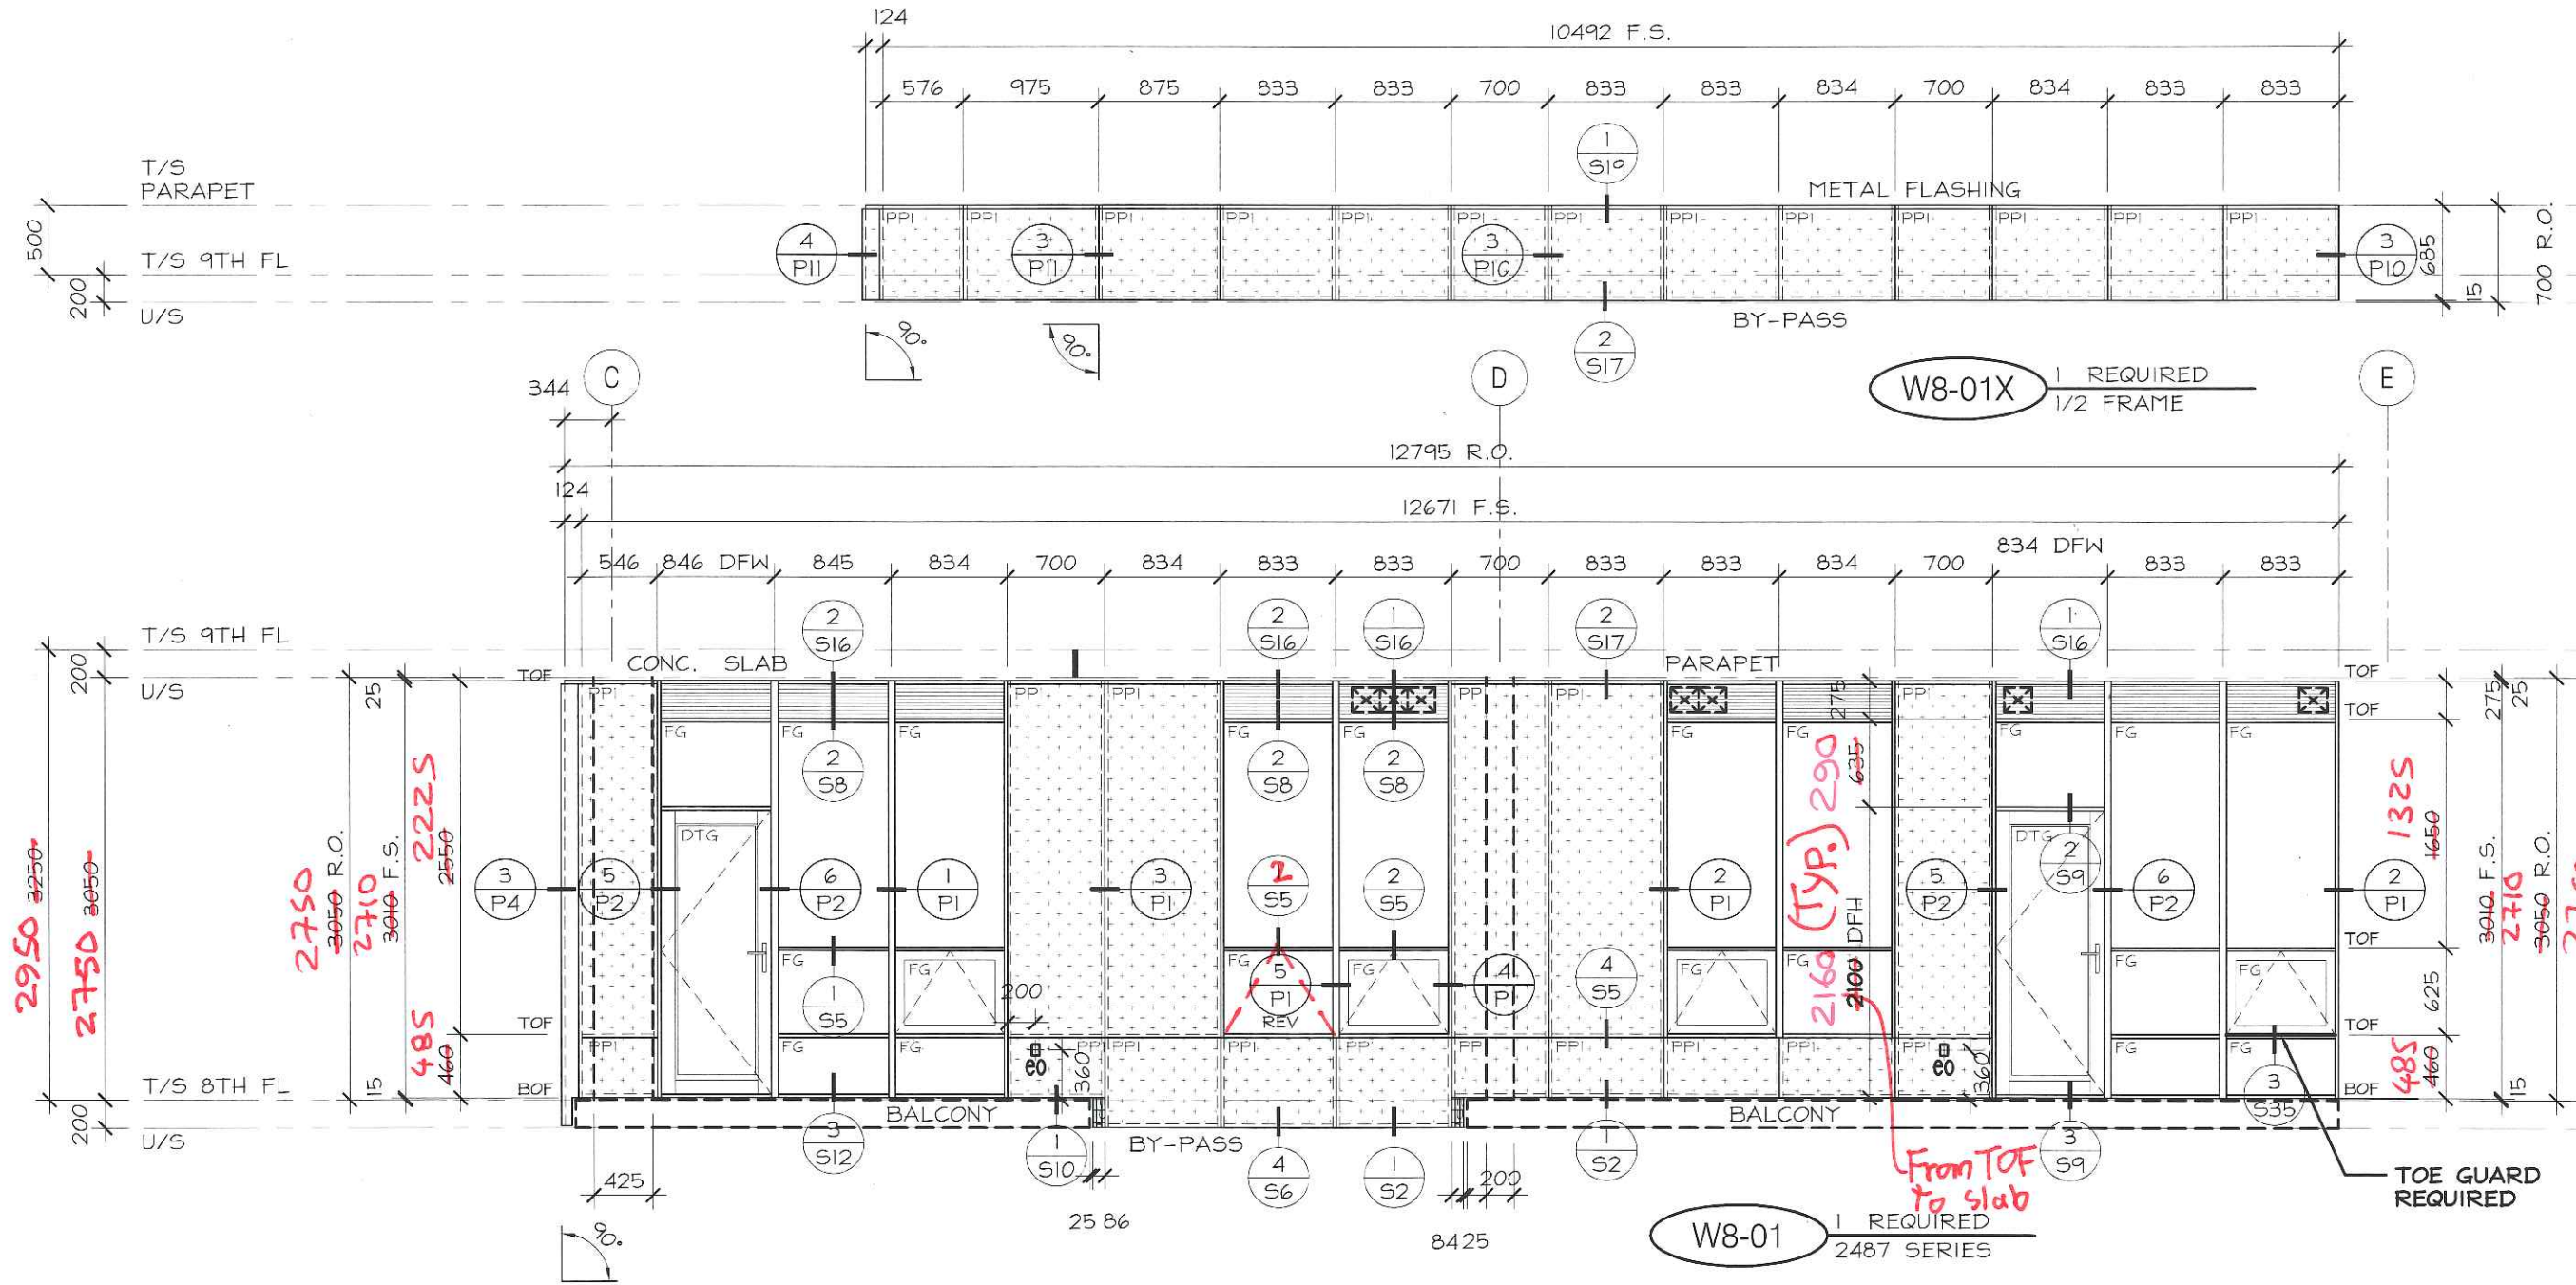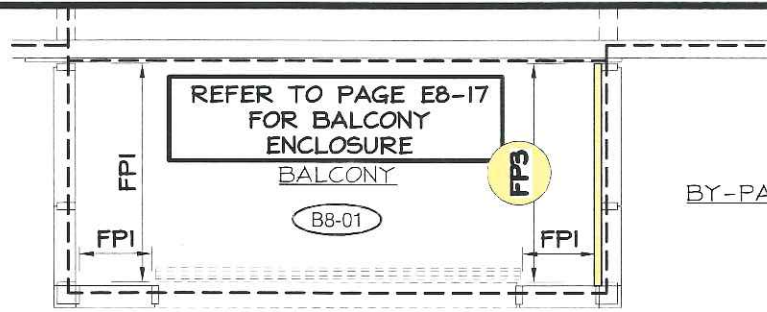

No.	REVISION	BY	DATE

PROJECT NAME:	SQ ALEXANDRA PARK - BLOCK 11
DRAWING TITLE:	8th FLOOR ELEVATIONS
ARCHITECT:	TEEPLE ARCHITECTS
CONTRACTOR:	TRIDEL
SCALE:	1:50
DRAWN BY:	S.C.
DATE:	MARCH 4, 2015

DRAWING No.:
E8-1

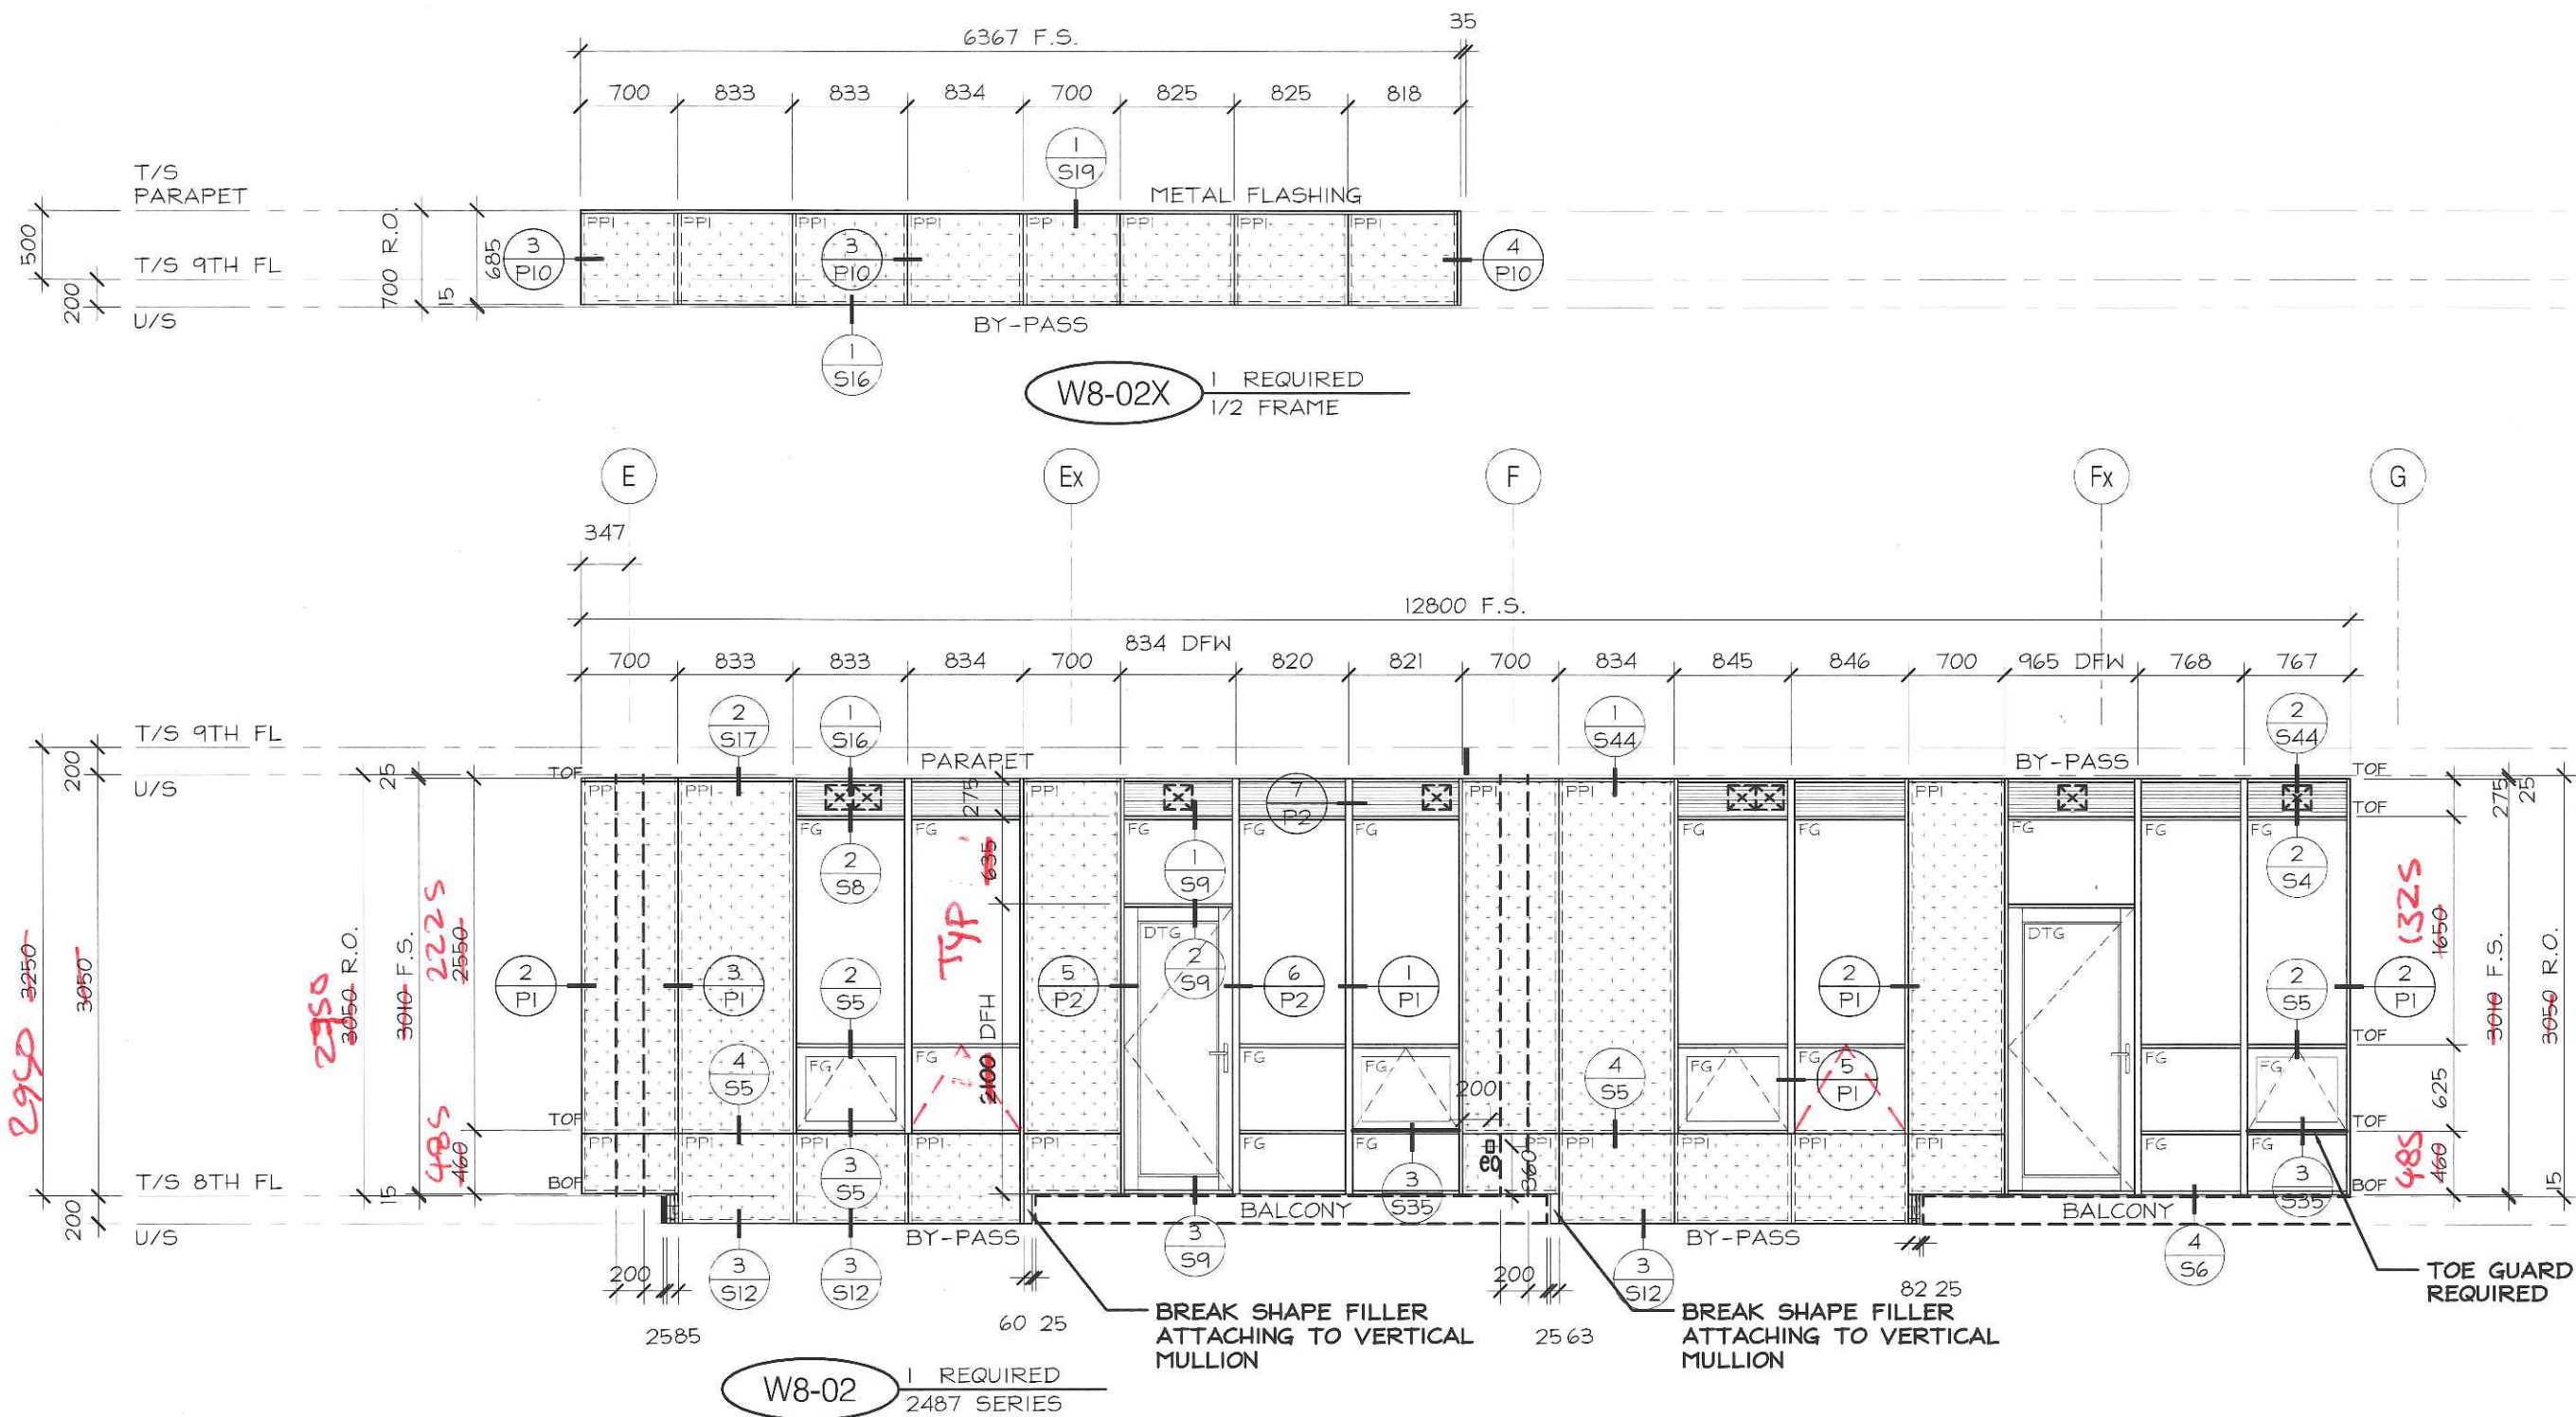


No.	REVISION	BY	DATE

PROJECT NAME: SQ ALEXANDRA PARK - BLOCK 11
 DRAWING TITLE: 8th FLOOR ELEVATIONS
 ARCHITECT: TEEPLE ARCHITECTS
 CONTRACTOR: TRIDEL
 SCALE: 1:50
 DRAWN BY: S.C.
 DATE: MARCH 4, 2015

DRAWING No.:
E8-2

REFER TO PAGE E8-18
FOR BALCONY
ENCLOSURE

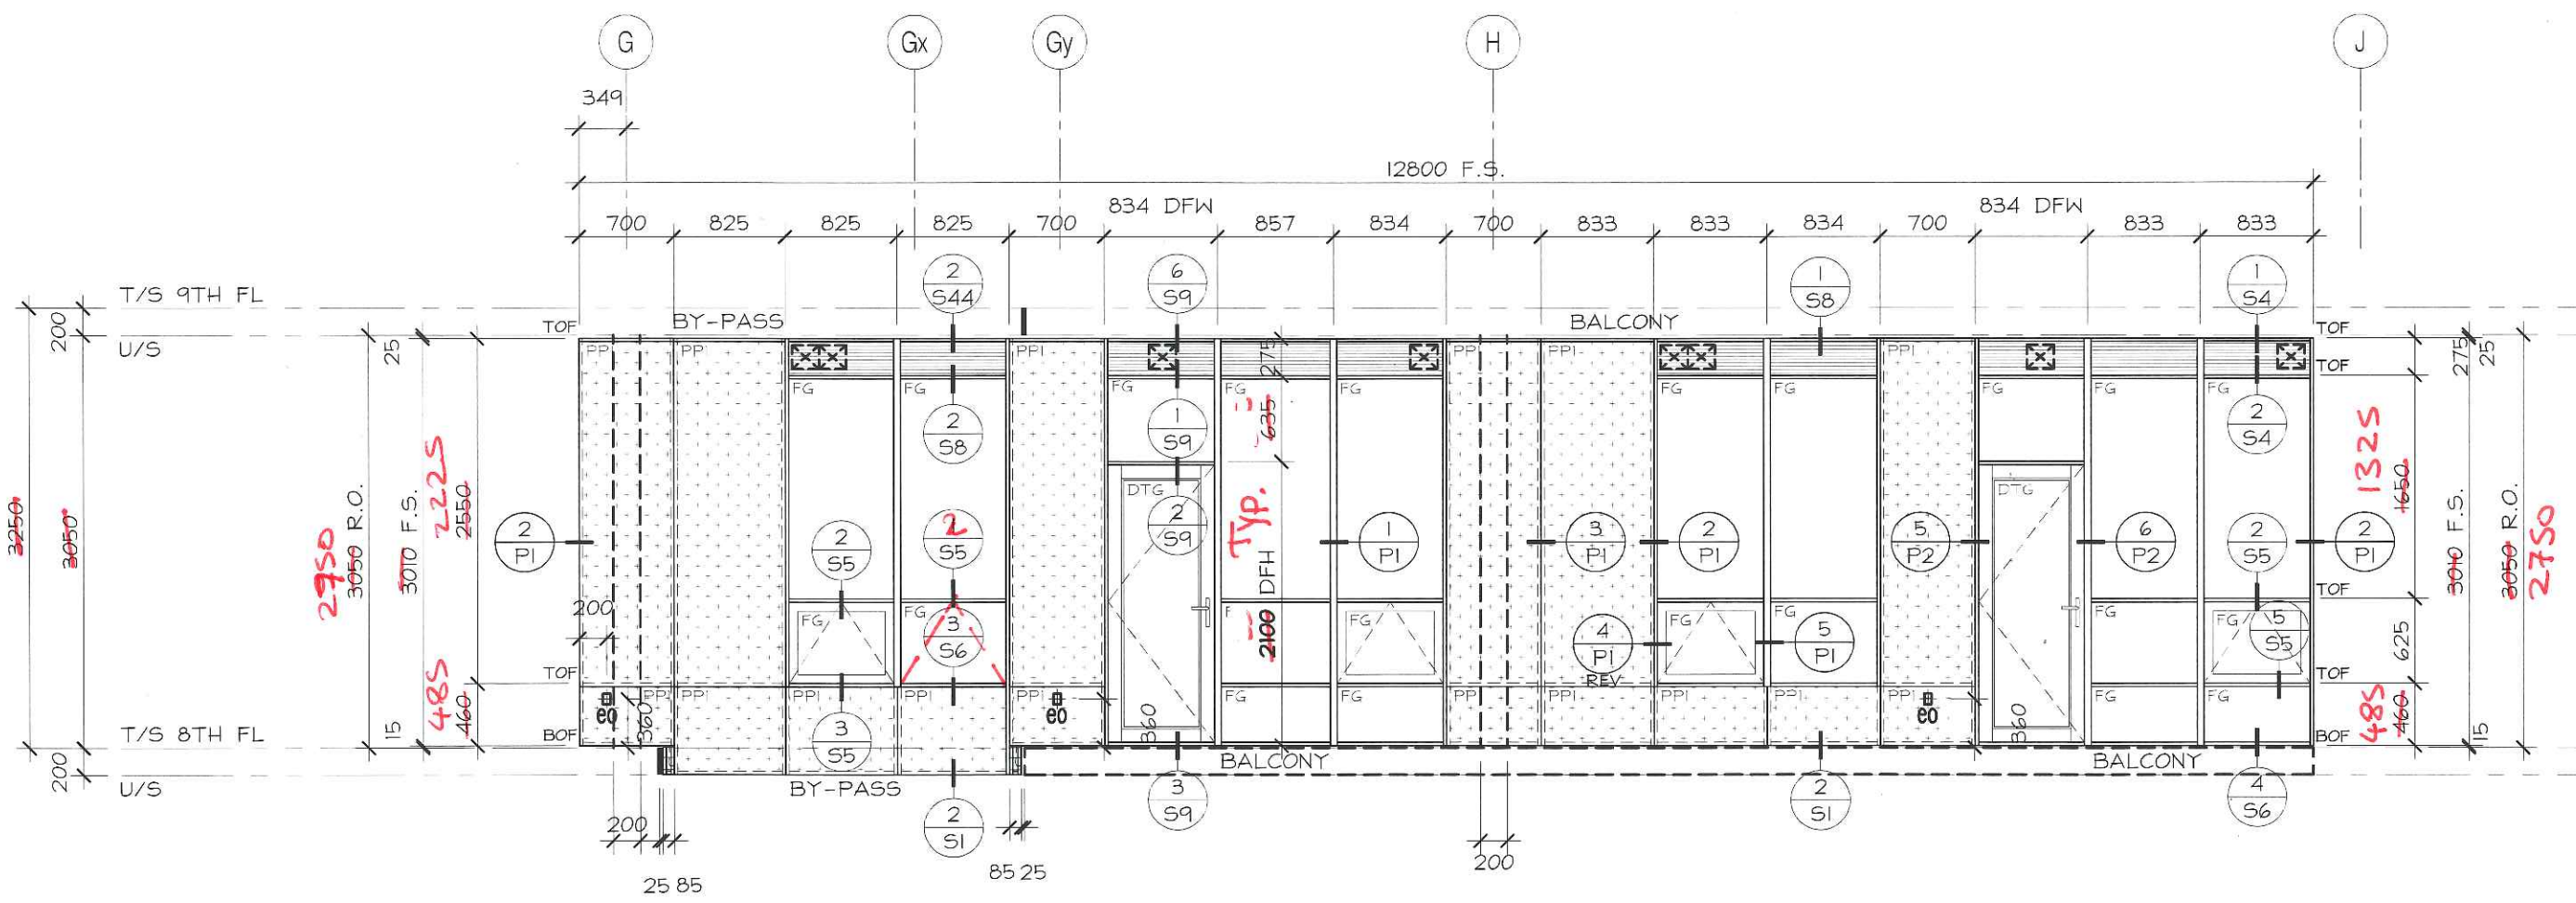

W8-03 1 REQUIRED
2487 SERIES


TORO ALUMINUM
COMMERCIAL INDUSTRIAL RESIDENTIAL
330 APPLEWOOD CRESCENT TEL: (905) 738-5220
CONCORD, ON, CANADA FAX: (905) 738-5481
L4K 4V2 WWW.TOROALUMINUM.COM

LICENSED PROFESSIONAL ENGINEER
06-27-15
D.T. PROHASKA
37549
PROVINCE OF ONTARIO

No.	REVISION	BY	DATE

PROJECT NAME: SQ ALEXANDRA PARK - BLOCK 11
DRAWING TITLE: 8th FLOOR ELEVATIONS
ARCHITECT: TEEPLE ARCHITECTS
CONTRACTOR: TRIDEL
SCALE: 1:50
DRAWN BY: S.C.
DATE: MARCH 4, 2015



DRAWING No.:
E8-3

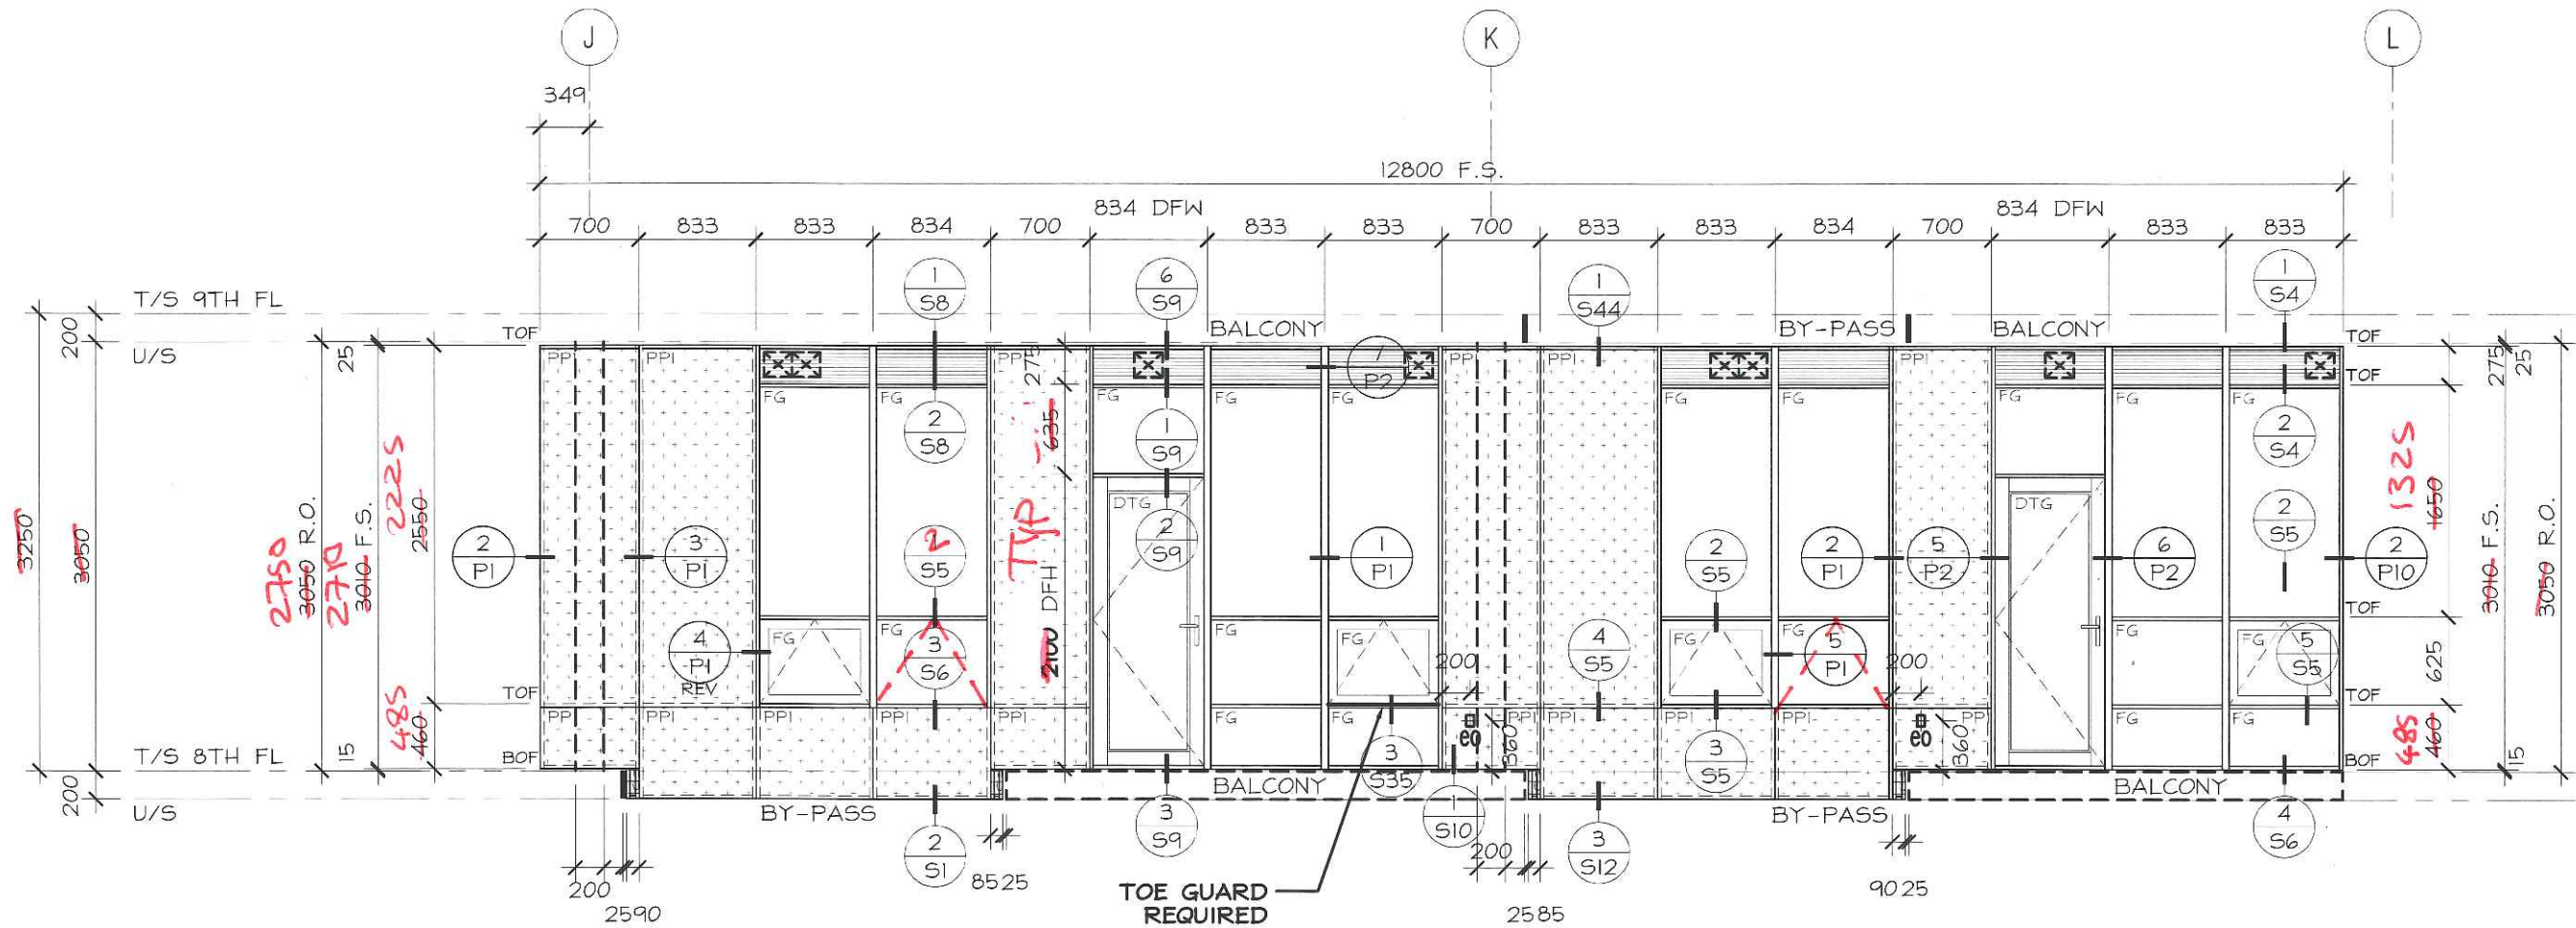

No.	REVISION	BY	DATE

PROJECT NAME:	SQ ALEXANDRA PARK - BLOCK11
DRAWING TITLE:	8th FLOOR ELEVATIONS
ARCHITECT:	TEEPLE ARCHITECTS
CONTRACTOR:	TRIDEL
SCALE:	1:50
DRAWN BY:	S.C.
DATE:	MARCH 4, 2015



DRAWING No.:
E8-4

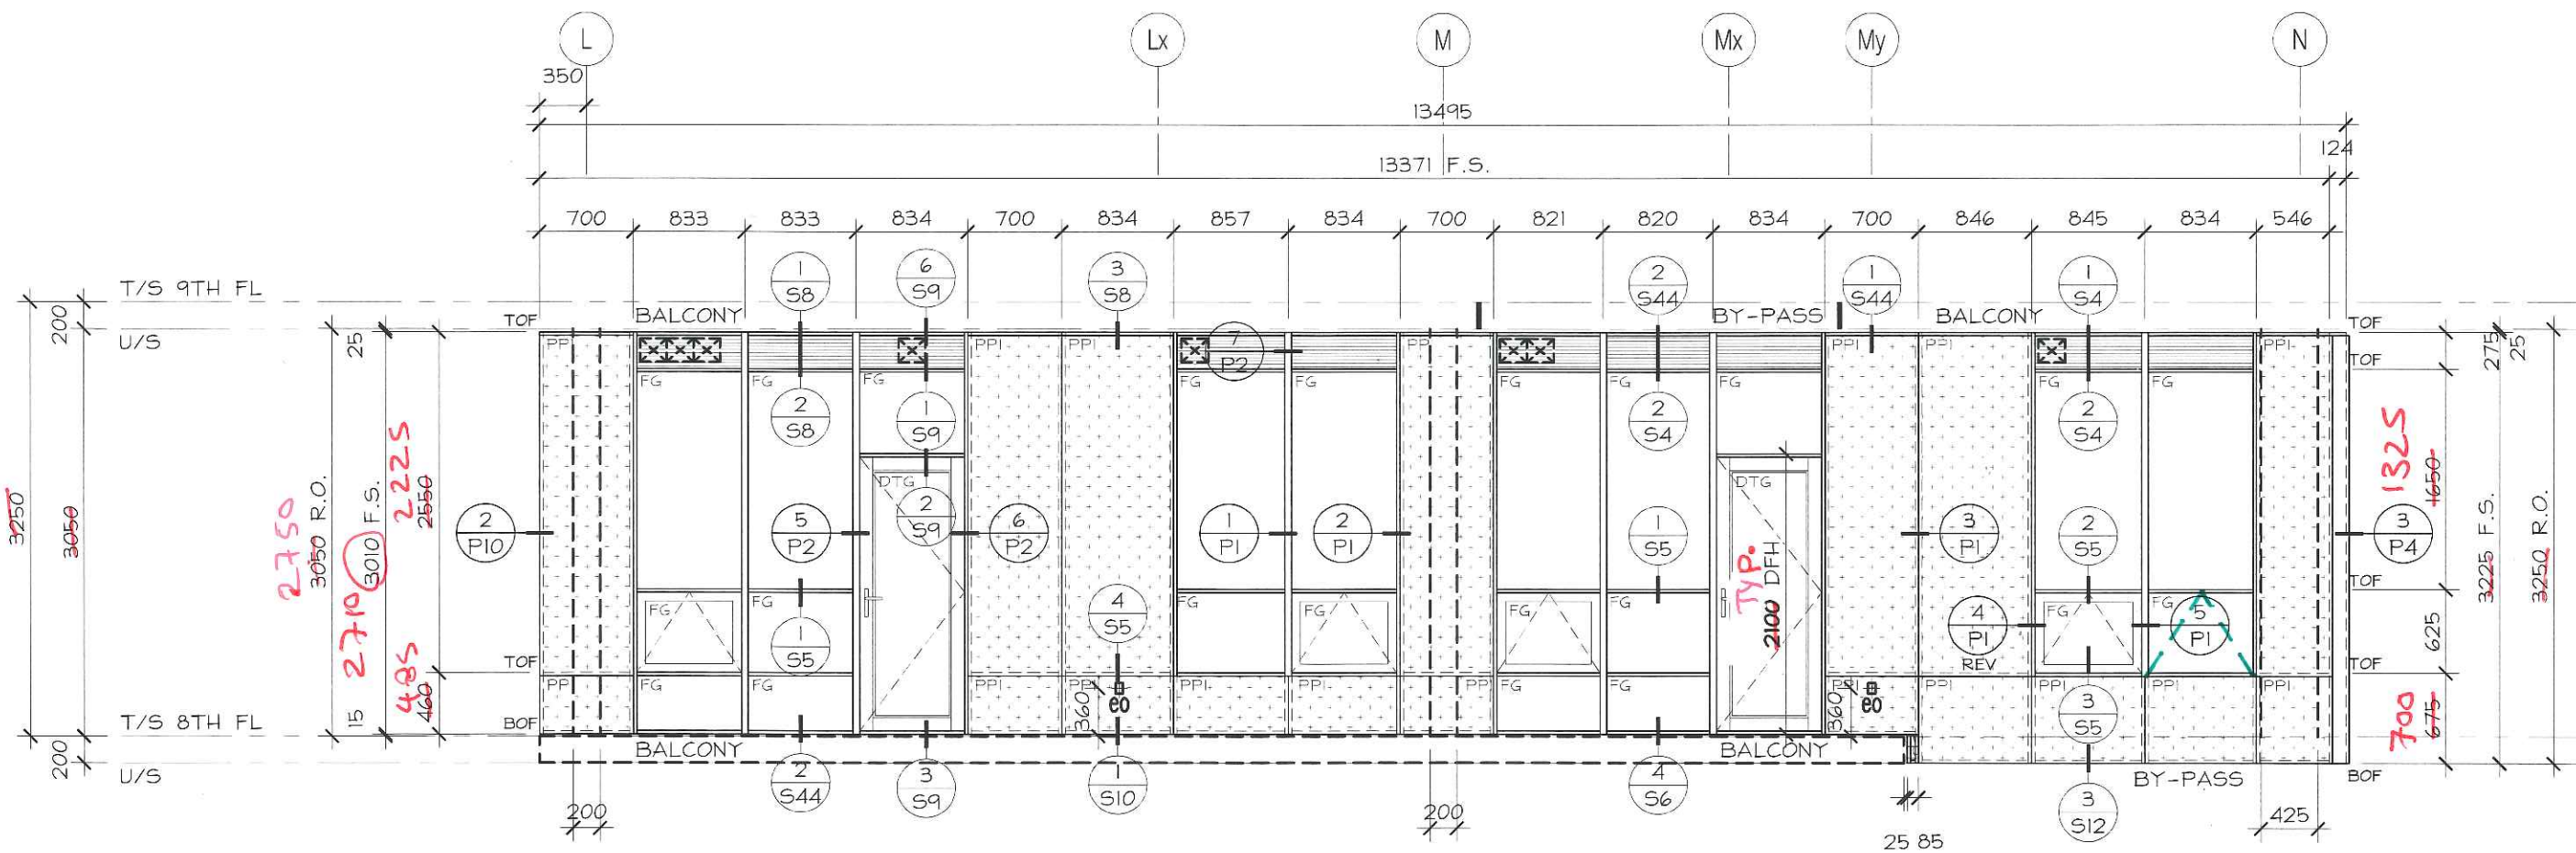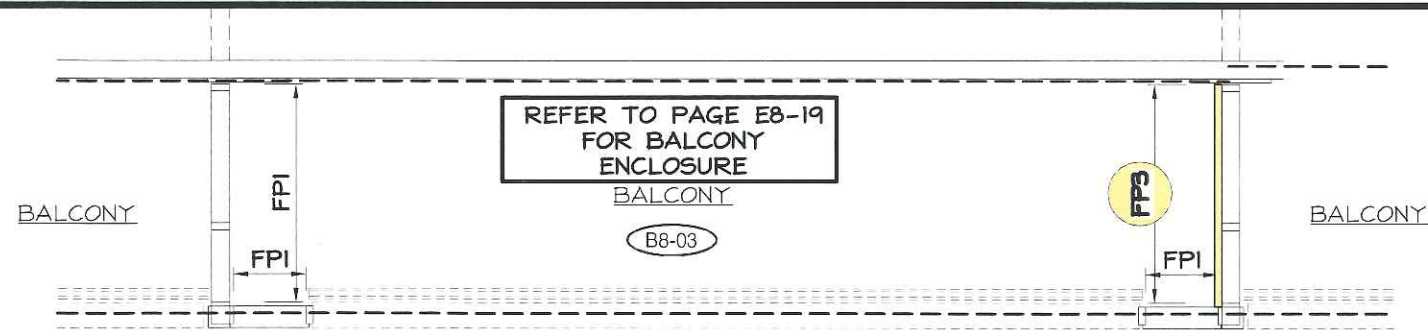

No.	REVISION	BY	DATE


PROJECT NAME: SQ ALEXANDRA PARK - BLOCK11
 DRAWING TITLE: 8th FLOOR ELEVATIONS
 ARCHITECT: TEEPLE ARCHITECTS
 CONTRACTOR: TRIDEL
 SCALE: 1:50
 DRAWN BY: S.C.
 DATE: MARCH 4, 2015

DRAWING No.: E8-5

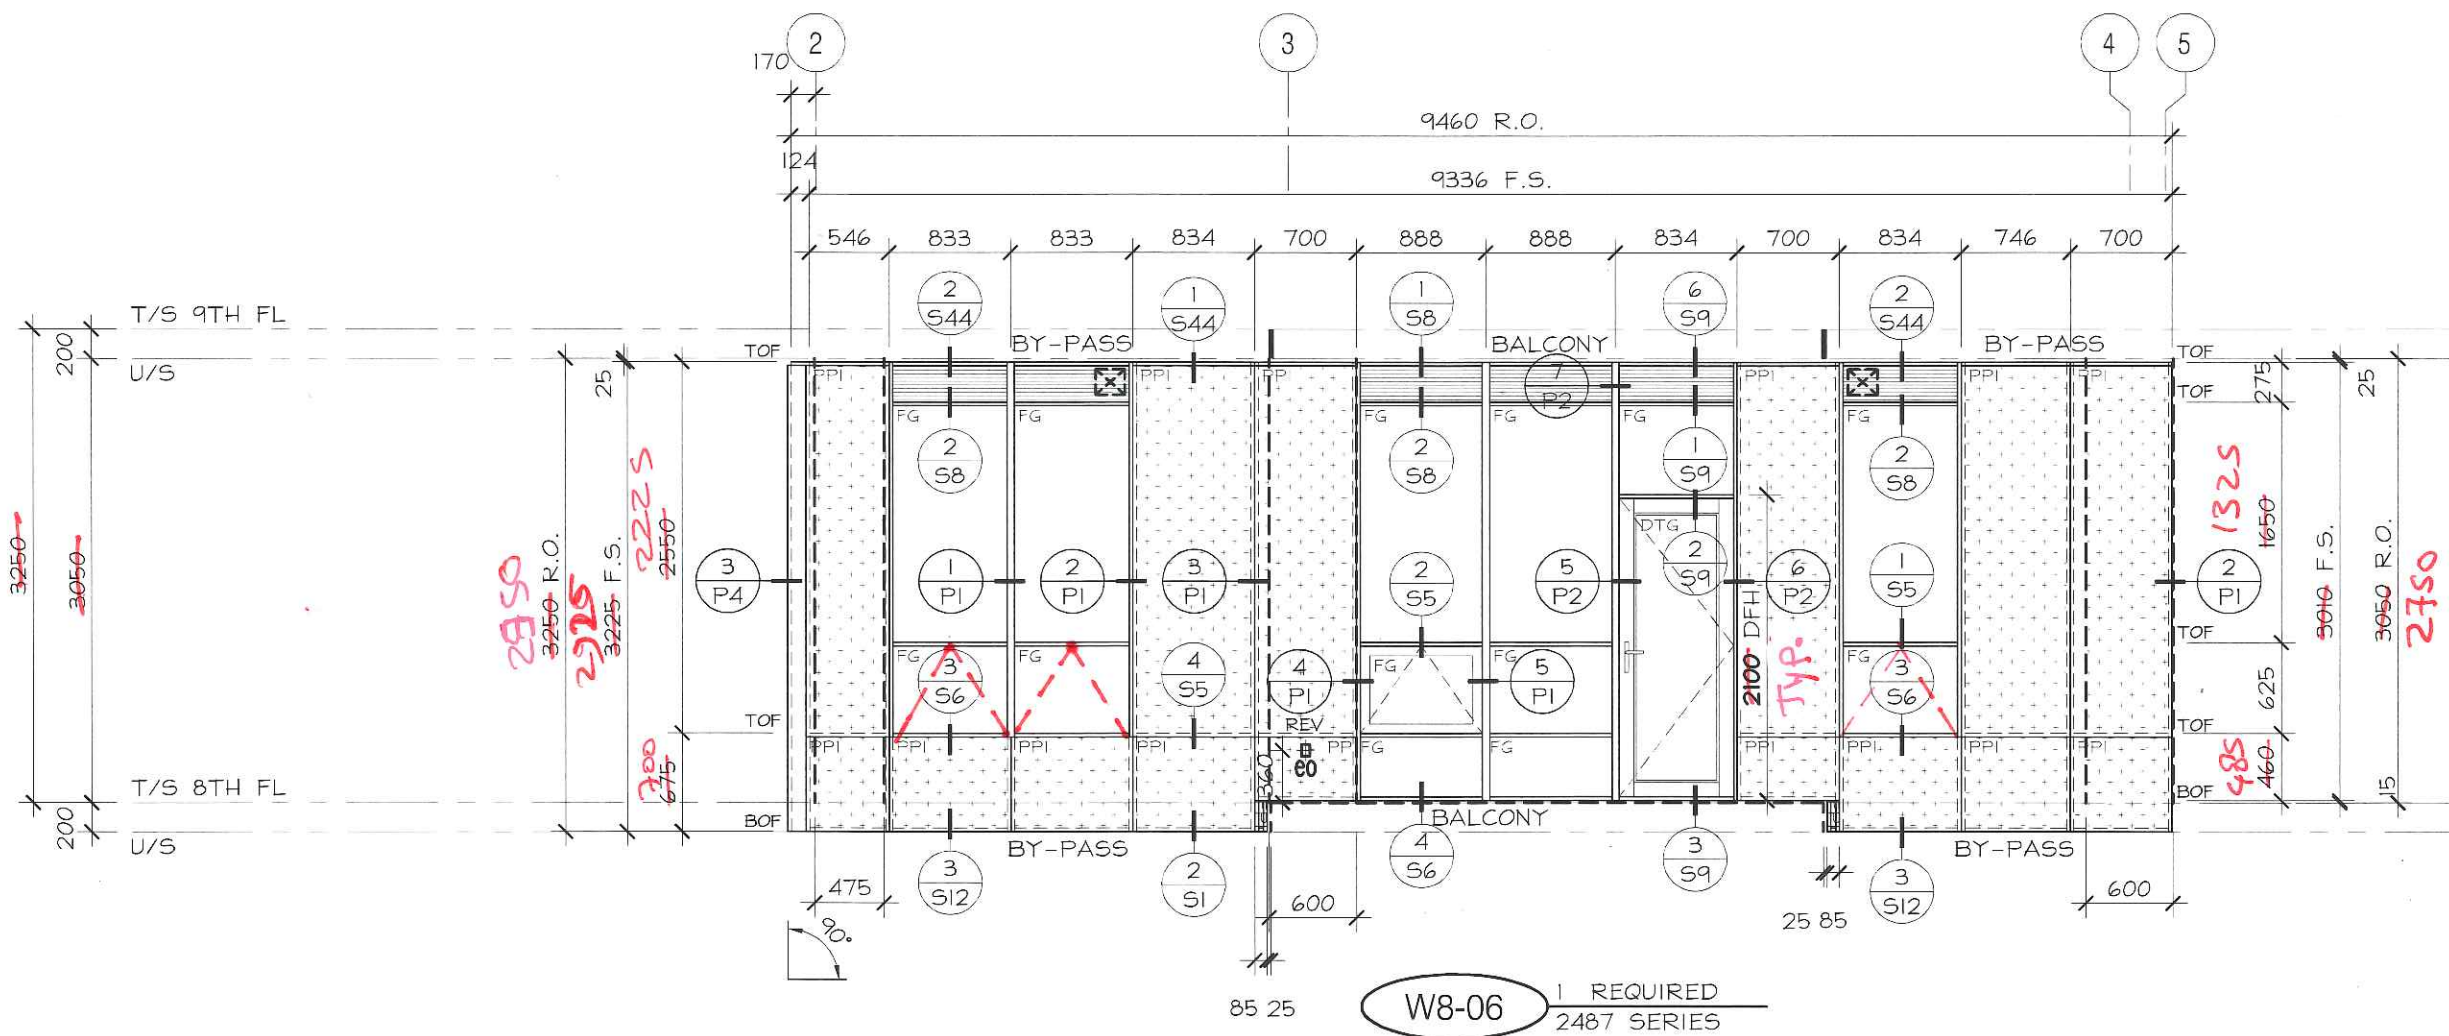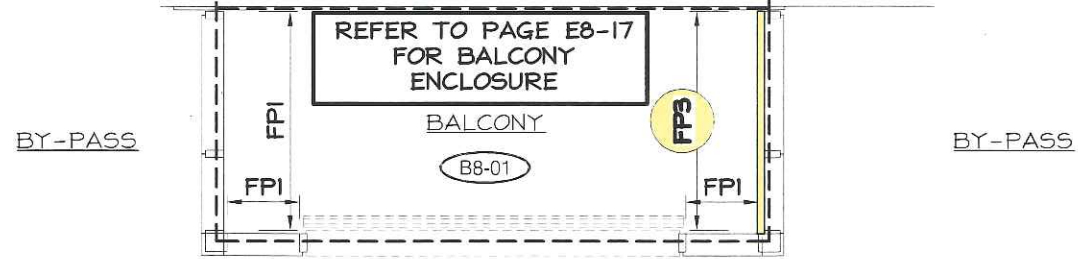

No.	REVISION	BY	DATE

PROJECT NAME: SQ ALEXANDRA PARK - BLOCK11		DRAWING No.: E8-6
DRAWING TITLE: 8th FLOOR ELEVATIONS		
ARCHITECT: TEEPLE ARCHITECTS		DATE: MARCH 4, 2015
CONTRACTOR: TRIDEL		
SCALE: 1:50	DRAWN BY: S.C.	

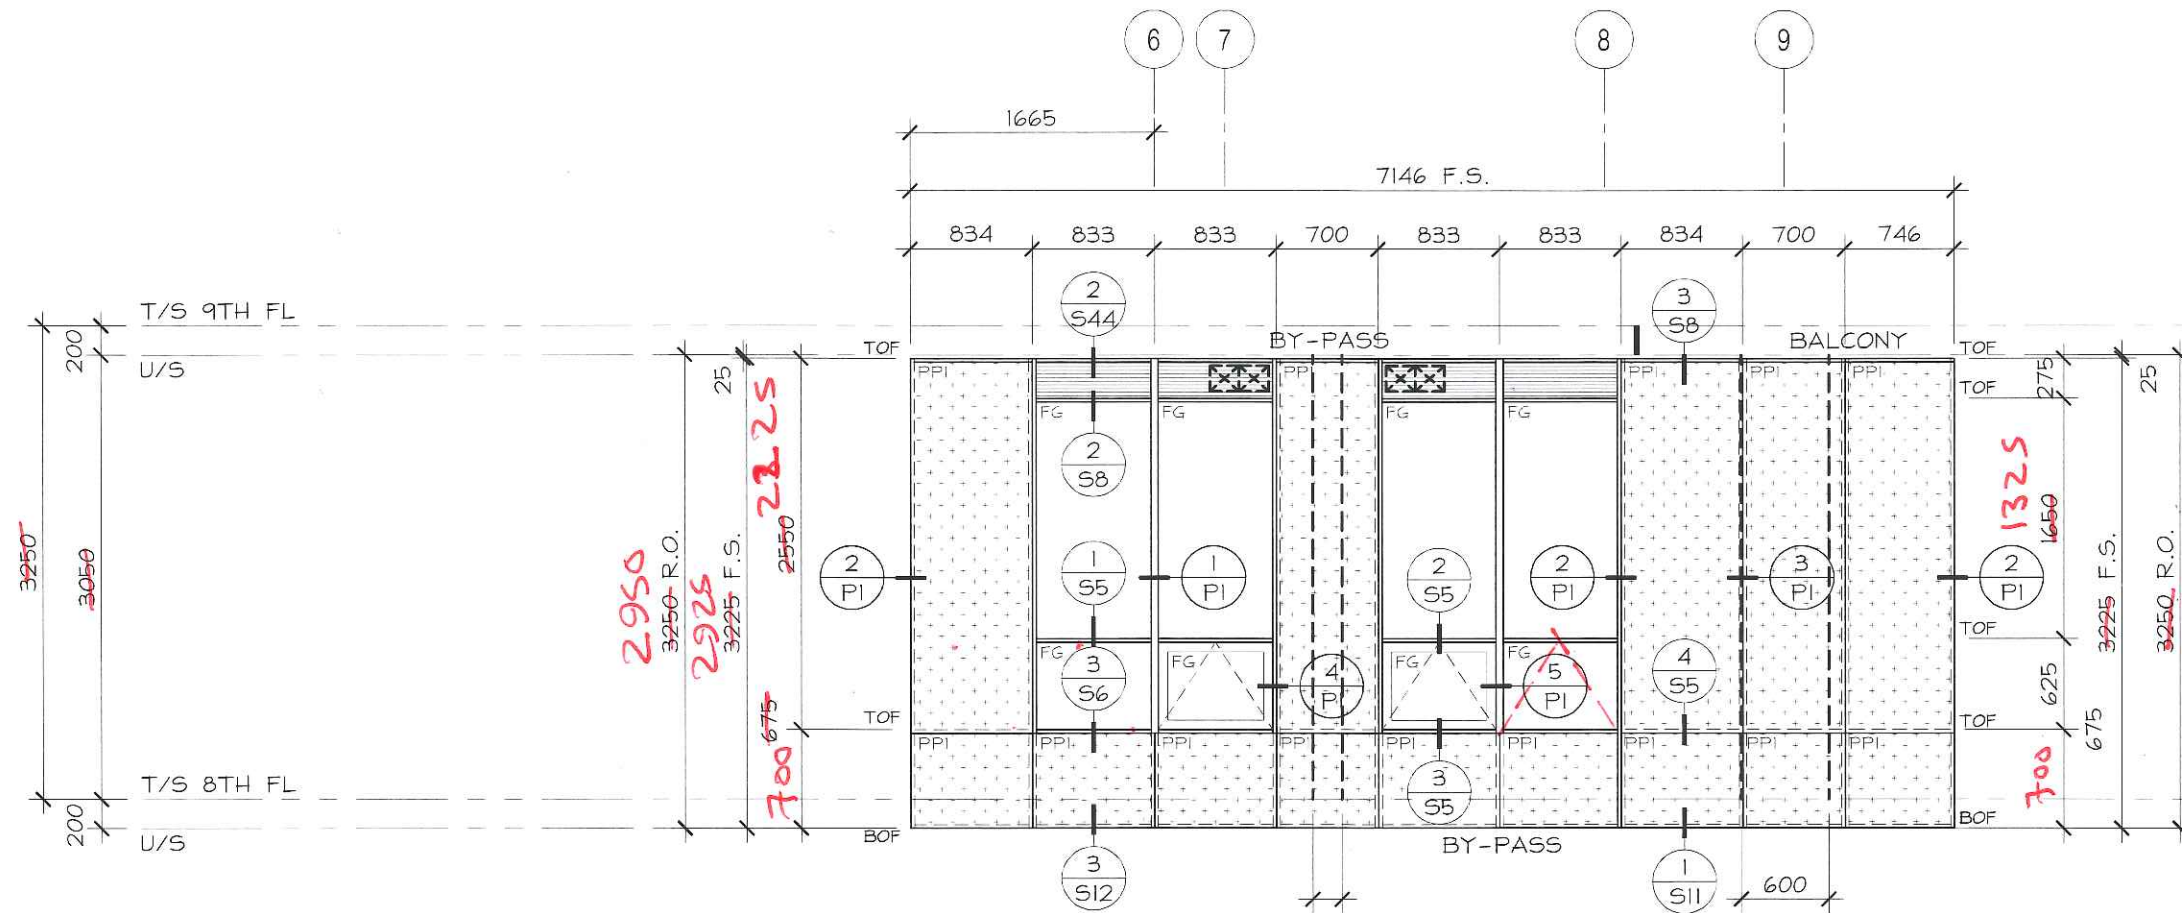

W8-07 1 REQUIRED
2487 SERIES



No.	REVISION	BY	DATE

PROJECT NAME: SQ ALEXANDRA PARK - BLOCK11
 DRAWING TITLE: 8th FLOOR ELEVATIONS
 ARCHITECT: TEEPLE ARCHITECTS
 CONTRACTOR: TRIDEL
 SCALE: 1:50
 DRAWN BY: S.C.
 DATE: MARCH 4, 2015

DRAWING No.:
E8-7


REFER TO PAGE E8-17
FOR BALCONY
ENCLOSURE
BALCONY

B8-01

FPS

BY-PASS

BY-PASS

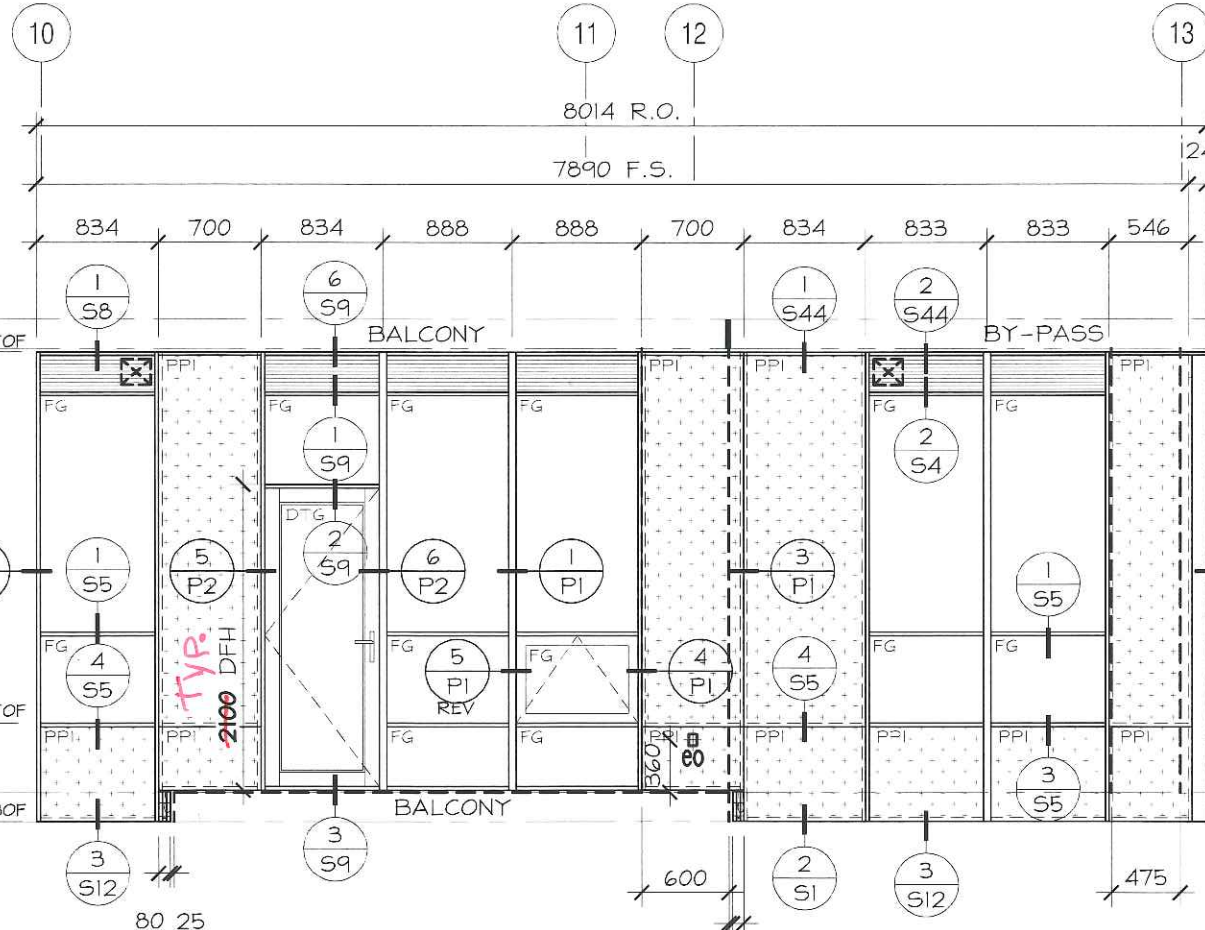

W8-08 1 REQUIRED
2487 SERIES

2950 3250
2750 3050
200
T/S 9TH FL
U/S
200
T/S 8TH FL
U/S

2950 3250 R.O.
3225 F.S.
700 675
2225

1325
1650
700 675
3225 F.S.
3250 R.O.



No.	REVISION	BY	DATE

PROJECT NAME: SQ ALEXANDRA PARK - BLOCK 11
DRAWING TITLE: 8th FLOOR ELEVATIONS
ARCHITECT: TEEPLE ARCHITECTS
CONTRACTOR: TRIDEL
SCALE: 1:50
DRAWN BY: S.C.
DATE: MARCH 4, 2015

DRAWING No.:
E8-8

REFER TO PAGE E8-20
FOR BALCONY
ENCLOSURE

BY-PASS

BY-PASS

BALCONY

B8-04

My

Mx

M

Lx

11129 R.O.

11005 F.S.

546 834 845 846 700 854 810 811 700 833 833 859 700 834 DFW

T/S 9TH FL

U/S

TOF

BY-PASS

BALCONY

BY-PASS

BALCONY

TOF

TOF

BOF

BY-PASS

BALCONY

BALCONY

BOF

85 25

200

85 25

W8-09 1 REQUIRED
2487 SERIES

BREAK SHAPE FILLER
ATTACHING TO VERTICAL
MULLION

2950
3250
2750
3050

2950
3250 R.O.
2925
3225 F.S.
2225
2550


310
636
275
2125
2100 DFH
3010 F.S.
3050 R.O.

T/S 8TH FL

U/S

TOF

BOF

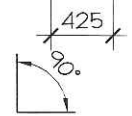

200

15

TORO ALUMINUM
COMMERCIAL INDUSTRIAL RESIDENTIAL
330 APPLEWOOD CRESCENT TEL: (905) 738-5220
CONCORD, ON, CANADA FAX: (905) 738-5481
L4K 4V2 WWW.TOROALUMINUM.COM

LICENSED PROFESSIONAL ENGINEER
06-27-15
D.T. PROHASKA
3754901
PROVINCE OF ONTARIO


No.	REVISION	BY	DATE

PROJECT NAME:	SQ ALEXANDRA PARK - BLOCK11
DRAWING TITLE:	8th FLOOR ELEVATIONS
ARCHITECT:	TEEPLE ARCHITECTS
CONTRACTOR:	TRIDEL
SCALE:	1:50
DRAWN BY:	S.C.
DATE:	MARCH 4, 2015

DRAWING No.:
E8-9

REFER TO PAGE E8-22
FOR BALCONY
ENCLOSURE

B8-06

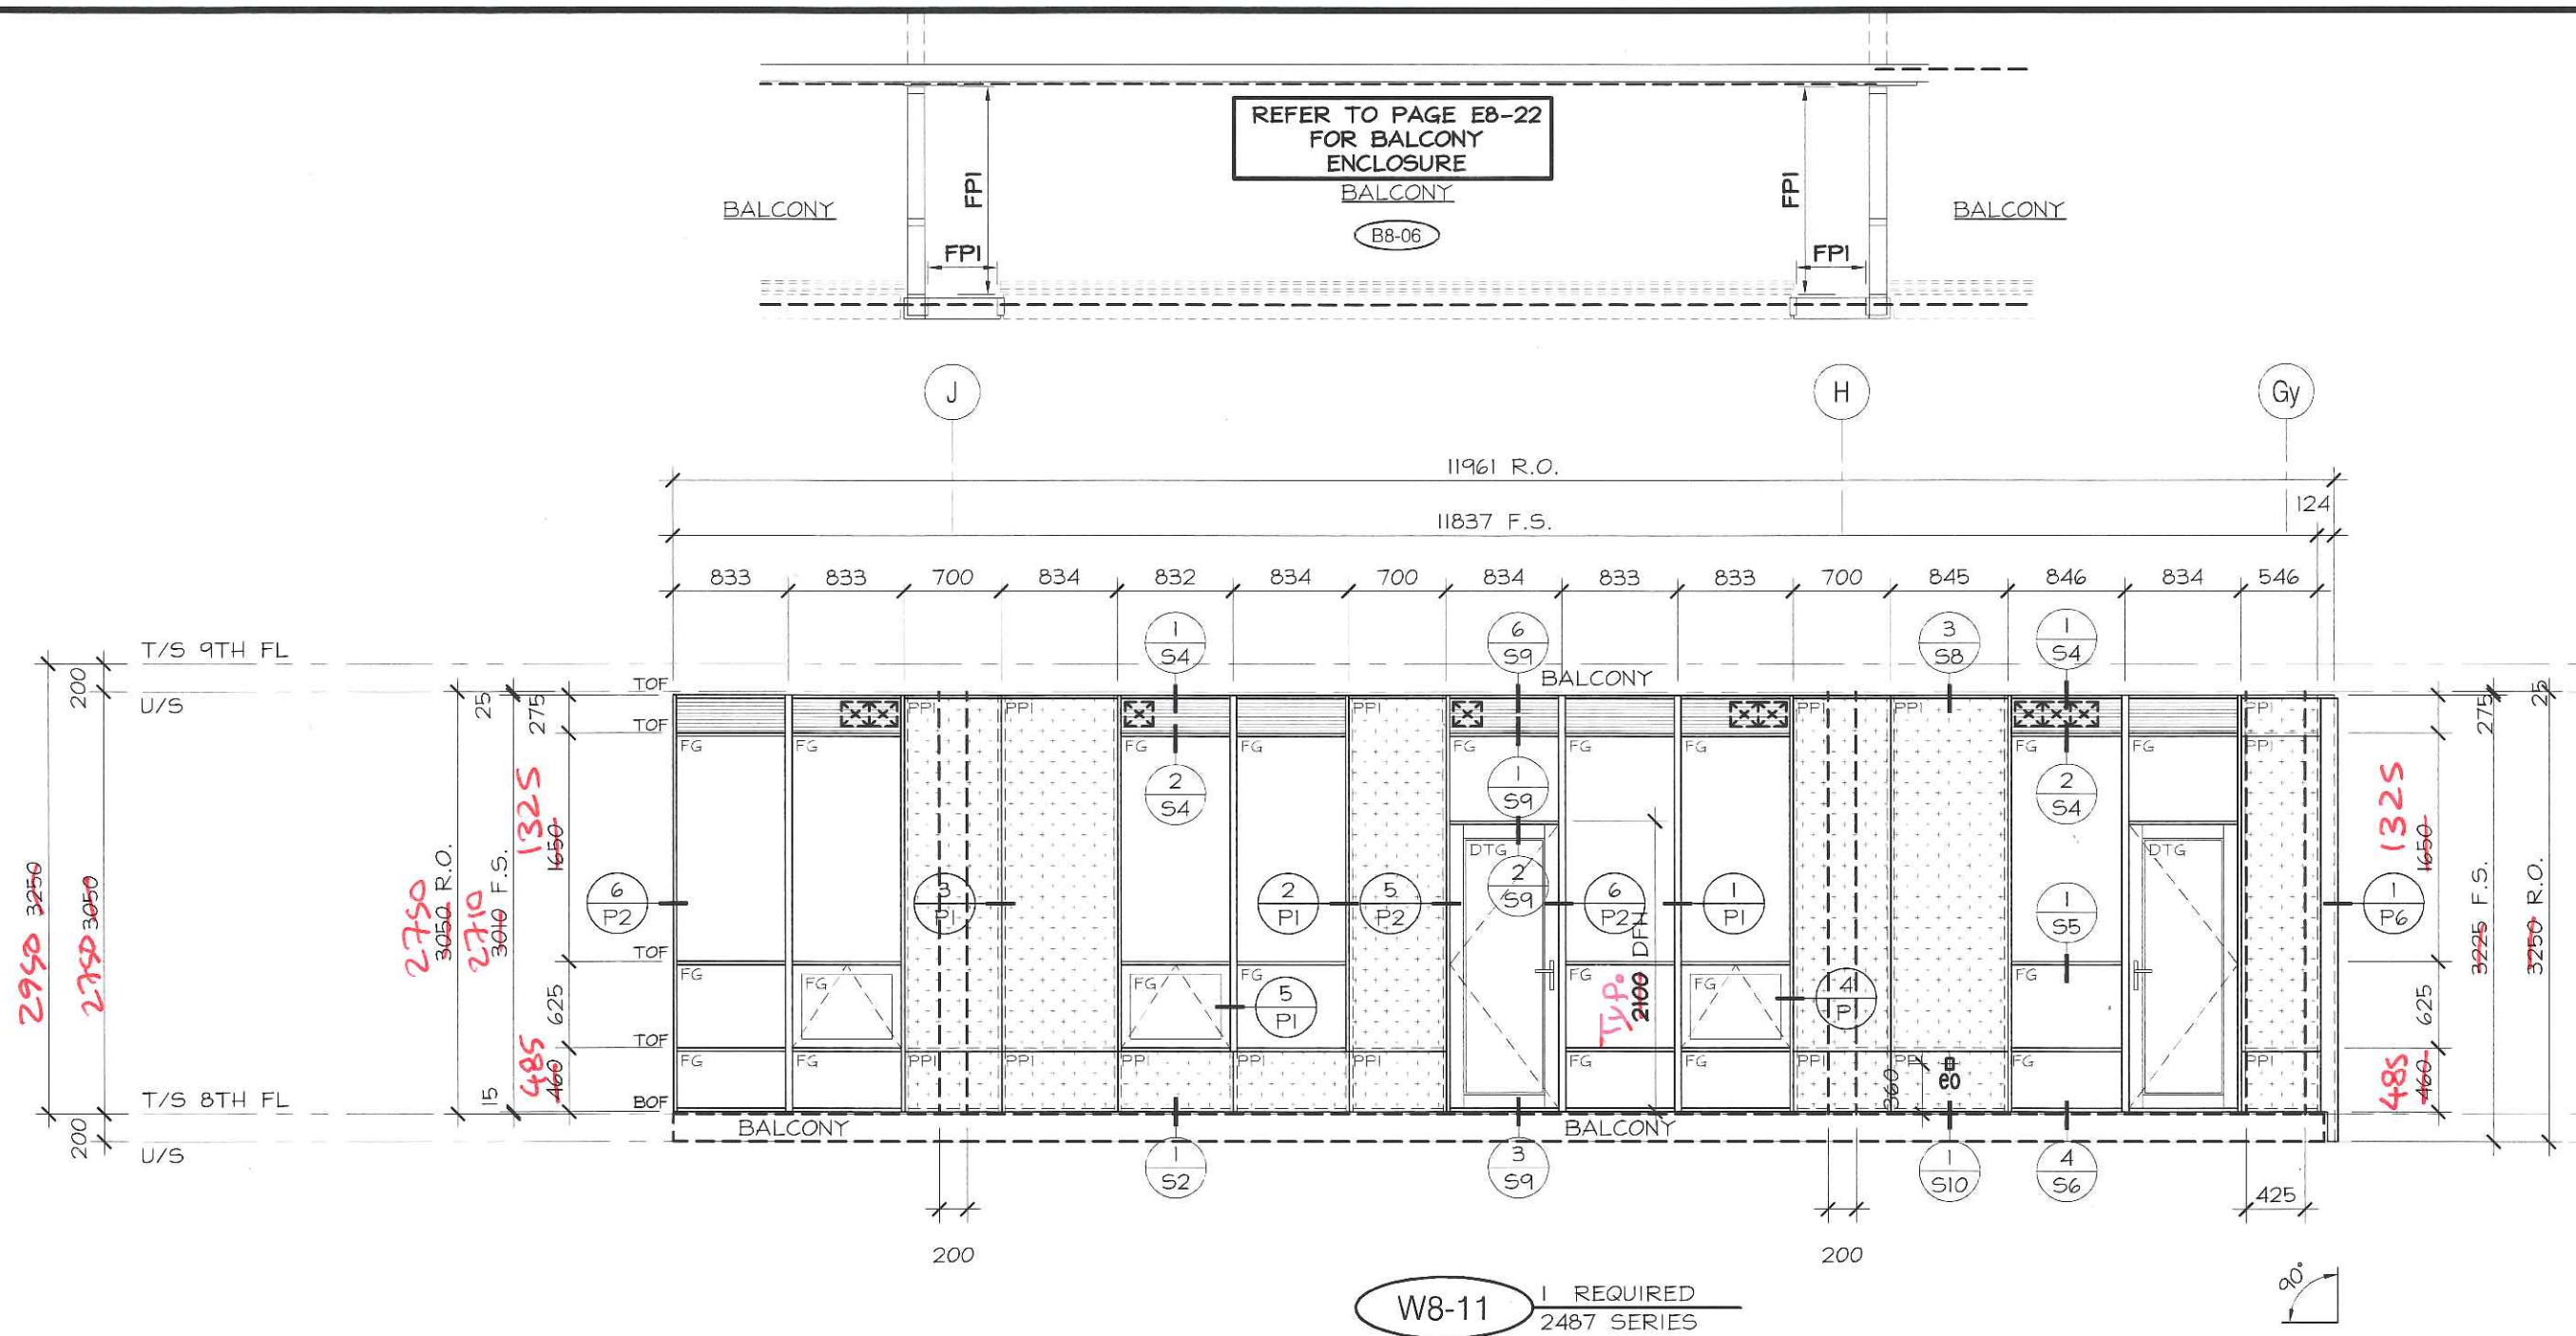

2950 3250
2750 3050

2750 3050 R.O.
2710 3010 F.S.
1325 1650

1325 1650
485 460
3225 F.S.
3250 R.O.


W8-11 1 REQUIRED 2487 SERIES



No.	REVISION	BY	DATE


PROJECT NAME: SQ ALEXANDRA PARK - BLOCK 11
 DRAWING TITLE: 8th FLOOR ELEVATIONS
 ARCHITECT: TEEPLE ARCHITECTS
 CONTRACTOR: TRIDEL
 SCALE: 1:50
 DRAWN BY: S.C.
 DATE: MARCH 4, 2015

DRAWING No.: E8-11

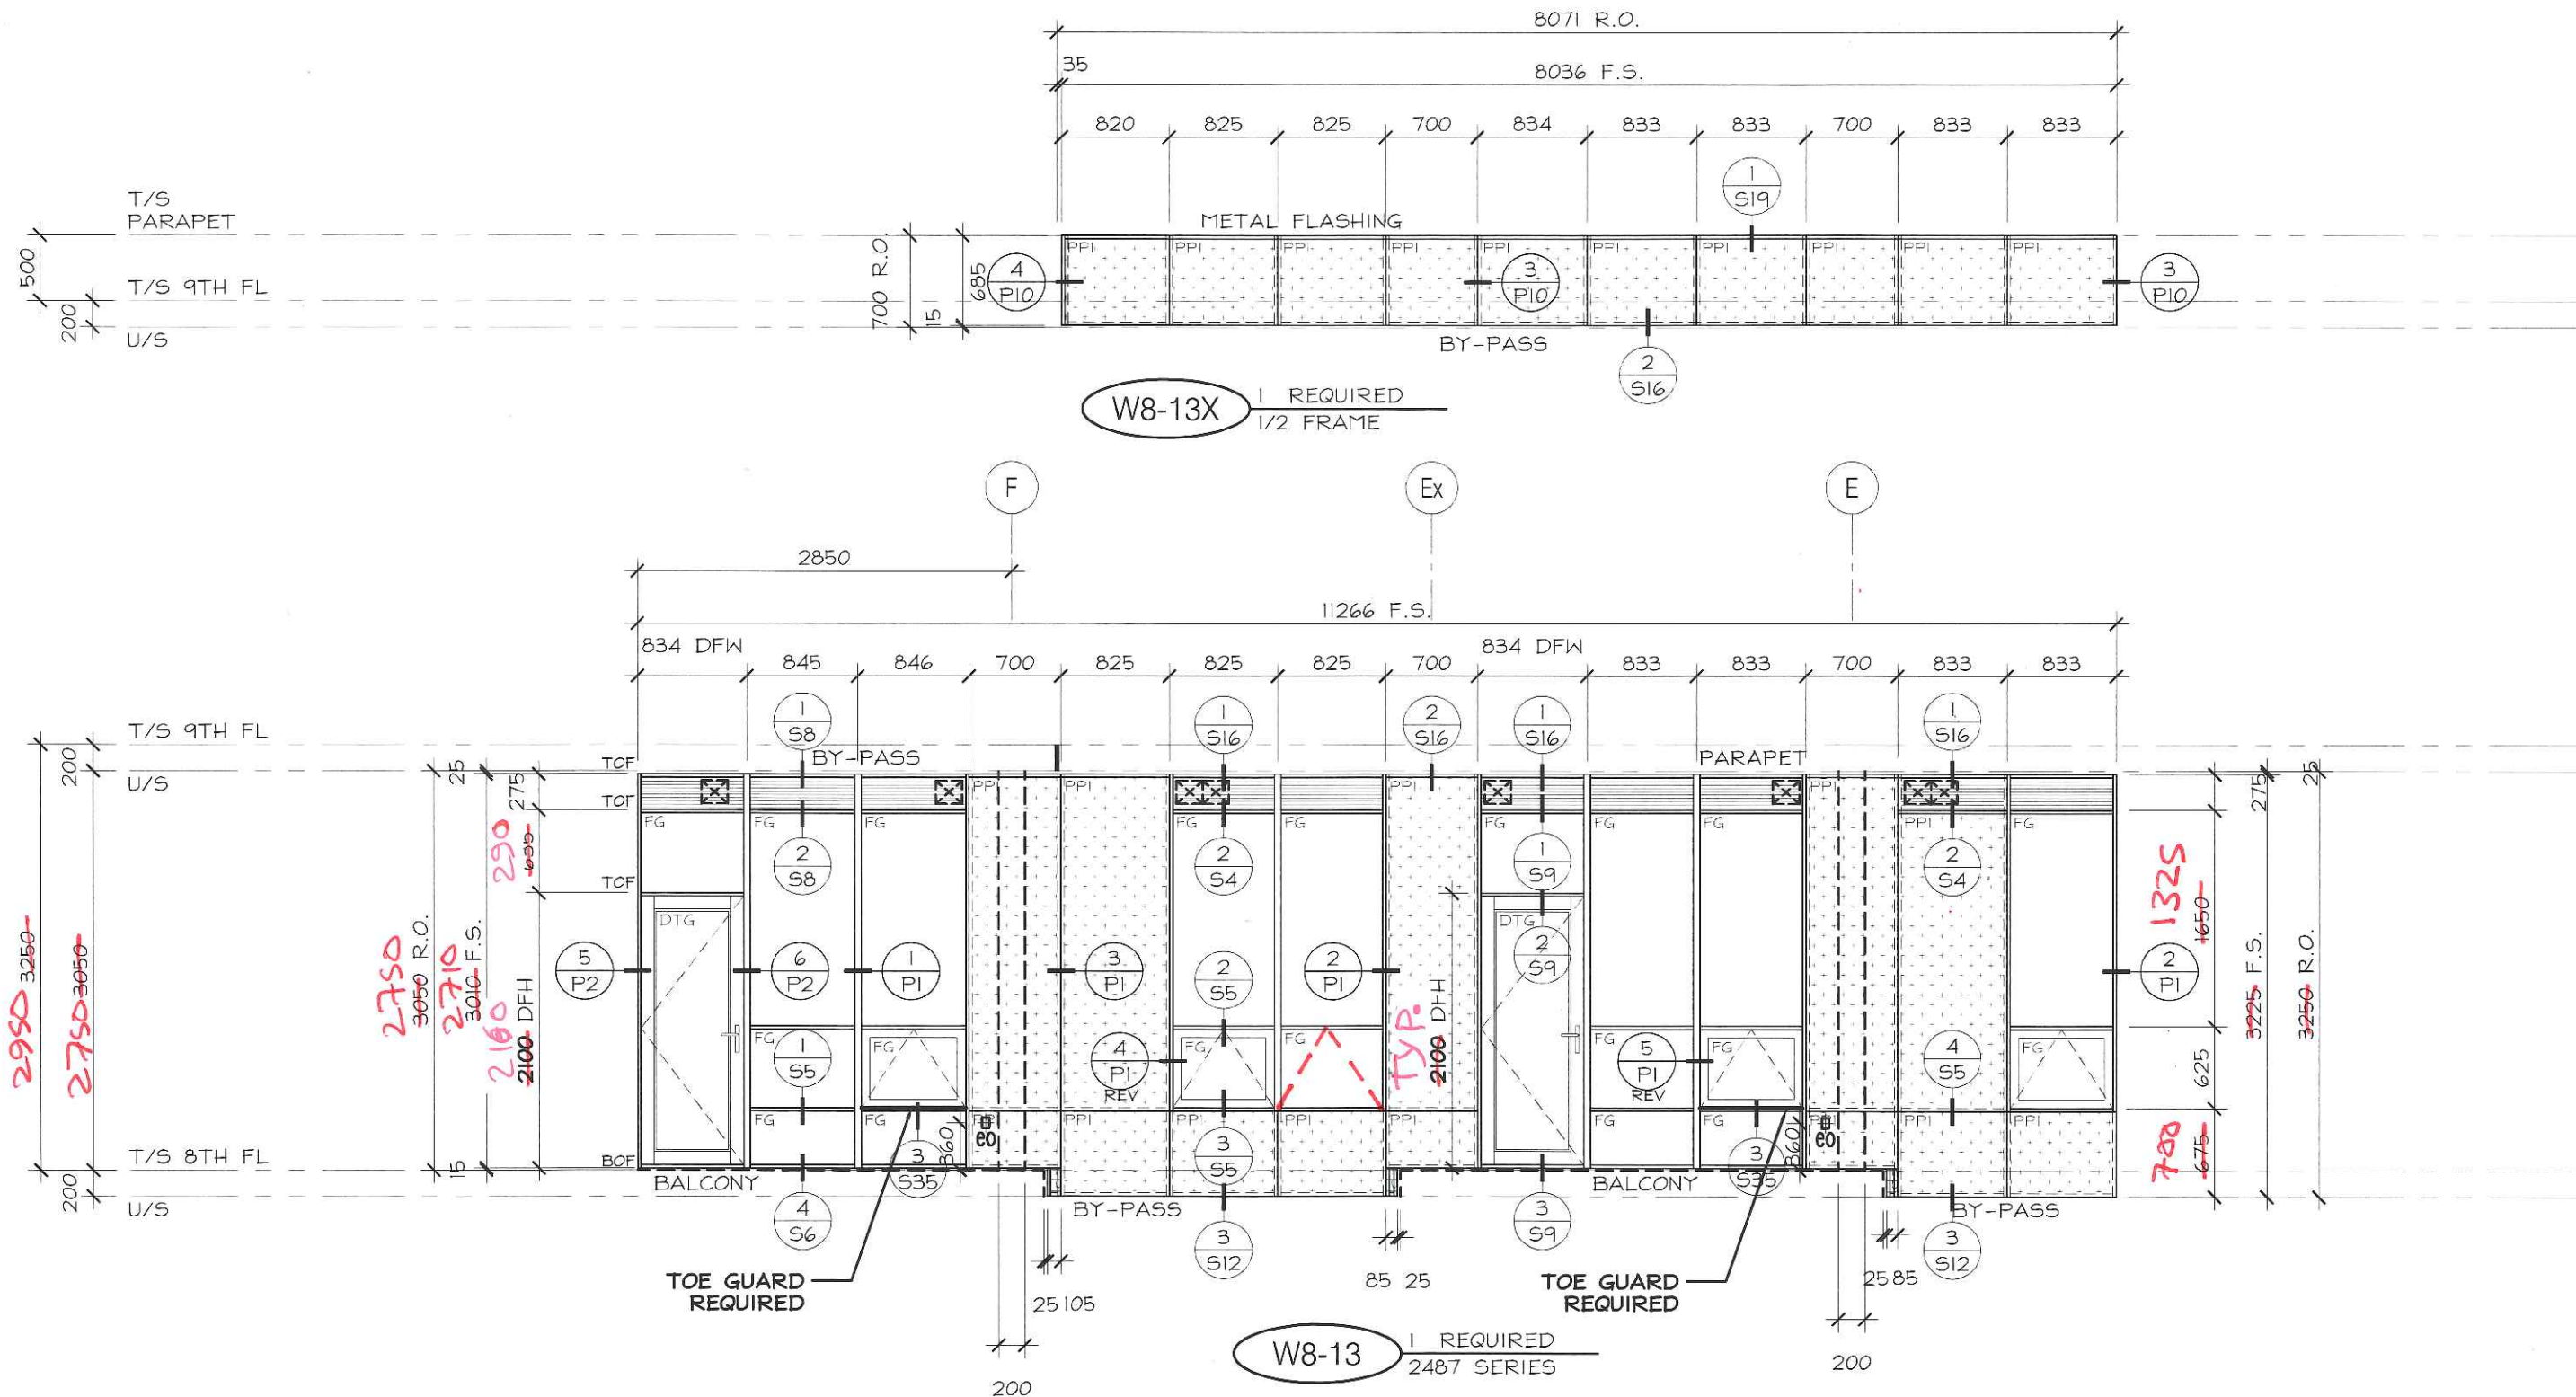

No.	REVISION	BY	DATE


PROJECT NAME:	SQ ALEXANDRA PARK - BLOCK11		
DRAWING TITLE:	8th FLOOR ELEVATIONS		
ARCHITECT:	TEEPLE ARCHITECTS		
CONTRACTOR:	TRIDEL		
SCALE:	1:50	DRAWN BY:	S.C.
DATE:	MARCH 4, 2015		
DRAWING No.:	E8-13		

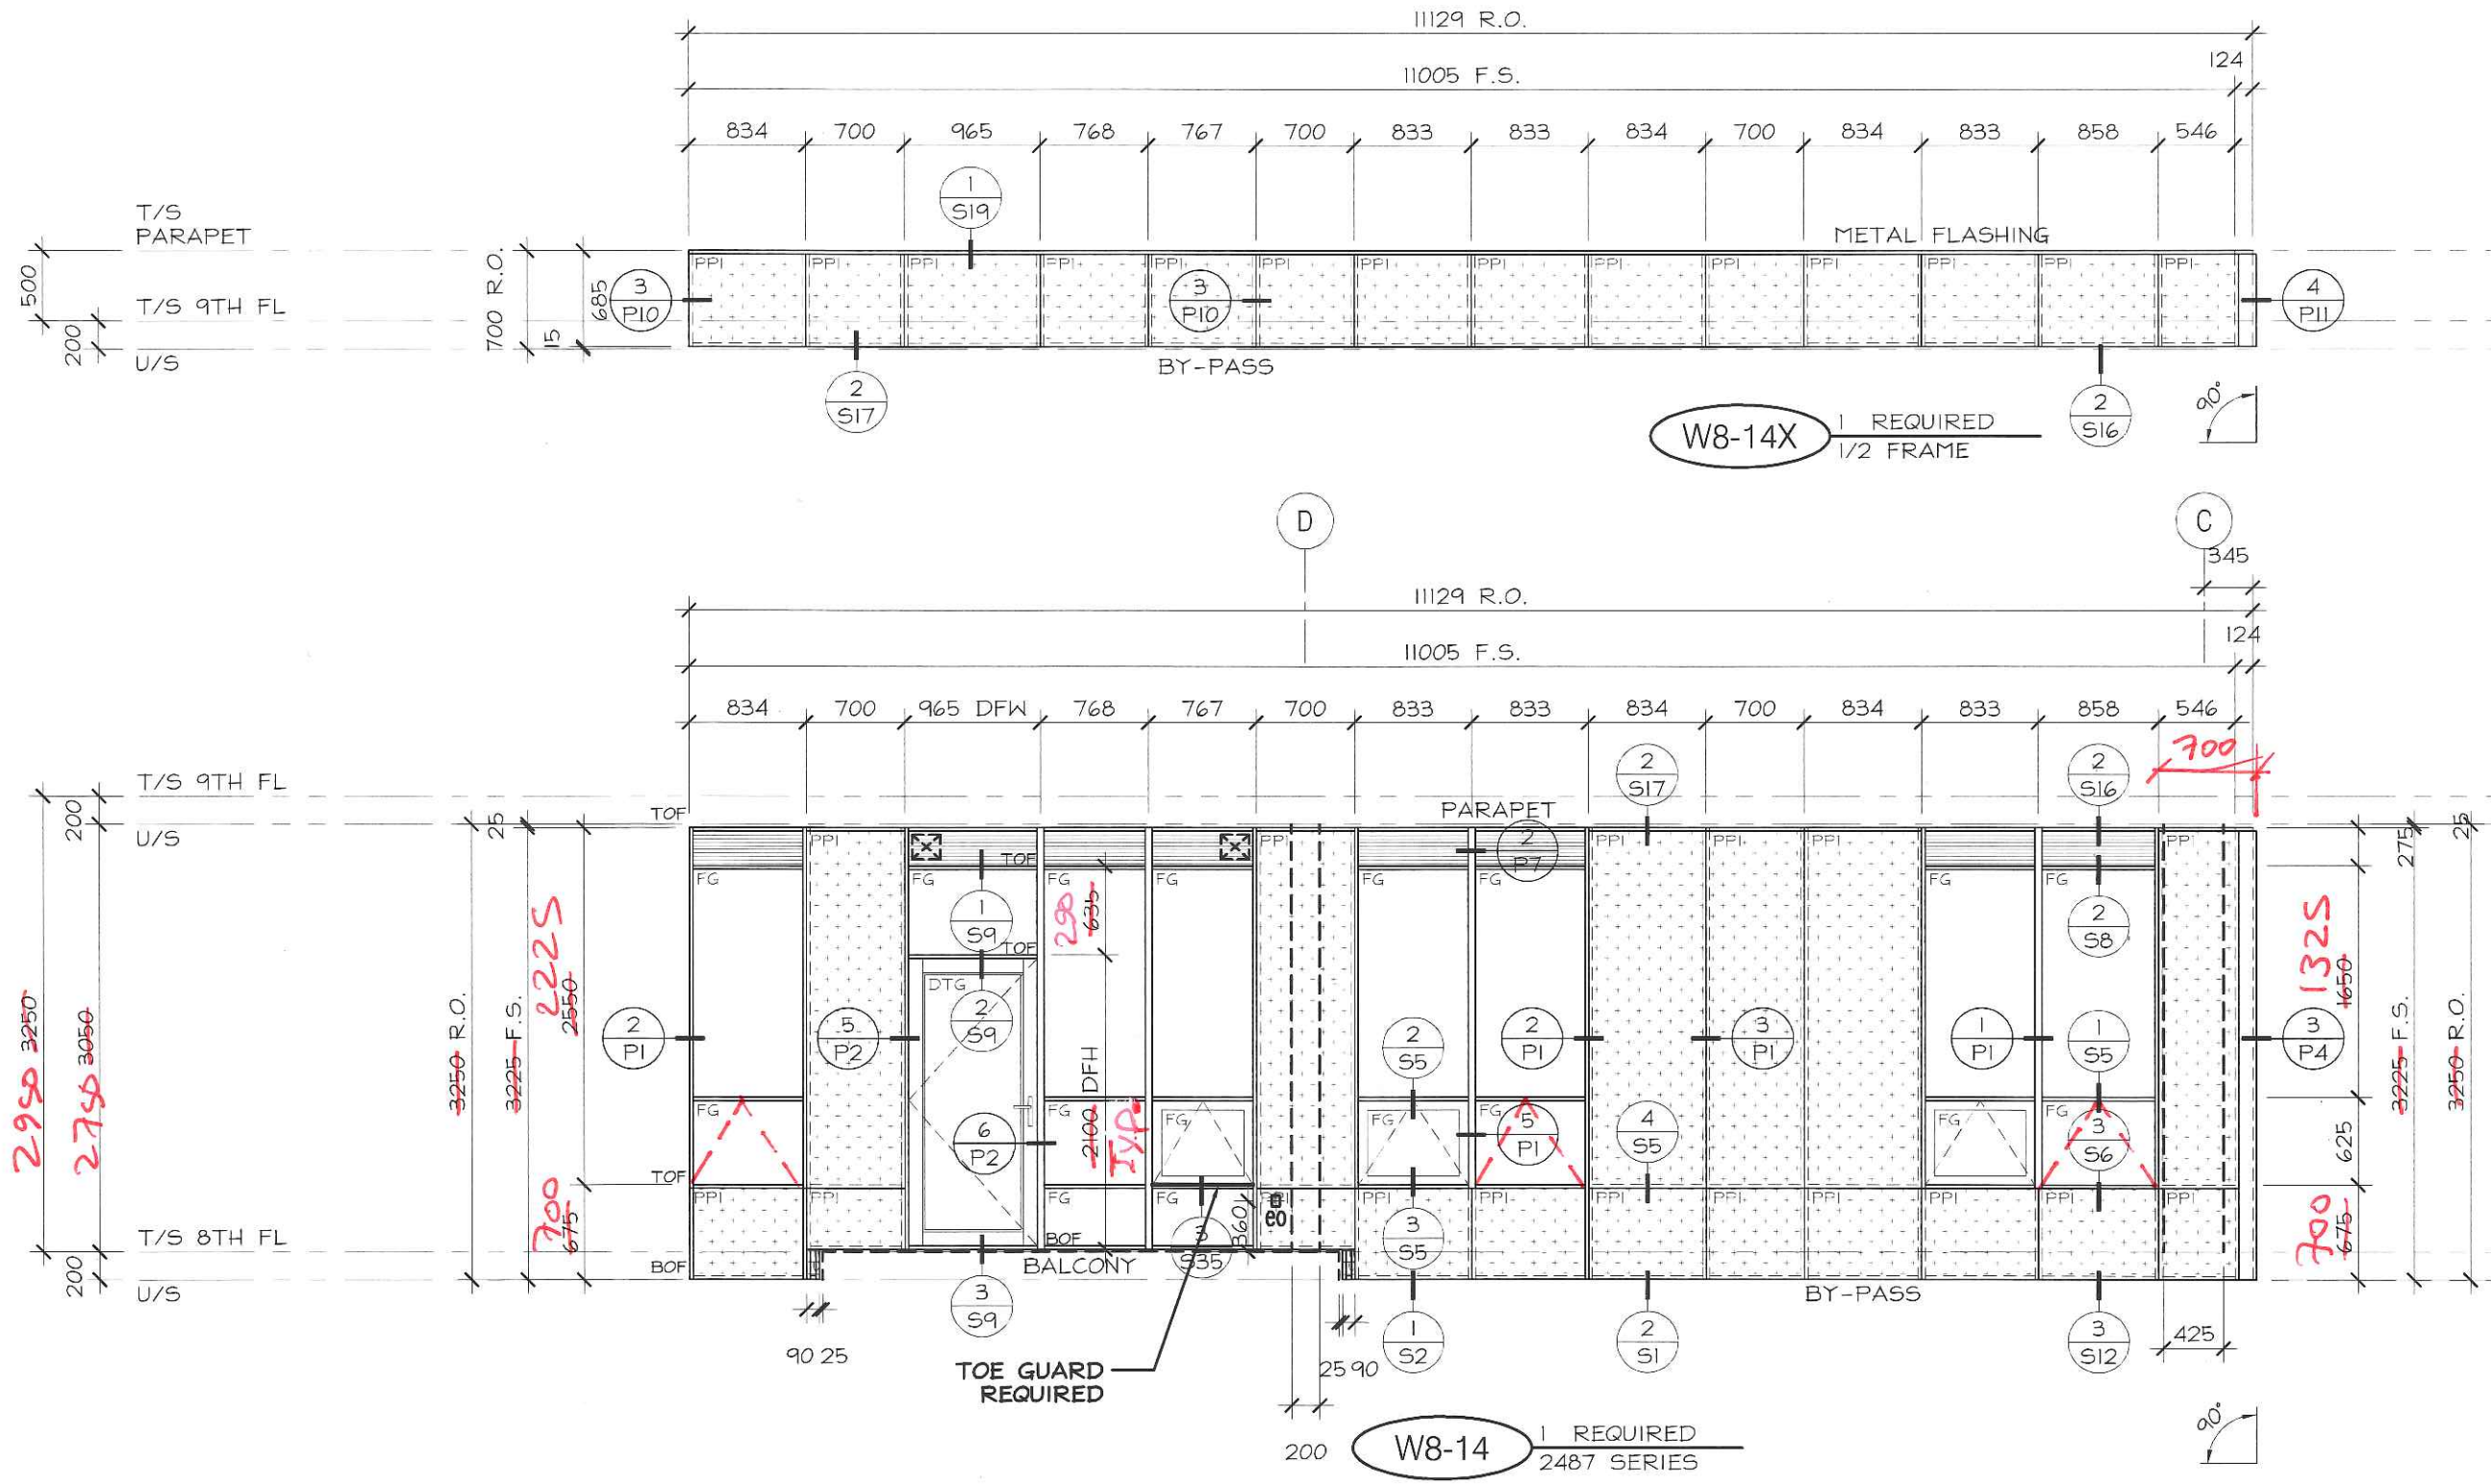

No.	REVISION	BY	DATE

PROJECT NAME: SQ ALEXANDRA PARK - BLOCK 11
 DRAWING TITLE: 8th FLOOR ELEVATIONS
 ARCHITECT: TEEPLE ARCHITECTS
 CONTRACTOR: TRIDEL
 SCALE: 1:50
 DRAWN BY: S.C.
 DATE: MARCH 4, 2015

DRAWING No.: E8-14


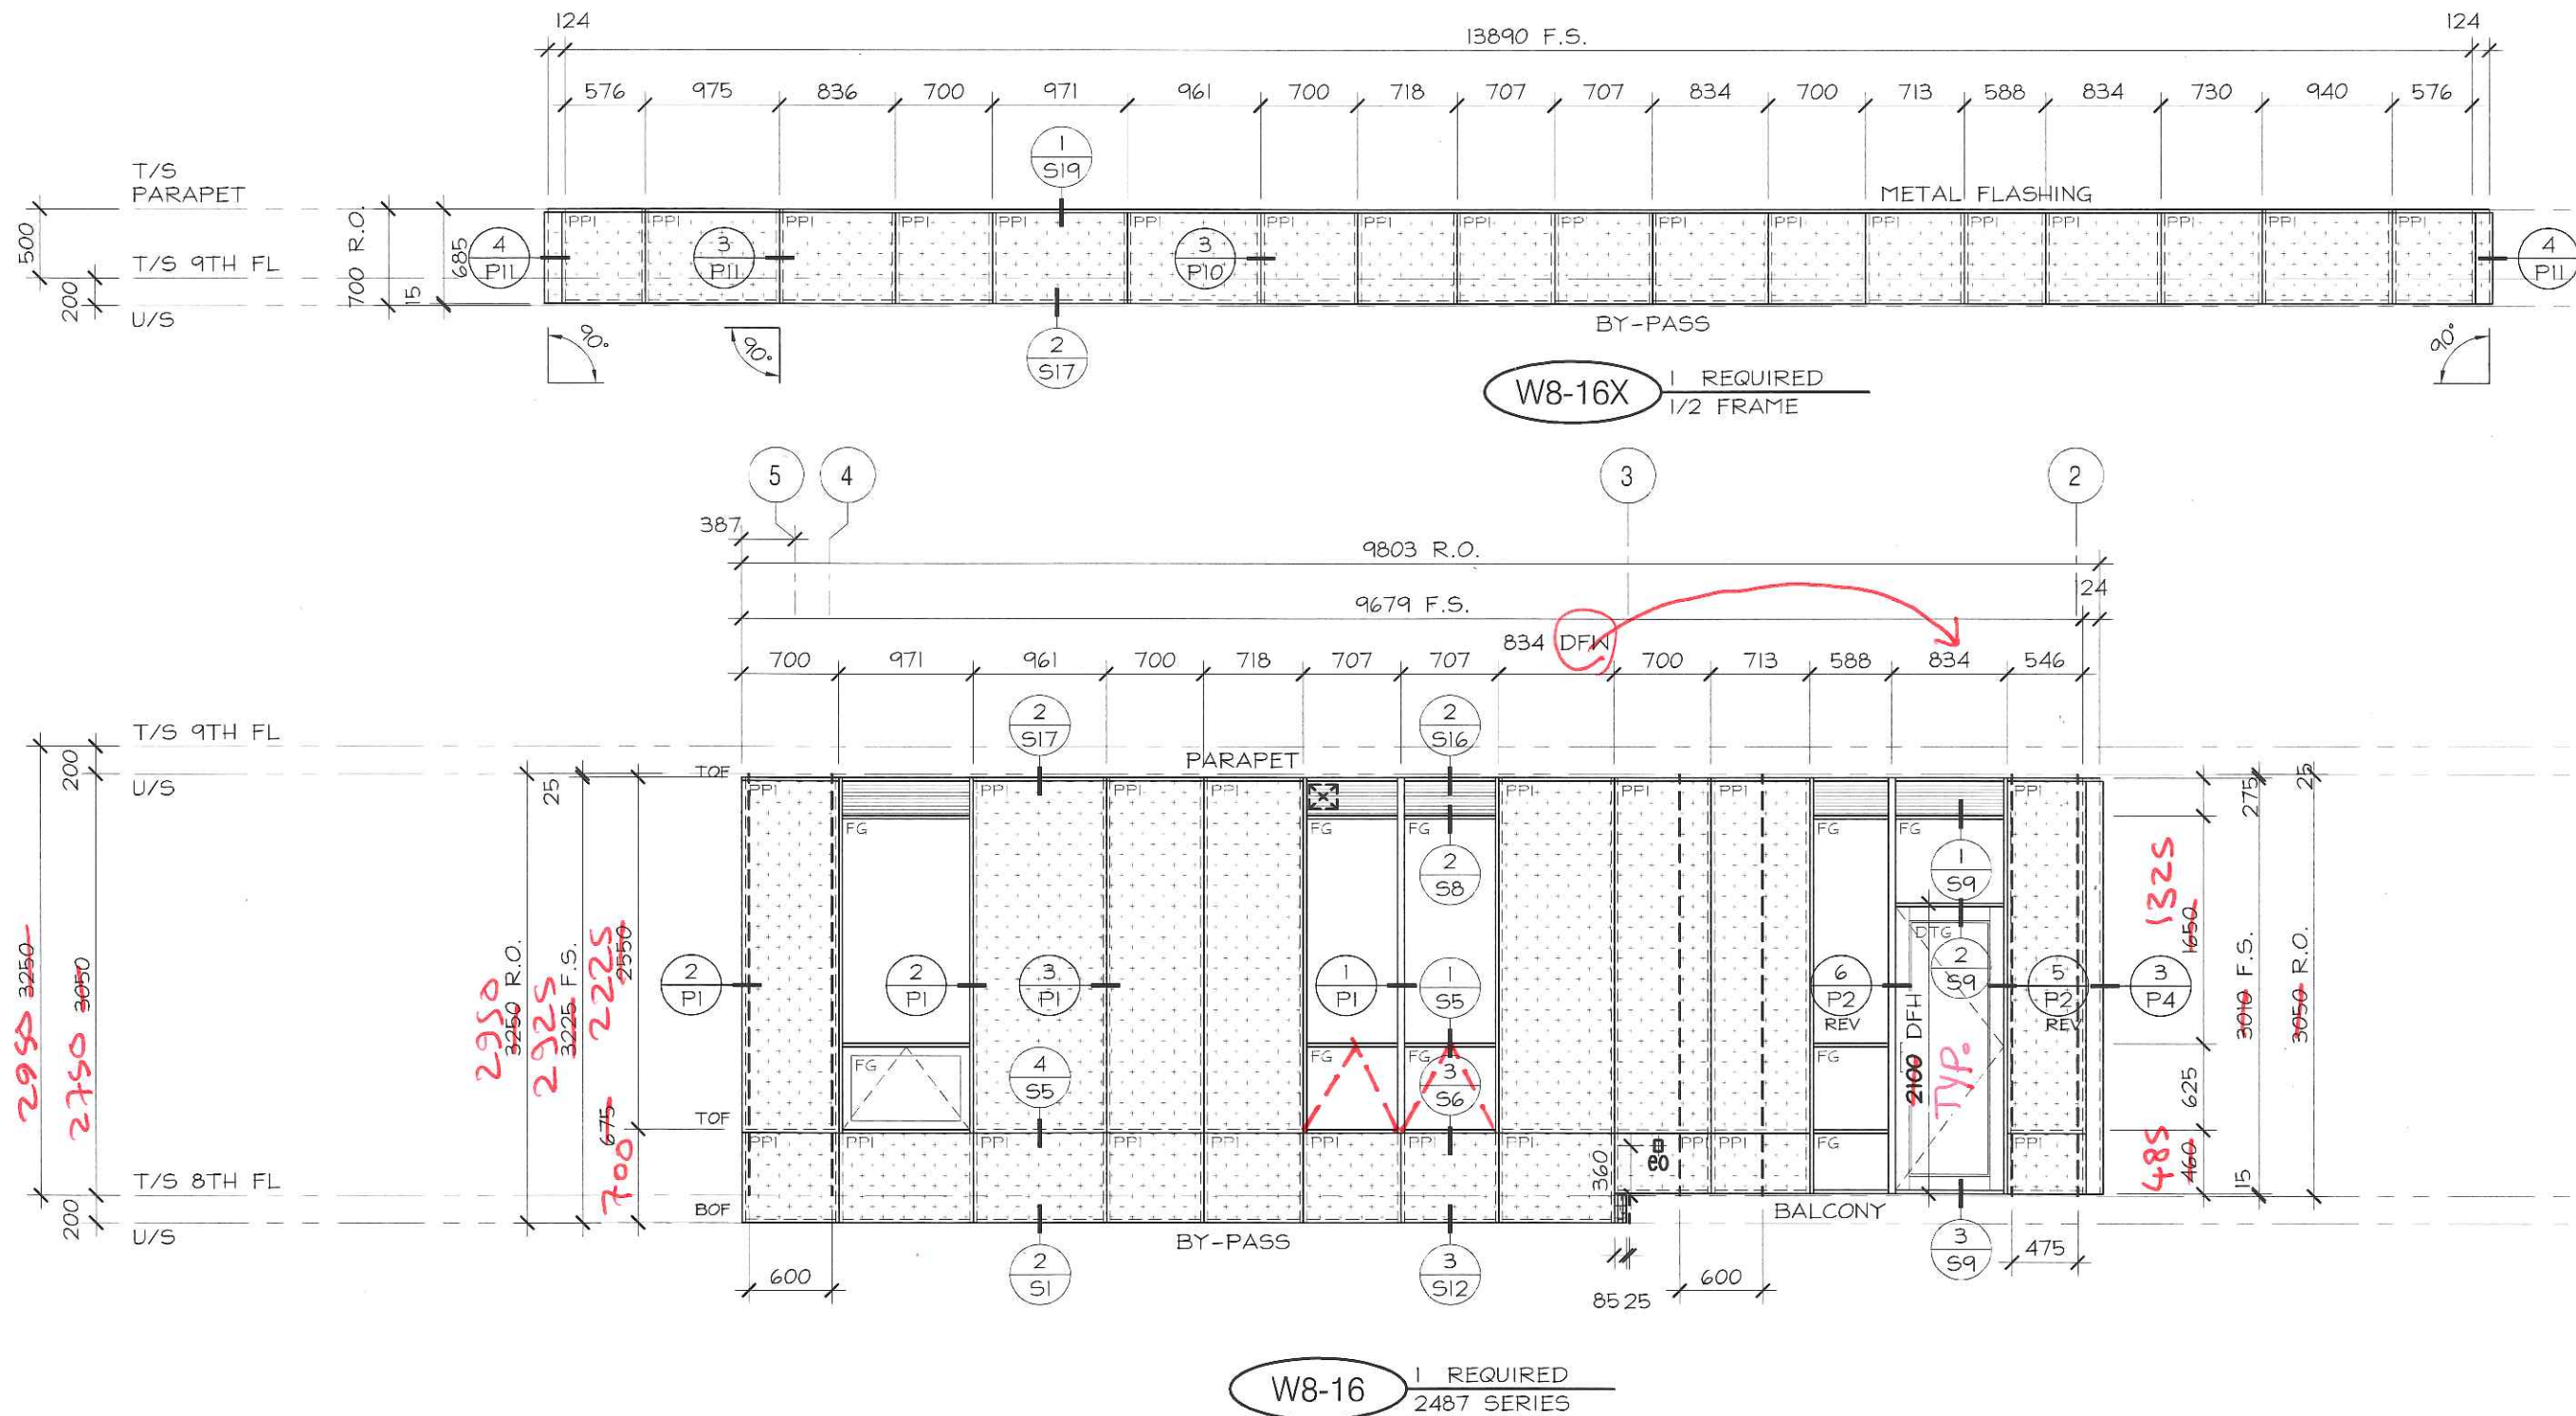


No.	REVISION	BY	DATE

PROJECT NAME:	SQ ALEXANDRA PARK - BLOCK 11		
DRAWING TITLE:	8th FLOOR ELEVATIONS		
ARCHITECT:	TEEPLE ARCHITECTS		
CONTRACTOR:	TRIDEL		
SCALE:	1:50	DRAWN BY:	S.C.
DATE:	MARCH 4, 2015		

DRAWING No.:
E8-16

FOR ALUMINUM BALCONY & TERRACE RAILINGS REFER TO TORO ALUMINUM RAILING SHOP DRAWINGS

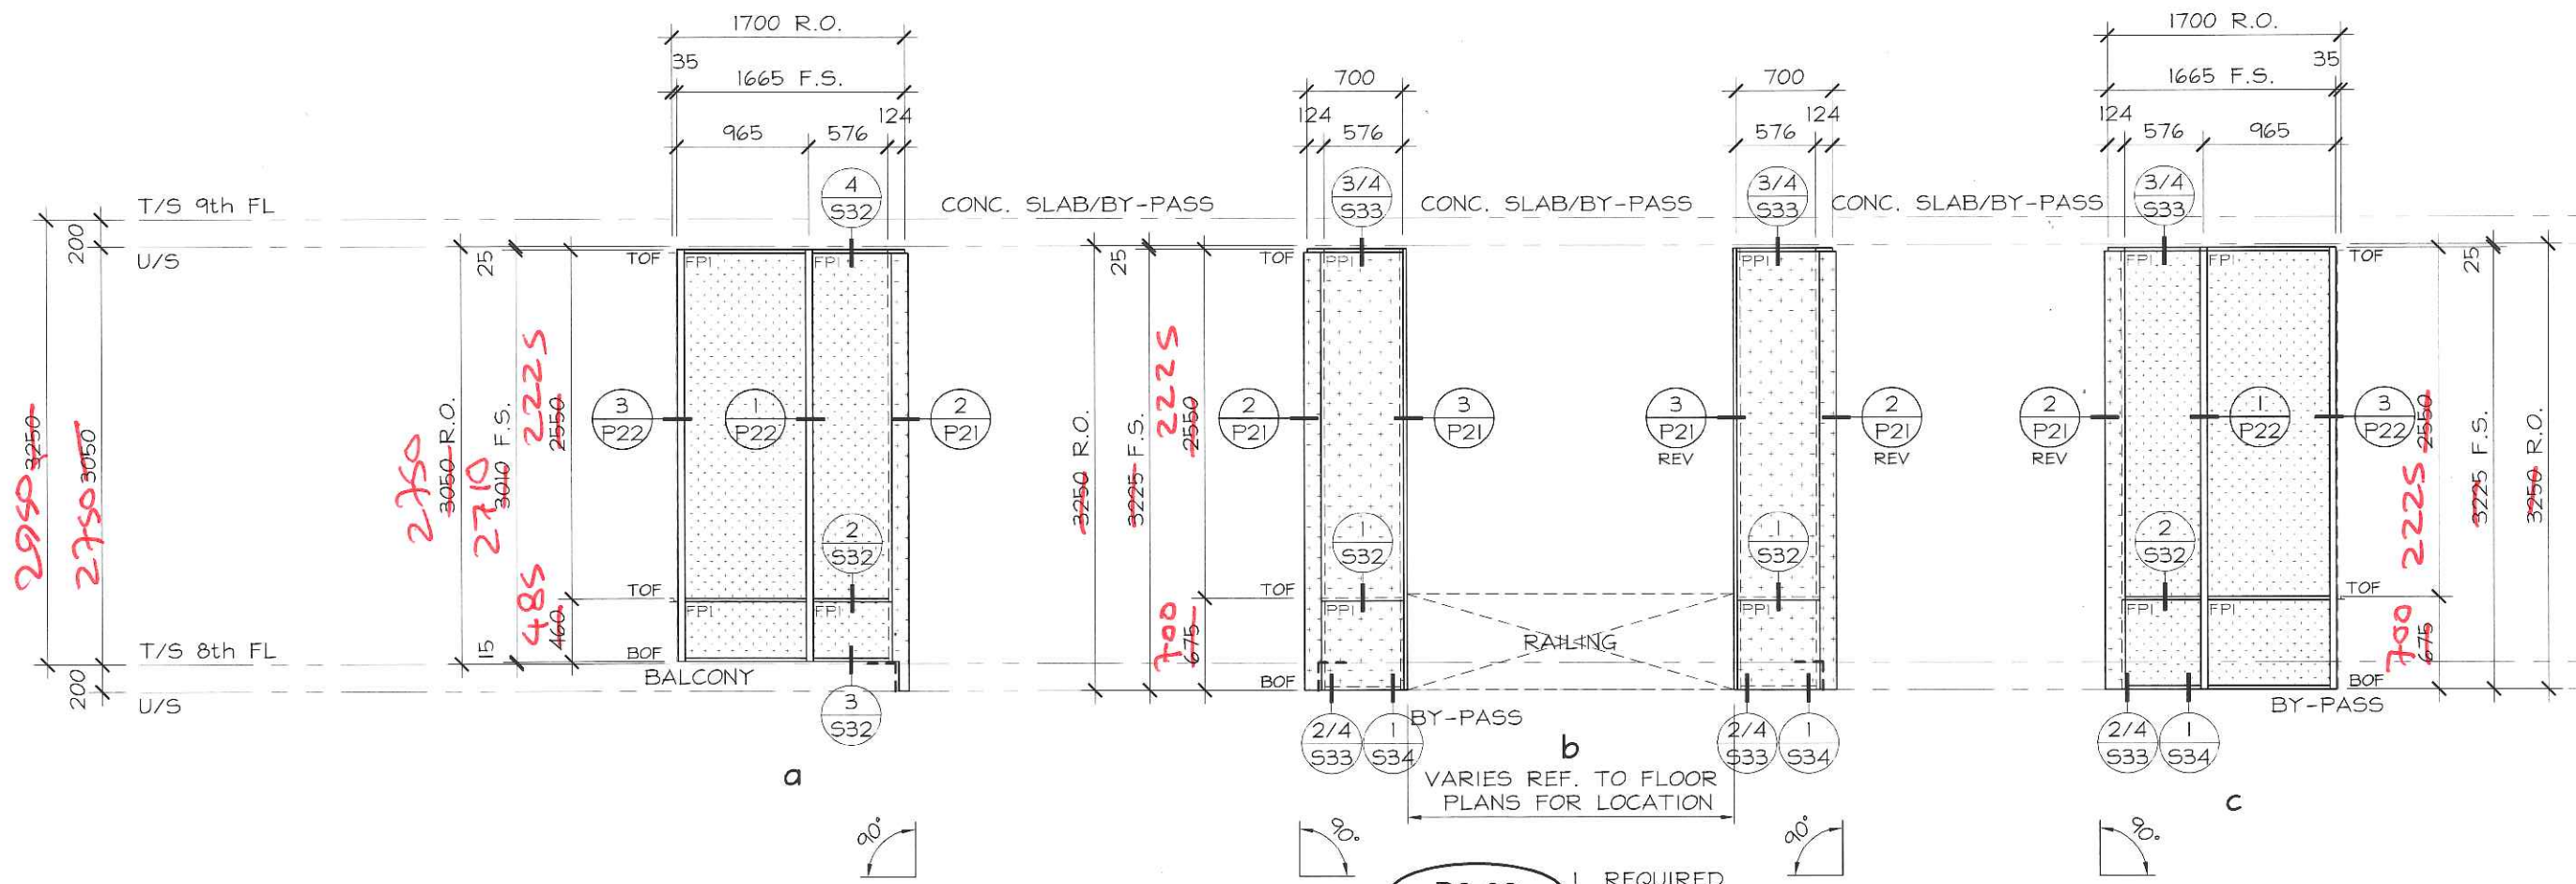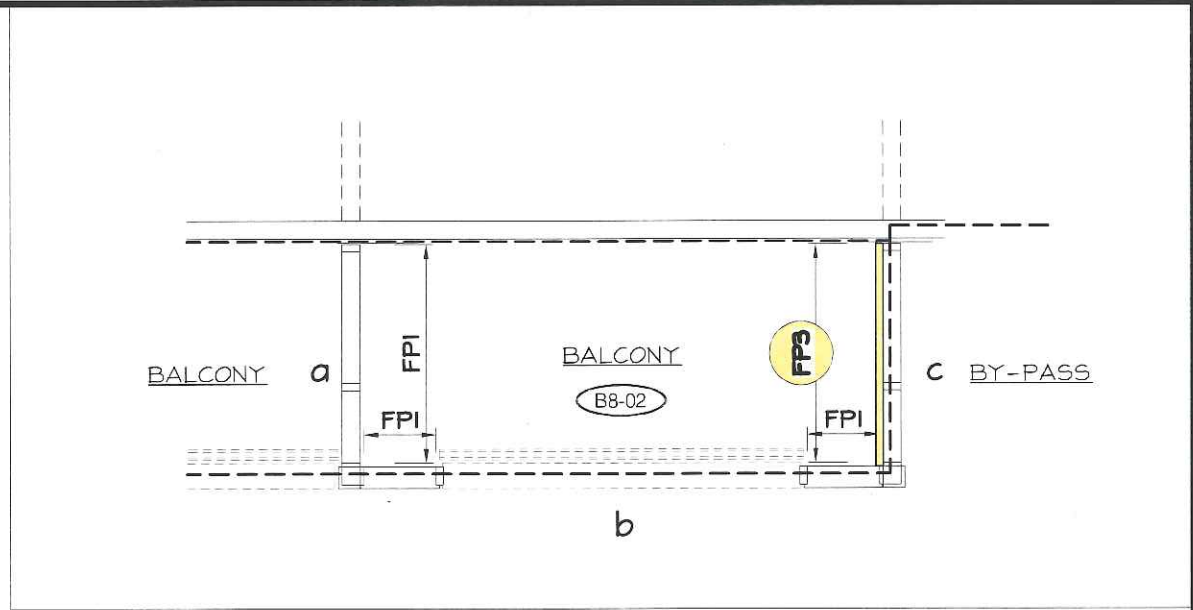



B8-02 1 REQUIRED
 2487 SERIES
 EXT. FINISH: PPG ACRYNAR PLATINUM UCFX11185
 INT. FINISH: PPG ACRYNAR PLATINUM UCFX11185
 C INT. FINISH: PPG ACRYNAR T.B.D.



No.	REVISION	BY	DATE

PROJECT NAME:	SQ ALEXANDRA PARK - BLOCK11		
DRAWING TITLE:	8th FLOOR ELEVATIONS		
ARCHITECT:	TEEPLE ARCHITECTS		DRAWING No.:
CONTRACTOR:	TRIDEL		E8-18
SCALE:	1:50	DRAWN BY:	S.C.
DATE:	MARCH 4, 2015		

FOR ALUMINUM BALCONY
& TERRACE RAILINGS
REFER TO TORO
ALUMINUM RAILING SHOP
DRAWINGS

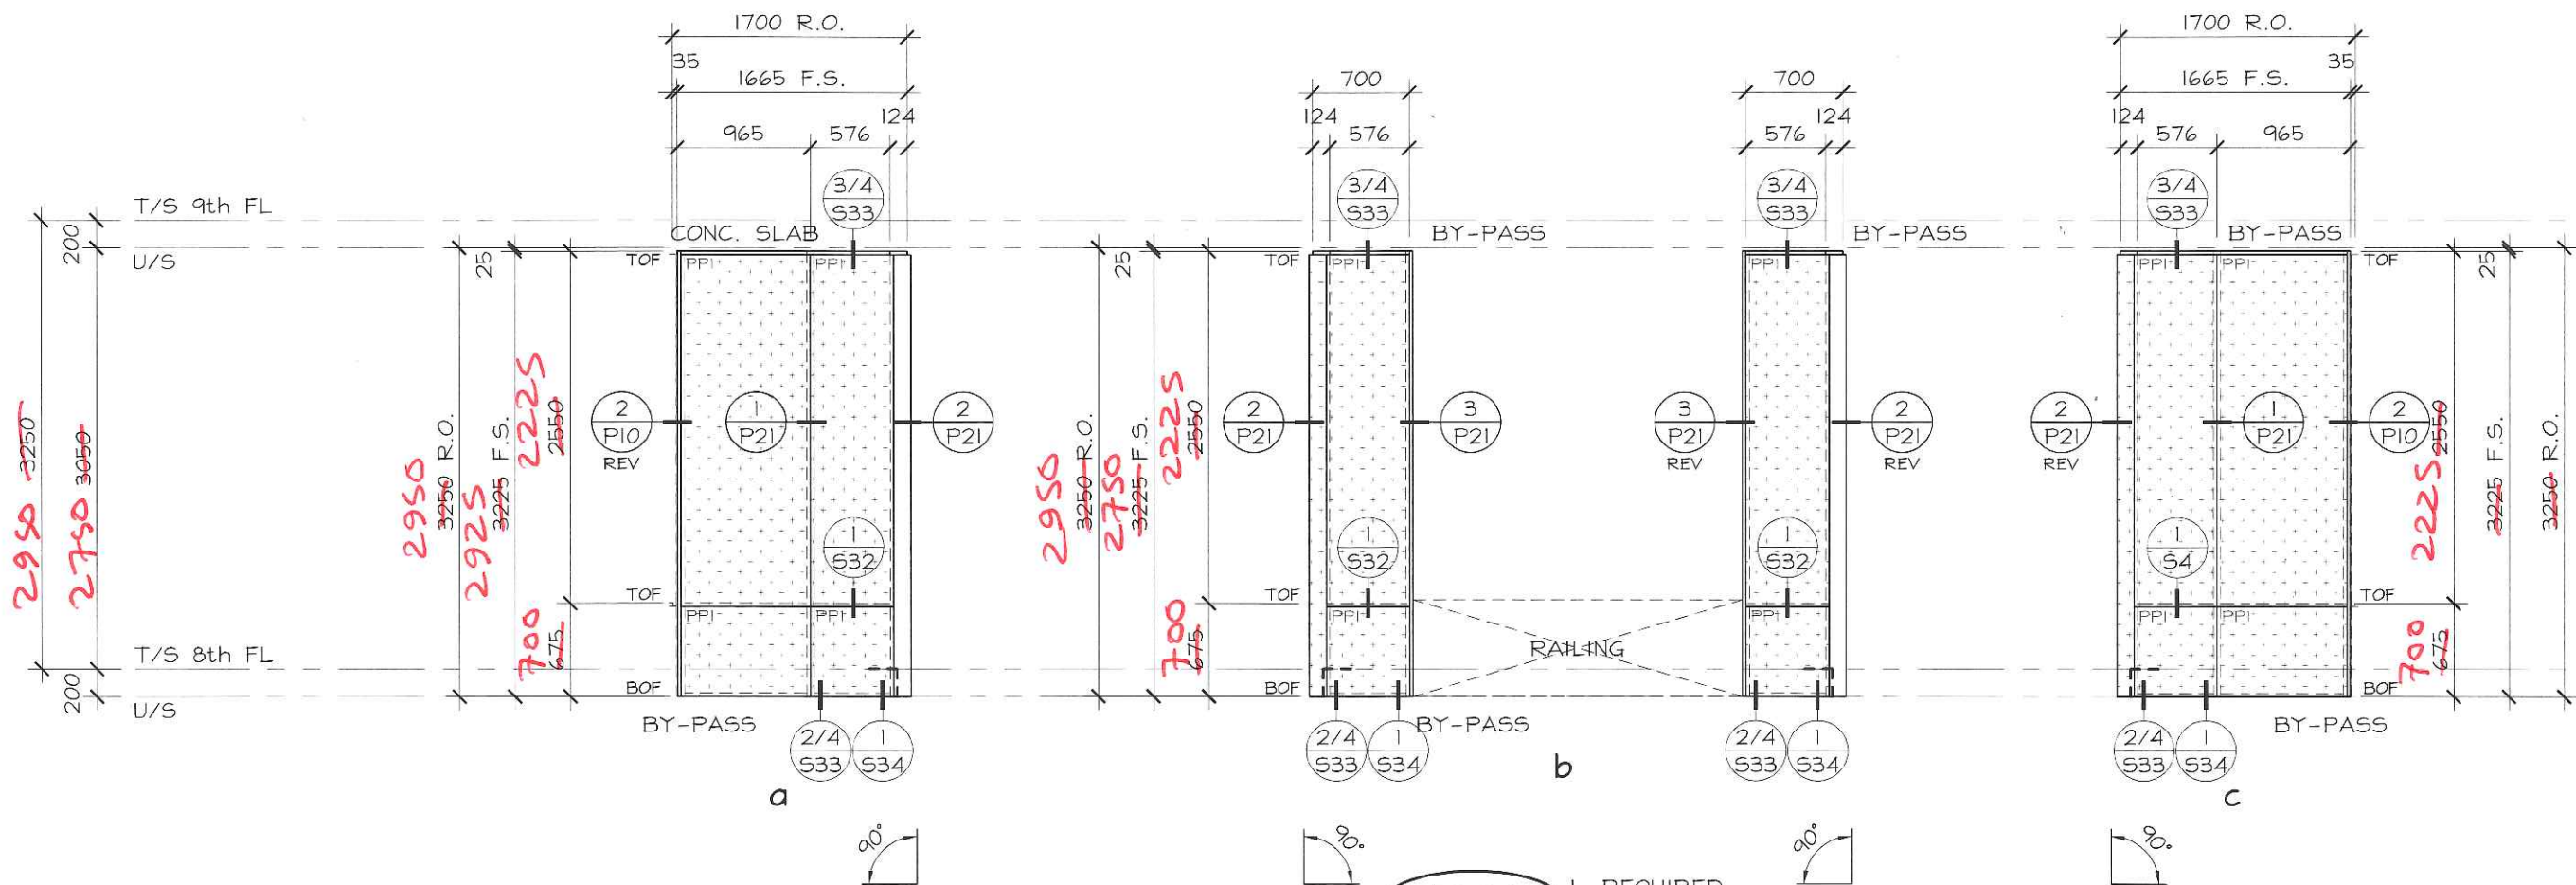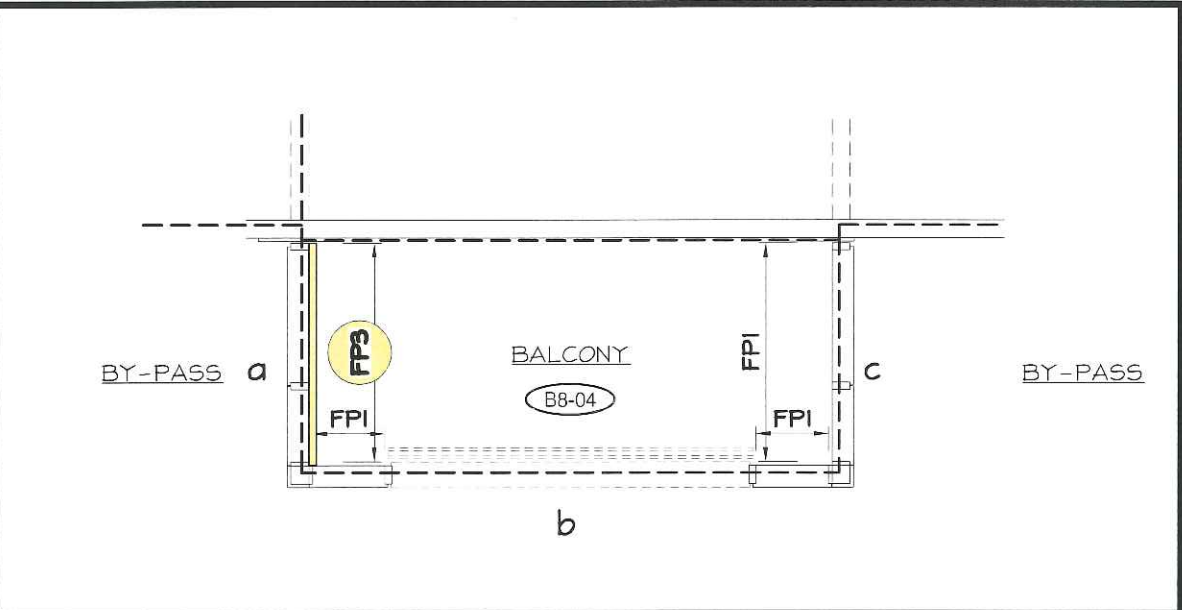



B8-04 1 REQUIRED
2487 SERIES
EXT. FINISH: PPG ACRYNAR PLATINUM UCFXIII85
INT. FINISH: PPG ACRYNAR PLATINUM UCFXIII85
a INT. FINISH: PPG ACRYNAR T.B.D.



No.	REVISION	BY	DATE

PROJECT NAME:	SQ ALEXANDRA PARK - BLOCK11		
DRAWING TITLE:	8th FLOOR ELEVATIONS		
ARCHITECT:	TEEPLE ARCHITECTS		DRAWING No.:
CONTRACTOR:	TRIDEL		E8-20
SCALE:	1:50	DRAWN BY:	S.C.
DATE:		MARCH 4, 2015	

FOR ALUMINUM BALCONY
 & TERRACE RAILINGS
 REFER TO TORO
 ALUMINUM RAILING SHOP
 DRAWINGS

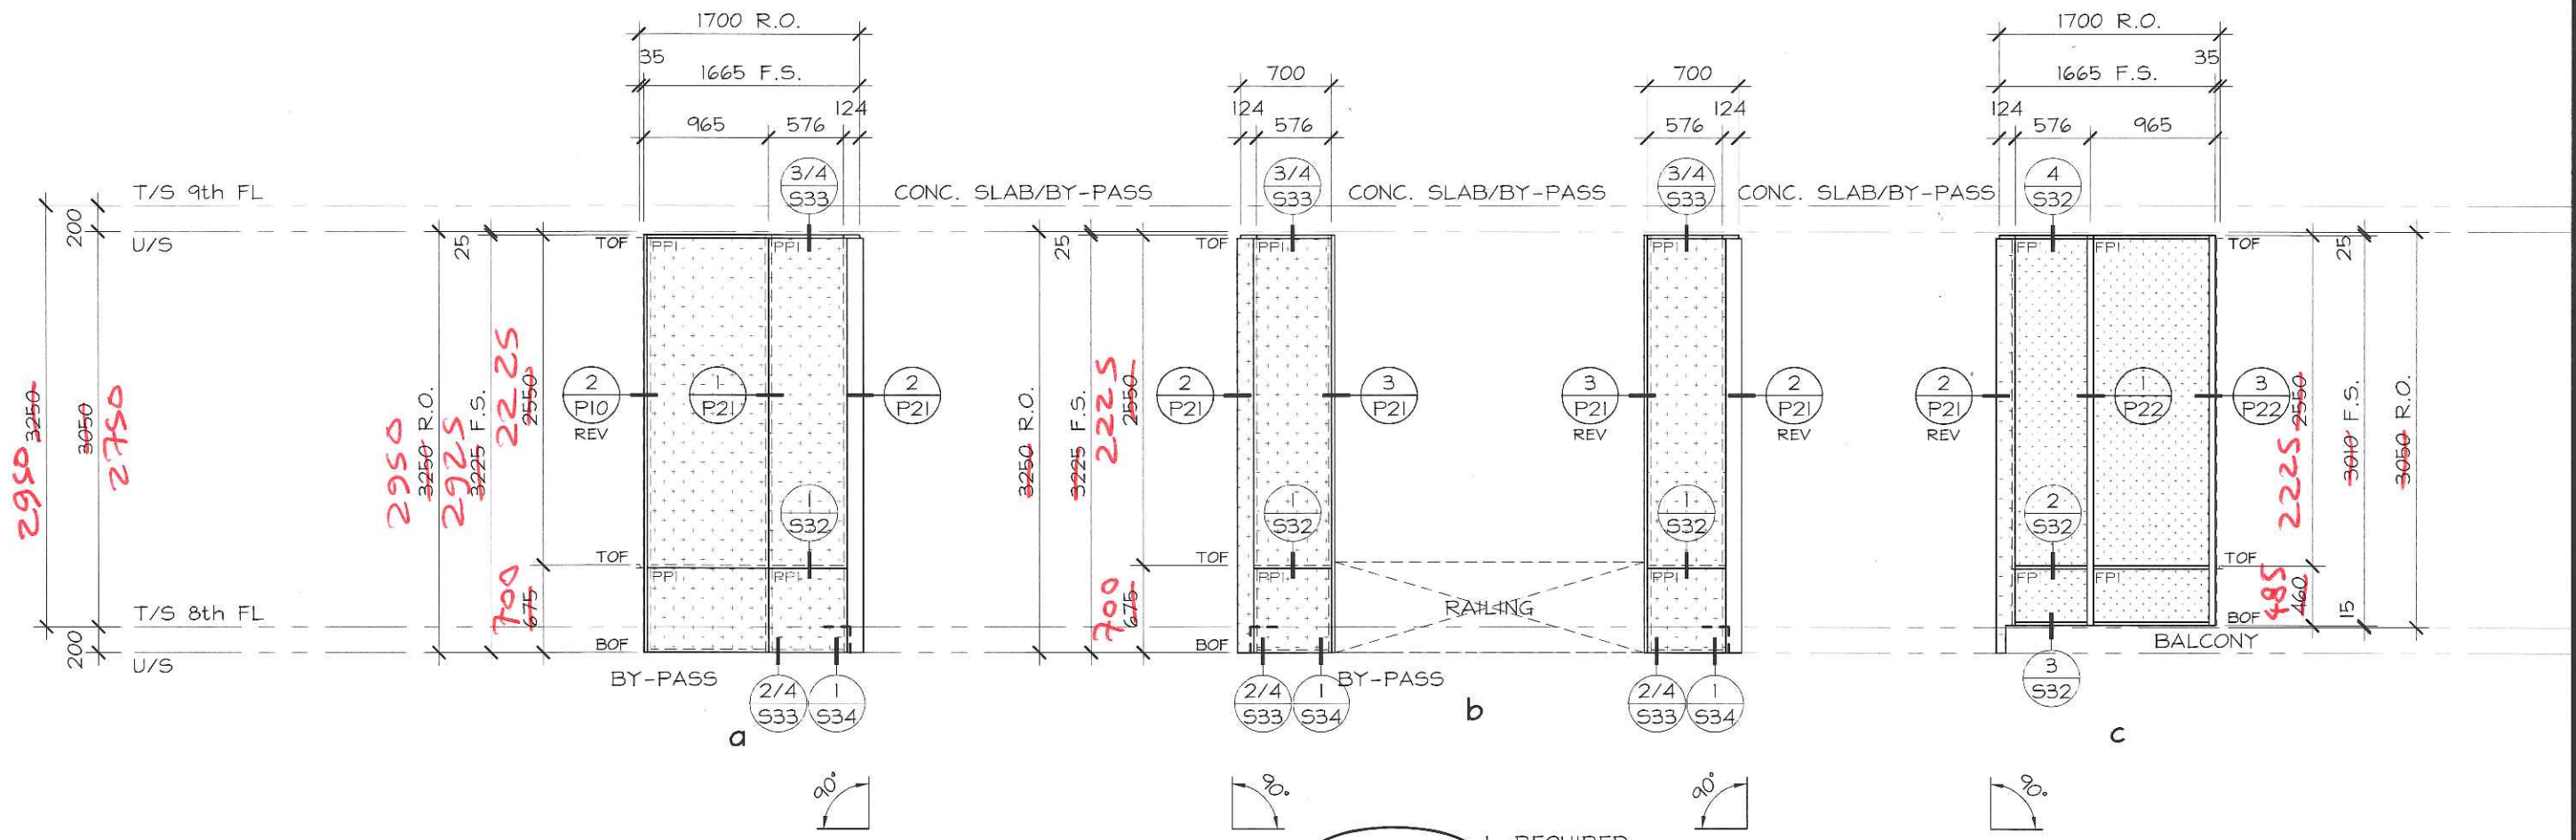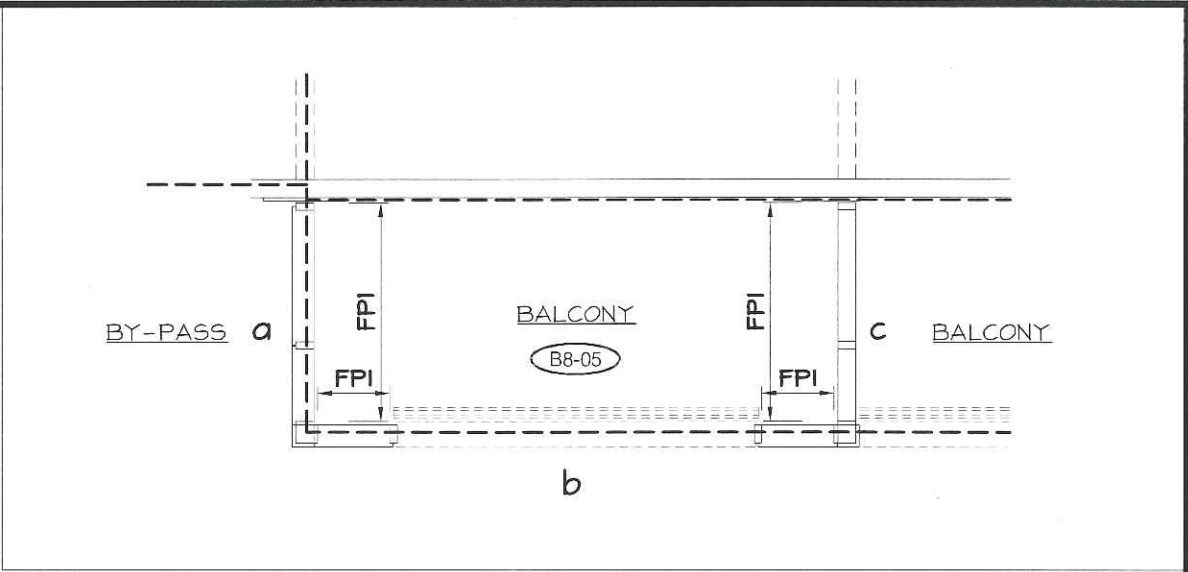

B8-05 1 REQUIRED
 2487 SERIES
 EXT. FINISH: PPG ACRYNAR PLATINUM UCFXIII85
 INT. FINISH: PPG ACRYNAR PLATINUM UCFXIII85



No.	REVISION	BY	DATE

PROJECT NAME:	SQ ALEXANDRA PARK - BLOCK 11		
DRAWING TITLE:	8th FLOOR ELEVATIONS		
ARCHITECT:	TEEPLE ARCHITECTS		
CONTRACTOR:	TRIDEL		
SCALE:	1:50	DRAWN BY:	S.C.
DATE:	MARCH 4, 2015		
DRAWING No.:	E8-21		

