

INDEX

ID0.0.0	COVER SHEET AND INDEX
ID0.0.1	FINISHES SCHEDULE PLUMBING & EQUIPMENT SCHEDULE
ID0.0.2	DOOR SCHEDULE LIGHTING AND ELECTRICAL LEGEND

ID1.0.0	P2 LEVEL PLANS ALL PLANS
ID1.0.1	P1 LEVEL PLANS ALL PLANS
ID1.1.0	1 ST FLOOR CONSTRUCTION PLAN
ID1.1.1	1 ST FLOOR REFLECTED CEILING PLAN
ID1.1.2	1 ST FLOOR FURNITURE & POWER PLAN
ID1.1.3	1 ST FLOOR FLOOR FINISHES PLAN
ID1.1.4	1 ST FLOOR WALL FINISHES PLAN
ID1.1.5	1 ST FLOOR / CORRIDOR ALL PLANS
ID1.1.6	1 ST FLOOR / CORRIDOR WINTER MATTING PLAN
ID1.2.0	2ND FLOOR CONSTRUCTION PLAN & REFLECTED CEILING PLAN
ID1.2.1	2ND FLOOR FLOOR FINISHES PLAN & WALL FINISHES PLAN
ID1.3.0	3RD FLOOR CONSTRUCTION PLAN & REFLECTED CEILING PLAN
ID1.3.1	3RD FLOOR FLOOR FINISHES PLAN & WALL FINISHES PLAN
ID1.4.0	4TH FLOOR CONSTRUCTION PLAN & REFLECTED CEILING PLAN
ID1.4.1	4TH FLOOR FLOOR FINISHES PLAN & WALL FINISHES PLAN

ID1.5.0	5TH FLOOR CONSTRUCTION PLAN & REFLECTED CEILING PLAN
ID1.5.1	5TH FLOOR FLOOR FINISHES PLAN & WALL FINISHES PLAN
ID1.6.0	6TH FLOOR CONSTRUCTION PLAN & REFLECTED CEILING PLAN
ID1.6.1	6TH FLOOR FLOOR FINISHES PLAN & WALL FINISHES PLAN
ID1.7.0	7TH FLOOR CONSTRUCTION PLAN & REFLECTED CEILING PLAN
ID1.7.1	7TH FLOOR FLOOR FINISHES PLAN & WALL FINISHES PLAN
ID1.8.0	8TH FLOOR CONSTRUCTION PLAN & REFLECTED CEILING PLAN
ID1.8.1	8TH FLOOR FLOOR FINISHES PLAN & WALL FINISHES PLAN
ID1.9.0	9TH FLOOR CONSTRUCTION PLAN & REFLECTED CEILING PLAN
ID1.9.1	9TH FLOOR FURNITURE & POWER PLAN FLOOR FINISHES PLAN & WALL FINISHES PLAN
ID1.10.0	10TH FLOOR ALL PLANS
ID1.11.0	11TH FLOOR ALL PLANS
ID1.12.0	12TH FLOOR ALL PLANS
ID1.13.0	13TH FLOOR ALL PLANS
ID1.14.0	14TH FLOOR ALL PLANS

ID2.0.0	ELEVATIONS
ID2.0.1	ELEVATIONS
ID2.0.2	ELEVATIONS
ID2.1.0	ELEVATIONS
ID2.1.1	ELEVATIONS
ID2.1.2	ELEVATIONS
ID2.1.3	ELEVATIONS
ID2.1.4	ELEVATIONS
ID2.1.5	ELEVATIONS
ID2.1.6	ELEVATIONS
ID2.1.7	ELEVATIONS
ID2.1.8	ELEVATIONS
ID2.1.9	ELEVATIONS
ID2.1.10	ELEVATIONS
ID2.1.11	ELEVATIONS
ID2.2.0	ELEVATIONS
ID2.3.0	ELEVATIONS
ID2.4.0	DOOR ELEVATIONS
ID2.4.1	DOOR ELEVATIONS
ID2.5.0	ELEVATOR CAB & GARBAGE CHUTE PLANS, ELEVATIONS & DETAILS
ID3.0.0	SECTION DETAILS
ID3.1.0	CEILING DETAILS
ID3.1.1	CEILING DETAILS
ID3.2.0	WALL SECTIONS
ID3.2.1	WALL SECTIONS

ID4.0.0	MILLWORK
ID4.1.0	MILLWORK
ID4.2.0	MILLWORK
ID5.0.0	TYPICAL DETAILS


ALEXANDRA PARK
MAIN BUILDING BLOCK 11

ISSUED FOR
AS-BUILT

DO NOT SCALE DRAWINGS.
CONTRACTOR MUST VERIFY ALL DRAWINGS, DIMENSIONS, DETAILS AND SPECIFICATIONS AND REPORT ANY DISCREPANCIES TO UNION 31 INC. BEFORE PROCEEDING WITH WORK. MATERIALS MAY NOT BE SUBSTITUTED WITHOUT WRITTEN APPROVAL FROM UNION 31 INC.
ALL DRAWINGS AND SPECIFICATIONS ARE INSTRUMENTS OF SERVICE AND THE PROPERTY OF UNION 31 INC. WHICH MUST BE RETURNED AT THE COMPLETION OF THE WORK.

PRINTED: 30-M8-17

01	31 MAY / 17	ISSUED FOR AS-BUILT	SV
NO.	DATE	COMMENTS	INI
REVISIONS:			

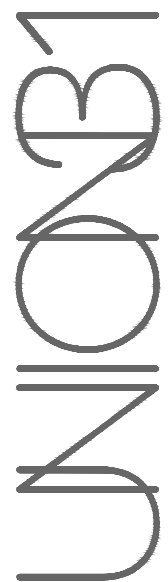

UNION31 INC.
183 BATHURST STREET, STE. 201
TORONTO, ON, M5T 2R7, CANADA
TEL: 416-597-1576 FAX: 416-597-2139

PROJECT NAME: ALEXANDRA PARK MAIN BUILDING BLOCK 11 ON, Canada	
PROJECT NO.:	13-949
DRAWING'S: INDEX	
DATE STARTED:	07 AUG / 13
SCALE:	NTS
DRAWN BY:	AP
APPROVED BY:	KC
DRAWING NO.:	ID 0.0.0

ACTION1	Corridor Ceiling Tile CGC Perforated Acoustic Tiles, 4 ft x 6 ft, acoustically treated, red edge FLB, laminated design. MST Co. Contractor: Craggs Interiors Ltd., 2nd x 3rd Floor, Supplier: CGC
BASE #1	100mm Tile Base
BASE #2	100mm MDF Applied Base
BASE #3	100mm MDF Flush Base
BASE #4	75mm Tile Base
BASE #5	100mm Tile base w/ Tile Trim #1
BASE #6	100mm Metal Base
BASE #7	100mm Recessed Base for Tile #11
BASE #8	50mm Cove Base Tile & Series: Painted Glass Ceiling Installation
CARPET#1	(Prog Management Office) Carpet Tile, Stack 9 #04332, Colour: Luminous #75001, 24"x24" Unidirectional Installation, 100% Dyed Supplier: Tandus Flooring Contact: Thomas Jackson 116-768-9339
CARPET#2	(Theatre) Branded Carpet: Dais Seafoam 40036, Carpet Back Material: 01862, 12' 6" 381 Dimensions, Dyed Supplier: Tandus Flooring
CARPET#3	(Corridors, Typical) Branded Carpet: Trail 44053, Carpet Lead Mar: 01910, 100 % Stain Resistant Supplier: Tandus Flooring
CARPET#4	(Corridors, Typical Accents) Branded Carpet: Aida 51050, Carpet Orientation: 00809, 100 % Stain Resistant Supplier: Tandus Flooring
GLASS#1	N/A
GLASS#2	(Lobby, Wall Paneling) 1/4" or thickness as required, Black painted glass, star-fire, tempered. Contractor to provide sample of decorative lead applied pattern for approval. Referred to contractor. Supplier: NGI Designer Glass
GLASS#3	(Dining Room/Party Room) 1/4" or thickness as required, NGMB Bronze Silk, star-fire, tempered. Contractor to provide sample of decorative lead applied pattern for approval. Referred to contractor. Supplier: NGI Designer Glass
GLASS#4	(Lobby Fireplace Wall) 1/4" or thickness as required, NGM Black Mirror, star-fire, tempered. Contractor to provide sample of decorative lead applied pattern for approval. Referred to contractor. Supplier: NGI Designer Glass
GLASS#5	(Whirlpool-glass wall into gym, glass doors) 1/2" or thick as required frosted glass. Supplier: Toro Aluminum
HARWOOD#1	(Party Room) Kentwood Originals, 7.5" wide, engineered plank floor Contractor: Sher Cree Random pattern installation, directionless. Supplier: Metropolitan Hardwood Floors
HARWOOD#2	N/A
MELAMINE #1	(Amenity Kitchen) Lightweight Resin W/ Stainless Steel - LW-3078 if approved alternative Contractor provide sample of decorative lead applied pattern for approval. Referred to contractor. Supplier: By Kitchen Manufacturer/Living Art Contact: Paris Kitchens
METAL #1	Balanced Space Selections - Engineered Partition Referred to contractor. Supplier: By Millwork Option 3 Display Contact: Form Novuo Tony Brkich 416-258-9711
METAL #2	(Party Room Divider Screen) Screen selection: metal frame, 18-20 gauge. Referred to contractor. Supplier: Sunblet Contact: 800-999-2645
METAL #3	(Party Room Bar Table) Branded Space Case 325 Salar Brass, all elements finished partition Contractor provide sample of decorative lead applied pattern for approval. Referred to contractor. Laminated, Italian Resin Top Supplier: Local Construction Inc. Contact: Lucia Niu 905-660-0410
METAL #4	(Fitness Room - Glazing Shoe) Safety Glazed Standard Pattern Supplier: Glazing Supplier
METAL #5	(Interphone, Metal Shroud @ sinks, Elevator Cabs, P1 and 14th Floor Elevator Doors/Metals) Sample Selections referred. Supplier: Milwark
METAL #6	(Throughout, Elevator Doors and Frame on Grd Flr) XL B&H Marine Sample Selection Supplier: Form Novuo
MIRROR#1	N/A
MIRROR#2	(Fitness) 1/4" or thickness as required, clear mirror, tempered. Contractor to provide sample for designer approval and appropriate pattern for approval. Referred to contractor. Supplier: NGI Designer Glass
PEDIMAT#1	(All Vestibules) Contractor Specify Grid No G6. Installations LEED registered contractor with plans in accordance with code. Supplier: Construction Specialties
PAINT#1	(General Walls, Throughout) Contractor Specify: 50YR 63/041, asex, eliminate glare and eliminate stains. Referred to contractor and appropriate pattern for approval. Supplier: Dulux
PAINT #2	(Ceiling, Throughout) Contractor Specify: 100N 83/000, asex, eliminate. Referred to contractor and appropriate pattern for approval. Supplier: Dulux
PAINT #3	(P Mgmt Office Wall and Base) Paint: Deliner Grey: 50YR 63/041, asex, eliminate glare and eliminate stains. Referred to contractor and appropriate pattern for approval. Supplier: Dulux
PAINT #4	(Parking Level Elevator Doors and Frames) Paint: Fire Base: 20YR 10/038, asex, eliminate glare and eliminate stains. Referred to contractor and appropriate pattern for approval. Supplier: Dulux
PAINT #5	(Party Room Base) Paint: Sin Precise: 100N 83/000, asex, eliminate. Referred to contractor and appropriate pattern for approval. Supplier: Dulux
PAINT #6	(Theatre Base) Paint: Ocean Gray: 100N 13/000, asex, eliminate. Referred to contractor and appropriate pattern for approval. Supplier: Dulux
PAINT #7	(Dining Room - Wall and Base) Paint: Men and Sin: 30YR 20/025, asex, eliminate glare and eliminate stains. Referred to contractor and appropriate pattern for approval. Supplier: Dulux
PAINT #8	(Changeroom Water Closet Walls) Paint: Ocean Gray: 50YR 49/036, asex, eliminate. Referred to contractor and appropriate pattern for approval.

[illegible]

	(Kitchen Flooring) 24'x24" porcelain tile, Metal Gloss, Steel Wool, #MAR0346RMFLQ2, grout TBD. Install as per manufacturer's instructions. Refer to drawing for details. Supplier: Mary Kourou Contact: Keith Davours 905.789.3756 x2544
TILE #7	N/A
TILE #8	(Mail Room Flooring) 60x120" prefinished, Silestone Prime Grey, Falds Natural, 60x120, polished, finished TBO. Refer to drawing for details. Refer to drawing for details. Supplier: Stone Tile
TILE #9	(Prog Management Kitchen/Adm) Porcelain tile, Versus, Ice Natural #VEIC1224, 12"x24", grout colour TBD. Installation: per manufacturer's instructions. Refer to drawing for details. Supplier: Centura
TILE #10	(Whirlpool Room Flooring) Refer to Table 3 Supplier: Stone Tile
TILE #11	(Lobby Recessed Base) Unfinished Silestone Prime Black BY UN BLK1224, polished per manufacturer's instructions. Refer to drawing for details. Supplier: Olympia Tile
TILE #12	(Changerooms, Showers) Mosaic tile, Quebec, Dark Grey FS, 2"x2", unglazed, #QD.CC.STR.022.FS Refer to drawing for details. Supplier: Olympia Tile
TILE #13	(P Level Elevator Lobby Wall) 12x24" porcelain tile, Montecarlo Matte, vein cut, Grey, natural finish, #2S.MG.GRY.1224, polished, finished TBO. Installation: per manufacturer's instructions. Refer to drawing for details. Supplier: Olympia Tile
TILE #14	(P Level Elevator Lobby Flooring) 12x24" porcelain tile, Evolve Night Black #WAVE.NHT.1224, grout colour TBD. Install as per manufacturer's instructions. Refer to drawing for details. Supplier: Olympia Tile
TILE #15	(Staff WC Whirlpool Room) 12x24" porcelain tile, Evolve, Colour: Night (Black), natural finish, #WAVE.NHT.1224, grout colour TBD. Installation: per manufacturer's instructions. Refer to drawing for details. Supplier: Olympia Tile
TILE #15a	(Staff WC Changeroom Cove Base) Unfinished Silestone Prime Black BY UN BLK1224, polished per manufacturer's instructions. Refer to drawing for details. Supplier: Olympia Tile
TILE #16	(Whirlpool Room Floor) 150x90" prefinished, Silestone Prime Grey, Falds Natural, 150x90, polished, finished TBO. Installation: per manufacturer's instructions. Refer to drawing for details. Supplier: Stone Tile
TILE #17	(Elevator Lobby Wall Ground Floor) Unfinished Silestone Prime Black BY UN BLK1224, polished per manufacturer's instructions. Refer to drawing for details. Supplier: Stone Tile
TILE #18	(Type Corridor Wall @ Elevator) 150x90" prefinished, Silestone Prime Grey, Falds Natural, 150x90, polished, finished TBO. Installation: per manufacturer's instructions. Refer to drawing for details. Supplier: Stone Tile
TILE #19	(Public Barrier Free Washroom Walls) 3'x10' ceramic tile, Liverpool, Col: Portland, glossy grout TBD. Install as per manufacturer's instructions. Refer to drawing for details. Refer to drawing for details. Supplier: Cera Gres Contact: Jessica Carlo 416.286.3553
TILE #20	(Changeroom - Cove Base) Unfinished Silestone Prime Black BY UN BLK1224, polished per manufacturer's instructions. Refer to drawing for details. Supplier: Olympia Tile
TILE #21	(Barrier Free Washroom Mural) Black (30" x 10") x 10", Silestone Prime Grey, Falds Natural, 30" x 10", polished, finished TBO. Installation: per manufacturer's instructions. Refer to drawing for details. Refer to drawing for details. Supplier: Stone Tile Stone Tile
TILE #22	(Garbage Room Floor) 30" x 60" prefinished porcelain tile, Quebec Series, Col: black Refer to drawing for details. Refer to drawing for details. Supplier: Olympia
TILE #23	(Garbage Room Walls) 300" x 600" prefinished porcelain tile, Evolve Natural, Grout: Falds, Col: black. Installation: per manufacturer's instructions. Refer to drawing for details. Refer to drawing for details. Supplier: Ciot
TILE #24	(Ground Fr Interior Whirlpool) 11'x11' unglazed porcelain tile, Quebec Series, Col: black Refer to drawing for details. Refer to drawing for details. Supplier: Olympia Tile
TILE #25	(Ground Fr Interior Whirlpool Nosing) 11'x11' unglazed porcelain tile, Quebec Series, Col: arctic white Refer to drawing for details. Refer to drawing for details. Supplier: Olympia Tile
TILE #26	(Ground Fr Fitness Wall Tile) 2'x8" glazed ceramic tile, Colour and Dimension Series, Col: arctic white Refer to drawing for details. Refer to drawing for details. Supplier: Olympia Tile
TILE TRIM #1	(Exposed Wall Tile Edges) Silestone Prime, Branded Nosing, 6" x 6" x 1/2"
TILE TRIM #2	(Laminates to Laminates) Silestone Prime, Branded Nosing, 6" x 6" x 1/2"
WALLCOVERING #1 (Corridors)	Vinyl Wallcovering, C-Series, Type II, prefinished, installed in Velux 05-16, per 766.12, Refer to drawing for details. Refer to drawing for details. Supplier: Metro Wallcovering Contact: Charley Binder 905.738.7461
WALLCOVERING #2 (P Level Elevator Lobby)	Vinyl Wallcovering, C-Series, Type II, prefinished, installed in Velux 05-16, per 776.09, Refer to drawing for details. Refer to drawing for details. Supplier: Metro Wallcovering
WALLCOVERING #3 (Party Room)	Vinyl Wallcovering, Versum 05 Tessera 770.11, 52" wide, 2002, Type II, Class A, Refer to wallcovering and installation details. Supplier: Metro Wallcovering
WALLCOVERING #4 (Dining Room Accent)	Canvas Wallcovering, 24" x 36" x 1/2", sealed, textured and prefinished, Type II, Class A, Refer to wallcovering and installation details. Supplier: Metro Wallcovering
WALLCOVERING #5 (Amenity Dining Room & Kitchen)	Vinyl Wallcovering, Korsoral, Mortage, Café Noir 8721-85, 54" wide, Type II, Class A, Refer to wallcovering and installation details. Supplier: Metro Wallcovering
WALLCOVERING #6 (Theatre)	Vinyl Wallcovering, Colour and Design, Obama Grid, C2C-042-45, Black/Mica, 54" wide, Type II, Class A, Refer to wallcovering and installation details. Supplier: Metro Wallcovering
WALLCOVERING #7 (Dr Floor Public Spaces)	Refer to Wallcovering 13.
WALLCOVERING #8 (Dr Floor Fitness)	

[illegible][illegible][illegible]

E1 - INTEGRAL SOAP DISPENSER	Parlour Senn Engineering Co. C/O Lerla E. E. O'Brien Revised 2/25/900 Supplier: Senn Engineering
E2 - TOWEL DISPENSER	Parlour Borden Graef Integrated Paper Products B-43699, Jane Doe Supplier: C/O de Dittler and Lardare
E3 - TOILET TISSUE DISPENSER	Parlour Borden Graef Integrated Paper Products B-2888 and related B-3888, Jane Doe Supplier: C/O de Dittler and Lardare
E4 - FEMININE NAPKIN DISPOSAL	Parlour Borden Graef Integrated Paper Products B-353, Jane Doe Supplier: C/O de Dittler and Lardare
E5 - GRAB BARS	Parlour Borden Graef Integrated Paper Products B-5898, B-5806, Lerla E. E. O'Brien Supplier: C/O de Dittler and Lardare
E6 - HOOK	Parlour Borden Graef Integrated Paper Products B-6717, Jane Doe Supplier: C/O de Dittler and Lardare
E7 - MAILBOXES	Mailboxes Rope de 4500-D192, rear add-on Supplier: Rope C/n/a Order de 1-514-934-0385
E8 - FRIDGE	Parlour Kitchen 24" integrated refrigerator, Blomberg BFRB 1050 FFBI. Supplier: Appan e Canada C/n/a John O'Brien 905-660-2424
E9 - DISHWASHER	Parlour Kitchen 24" fully integrated dishwasher, Blomberg DBS100. Supplier: Appan e Canada
E10 - MICROWAVE	Parlour Kitchen Panasonic NN ST7655 Supplier: Appan e Canada
E11 - INTERPHONE	Bell Bell
E12 - LOCKERS	Hadrin "Emperor" Locker System, double tier, 72" high x 12" wide x 12" deep, Dile 628 Supplier: Hadrin C/n/a Order De 1-905-333-0300
E13 - WATER FOUNTAIN	Exercise Rite Reiter P14 Reiter
E14	N/A
E15 - TV	Dinn-Rite 46" Brite
E16 - TV	Barr 46" TV mounted behind mirrored wall paneling. TBD
E17 - TV	Parlour 65", by client
E18 - B.F. Mirror	B.F. Barr Borden B293 1836, fixed position mirror Supplier: C/O de Dittler and Lardare
E19 - TBD	
E20 - Paper Mania	O'Brien Borden
E24 - Warmer Drawer	Kitchen Porter and Charles WD60-14 24" stainless steel warming drawer, 5.5" high Supplier: Appan e Canada
E25 - Warmer Drawer	Kitchen Porter and Charles WD60-21 24" stainless steel warming drawer, 8.2" high Supplier: Appan e Canada
E26 - Electric Frepa	Dinn-Rite Dimplex LXLF50
E27 - Wrapping	Carter Carter Creative Wrapping Service, paper products per package Supplier: Adan e Carter's Entertainment and Spa
E28 - WALL MNT SOAP DISPENSER	P1 and 9 Borden Commercial Washers, GF Men & Women, BF Supplier: C/O de Dittler and Lardare
E29 - UNDER COUNTER FRIDGE	Prep Mania Bar Area Panel ready - 24" under counter fridge, Marvel ML24BRF3LP, handing as received. Supplier: Appan e Canada
E30 - ELEC FIREPLACE	IL Dimplex LXLF100
E31 - COUNTER SOAP DISPENSER	Ground Floor Washroom / Canteen Borden Mde B-8263


MUST BE RETURNED AT THE COMPLETION OF THE WORK.

31 MAY / 17	ISSUED FOR AS-BUILT	S
DATE	COMMENTS	IN


REVISIONS:

PROJECT NAME:	
ALEXANDRA PARK MAIN BUILDING	
BLOCK 11 ON, Canada	
PROJECT NO.:	13-949
DRAWING/S:	
FINISHES SCHEDULE PLUMBING & EQUIPMENT SCHEDULE	
DATE STARTED:	07 AUG / 13
SCALE:	NTS
DRAWN BY:	AP
APPROVED BY:	KC
DRAWING NO.:	ID 0.0.1


DATE STARTED: 07 AUG / 13	DRAWING NO.: ID 0.0.1
SCALE: NTS	
DRAWN BY: AP	
APPROVED BY: KC	

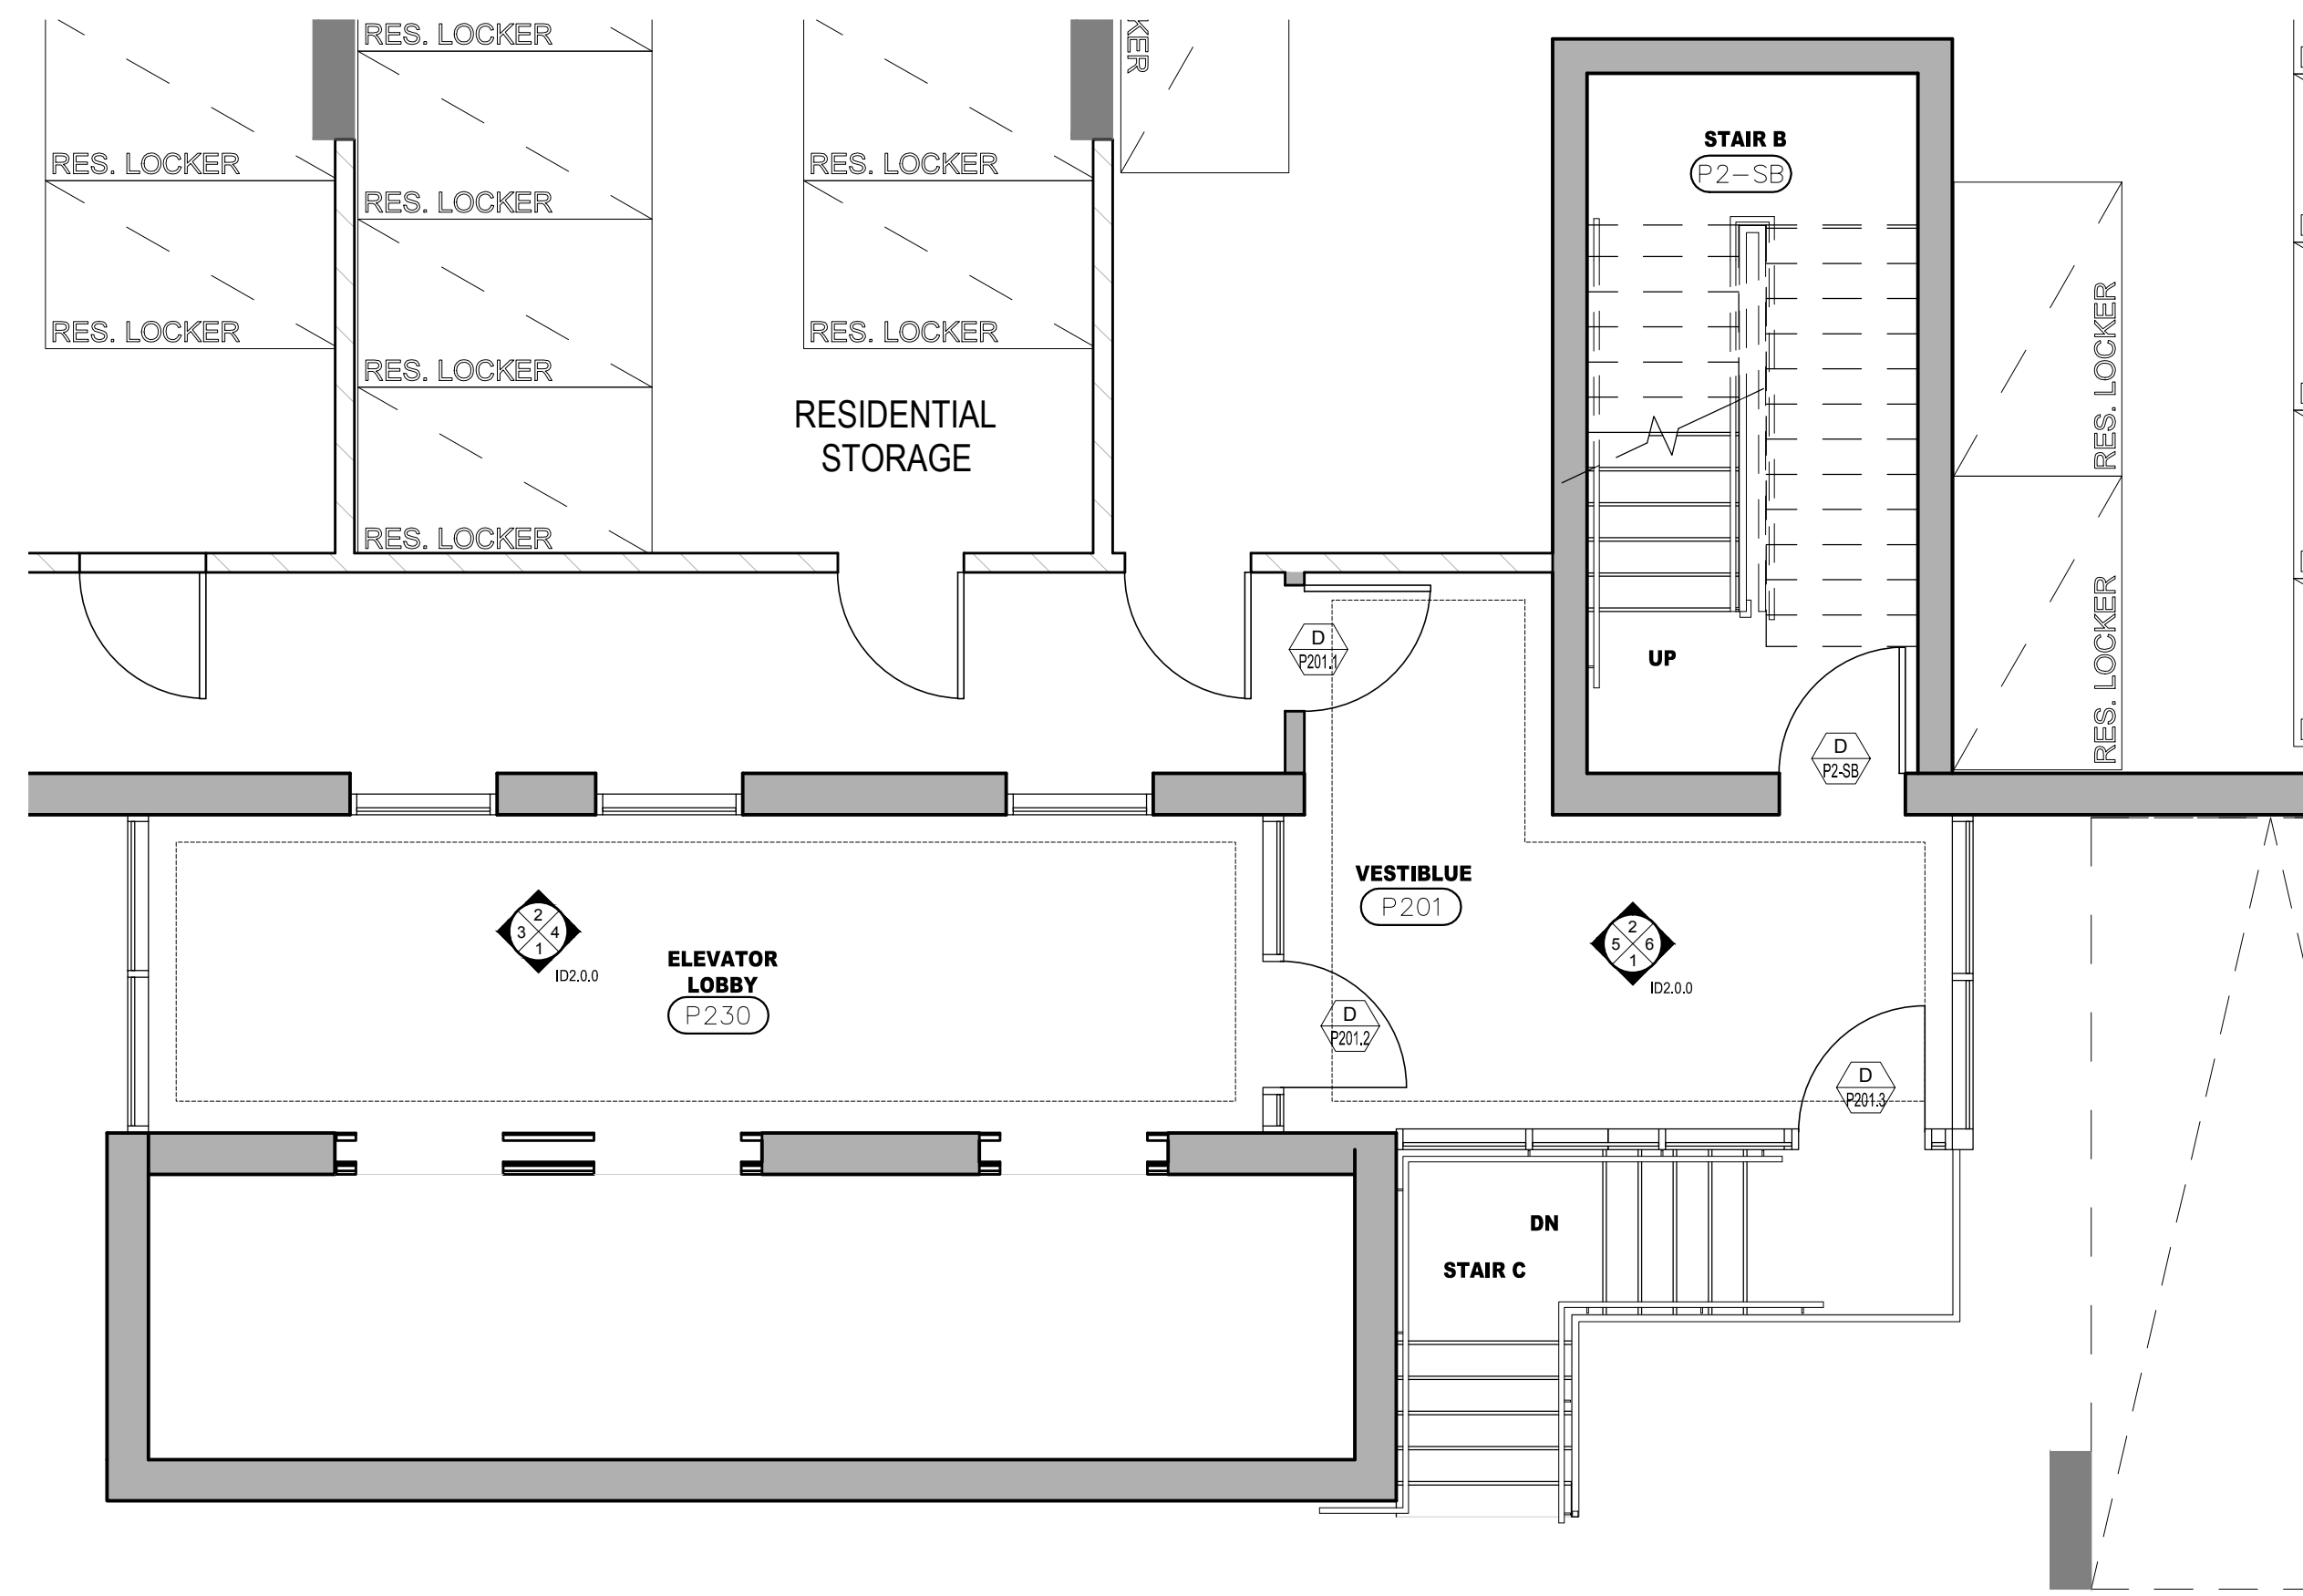


1 CONSTRUCTION PLAN
ID1.0.0 / P2 LEVEL
SCALE 1:50

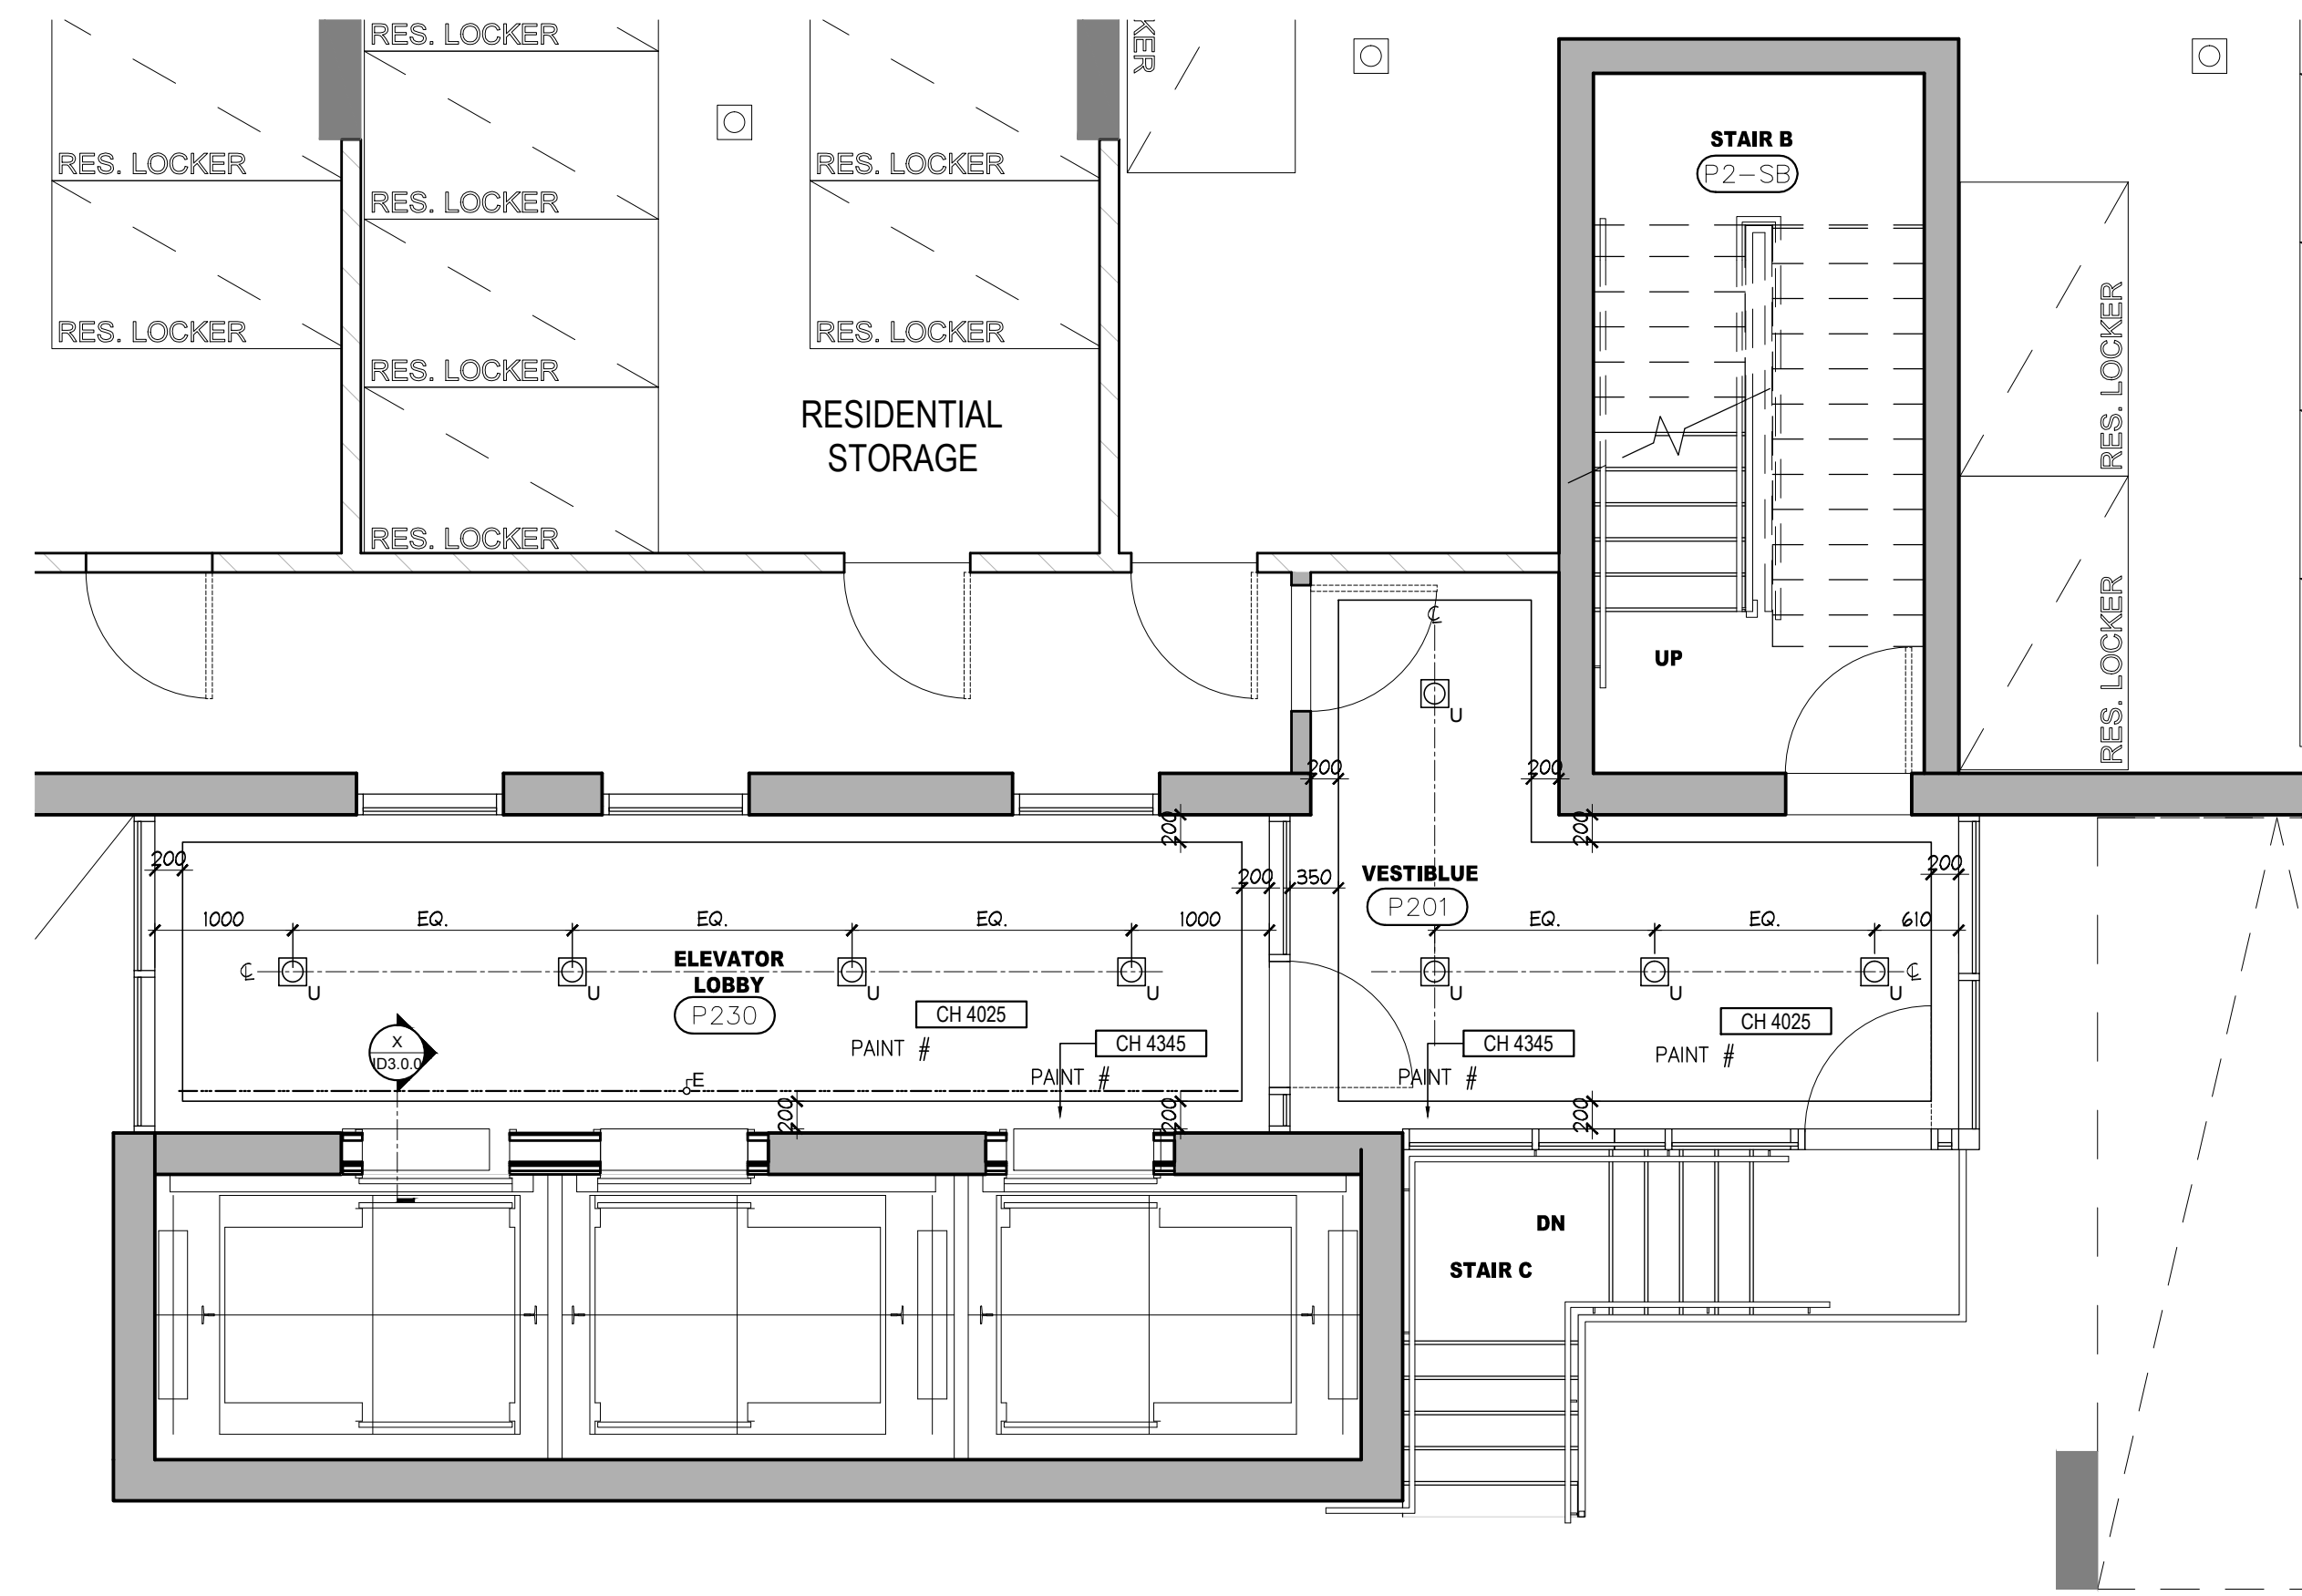


2 REFLECTED CEILING PLAN
ID1.0.0 / P2 LEVEL
SCALE 1:50

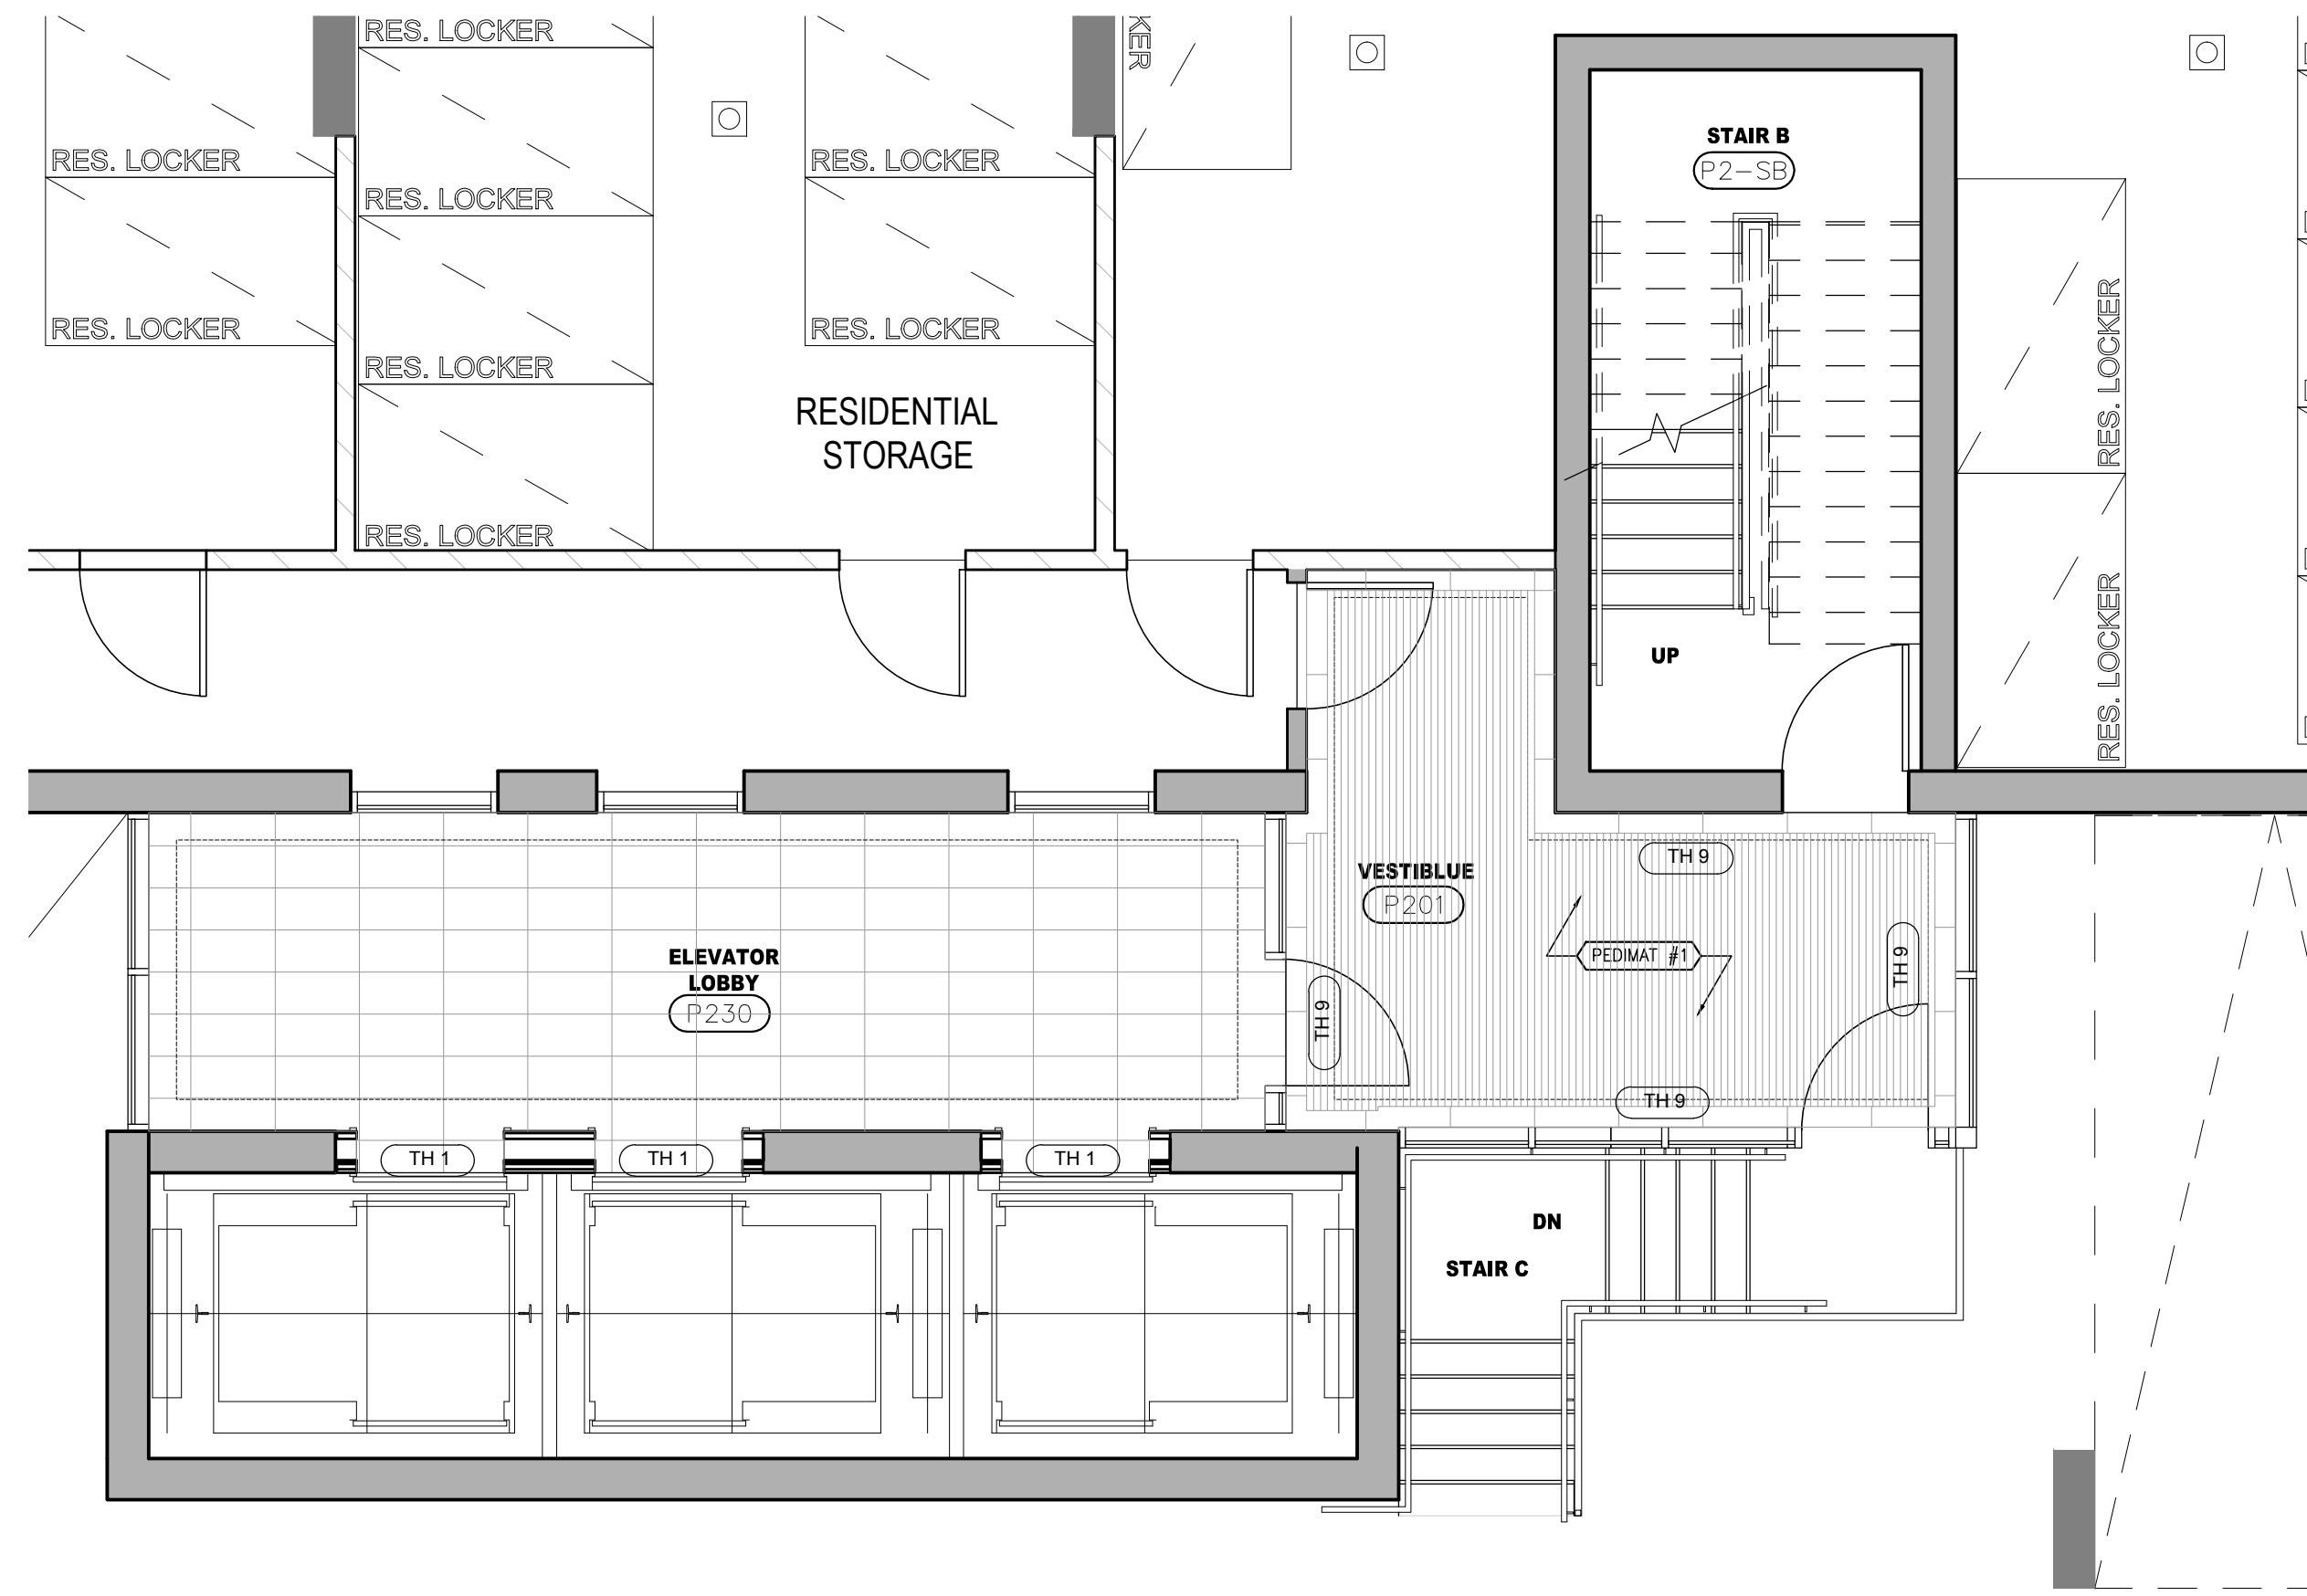

3 FLOOR FINISHES PLAN
ID1.0.0 / P2 LEVEL
SCALE 1:50

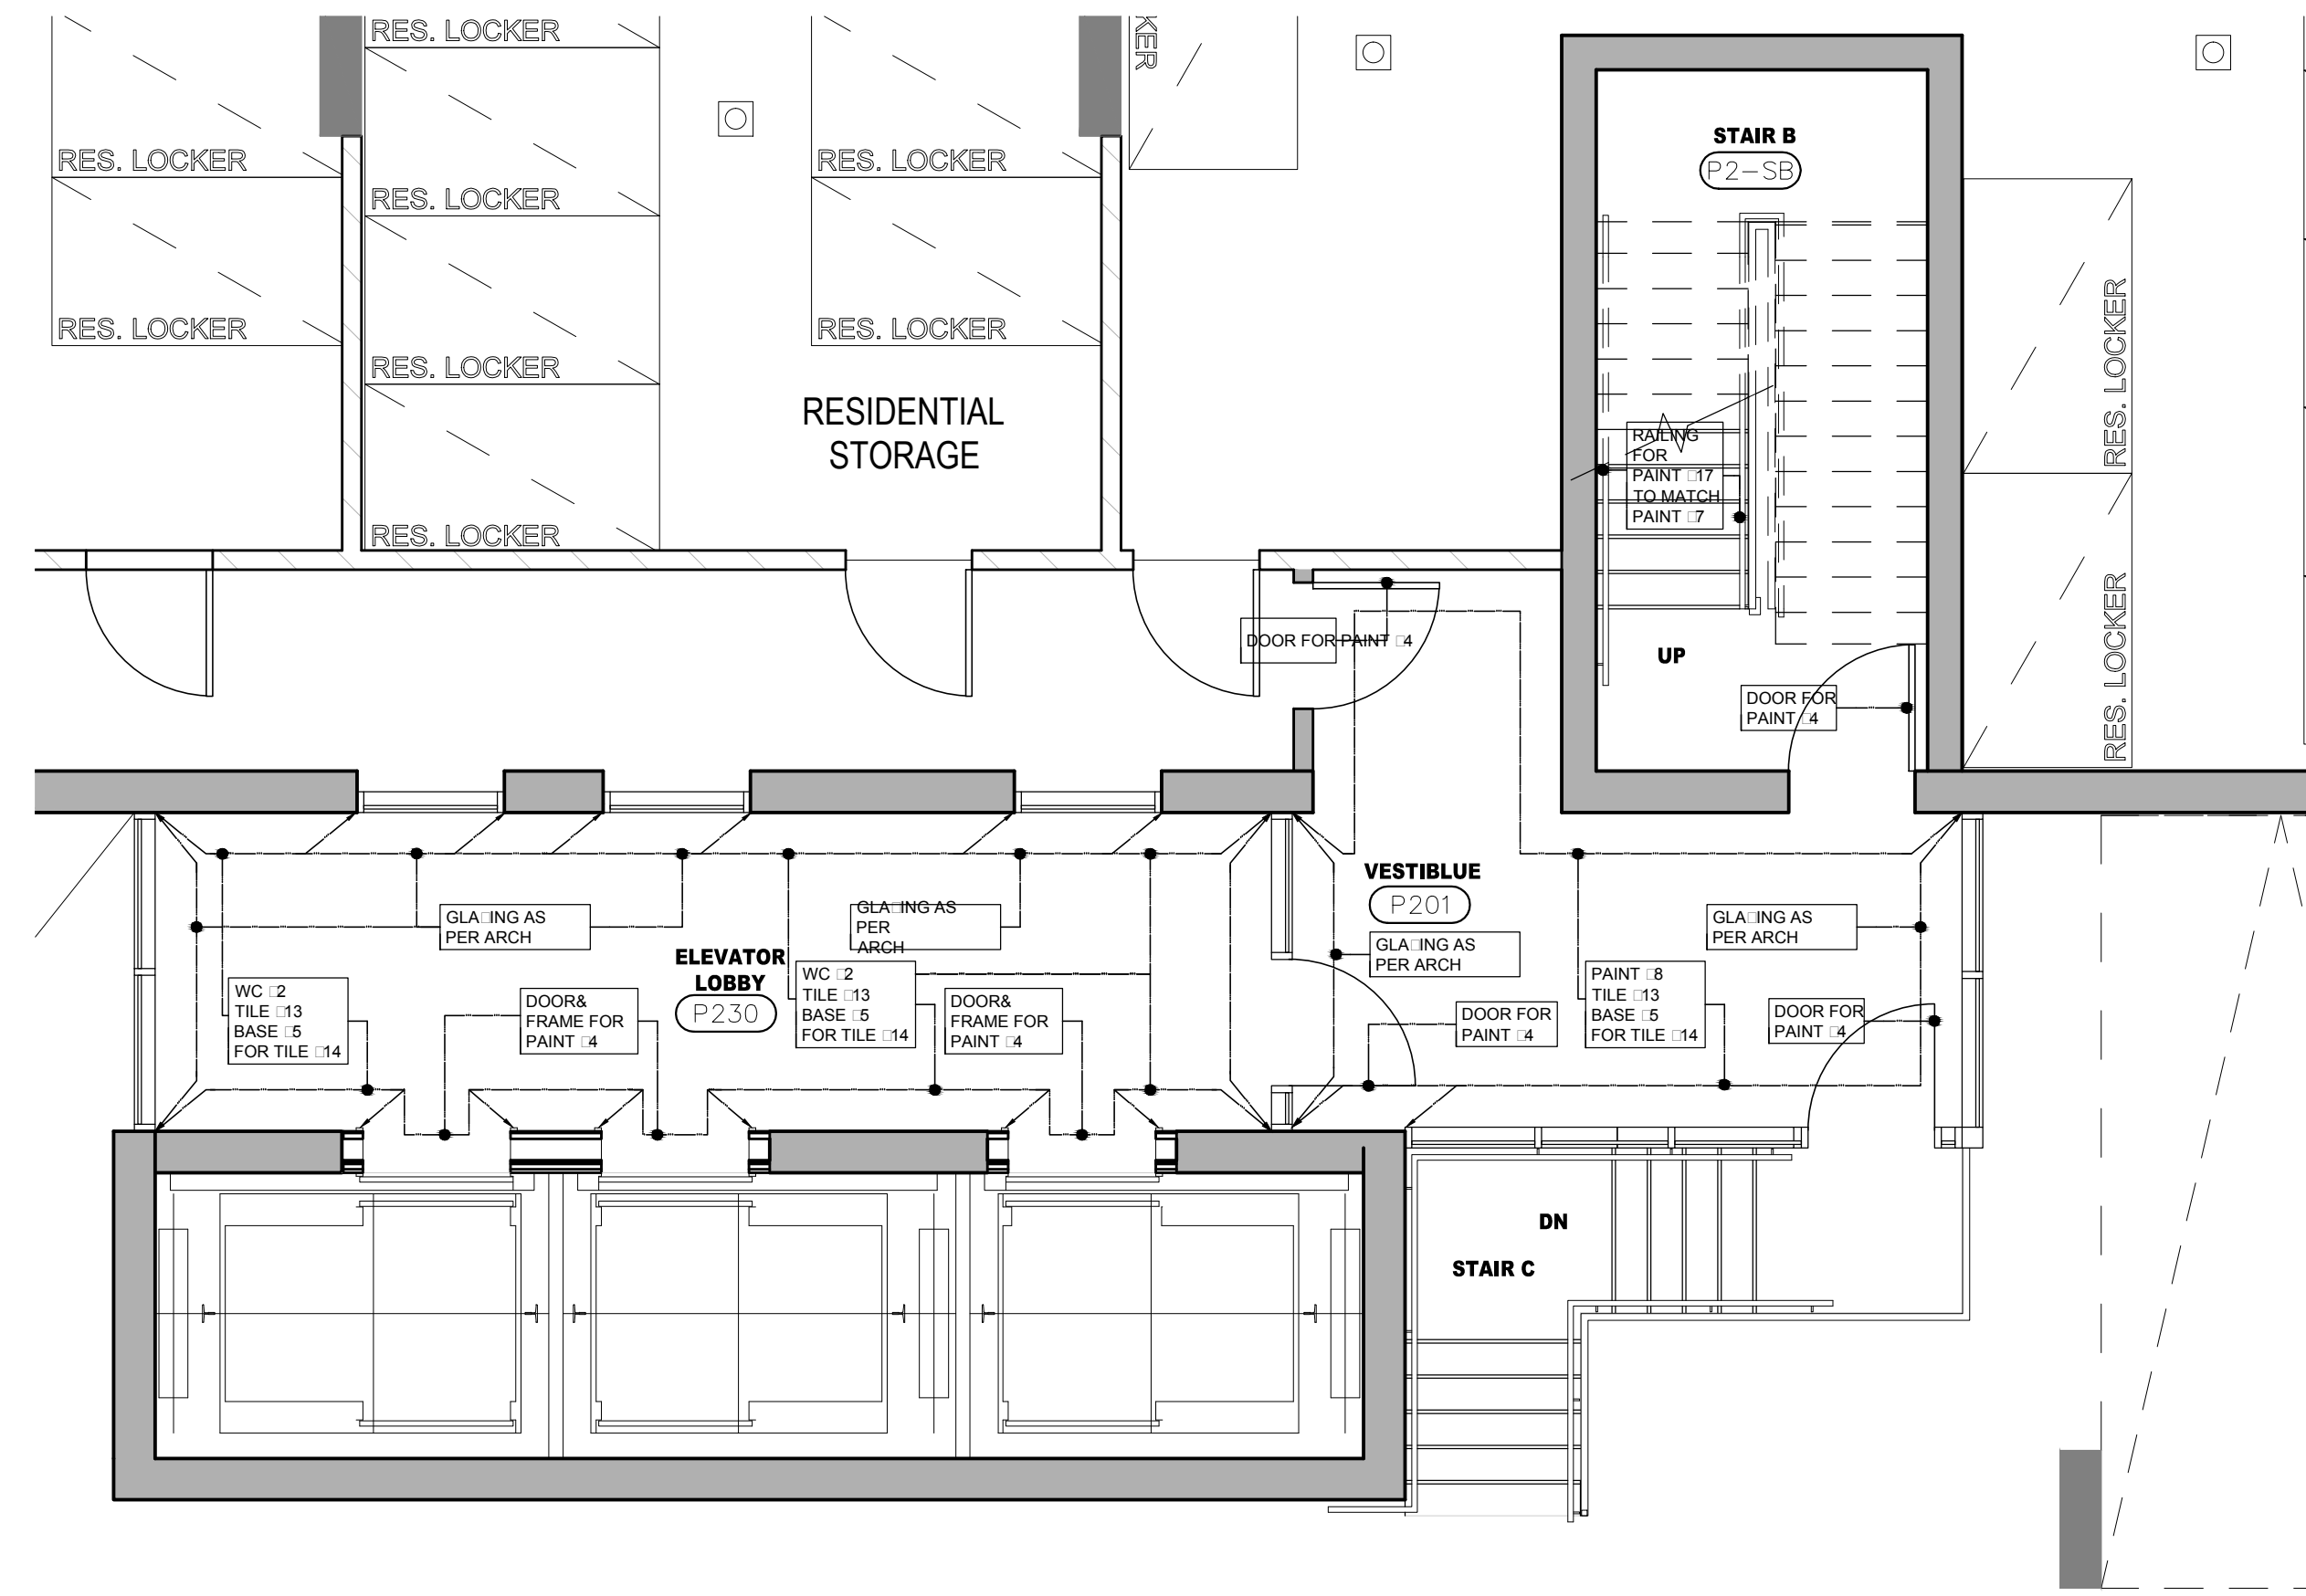

4 WALL FINISHES PLAN
ID1.0.0 / P2 LEVEL
SCALE 1:50

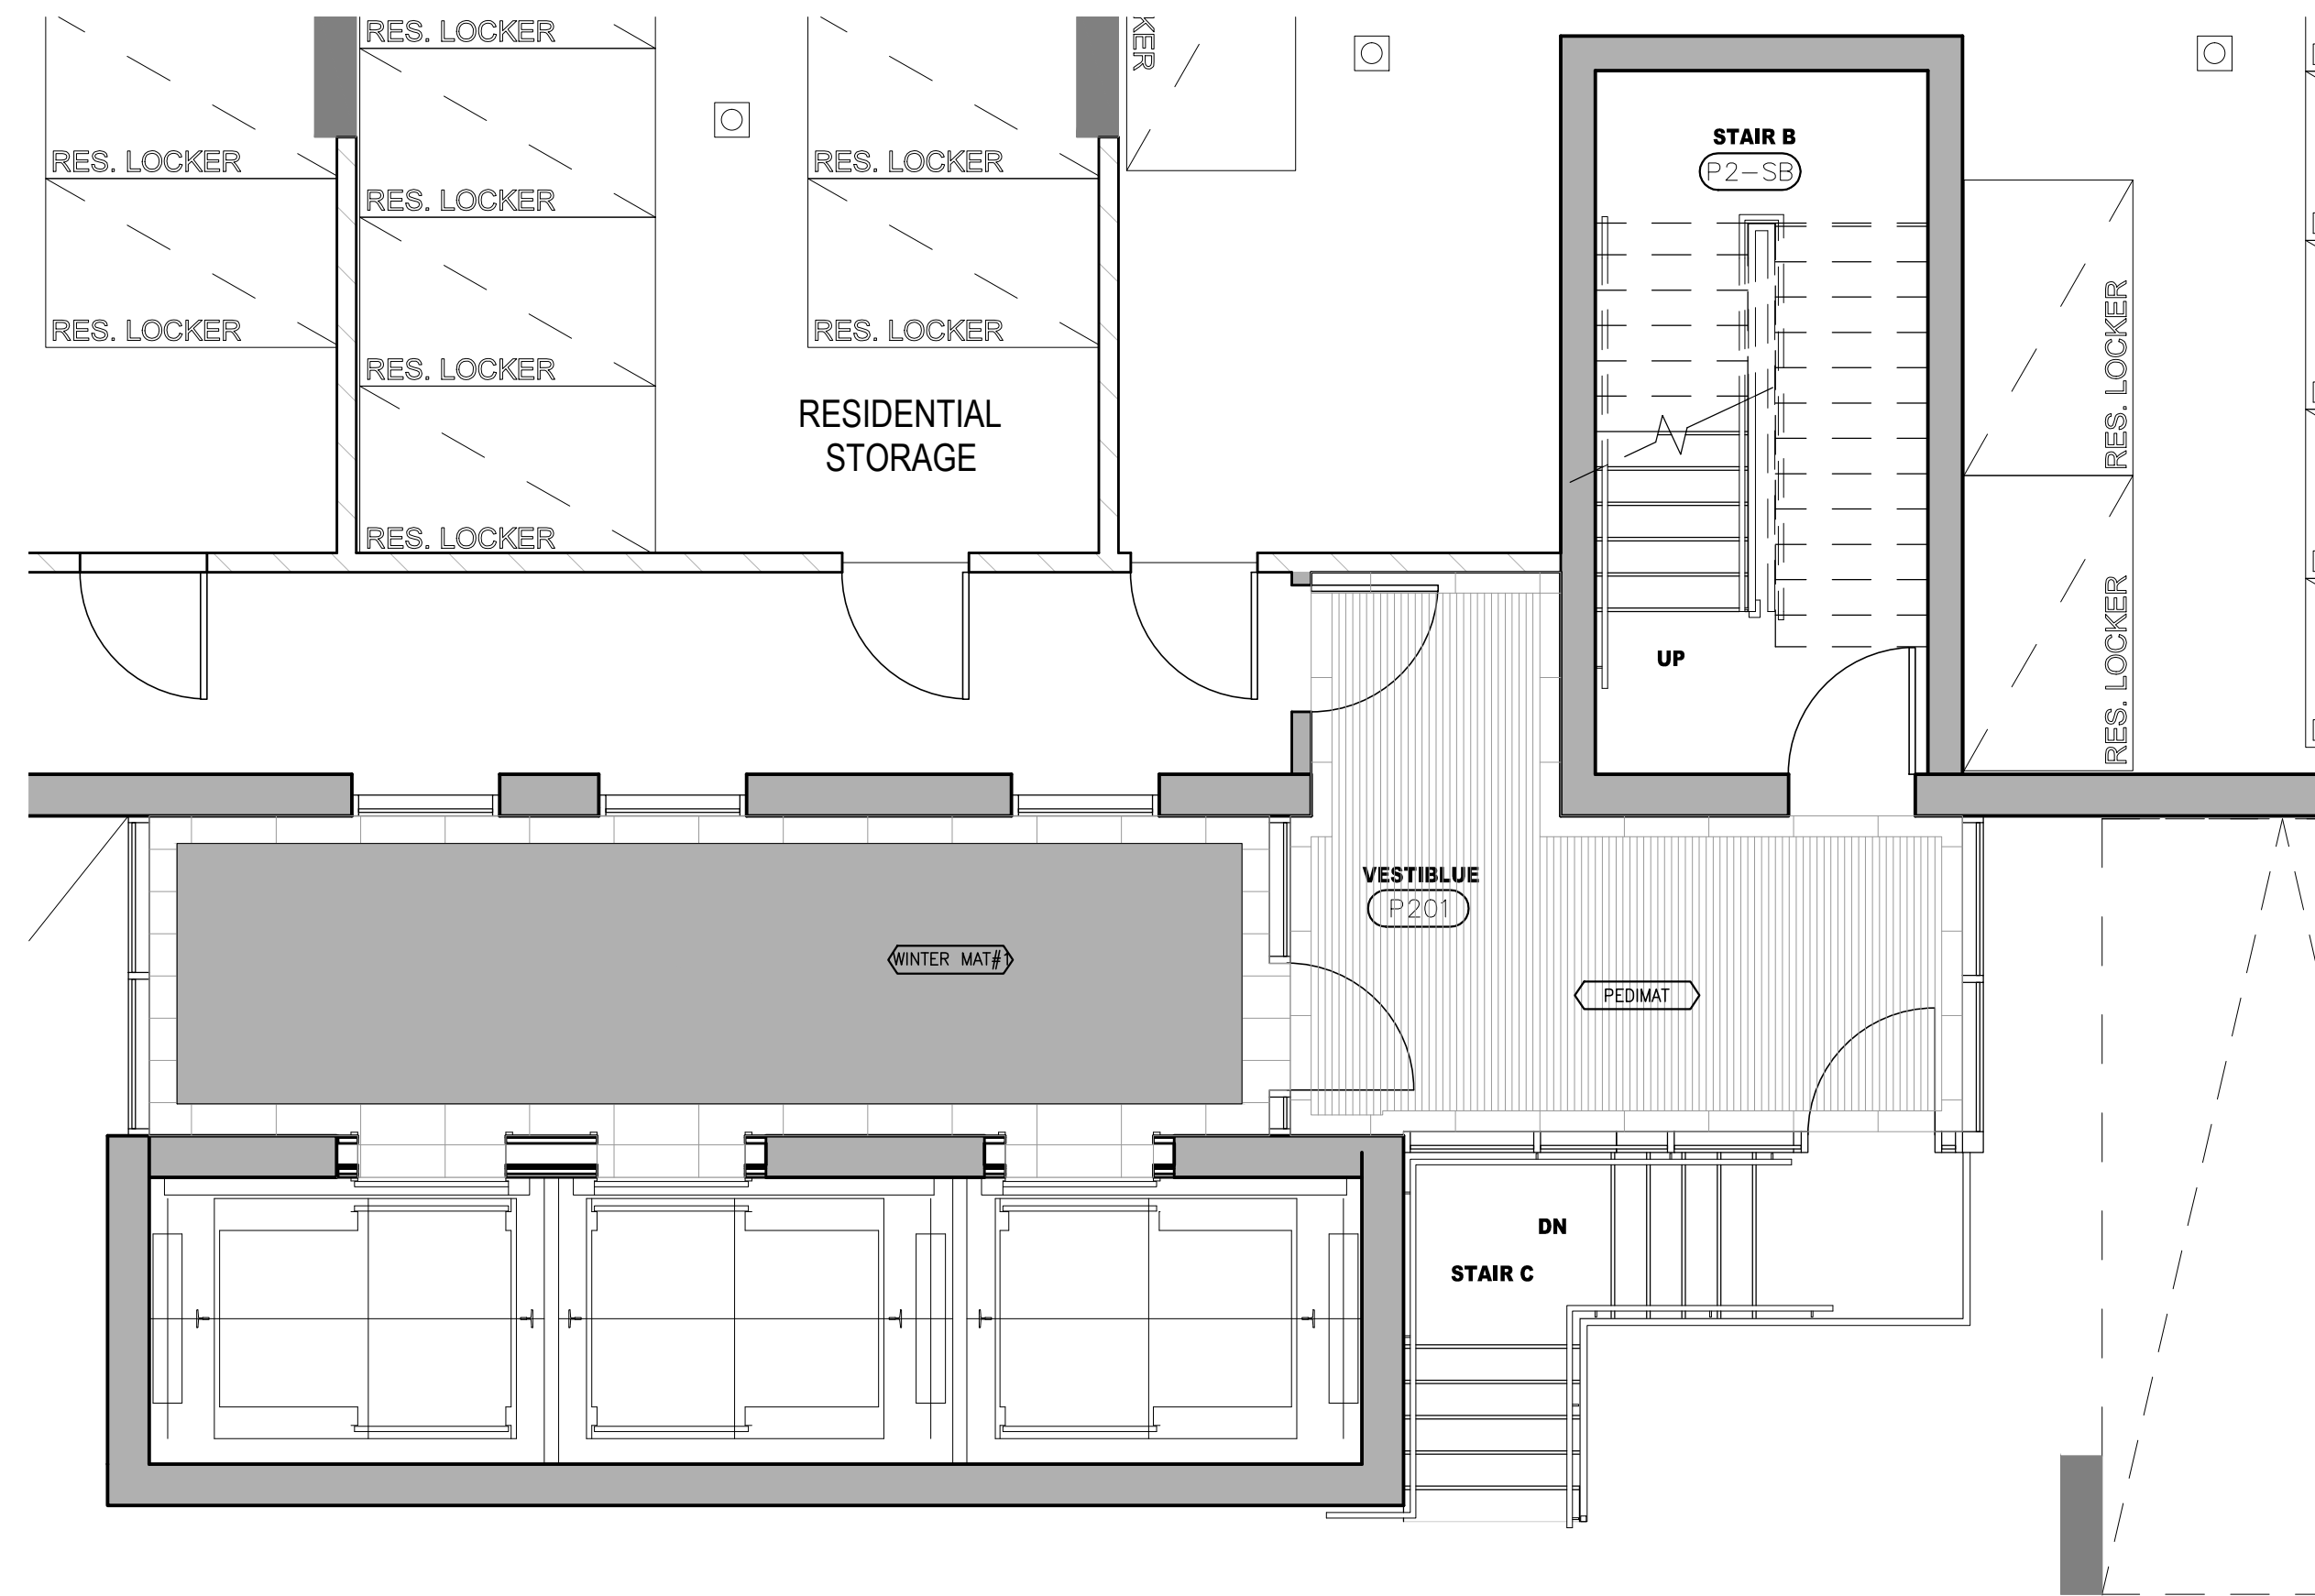

5 WINTER MATTING PLAN
ID1.0.0 / P2 LEVEL
SCALE 1:50

DO NOT SCALE DRAWINGS.

CONTRACTOR MUST VERIFY ALL DRAWINGS, DIMENSIONS, DETAILS AND SPECIFICATIONS AND REPORT ANY DISCREPANCIES TO UNION 31 INC. BEFORE PROCEEDING WITH WORK. MATERIALS MAY NOT BE SUBSTITUTED WITHOUT WRITTEN APPROVAL FROM UNION 31 INC.

ALL DRAWINGS AND SPECIFICATIONS ARE INSTRUMENTS OF SERVICE AND THE PROPERTY OF UNION 31 INC. WHICH MUST BE RETURNED AT THE COMPLETION OF THE WORK.

PRINTED: 30-MAY-17

ISSUED FOR
AS-BUILT

01	31 MAY / 17	ISSUED FOR AS-BUILT	SV
NO.	DATE	COMMENTS	INI
REVISIONS:			

UNION31

UNION31 INC.
183 BATHURST STREET, STE. 201
TORONTO, ON, M5T 2R7, CANADA
TEL: 416-597-1576 FAX: 416-597-2139

PROJECT NAME: ALEXANDRA PARK MAIN BUILDING BLOCK 11 ON, Canada			
PROJECT NO.: 13-949			
DRAWINGS: P 2 LEVEL CONSTRUCTION PLAN & REFLECTED CEILING PLAN FLOOR & WALL FINISHES PLANS			
DATE STARTED: 07 AUG / 13		DRAWING NO.: ID	
SCALE: 1:50		ID	
DRAWN BY: AP		1.0.0	
APPROVED BY: KC			

DO NOT SCALE DRAWINGS.

CONTRACTOR MUST VERIFY ALL DRAWINGS, DIMENSIONS, DETAILS AND SPECIFICATIONS AND REPORT ANY DISCREPANCIES TO UNION 31 INC. BEFORE PROCEEDING WITH WORK. MATERIALS MAY NOT BE SUBSTITUTED WITHOUT WRITTEN APPROVAL FROM UNION 31 INC.

ALL DRAWINGS AND SPECIFICATIONS ARE INSTRUMENTS OF SERVICE AND THE PROPERTY OF UNION 31 INC. WHICH MUST BE RETURNED AT THE COMPLETION OF THE WORK.

PRINTED: 30-MAY-17

ISSUED FOR
AS-BUILT

01	31 MAY / 17	ISSUED FOR AS-BUILT	SV
NO.	DATE	COMMENTS	INI

REVISIONS:

UNION31

UNION31 INC.
183 BATHURST STREET, STE. 201
TORONTO, ON, M5T 2R7, CANADA
TEL: 416-597-1576 FAX: 416-597-2139


PROJECT NAME:
ALEXANDRA PARK
MAIN BUILDING

BLOCK 11
ON, Canada


PROJECT NO.:
13-949

DRAWINGS:
P 1 LEVEL
CONSTRUCTION PLAN &
REFLECTED CEILING PLAN
FLOOR & WALL FINISHES PLANS


DATE STARTED: 07 AUG / 13	DRAWING NO.:
SCALE: 1" = 50'	ID
DRAWN BY: AP	1.0.1
APPROVED BY: KC	

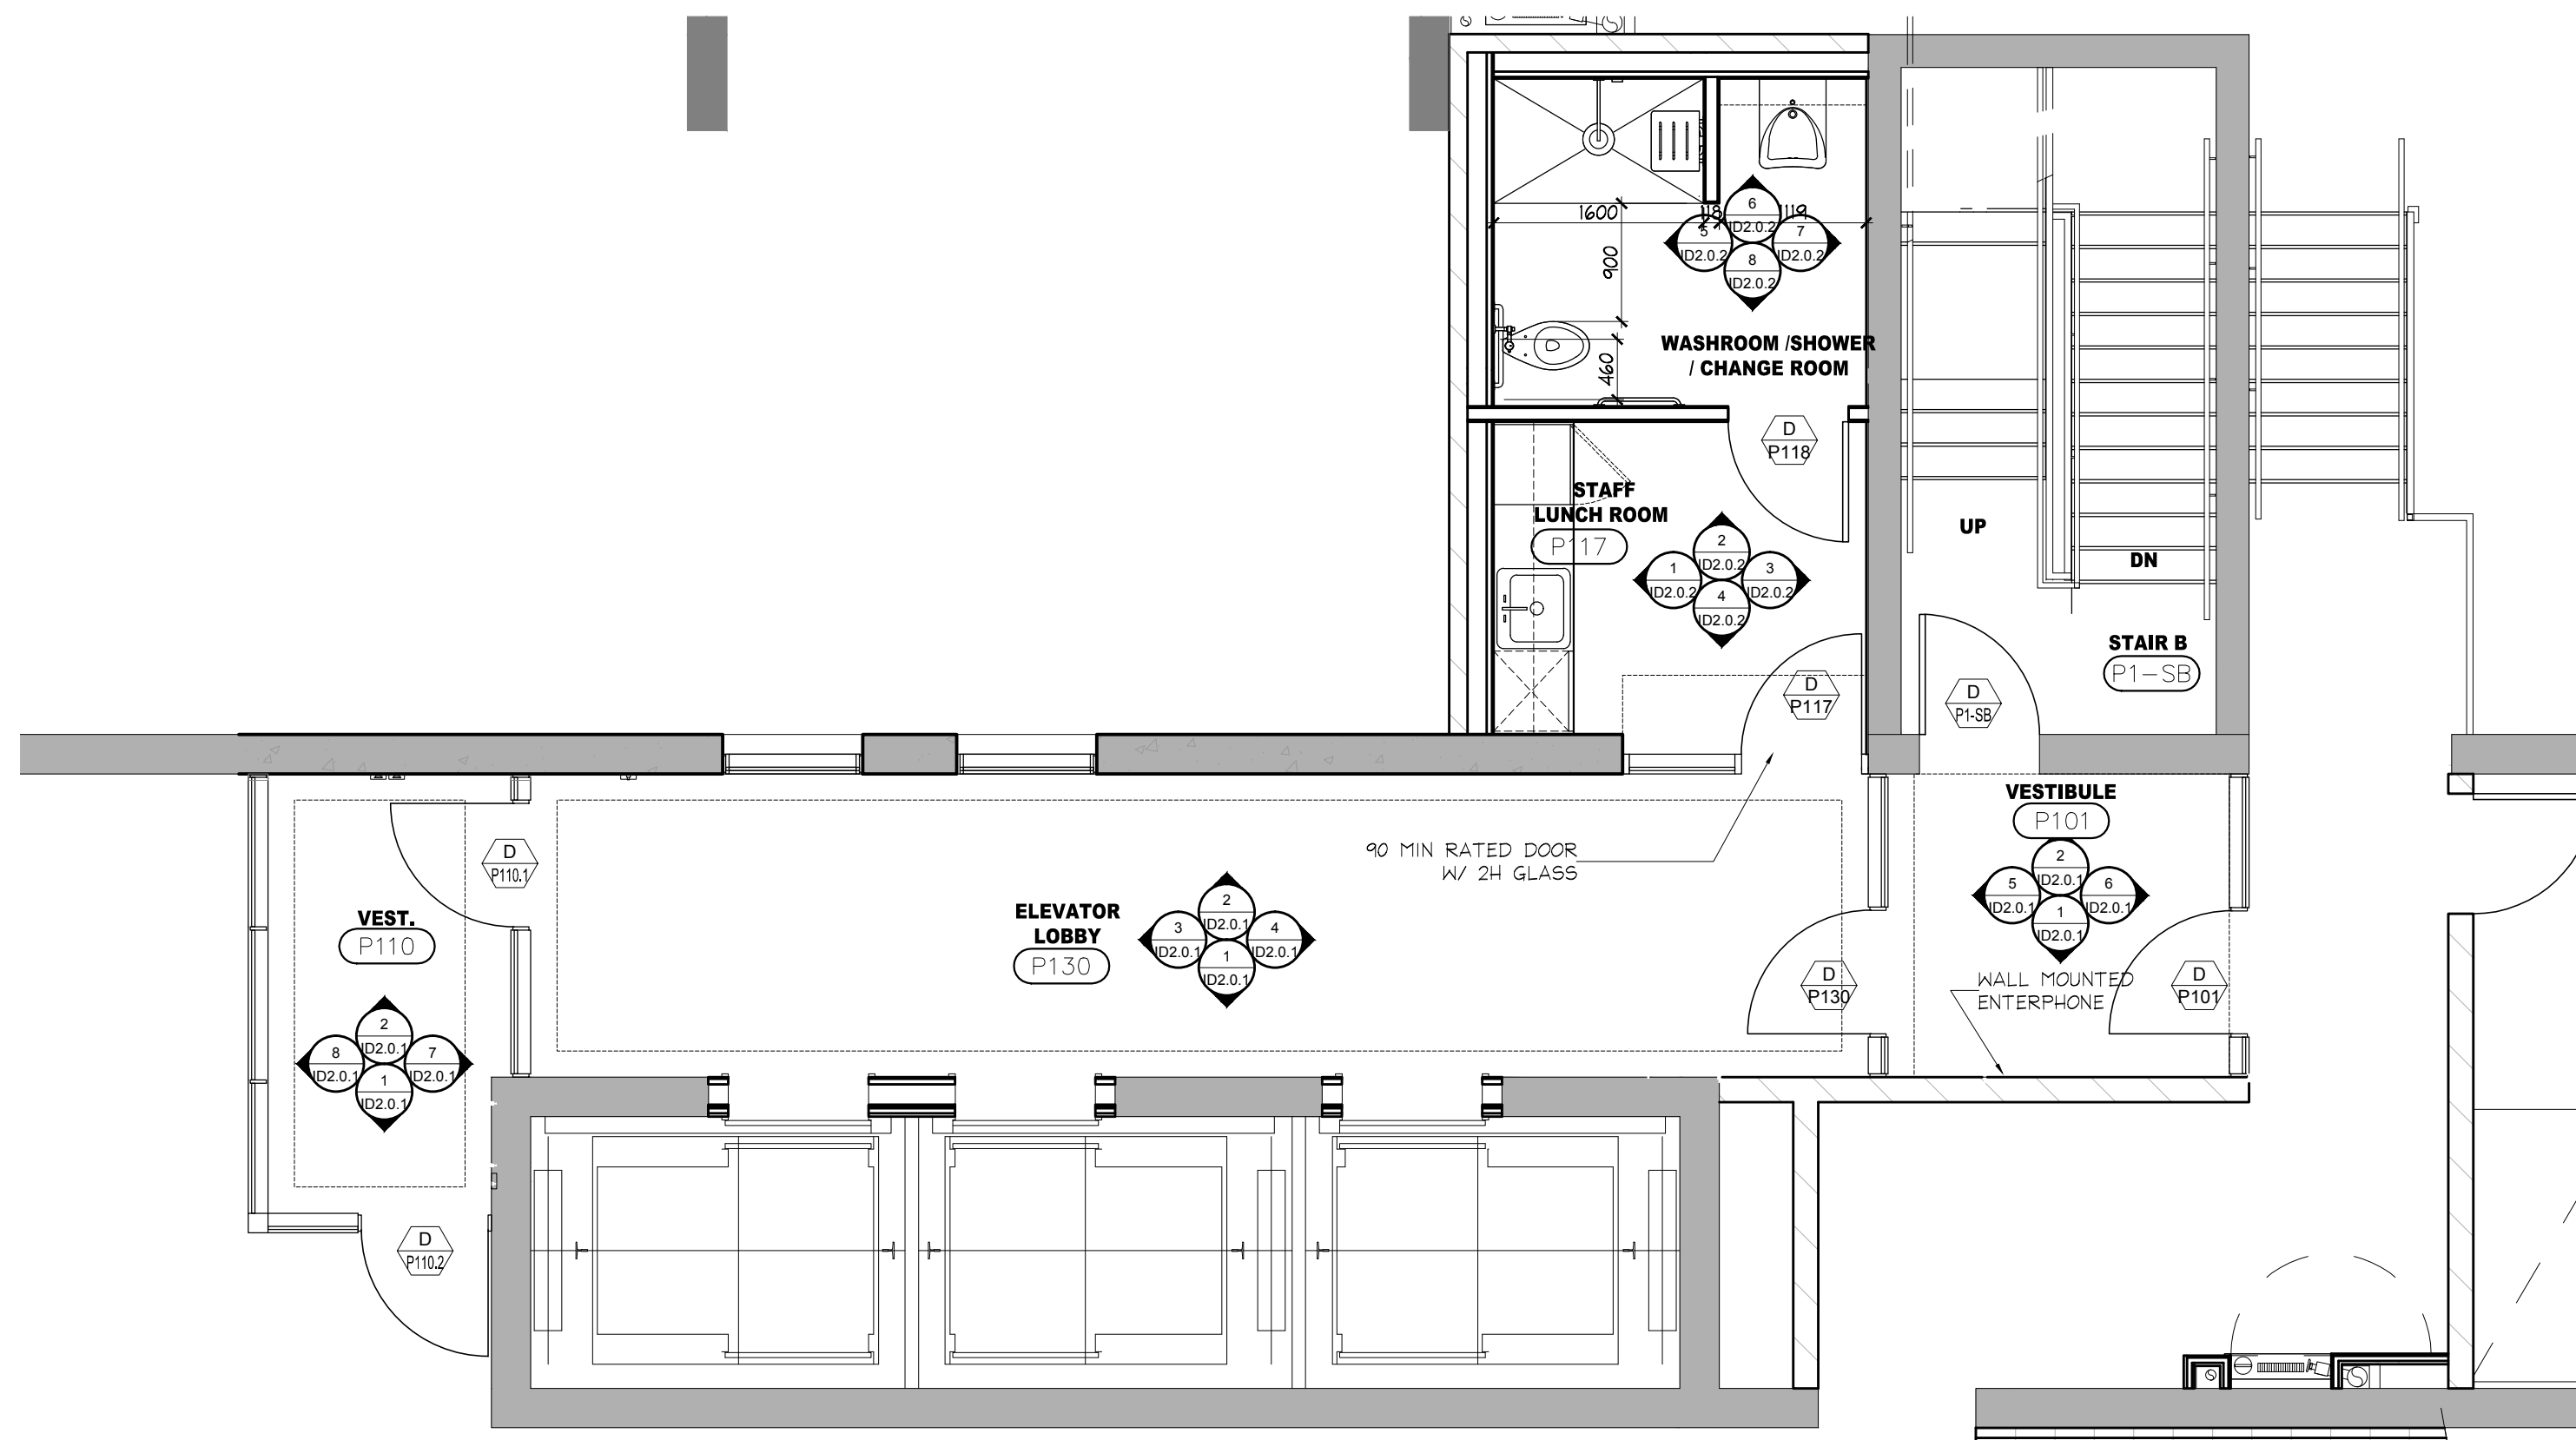


1 CONSTRUCTION PLAN
P1 LEVEL
SCALE 1:50

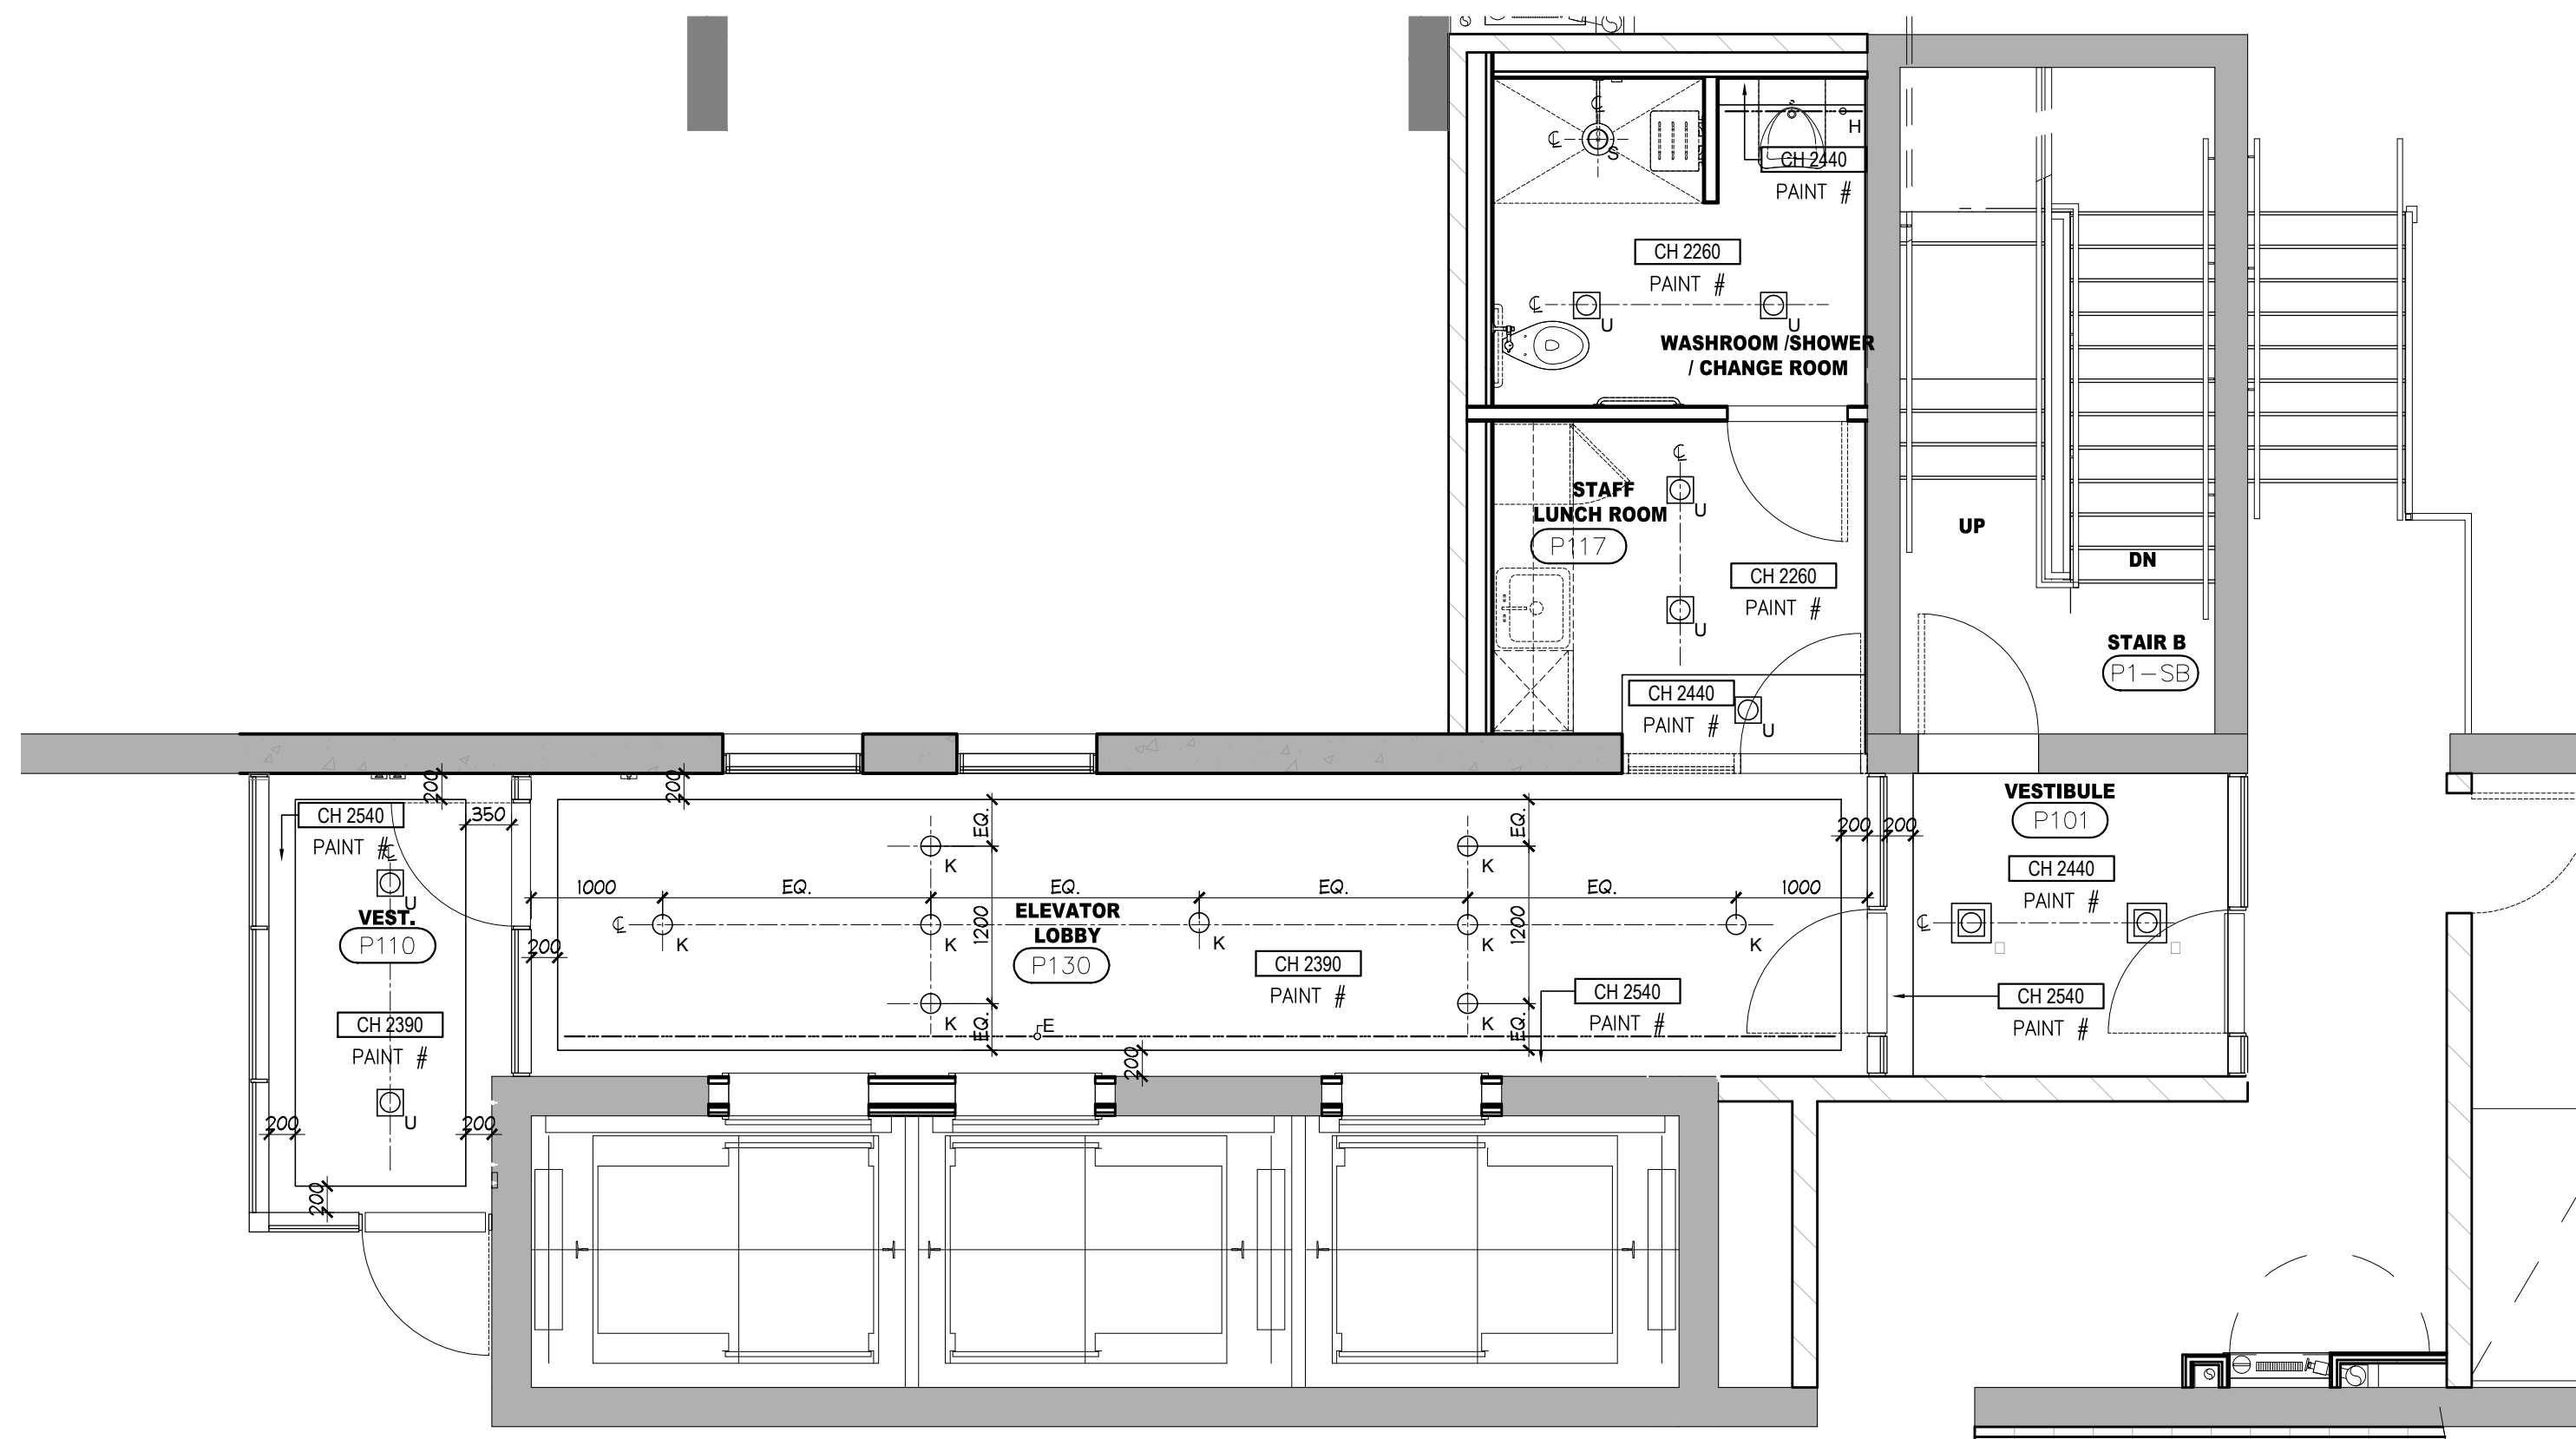


2 REFLECTED CEILING PLAN
P1 LEVEL
SCALE 1:50

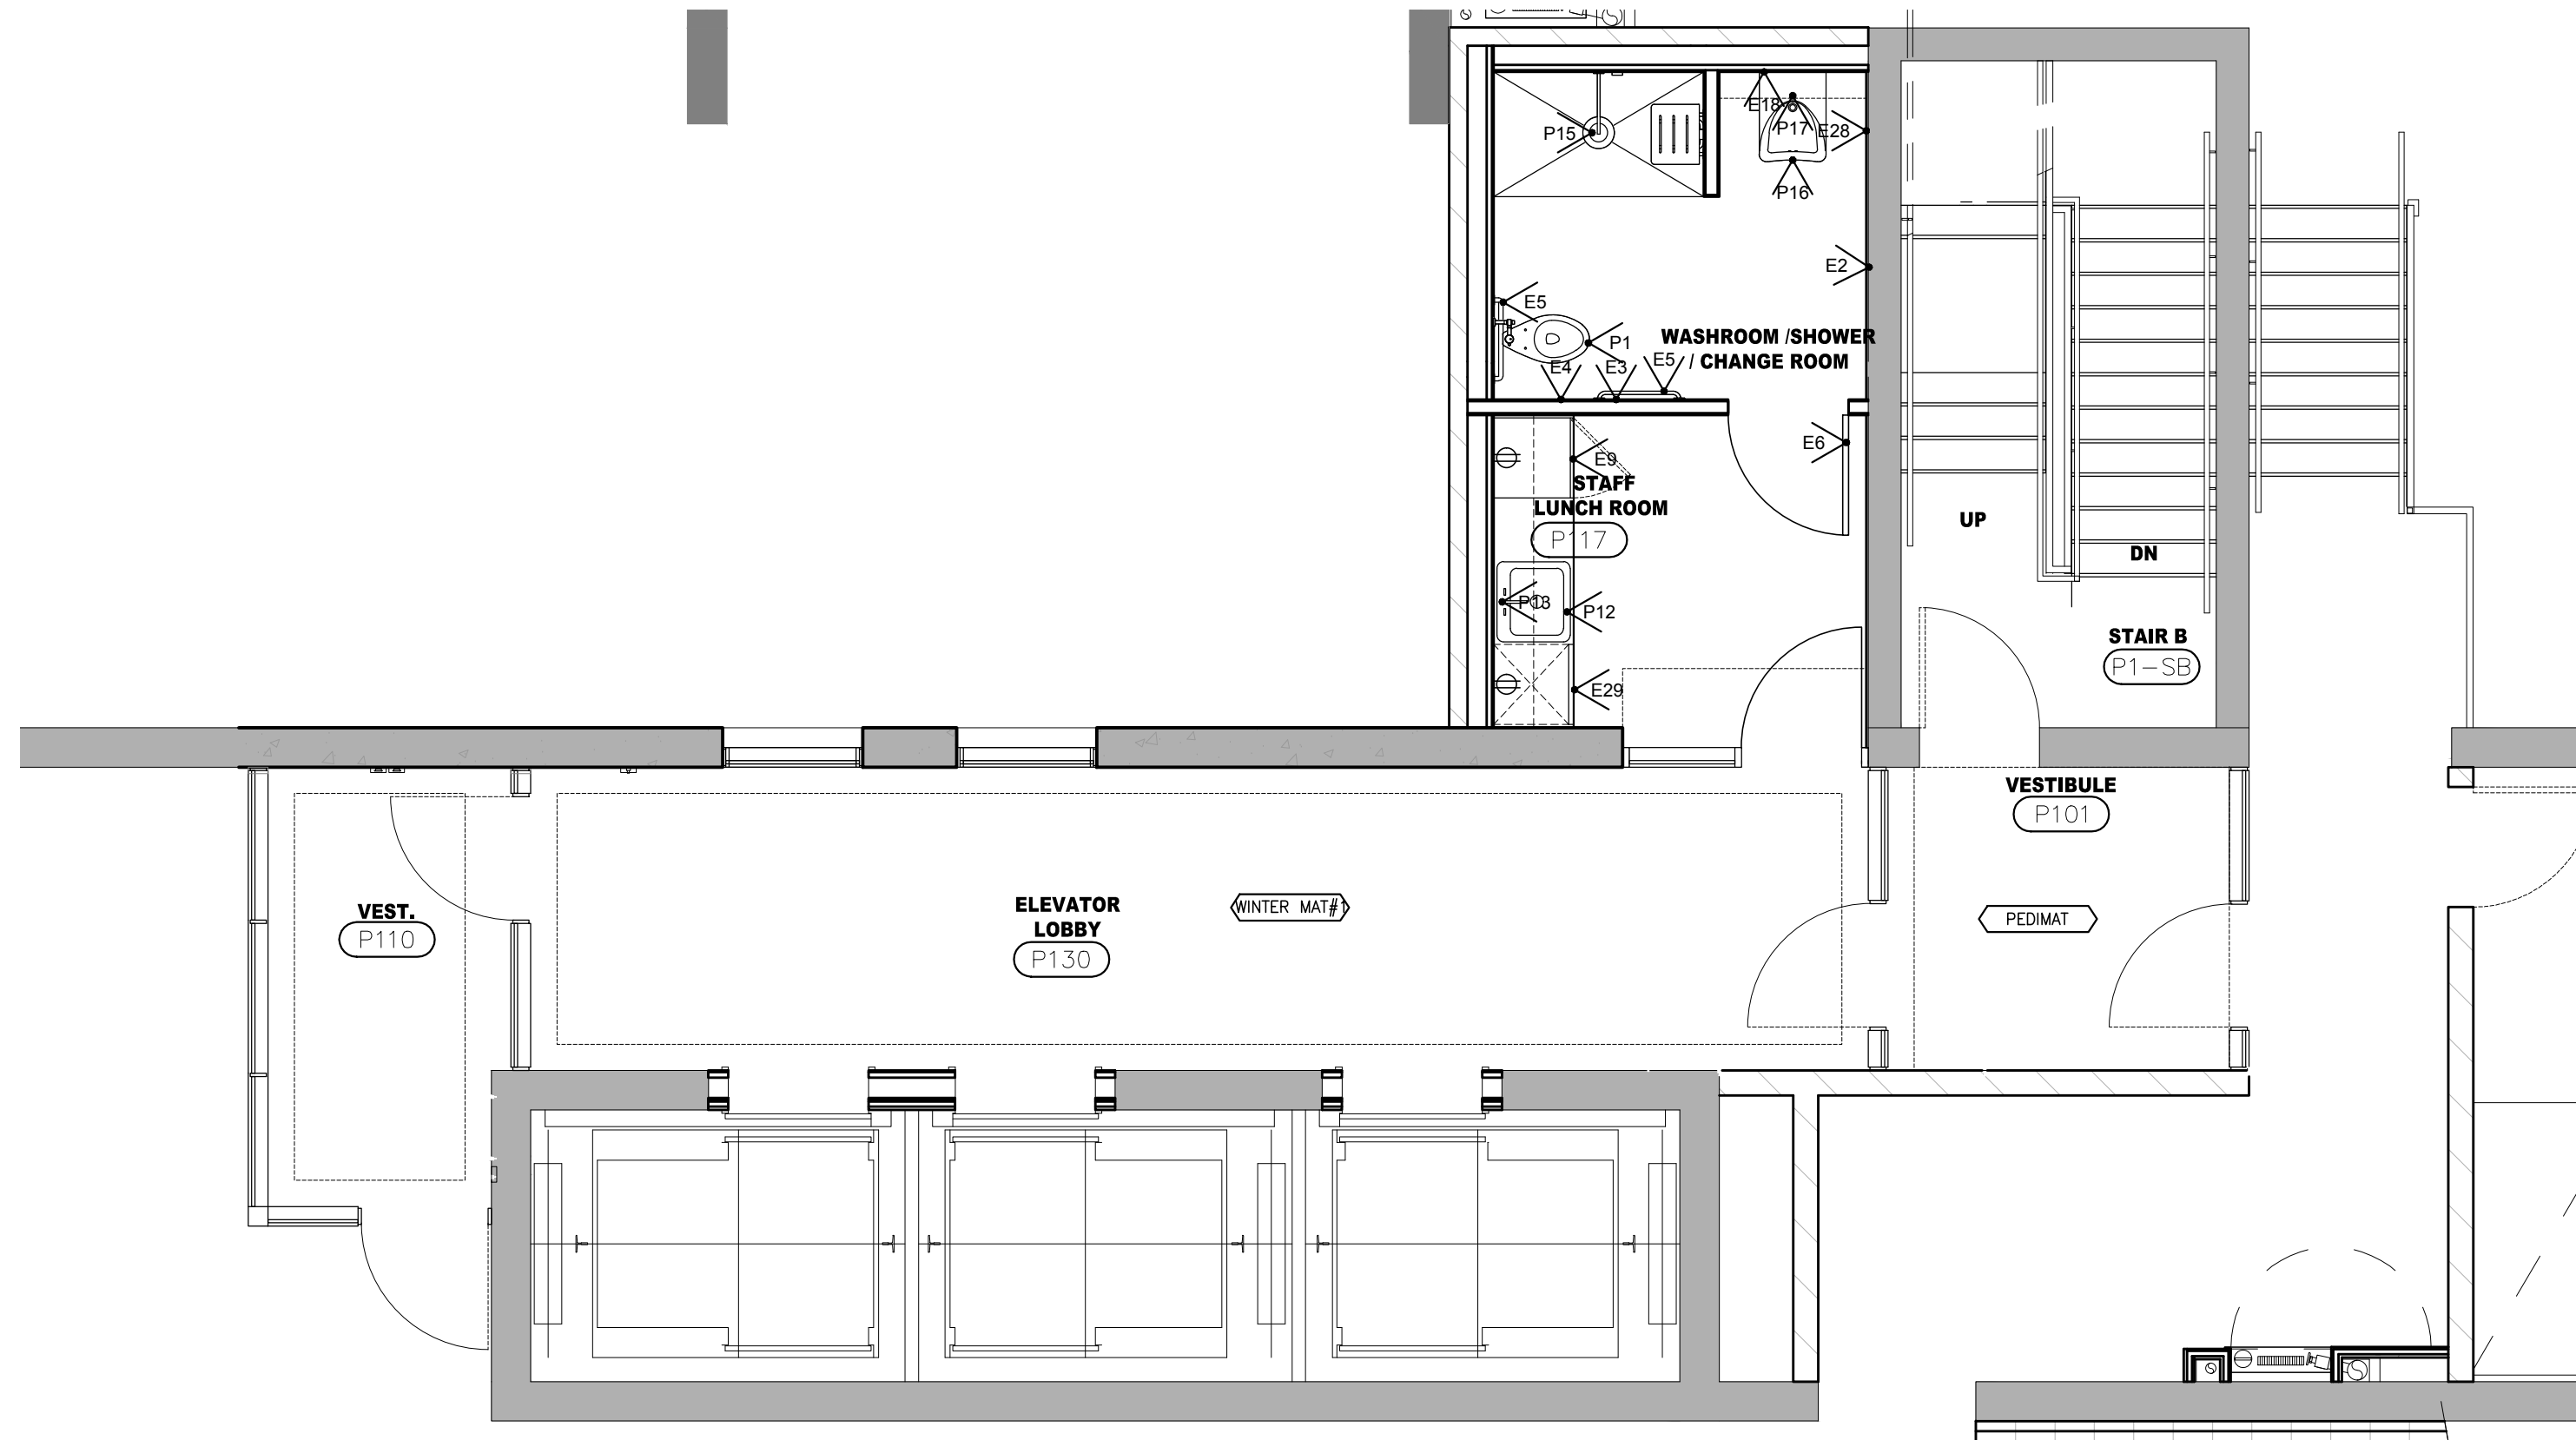


3 POWER & FUNITURE PLAN
P1 LEVEL
SCALE 1:50

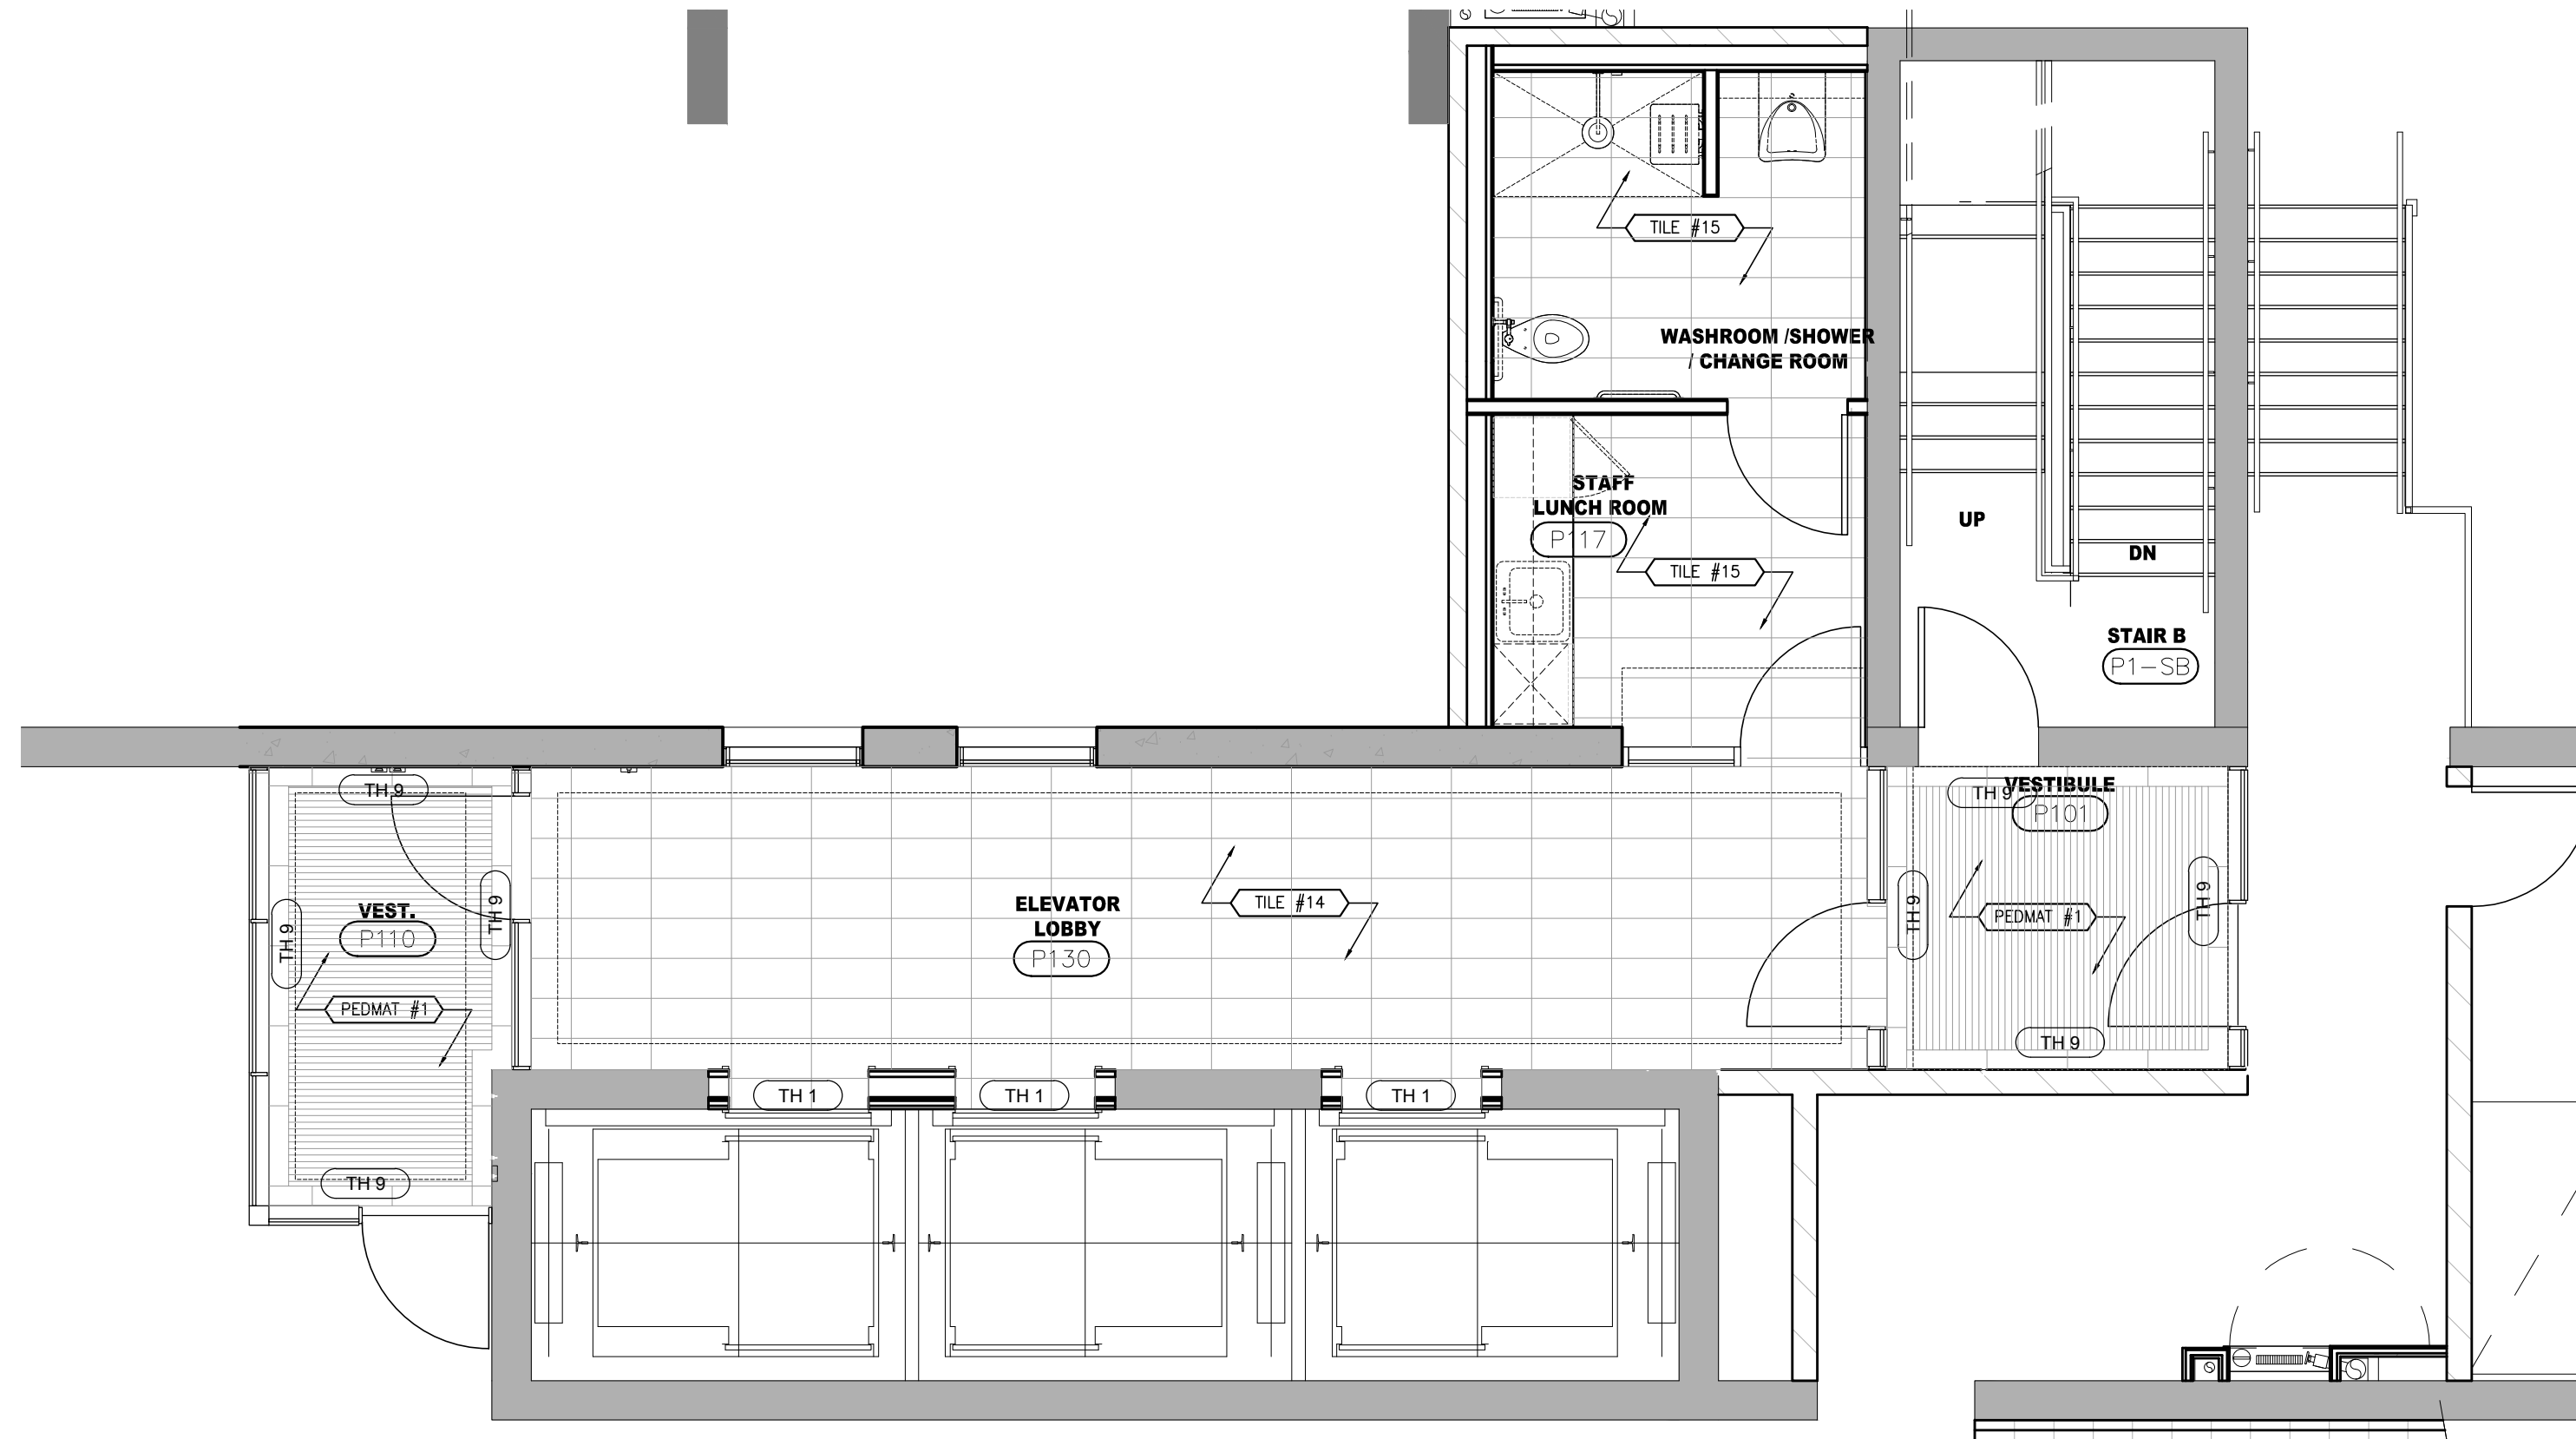

4 FLOOR FINISHES PLAN
P1 LEVEL
SCALE 1:50

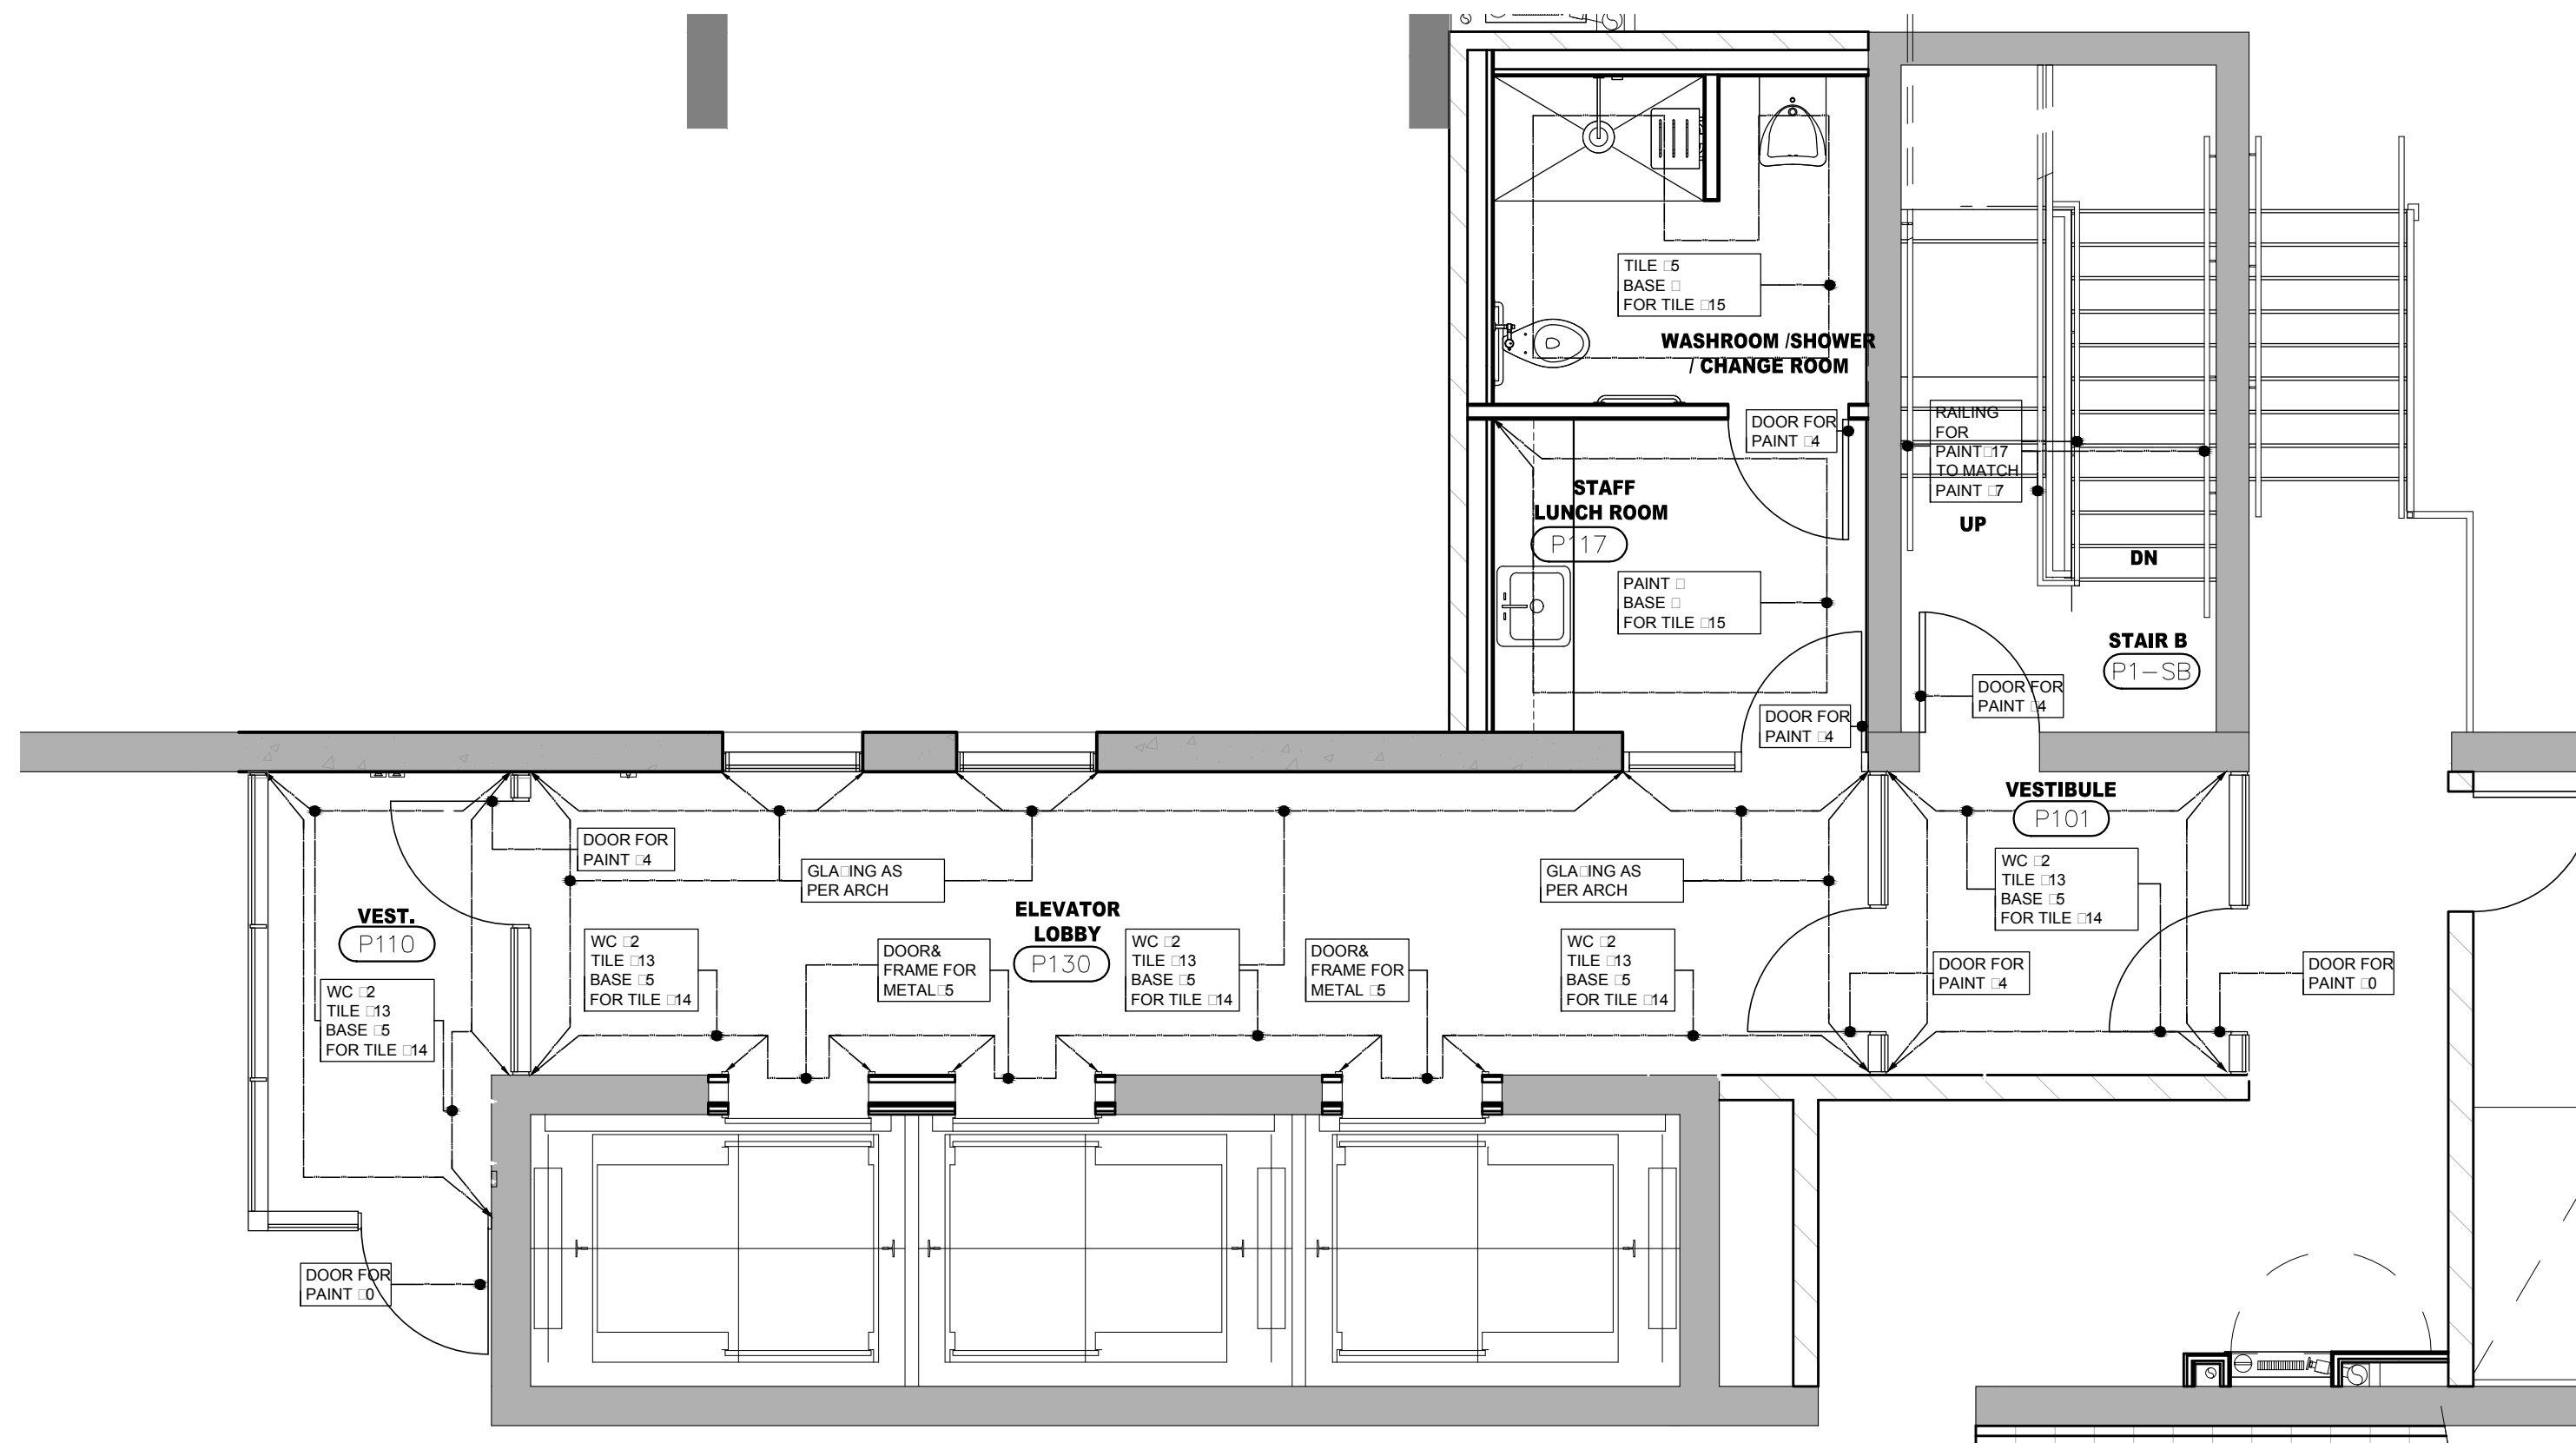

5 WALL FINISHES PLAN
P1 LEVEL
SCALE 1:50

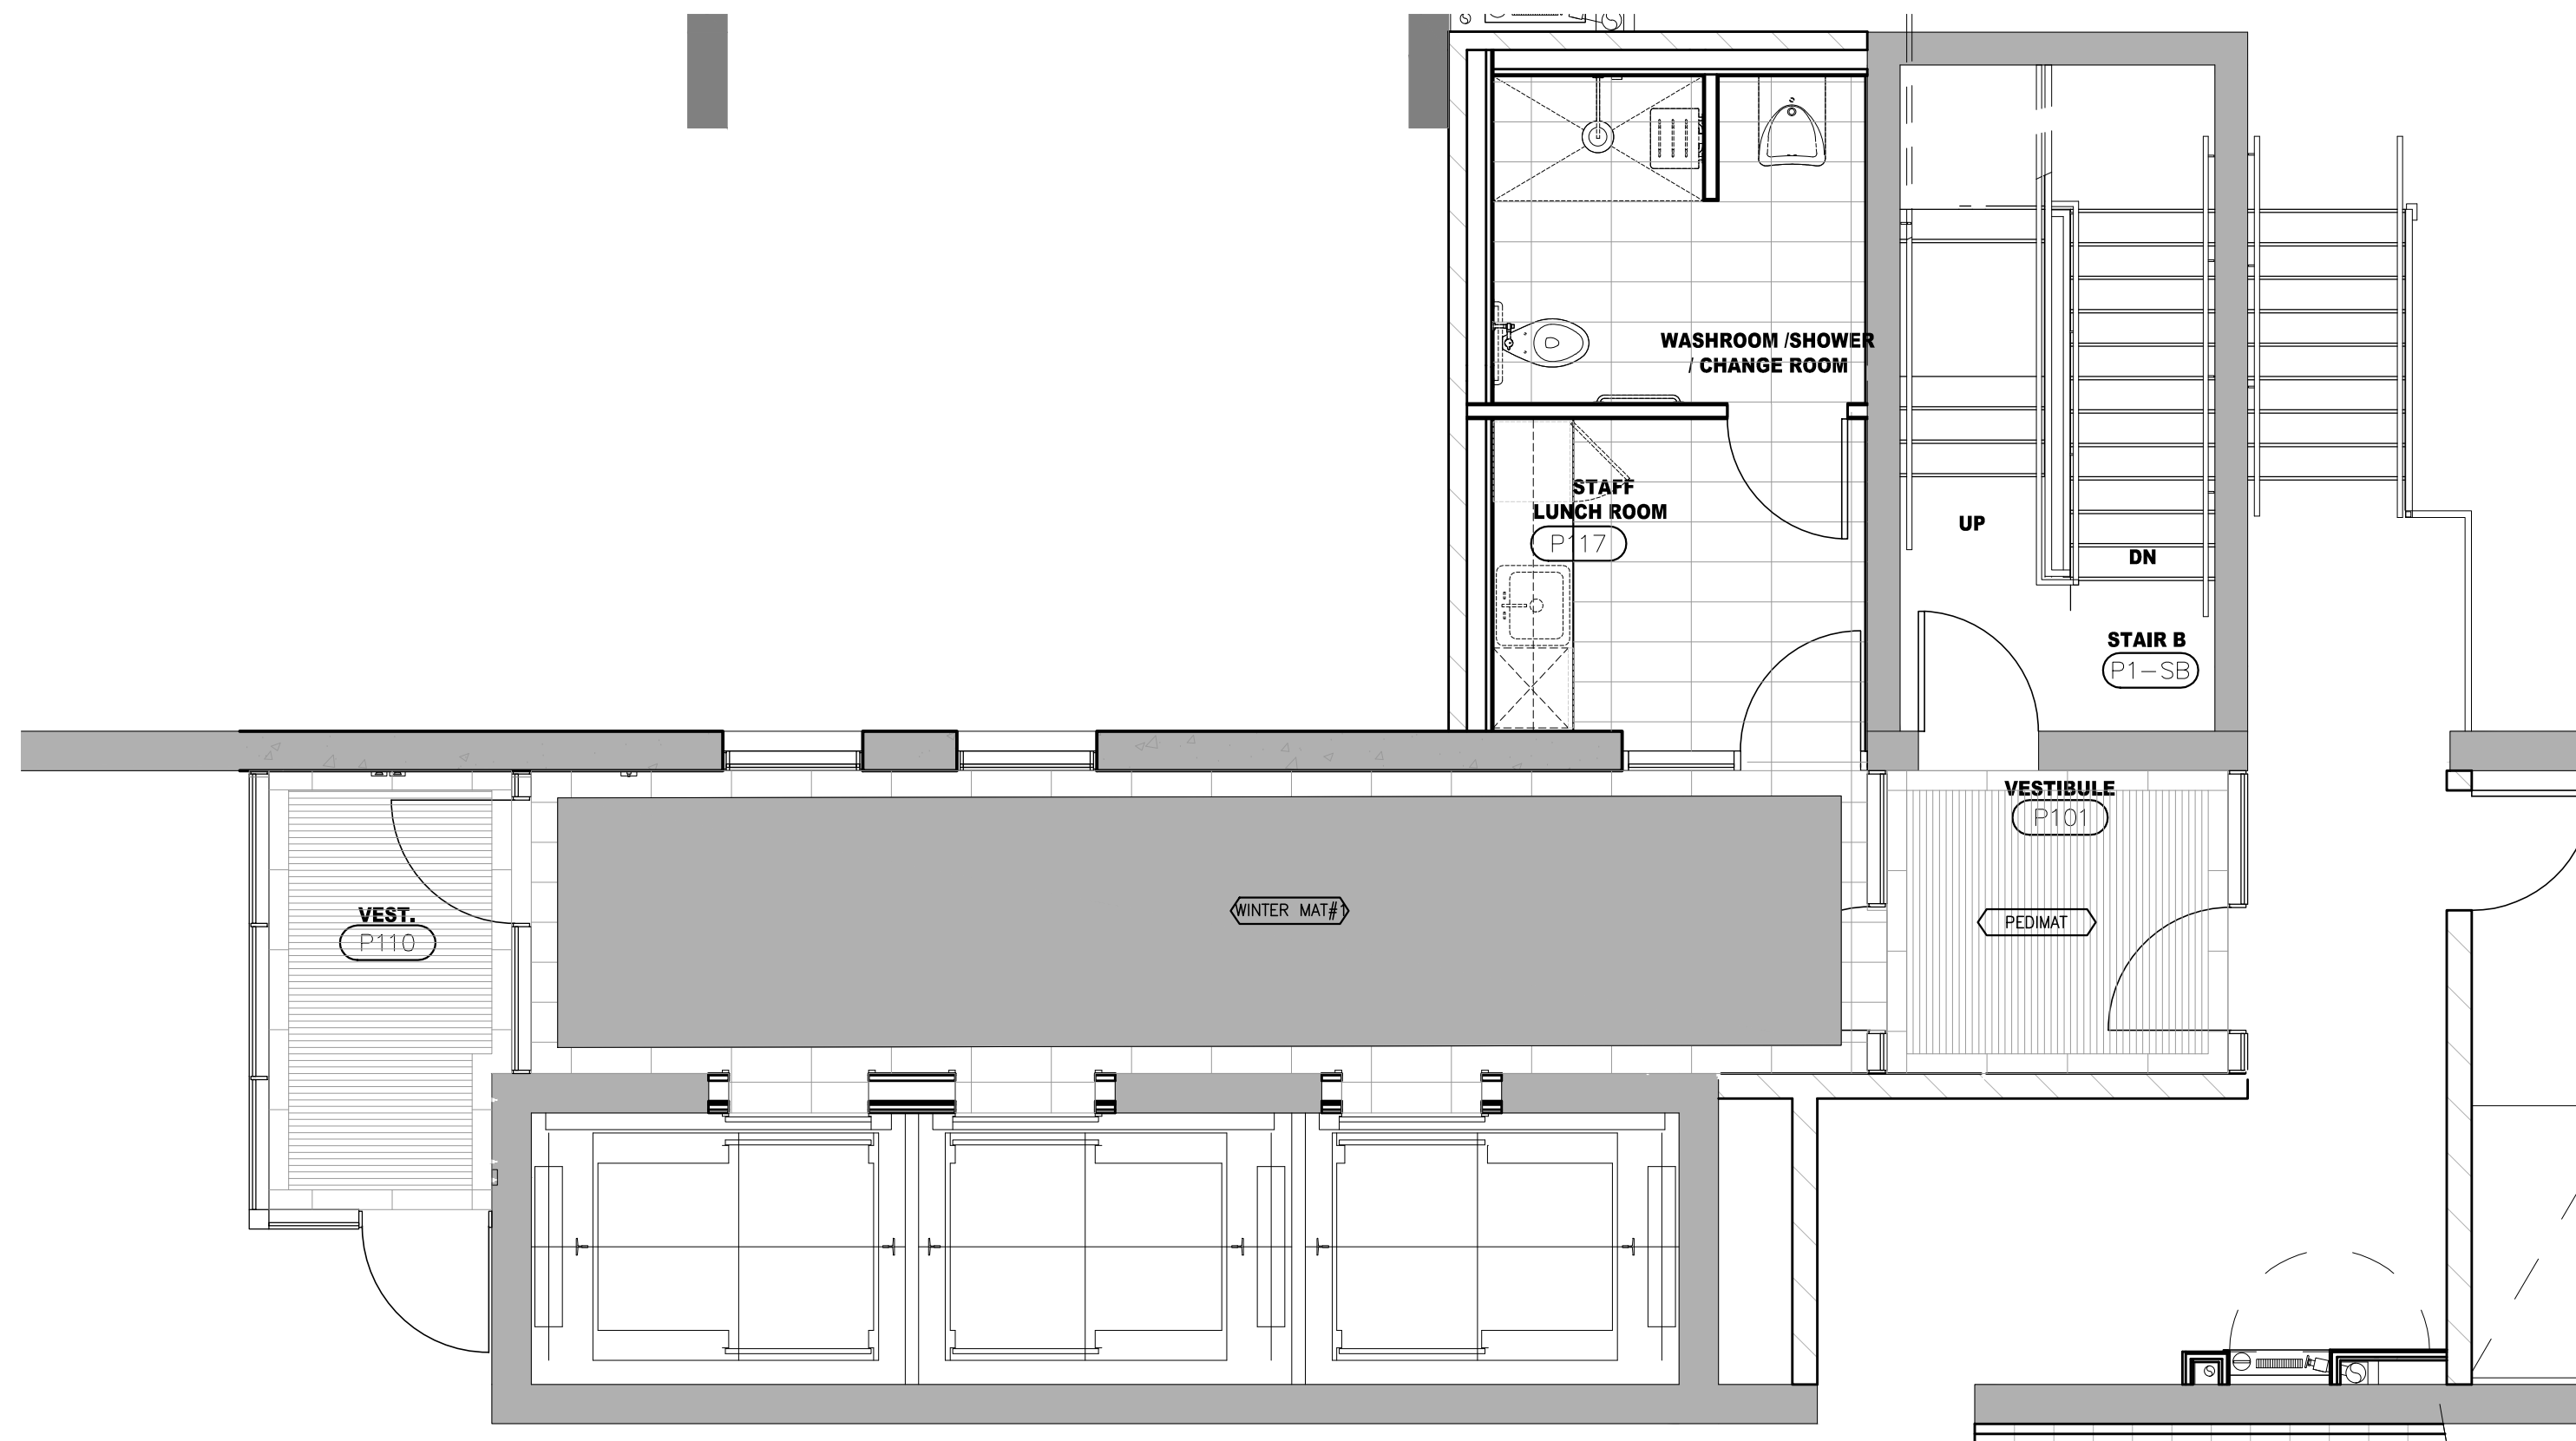

6 WINTER MATTING PLAN
P1 LEVEL
SCALE 1:50

DO NOT SCALE DRAWINGS.

CONTRACTOR MUST VERIFY ALL DRAWINGS, DIMENSIONS, DETAILS AND SPECIFICATIONS AND REPORT ANY DISCREPANCIES TO UNION 31 INC. BEFORE PROCEEDING WITH WORK. MATERIALS MAY NOT BE SUBSTITUTED WITHOUT WRITTEN APPROVAL FROM UNION 31 INC.

ALL DRAWINGS AND SPECIFICATIONS ARE INSTRUMENTS OF SERVICE AND THE PROPERTY OF UNION 31 INC. WHICH MUST BE RETURNED AT THE COMPLETION OF THE WORK.

PRINTED: 30-M8-17

ISSUED FOR
AS-BUILT


01	31 MAY / 17	ISSUED FOR AS-BUILT	SV
NO.	DATE	COMMENTS	INI

UNION31

UNION31 INC.
183 BATHURST STREET, STE. 201
TORONTO, ON, M5T 2R7, CANADA
TEL: 416-597-1576 FAX: 416-597-2139

PROJECT NAME:	ALEXANDRA PARK MAIN BUILDING
PROJECT NO.:	13-949
DRAWINGS:	GROUND FLOOR CONSTRUCTION PLAN

DATE STARTED:	07 AUG / 13	DRAWING NO.:	ID
SCALE:	1" = 50'	DRAWN BY:	AP
APPROVED BY:	KC	1.1.0	

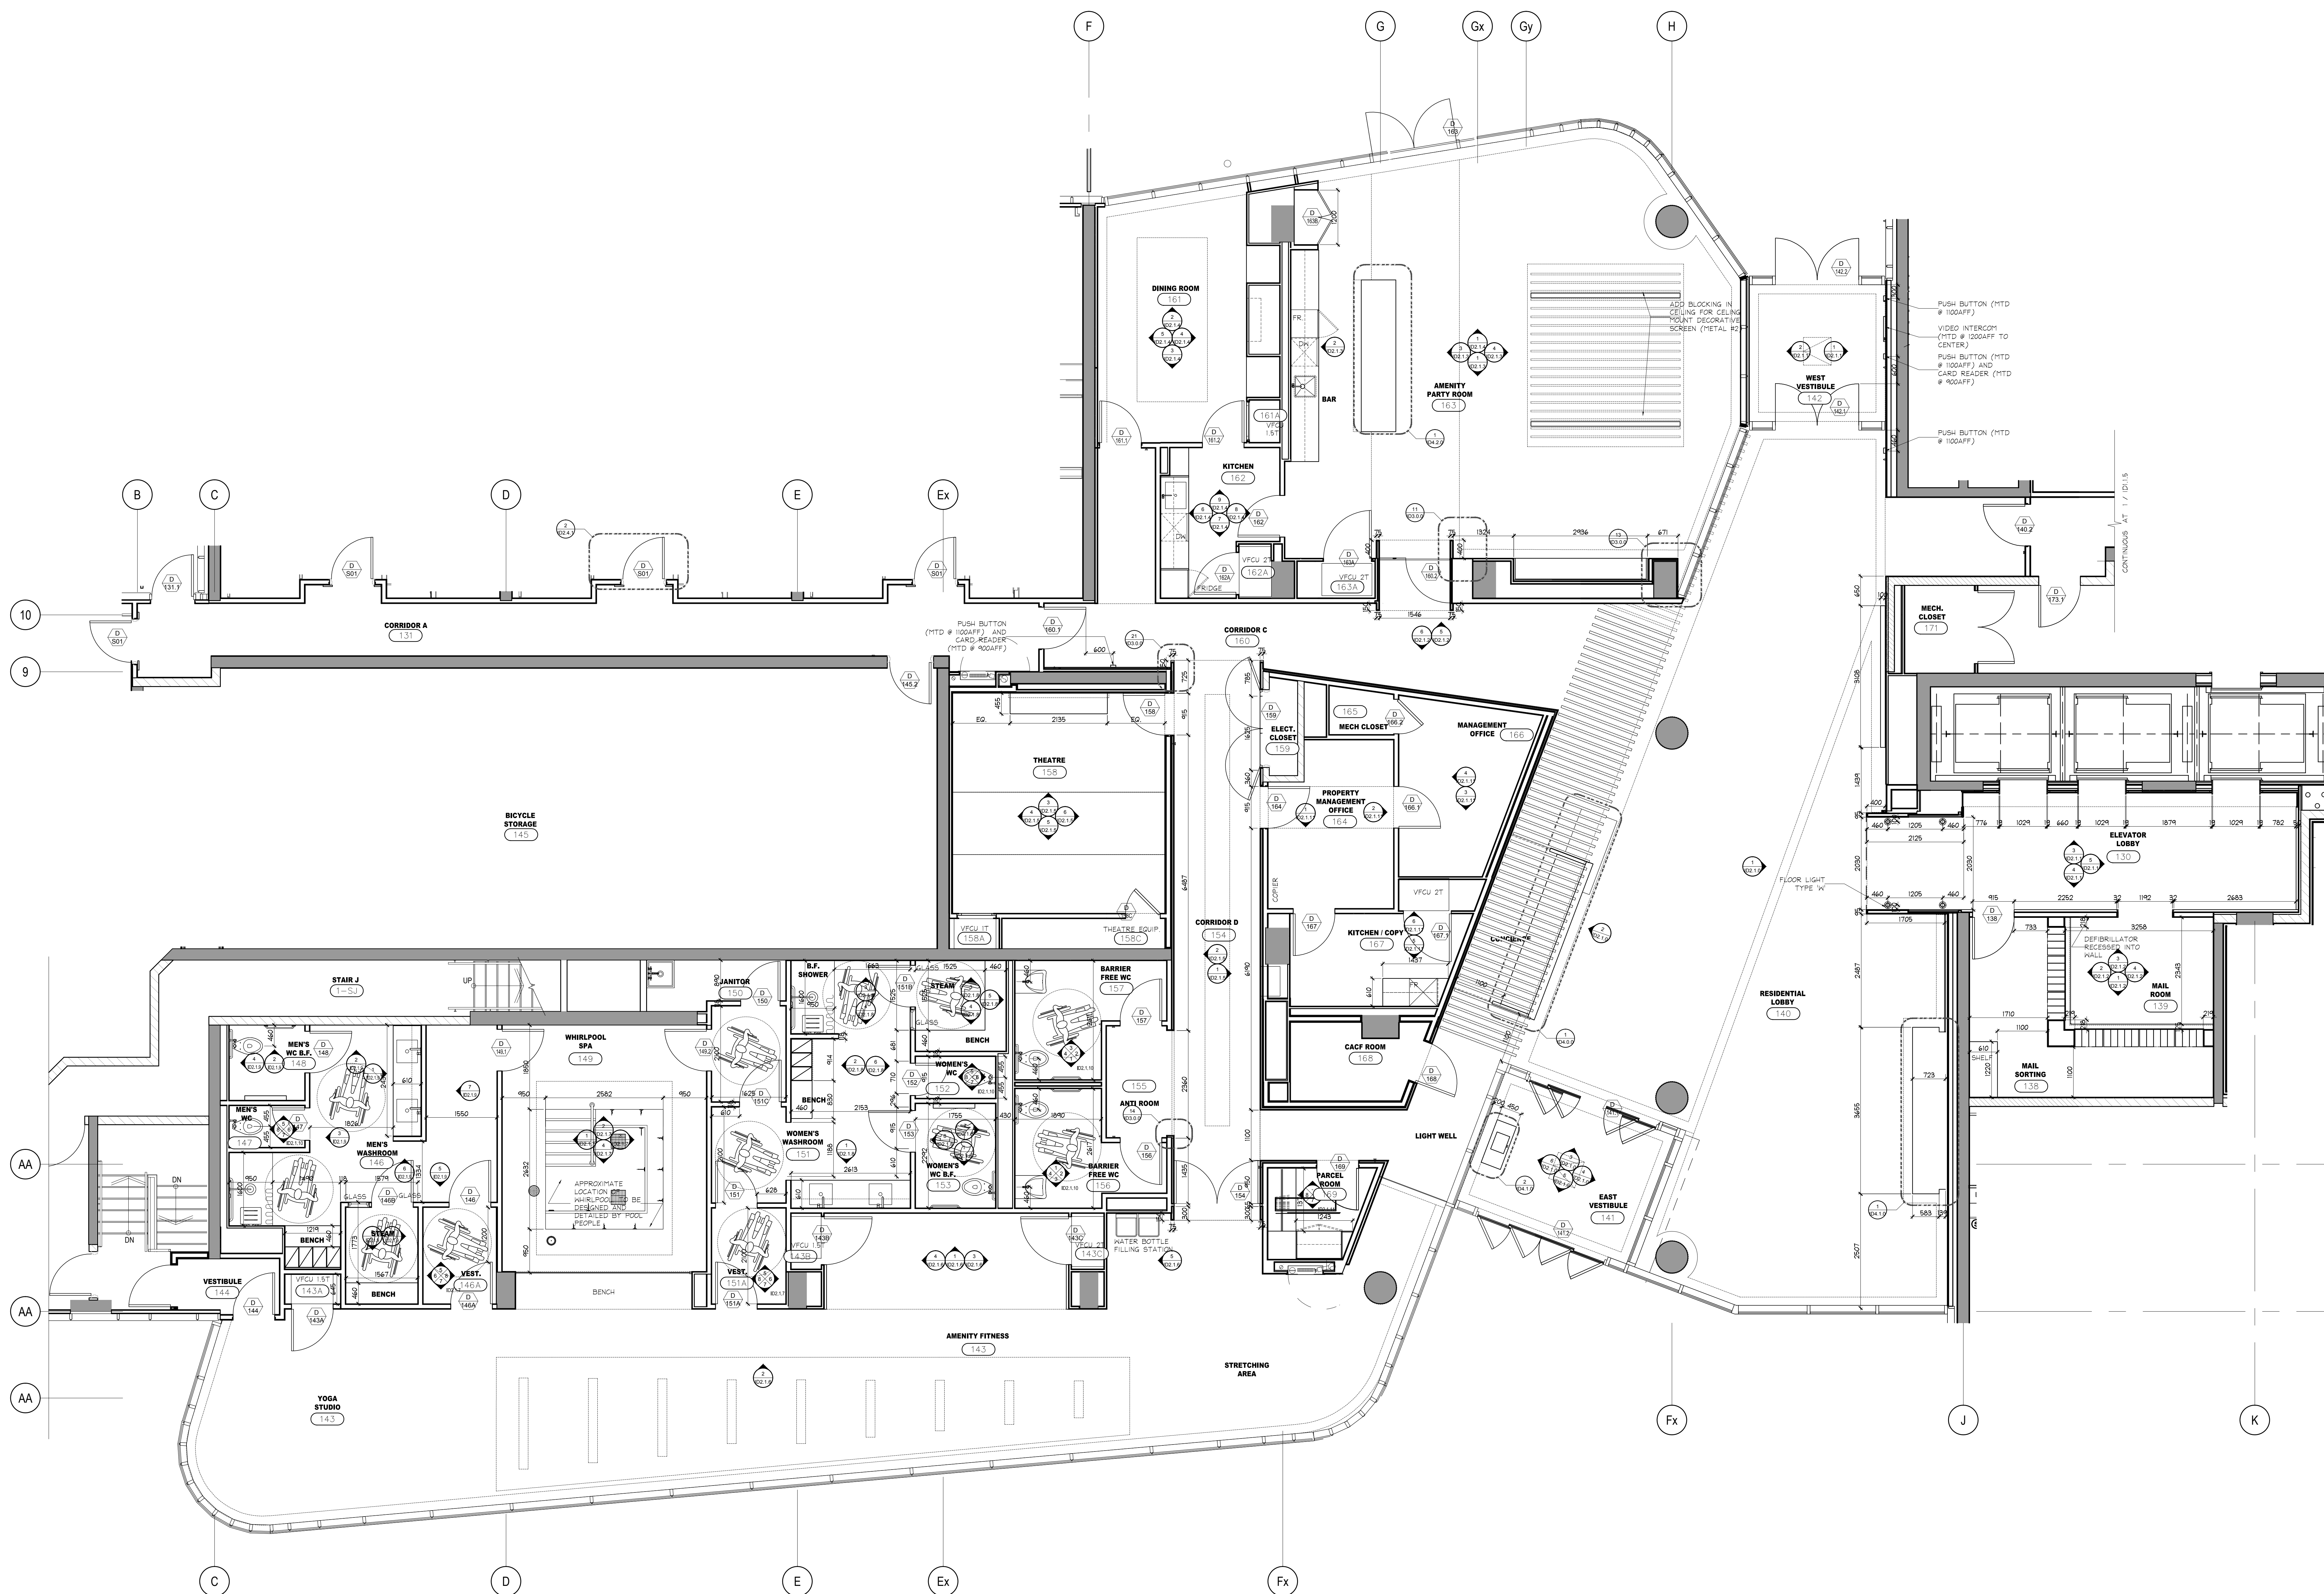

1 CONSTRUCTION PLAN
ID1.1.0 GROUND FLOOR SCALE 1/50

DO NOT SCALE DRAWINGS.

CONTRACTOR MUST VERIFY ALL DRAWINGS, DIMENSIONS, DETAILS AND SPECIFICATIONS AND REPORT ANY DISCREPANCIES TO UNION 31 INC. BEFORE PROCEEDING WITH WORK. MATERIALS MAY NOT BE SUBSTITUTED WITHOUT WRITTEN APPROVAL FROM UNION 31 INC.

ALL DRAWINGS AND SPECIFICATIONS ARE INSTRUMENTS OF SERVICE AND THE PROPERTY OF UNION 31 INC. WHICH MUST BE RETURNED AT THE COMPLETION OF THE WORK.

PRINTED: 30-Mar-17

ISSUED FOR
AS-BUILT

01	31 MAY / 17	ISSUED FOR AS-BUILT	SV
NO.	DATE	COMMENTS	INI

UNION31

UNION31 INC.
183 BATHURST STREET, STE. 201
TORONTO, ON, M5T 2R7, CANADA
TEL: 416-597-1576 FAX: 416-597-2139


PROJECT NAME:
**ALEXANDRA PARK
MAIN BUILDING**
BLOCK 11
ON, Canada

PROJECT NO.:
13-949

DRAWINGS:

GROUND FLOOR
REFLECTED CEILING PLAN

DATE STARTED: 07 AUG / 13	DRAWING NO.:
SCALE: 1" = 50'	ID
DRAWN BY: AP	1.1.1
APPROVED BY: KC	

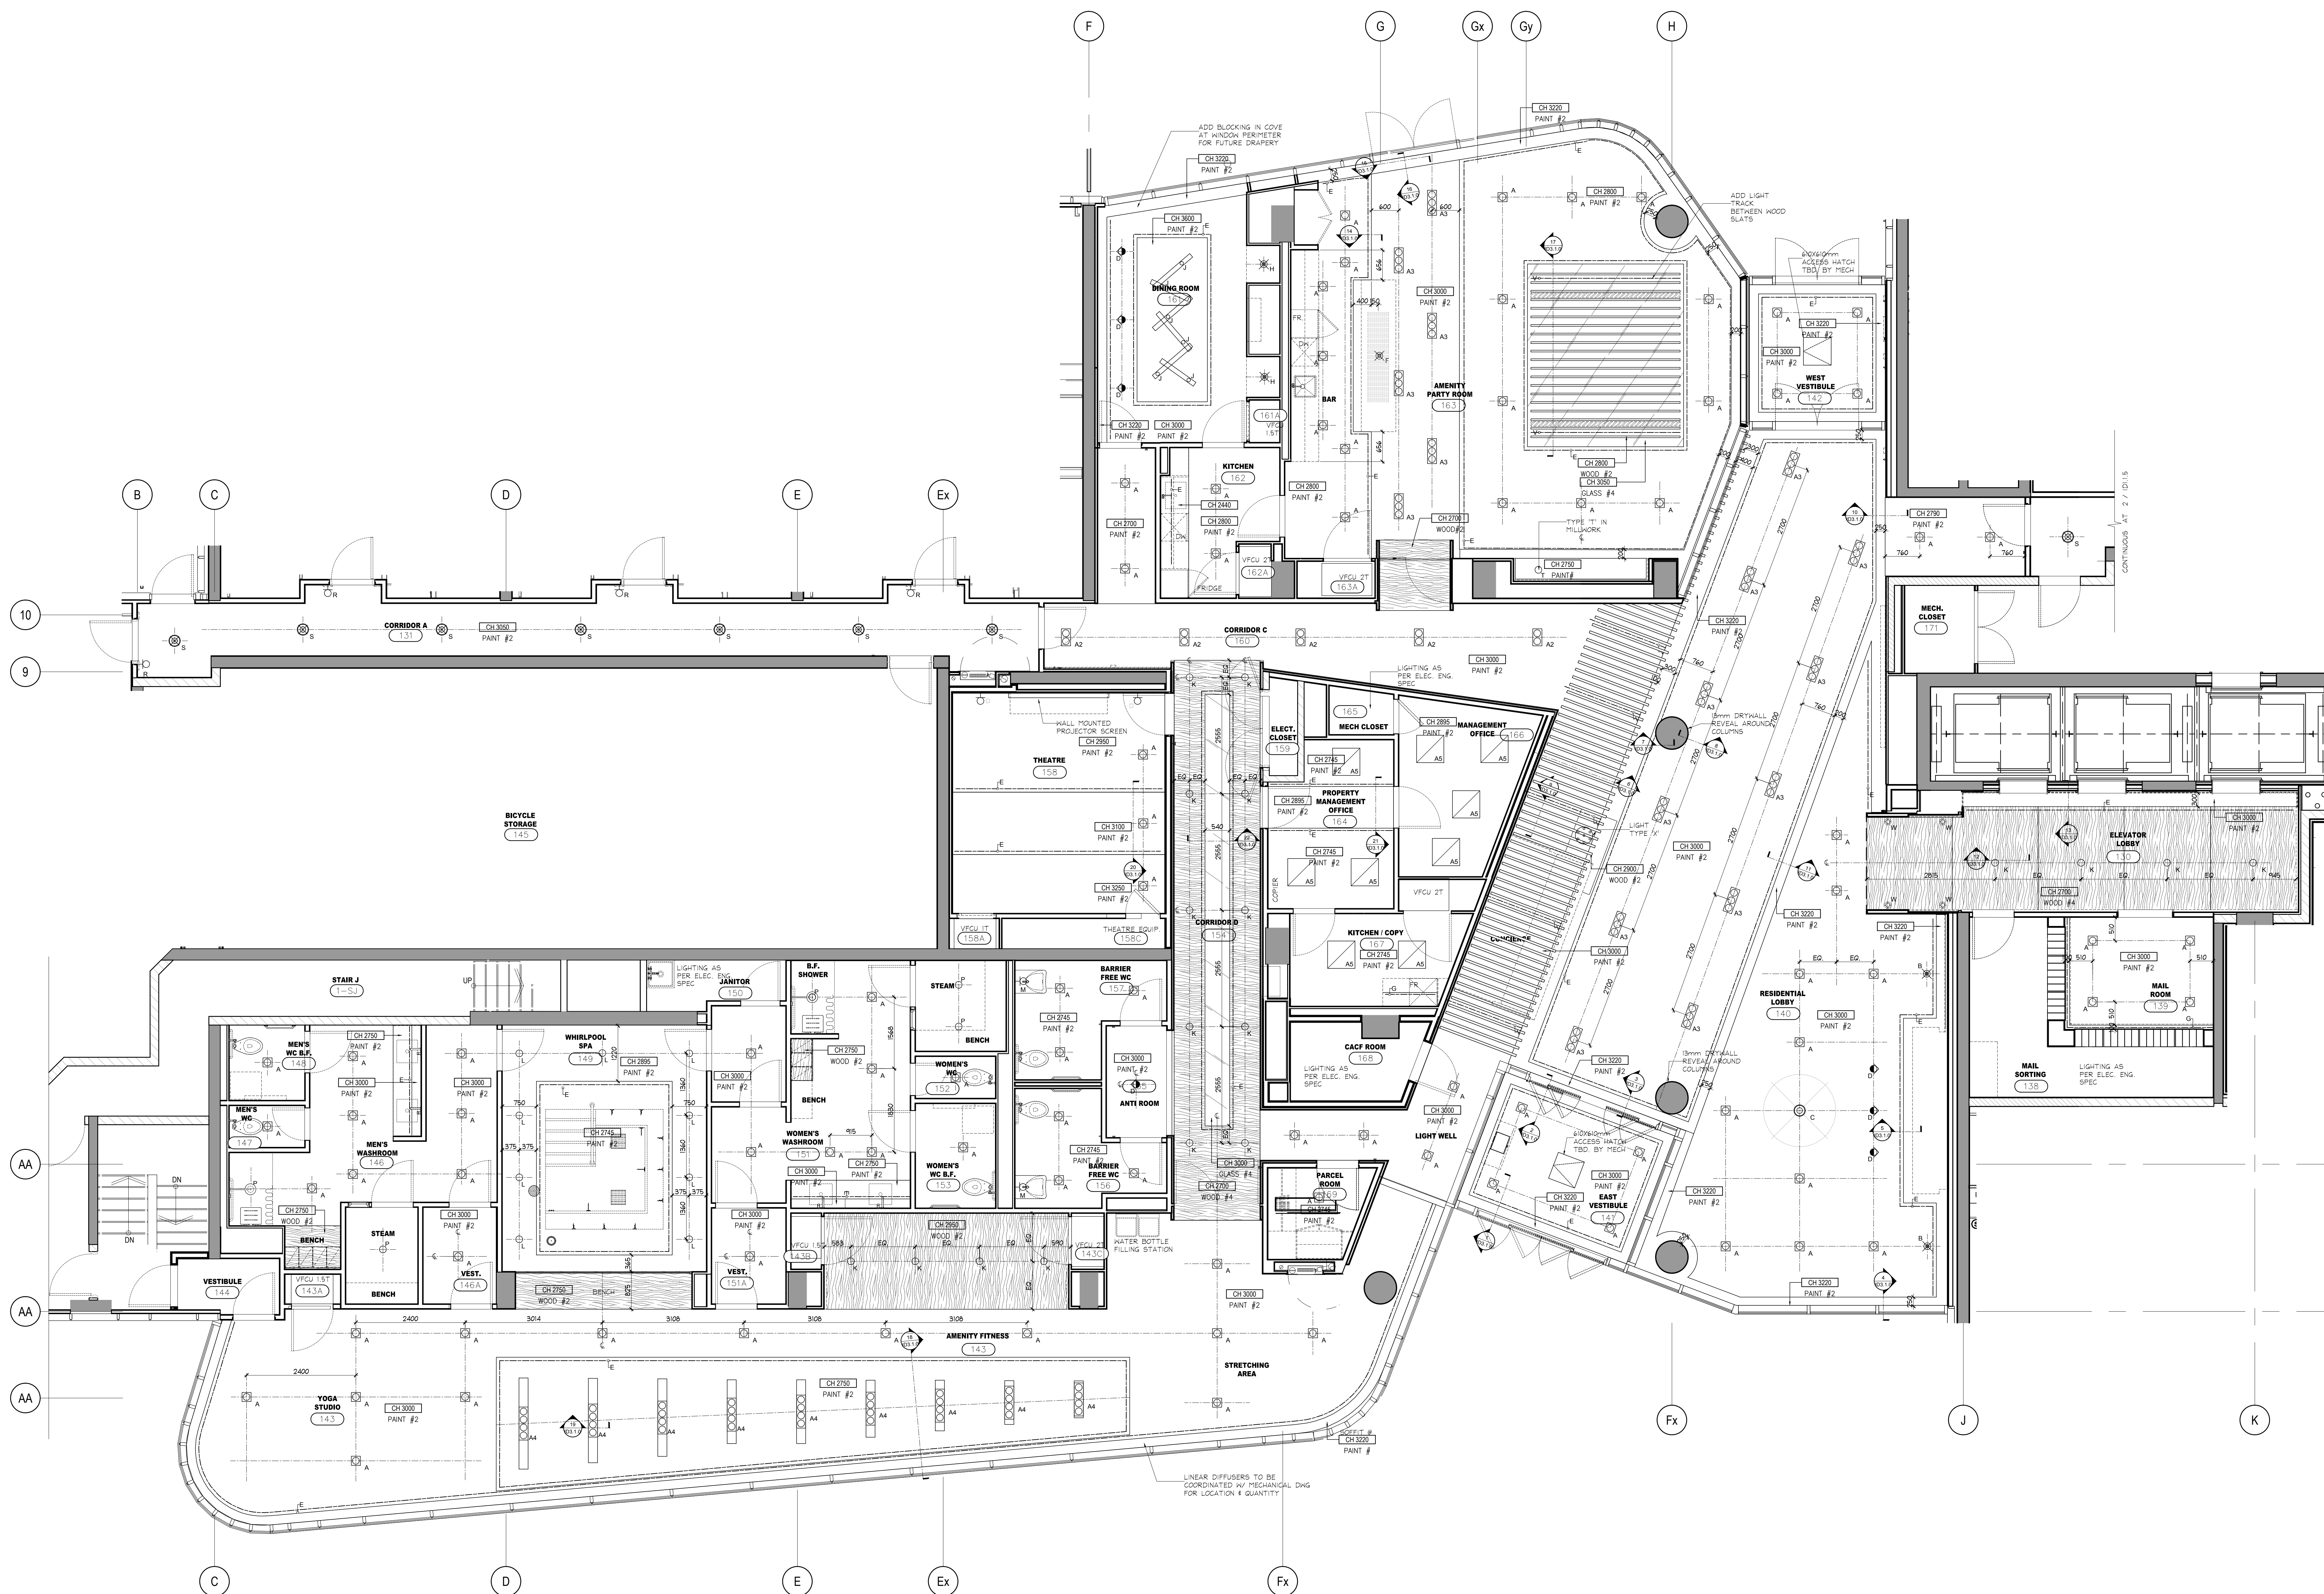

1 REFLECTED CEILING PLAN
ID1.1.1 GROUND FLOOR SCALE 1:50

DO NOT SCALE DRAWINGS.

CONTRACTOR MUST VERIFY ALL DRAWINGS, DIMENSIONS, DETAILS AND SPECIFICATIONS AND REPORT ANY DISCREPANCIES TO UNION 31 INC. BEFORE PROCEEDING WITH WORK. MATERIALS MAY NOT BE SUBSTITUTED WITHOUT WRITTEN APPROVAL FROM UNION 31 INC.

ALL DRAWINGS AND SPECIFICATIONS ARE INSTRUMENTS OF SERVICE AND THE PROPERTY OF UNION 31 INC. WHICH MUST BE RETURNED AT THE COMPLETION OF THE WORK.

PRINTED: 19-Sep-17


ISSUED FOR
AS-BUILT

01	31 MAY / 17	ISSUED FOR AS-BUILT	SV
NO.	DATE	COMMENTS	INI
REVISIONS:			

UNION 31

UNION31 INC.
183 BATHURST STREET, STE. 201
TORONTO, ON, M5T 2R7, CANADA
TEL: 416-597-1576 FAX: 416-597-2139

PROJECT NAME:		ALEXANDRA PARK MAIN BUILDING	
PROJECT NO.:		13-949	
DRAWINGS:		GROUND FLOOR FURNITURE & POWER PLAN	
DATE STARTED:	07 AUG / 13	DRAWING NO.:	ID
SCALE:	1 : 50	DRAWN BY:	AP
APPROVED BY:	KC	1.1.2	

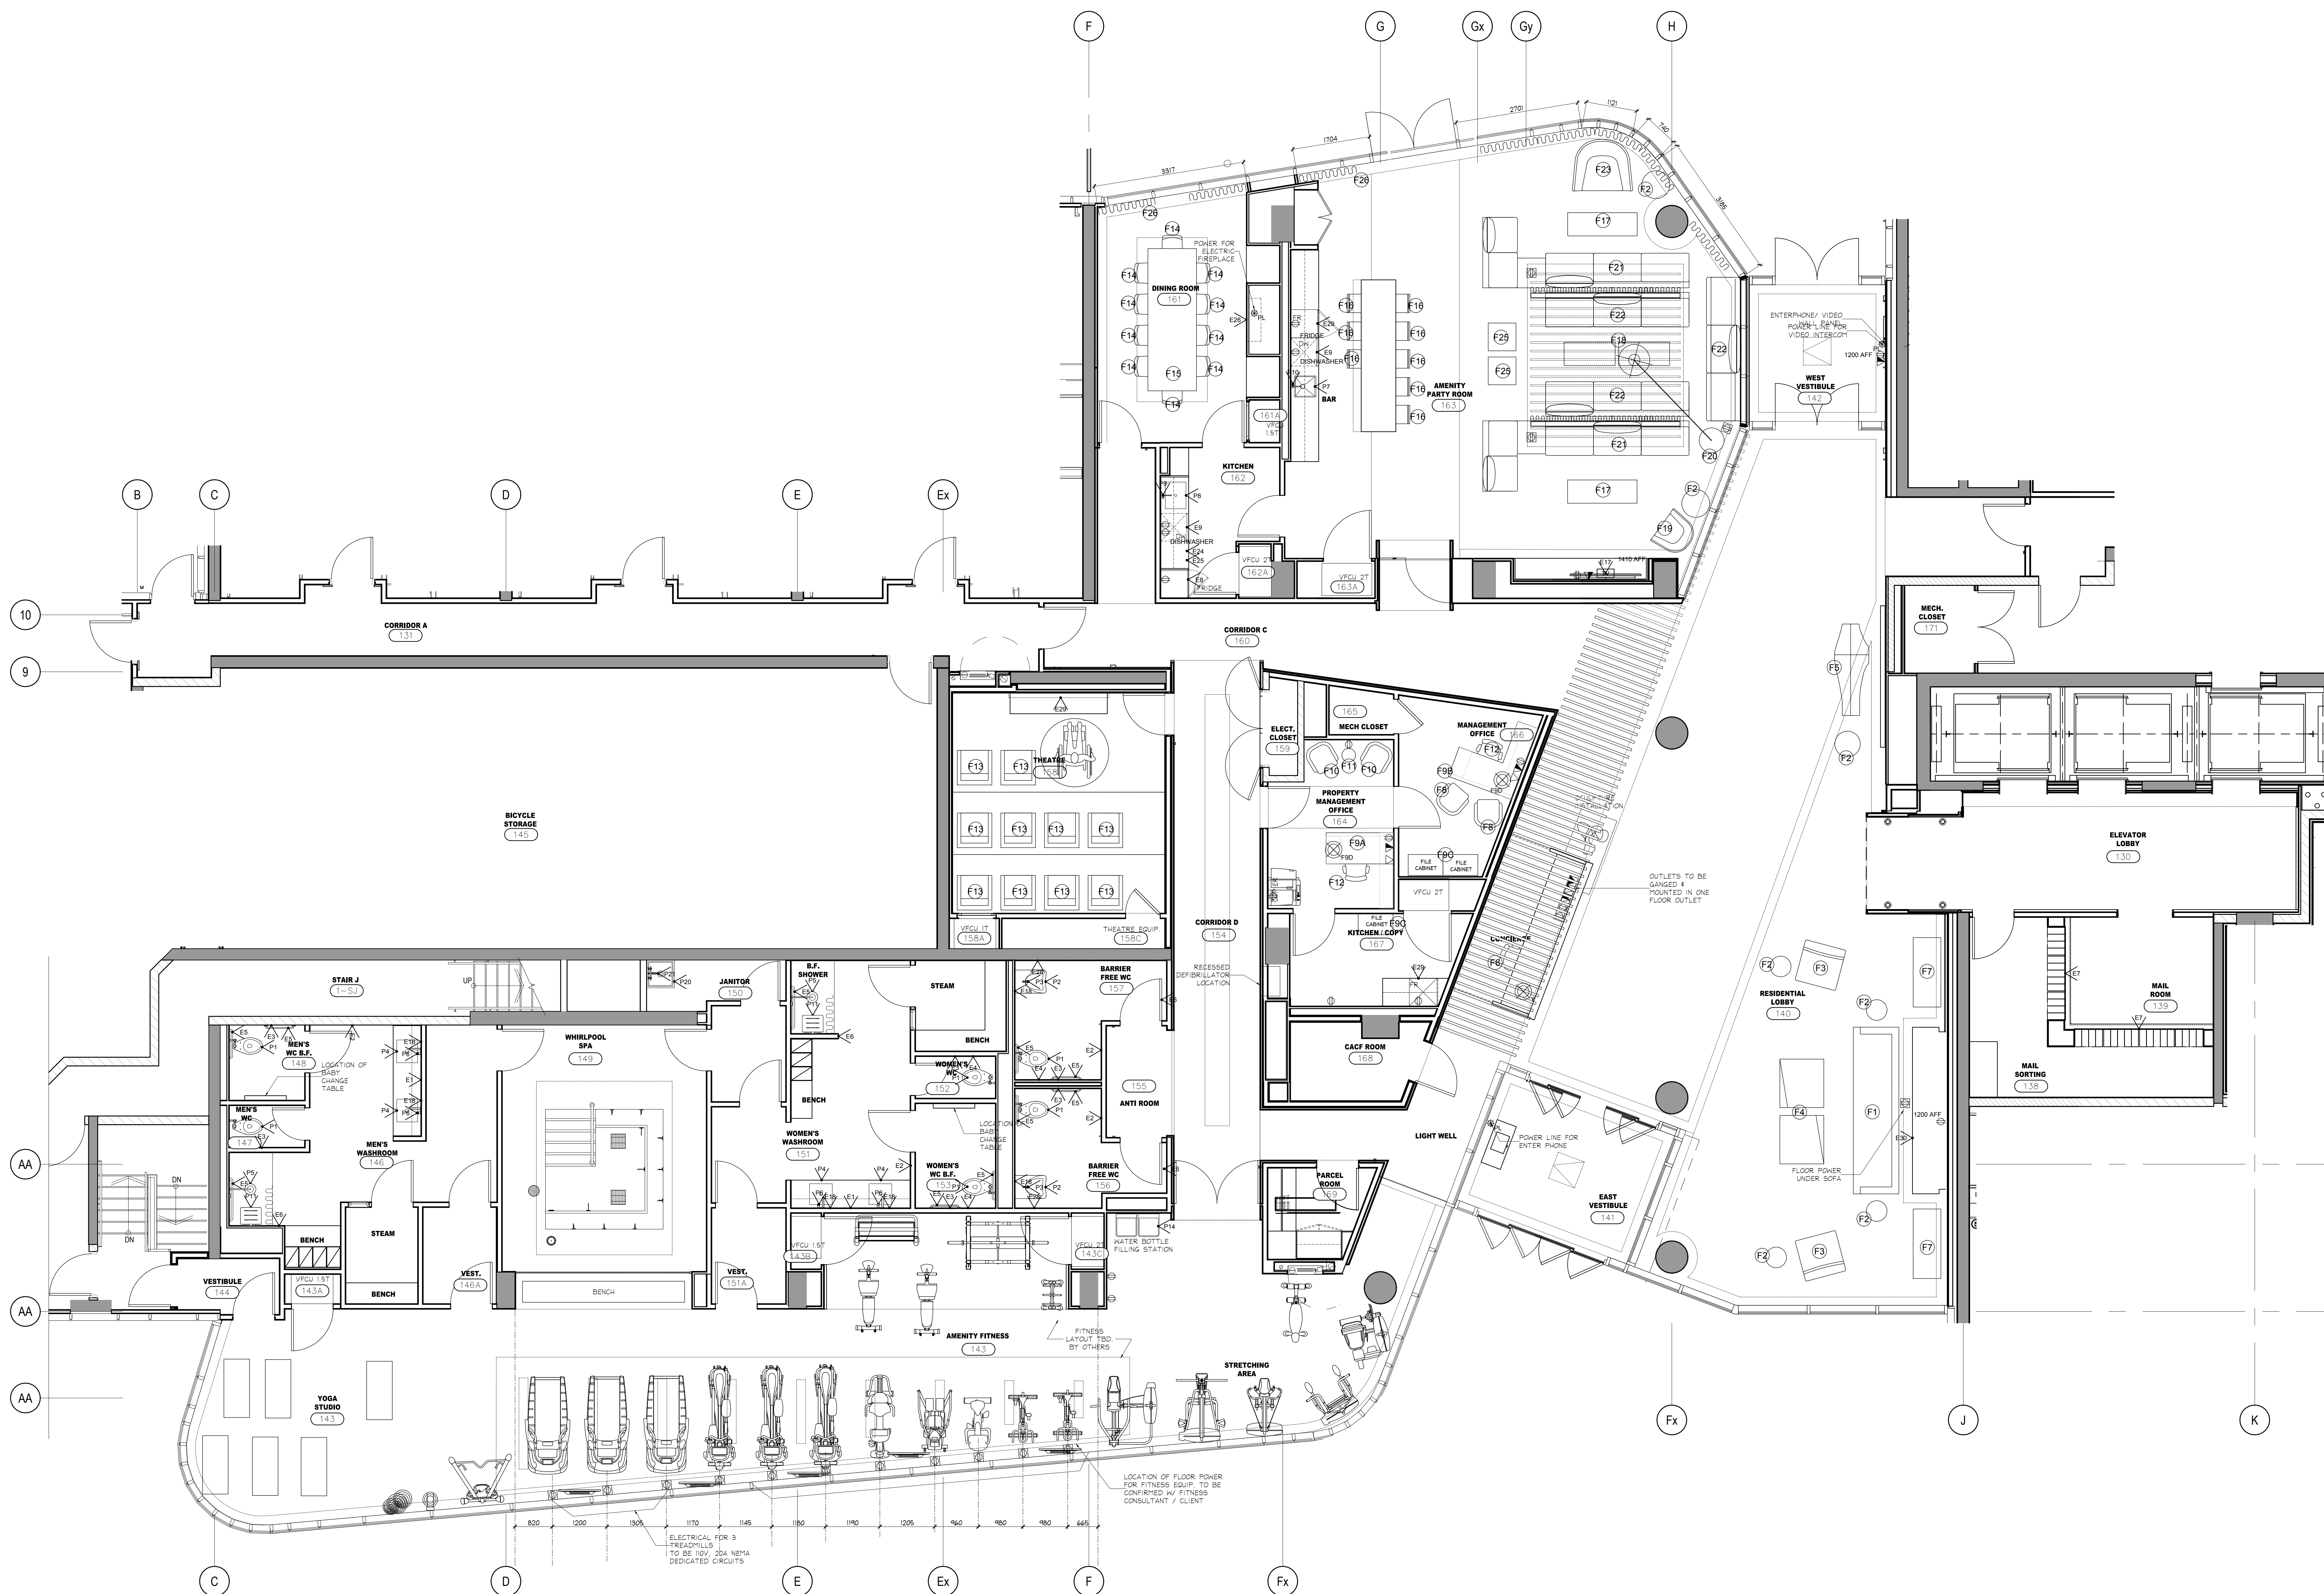

1 FURNITURE & POWER PLAN
ID1.1.2 GROUND FLOOR SCALE 1:50

DO NOT SCALE DRAWINGS.

CONTRACTOR MUST VERIFY ALL DRAWINGS, DIMENSIONS, DETAILS AND SPECIFICATIONS AND REPORT ANY DISCREPANCIES TO UNION 31 INC. BEFORE PROCEEDING WITH WORK. MATERIALS MAY NOT BE SUBSTITUTED WITHOUT WRITTEN APPROVAL FROM UNION 31 INC.

ALL DRAWINGS AND SPECIFICATIONS ARE INSTRUMENTS OF SERVICE AND THE PROPERTY OF UNION 31 INC. WHICH MUST BE RETURNED AT THE COMPLETION OF THE WORK.

PRINTED: 30-MAR-17


ISSUED FOR
AS-BUILT

01	31 MAY / 17	ISSUED FOR AS-BUILT	SV
NO.	DATE	COMMENTS	INI
REVISIONS:			

UNION31

UNION31 INC.
183 BATHURST STREET, STE. 201
TORONTO, ON, M5T 2R7, CANADA
TEL: 416-597-1576 FAX: 416-597-2139

PROJECT NAME:		ALEXANDRA PARK MAIN BUILDING	
PROJECT NO.:		13-949	
DRAWINGS:		GROUND FLOOR FLOOR FINISHES PLAN	
DATE STARTED:	07 AUG / 13	DRAWING NO.:	ID
SCALE:	1 : 50	DRAWN BY:	AP
APPROVED BY:	KC	REVISIONS:	1.1.3

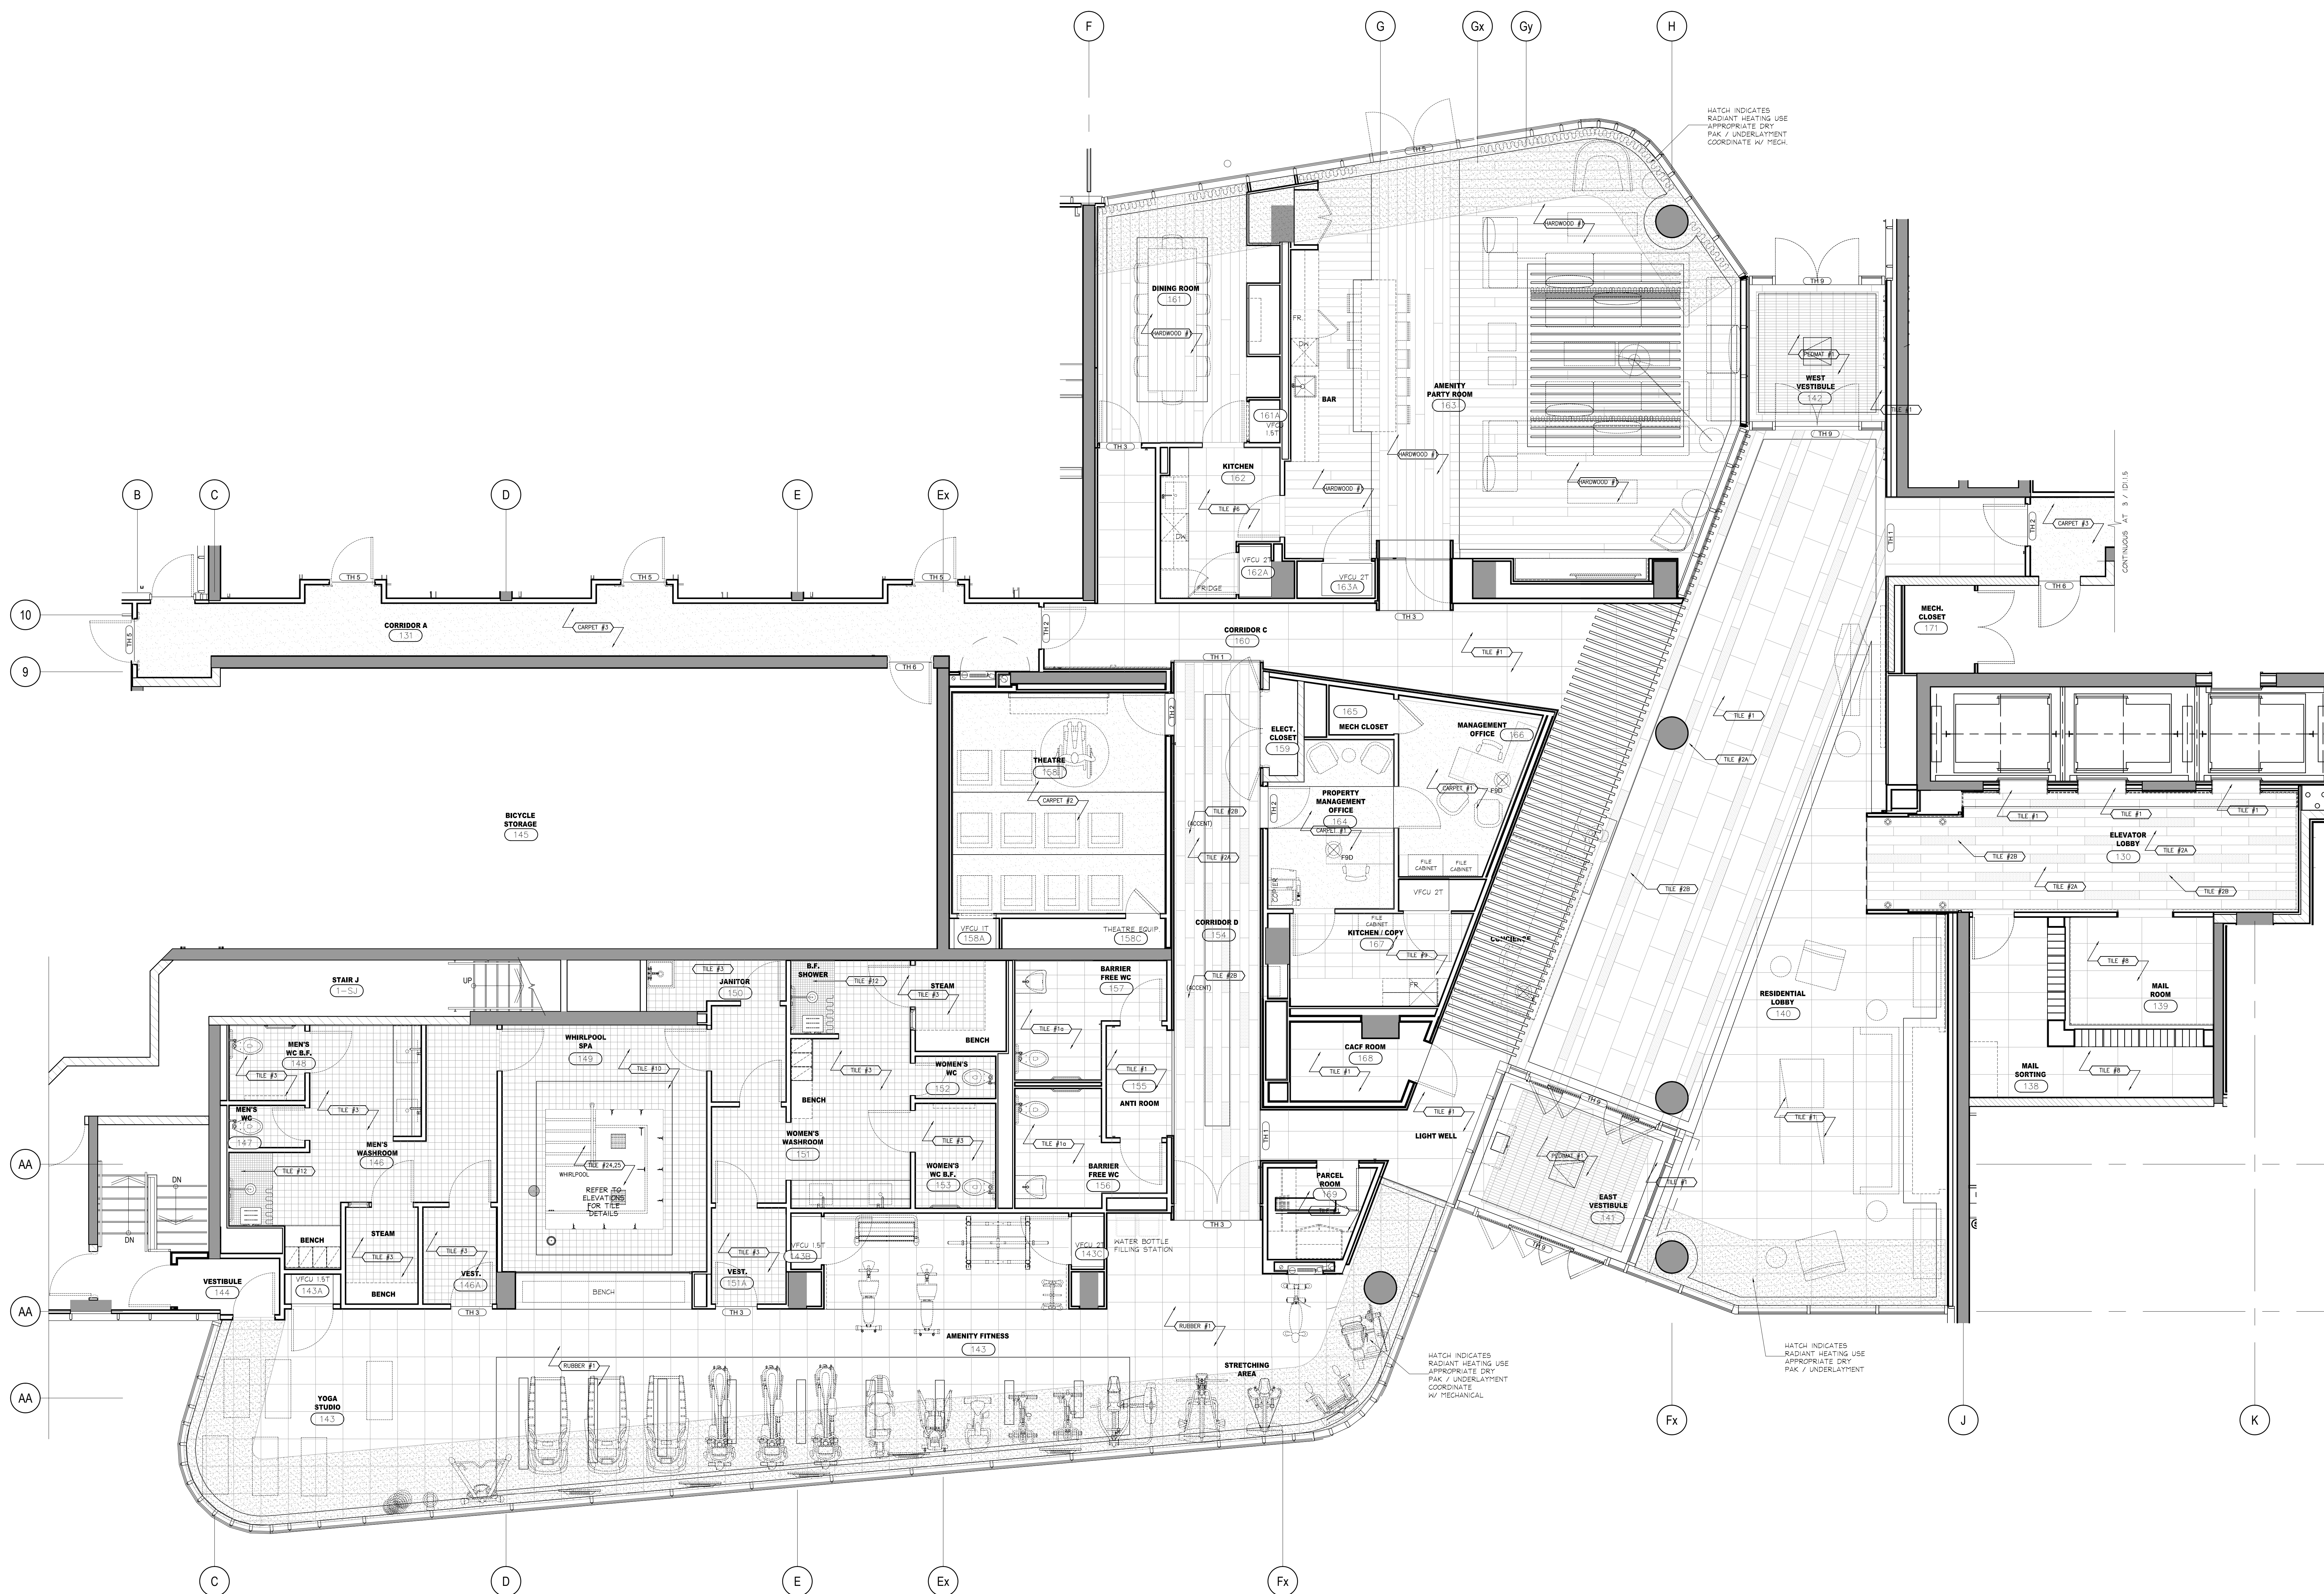

1 FLOOR FINISHES PLAN
ID1.1.3 GROUND FLOOR SCALE 1:50

DO NOT SCALE DRAWINGS.

CONTRACTOR MUST VERIFY ALL DRAWINGS, DIMENSIONS, DETAILS AND SPECIFICATIONS. AND REPORT ANY DISCREPANCIES TO UNION 31 INC. BEFORE PROCEEDING WITH WORK. MATERIALS MAY NOT BE SUBSTITUTED WITHOUT WRITTEN APPROVAL FROM UNION 31 INC.

ALL DRAWINGS AND SPECIFICATIONS ARE INSTRUMENTS OF SERVICE AND THE PROPERTY OF UNION 31 INC. WHICH MUST BE RETURNED AT THE COMPLETION OF THE WORK.

PRINTED: 30-May-17


ISSUED FOR
AS-BUILT

01	31 MAY / 17	ISSUED FOR AS-BUILT	SV
NO.	DATE	COMMENTS	INI

UNION31

UNION31 INC.
183 BATHURST STREET, STE. 201
TORONTO, ON, M5T 2R7, CANADA
TEL: 416-597-1576 FAX: 416-597-2139

PROJECT NAME:		ALEXANDRA PARK MAIN BUILDING
PROJECT NO.:		13-949
DRAWINGS:		GROUND FLOOR WALL FINISHES PLAN
DATE STARTED:	07 AUG / 13	DRAWING NO.:
SCALE:	1" = 50'	ID
DRAWN BY:	AP	1.1.4
APPROVED BY:	KC	

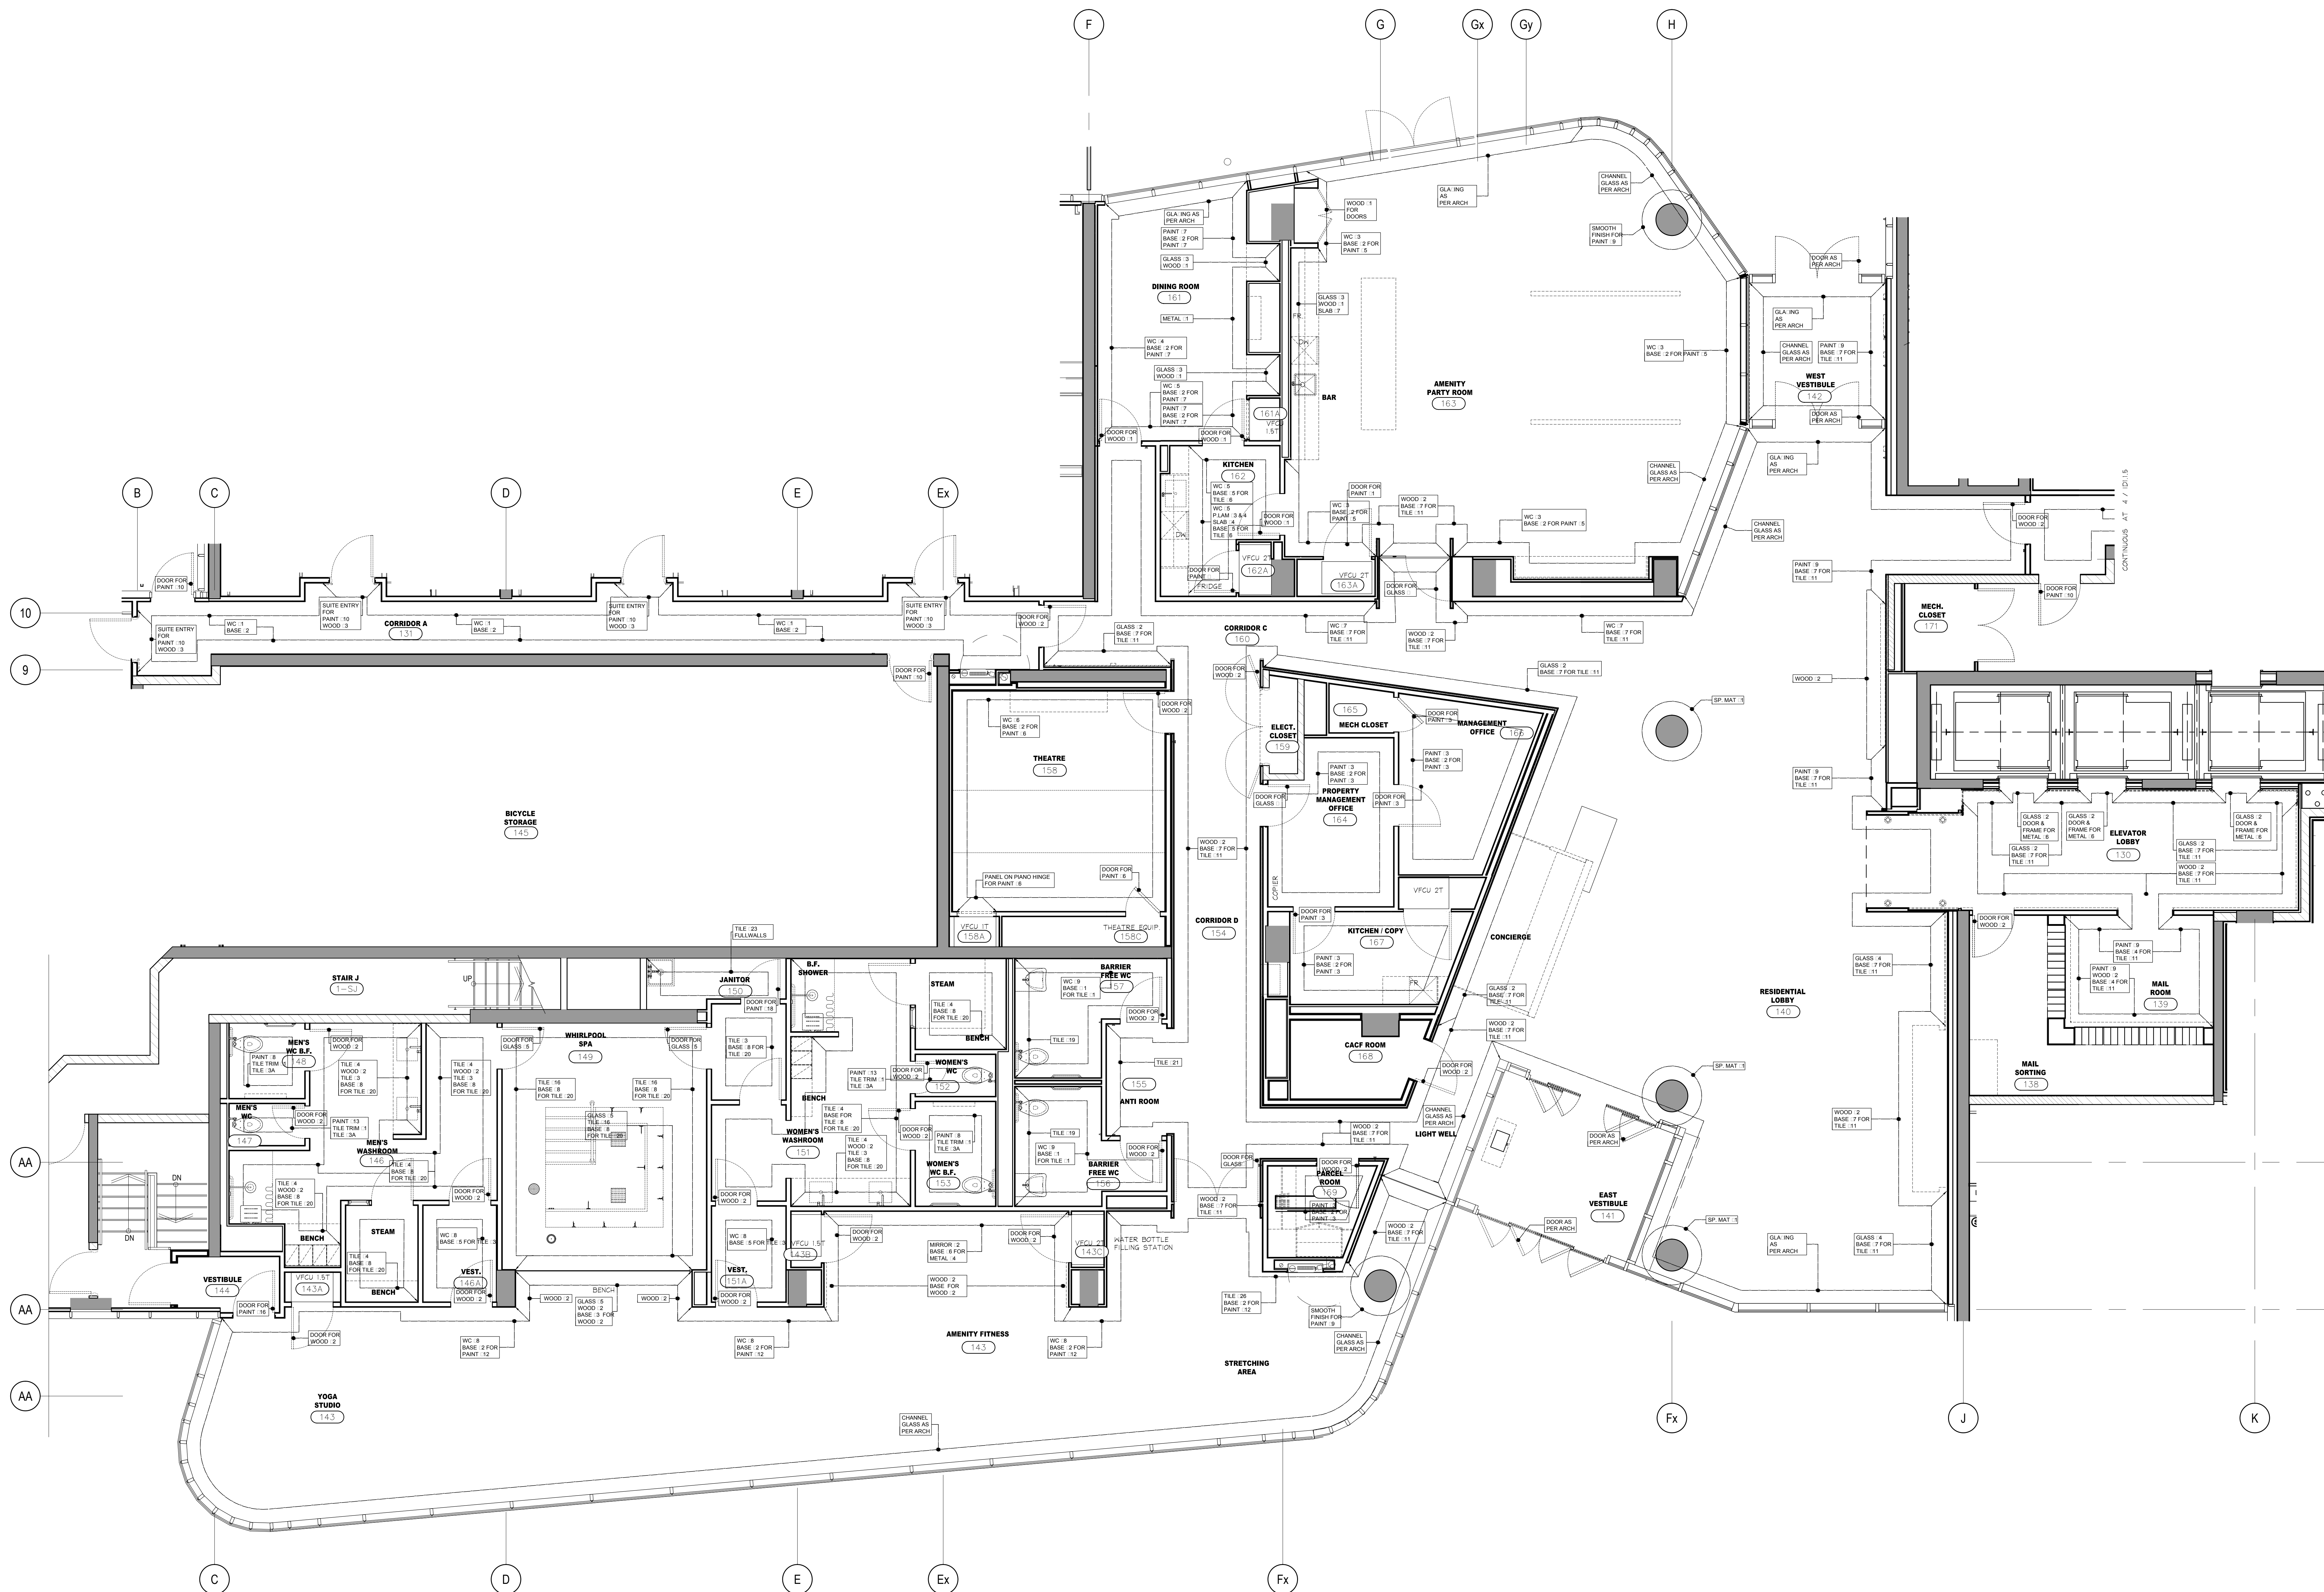

1 WALL FINISHES PLAN
GROUND FLOOR
SCALE 1:50

CONTRACTOR MUST VERIFY ALL DRAWINGS, DIMENSIONS, DETAILS AND SPECIFICATIONS, AND REPORT ANY DISCREPANCIES TO UNION 31 INC. BEFORE PROCEEDING WITH WORK. MATERIALS MAY NOT BE SUBSTITUTED WITHOUT WRITTEN APPROVAL FROM UNION 31 INC.


ALL DRAWINGS AND SPECIFICATIONS ARE INSTRUMENTS OF SERVICE AND THE PROPERTY OF UNION 31 INC. WHICH MUST BE RETURNED AT THE COMPLETION OF THE WORK.


ISSUED FOR
AS-BUILT

NO3

PROJECT NAME:	
ALEXANDRA PARK MAIN BUILDING	
BLOCK 11 ON, Canada	
PROJECT NO.:	13-949
DRAWING(S):	
GROUND FLOOR / CORRIDOR CONSTRUCTION PLAN & REFLECTED CEILING PLAN FLOOR & WALL FINISHES PLANS	

DATE STARTED: 07 AUG / 13	DRAWING NO.: ID 1.1.5
SCALE: 1 : 50	
DRAWN BY: AP	
APPROVED BY: KC	

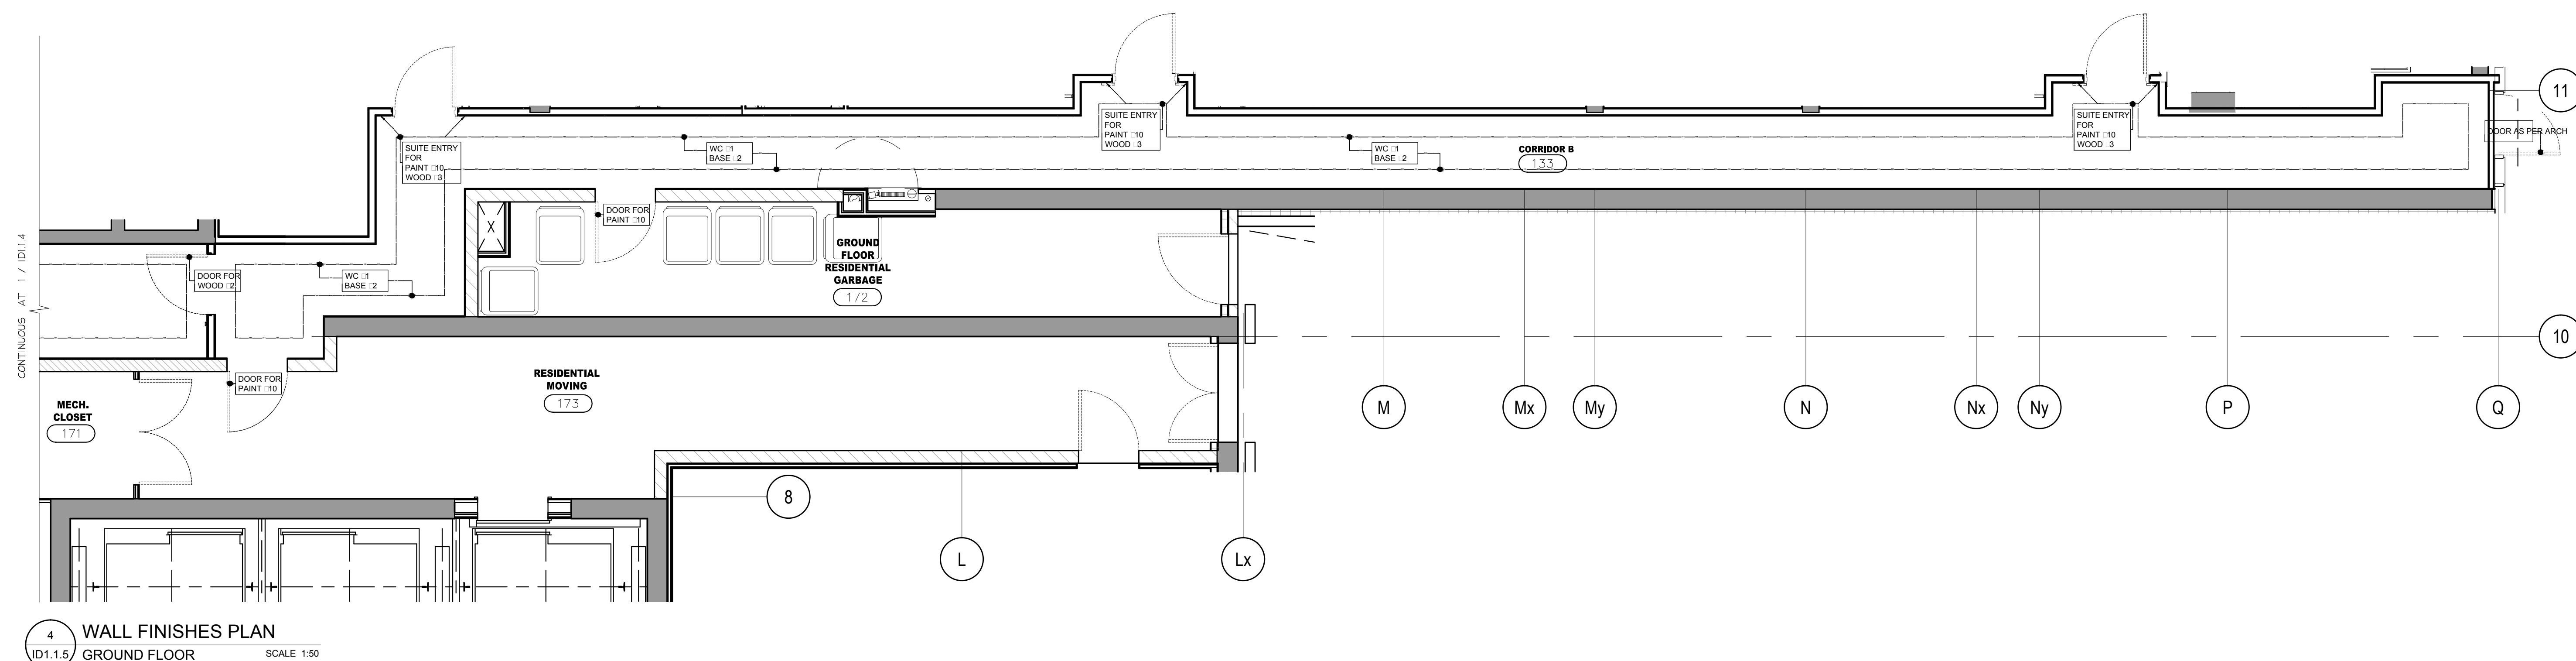

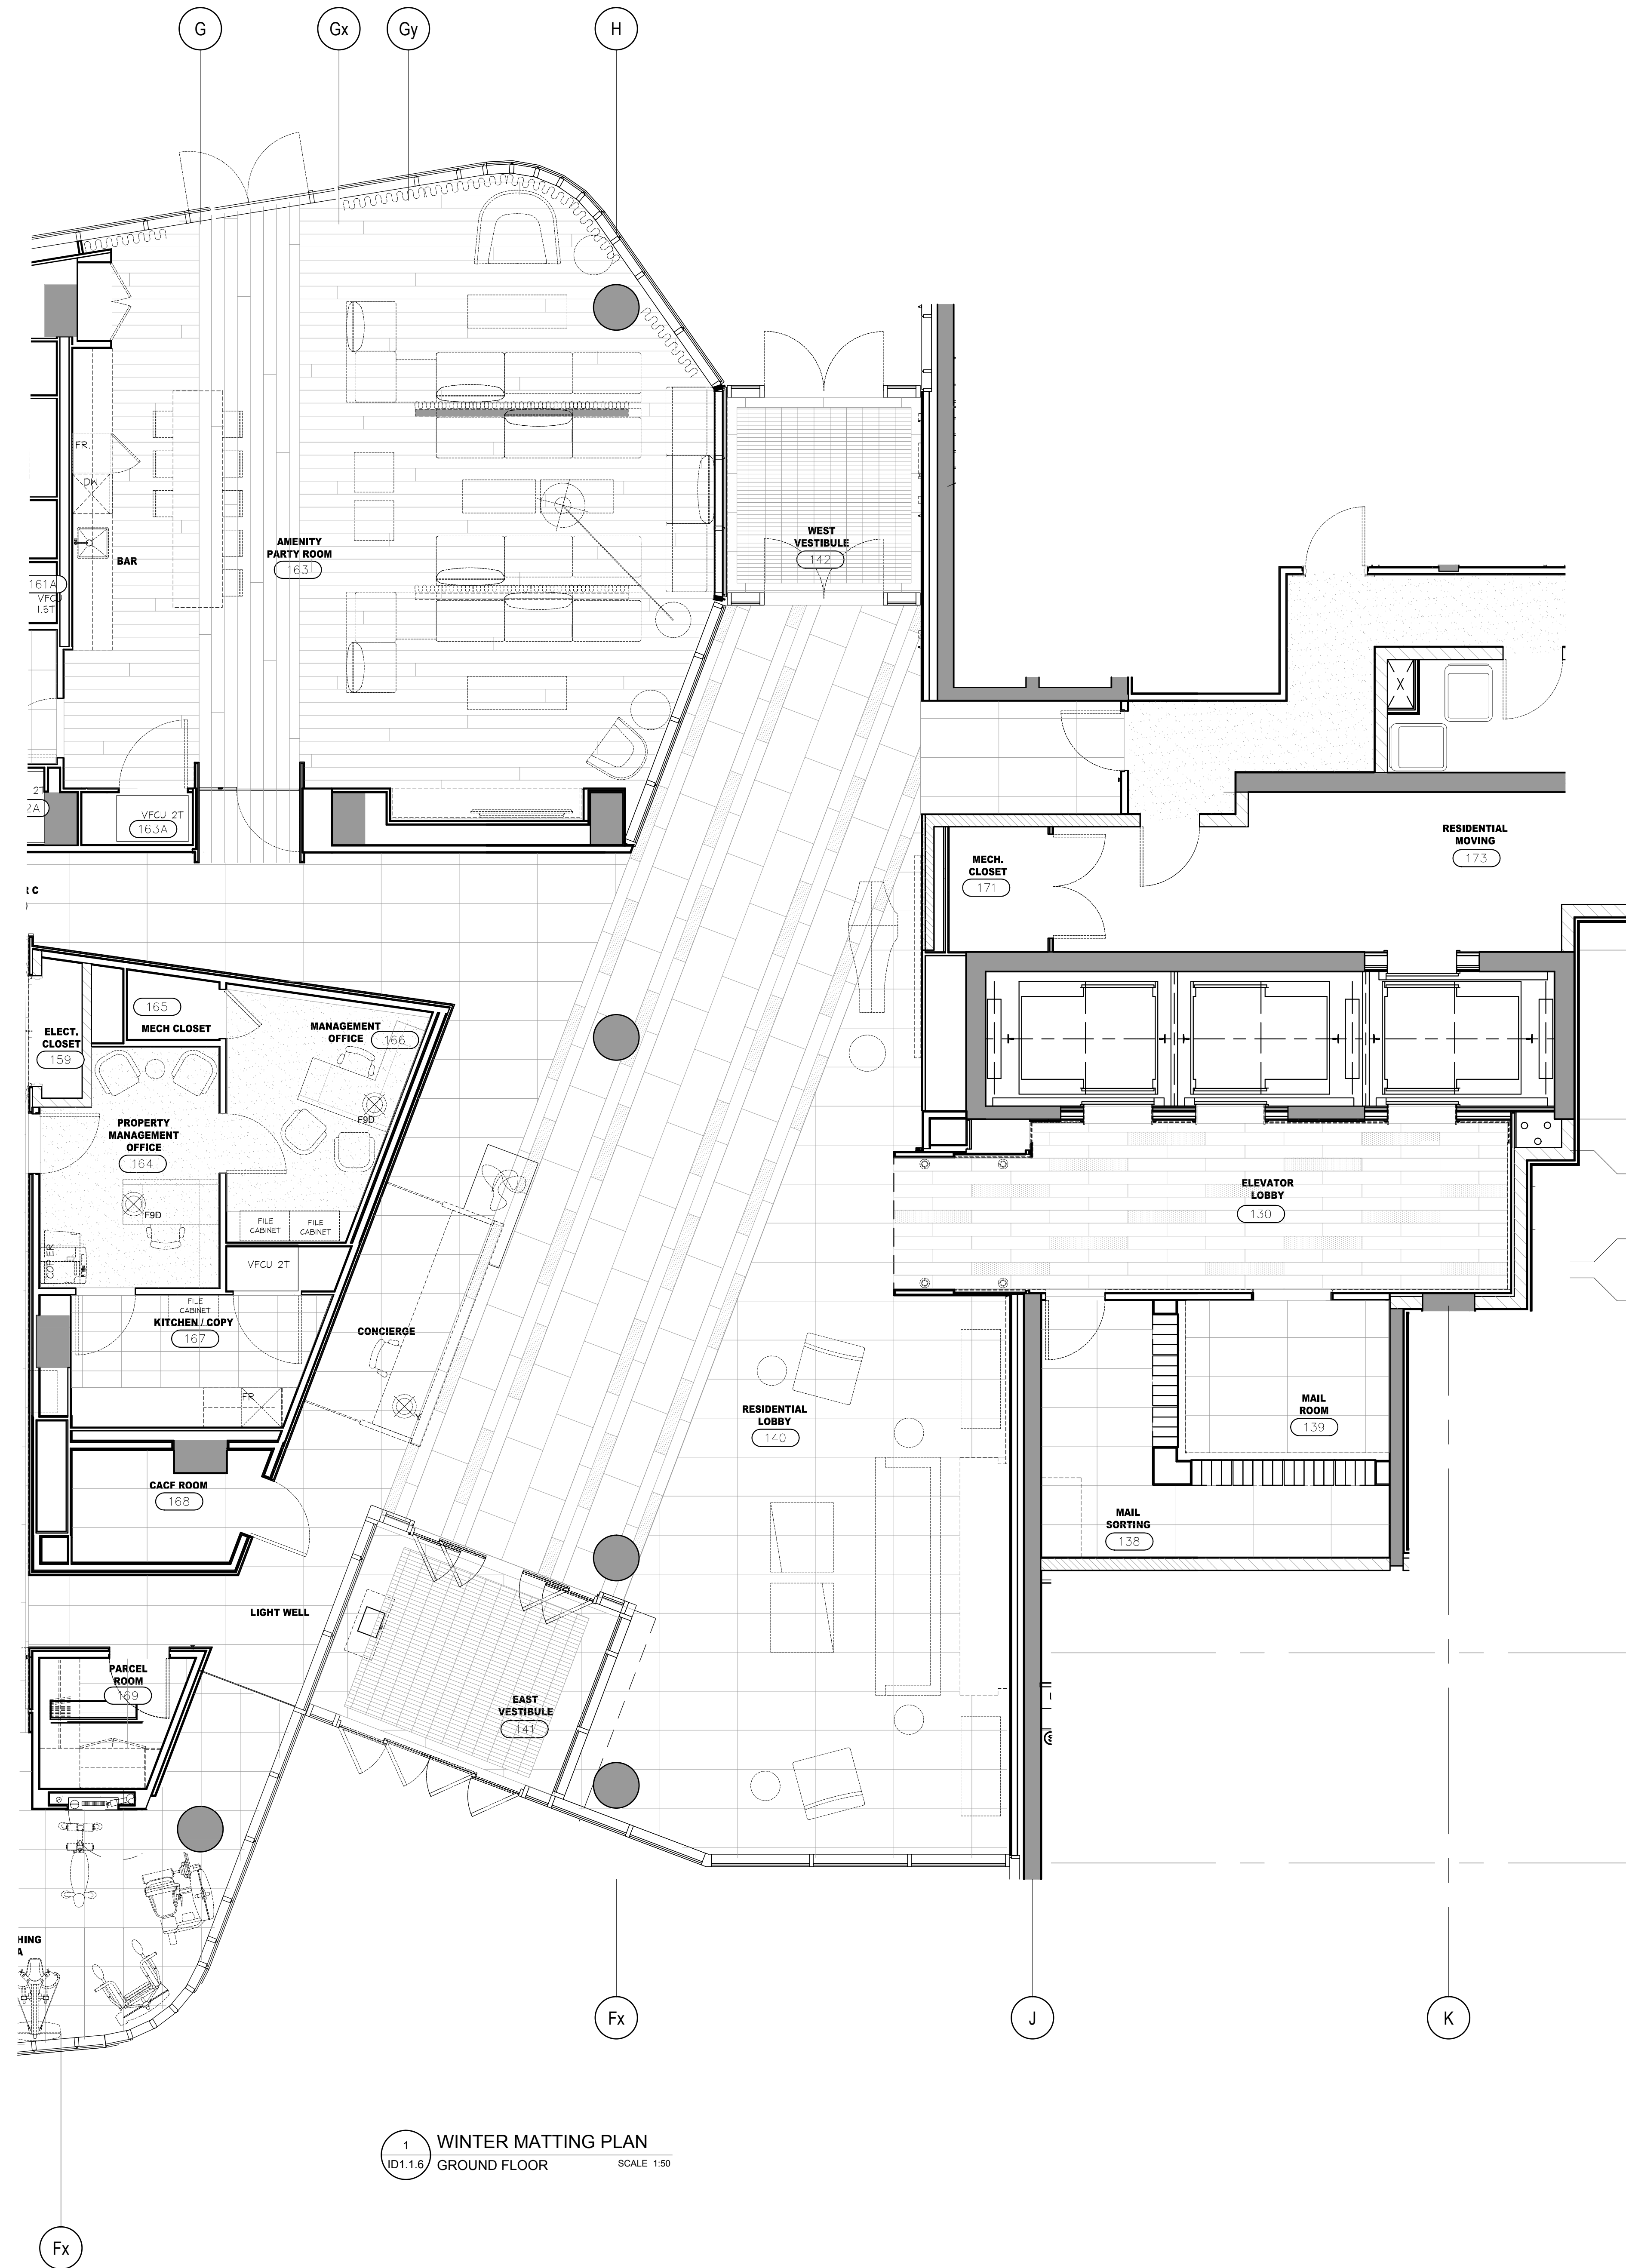

DO NOT SCALE DRAWINGS.
CONTRACTOR MUST VERIFY ALL DRAWINGS, DIMENSIONS, DETAILS AND SPECIFICATIONS AND REPORT ANY DISCREPANCIES TO UNION 31 INC. BEFORE PROCEEDING WITH WORK. MATERIALS MAY NOT BE SUBSTITUTED WITHOUT WRITTEN APPROVAL FROM UNION 31 INC.
ALL DRAWINGS AND SPECIFICATIONS ARE INSTRUMENTS OF SERVICE AND THE PROPERTY OF UNION 31 INC. WHICH MUST BE RETURNED AT THE COMPLETION OF THE WORK.

PRINTED: 30-May-17


ISSUED FOR
AS-BUILT

01	31 MAY / 17	ISSUED FOR AS-BUILT	SV
NO.	DATE	COMMENTS	INI
REVISIONS:			

UNION31

UNION31 INC.
183 BATHURST STREET, STE. 201
TORONTO, ON, M5T 2R7, CANADA
TEL: 416-597-1576 FAX: 416-597-2139

PROJECT NAME:		ALEXANDRA PARK MAIN BUILDING	
PROJECT NO.:		13-949	
DRAWING'S:		GROUND FLOOR WINTER MATTING PLAN	
DATE STARTED:	07 AUG / 13	DRAWING NO.:	ID
SCALE:	1" = 50'	DRAWN BY:	AP
APPROVED BY:	KC		1.1.6

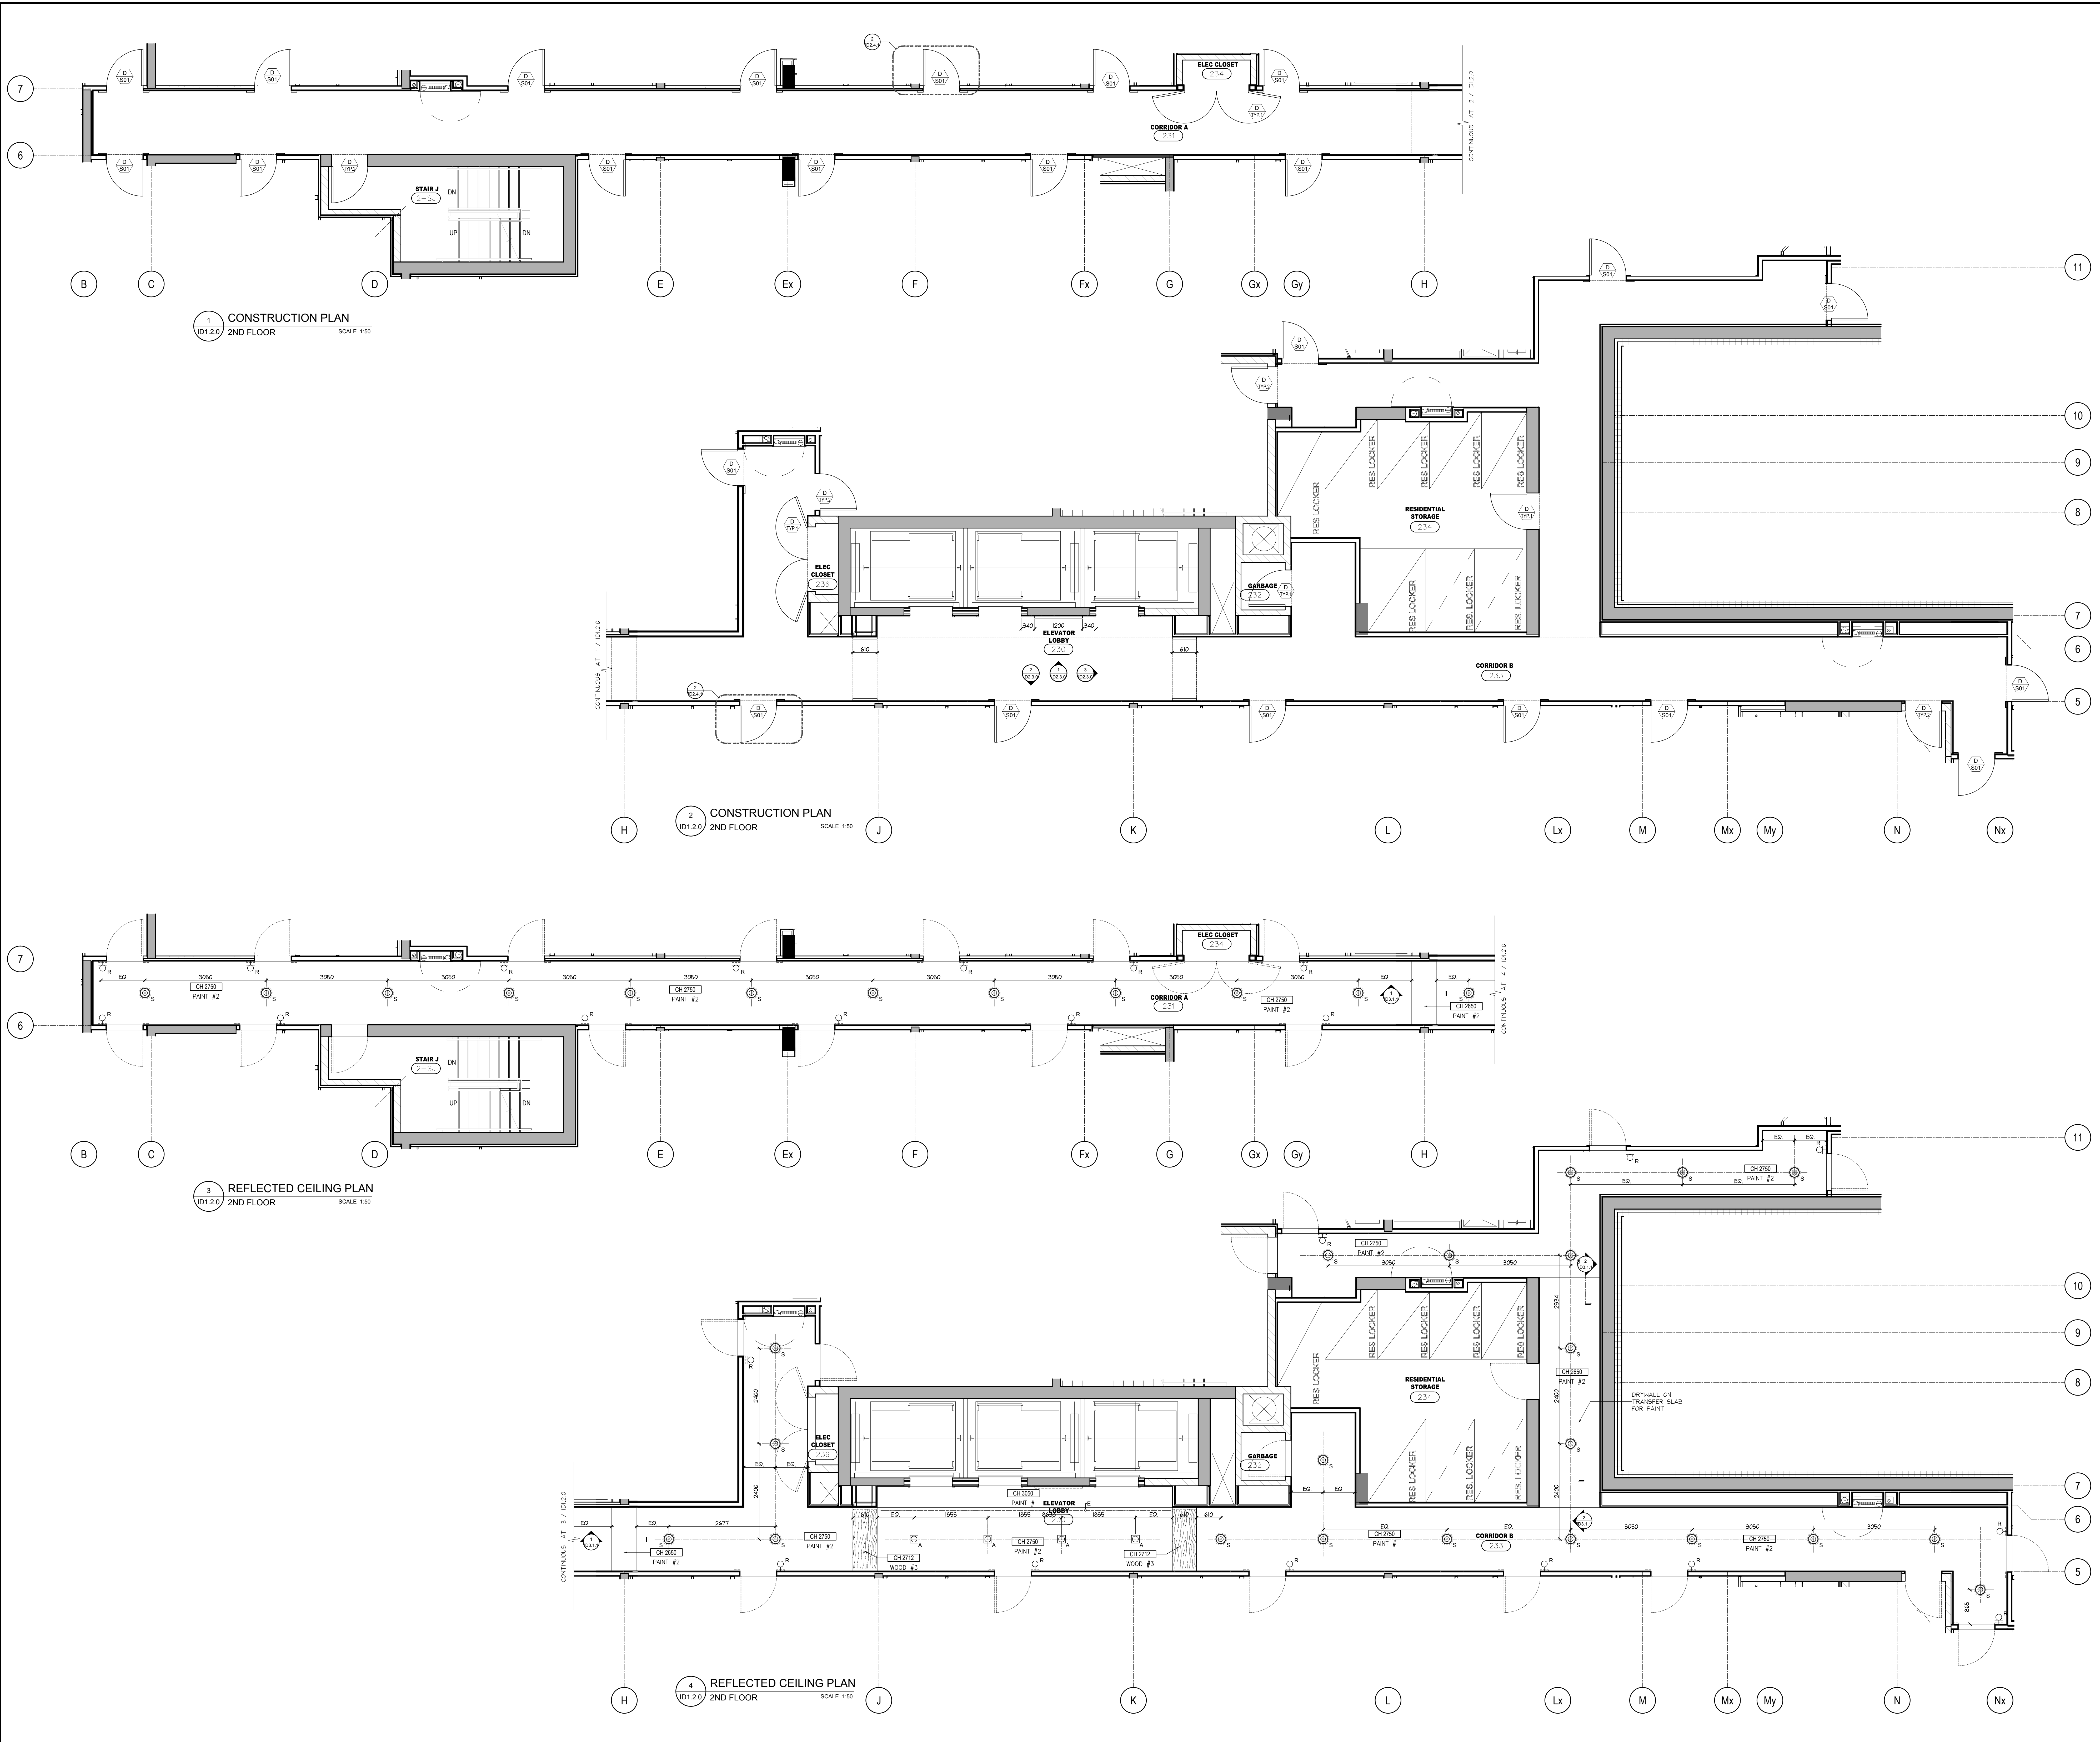

DO NOT SCALE DRAWINGS.
CONTRACTOR MUST VERIFY ALL DRAWINGS, DIMENSIONS, DETAILS AND SPECIFICATIONS AND REPORT ANY DISCREPANCIES TO UNION 31 INC. BEFORE PROCEEDING WITH WORK. MATERIALS MAY NOT BE SUBSTITUTED WITHOUT WRITTEN APPROVAL FROM UNION 31 INC.
ALL DRAWINGS AND SPECIFICATIONS ARE INSTRUMENTS OF SERVICE AND THE PROPERTY OF UNION 31 INC. WHICH MUST BE RETURNED AT THE COMPLETION OF THE WORK.

PRINTED: 30-MAY-17

ISSUED FOR
AS-BUILT

01	31 MAY 17	ISSUED FOR AS-BUILT	SV
NO.	DATE	COMMENTS	INI
REVISIONS:			

UNION 31

UNION31 INC.
183 BATHURST STREET, STE. 201
TORONTO, ON, M5T 2R7, CANADA
TEL: 416-597-1576 FAX: 416-597-2139

PROJECT NAME:		ALEXANDRA PARK MAIN BUILDING	
PROJECT NO.:		13-949	
DRAWINGS:		2ND FLOOR CONSTRUCTION PLAN & REFLECTED CEILING PLAN	
DATE STARTED:		07 AUG / 13	
SCALE:		1 : 50	
DRAWN BY:		AP	
APPROVED BY:		KC	
DRAWING NO.:		ID 1.2.0	

CONTRACTOR MUST VERIFY ALL DRAWINGS, DIMENSIONS, DETAILS AND SPECIFICATIONS, AND REPORT ANY DISCREPANCIES TO UNION 31 INC. BEFORE PROCEEDING WITH WORK. MATERIALS MAY NOT BE SUBSTITUTED WITHOUT WRITTEN APPROVAL FROM UNION 31 INC.


ALL DRAWINGS AND SPECIFICATIONS ARE INSTRUMENTS OF SERVICE AND THE PROPERTY OF UNION 31 INC. WHICH MUST BE RETURNED AT THE COMPLETION OF THE WORK.


ISSUED FOR
AS-BUILT

1302


PROJECT NAME:	
ALEXANDRA PARK MAIN BUILDING	
BLOCK 11	
ON, Canada	
PROJECT NO.:	13-949
DRAWING/S:	

DATE STARTED: 07 AUG / 13	DRAWING NO.: ID 1.2.1
SCALE: 1 : 50	
DRAWN BY: AP	
APPROVED BY: KC	

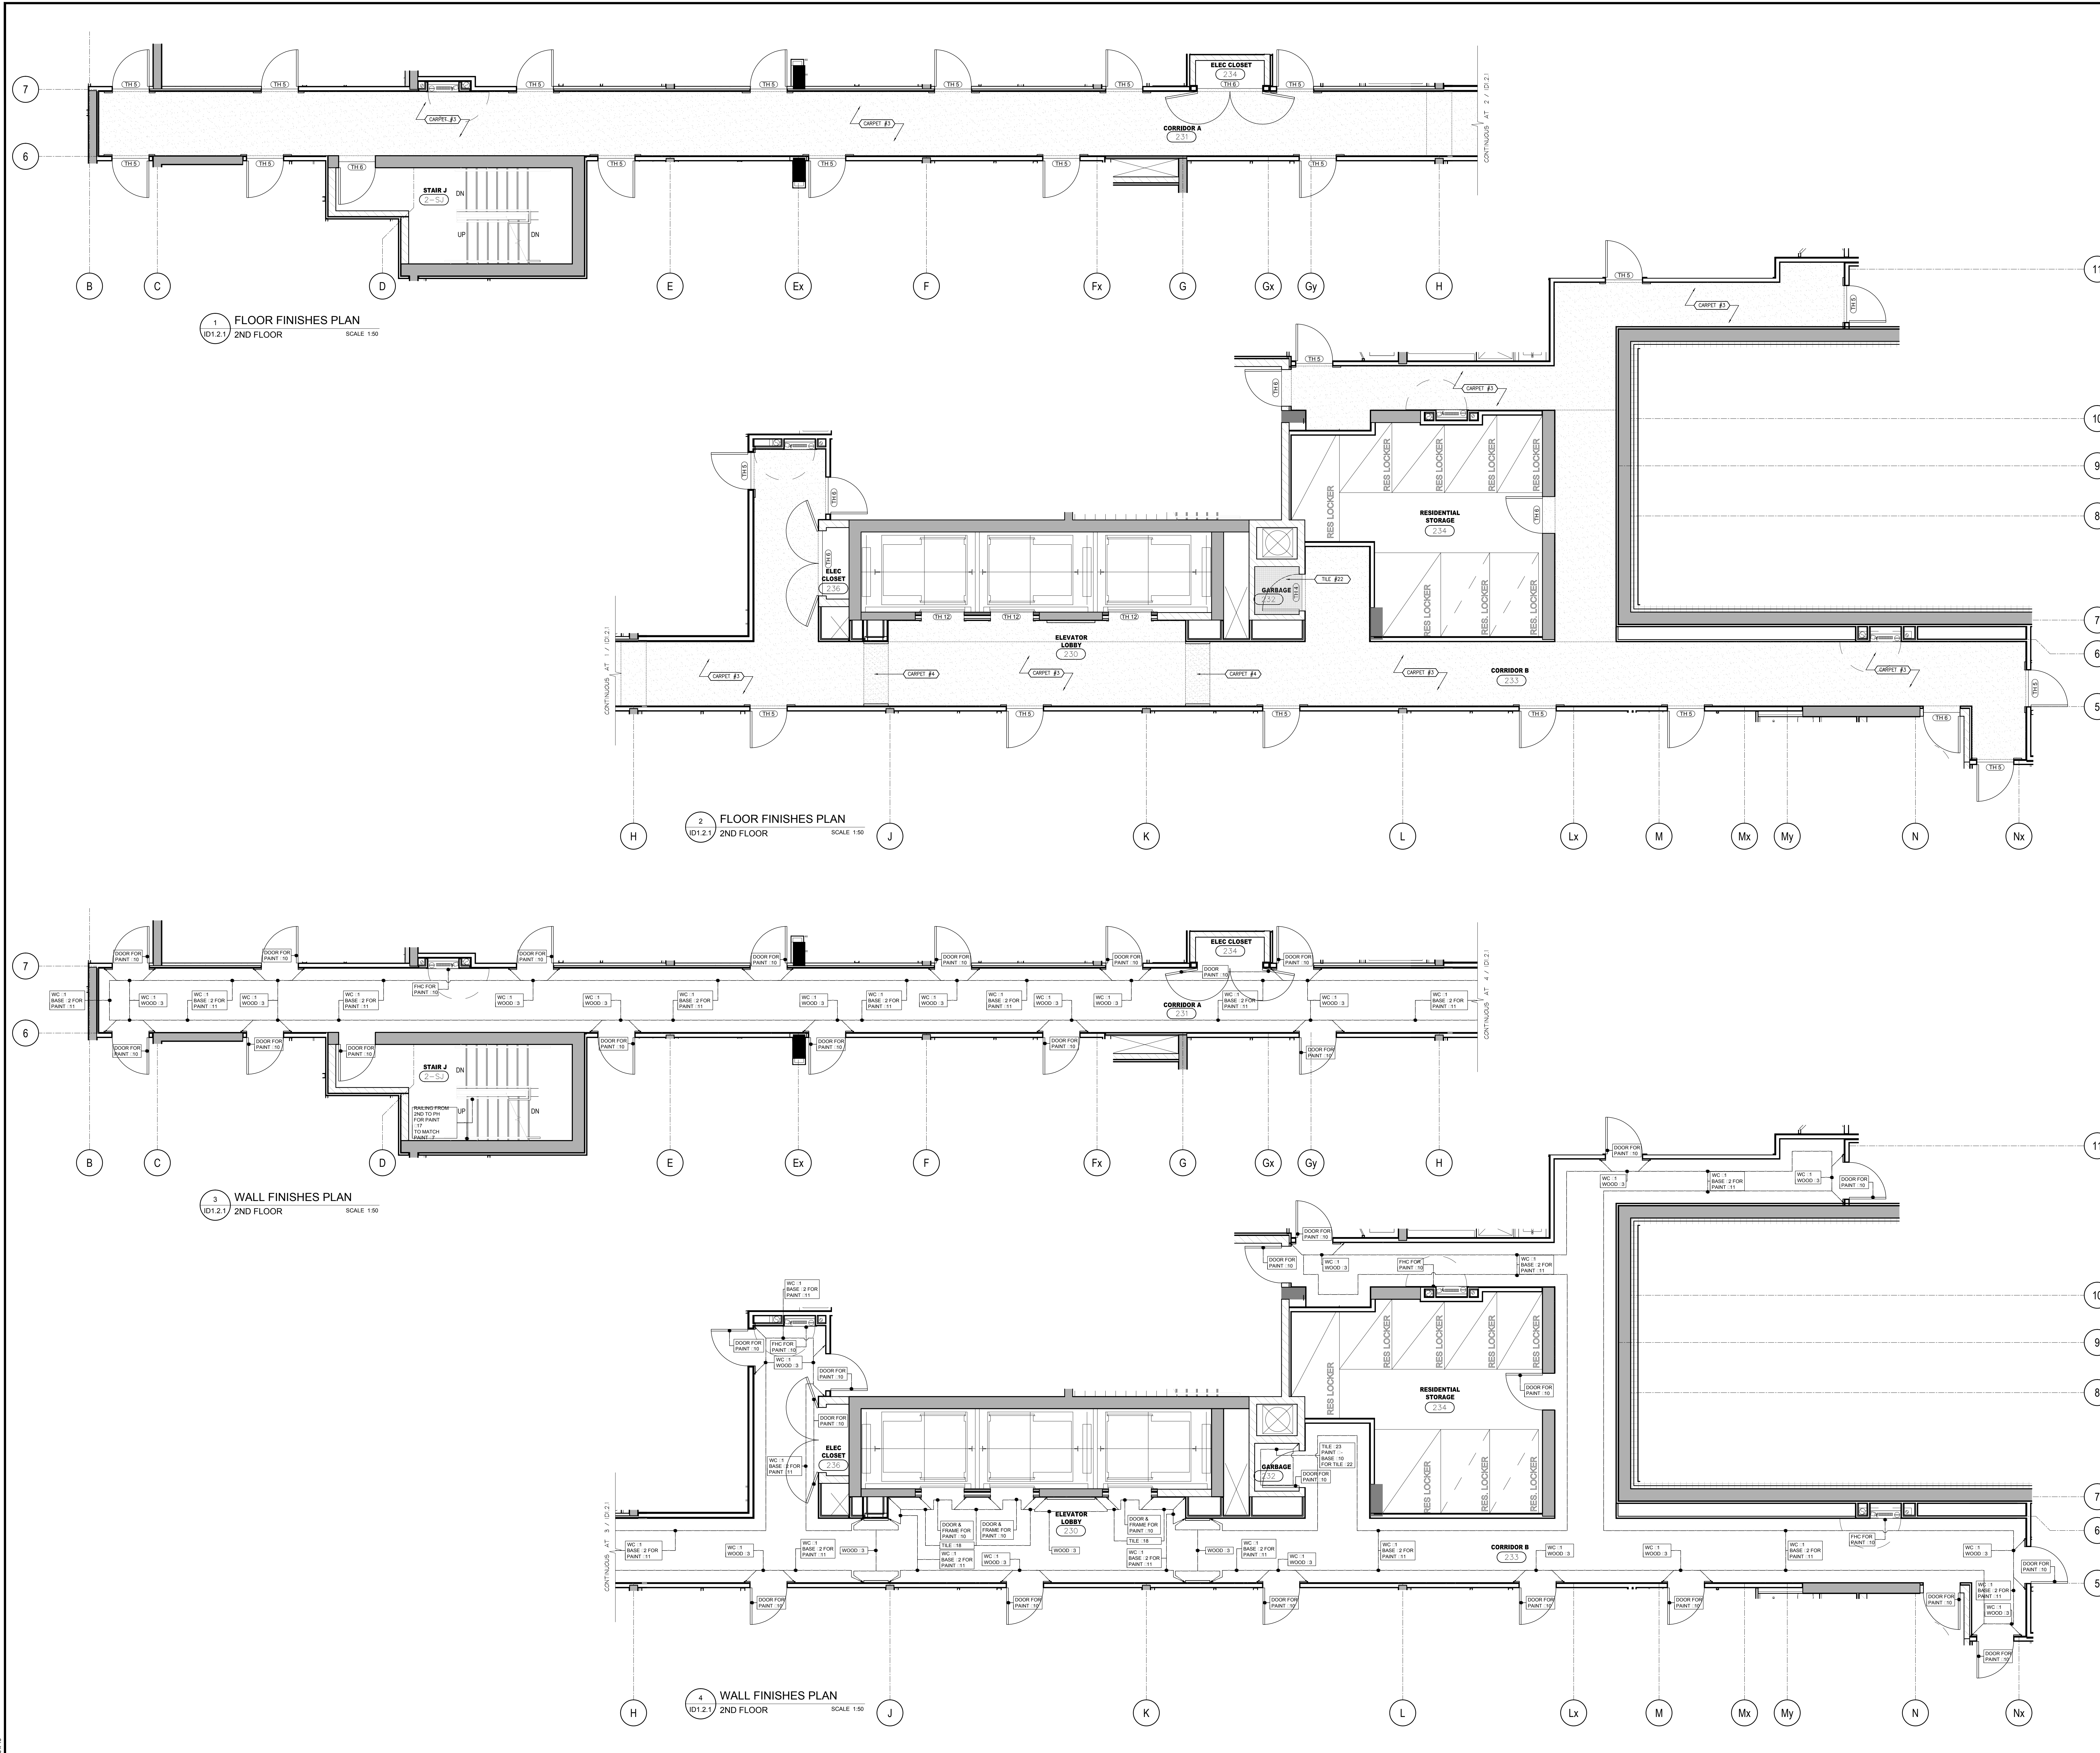


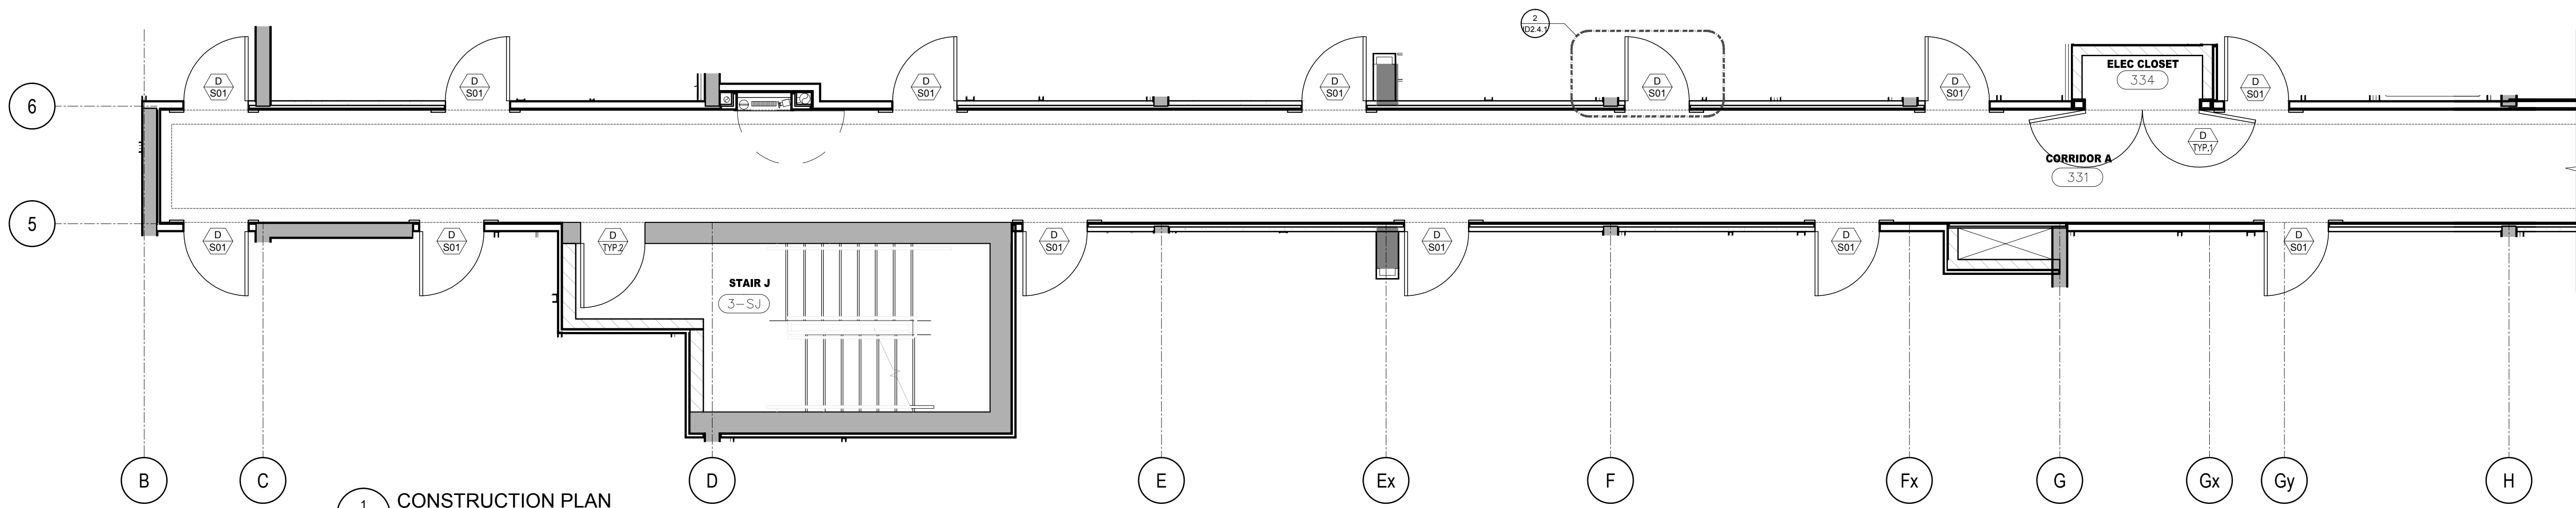


1 CONSTRUCTION PLAN
3RD FLOOR
SCALE 1:50

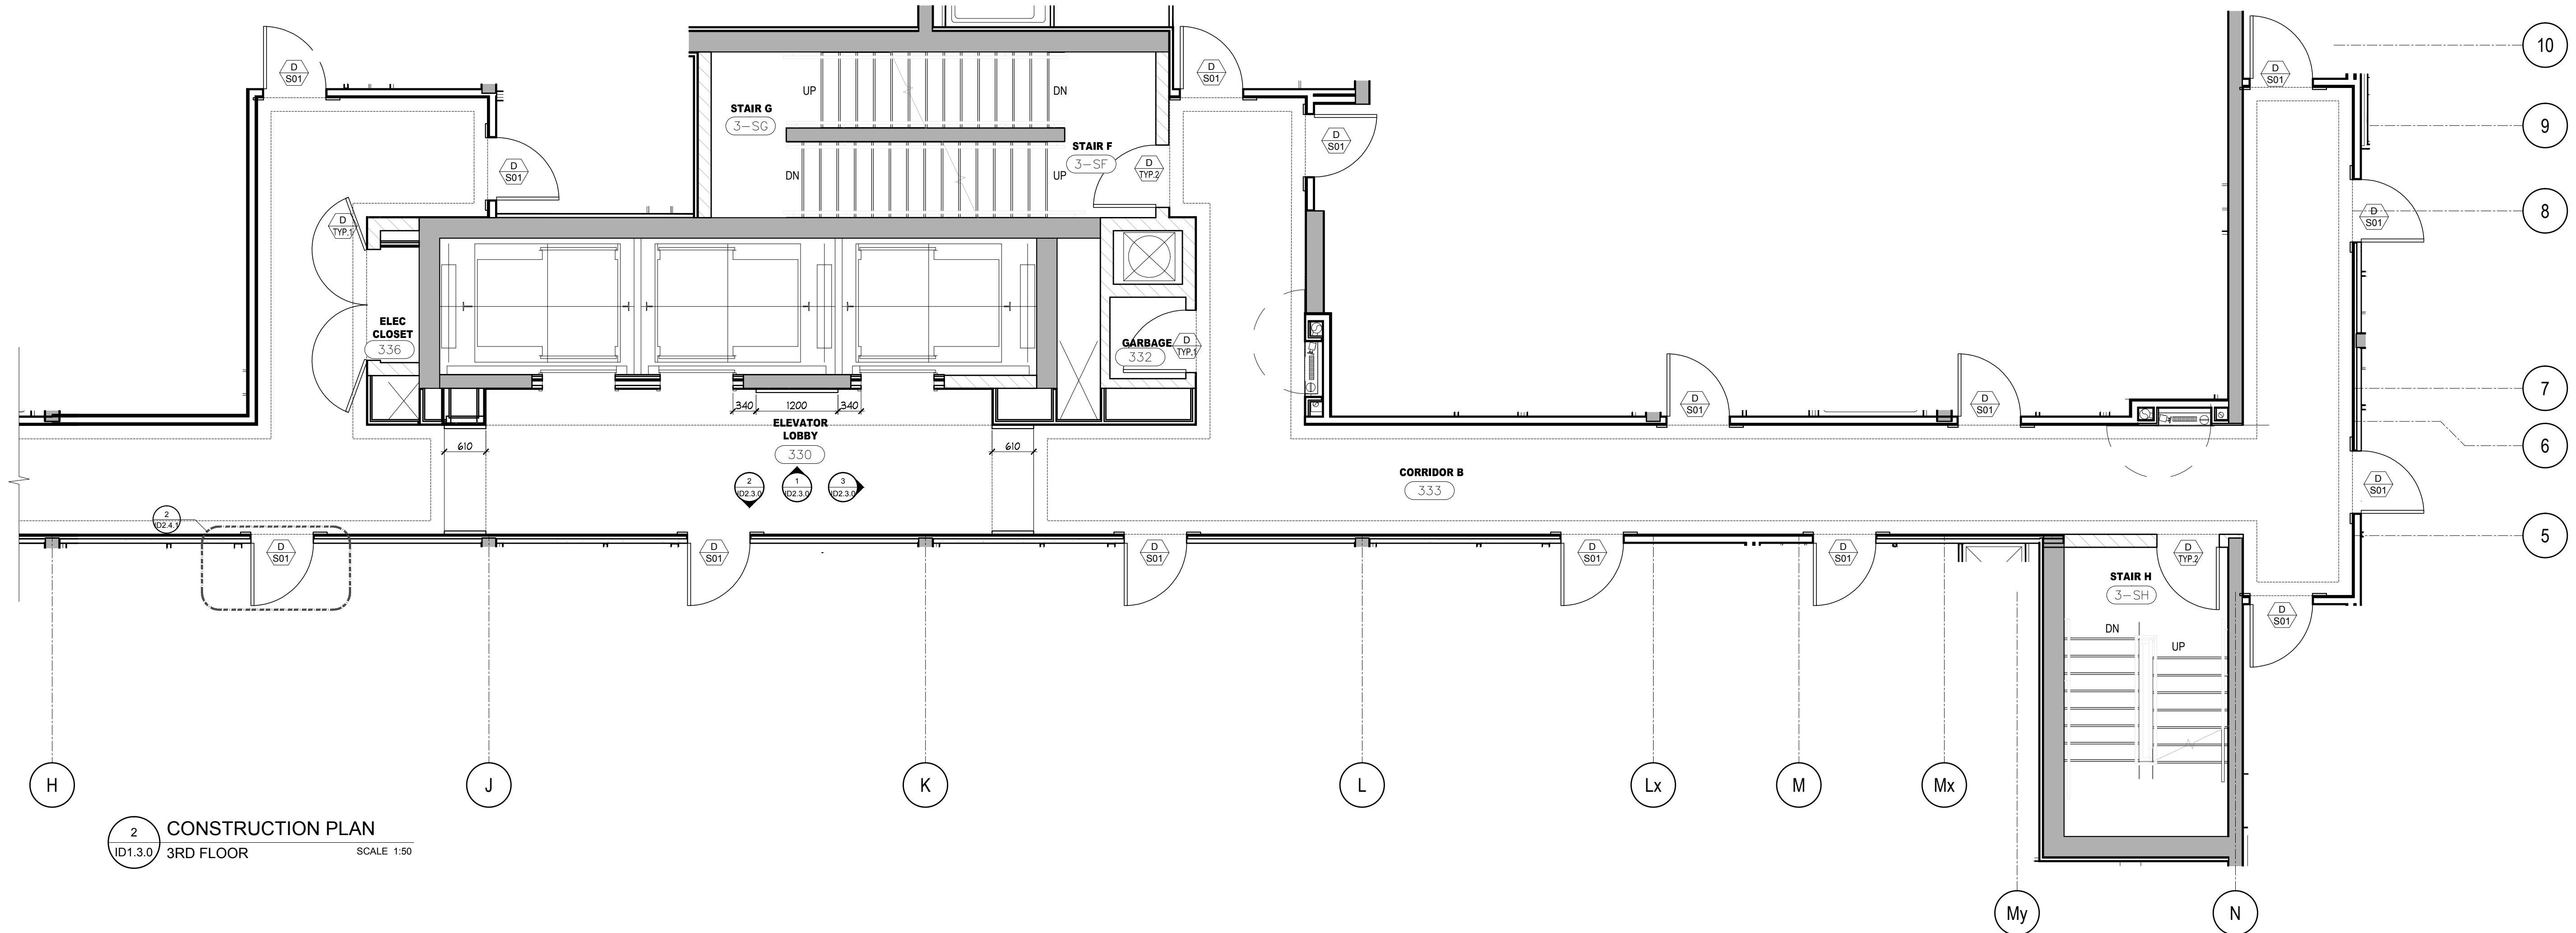

2 CONSTRUCTION PLAN
3RD FLOOR
SCALE 1:50

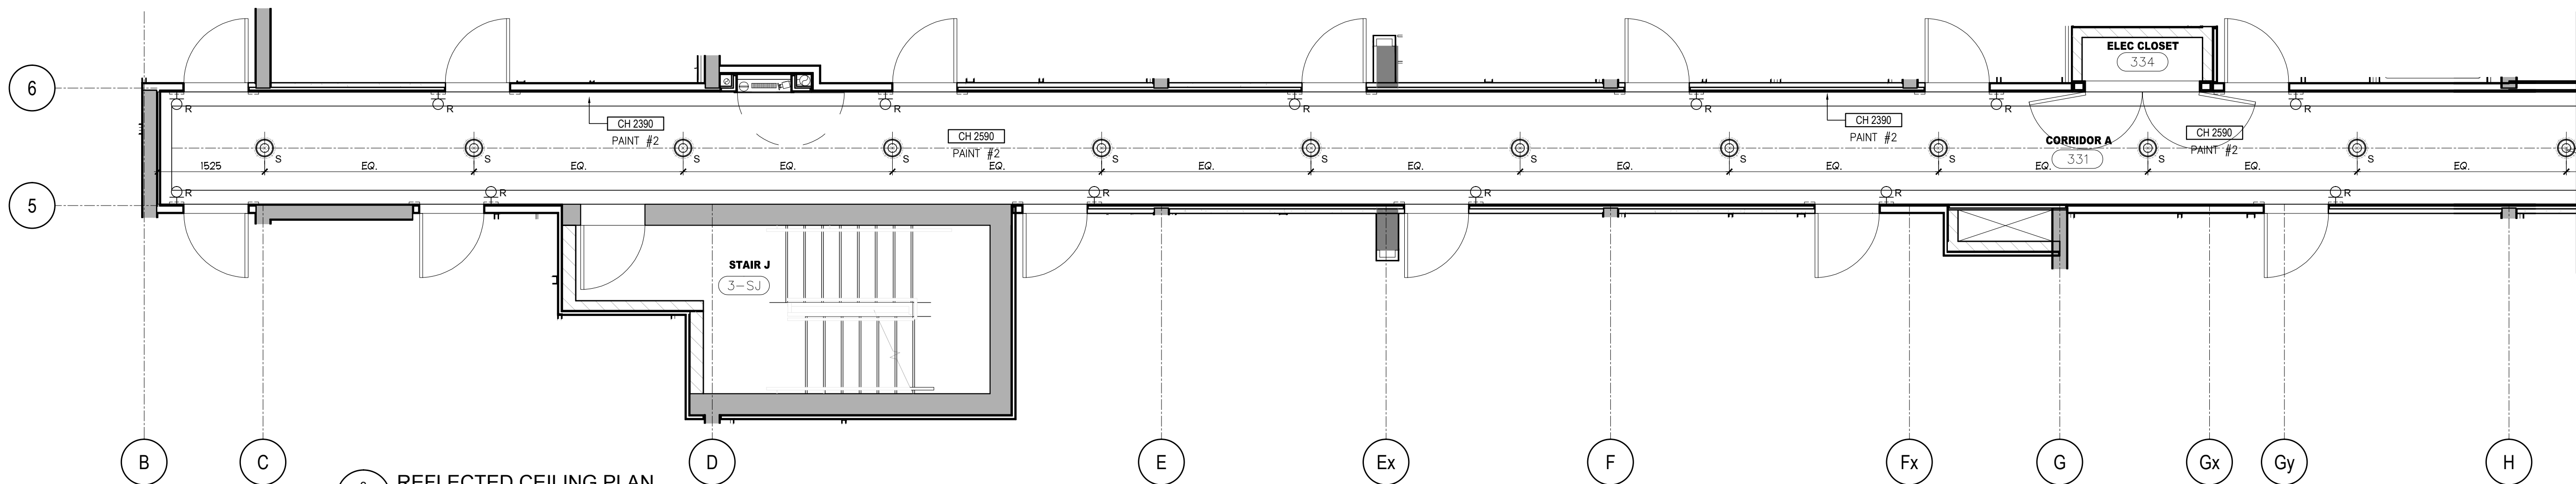

3 REFLECTED CEILING PLAN
3RD FLOOR
SCALE 1:50

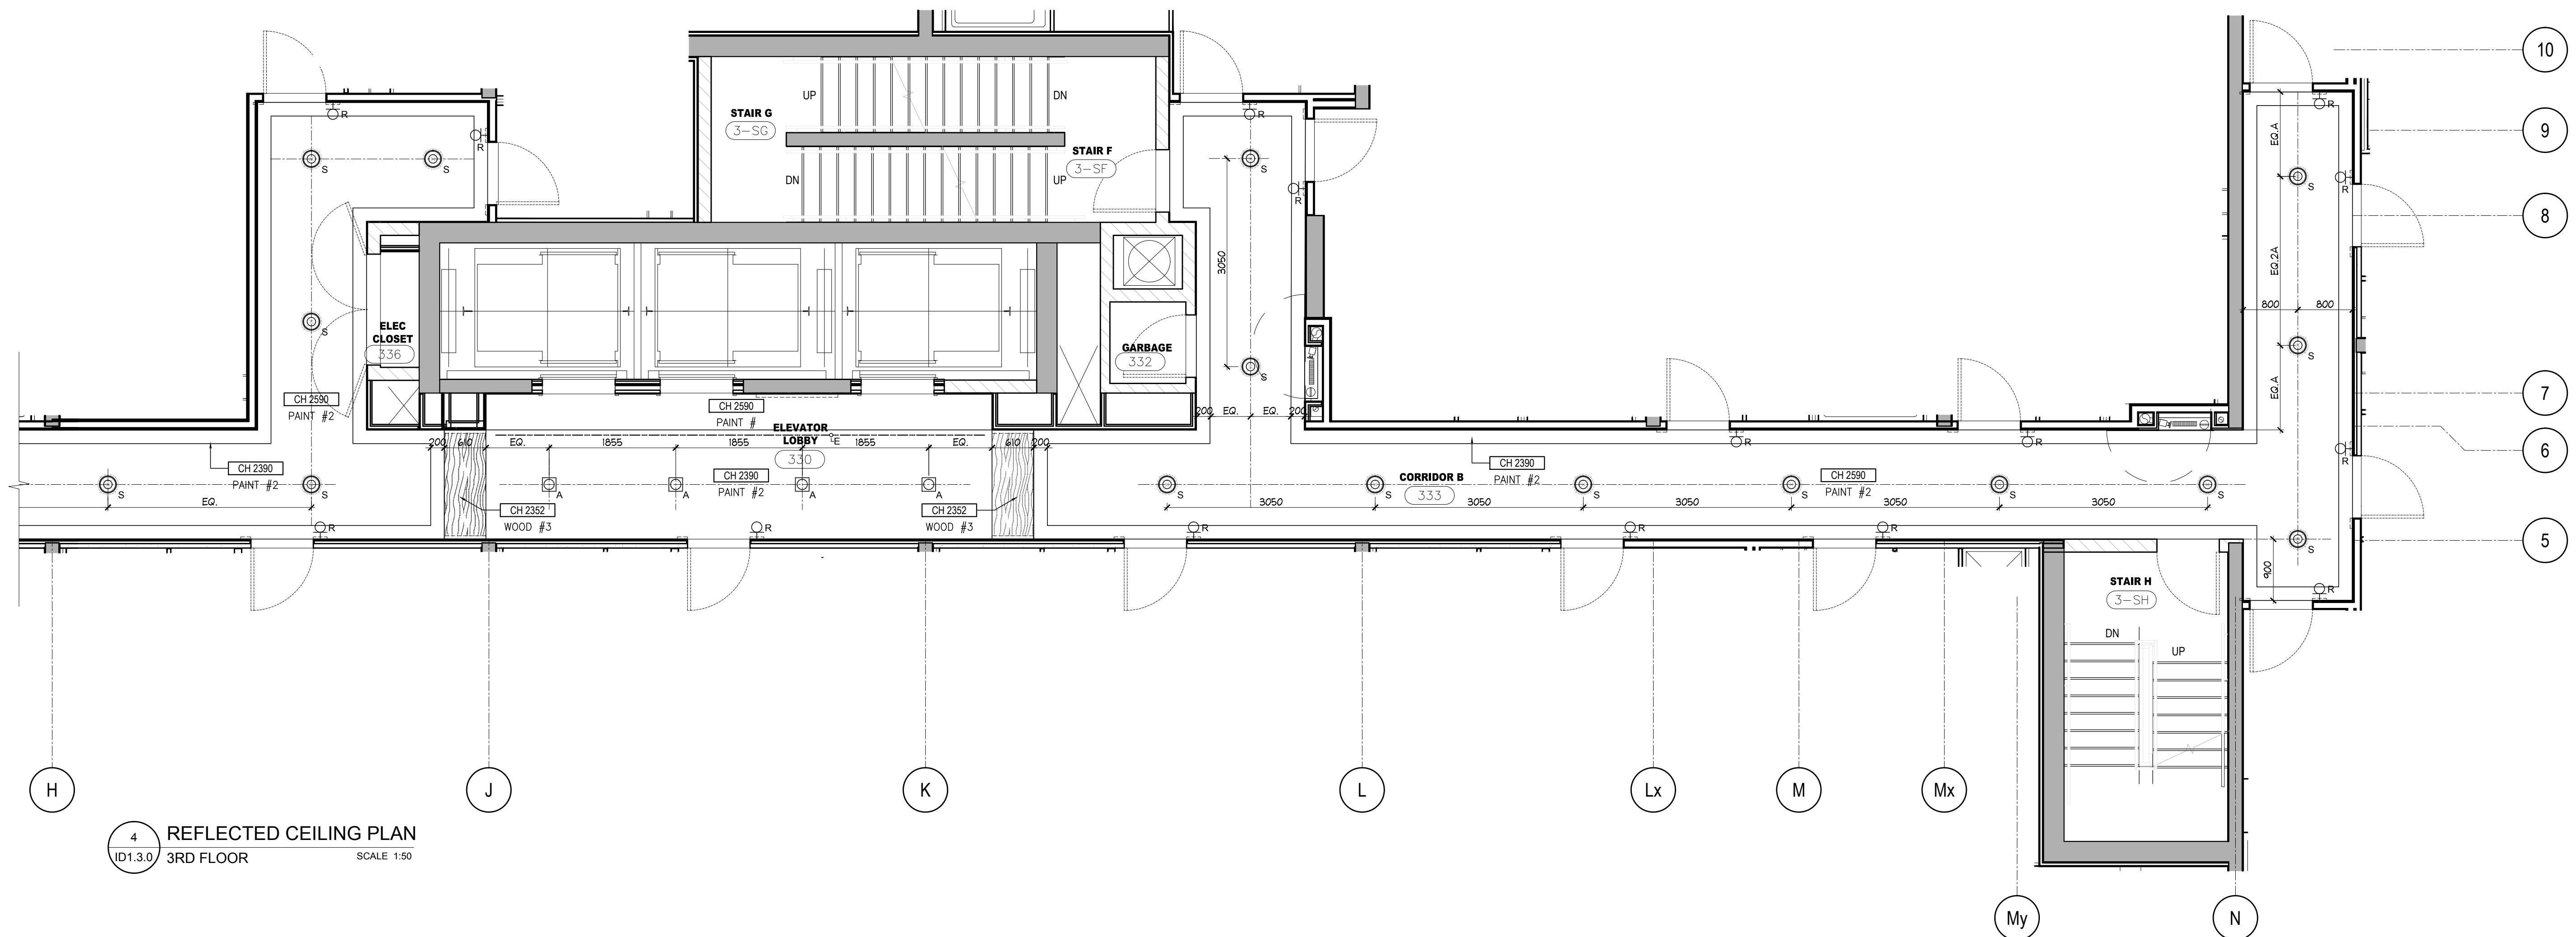

4 REFLECTED CEILING PLAN
3RD FLOOR
SCALE 1:50

DO NOT SCALE DRAWINGS.

CONTRACTOR MUST VERIFY ALL DRAWINGS, DIMENSIONS, DETAILS AND SPECIFICATIONS AND REPORT ANY DISCREPANCIES TO UNION 31 INC. BEFORE PROCEEDING WITH WORK. MATERIALS MAY NOT BE SUBSTITUTED WITHOUT WRITTEN APPROVAL FROM UNION 31 INC.

ALL DRAWINGS AND SPECIFICATIONS ARE INSTRUMENTS OF SERVICE AND THE PROPERTY OF UNION 31 INC. WHICH MUST BE RETURNED AT THE COMPLETION OF THE WORK.


PRINTED: 30-MAY-17

ISSUED FOR
AS-BUILT


01	31 MAY / 17	ISSUED FOR AS-BUILT	SV
NO.	DATE	COMMENTS	INI

REVISIONS:


UNION 31
PROJECT NAME:
ALEXANDRA PARK
MAIN BUILDING
BLOCK 11
ON, Canada
PROJECT NO.:
13-949
DRAWINGS:
3RD FLOOR
CONSTRUCTION PLAN &
REFLECTED CEILING PLAN
DATE STARTED: 07 AUG / 13
SCALE: 1 : 50
DRAWN BY: AP
APPROVED BY: KC
DRAWING NO.:
ID
1.3.0

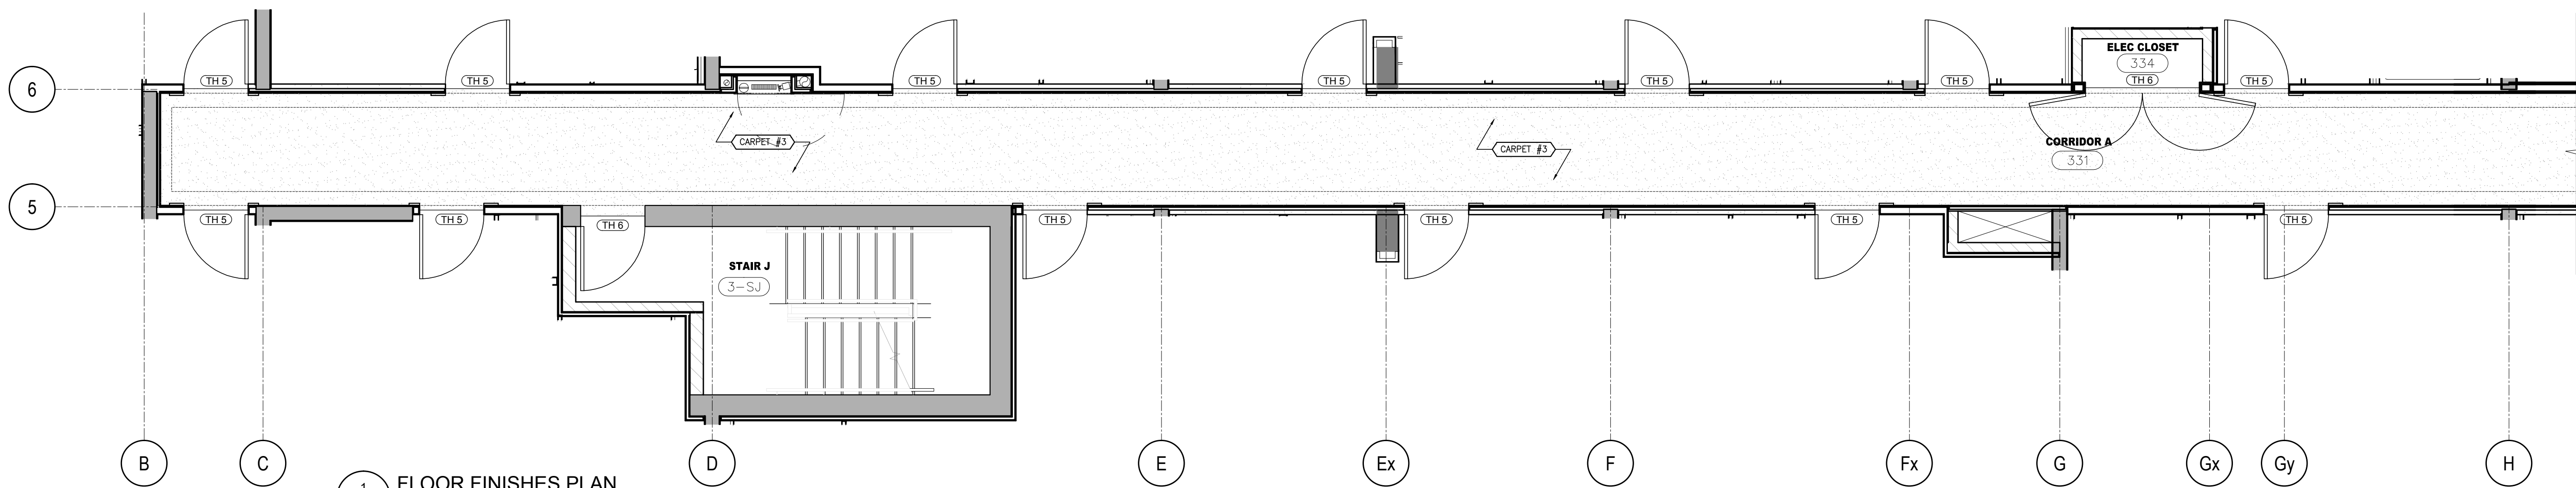


1 FLOOR FINISHES PLAN
3RD FLOOR
SCALE 1:50

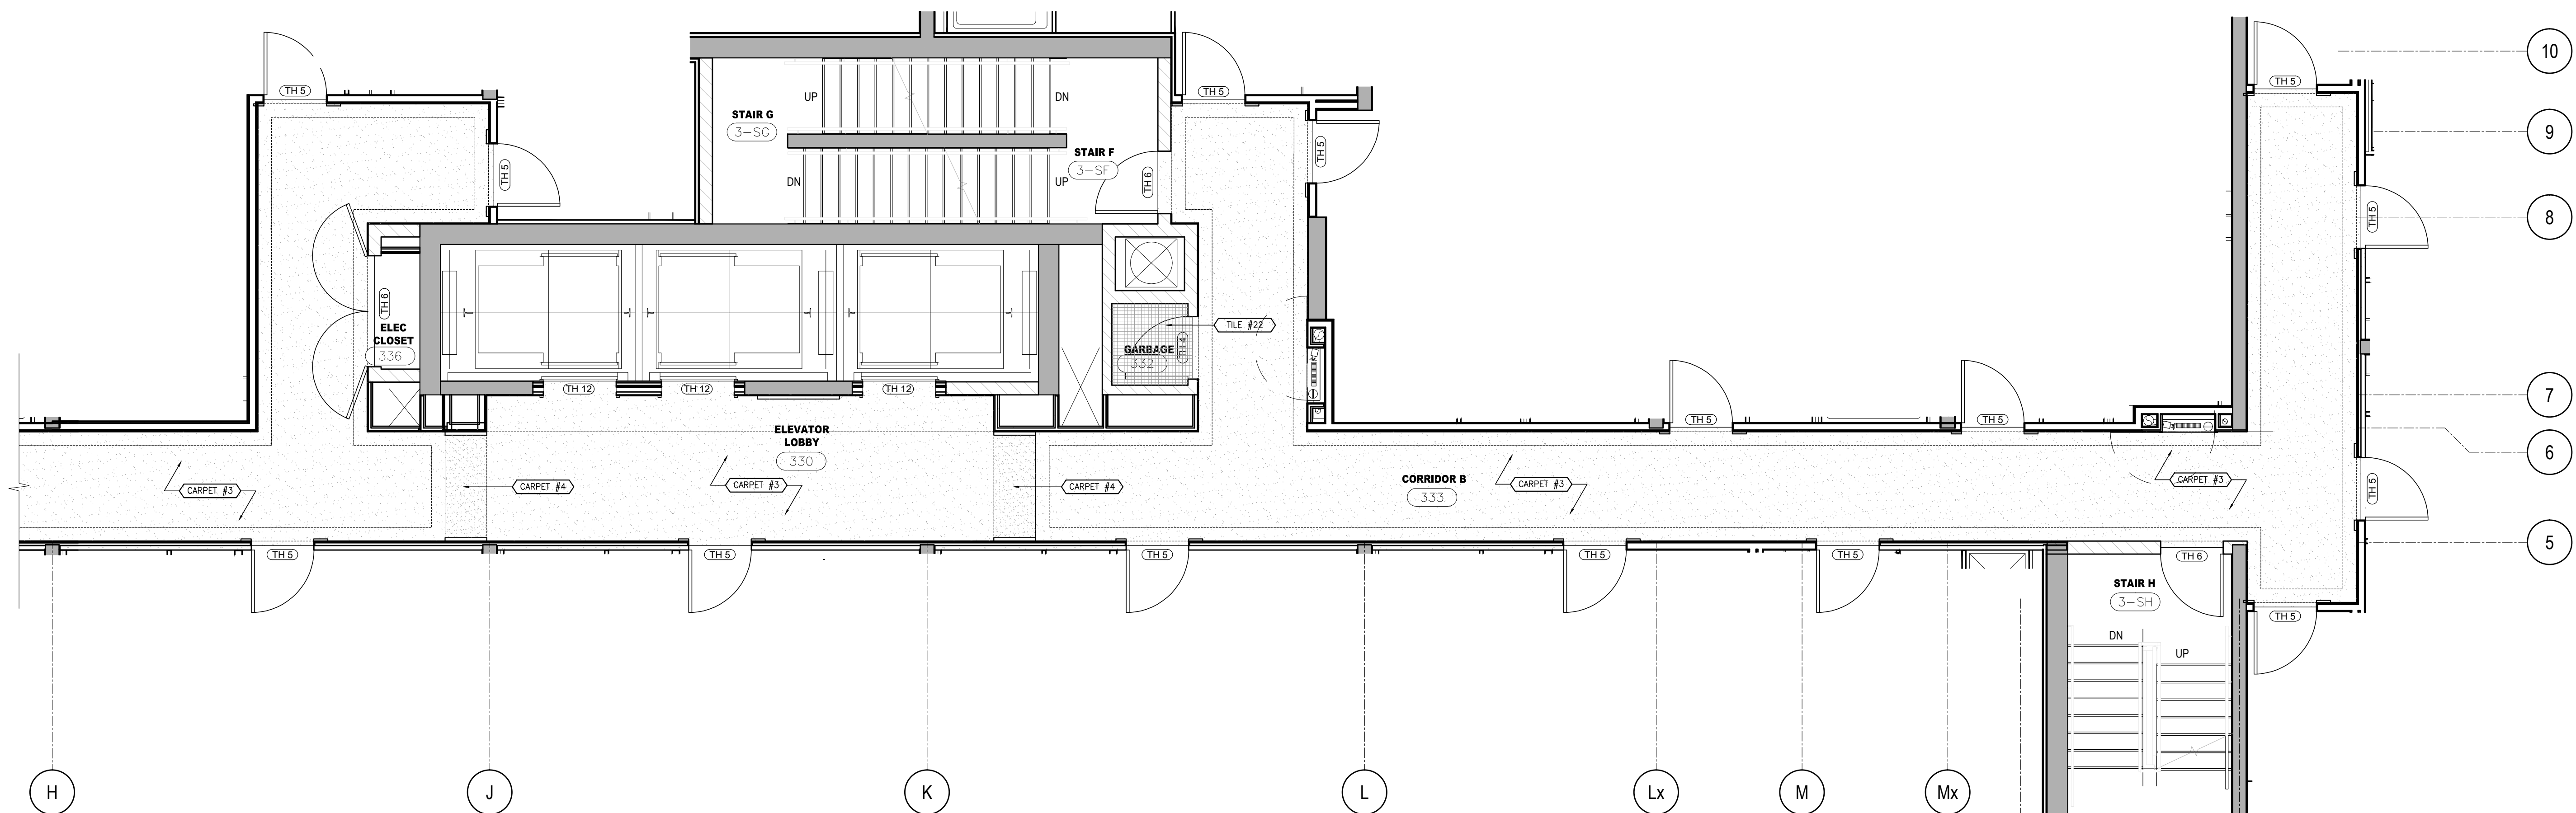

2 FLOOR FINISHES PLAN
3RD FLOOR
SCALE 1:50

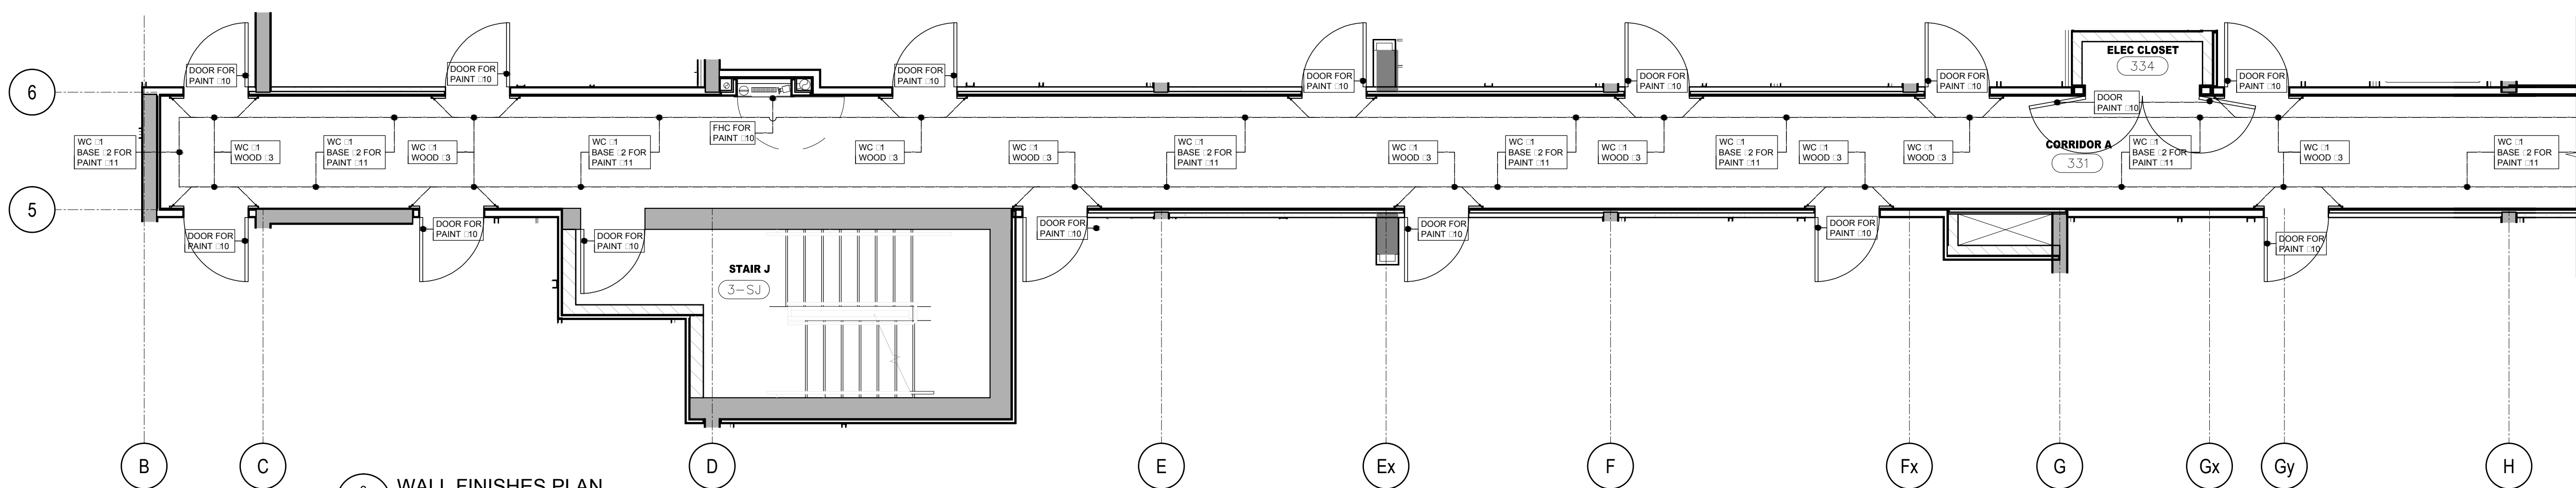

3 WALL FINISHES PLAN
3RD FLOOR
SCALE 1:50

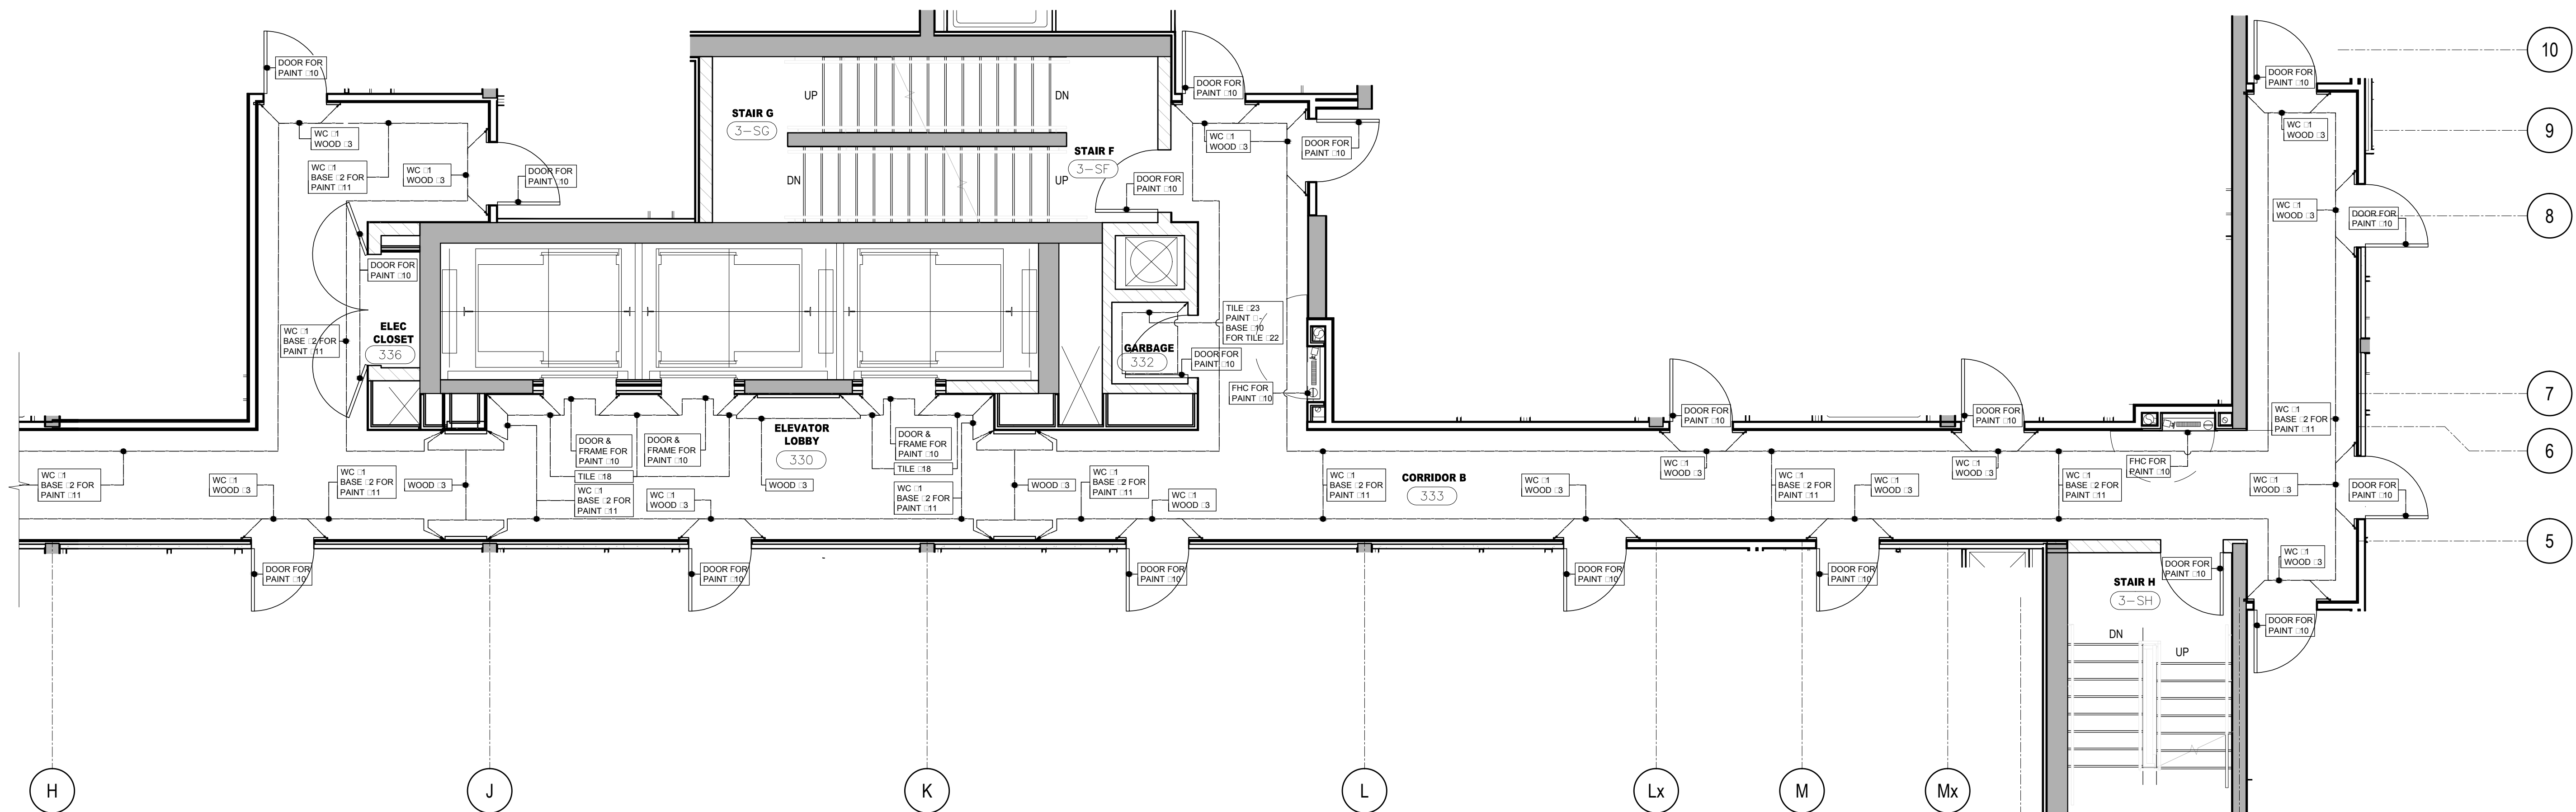

4 WALL FINISHES PLAN
3RD FLOOR
SCALE 1:50

DO NOT SCALE DRAWINGS.
CONTRACTOR MUST VERIFY ALL DRAWINGS, DIMENSIONS, DETAILS AND SPECIFICATIONS AND REPORT ANY DISCREPANCIES TO UNION 31 INC. BEFORE PROCEEDING WITH WORK. MATERIALS MAY NOT BE SUBSTITUTED WITHOUT WRITTEN APPROVAL FROM UNION 31 INC.
ALL DRAWINGS AND SPECIFICATIONS ARE INSTRUMENTS OF SERVICE AND THE PROPERTY OF UNION 31 INC. WHICH MUST BE RETURNED AT THE COMPLETION OF THE WORK.

PRINTED: 30-May-17

ISSUED FOR
AS-BUILT





01	31 MAY / 17	ISSUED FOR AS-BUILT	SV
NO.	DATE	COMMENTS	INI

REVISIONS:

UNION 31

UNION31 INC.
183 BATHURST STREET, STE. 201
TORONTO, ON, M5T 2R7, CANADA
TEL: 416-597-1576 FAX: 416-597-2139

PROJECT NAME:		ALEXANDRA PARK MAIN BUILDING	
		BLOCK 11 ON, Canada	
PROJECT NO.:		13-949	
DRAWINGS:		3RD FLOOR FLOOR FINISHES PLAN & WALL FINISHES PLAN	
DATE STARTED:		07 AUG / 13	DRAWING NO.:
SCALE:		1 : 50	ID
DRAWN BY:		AP	1.3.1
APPROVED BY:		KC	

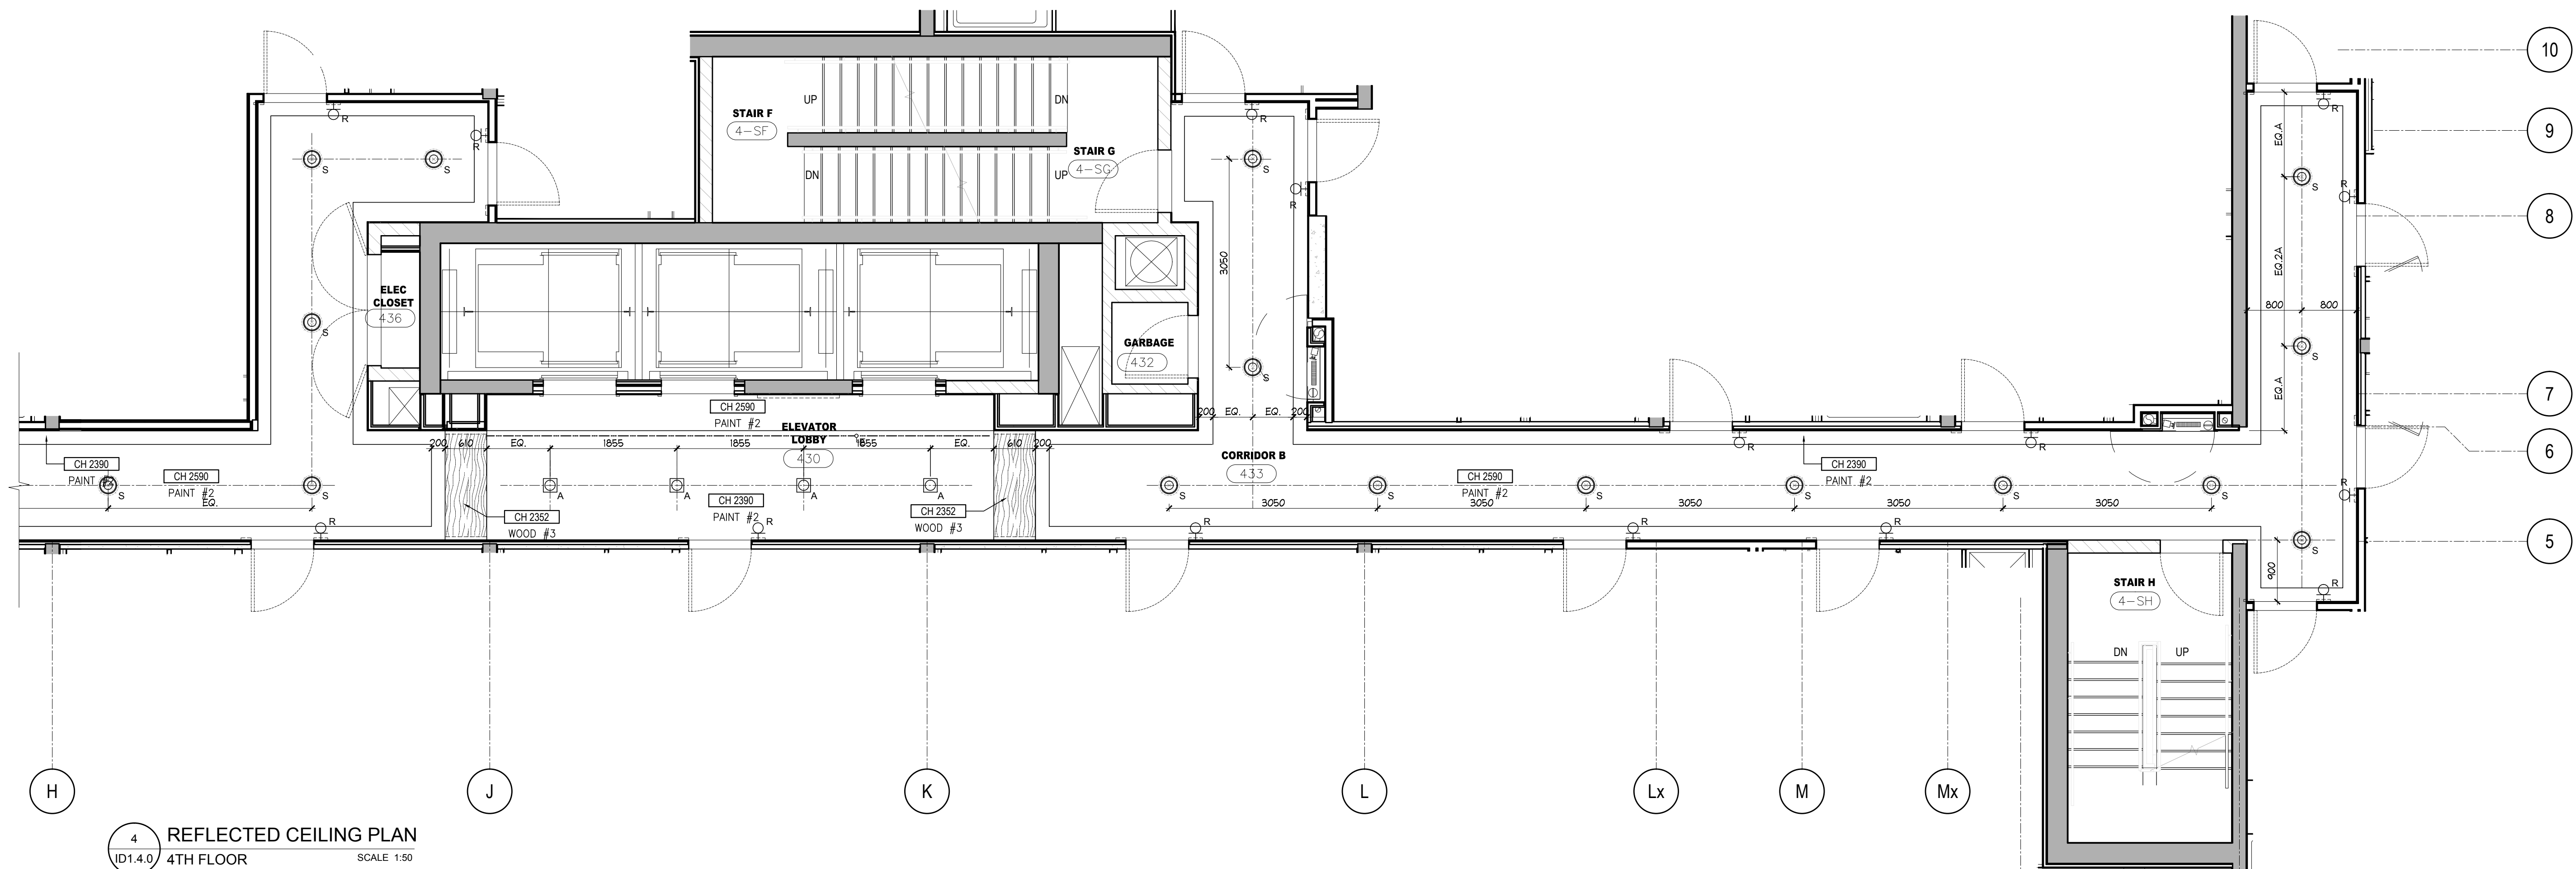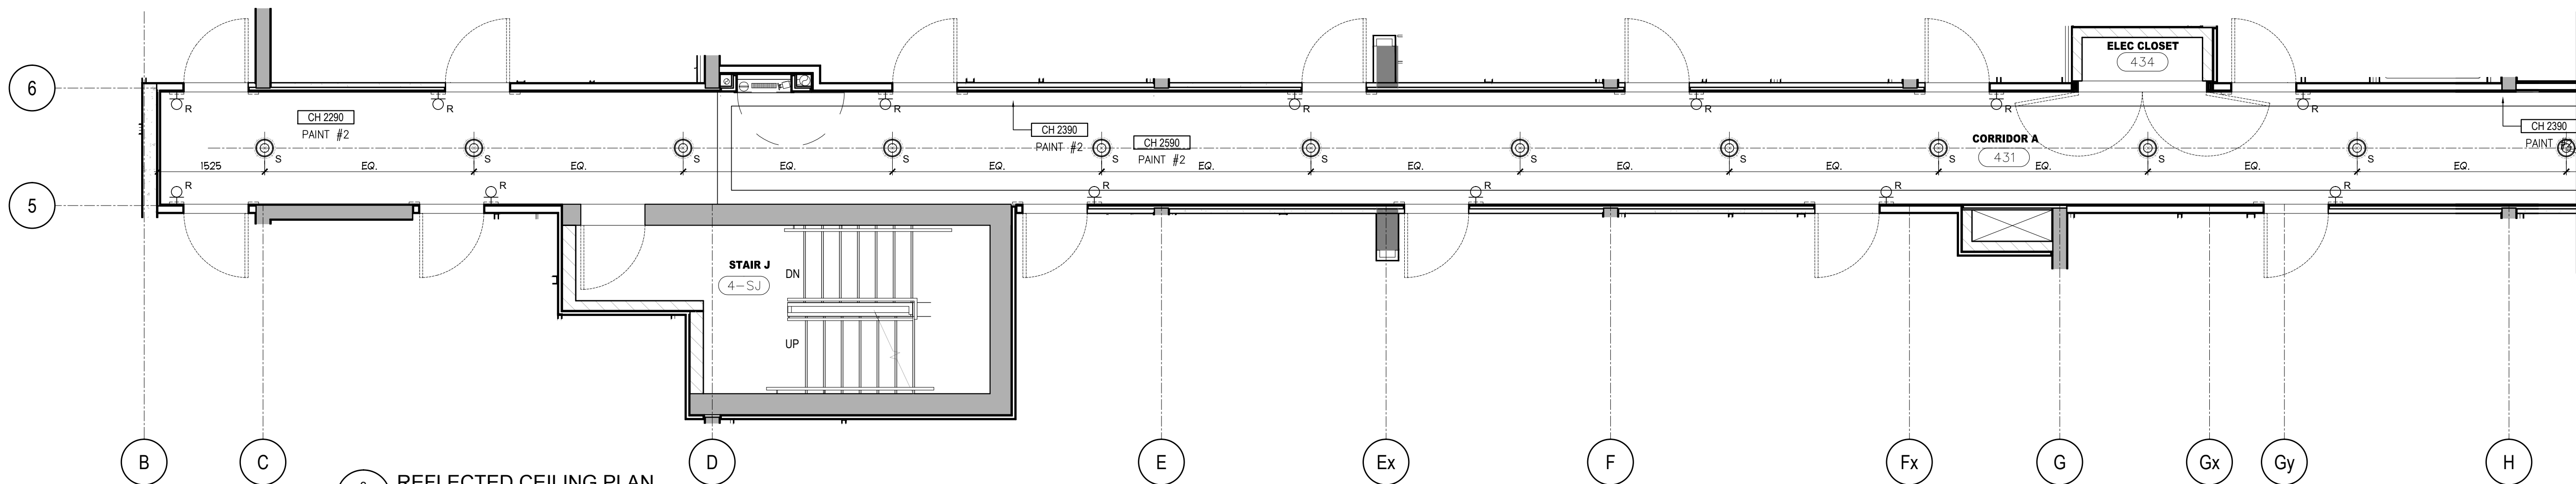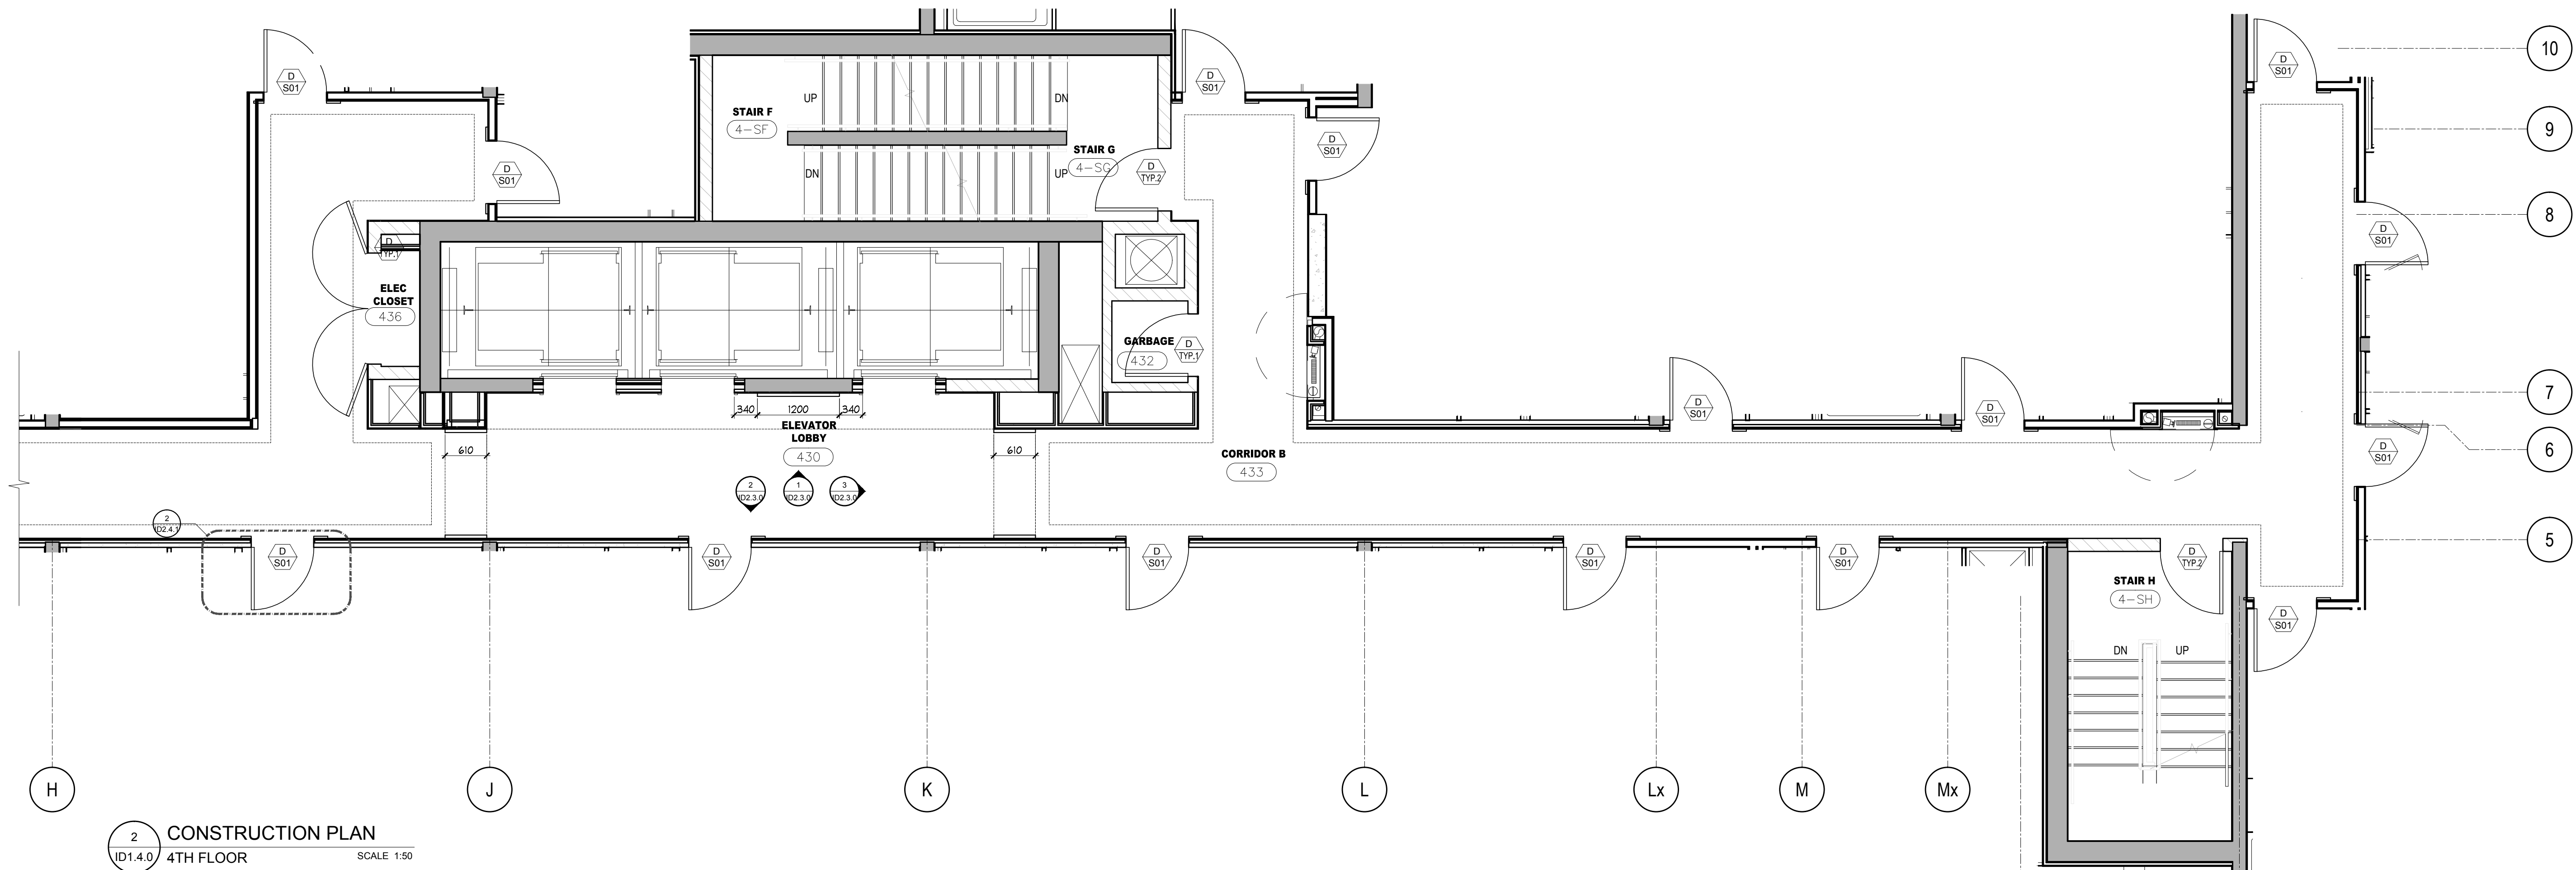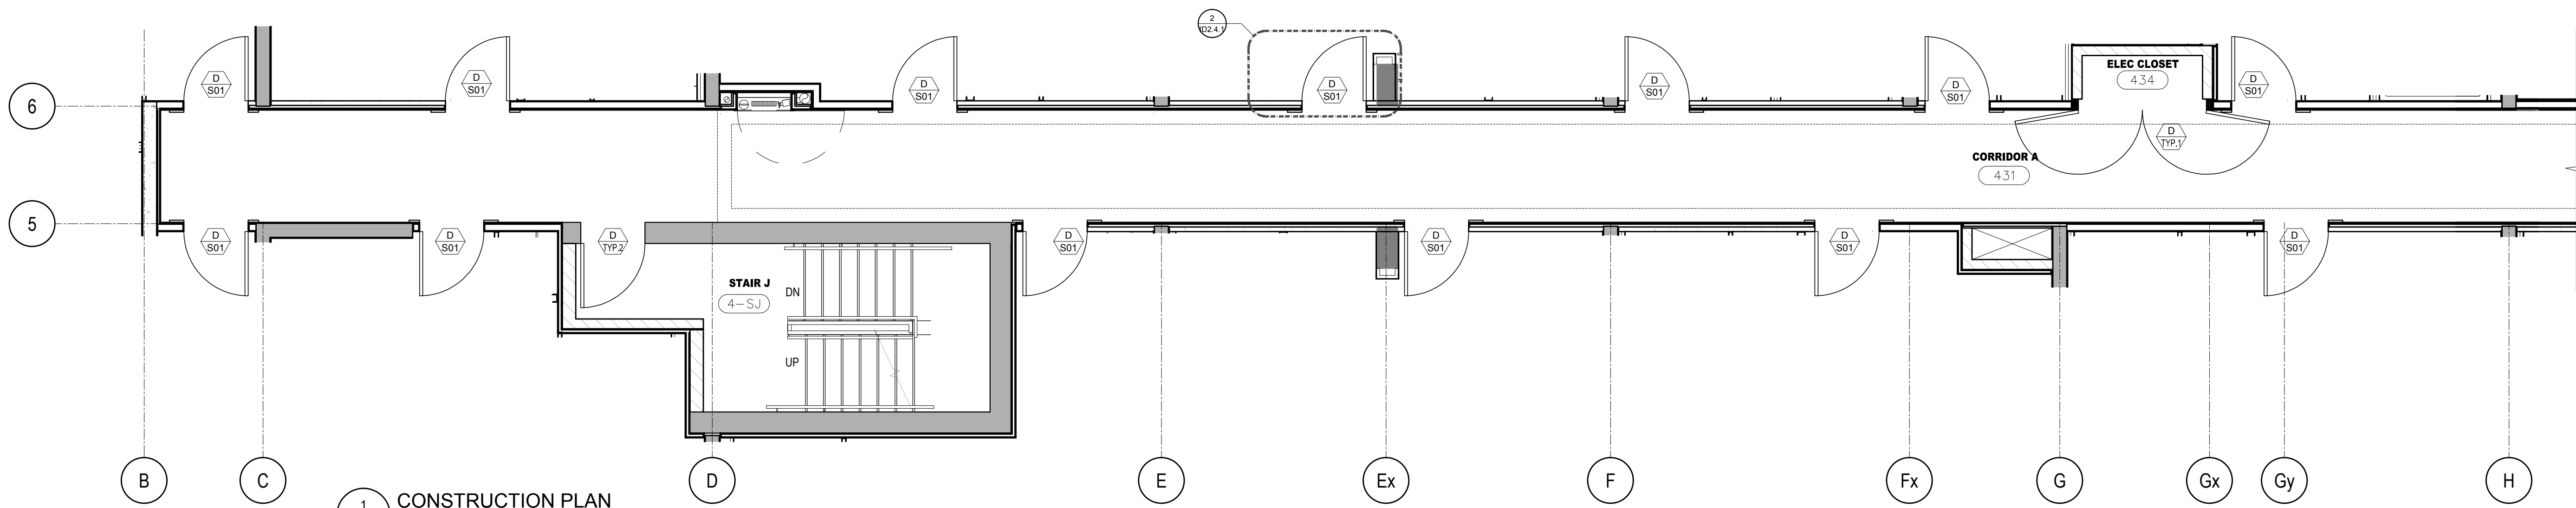

DO NOT SCALE DRAWINGS.

CONTRACTOR MUST VERIFY ALL DRAWINGS, DIMENSIONS, DETAILS AND SPECIFICATIONS AND REPORT ANY DISCREPANCIES TO UNION 31 INC. BEFORE PROCEEDING WITH WORK. MATERIALS MAY NOT BE SUBSTITUTED WITHOUT WRITTEN APPROVAL FROM UNION 31 INC.

ALL DRAWINGS AND SPECIFICATIONS ARE INSTRUMENTS OF SERVICE AND THE PROPERTY OF UNION 31 INC. WHICH MUST BE RETURNED AT THE COMPLETION OF THE WORK.

PRINTED: 30-MAY-17

ISSUED FOR
AS-BUILT


01	31 MAY 17	ISSUED FOR AS-BUILT	SV
NO.	DATE	COMMENTS	INI

REVISIONS:


UNION 31

UNION31 INC.
183 BATHURST STREET, STE. 201
TORONTO, ON, M5T 2R7, CANADA
TEL: 416-597-1576 FAX: 416-597-2139


PROJECT NAME:	ALEXANDRA PARK MAIN BUILDING
PROJECT NO.:	13-949
DRAWINGS:	4TH FLOOR CONSTRUCTION PLAN & REFLECTED CEILING PLAN
DATE STARTED:	07 AUG / 13
SCALE:	1 : 50
DRAWN BY:	AP
APPROVED BY:	KC
DRAWING NO.:	ID 1.4.0

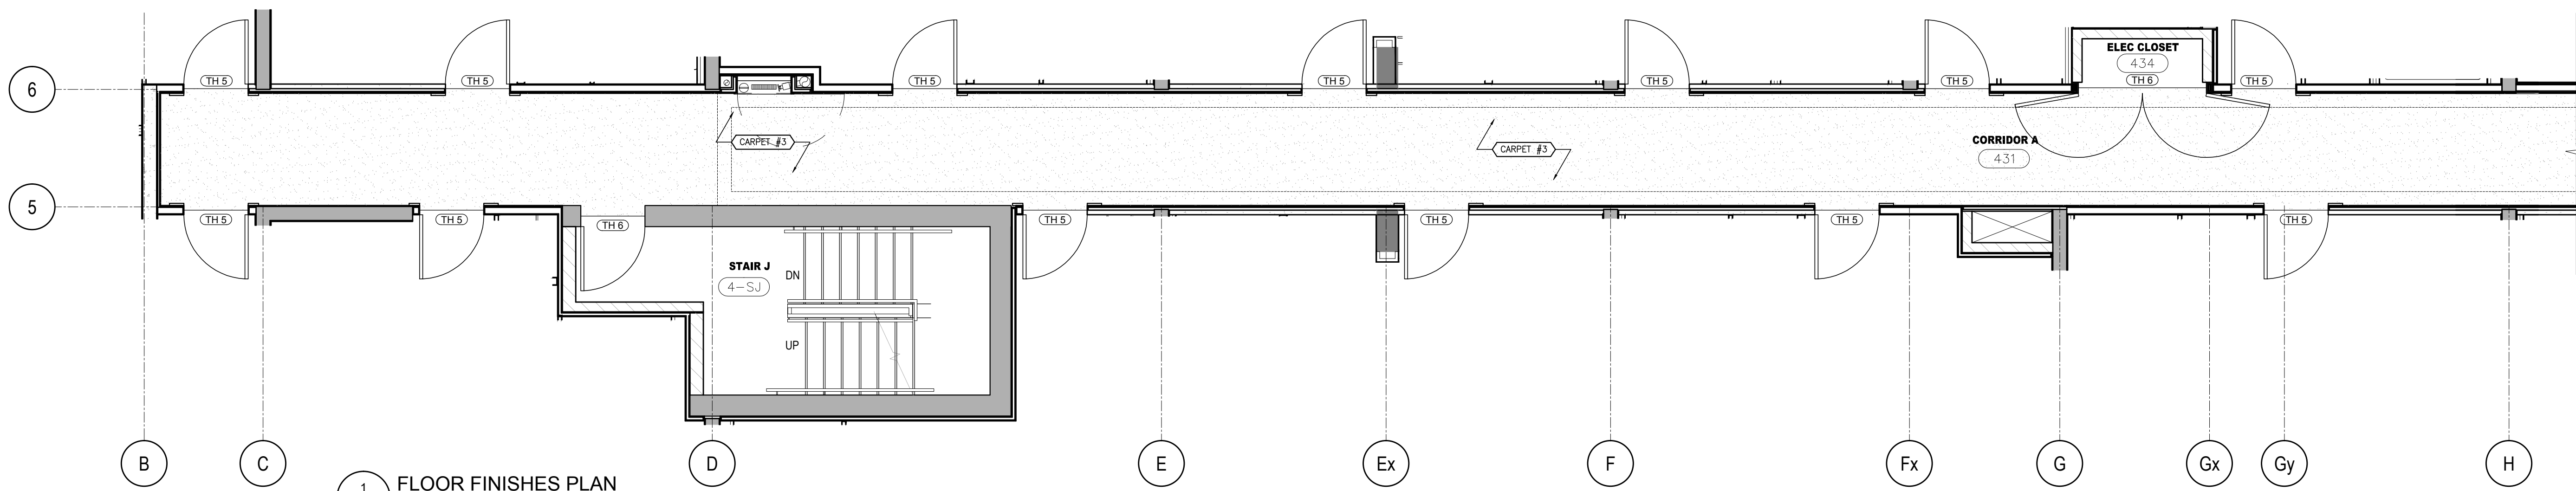


1 FLOOR FINISHES PLAN
4TH FLOOR
SCALE 1:50

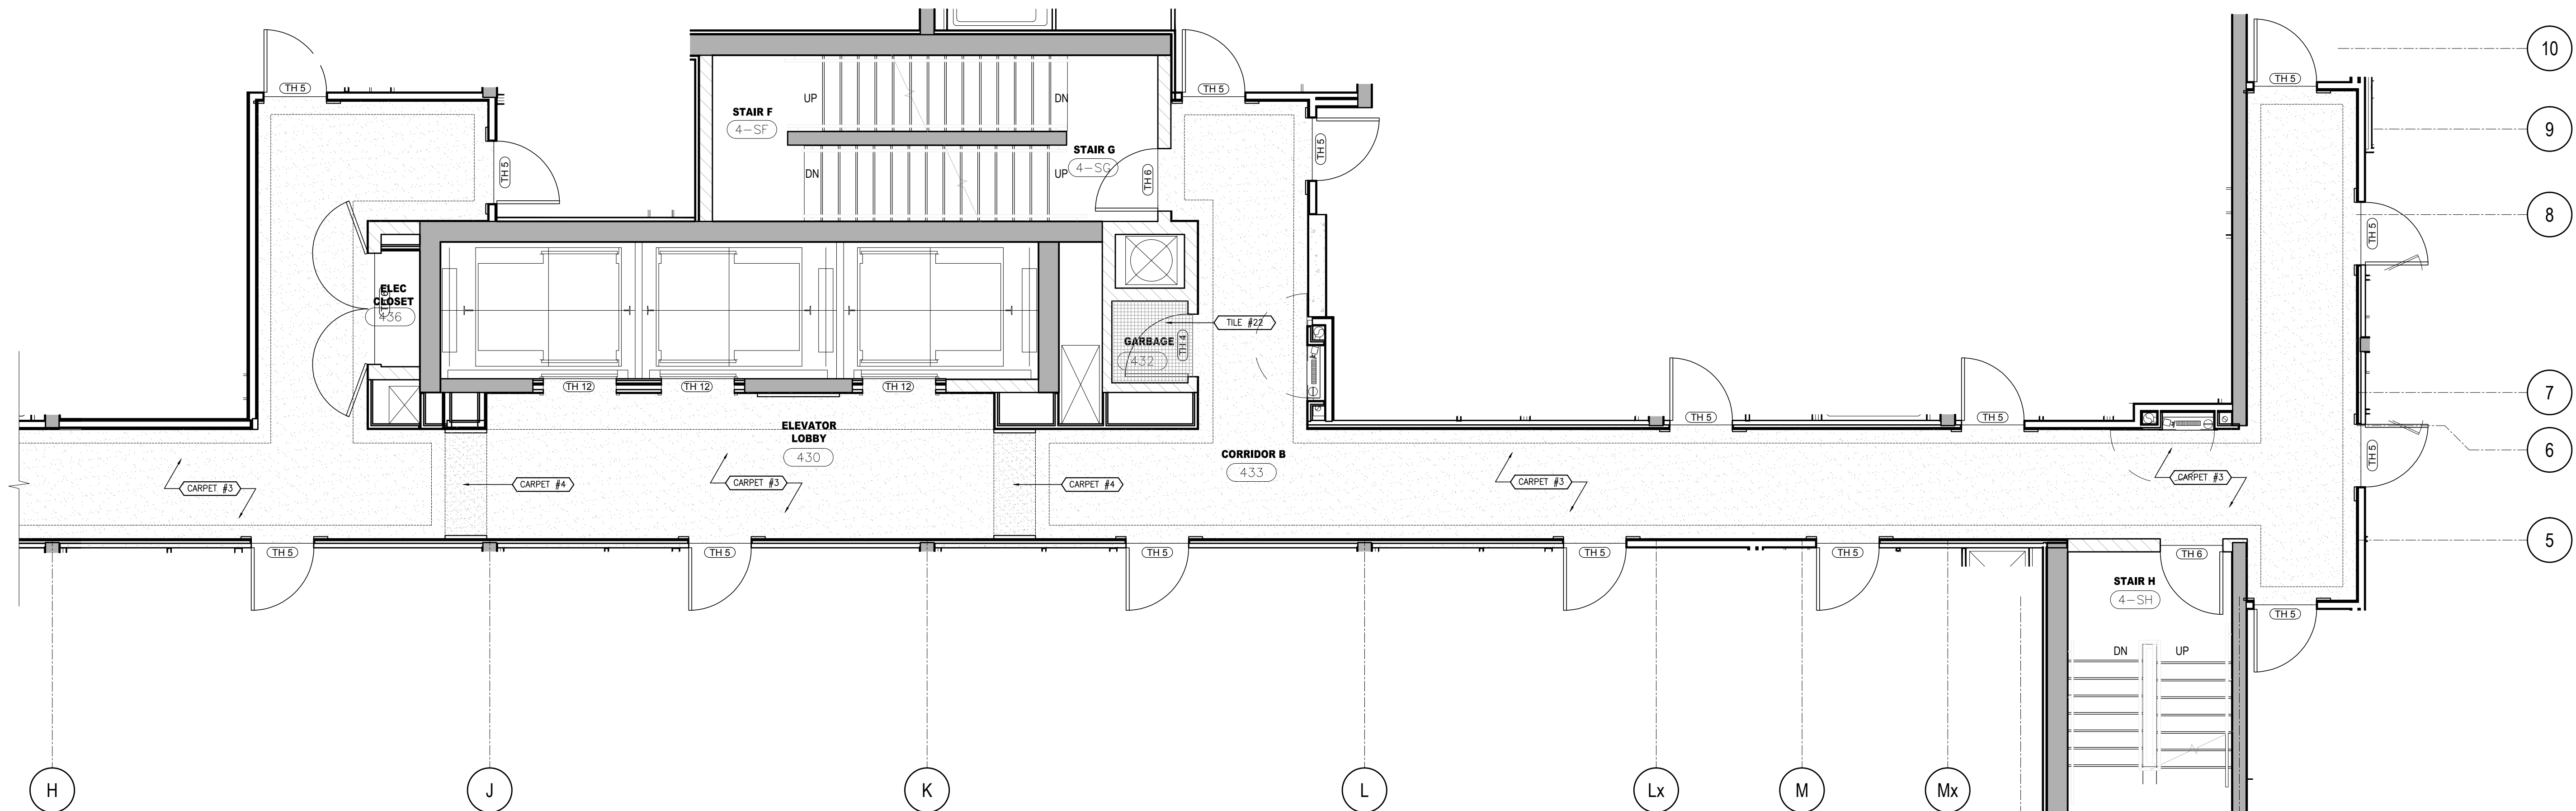

2 FLOOR FINISHES PLAN
4TH FLOOR
SCALE 1:50

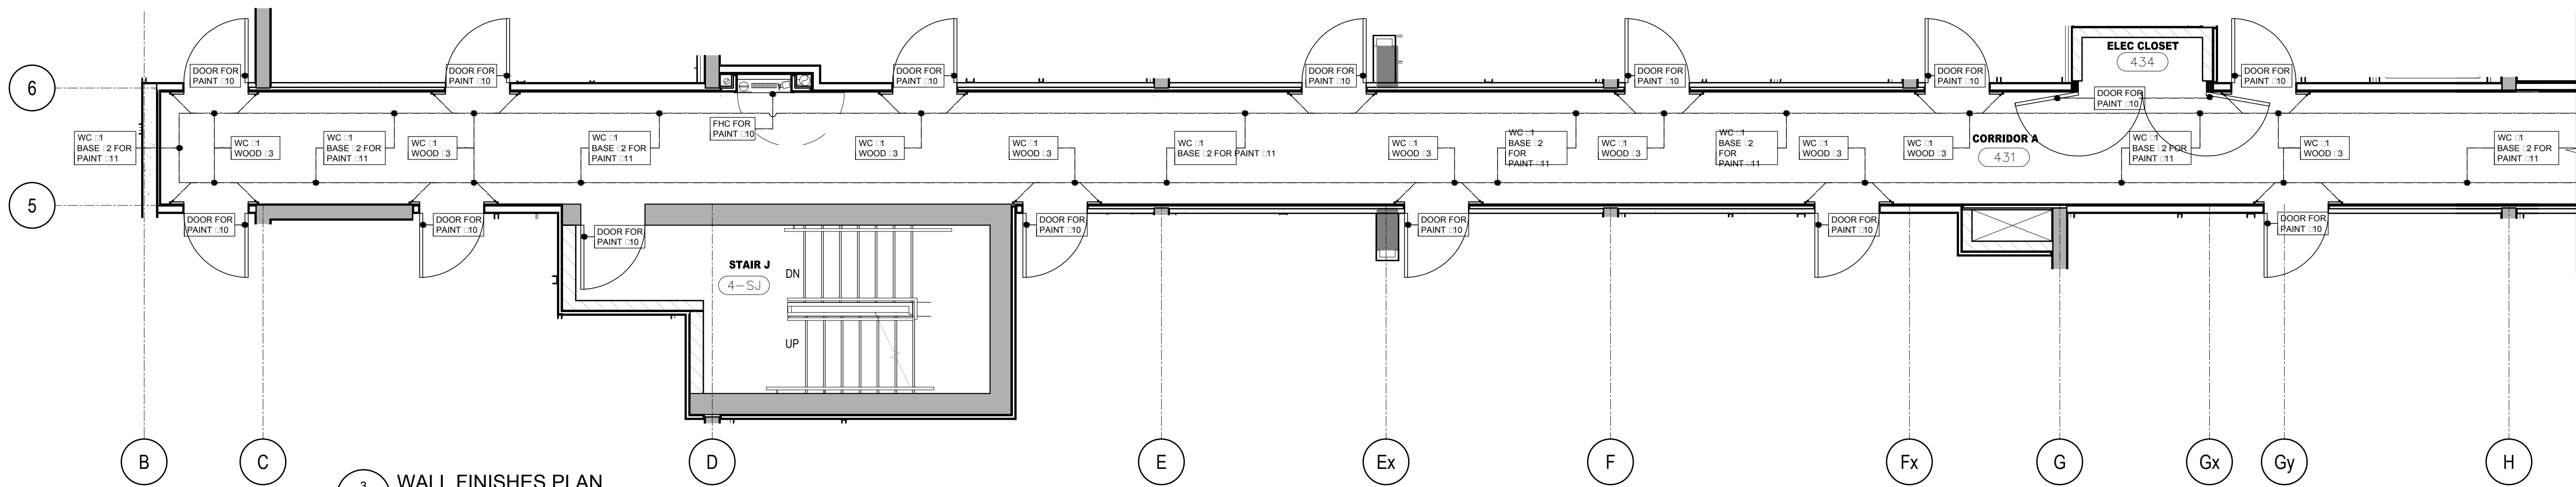

3 WALL FINISHES PLAN
4TH FLOOR
SCALE 1:50

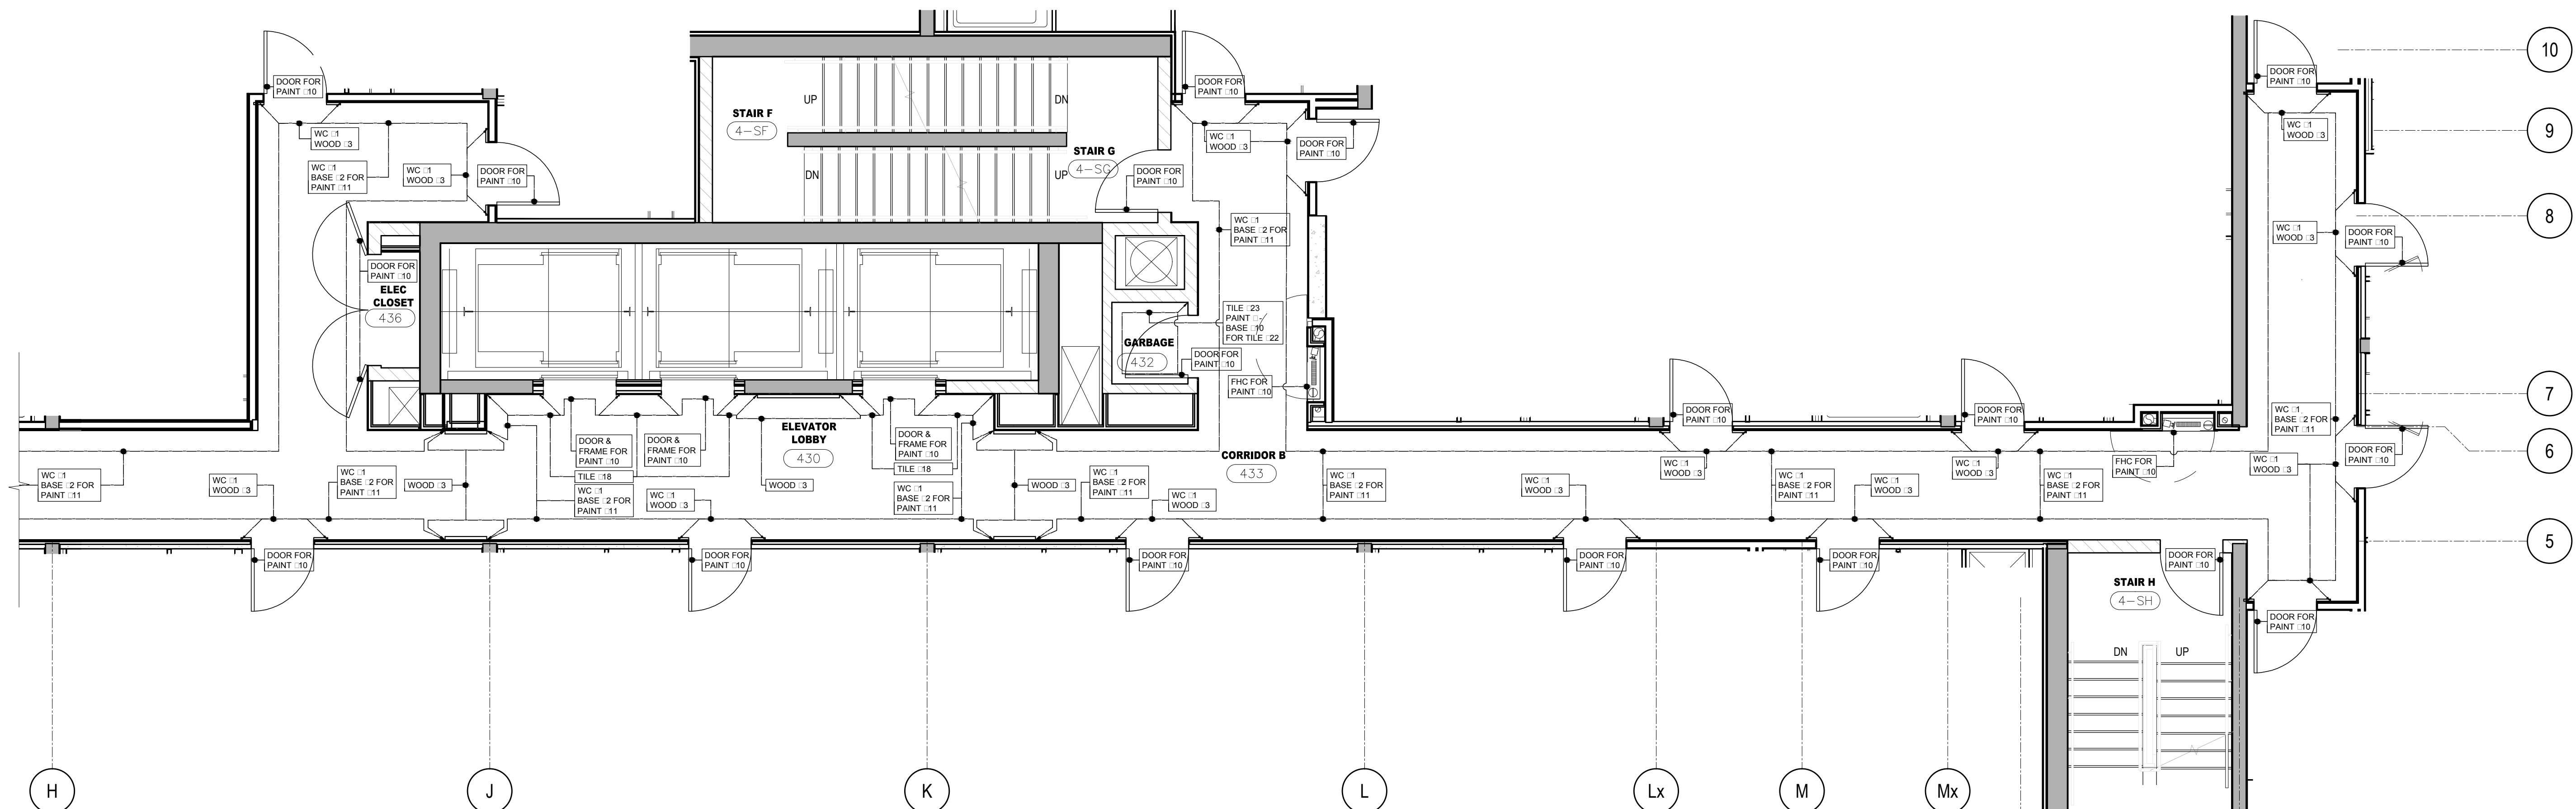

4 WALL FINISHES PLAN
4TH FLOOR
SCALE 1:50

DO NOT SCALE DRAWINGS.

CONTRACTOR MUST VERIFY ALL DRAWINGS, DIMENSIONS, DETAILS AND SPECIFICATIONS AND REPORT ANY DISCREPANCIES TO UNION 31 INC. BEFORE PROCEEDING WITH WORK. MATERIALS MAY NOT BE SUBSTITUTED WITHOUT WRITTEN APPROVAL FROM UNION 31 INC.

ALL DRAWINGS AND SPECIFICATIONS ARE INSTRUMENTS OF SERVICE AND THE PROPERTY OF UNION 31 INC. WHICH MUST BE RETURNED AT THE COMPLETION OF THE WORK.

PRINTED: 30-MAY-17

ISSUED FOR
AS-BUILT



01	31 MAY / 17	ISSUED FOR AS-BUILT	SV
NO.	DATE	COMMENTS	INI

REVISIONS:

UNION 31

UNION31 INC.
183 BATHURST STREET, STE. 201
TORONTO, ON, M5T 2R7, CANADA
TEL: 416-597-1576 FAX: 416-597-2139

PROJECT NAME:		ALEXANDRA PARK MAIN BUILDING	
		BLOCK 11 ON, Canada	
PROJECT NO.:		13-949	
DRAWINGS:		4TH FLOOR FLOOR FINISHES PLAN & WALL FINISHES PLAN	
DATE STARTED: 07 AUG / 13		DRAWING NO.:	
SCALE: 1" = 50'		ID	
DRAWN BY: AP		1.4.1	
APPROVED BY: KC			

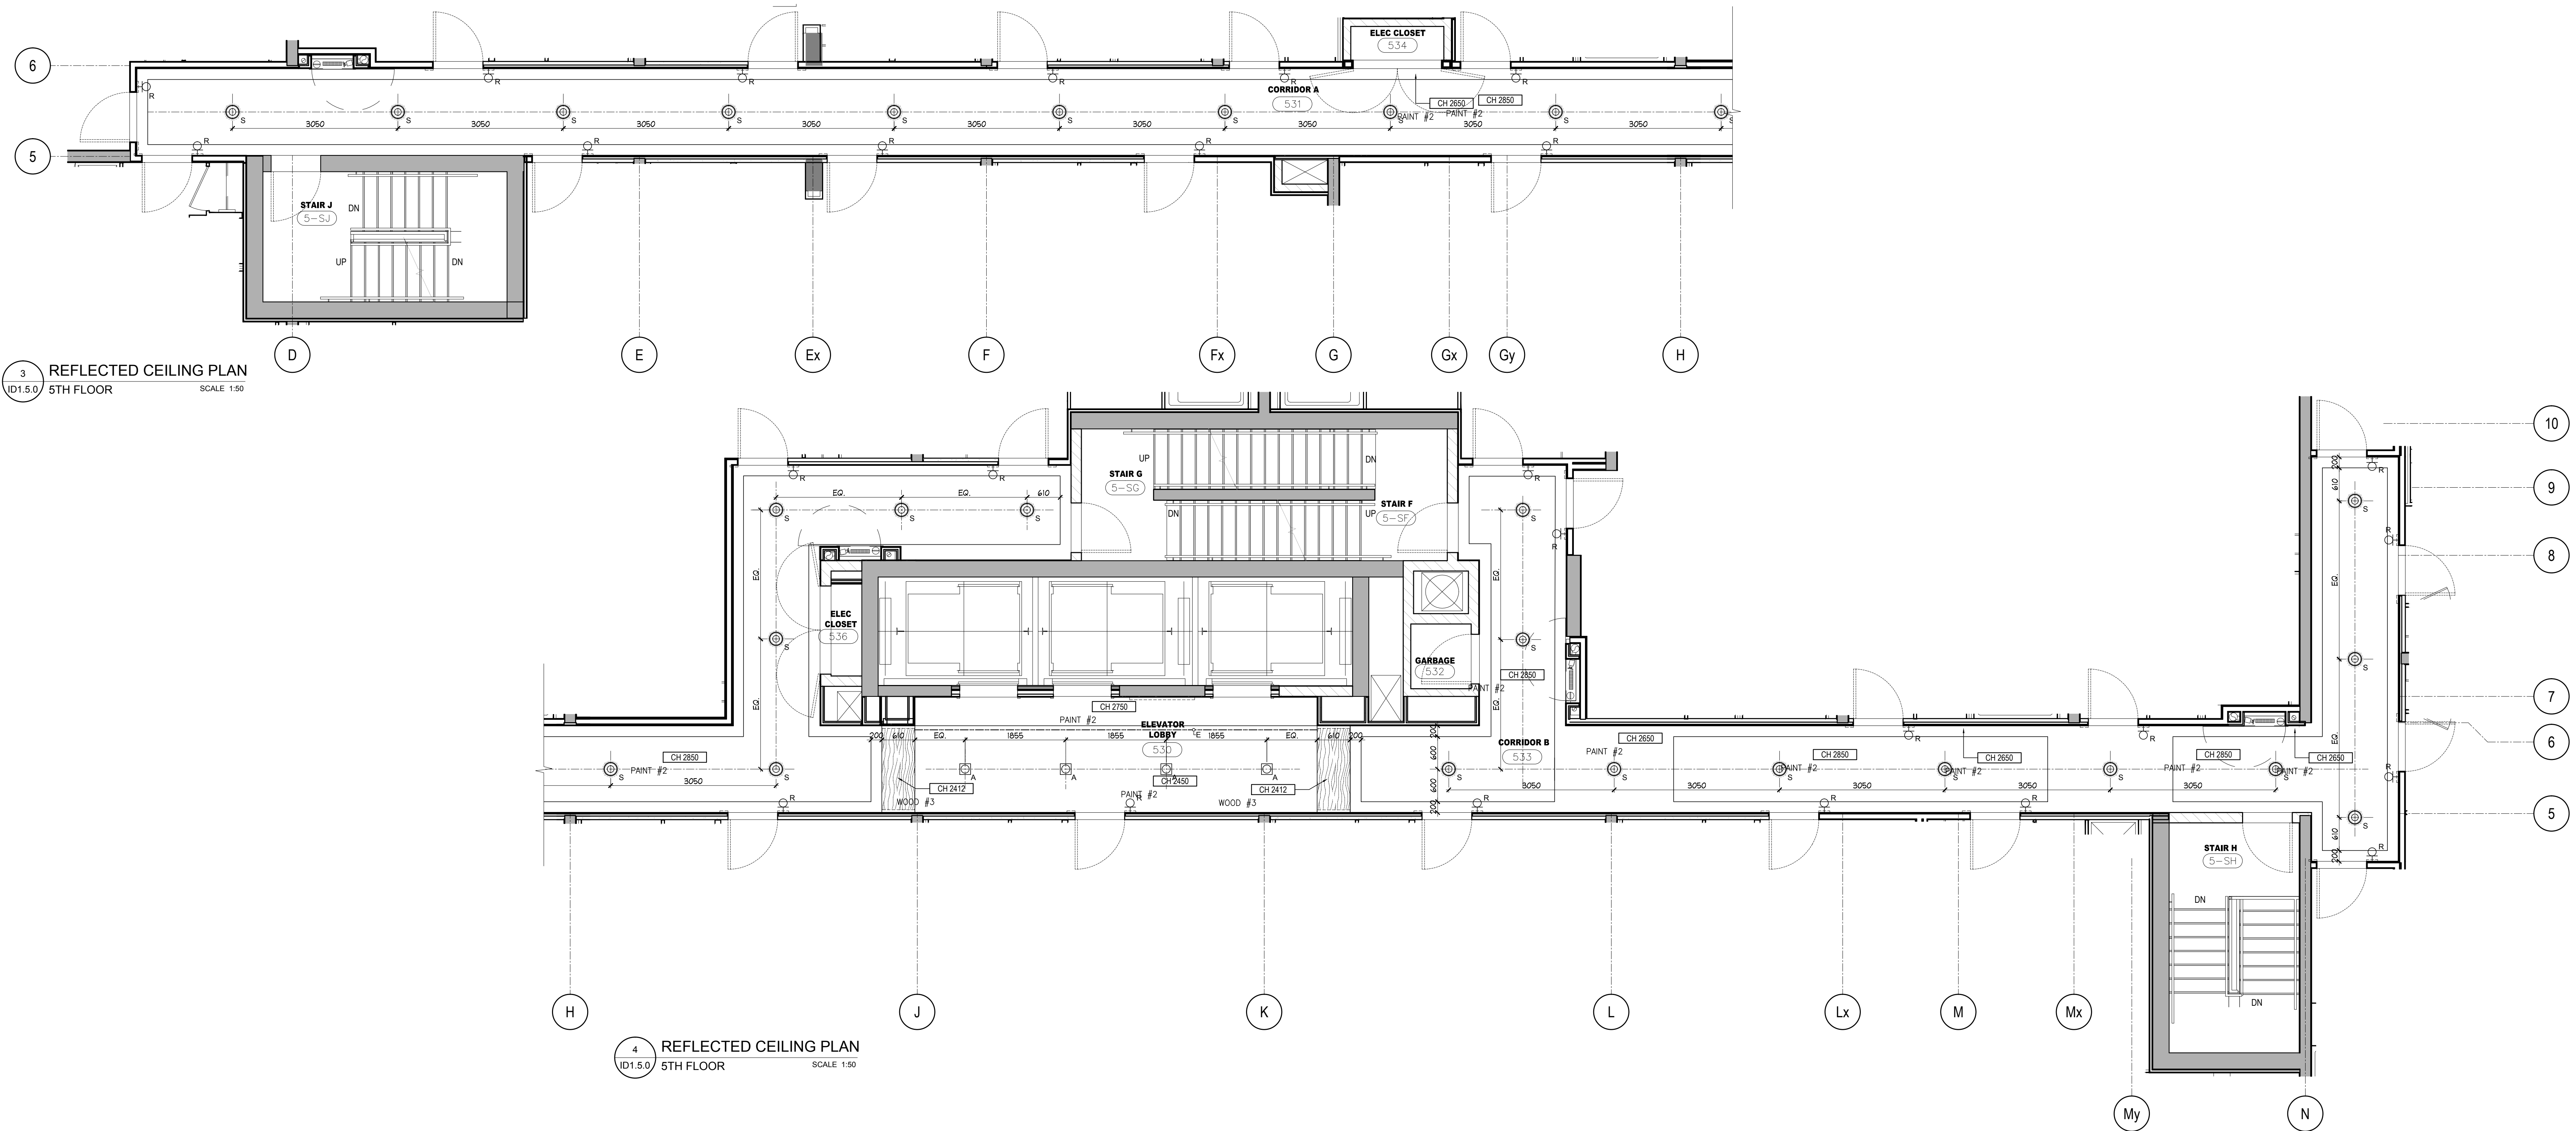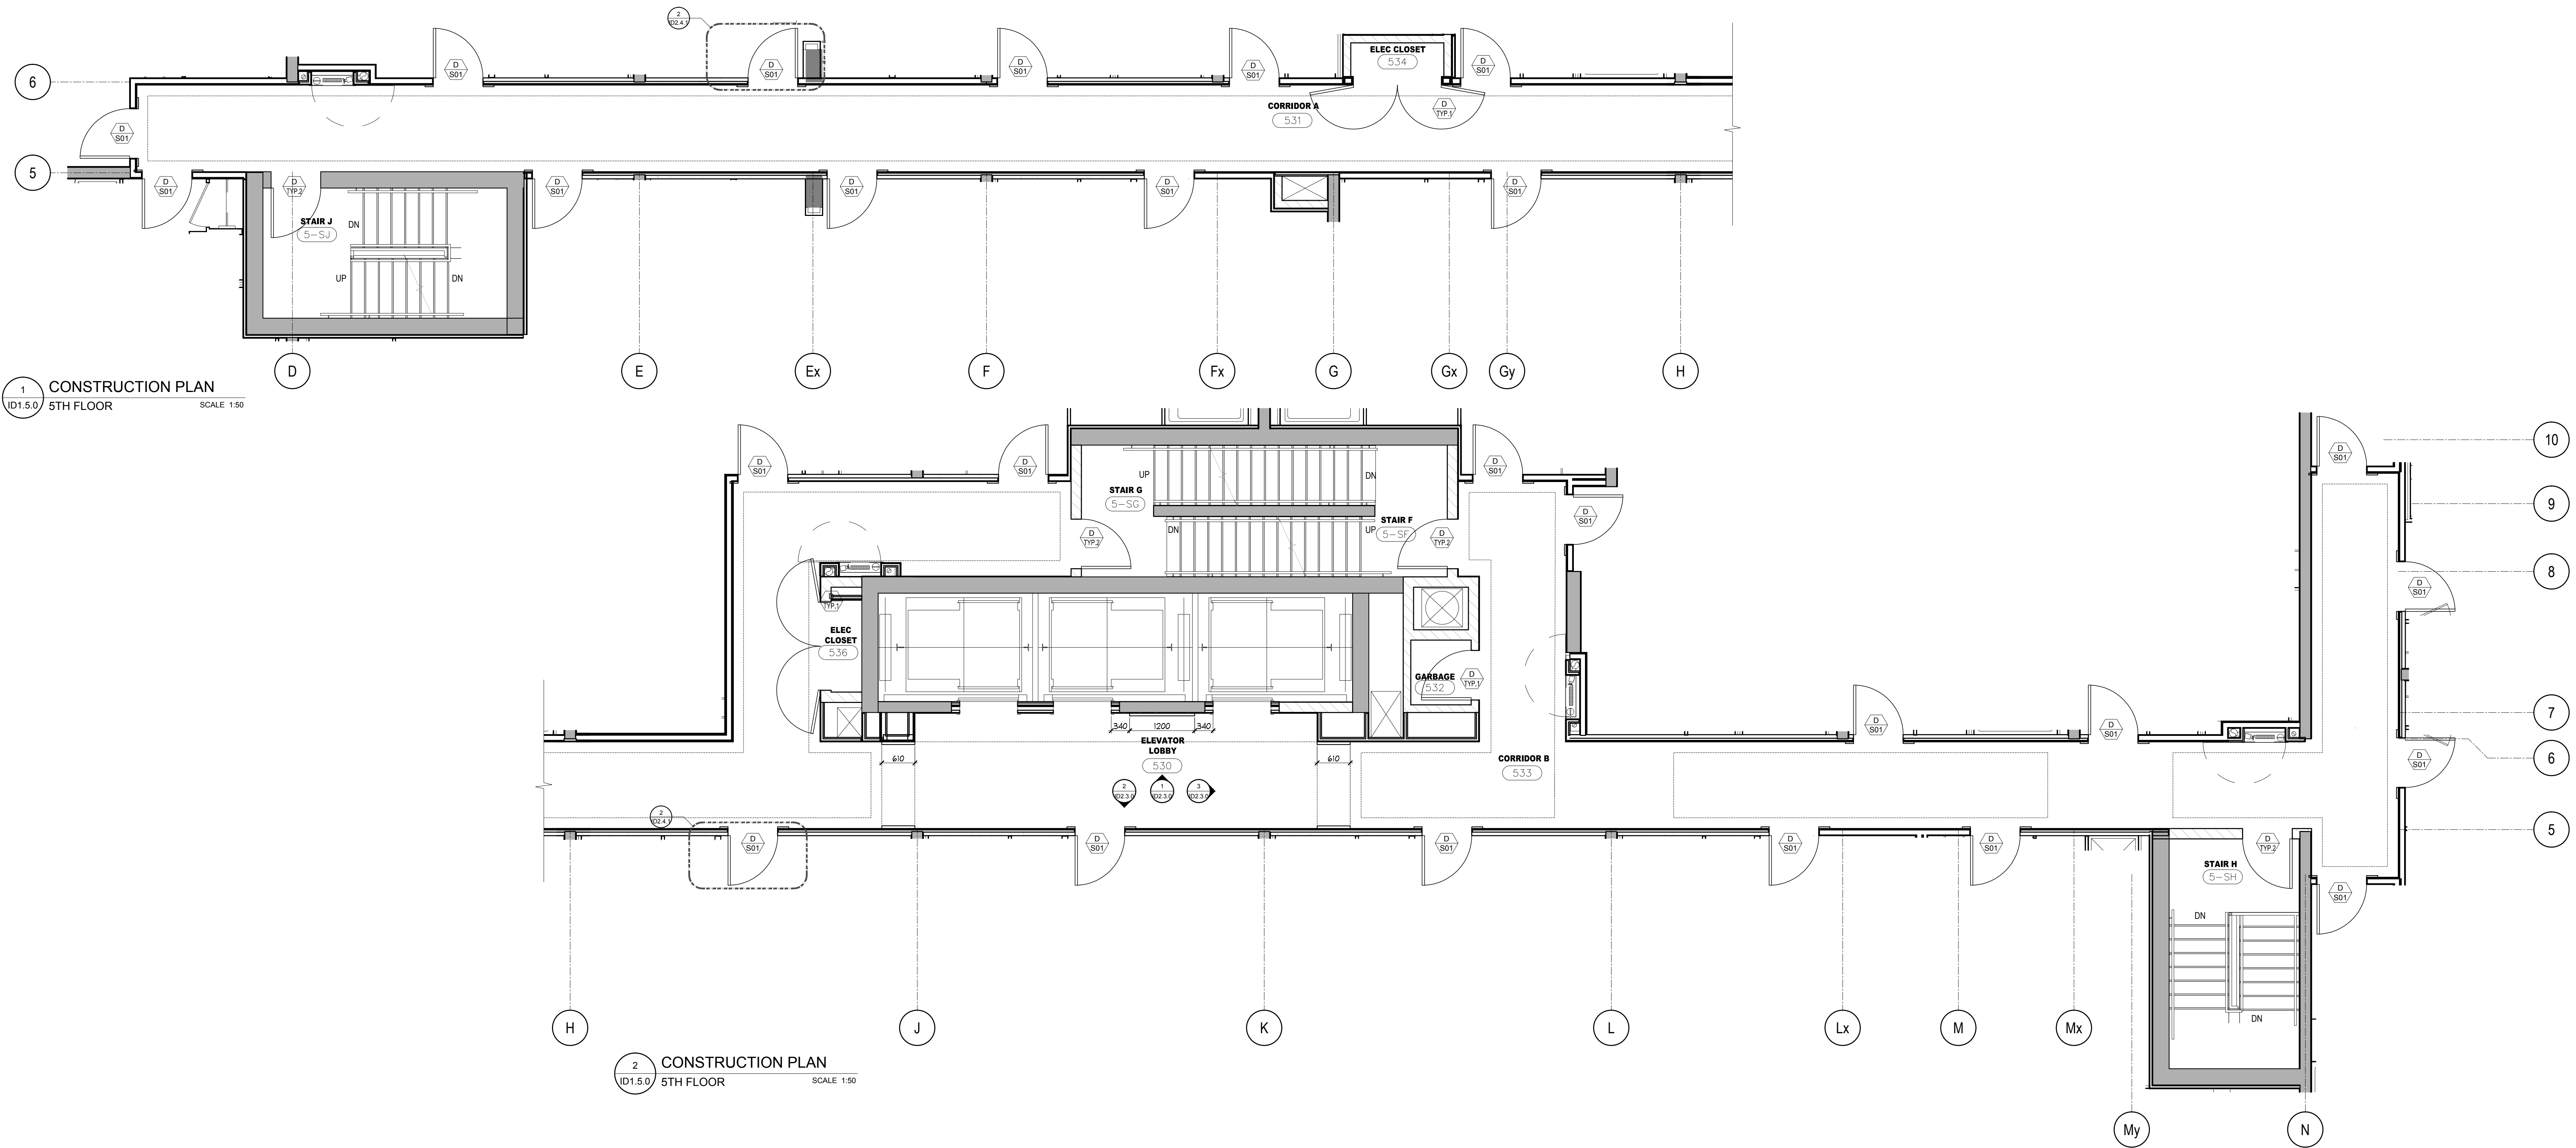

DO NOT SCALE DRAWINGS.

CONTRACTOR MUST VERIFY ALL DRAWINGS, DIMENSIONS, DETAILS AND SPECIFICATIONS AND REPORT ANY DISCREPANCIES TO UNION 31 INC. BEFORE PROCEEDING WITH WORK. MATERIALS MAY NOT BE SUBSTITUTED WITHOUT WRITTEN APPROVAL FROM UNION 31 INC.

ALL DRAWINGS AND SPECIFICATIONS ARE INSTRUMENTS OF SERVICE AND THE PROPERTY OF UNION 31 INC. WHICH MUST BE RETURNED AT THE COMPLETION OF THE WORK.

PRINTED: 30-MAY-17

ISSUED FOR
AS-BUILT


01	31 MAY / 17	ISSUED FOR AS-BUILT	SV
NO.	DATE	COMMENTS	INI

REVISIONS:


UNION31

UNION31 INC.
183 BATHURST STREET, STE. 201
TORONTO, ON, M5T 2R7, CANADA
TEL: 416-597-1576 FAX: 416-597-2139


PROJECT NAME:		ALEXANDRA PARK MAIN BUILDING	
PROJECT NO.:		13-949	
DRAWINGS:		5TH FLOOR CONSTRUCTION PLAN & REFLECTED CEILING PLAN	
DATE STARTED:	07 AUG / 13	DRAWING NO.:	ID
SCALE:	1 : 50	DRAWN BY:	AP
APPROVED BY:	KC	DRAWING NO.:	1.5.0

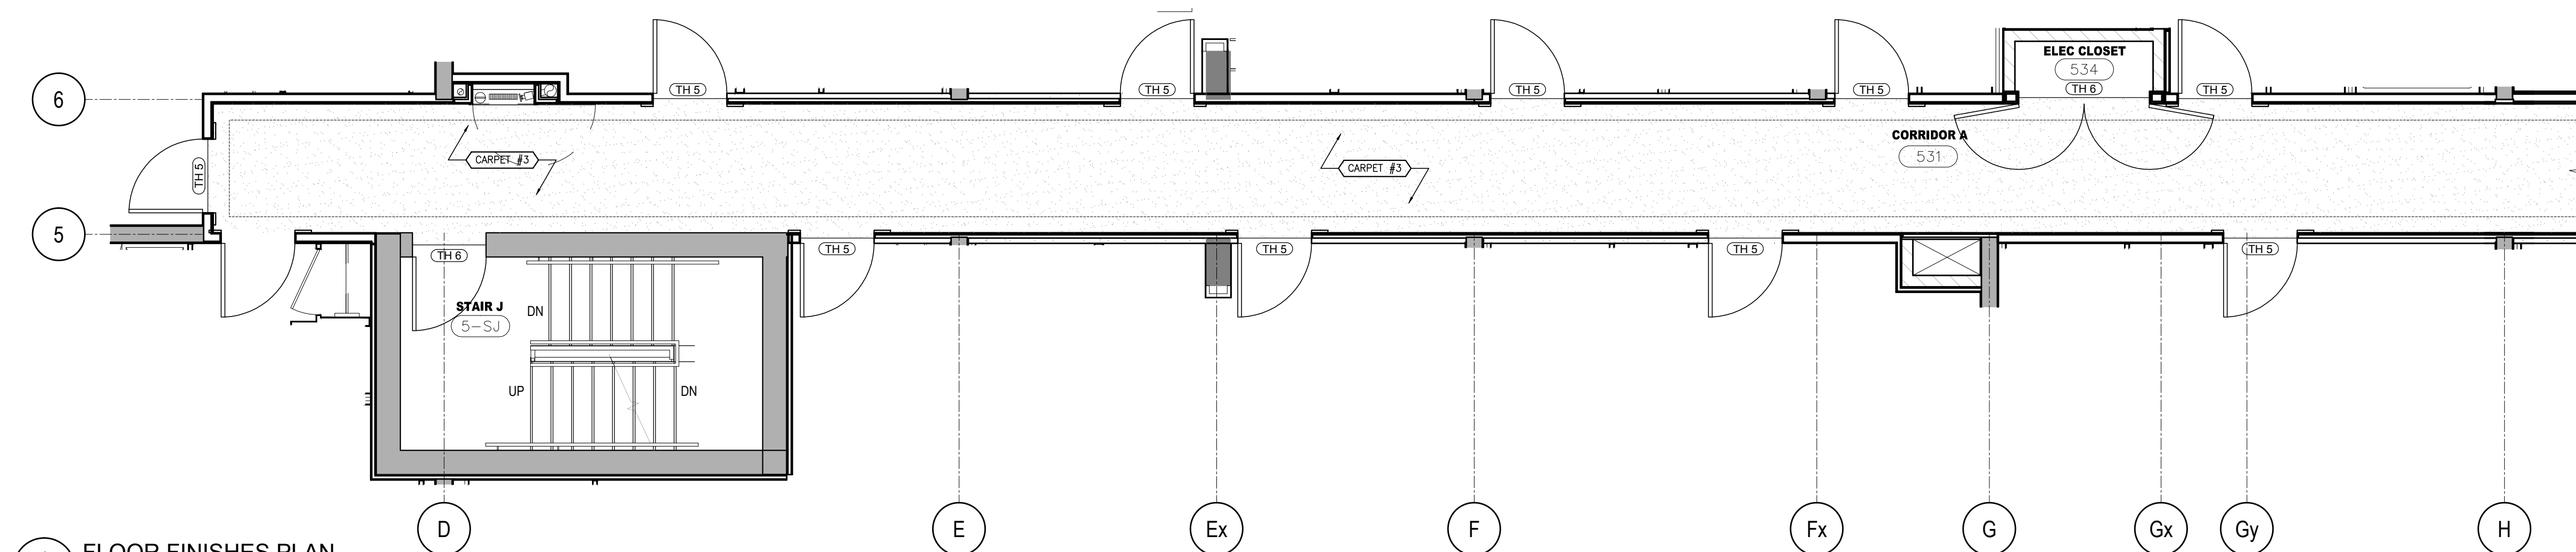


1 FLOOR FINISHES PLAN
5TH FLOOR
SCALE 1:50

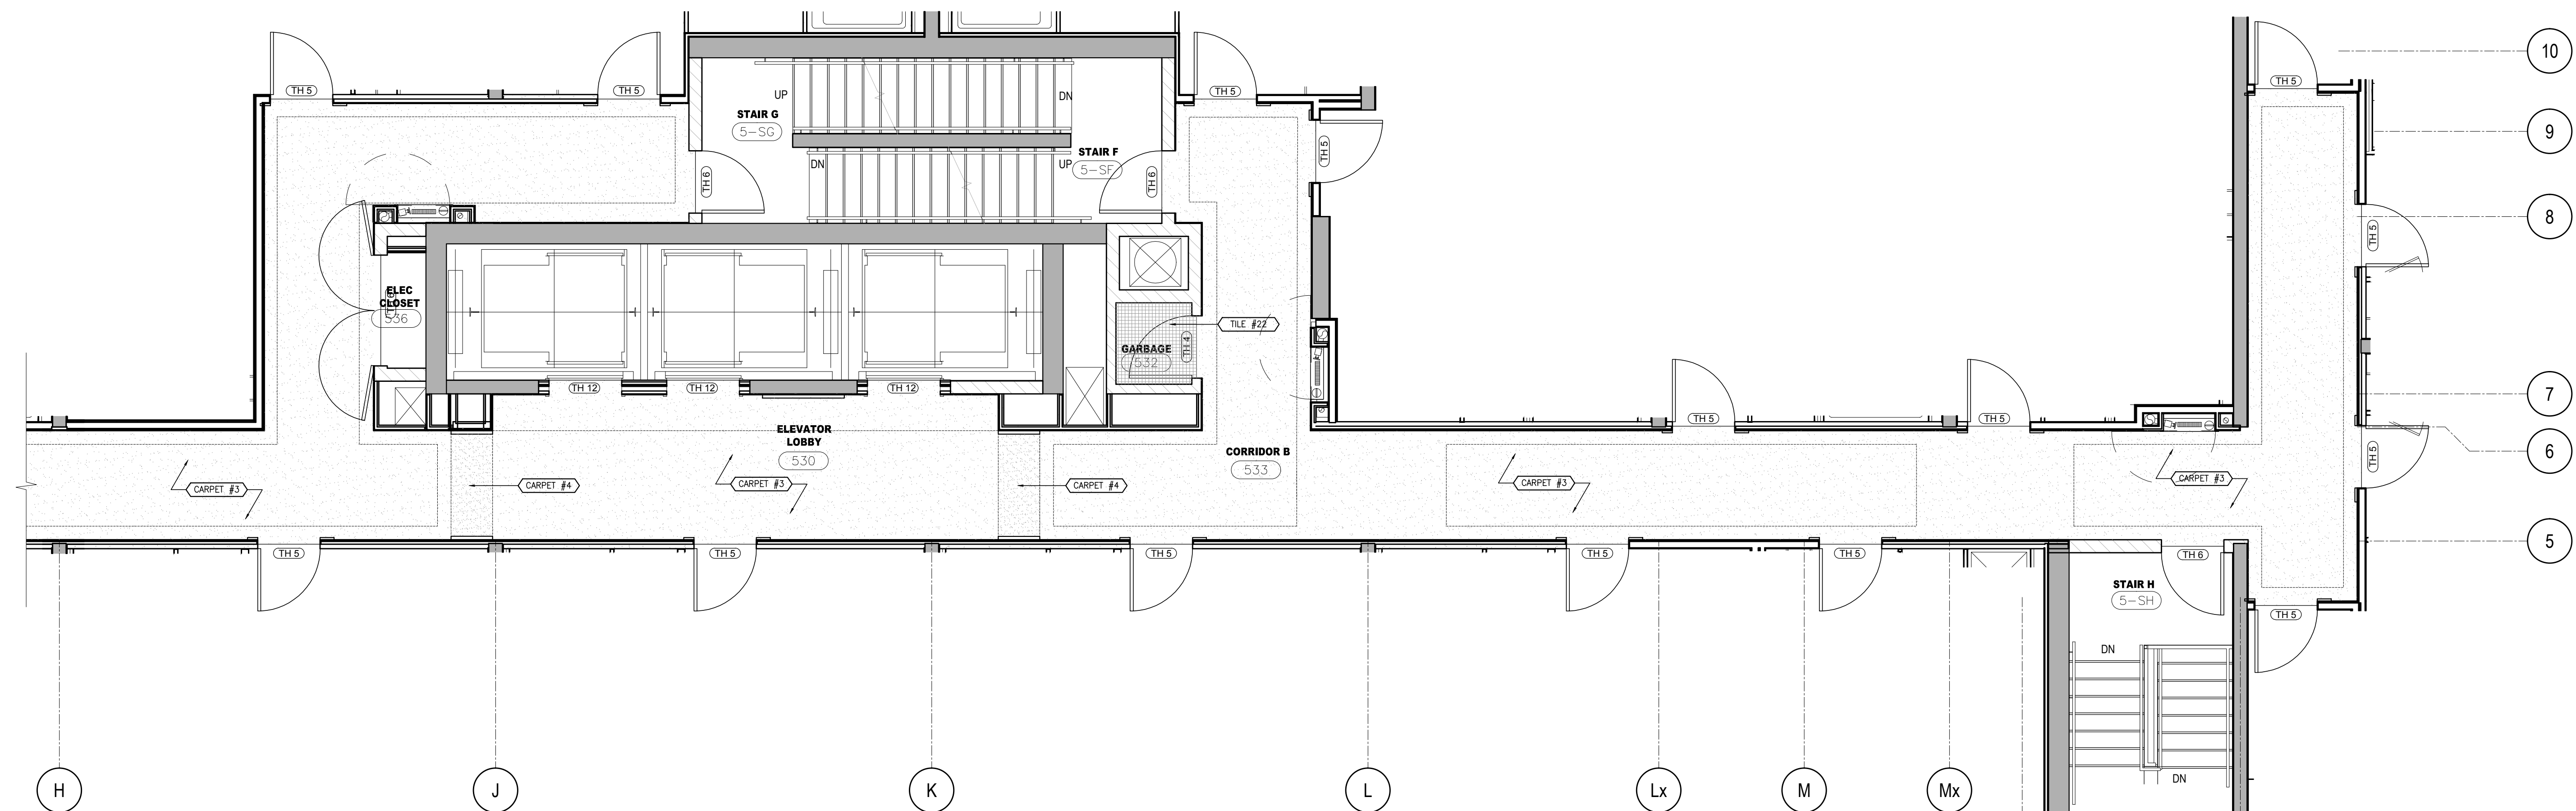

2 FLOOR FINISHES PLAN
5TH FLOOR
SCALE 1:50

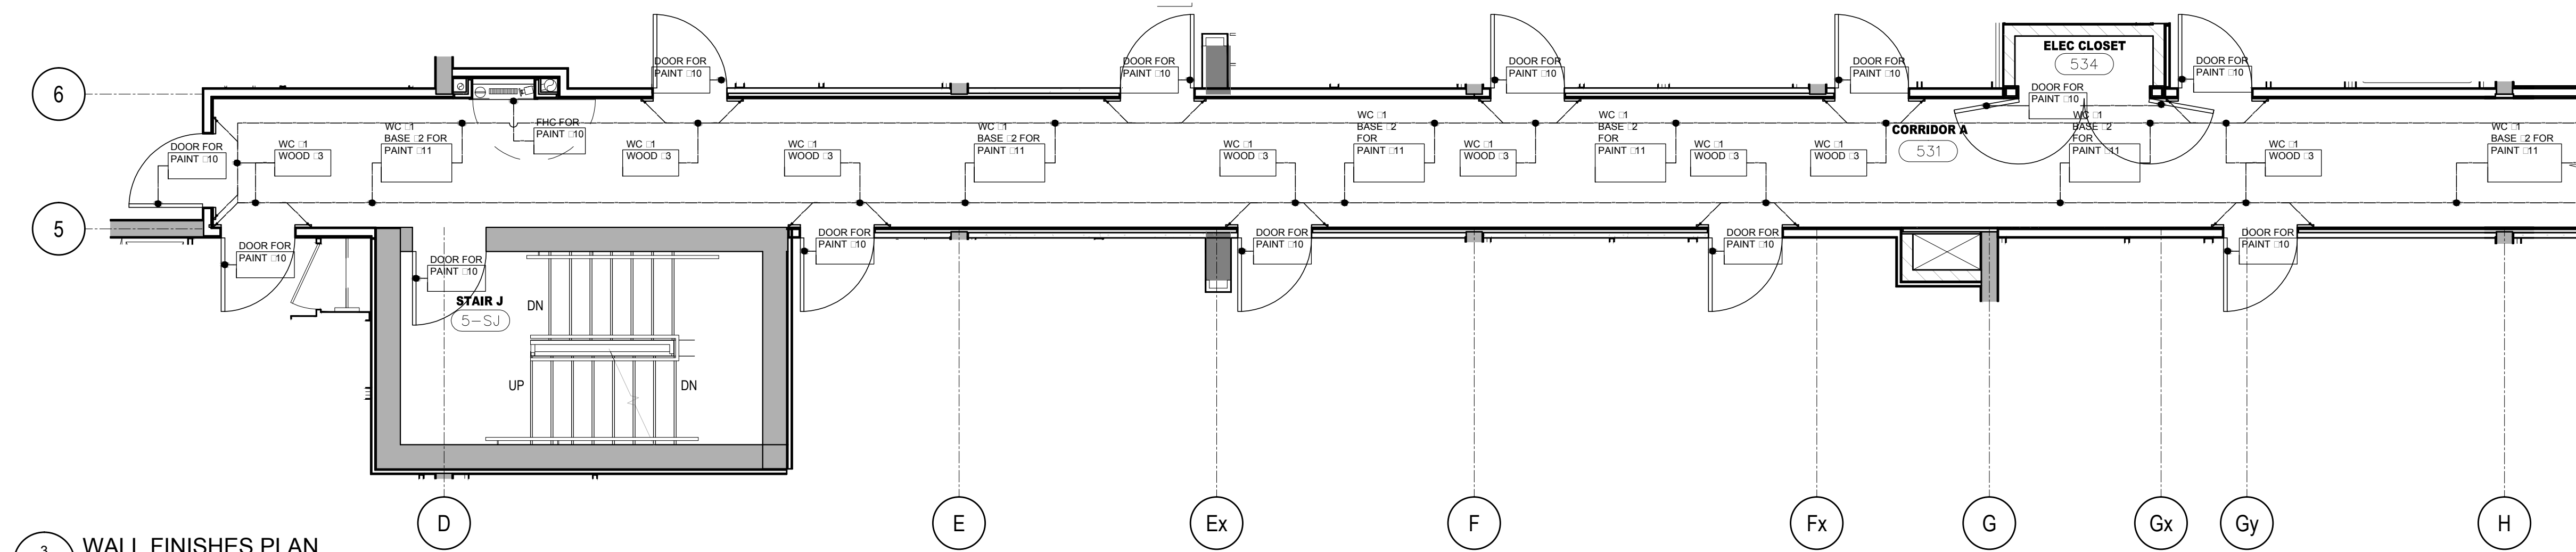

3 WALL FINISHES PLAN
5TH FLOOR
SCALE 1:50

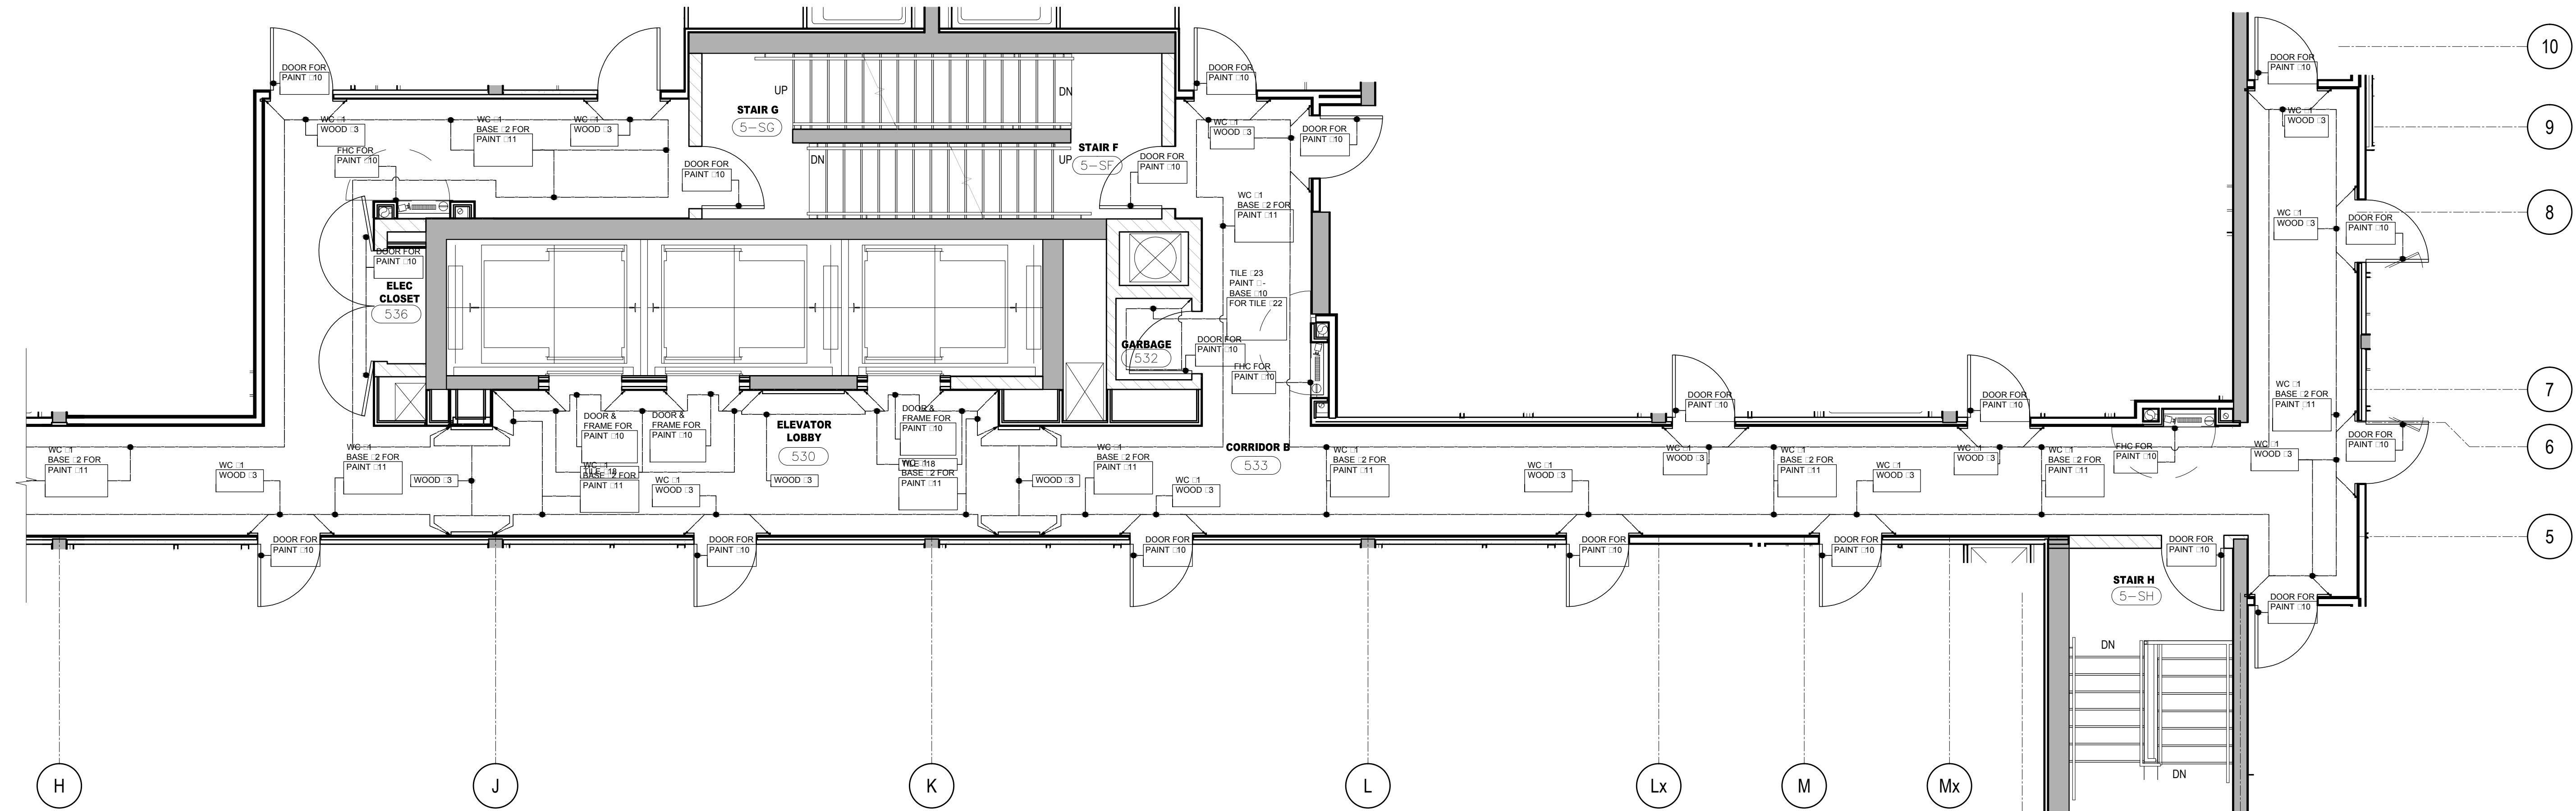

4 WALL FINISHES PLAN
5TH FLOOR
SCALE 1:50

DO NOT SCALE DRAWINGS.
CONTRACTOR MUST VERIFY ALL DRAWINGS, DIMENSIONS, DETAILS AND SPECIFICATIONS. AND REPORT ANY DISCREPANCIES TO UNION 31 INC. BEFORE PROCEEDING WITH WORK. MATERIALS MAY NOT BE SUBSTITUTED WITHOUT WRITTEN APPROVAL FROM UNION 31 INC.
ALL DRAWINGS AND SPECIFICATIONS ARE INSTRUMENTS OF SERVICE AND THE PROPERTY OF UNION 31 INC. WHICH MUST BE RETURNED AT THE COMPLETION OF THE WORK.

PRINTED: 30-MAR-17


ISSUED FOR
AS-BUILT

01	31 MAY / 17	ISSUED FOR AS-BUILT	SV
NO.	DATE	COMMENTS	INI
REVISIONS:			


UNION 31

UNION31 INC.
183 BATHURST STREET, STE. 201
TORONTO, ON, M5T 2R7, CANADA
TEL: 416-597-1576 FAX: 416-597-2139


PROJECT NAME:		ALEXANDRA PARK MAIN BUILDING	
PROJECT NO.:		13-949	
DRAWINGS:		5TH FLOOR FLOOR FINISHES PLAN & WALL FINISHES PLAN	
DATE STARTED:		07 AUG / 13	
SCALE:		1 : 50	
DRAWN BY:		AP	
APPROVED BY:		KC	
DRAWING NO.:		ID 1.5.1	

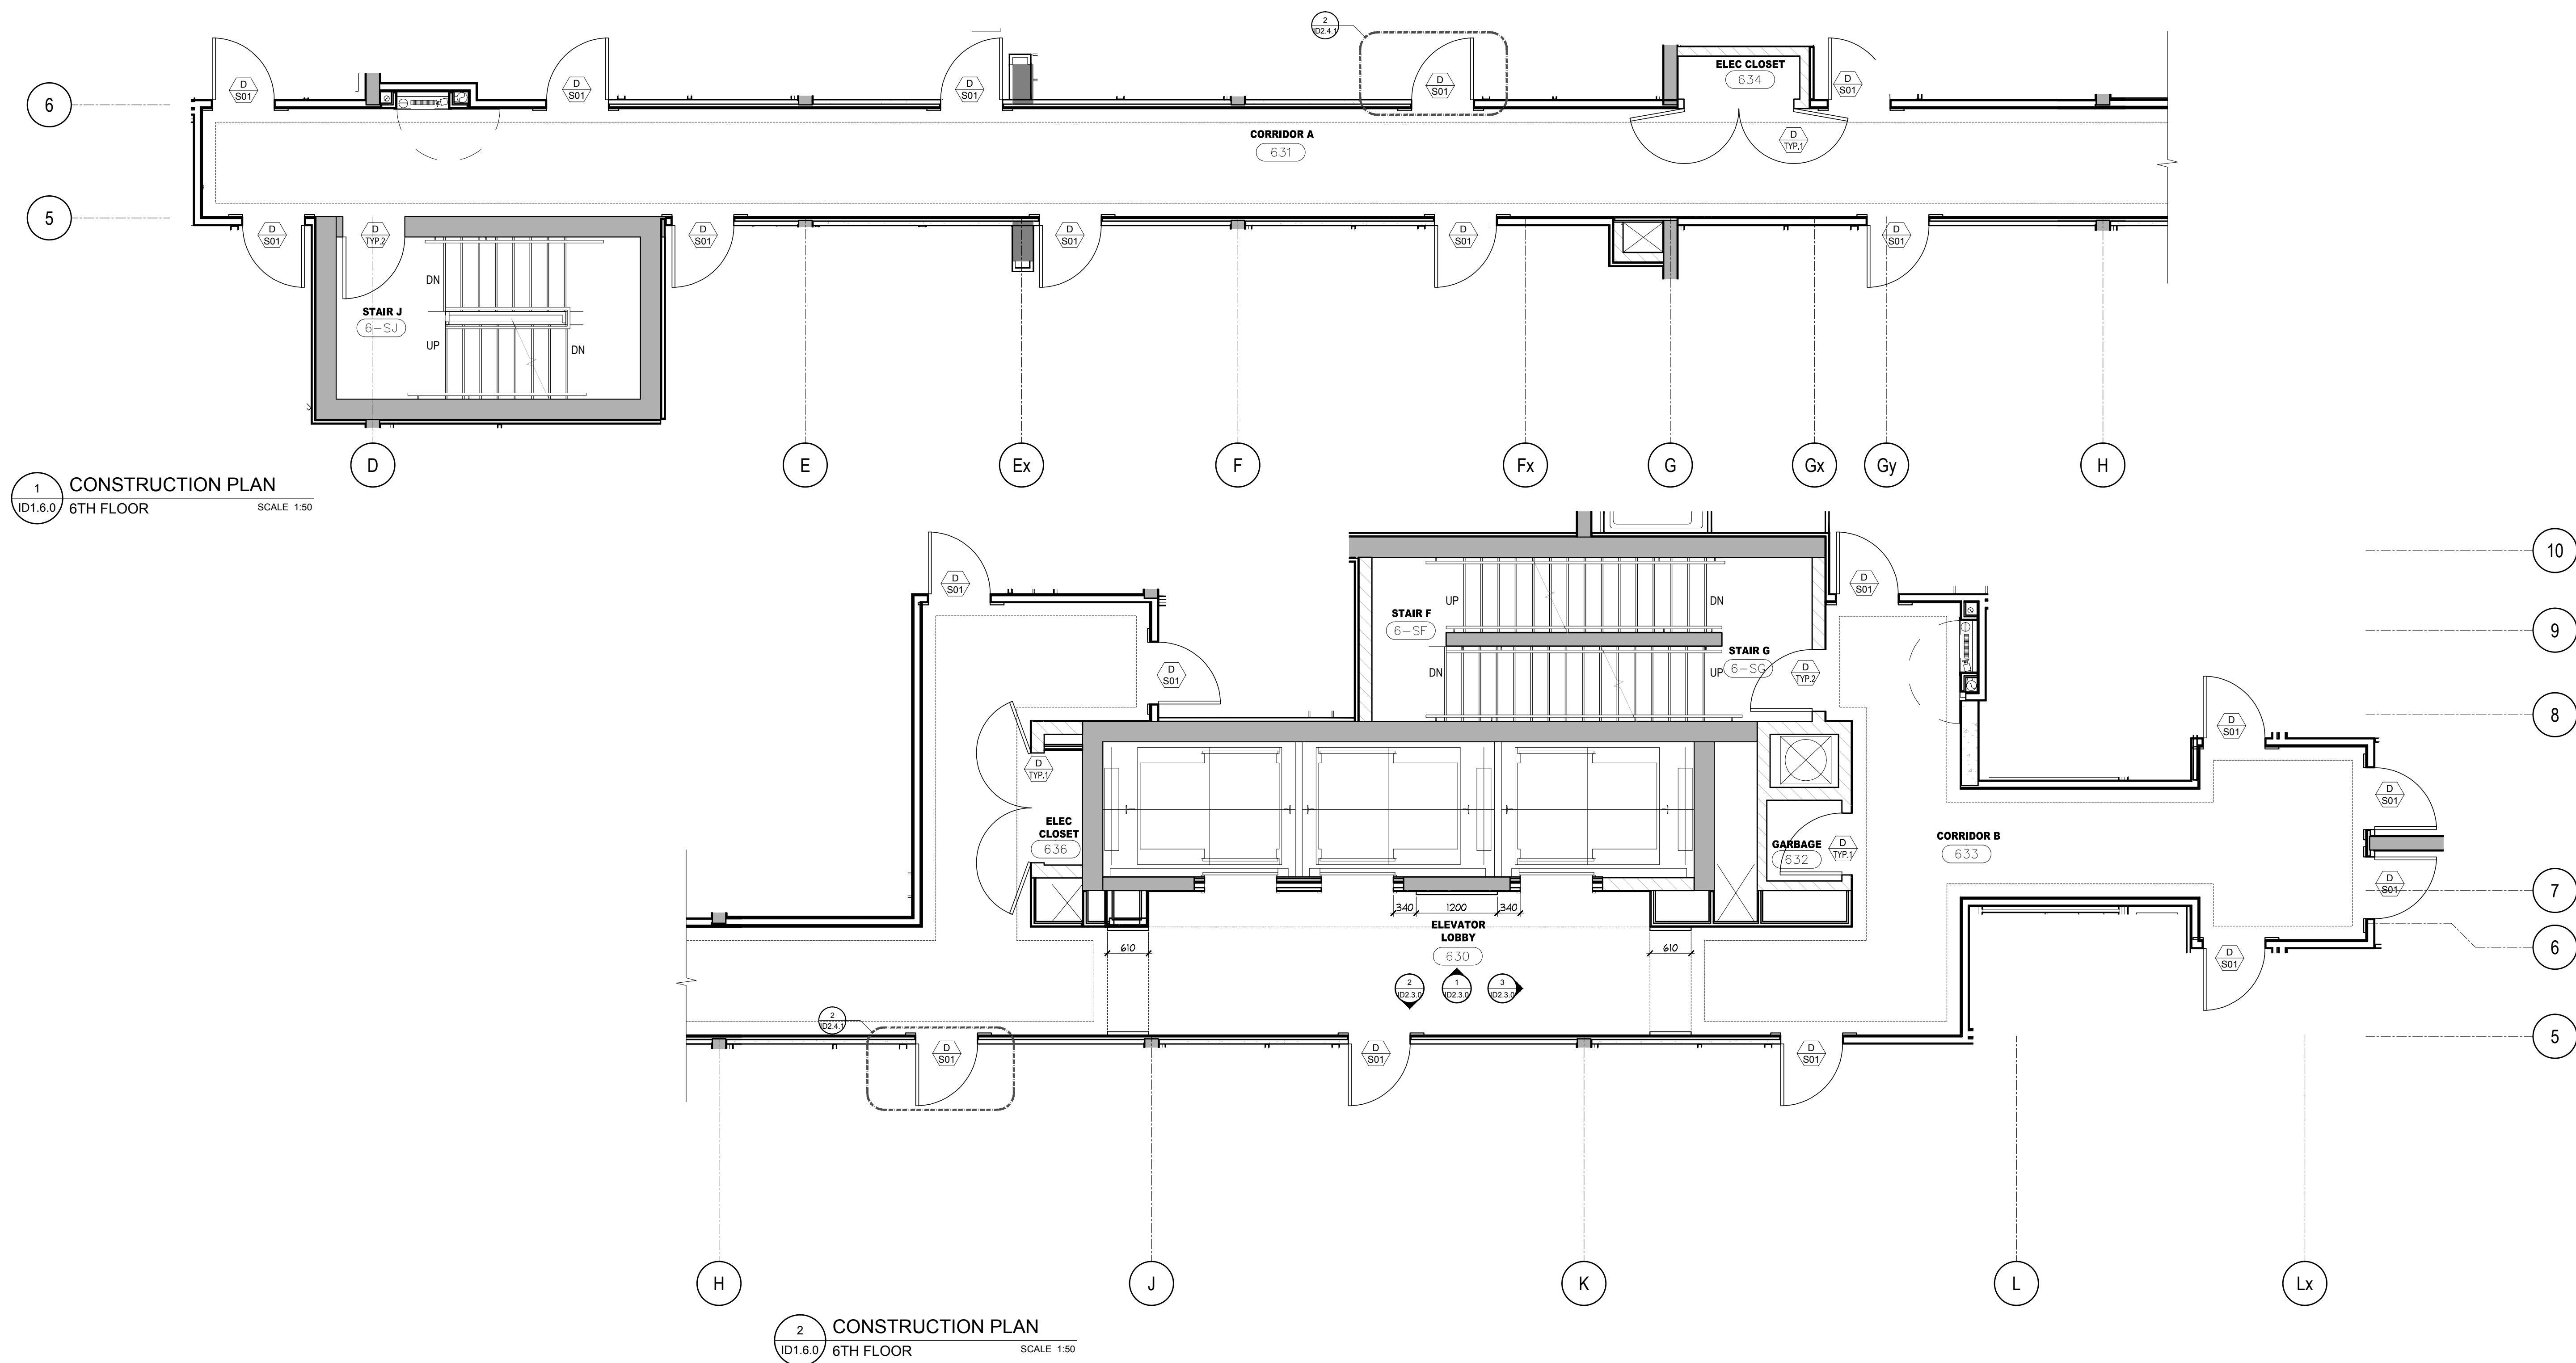


1 CONSTRUCTION PLAN
6TH FLOOR
SCALE 1:50

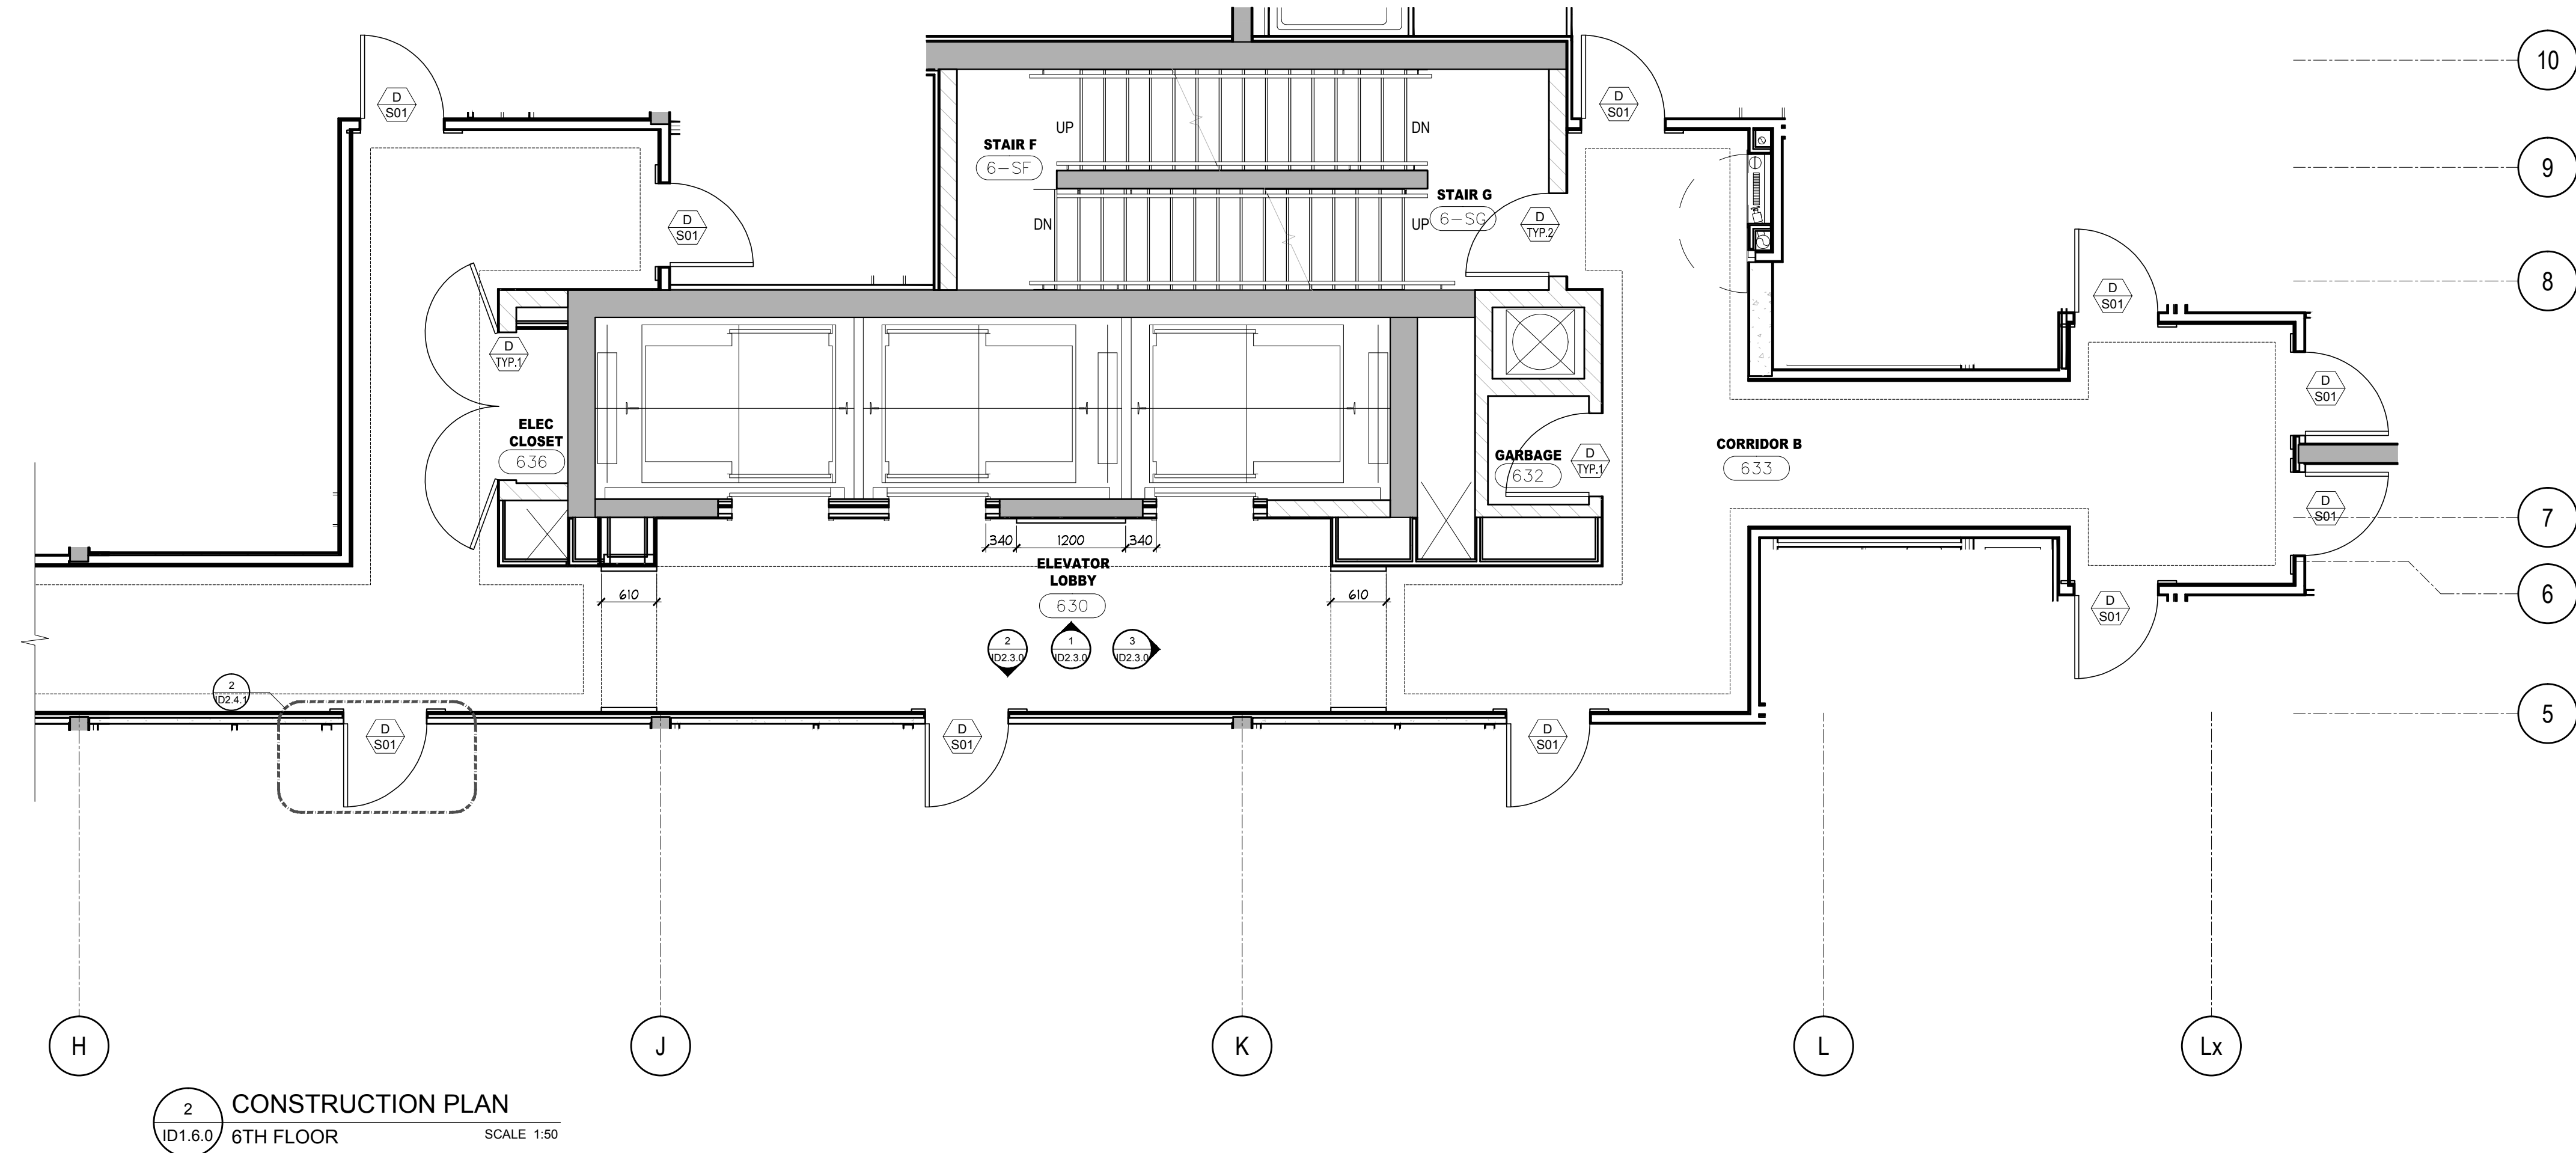

2 CONSTRUCTION PLAN
6TH FLOOR
SCALE 1:50

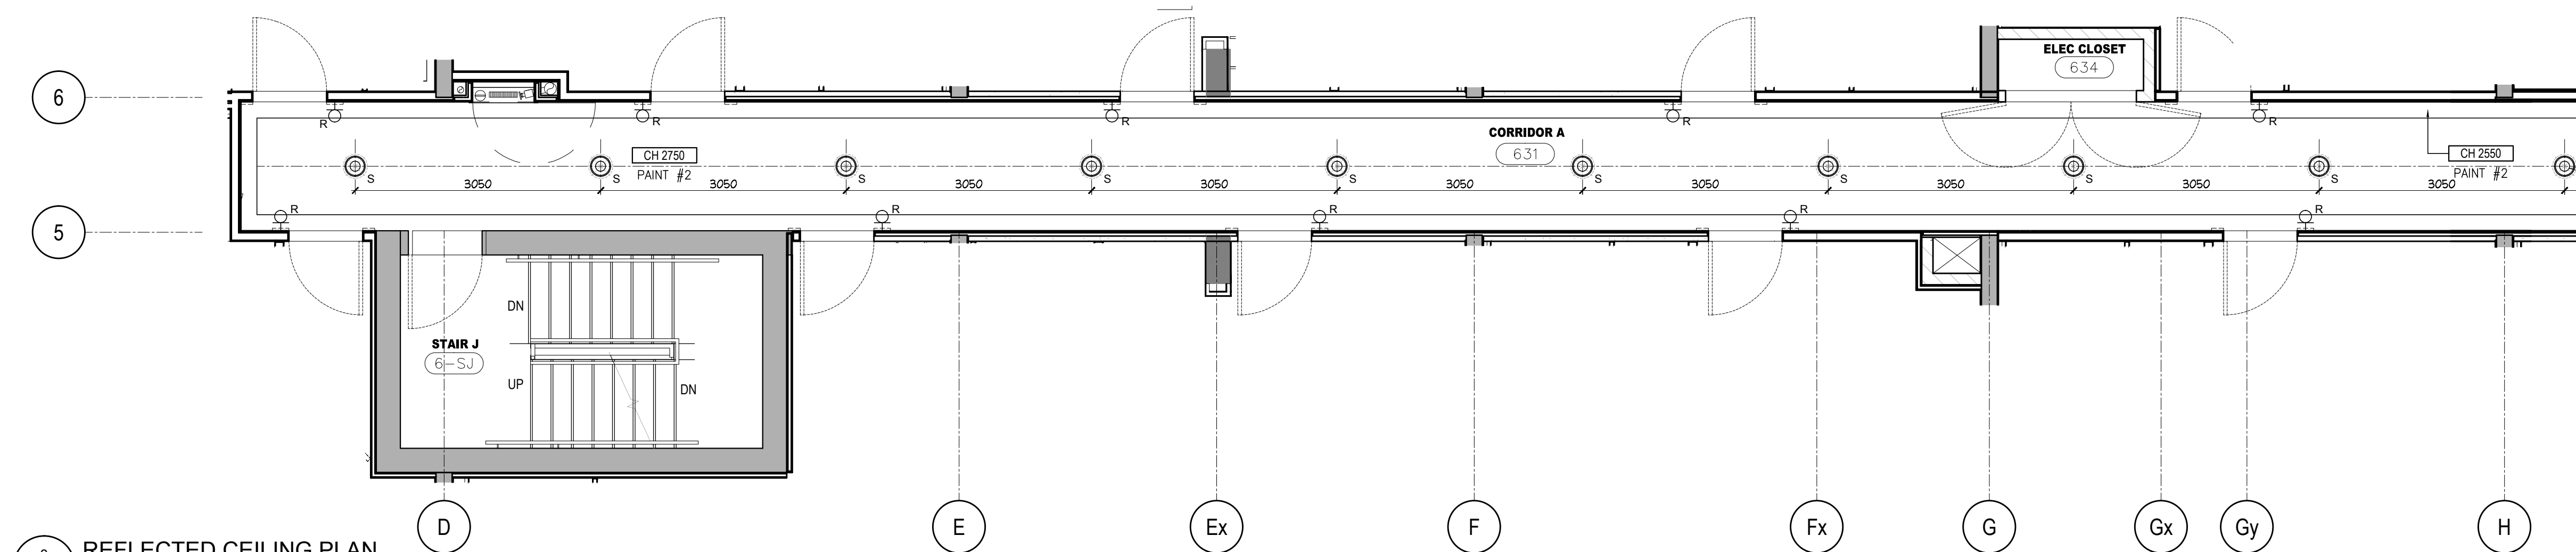

3 REFLECTED CEILING PLAN
6TH FLOOR
SCALE 1:50

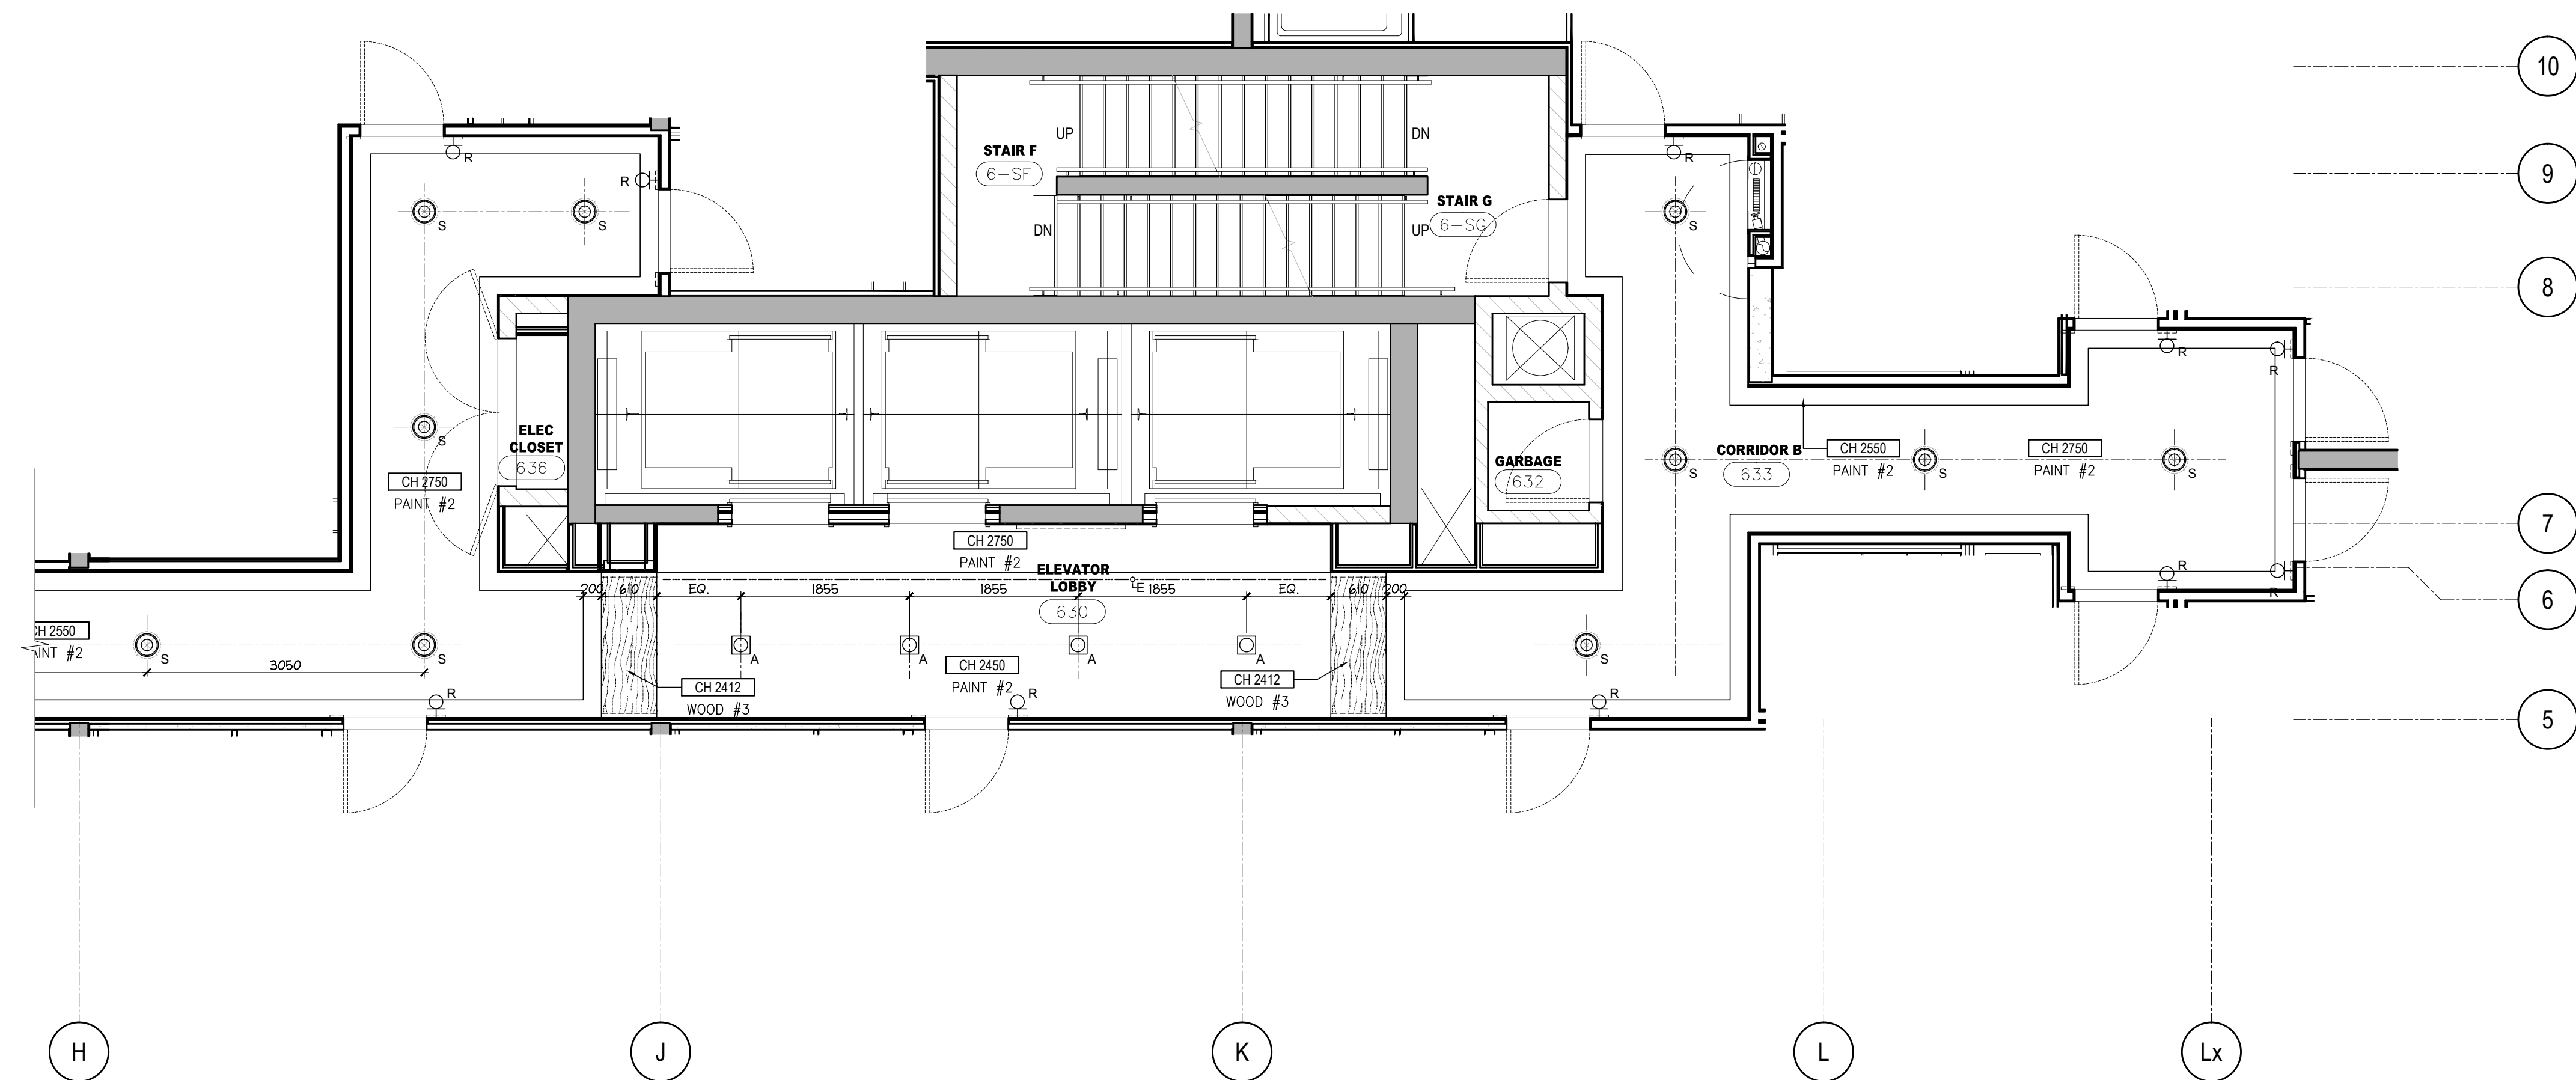

4 REFLECTED CEILING PLAN
6TH FLOOR
SCALE 1:50

DO NOT SCALE DRAWINGS.

CONTRACTOR MUST VERIFY ALL DRAWINGS, DIMENSIONS, DETAILS AND SPECIFICATIONS AND REPORT ANY DISCREPANCIES TO UNION 31 INC. BEFORE PROCEEDING WITH WORK. MATERIALS MAY NOT BE SUBSTITUTED WITHOUT WRITTEN APPROVAL FROM UNION 31 INC.

ALL DRAWINGS AND SPECIFICATIONS ARE INSTRUMENTS OF SERVICE AND THE PROPERTY OF UNION 31 INC. WHICH MUST BE RETURNED AT THE COMPLETION OF THE WORK.



PRINTED: 30-MAY-17

ISSUED FOR
AS-BUILT

01	31 MAY 17	ISSUED FOR AS-BUILT	SV
NO.	DATE	COMMENTS	INI

REVISIONS:

UNION31
PROJECT NAME:
ALEXANDRA PARK
MAIN BUILDING
BLOCK 11
ON, Canada
PROJECT NO.:
13-949
DRAWING NO.:
6TH FLOOR
CONSTRUCTION PLAN &
REFLECTED CEILING PLAN
DATE STARTED: 07 AUG / 13
SCALE: 1 : 50
DRAWN BY: AP
APPROVED BY: KC
DRAWING NO.:
ID
1.6.0

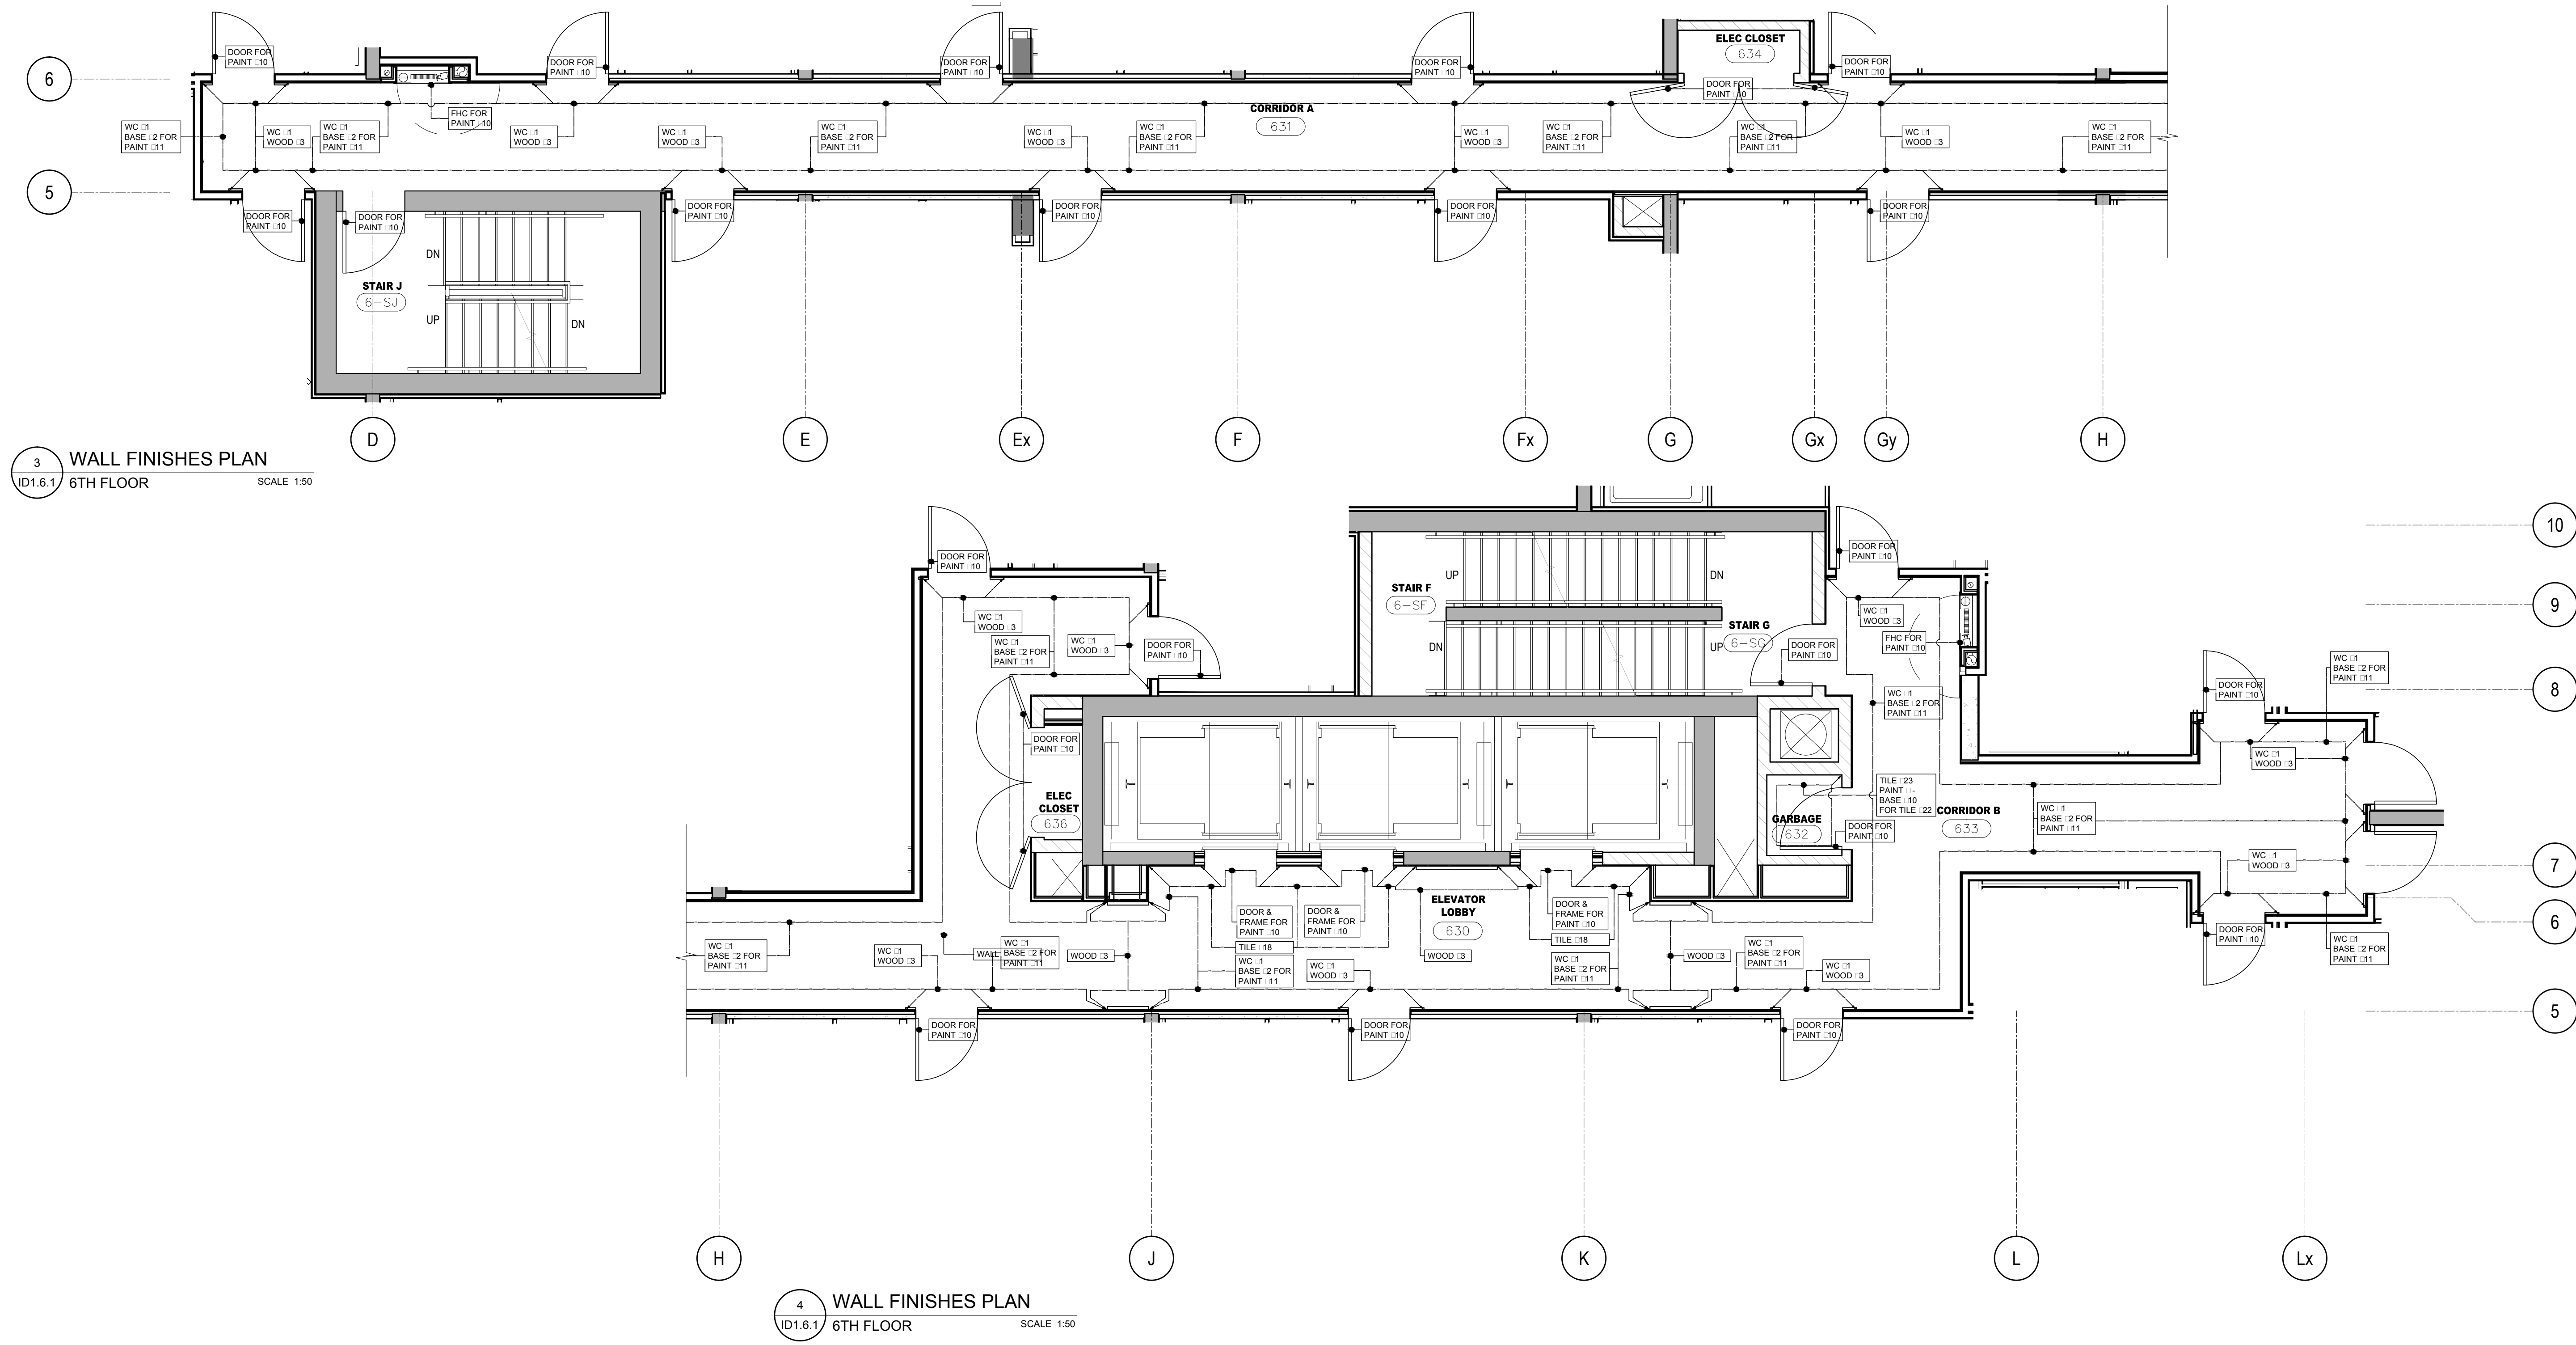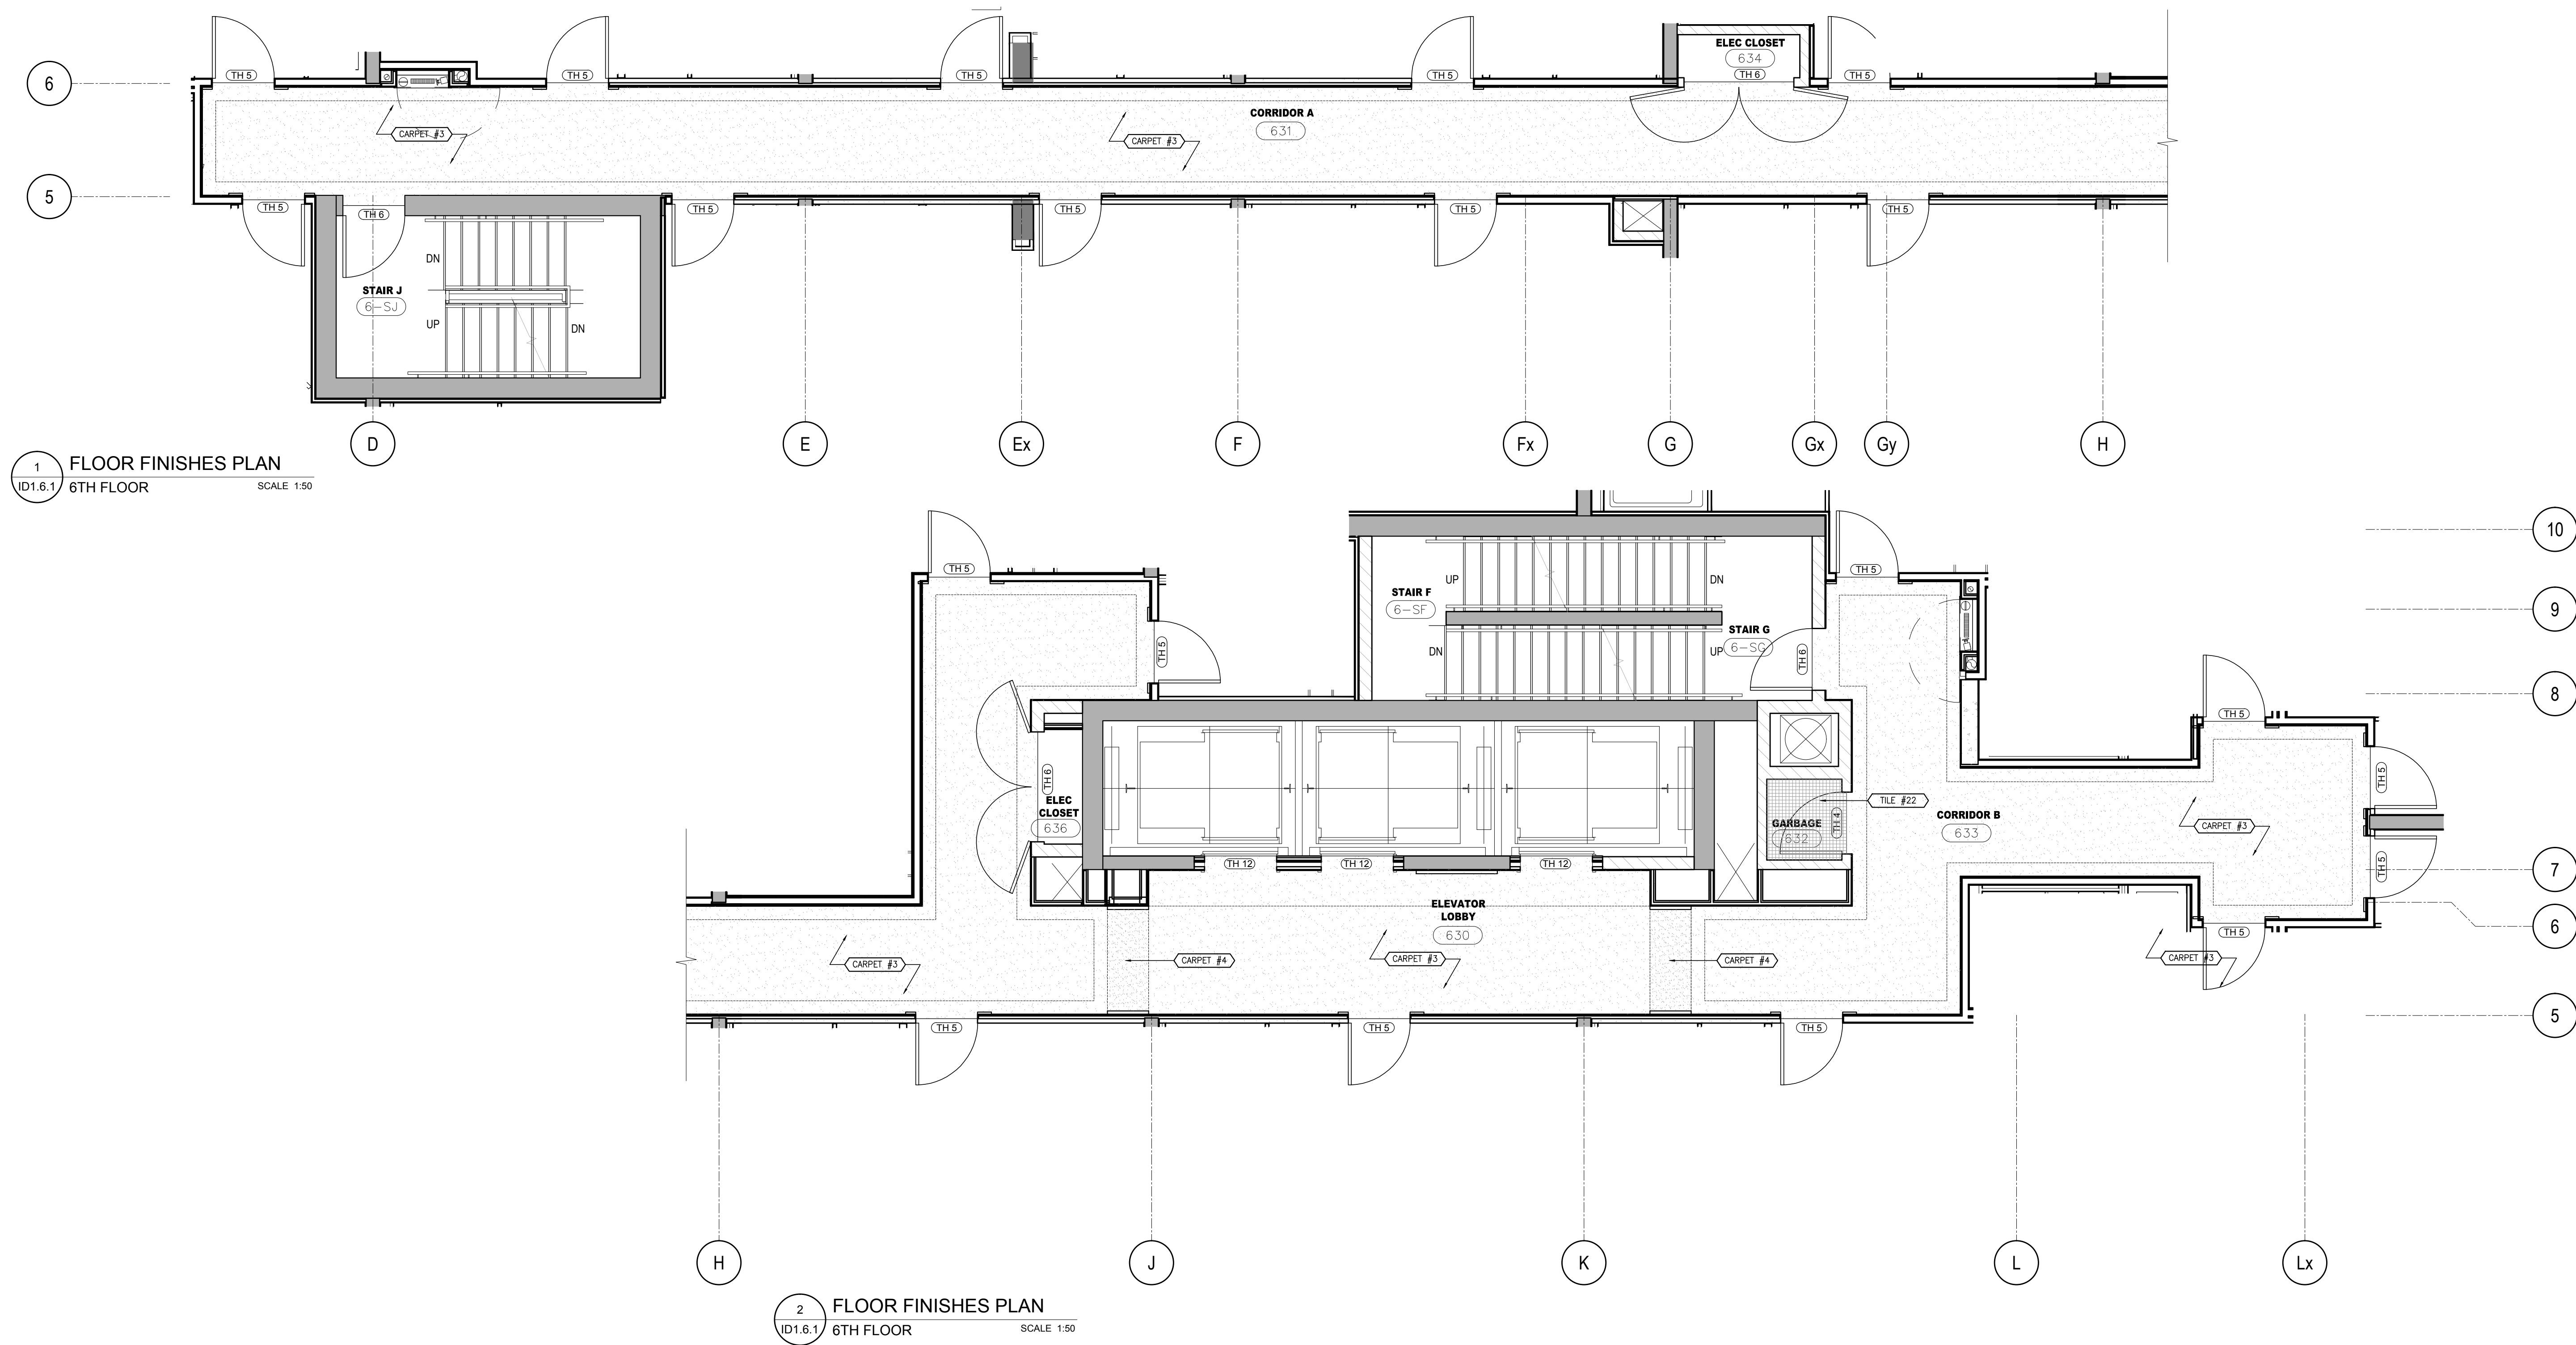

DO NOT SCALE DRAWINGS.

CONTRACTOR MUST VERIFY ALL DRAWINGS, DIMENSIONS, DETAILS AND SPECIFICATIONS AND REPORT ANY DISCREPANCIES TO UNION 31 INC. BEFORE PROCEEDING WITH WORK. MATERIALS MAY NOT BE SUBSTITUTED WITHOUT WRITTEN APPROVAL FROM UNION 31 INC.

ALL DRAWINGS AND SPECIFICATIONS ARE INSTRUMENTS OF SERVICE AND THE PROPERTY OF UNION 31 INC. WHICH MUST BE RETURNED AT THE COMPLETION OF THE WORK.

PRINTED: 30-MAY-17

ISSUED FOR AS-BUILT

01	31 MAY / 17	ISSUED FOR AS-BUILT	SV
NO.	DATE	COMMENTS	INI
REVISIONS:			

UNION 31

PROJECT NAME:

ALEXANDRA PARK
MAIN BUILDING
BLOCK 11
ON, Canada

PROJECT NO.:
13-949

DRAWINGS:

6TH FLOOR
FLOOR FINISHES PLAN &
WALL FINISHES PLAN

DATE STARTED: 07 AUG / 13



DRAWING NO.:
ID

SCALE: 1" = 50'

DRAWN BY: AP

APPROVED BY: KC

1.6.1

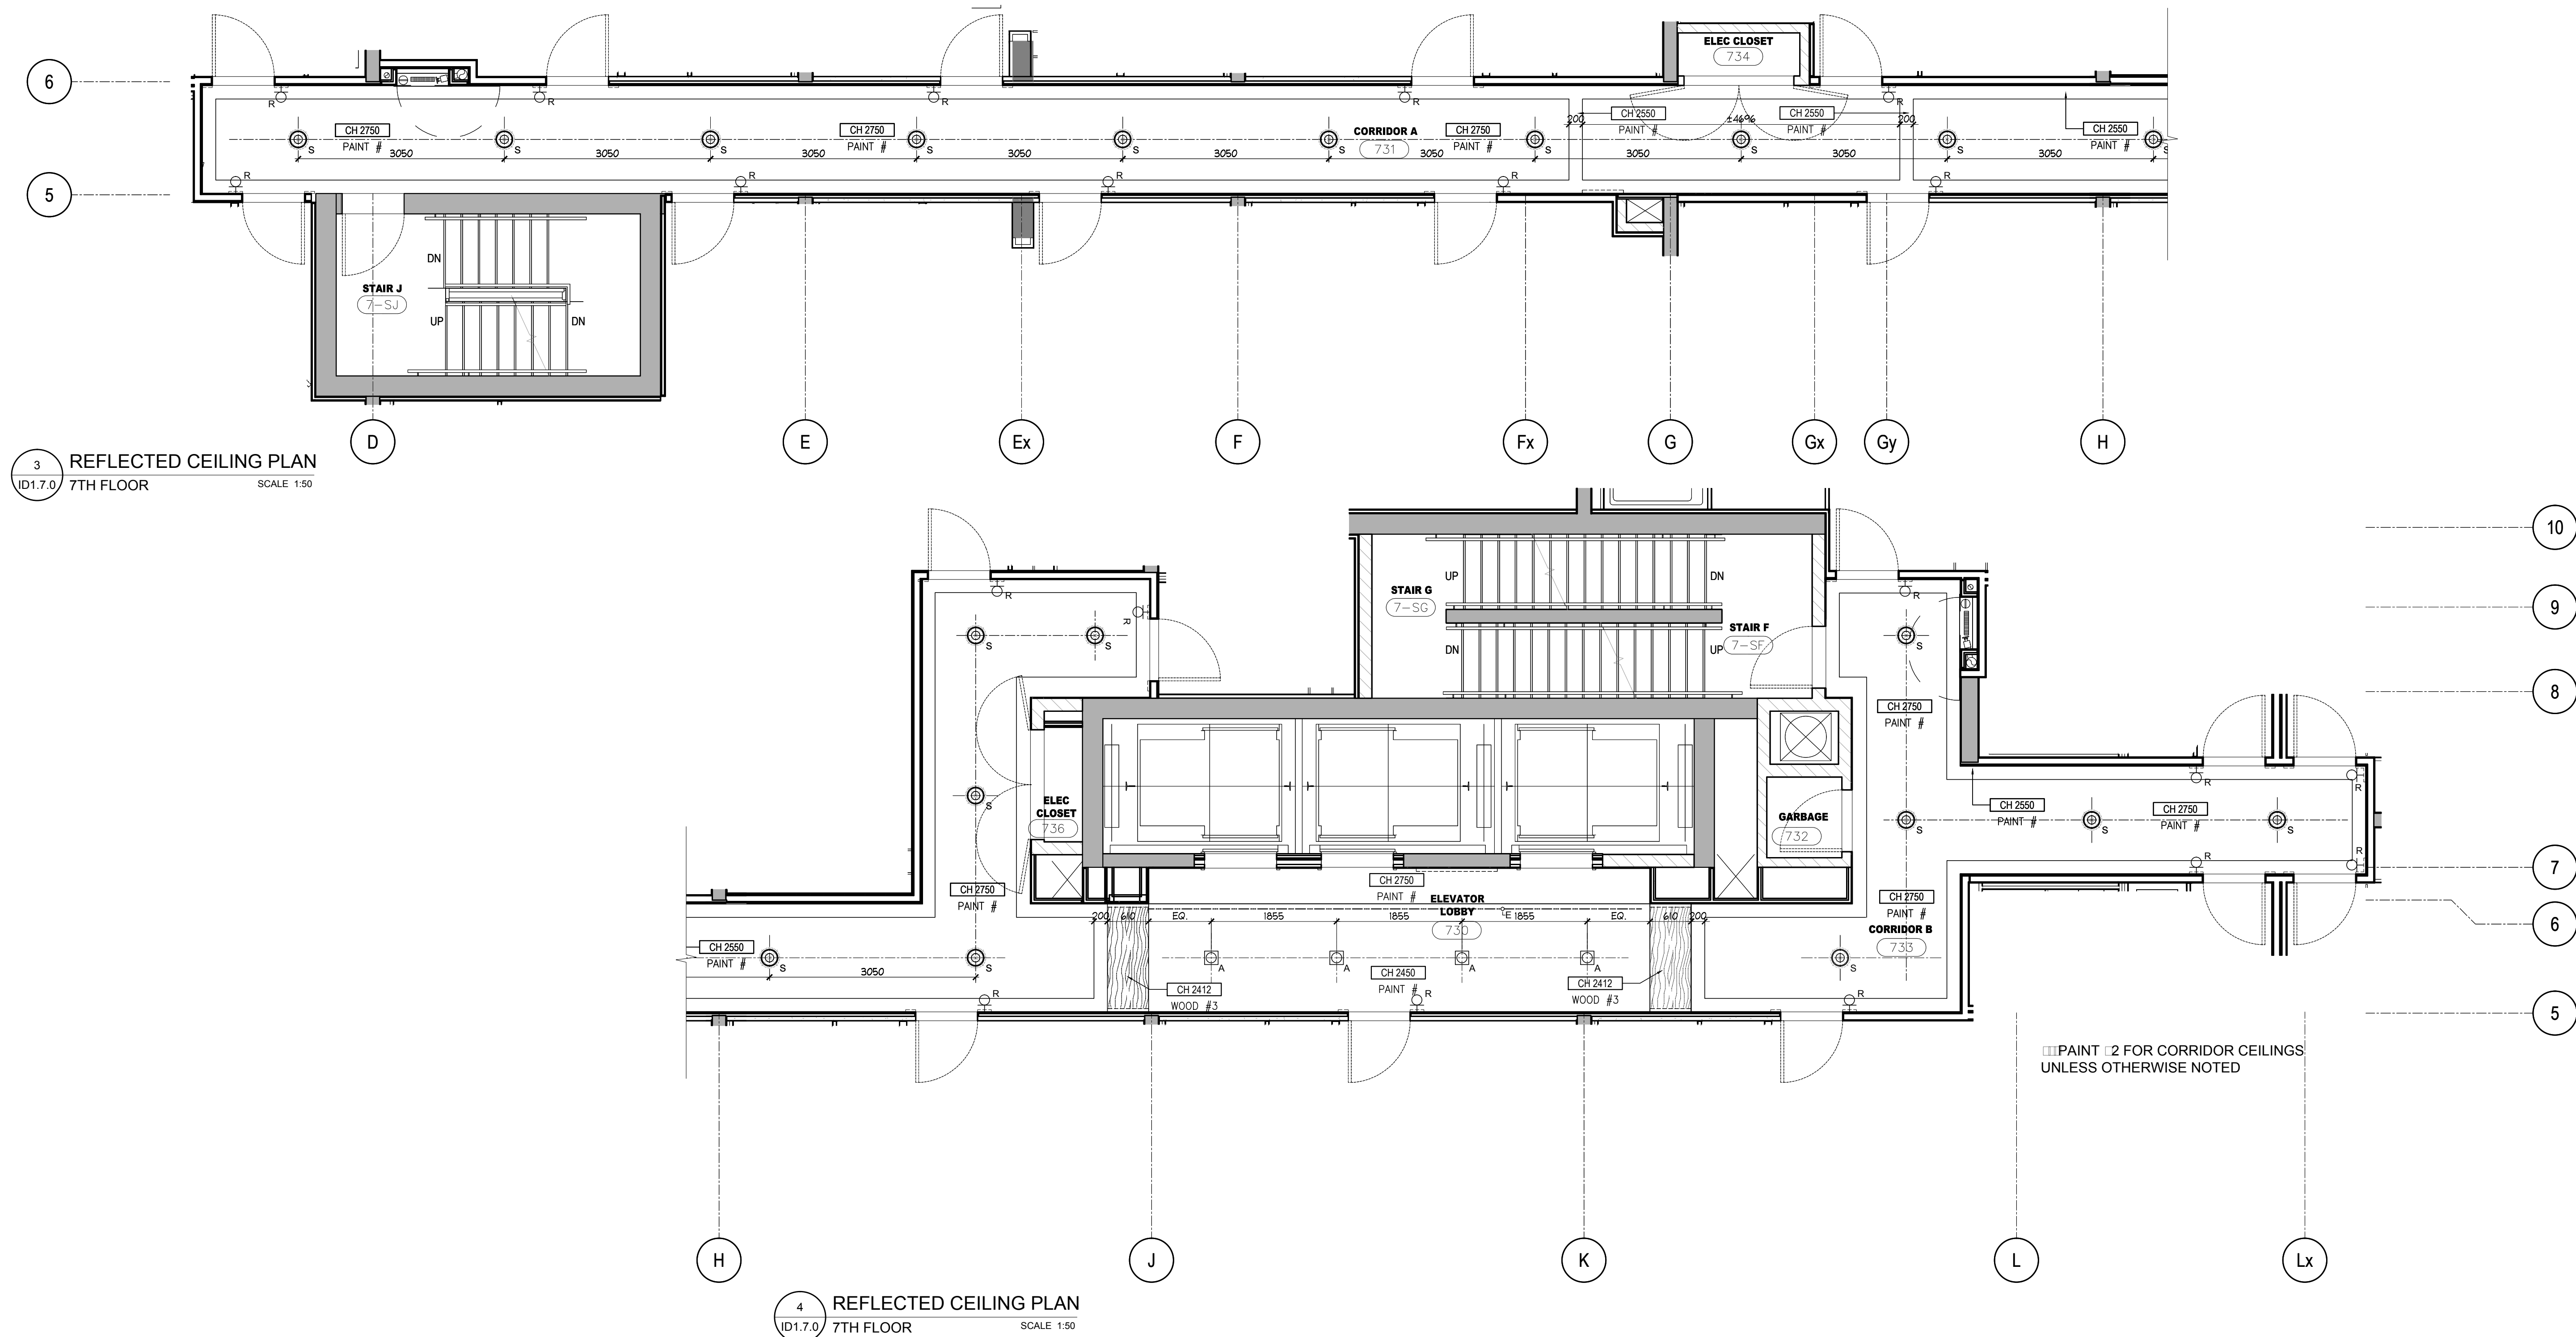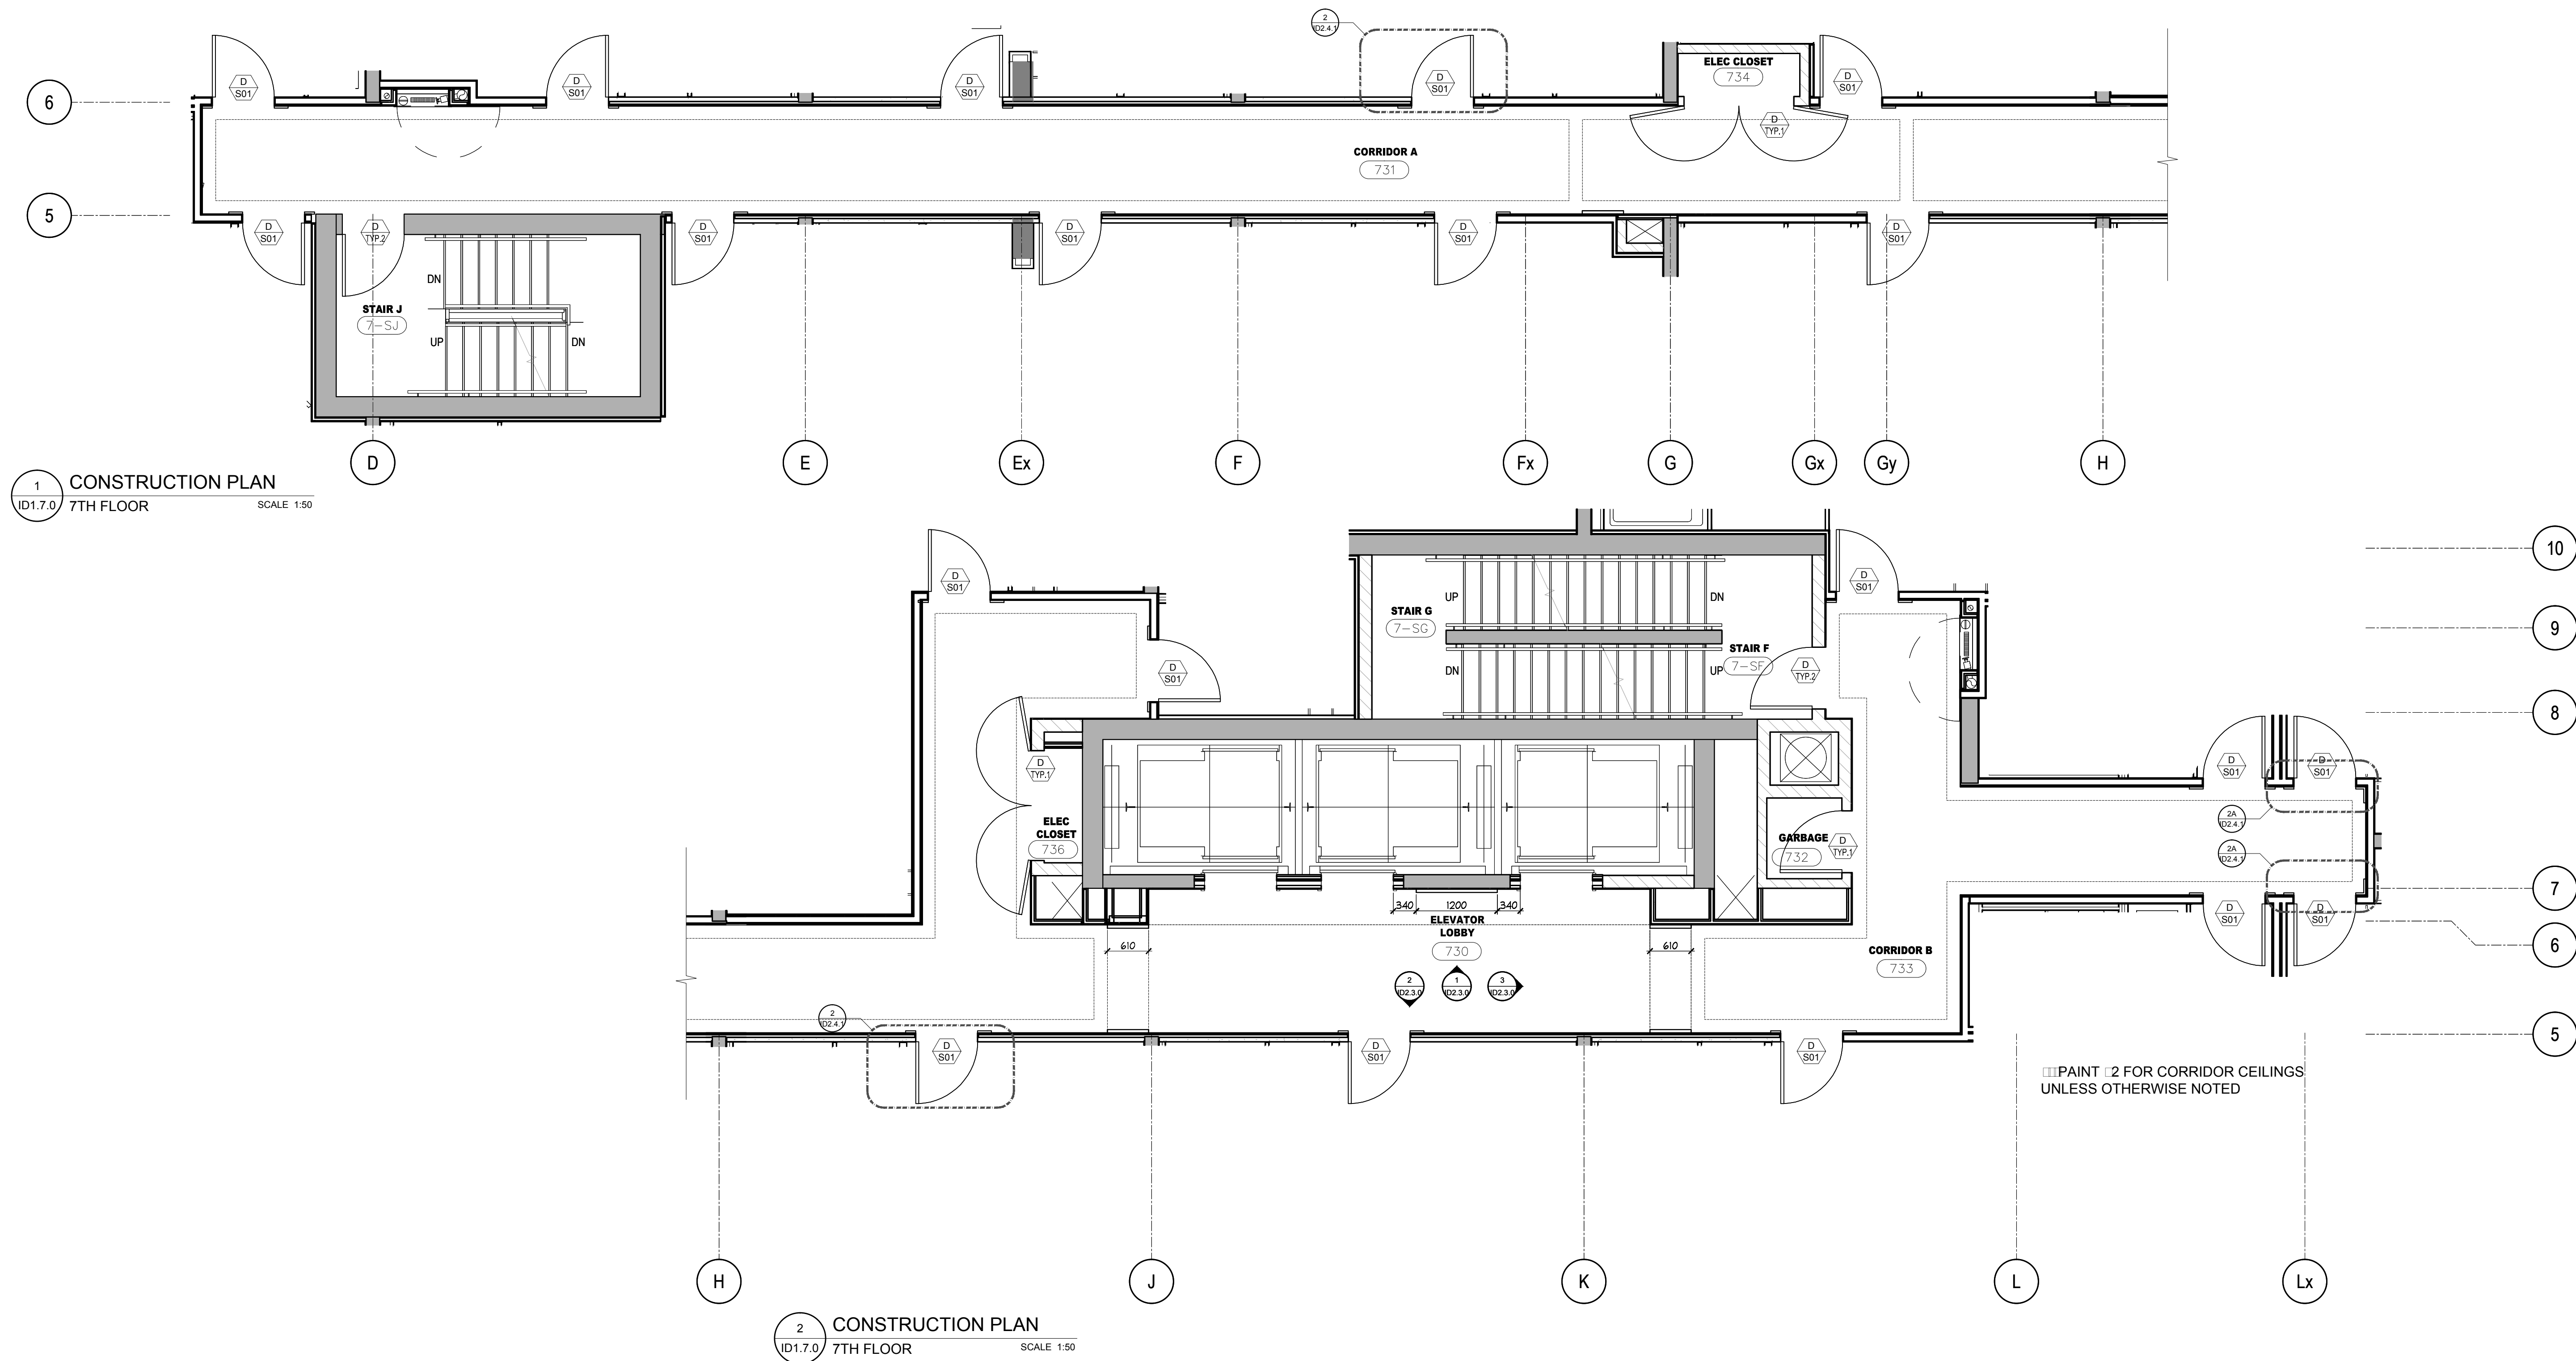

DO NOT SCALE DRAWINGS.

CONTRACTOR MUST VERIFY ALL DRAWINGS, DIMENSIONS, DETAILS AND SPECIFICATIONS AND REPORT ANY DISCREPANCIES TO UNION 31 INC. BEFORE PROCEEDING WITH WORK. MATERIALS MAY NOT BE SUBSTITUTED WITHOUT WRITTEN APPROVAL FROM UNION 31 INC.

ALL DRAWINGS AND SPECIFICATIONS ARE INSTRUMENTS OF SERVICE AND THE PROPERTY OF UNION 31 INC. WHICH MUST BE RETURNED AT THE COMPLETION OF THE WORK.

PRINTED: 30-MAY-17



ISSUED FOR
AS-BUILT

01	31 MAY / 17	ISSUED FOR AS-BUILT	SV
NO.	DATE	COMMENTS	INI
REVISIONS:			

UNION31

UNION31 INC.
183 BATHURST STREET, STE. 201
TORONTO, ON, M5T 2R7, CANADA
TEL: 416-597-1576 FAX: 416-597-2139

PROJECT NAME:		ALEXANDRA PARK MAIN BUILDING	
PROJECT NO.:		13-949	
DRAWING NO.:		7TH FLOOR CONSTRUCTION PLAN & REFLECTED CEILING PLAN	
DATE STARTED:		07 AUG / 13	
SCALE:		1 : 50	
DRAWN BY:		AP	
APPROVED BY:		KC	
		ID 1.7.0	

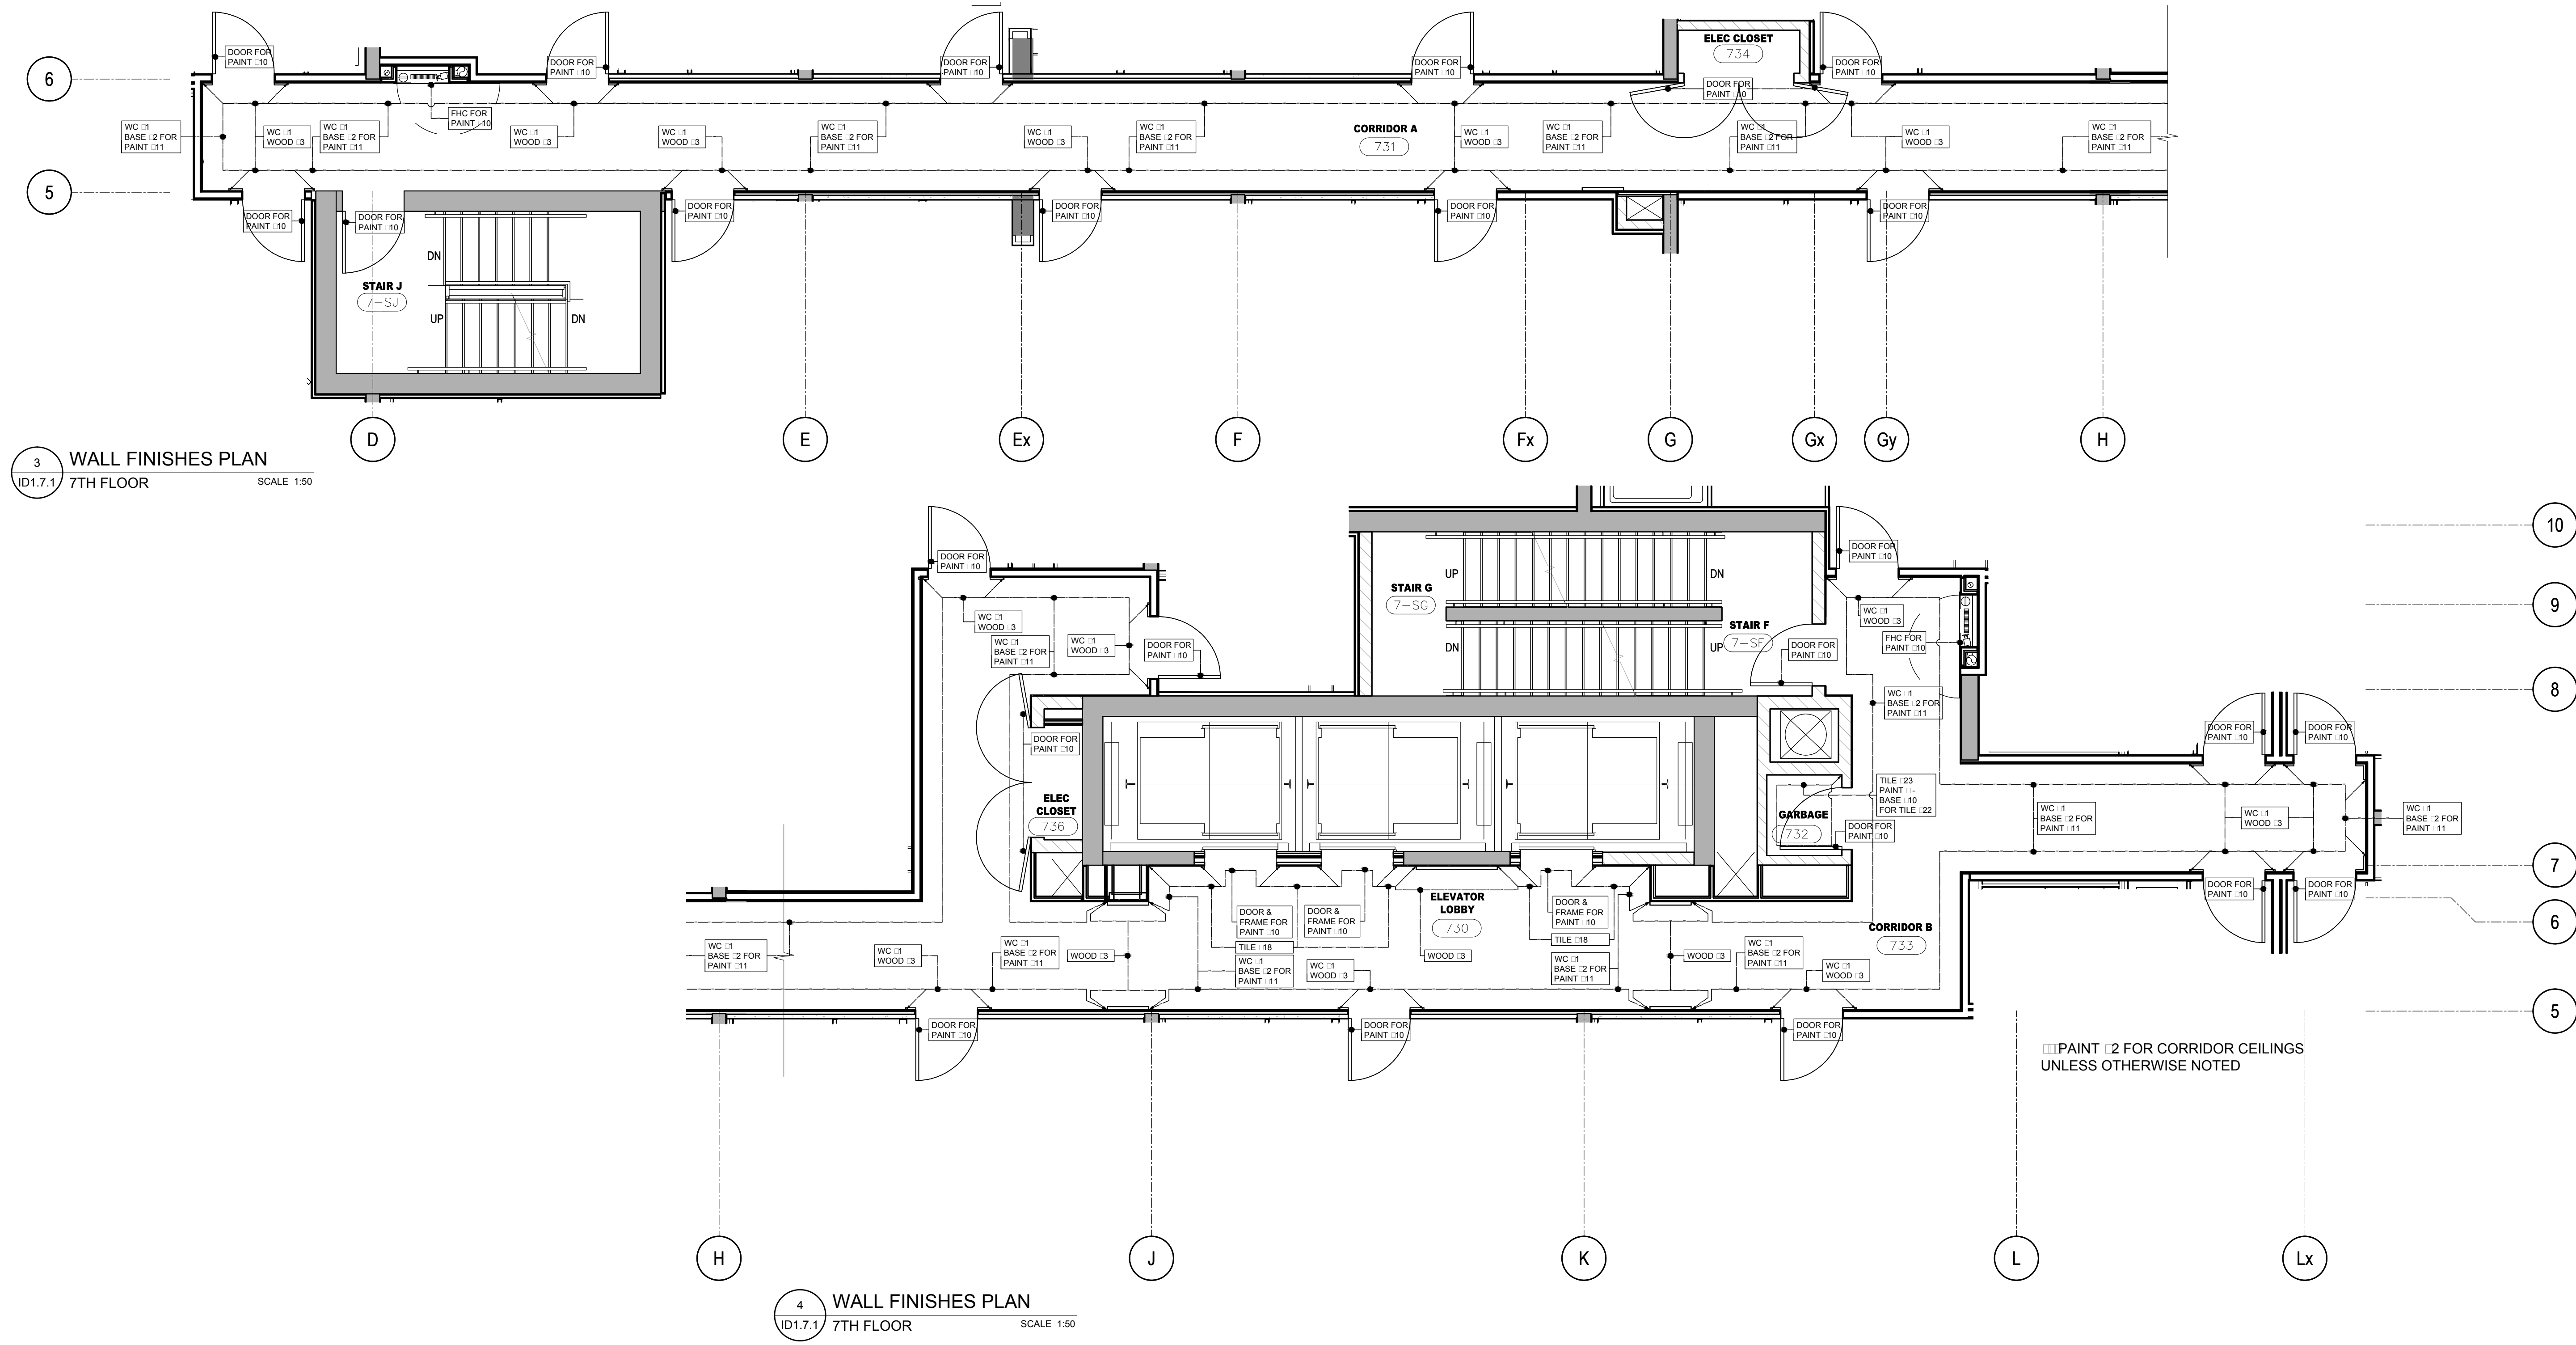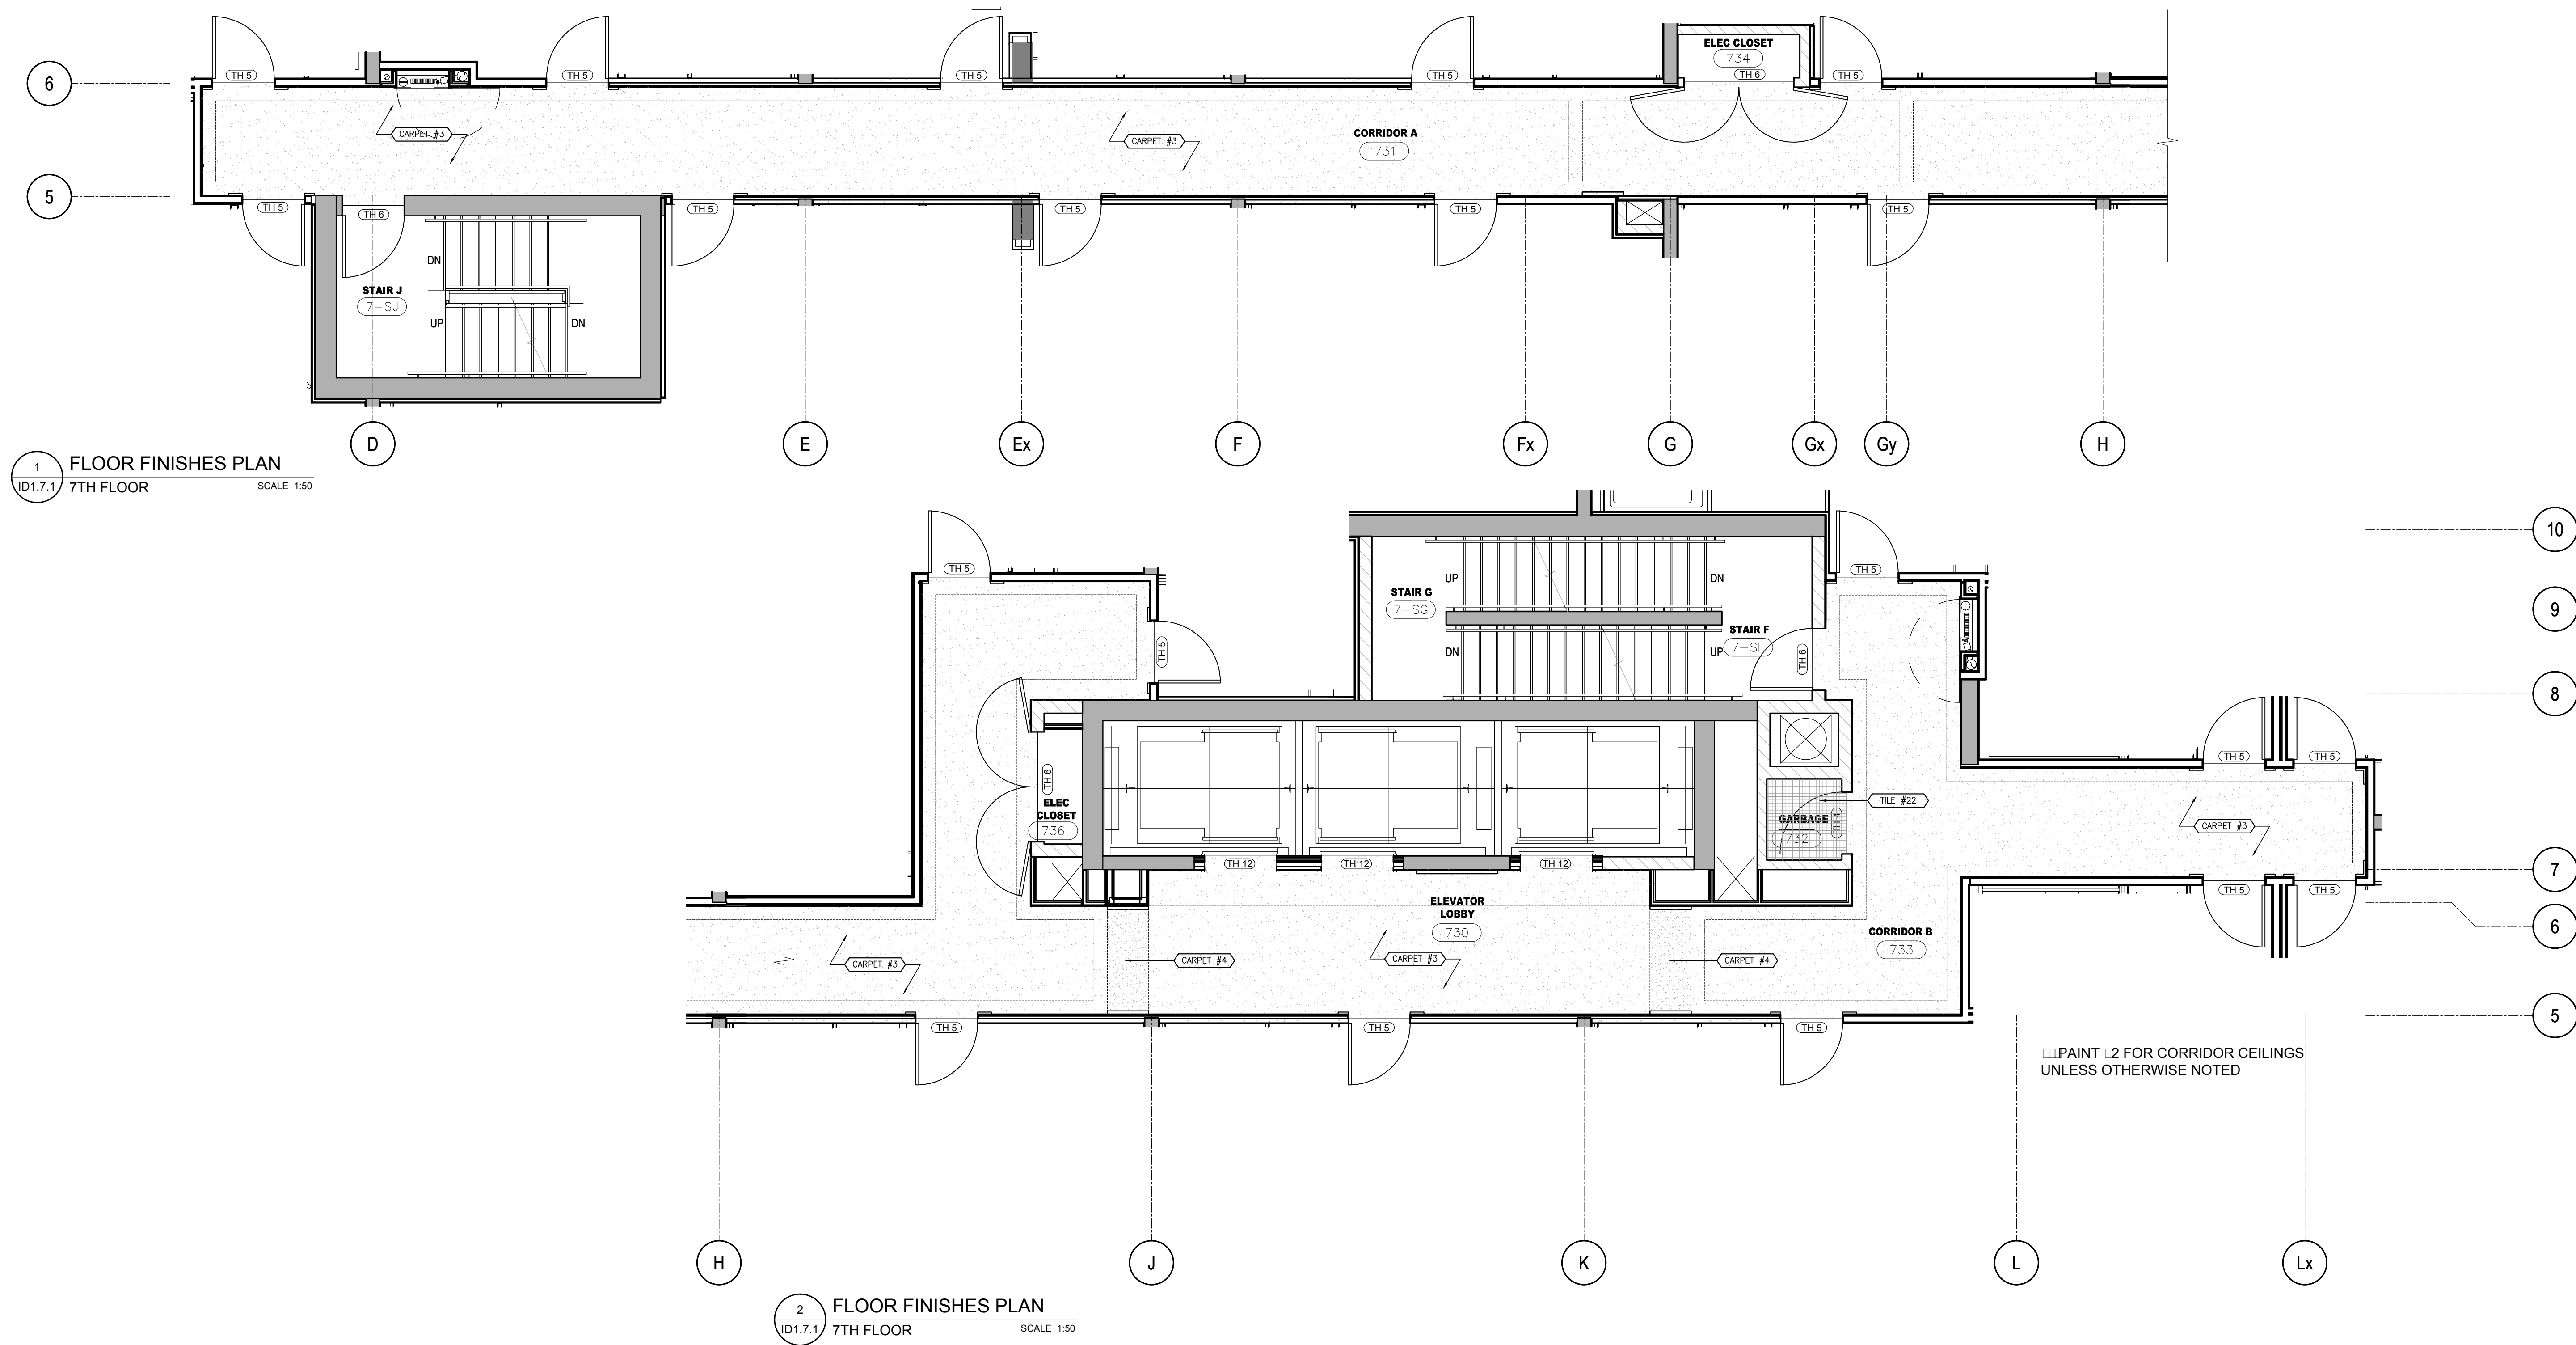

DO NOT SCALE DRAWINGS.

CONTRACTOR MUST VERIFY ALL DRAWINGS, DIMENSIONS, DETAILS AND SPECIFICATIONS, AND REPORT ANY DISCREPANCIES TO UNION 31 INC. BEFORE PROCEEDING WITH WORK. MATERIALS MAY NOT BE SUBSTITUTED WITHOUT WRITTEN APPROVAL FROM UNION 31 INC.

ALL DRAWINGS AND SPECIFICATIONS ARE INSTRUMENTS OF SERVICE AND THE PROPERTY OF UNION 31 INC. WHICH MUST BE RETURNED AT THE COMPLETION OF THE WORK.

PRINTED: 30-M8-17

ISSUED FOR AS-BUILT

01	31 MAY / 17	ISSUED FOR AS-BUILT	SV
NO.	DATE	COMMENTS	INI
REVISIONS:			

UNION31



UNION31 INC.
183 BATHURST STREET, STE. 201
TORONTO, ON, M5T 2R7, CANADA
TEL: 416-597-1576 FAX: 416-597-2139

PROJECT NAME:
**ALEXANDRA PARK
MAIN BUILDING**
BLOCK 11
ON, Canada

PROJECT NO.:
13-949

DRAWINGS:
**7TH FLOOR
FLOOR FINISHES PLAN &
WALL FINISHES PLAN**

DATE STARTED: 07 AUG / 13	DRAWING NO.:
SCALE: 1" = 50'	ID
DRAWN BY: AP	1.7.1
APPROVED BY: KC	

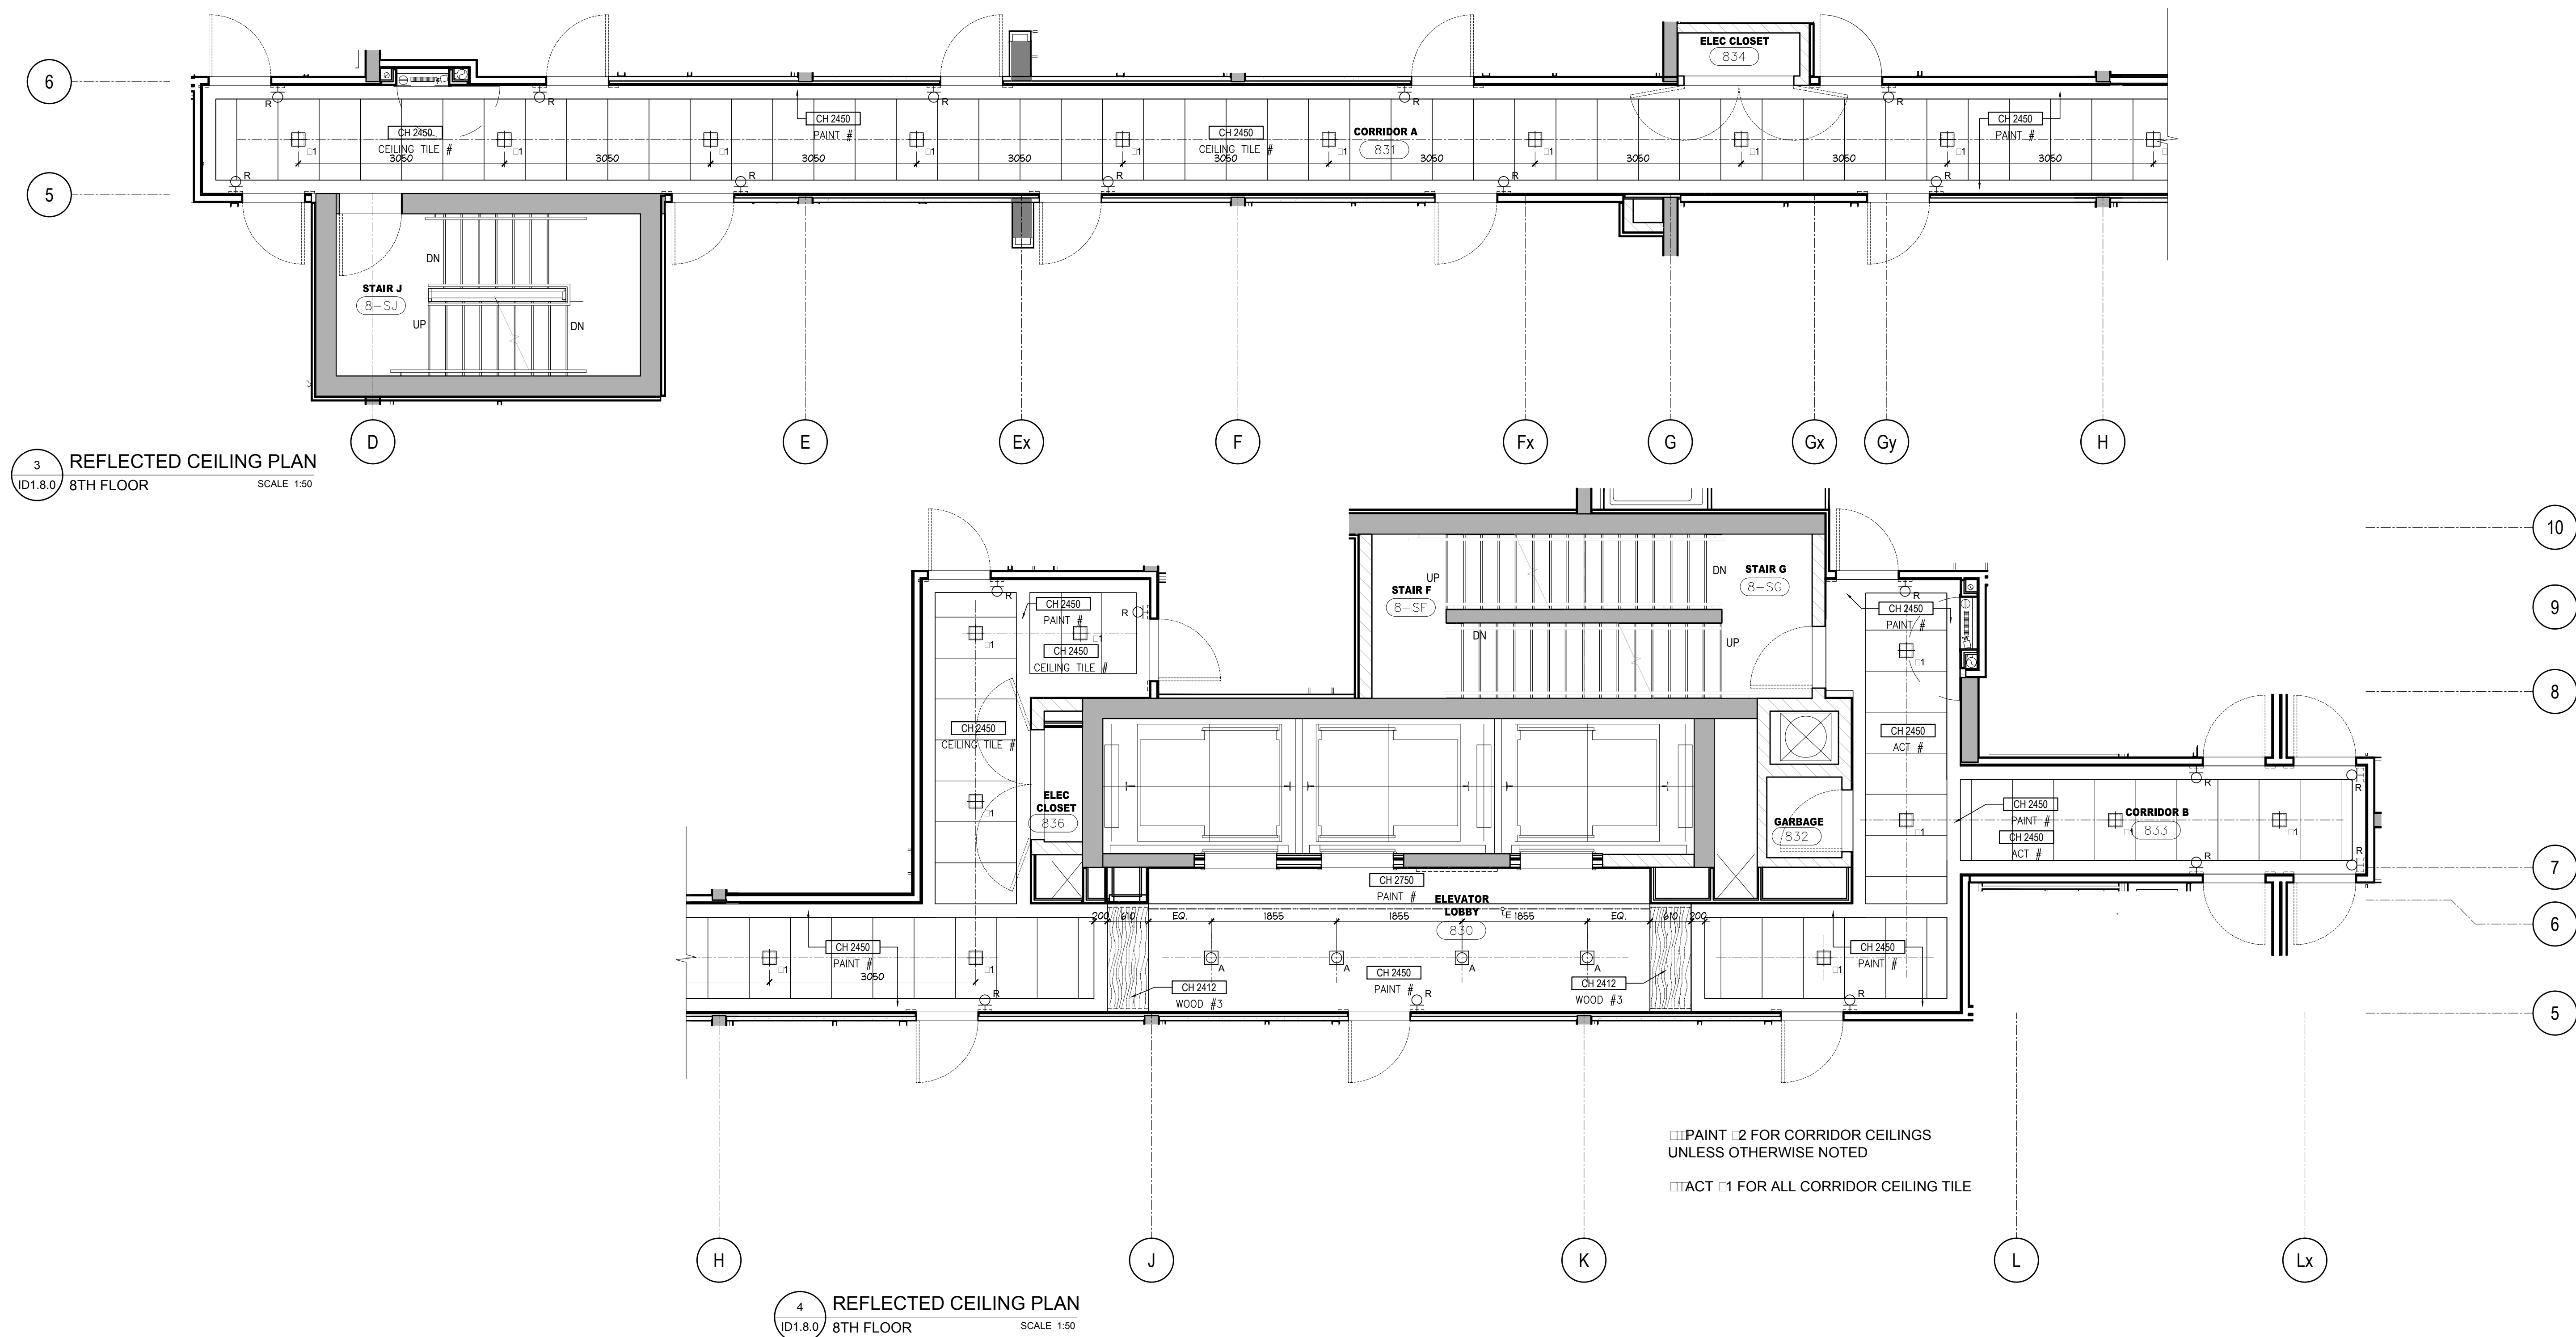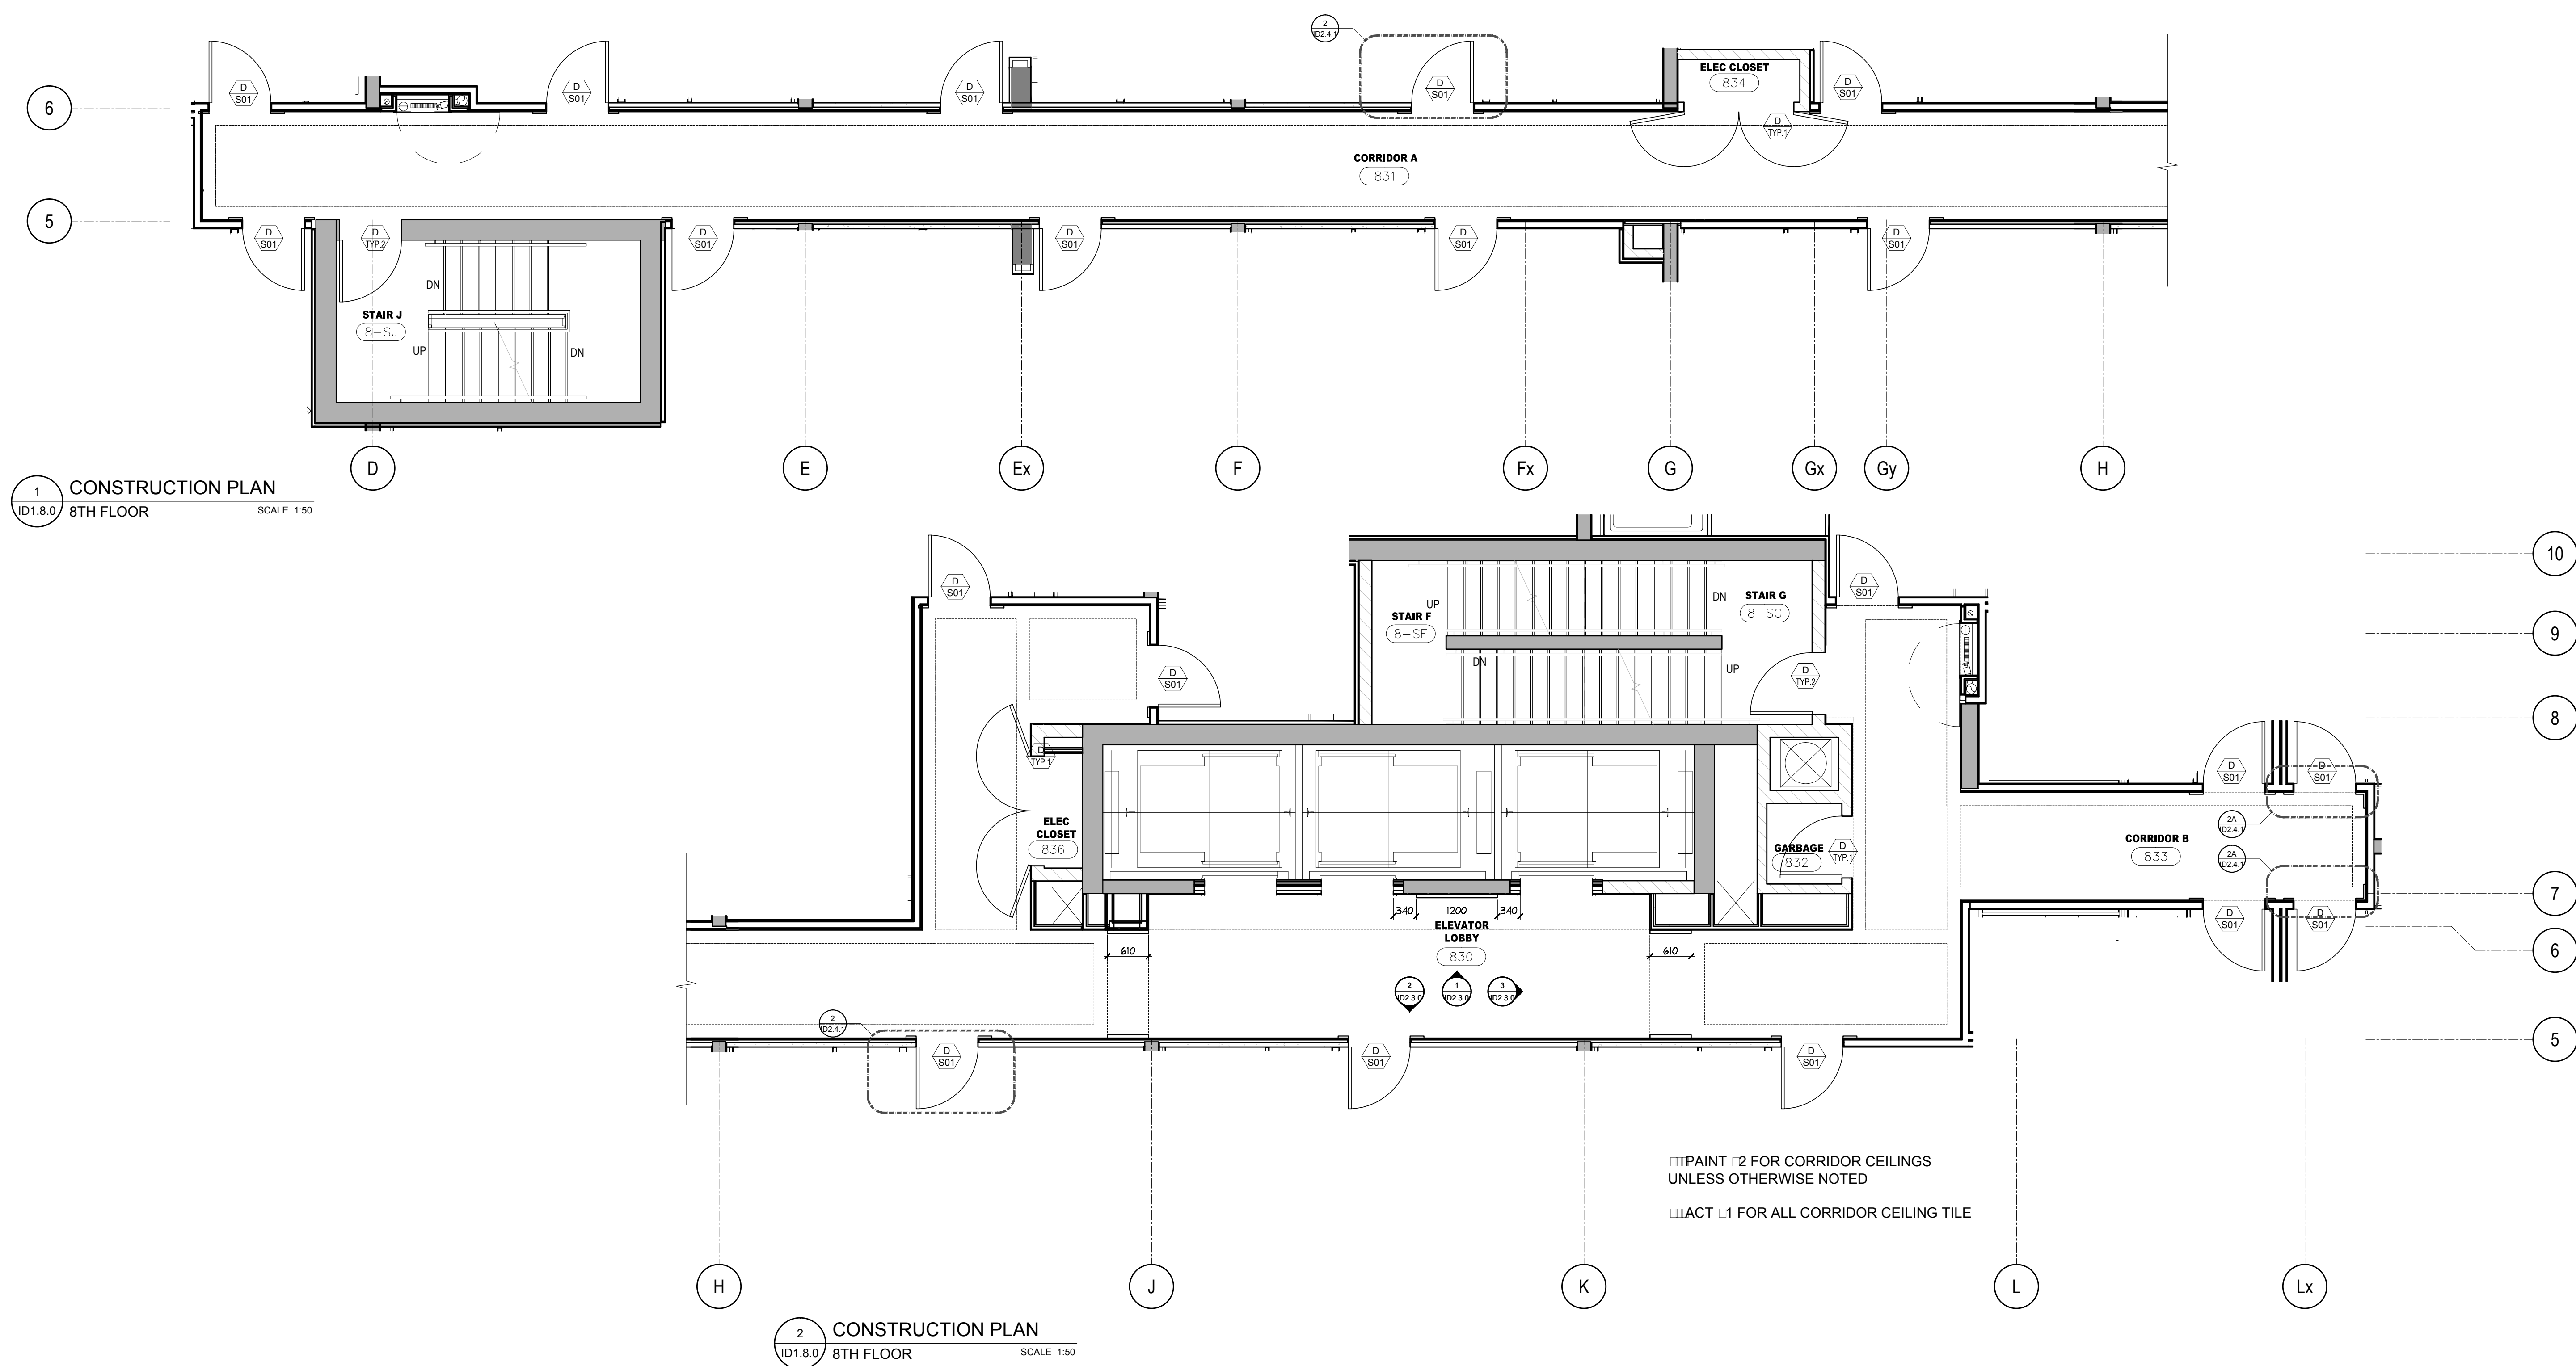

DO NOT SCALE DRAWINGS.

CONTRACTOR MUST VERIFY ALL DRAWINGS, DIMENSIONS, DETAILS AND SPECIFICATIONS AND REPORT ANY DISCREPANCIES TO UNION 31 INC. BEFORE PROCEEDING WITH WORK. MATERIALS MAY NOT BE SUBSTITUTED WITHOUT WRITTEN APPROVAL FROM UNION 31 INC. ALL DRAWINGS AND SPECIFICATIONS ARE INSTRUMENTS OF SERVICE AND THE PROPERTY OF UNION 31 INC. WHICH MUST BE RETURNED AT THE COMPLETION OF THE WORK.

PRINTED: 30-MAY-17

ISSUED FOR
AS-BUILT



01	31 MAY / 17	ISSUED FOR AS-BUILT	SV
NO.	DATE	COMMENTS	INI

REVISIONS:

UNION31

UNION31 INC.
183 BATHURST STREET, STE. 201
TORONTO, ON, M5T 2R7, CANADA
TEL: 416-597-1576 FAX: 416-597-2139

PROJECT NAME:		ALEXANDRA PARK MAIN BUILDING	
PROJECT NO.:		13-949	
DRAWINGS:		8TH FLOOR CONSTRUCTION PLAN & REFLECTED CEILING PLAN	
DATE STARTED:	07 AUG / 13	DRAWING NO.:	ID
SCALE:	1 : 50	DRAWN BY:	AP
APPROVED BY:	KC		1.8.0

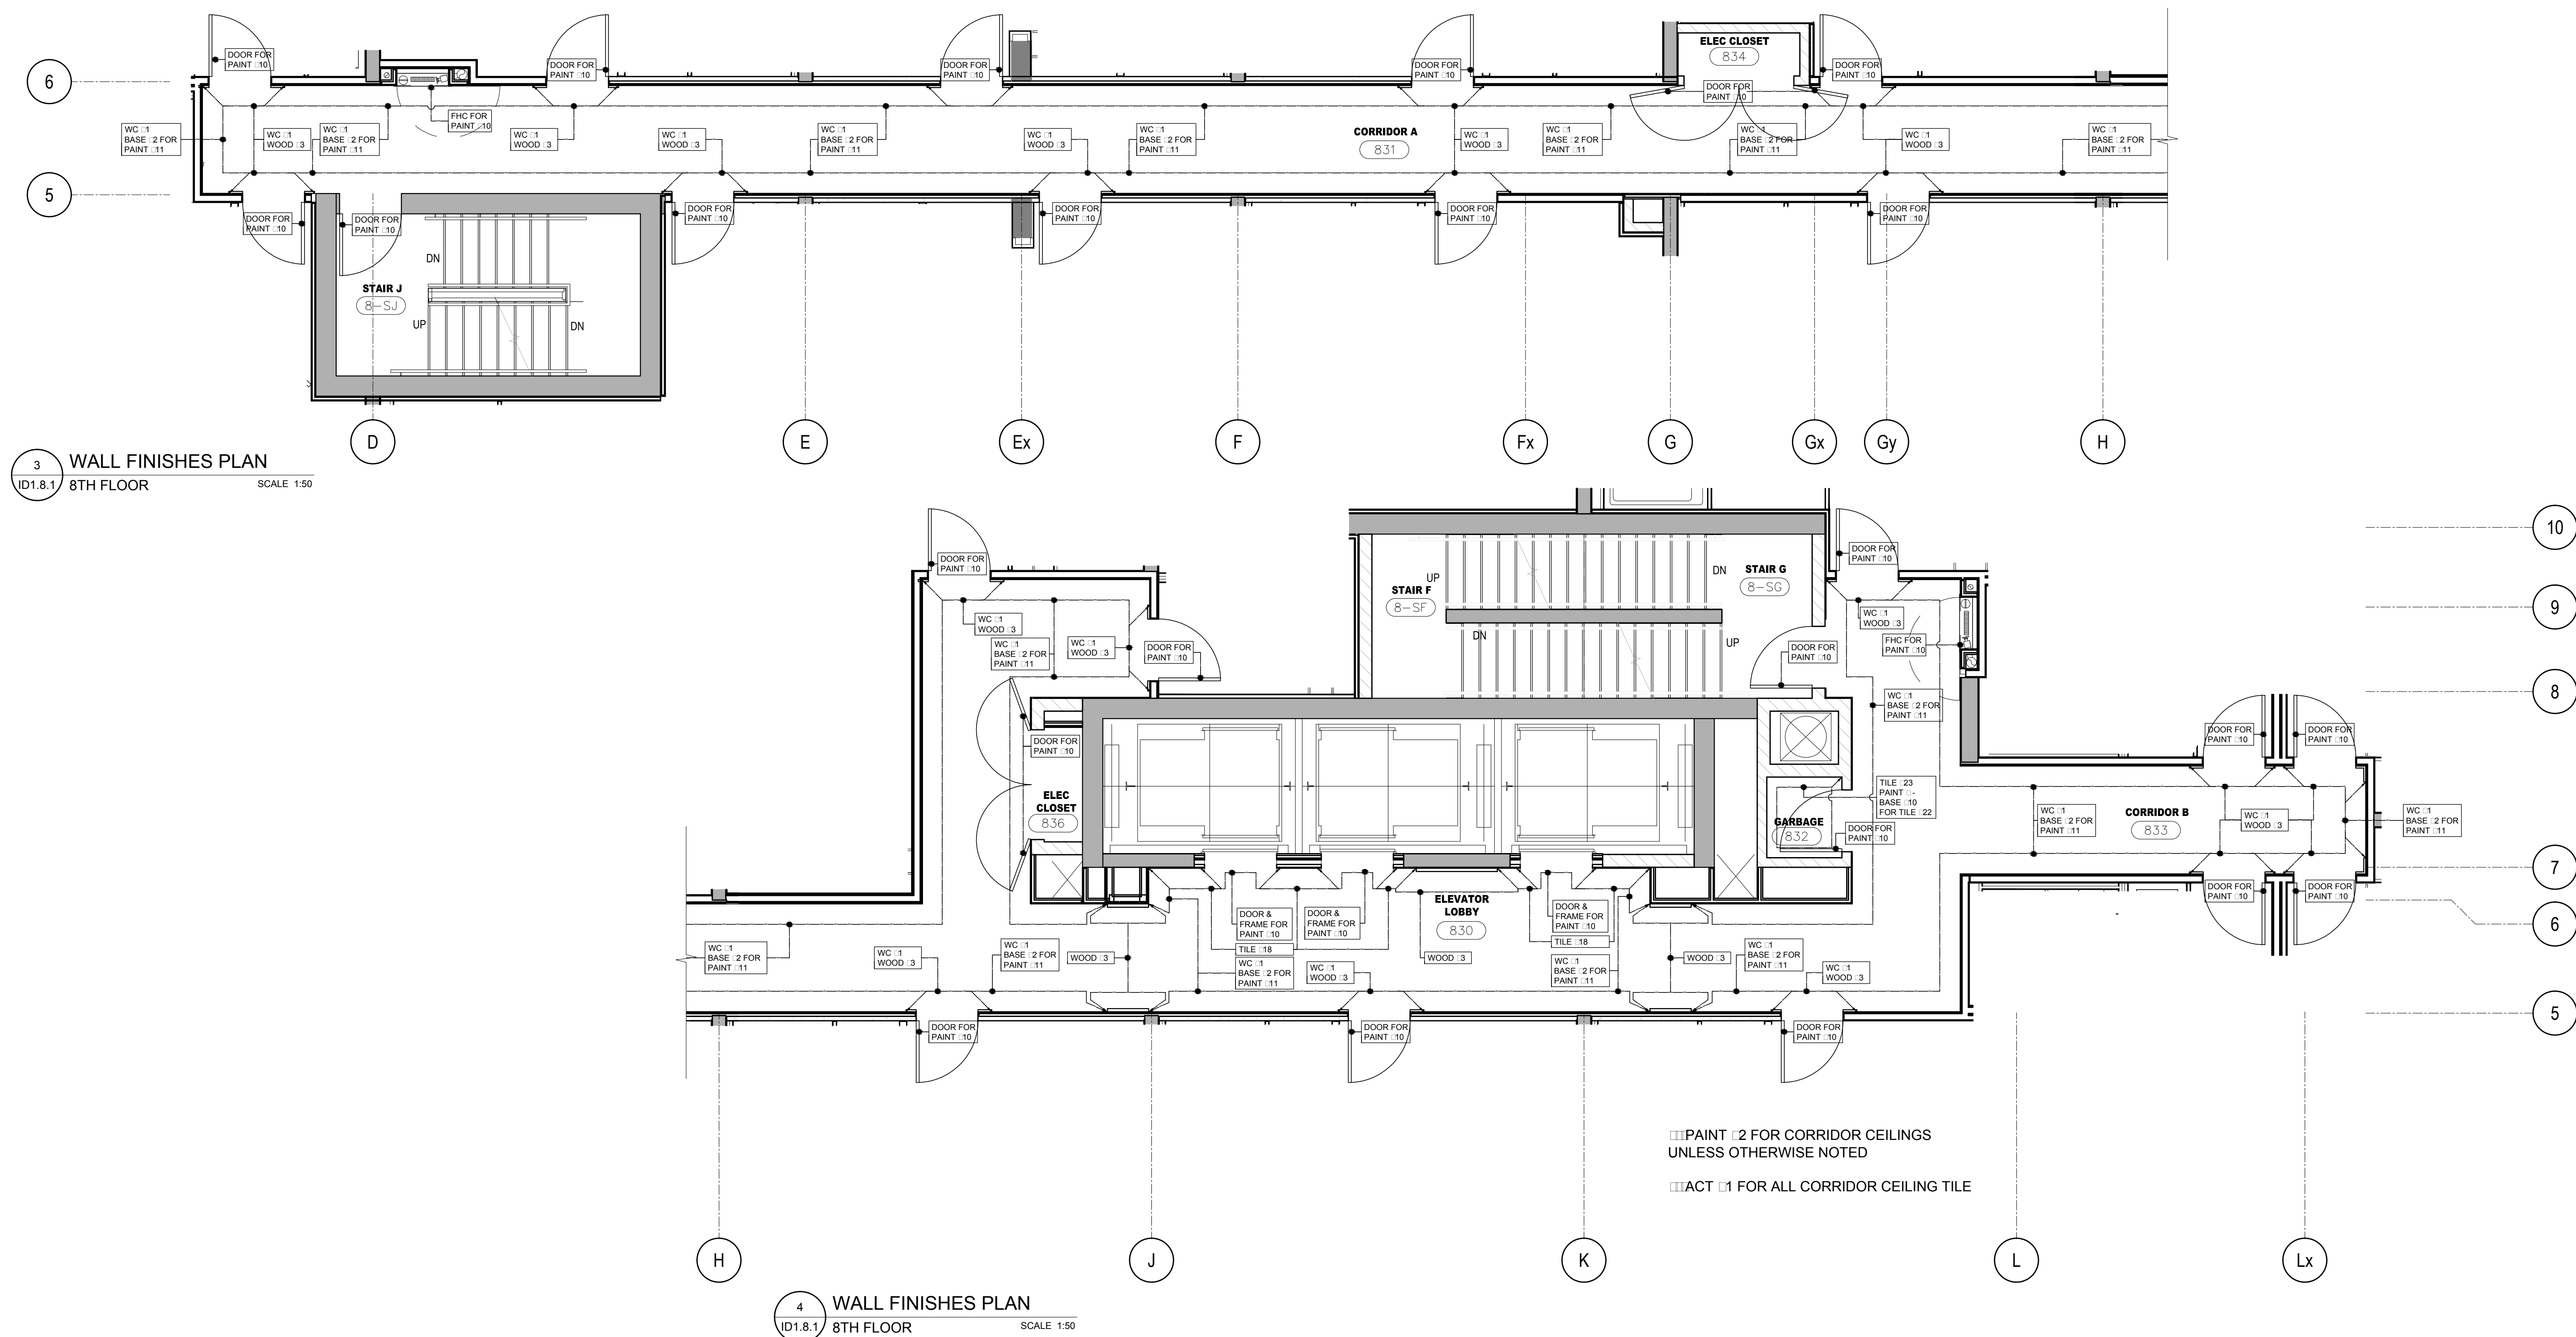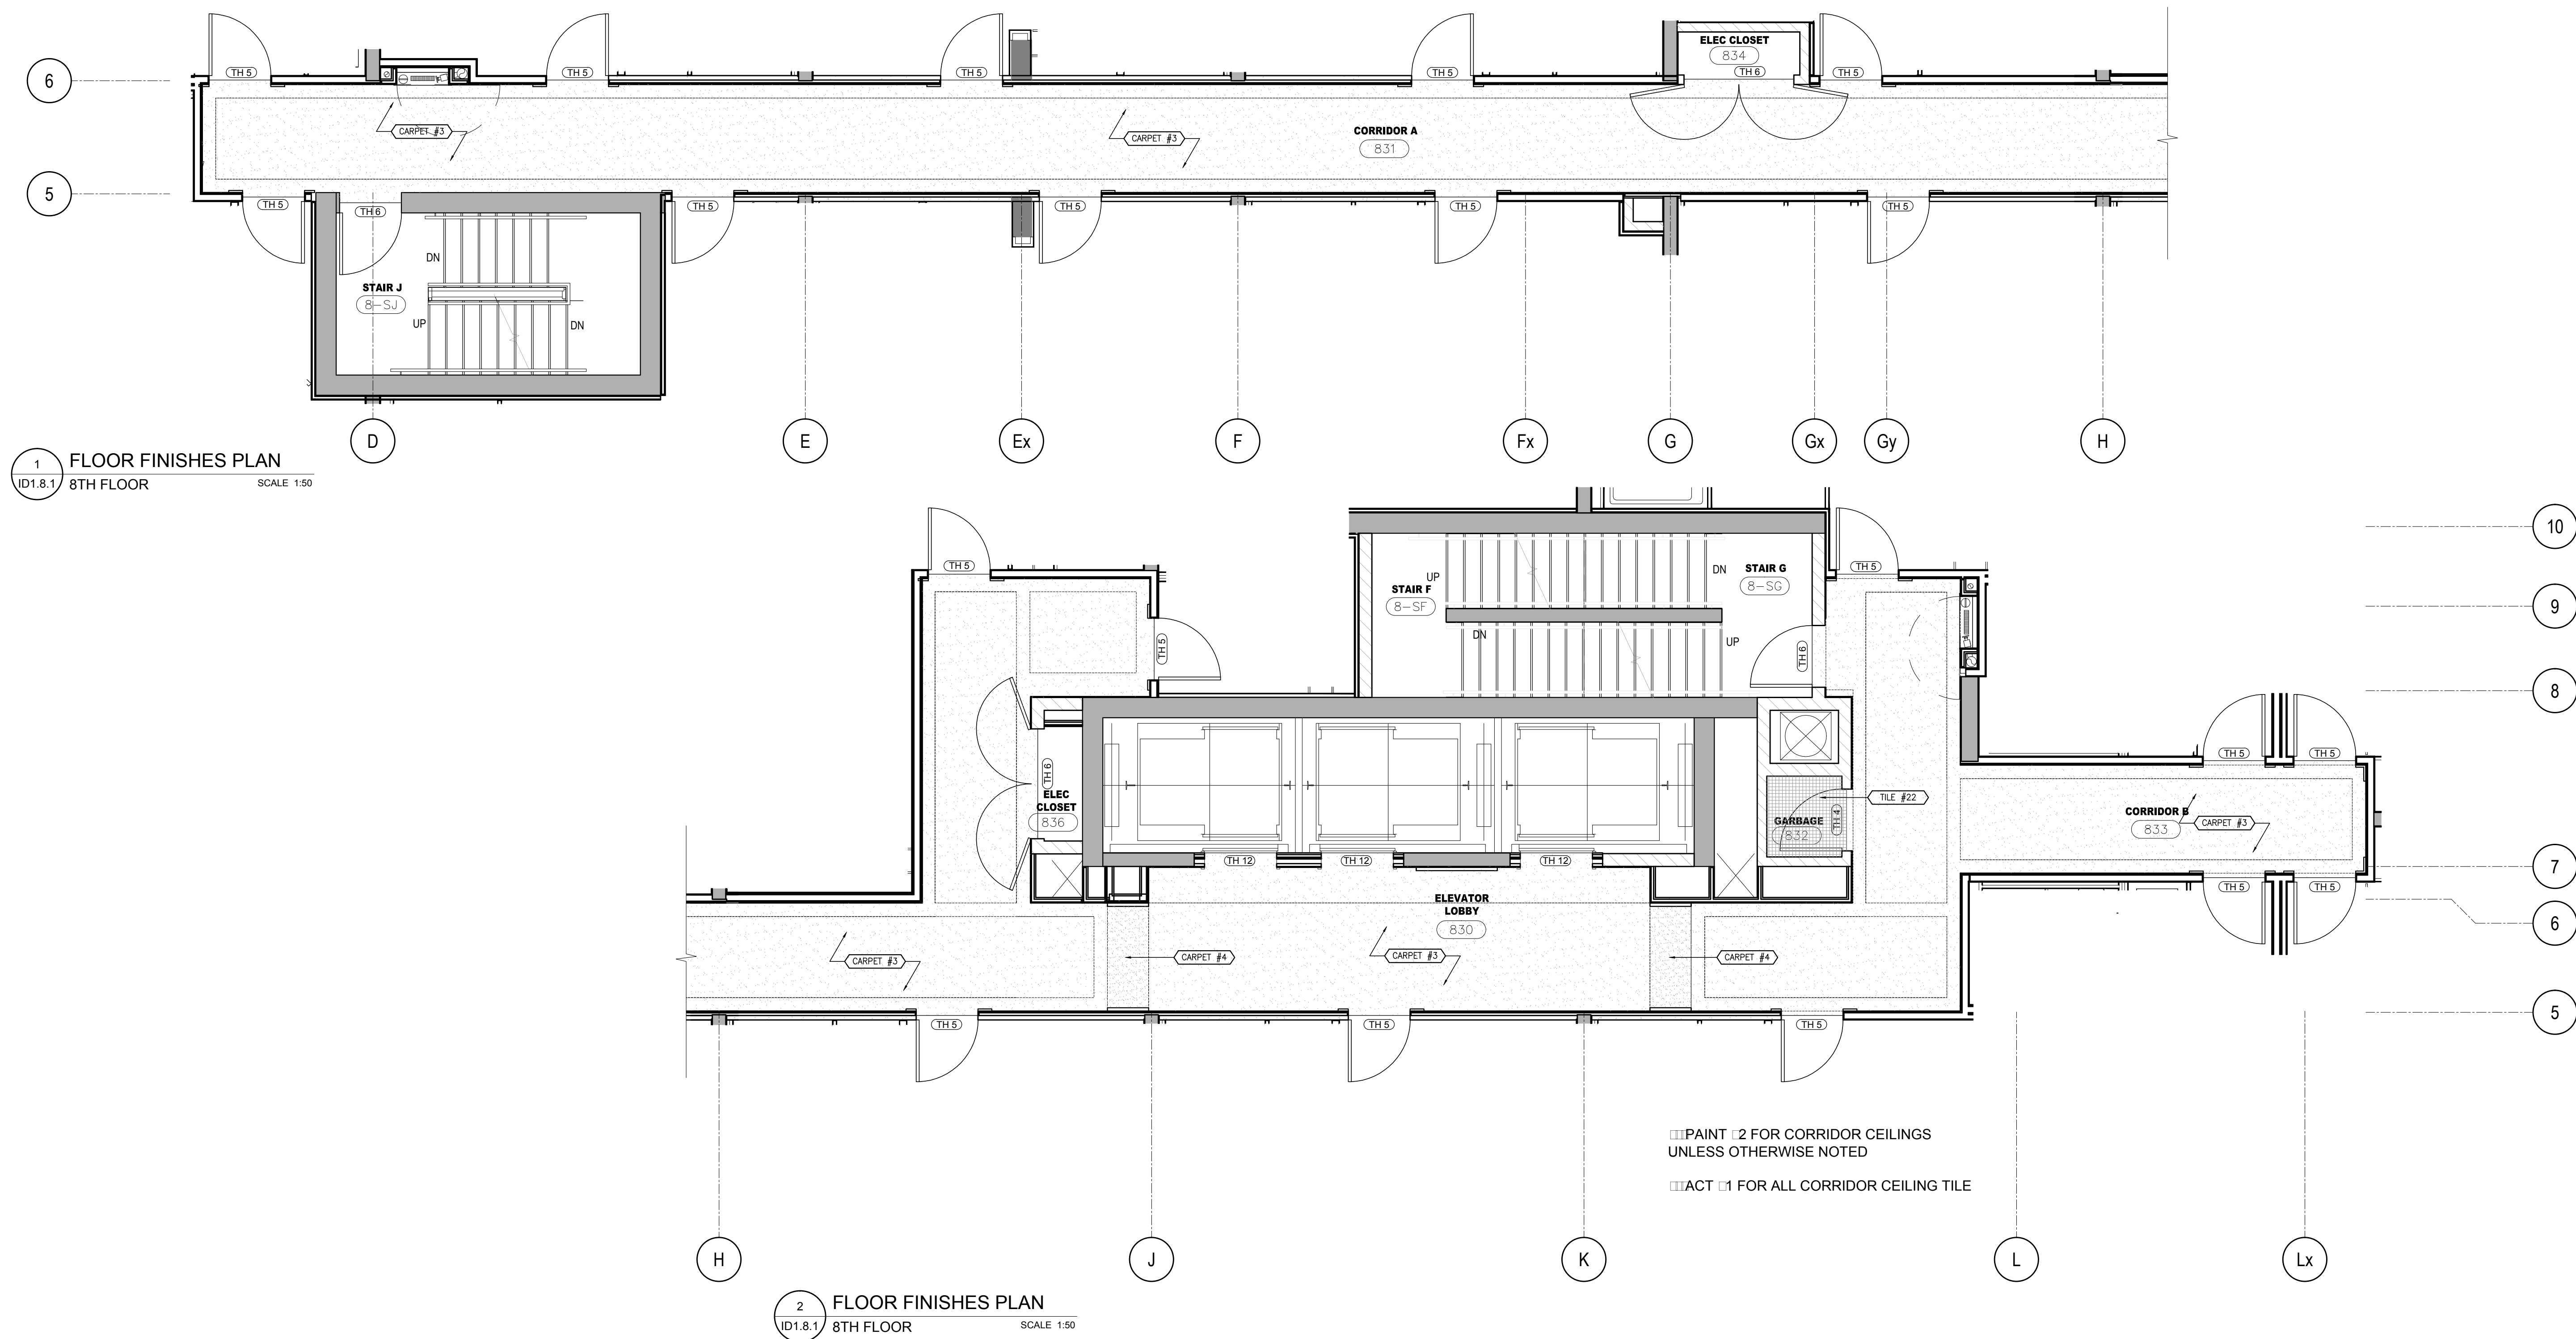

DO NOT SCALE DRAWINGS.

CONTRACTOR MUST VERIFY ALL DRAWINGS, DIMENSIONS, DETAILS AND SPECIFICATIONS AND REPORT ANY DISCREPANCIES TO UNION 31 INC. BEFORE PROCEEDING WITH WORK. MATERIALS MAY NOT BE SUBSTITUTED WITHOUT WRITTEN APPROVAL FROM UNION 31 INC.

ALL DRAWINGS AND SPECIFICATIONS ARE INSTRUMENTS OF SERVICE AND THE PROPERTY OF UNION 31 INC. WHICH MUST BE RETURNED AT THE COMPLETION OF THE WORK.

PRINTED: 30-MAR-17

ISSUED FOR
AS-BUILT

01	31 MAY 17	ISSUED FOR AS-BUILT	SV
NO.	DATE	COMMENTS	INI

REVISIONS:

UNION31

PROJECT NAME:
ALEXANDRA PARK
MAIN BUILDING
BLOCK 11
ON, Canada
PROJECT NO.:
13-949
DRAWINGS:
8TH FLOOR
FLOOR FINISHES PLAN &
WALL FINISHES PLAN
DATE STARTED: 07 AUG / 13
SCALE: 1 : 50
DRAWN BY: AP
APPROVED BY: KC

UNION31 INC.
183 BATHURST STREET, STE. 201
TORONTO, ON, M5T 2R7, CANADA
TEL: 416-597-1576 FAX: 416-597-2139

DRAWING NO.:	ID
1.8.1	

DO NOT SCALE DRAWINGS.

CONTRACTOR MUST VERIFY ALL DRAWINGS, DIMENSIONS, DETAILS AND SPECIFICATIONS AND REPORT ANY DISCREPANCIES TO UNION 31 INC. BEFORE PROCEEDING WITH WORK. MATERIALS MAY NOT BE SUBSTITUTED WITHOUT WRITTEN APPROVAL FROM UNION 31 INC.

ALL DRAWINGS AND SPECIFICATIONS ARE INSTRUMENTS OF SERVICE AND THE PROPERTY OF UNION 31 INC. WHICH MUST BE RETURNED AT THE COMPLETION OF THE WORK.

PRINTED: 30-May-17


ISSUED FOR
AS-BUILT

01	31 MAY / 17	ISSUED FOR AS-BUILT	SV
NO.	DATE	COMMENTS	INI
REVISIONS:			


UNION31

UNION31 INC.
183 BATHURST STREET, STE. 201
TORONTO, ON, M5T 2R7, CANADA
TEL: 416-597-1576 FAX: 416-597-2139

PROJECT NAME:		ALEXANDRA PARK MAIN BUILDING	
PROJECT NO.:		13-949	
DRAWINGS:		9TH FLOOR CONSTRUCTION PLAN & REFLECTED CEILING PLAN	
DATE STARTED:	07 AUG / 13	DRAWING NO.:	ID
SCALE:	1 : 50	DRAWN BY:	AP
APPROVED BY:	KC		1.9.0

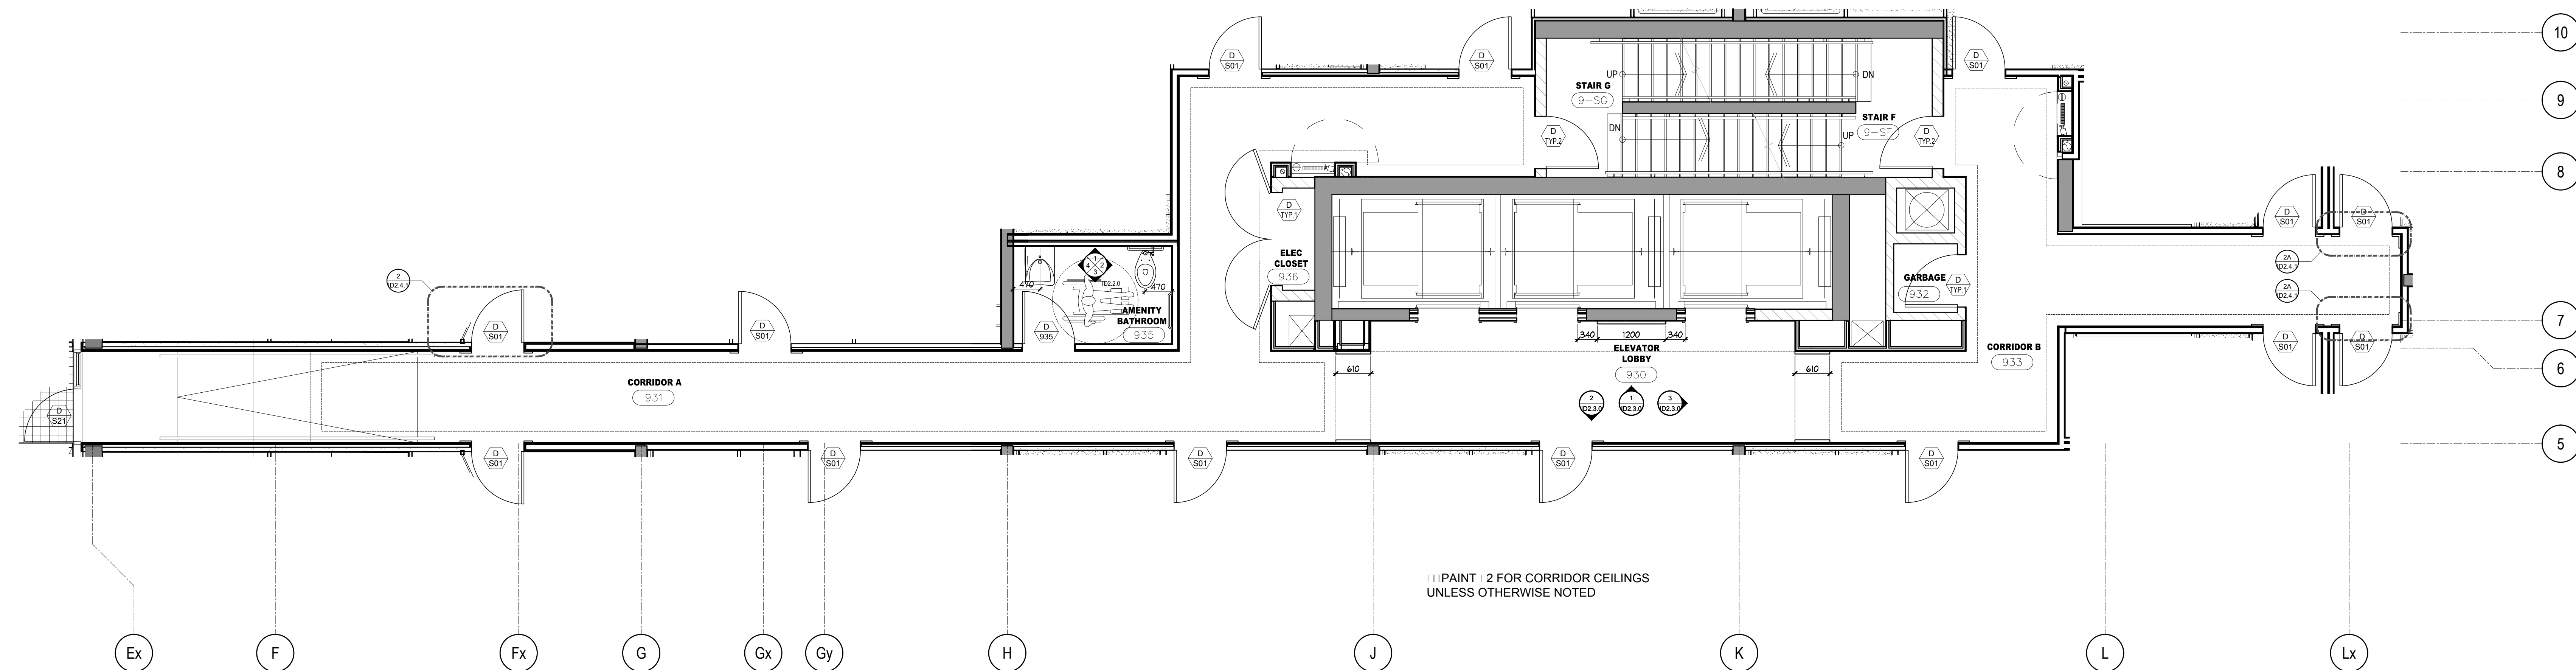

1 CONSTRUCTION PLAN
ID1.9.0 9TH FLOOR SCALE 1:50

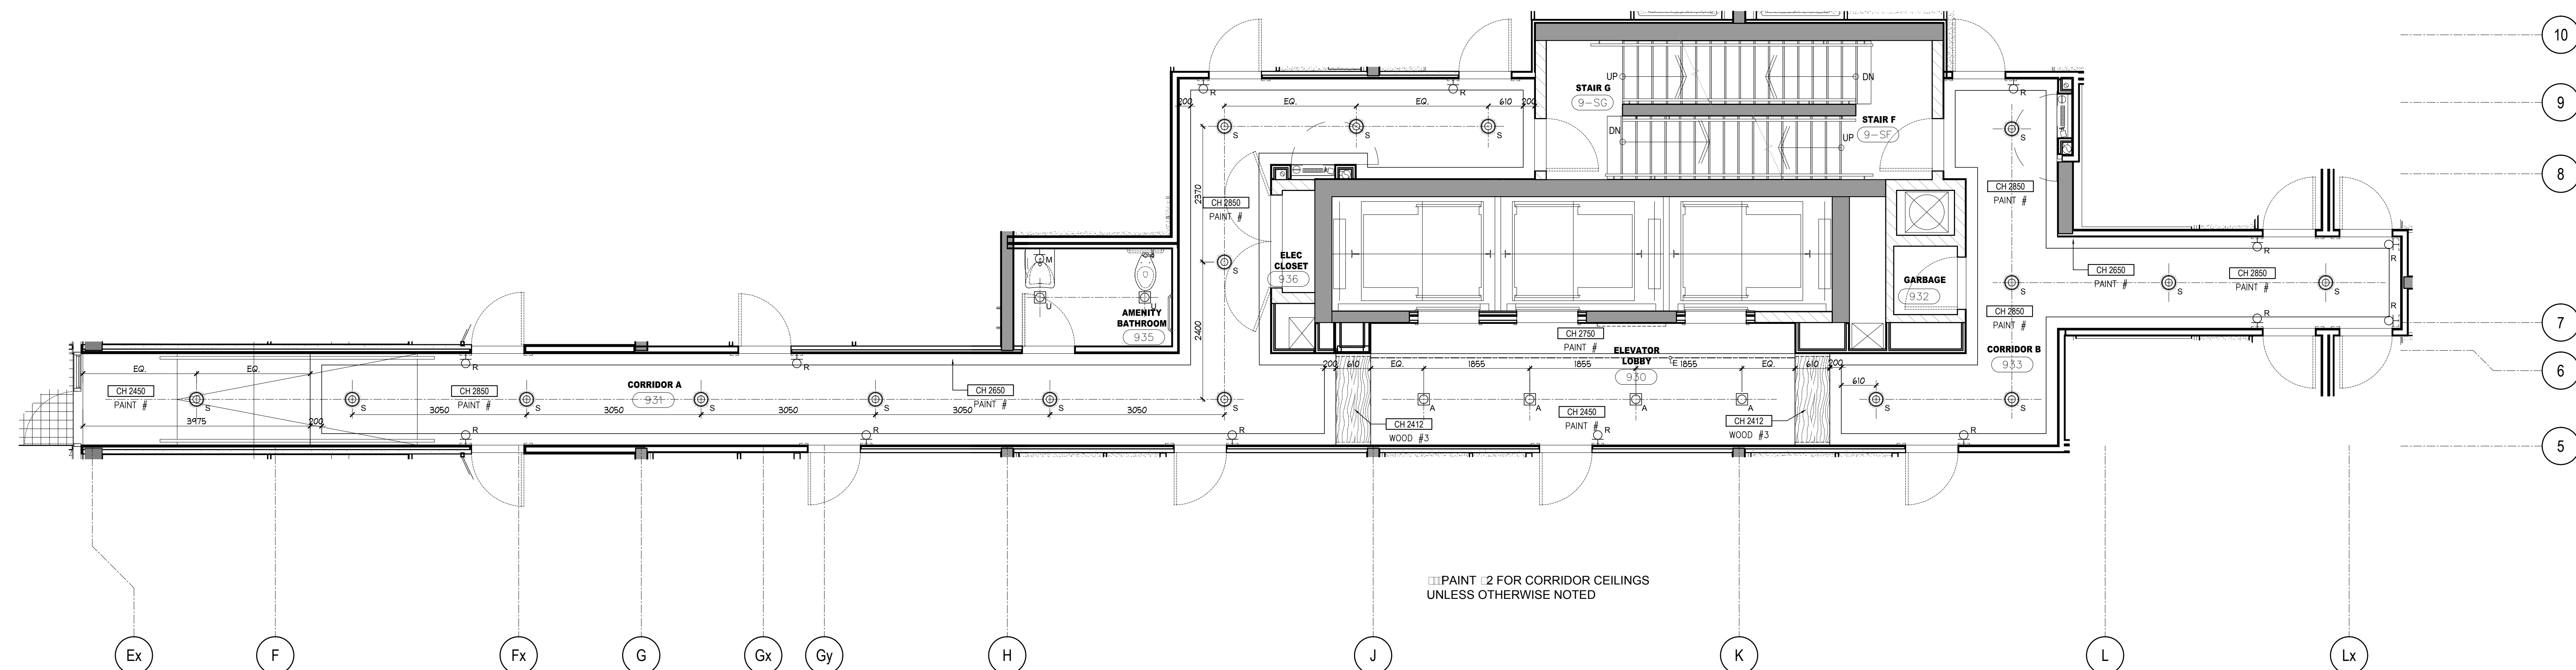

2 REFLECTED CEILING PLAN
ID1.9.0 9TH FLOOR SCALE 1:50

DO NOT SCALE DRAWINGS.

CONTRACTOR MUST VERIFY ALL DRAWINGS, DIMENSIONS, DETAILS AND SPECIFICATIONS AND REPORT ANY DISCREPANCIES TO UNION 31 INC. BEFORE PROCEEDING WITH WORK. MATERIALS MAY NOT BE SUBSTITUTED WITHOUT WRITTEN APPROVAL FROM UNION 31 INC.

ALL DRAWINGS AND SPECIFICATIONS ARE INSTRUMENTS OF SERVICE AND THE PROPERTY OF UNION 31 INC. WHICH MUST BE RETURNED AT THE COMPLETION OF THE WORK.

PRINTED: 30-May-17


ISSUED FOR
AS-BUILT

01	31 MAY / 17	ISSUED FOR AS-BUILT	SV
NO.	DATE	COMMENTS	INI
REVISIONS:			


UNION31

UNION31 INC.
183 BATHURST STREET, STE. 201
TORONTO, ON, M5T 2R7, CANADA
TEL: 416-597-1576 FAX: 416-597-2139


PROJECT NAME:		ALEXANDRA PARK MAIN BUILDING	
PROJECT NO.:		13-949	
DRAWINGS:		9TH FLOOR FURNITURE & POWER PLAN FLOOR FINISHES PLAN & WALL FINISHES PLAN	
DATE STARTED:	07 AUG / 13	DRAWING NO.:	ID
SCALE:	1" = 50'	DRAWN BY:	AP
APPROVED BY:	KC		1.9.1

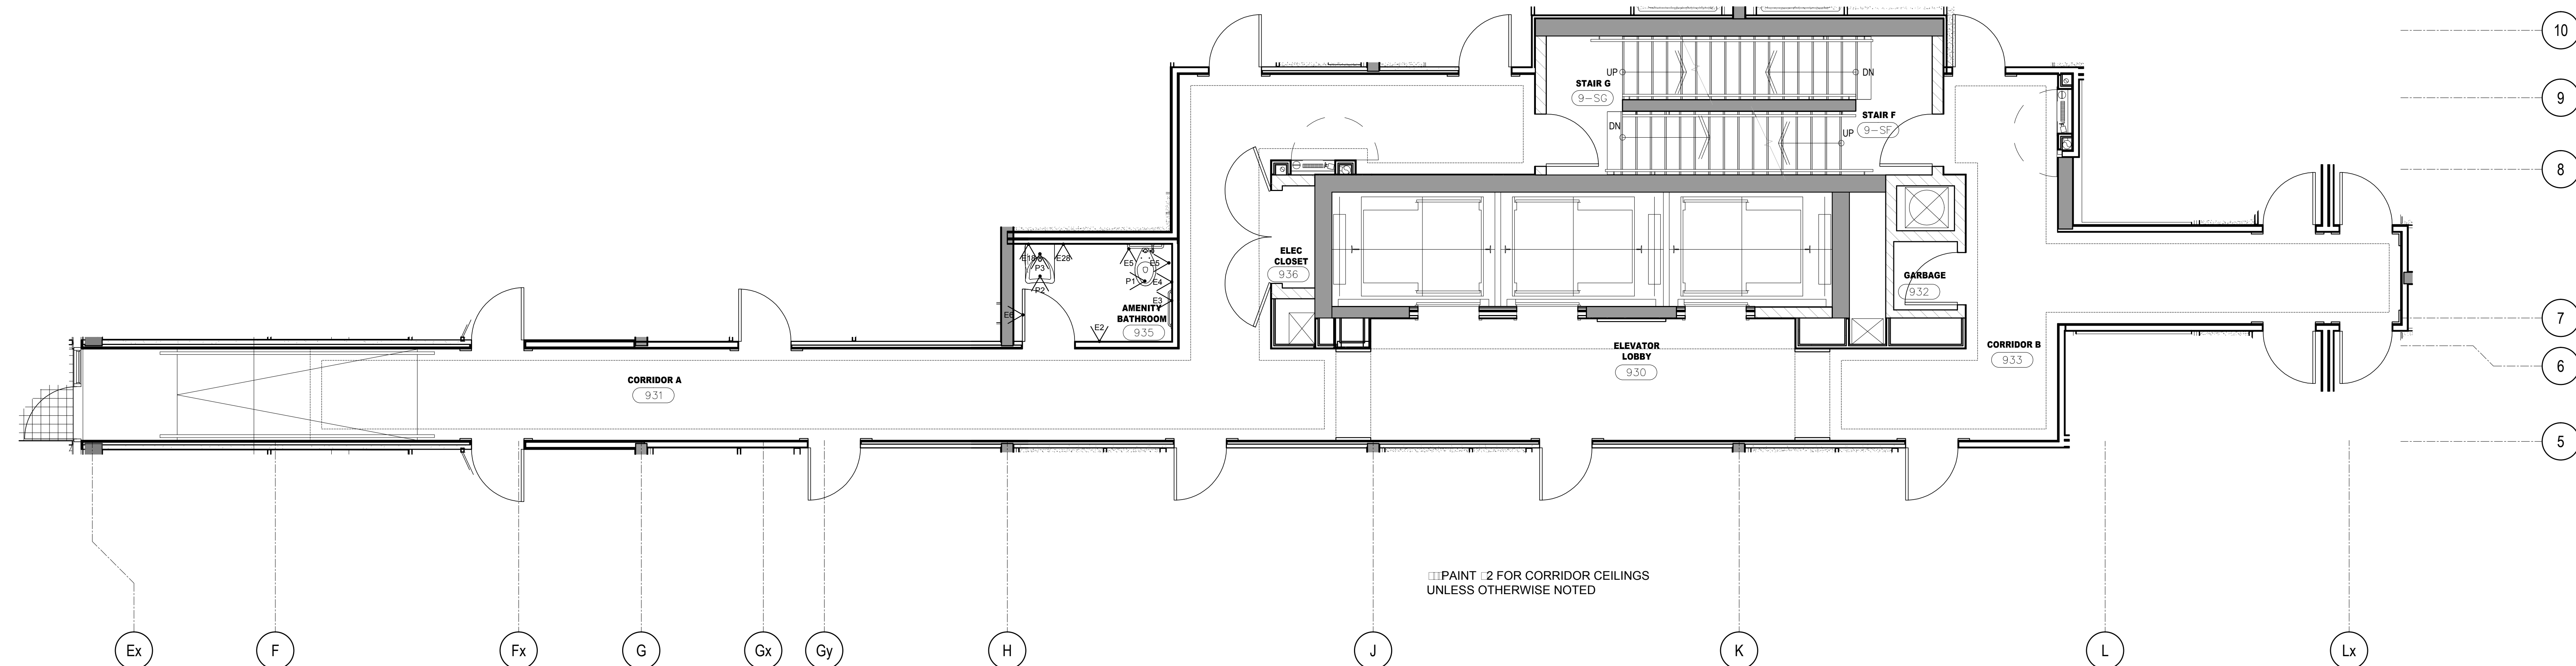





1 FURNITURE & POWER PLAN
ID1.9.1 9TH FLOOR SCALE 1/50

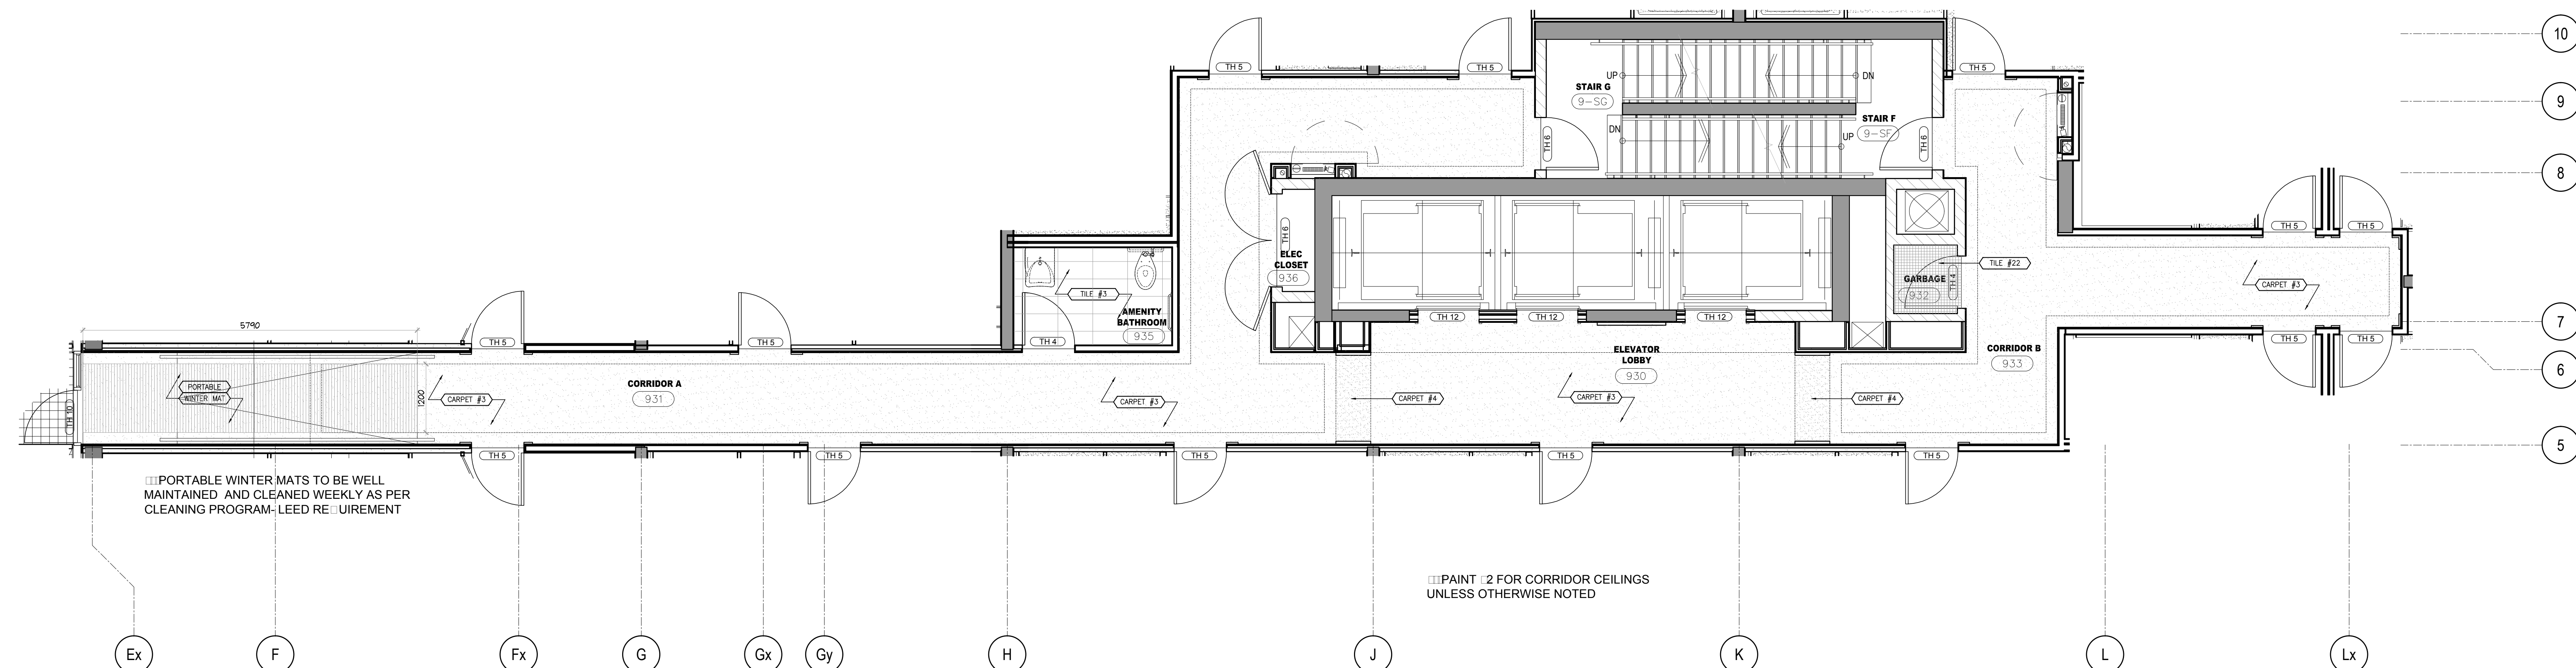

2 FLOOR FINISHES PLAN
ID1.9.1 9TH FLOOR SCALE 1/50

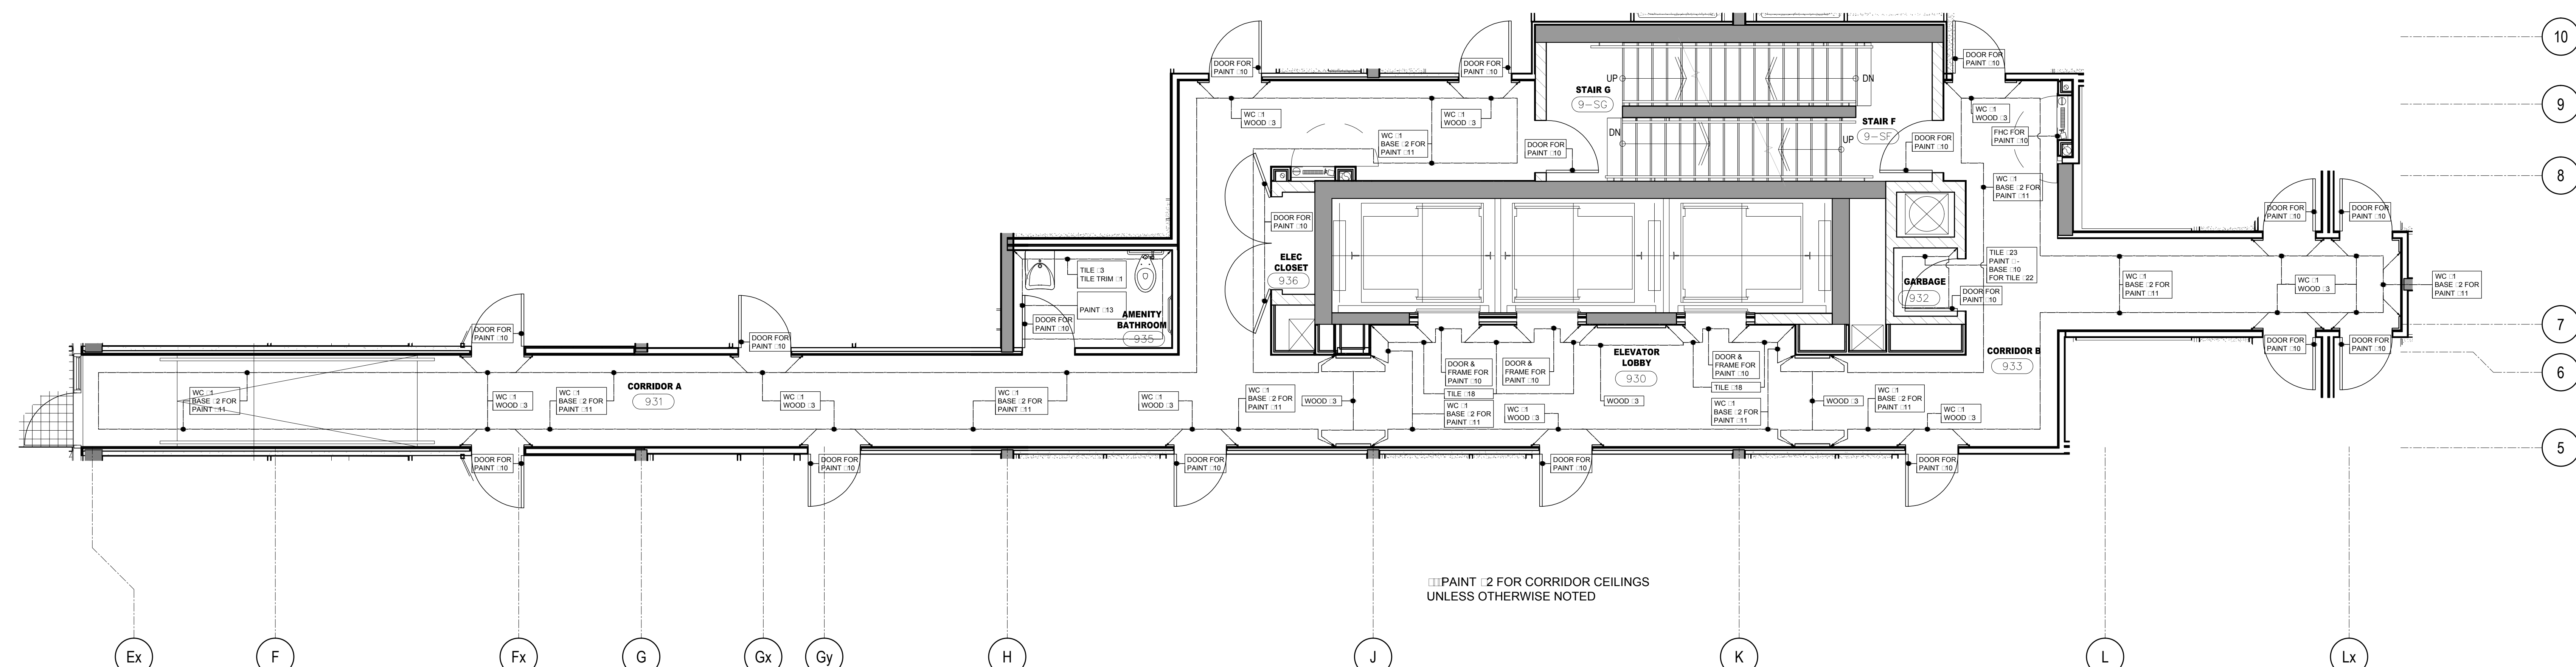

3 WALL FINISHES PLAN
ID1.9.1 9TH FLOOR SCALE 1/50

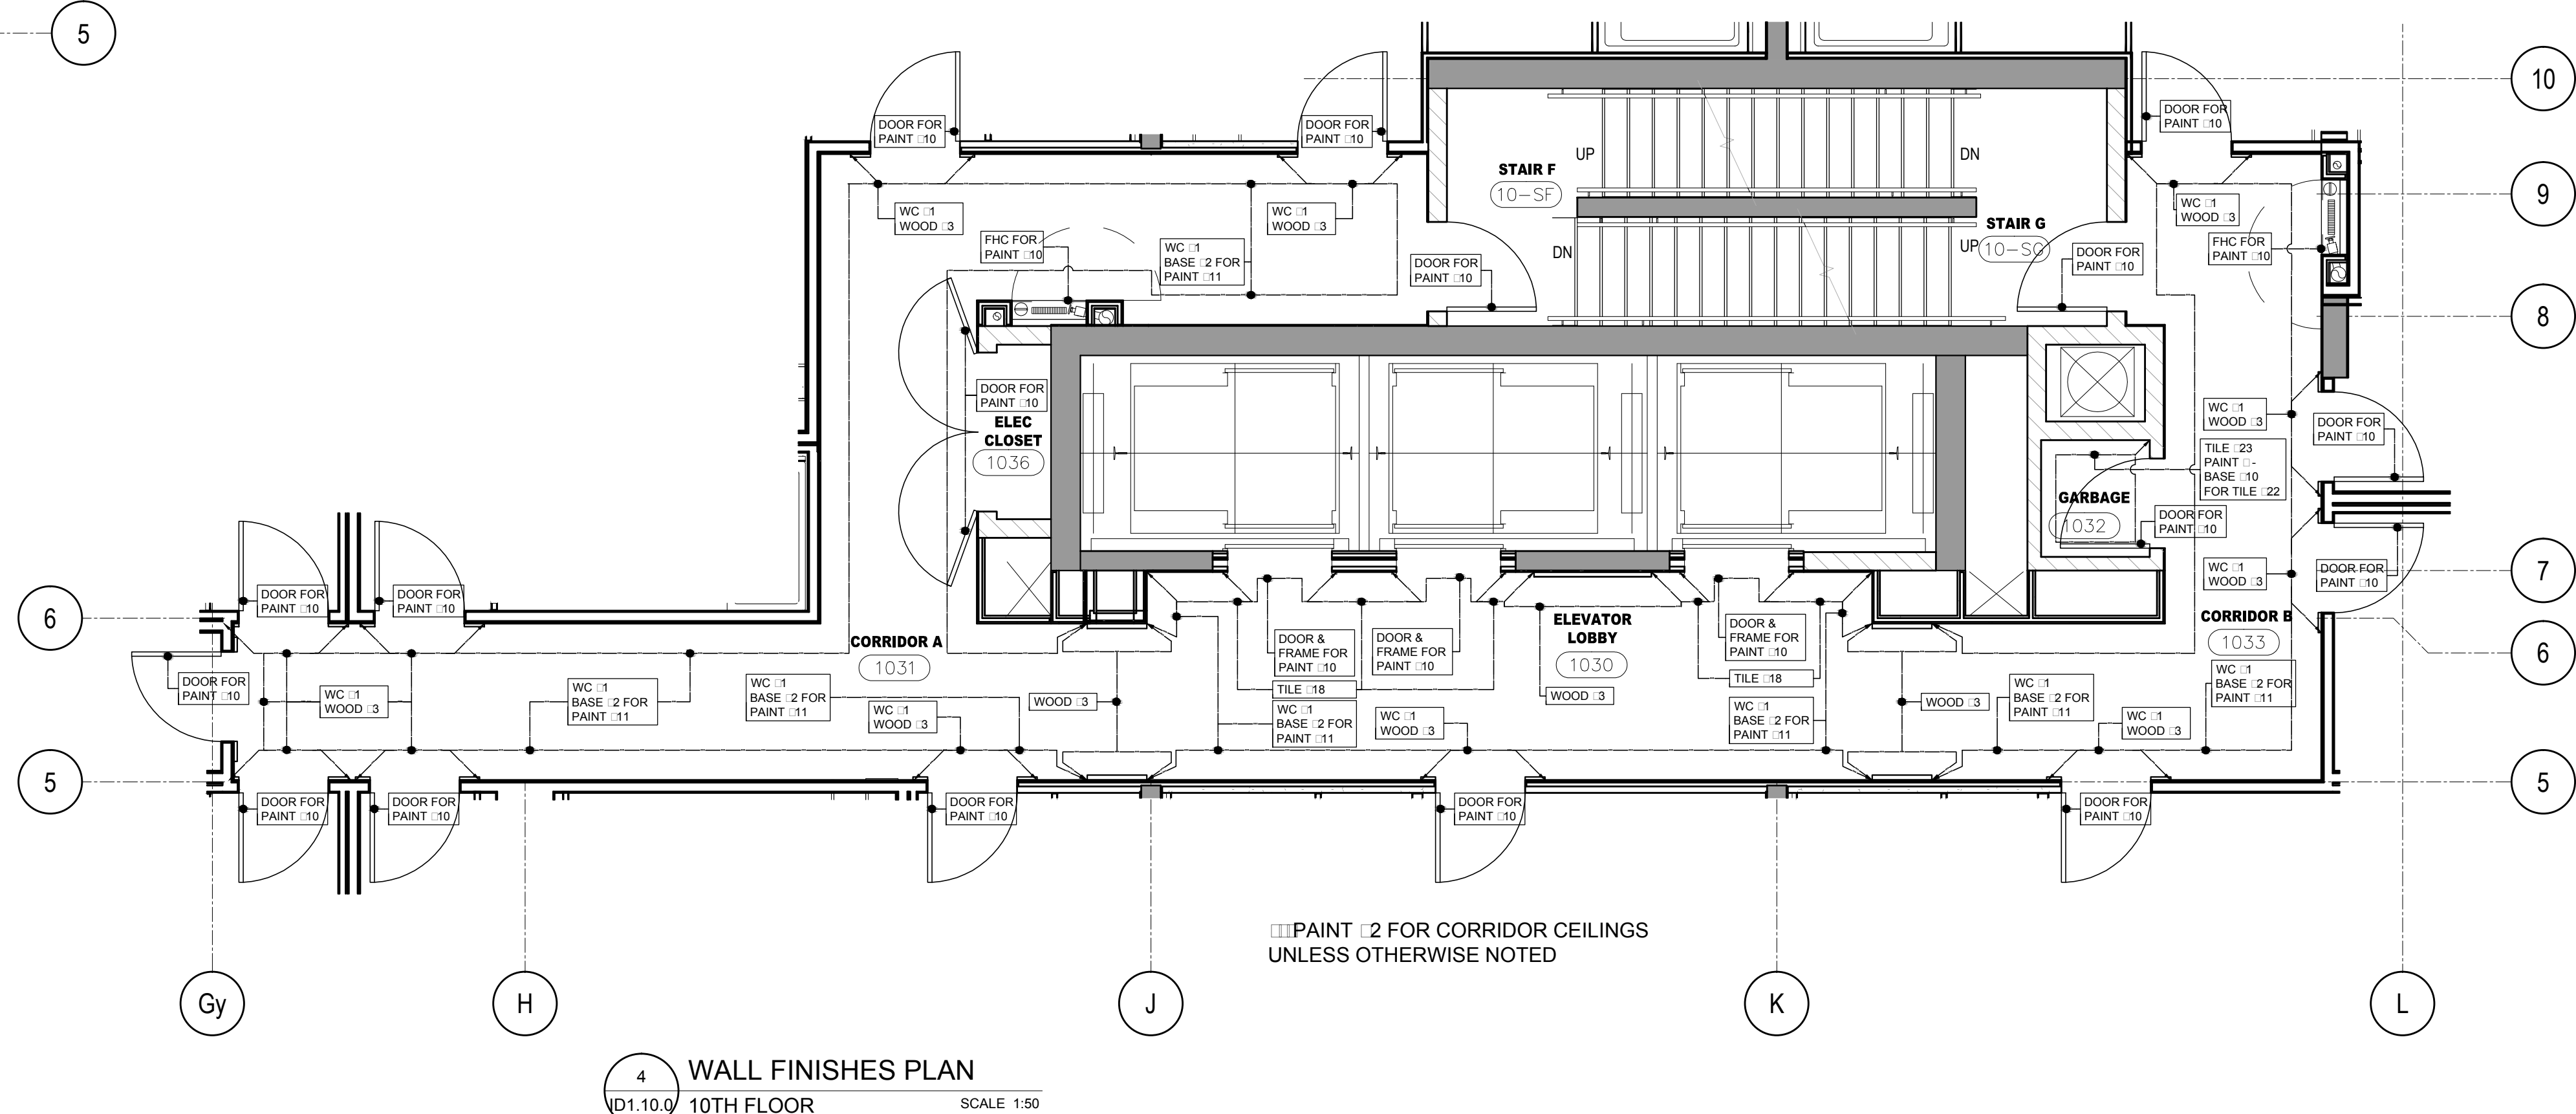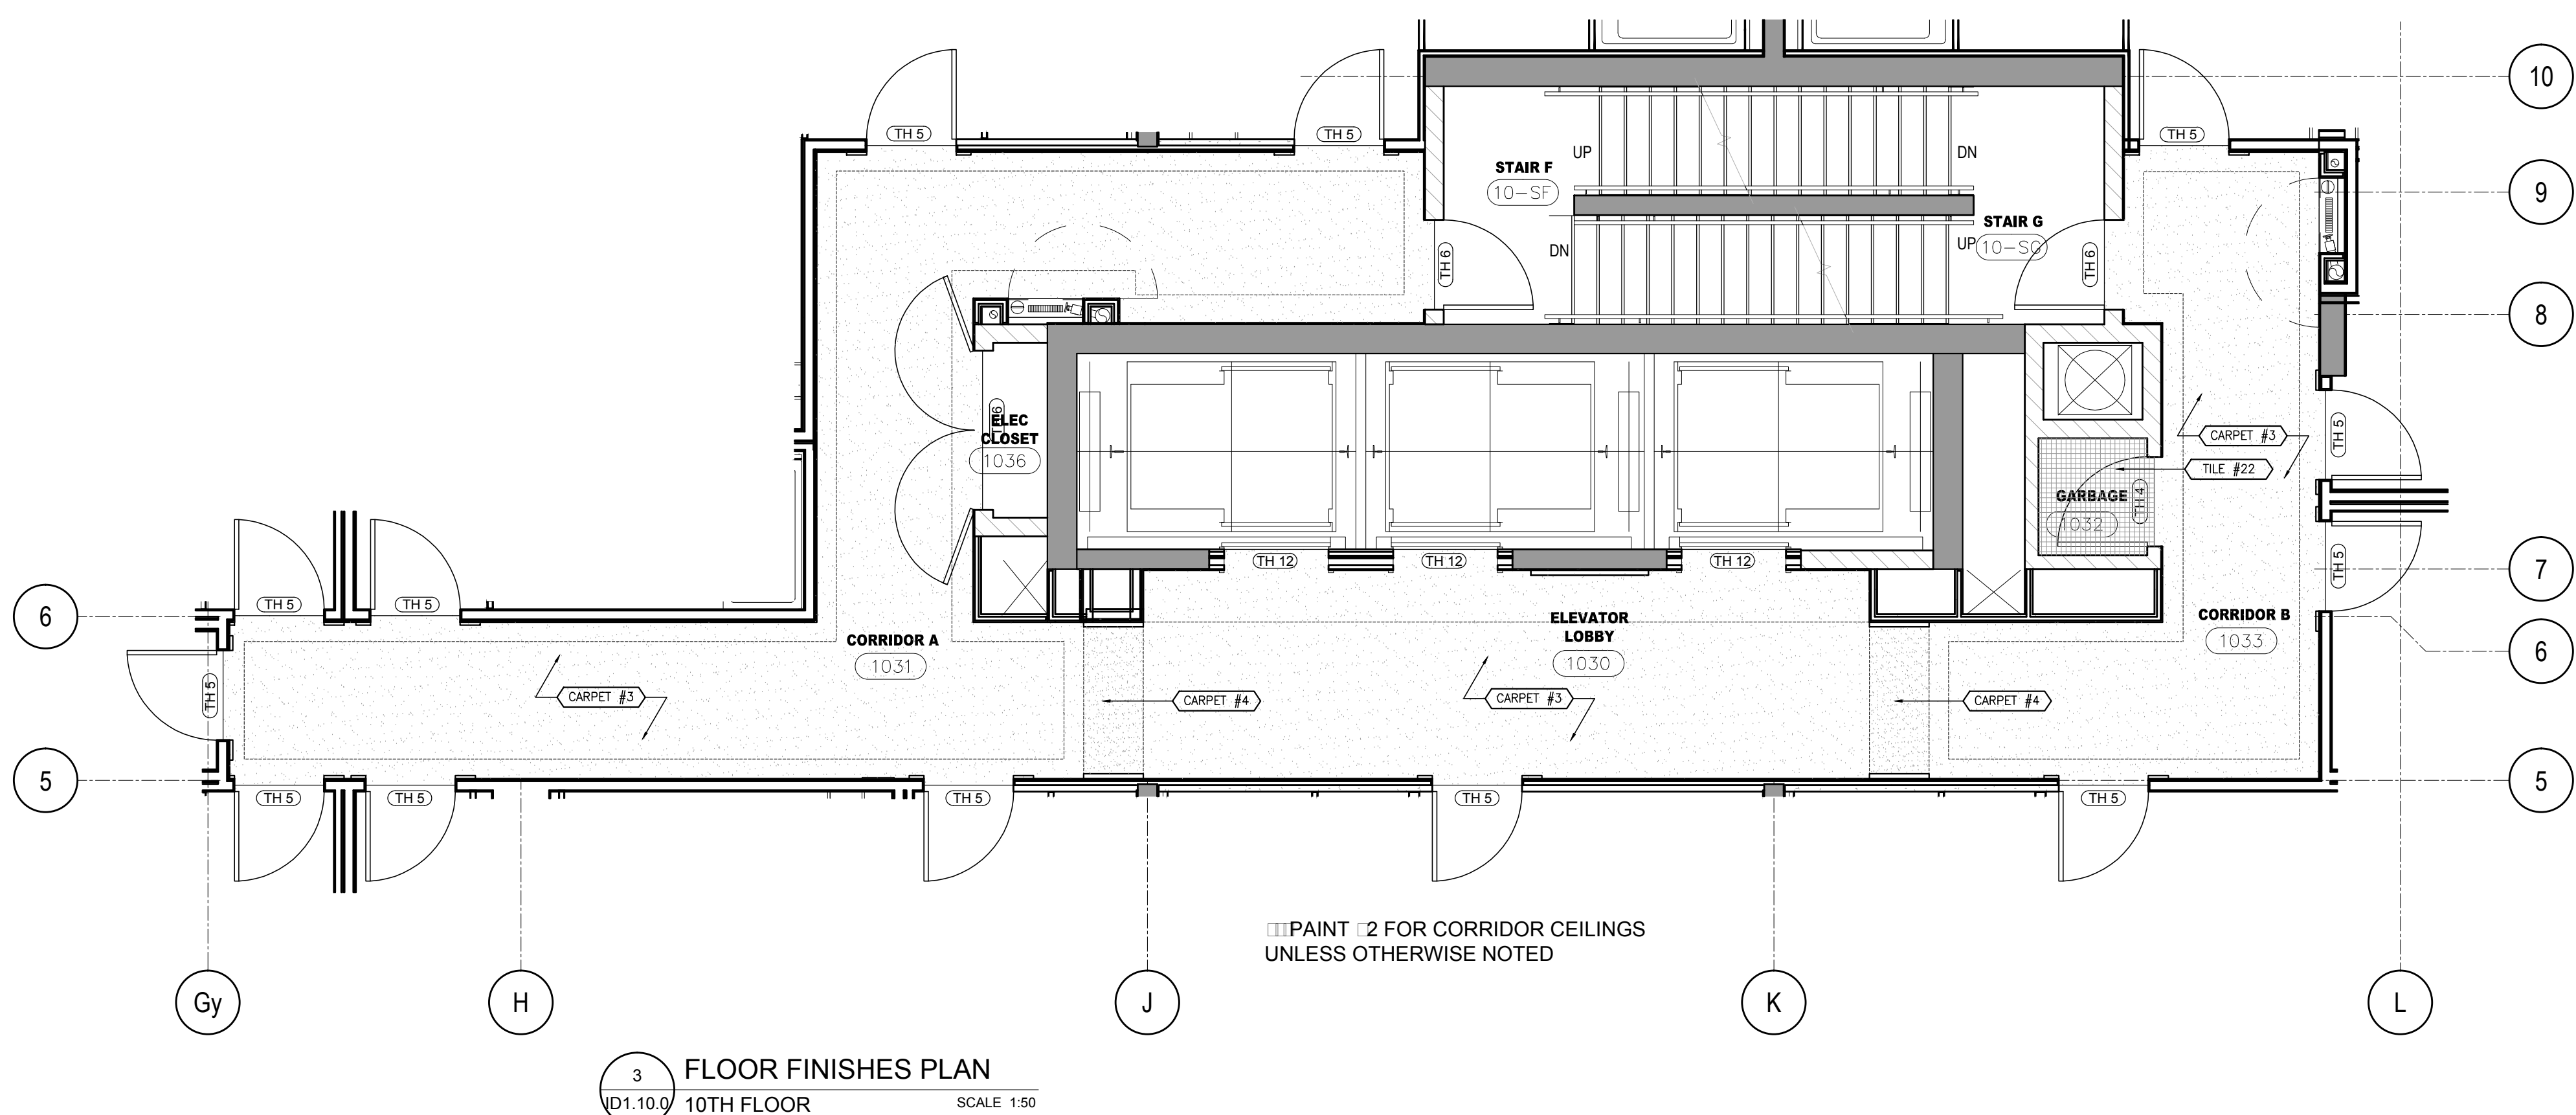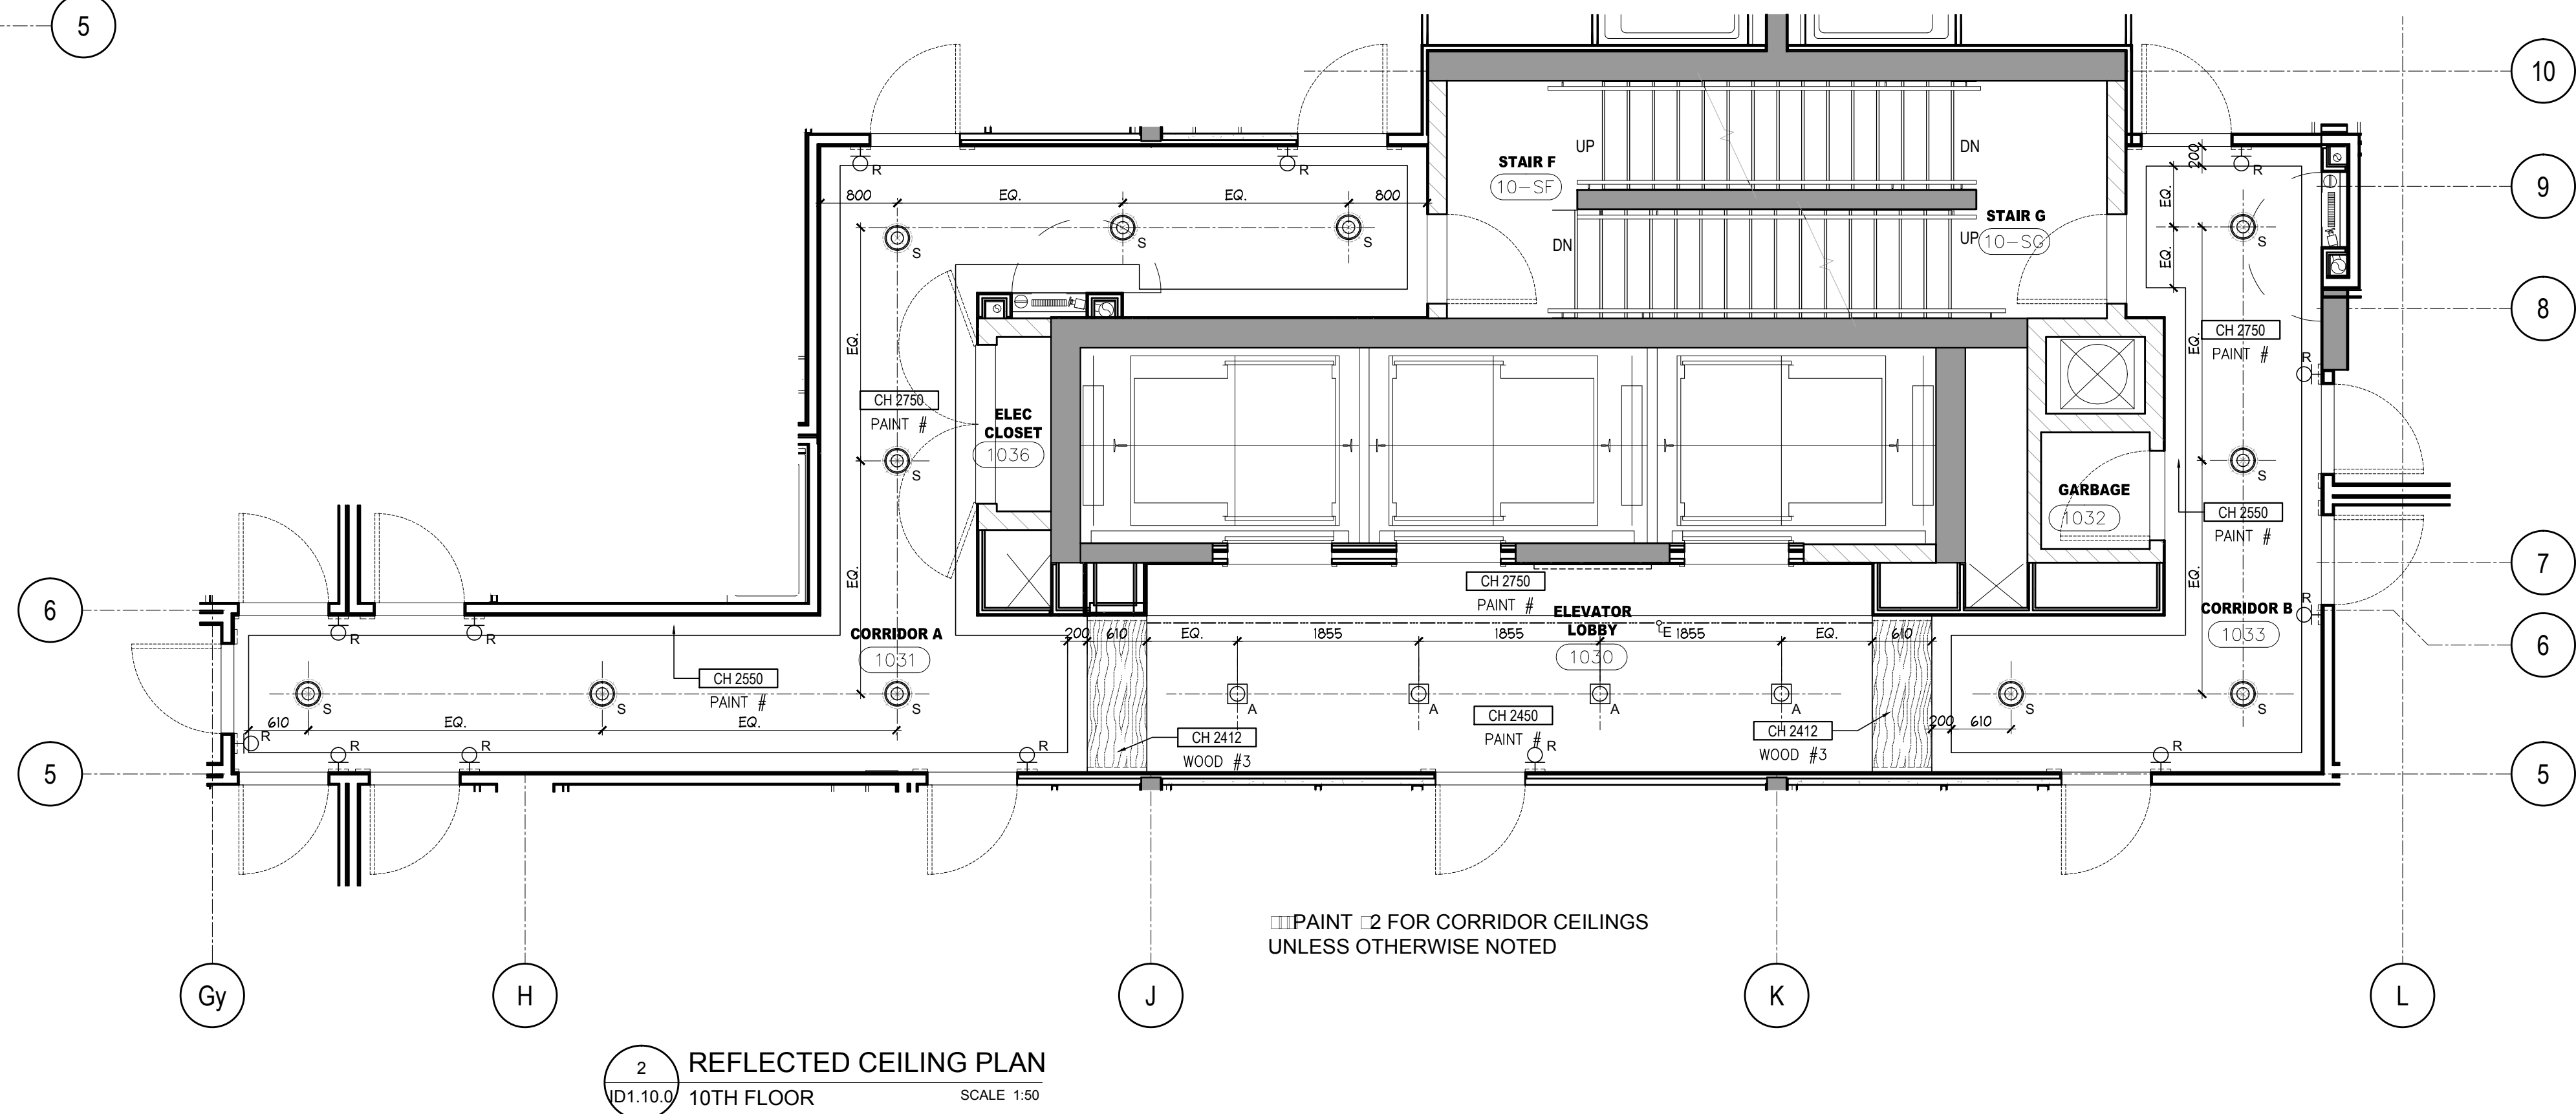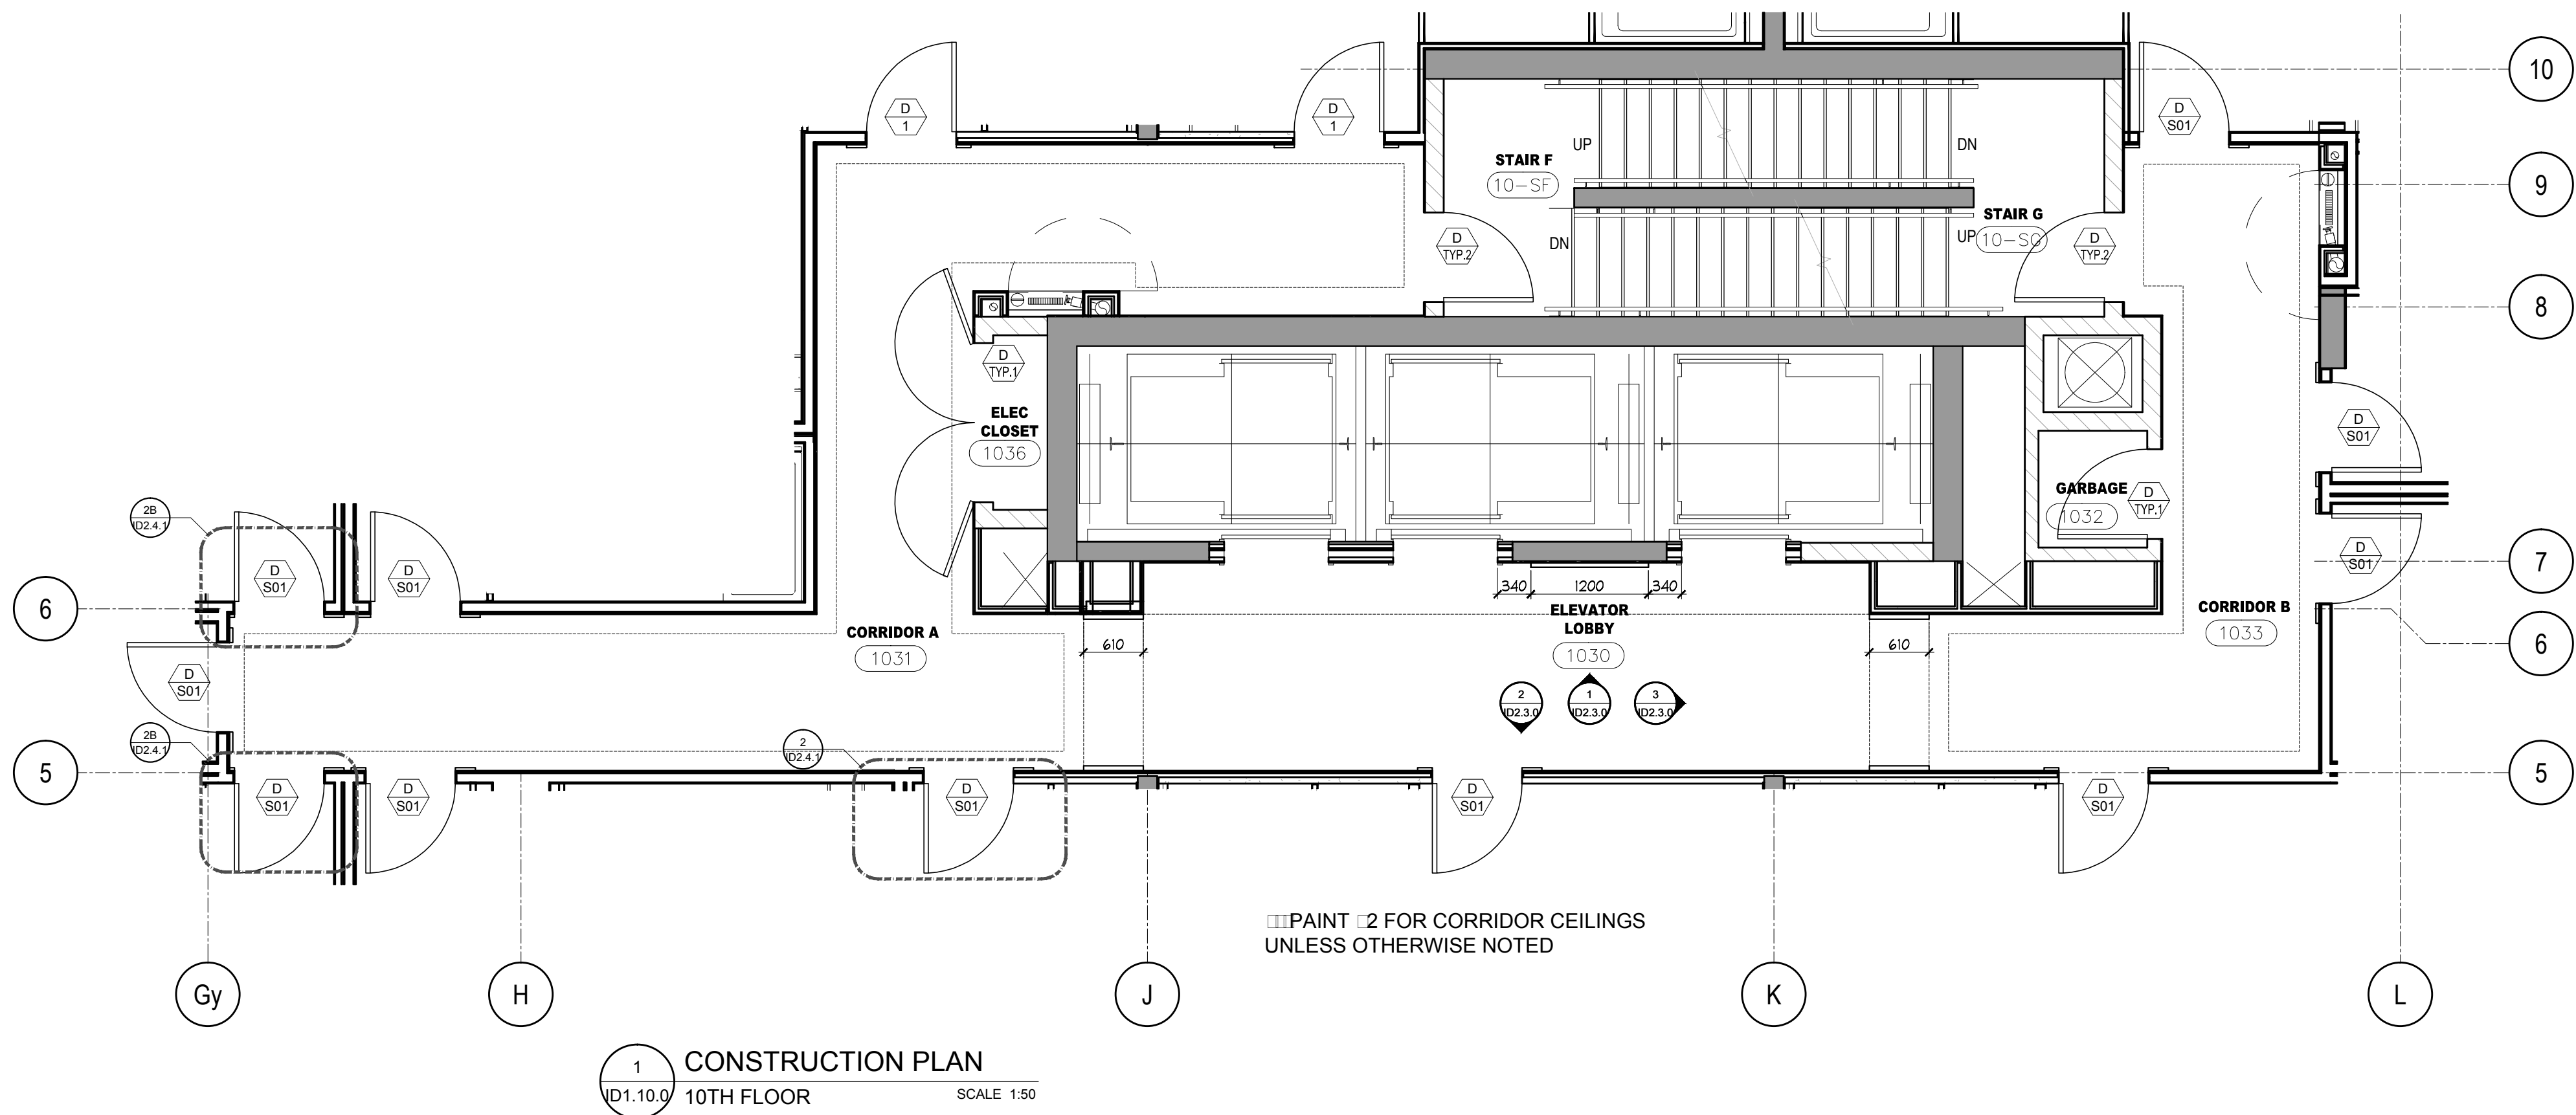

DO NOT SCALE DRAWINGS.

CONTRACTOR MUST VERIFY ALL DRAWINGS, DIMENSIONS, DETAILS AND SPECIFICATIONS AND REPORT ANY DISCREPANCIES TO UNION 31 INC. BEFORE PROCEEDING WITH WORK. MATERIALS MAY NOT BE SUBSTITUTED WITHOUT WRITTEN APPROVAL FROM UNION 31 INC.

ALL DRAWINGS AND SPECIFICATIONS ARE INSTRUMENTS OF SERVICE AND THE PROPERTY OF UNION 31 INC. WHICH MUST BE RETURNED AT THE COMPLETION OF THE WORK.

PRINTED: 30-May-17

ISSUED FOR
AS-BUILT

01	31 MAY / 17	ISSUED FOR AS-BUILT	SV
NO.	DATE	COMMENTS	INI





REVISIONS:

UNION31

UNION31 INC.
183 BATHURST STREET, STE. 201
TORONTO, ON, M5T 2R7, CANADA
TEL: 416-597-1576 FAX: 416-597-2139

PROJECT NAME:	ALEXANDRA PARK MAIN BUILDING
BLOCK 11 ON, Canada	
PROJECT NO.:	13-949
DRAWINGS:	10TH FLOOR CONSTRUCTION PLAN & REFLECTED CEILING PLAN & FLOOR & WALL FINISHES PLANS

DATE STARTED:	07 AUG / 13	DRAWING NO.:	ID
SCALE:	1 : 50		1.10.0
DRAWN BY:	AP		
APPROVED BY:	KC		

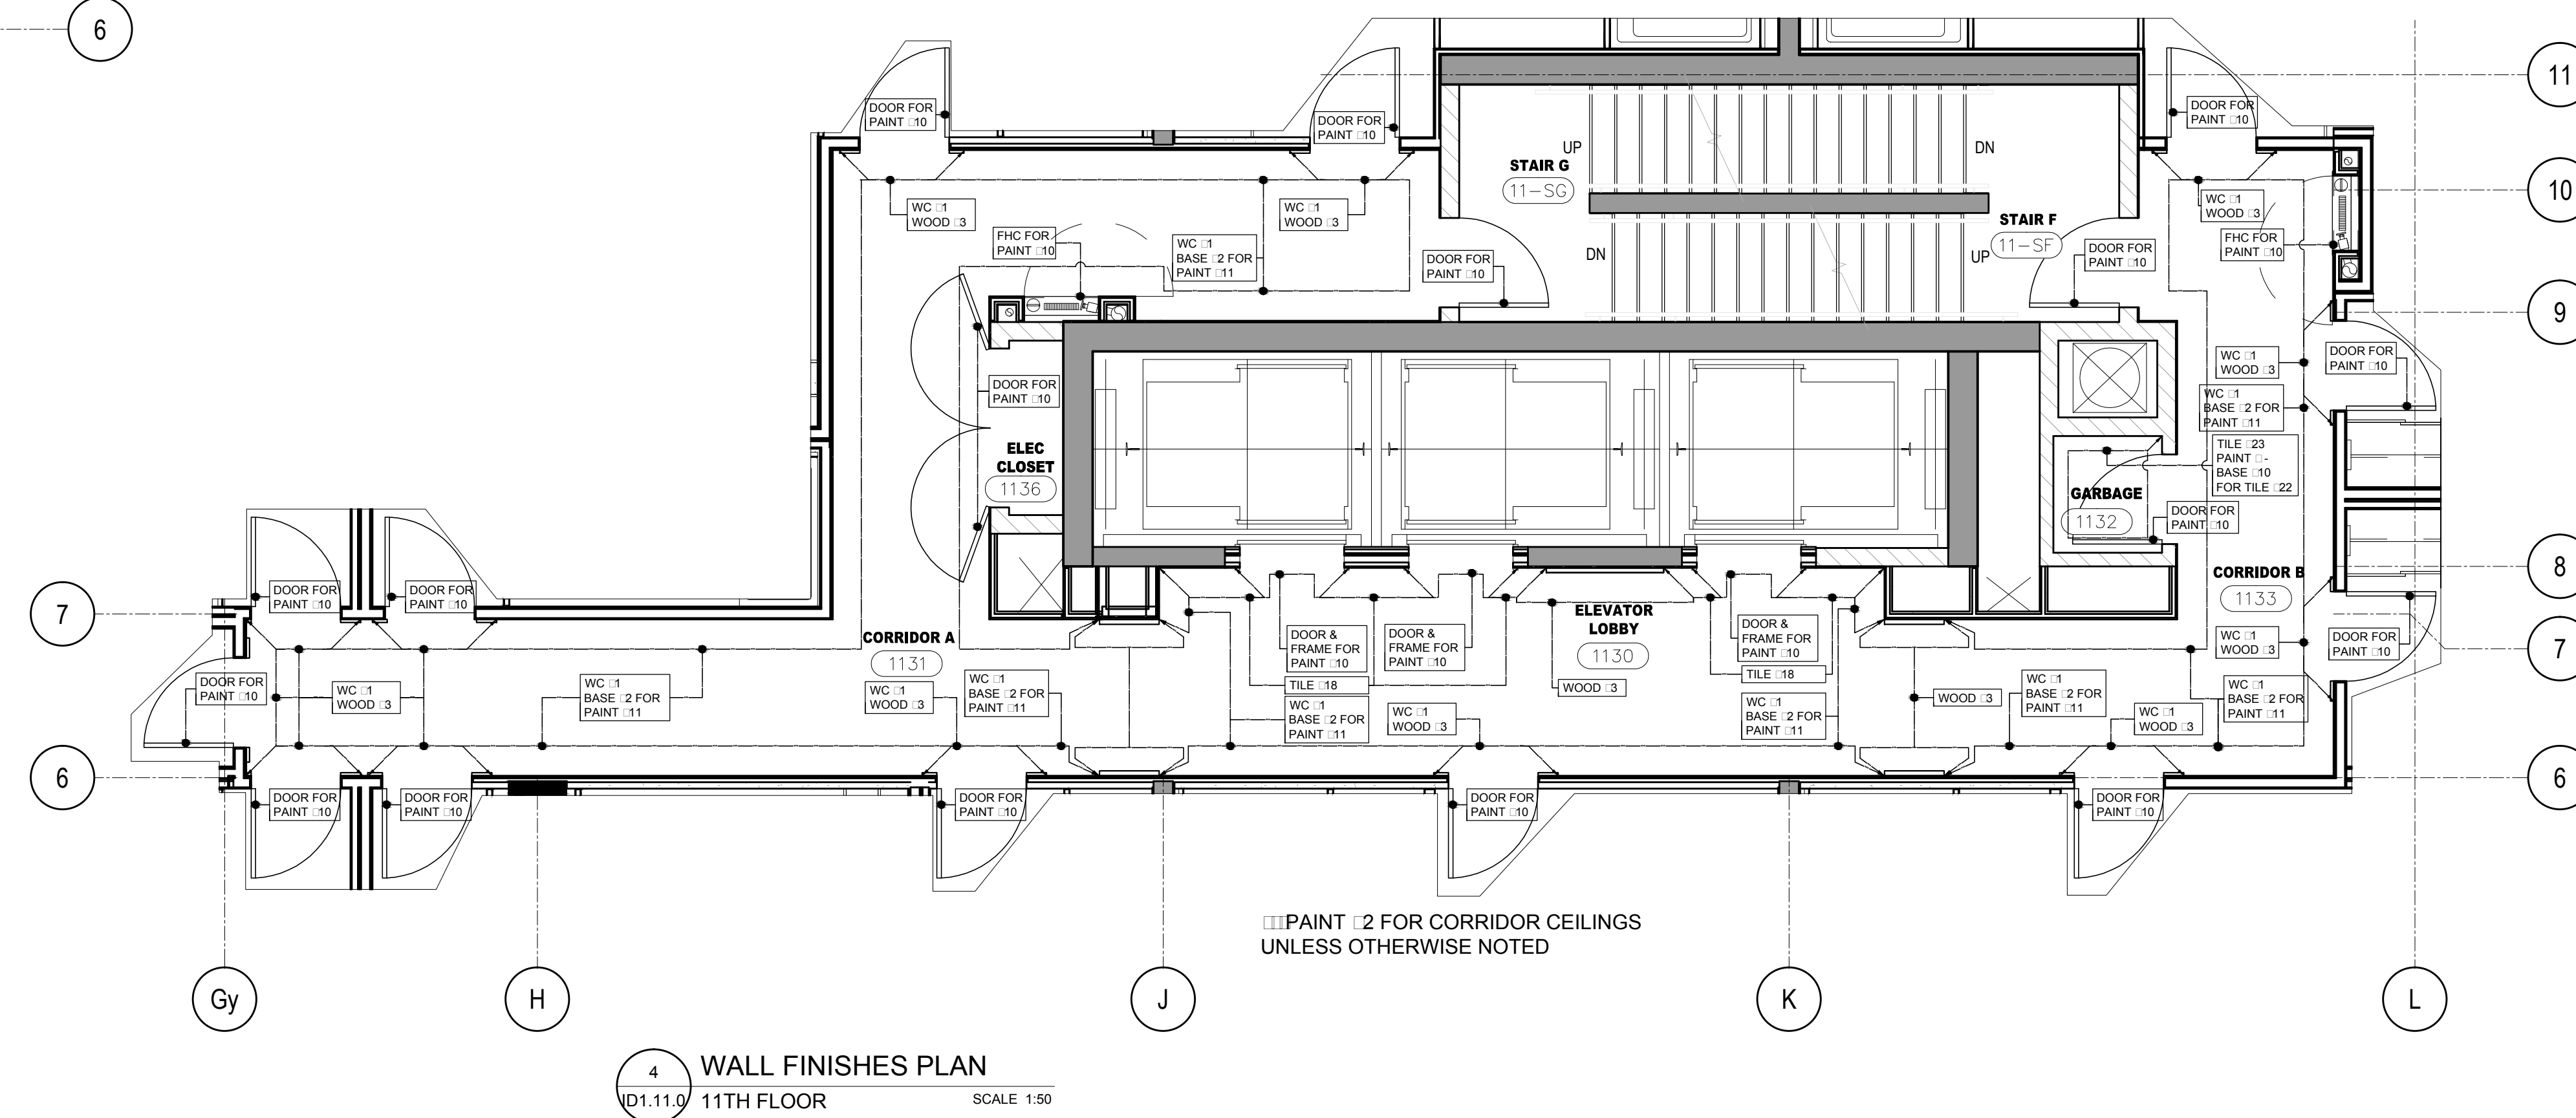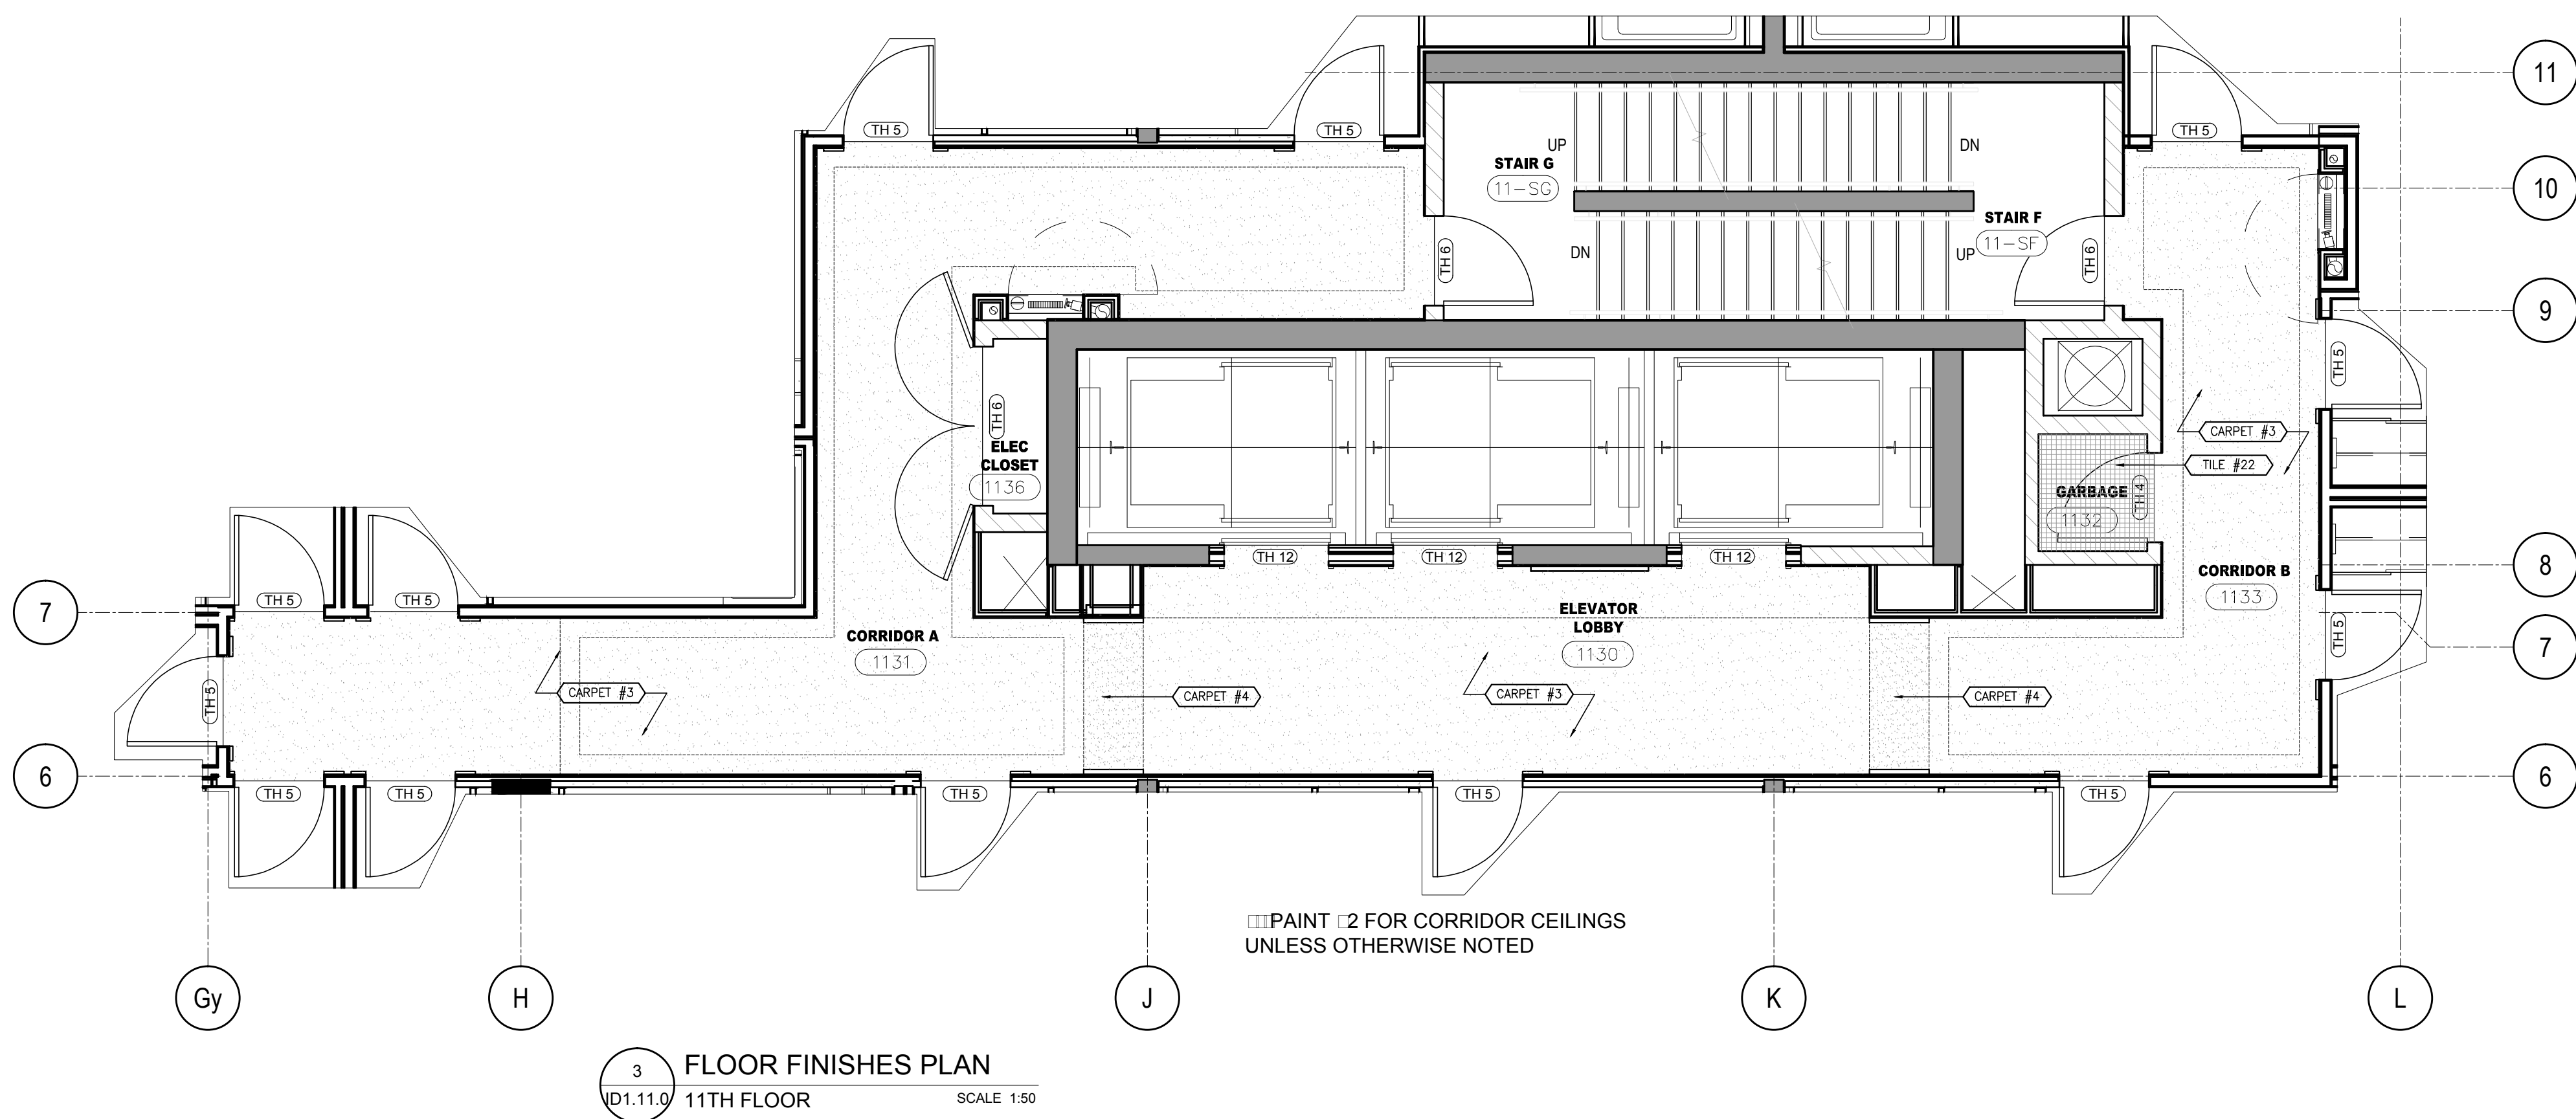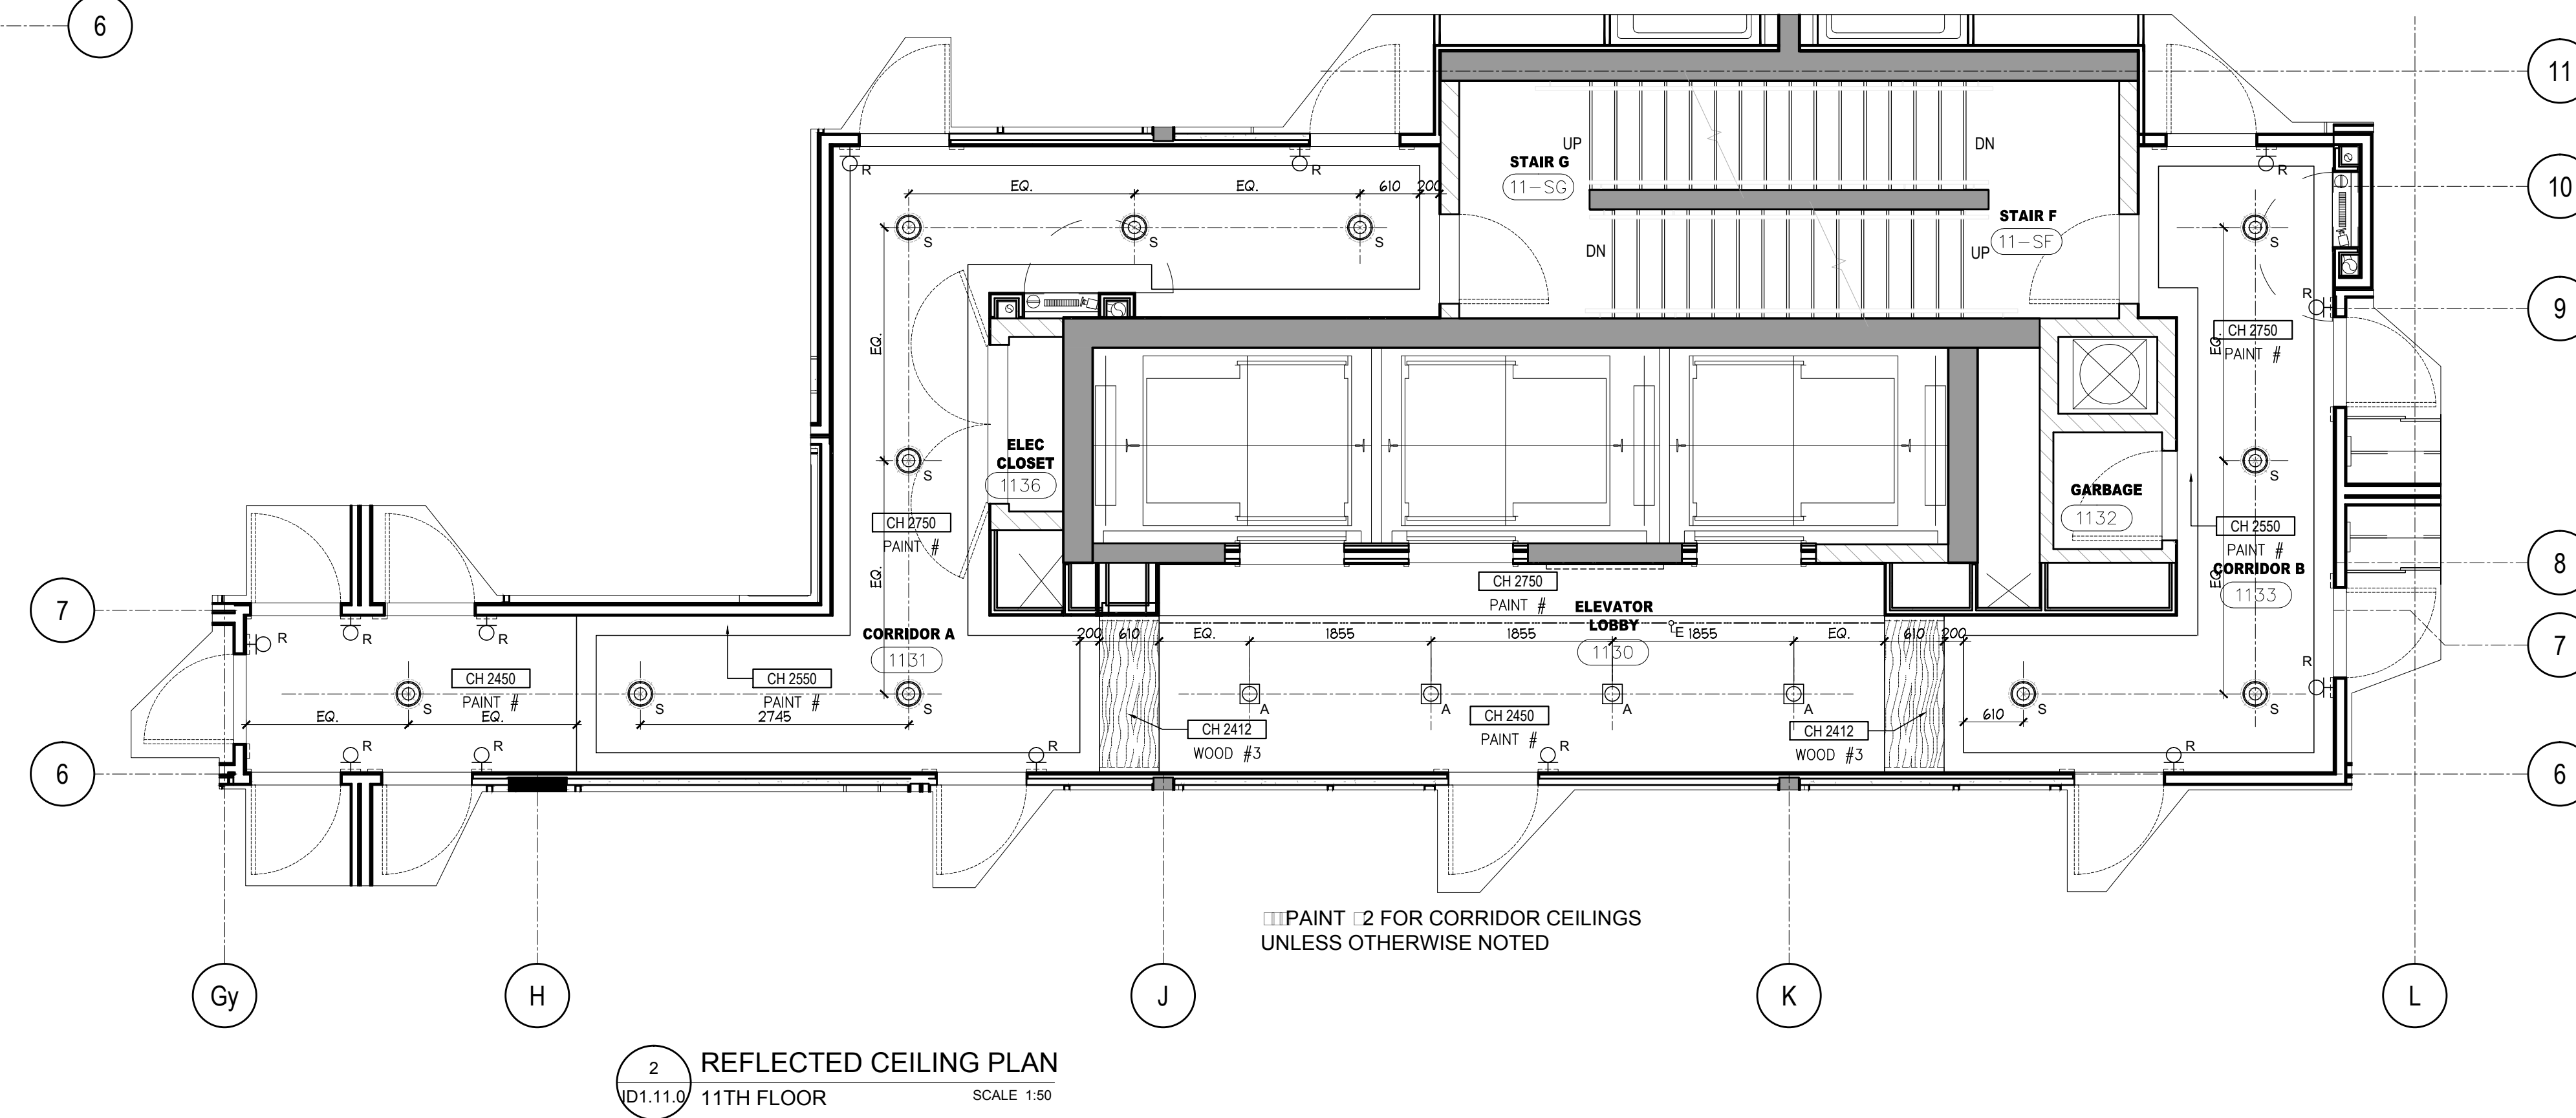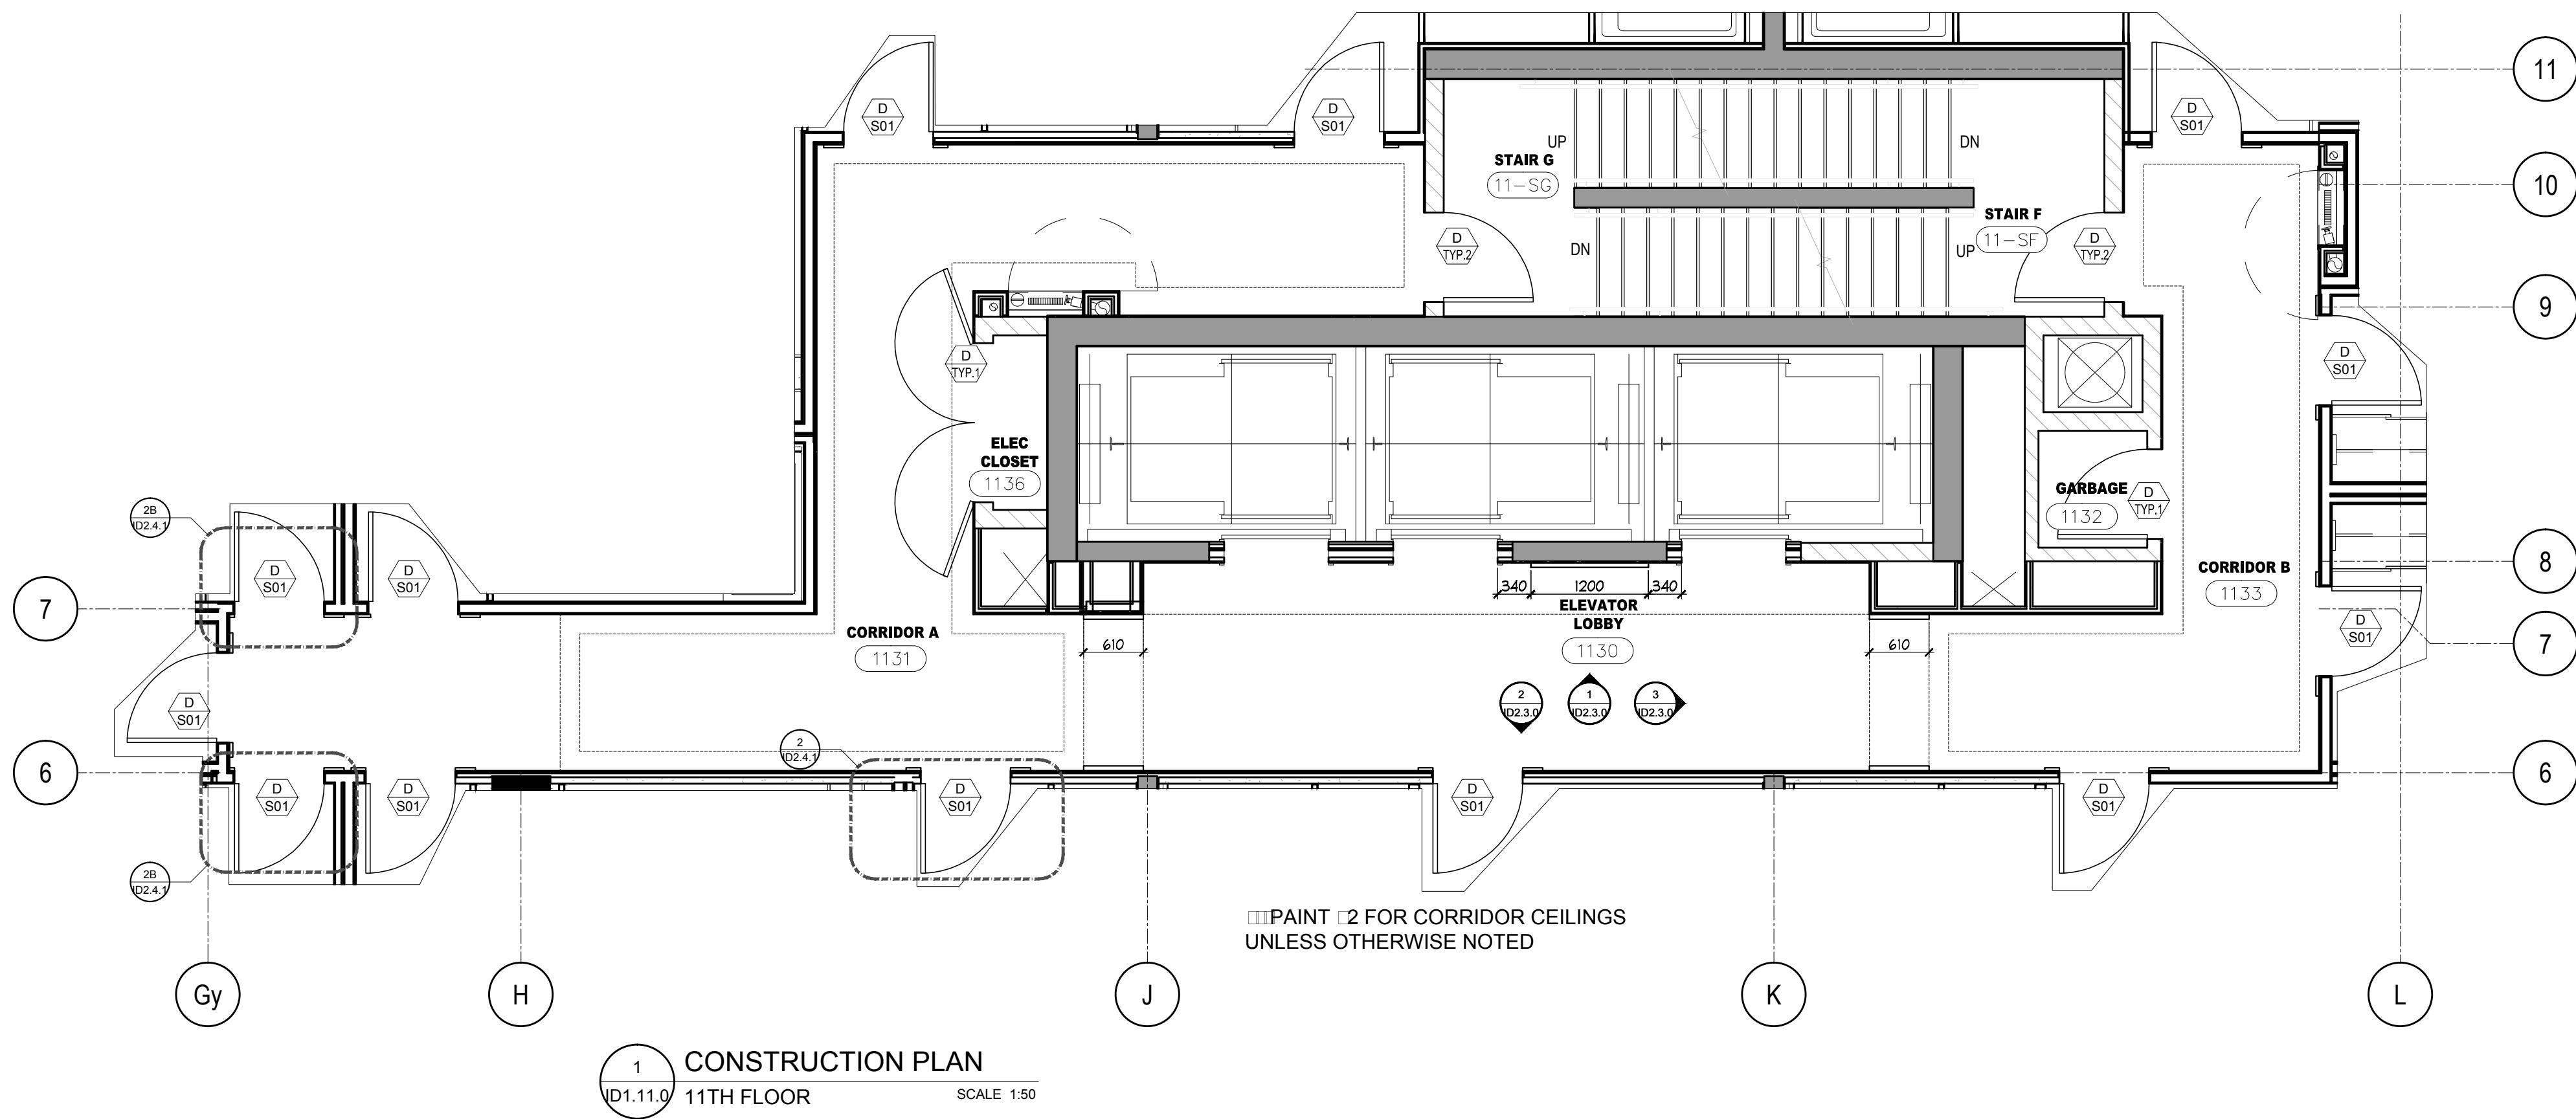

DO NOT SCALE DRAWINGS.

CONTRACTOR MUST VERIFY ALL DRAWINGS, DIMENSIONS, DETAILS AND SPECIFICATIONS, AND REPORT ANY DISCREPANCIES TO UNION 31 INC. BEFORE PROCEEDING WITH WORK. MATERIALS MAY NOT BE SUBSTITUTED WITHOUT WRITTEN APPROVAL FROM UNION 31 INC.

ALL DRAWINGS AND SPECIFICATIONS ARE INSTRUMENTS OF SERVICE AND THE PROPERTY OF UNION 31 INC. WHICH MUST BE RETURNED AT THE COMPLETION OF THE WORK.

PRINTED: 30-May-17

ISSUED FOR AS-BUILT

01	31 MAY / 17	ISSUED FOR AS-BUILT	SV
NO.	DATE	COMMENTS	INI
REVISIONS:			

UNION31 INC.
183 BATHURST STREET, STE. 201
TORONTO, ON, M5T 2R7, CANADA
TEL: 416-597-1576 FAX: 416-597-2139

PROJECT NAME:
**ALEXANDRA PARK
MAIN BUILDING**
BLOCK 11
ON, Canada

PROJECT NO.:
13-949

DRAWINGS:
11TH FLOOR
CONSTRUCTION PLAN &
REFLECTED CEILING PLAN &
FLOOR & WALL FINISHES PLANS

DATE STARTED: 07 AUG / 13
SCALE: 1 : 50
DRAWN BY: AP
APPROVED BY: KC

DRAWING NO.:
ID
1.11.0

DO NOT SCALE DRAWINGS.

CONTRACTOR MUST VERIFY ALL DRAWINGS, DIMENSIONS, DETAILS AND SPECIFICATIONS, AND REPORT ANY DISCREPANCIES TO UNION 31 INC. BEFORE PROCEEDING WITH WORK. MATERIALS MAY NOT BE SUBSTITUTED WITHOUT WRITTEN APPROVAL FROM UNION 31 INC.

ALL DRAWINGS AND SPECIFICATIONS ARE INSTRUMENTS OF SERVICE AND THE PROPERTY OF UNION 31 INC. WHICH MUST BE RETURNED AT THE COMPLETION OF THE WORK.

PRINTED: 30-May-17

ISSUED FOR
AS-BUILT





01	31 MAY / 17	ISSUED FOR AS-BUILT	SV
NO.	DATE	COMMENTS	INI
REVISIONS:			

UNION31

UNION31 INC.
183 BATHURST STREET, STE. 201
TORONTO, ON, M5T 2R7, CANADA
TEL: 416-597-1576 FAX: 416-597-2139

PROJECT NAME:		ALEXANDRA PARK MAIN BUILDING
PROJECT NO.:		13-949
DRAWINGS:		12TH FLOOR CONSTRUCTION PLAN & REFLECTED CEILING PLAN & FLOOR & WALL FINISHES PLANS

DATE STARTED:	07 AUG / 13	DRAWING NO.:	ID
SCALE:	1" = 50'	DRAWN BY:	AP
APPROVED BY:	KC	1.12.0	

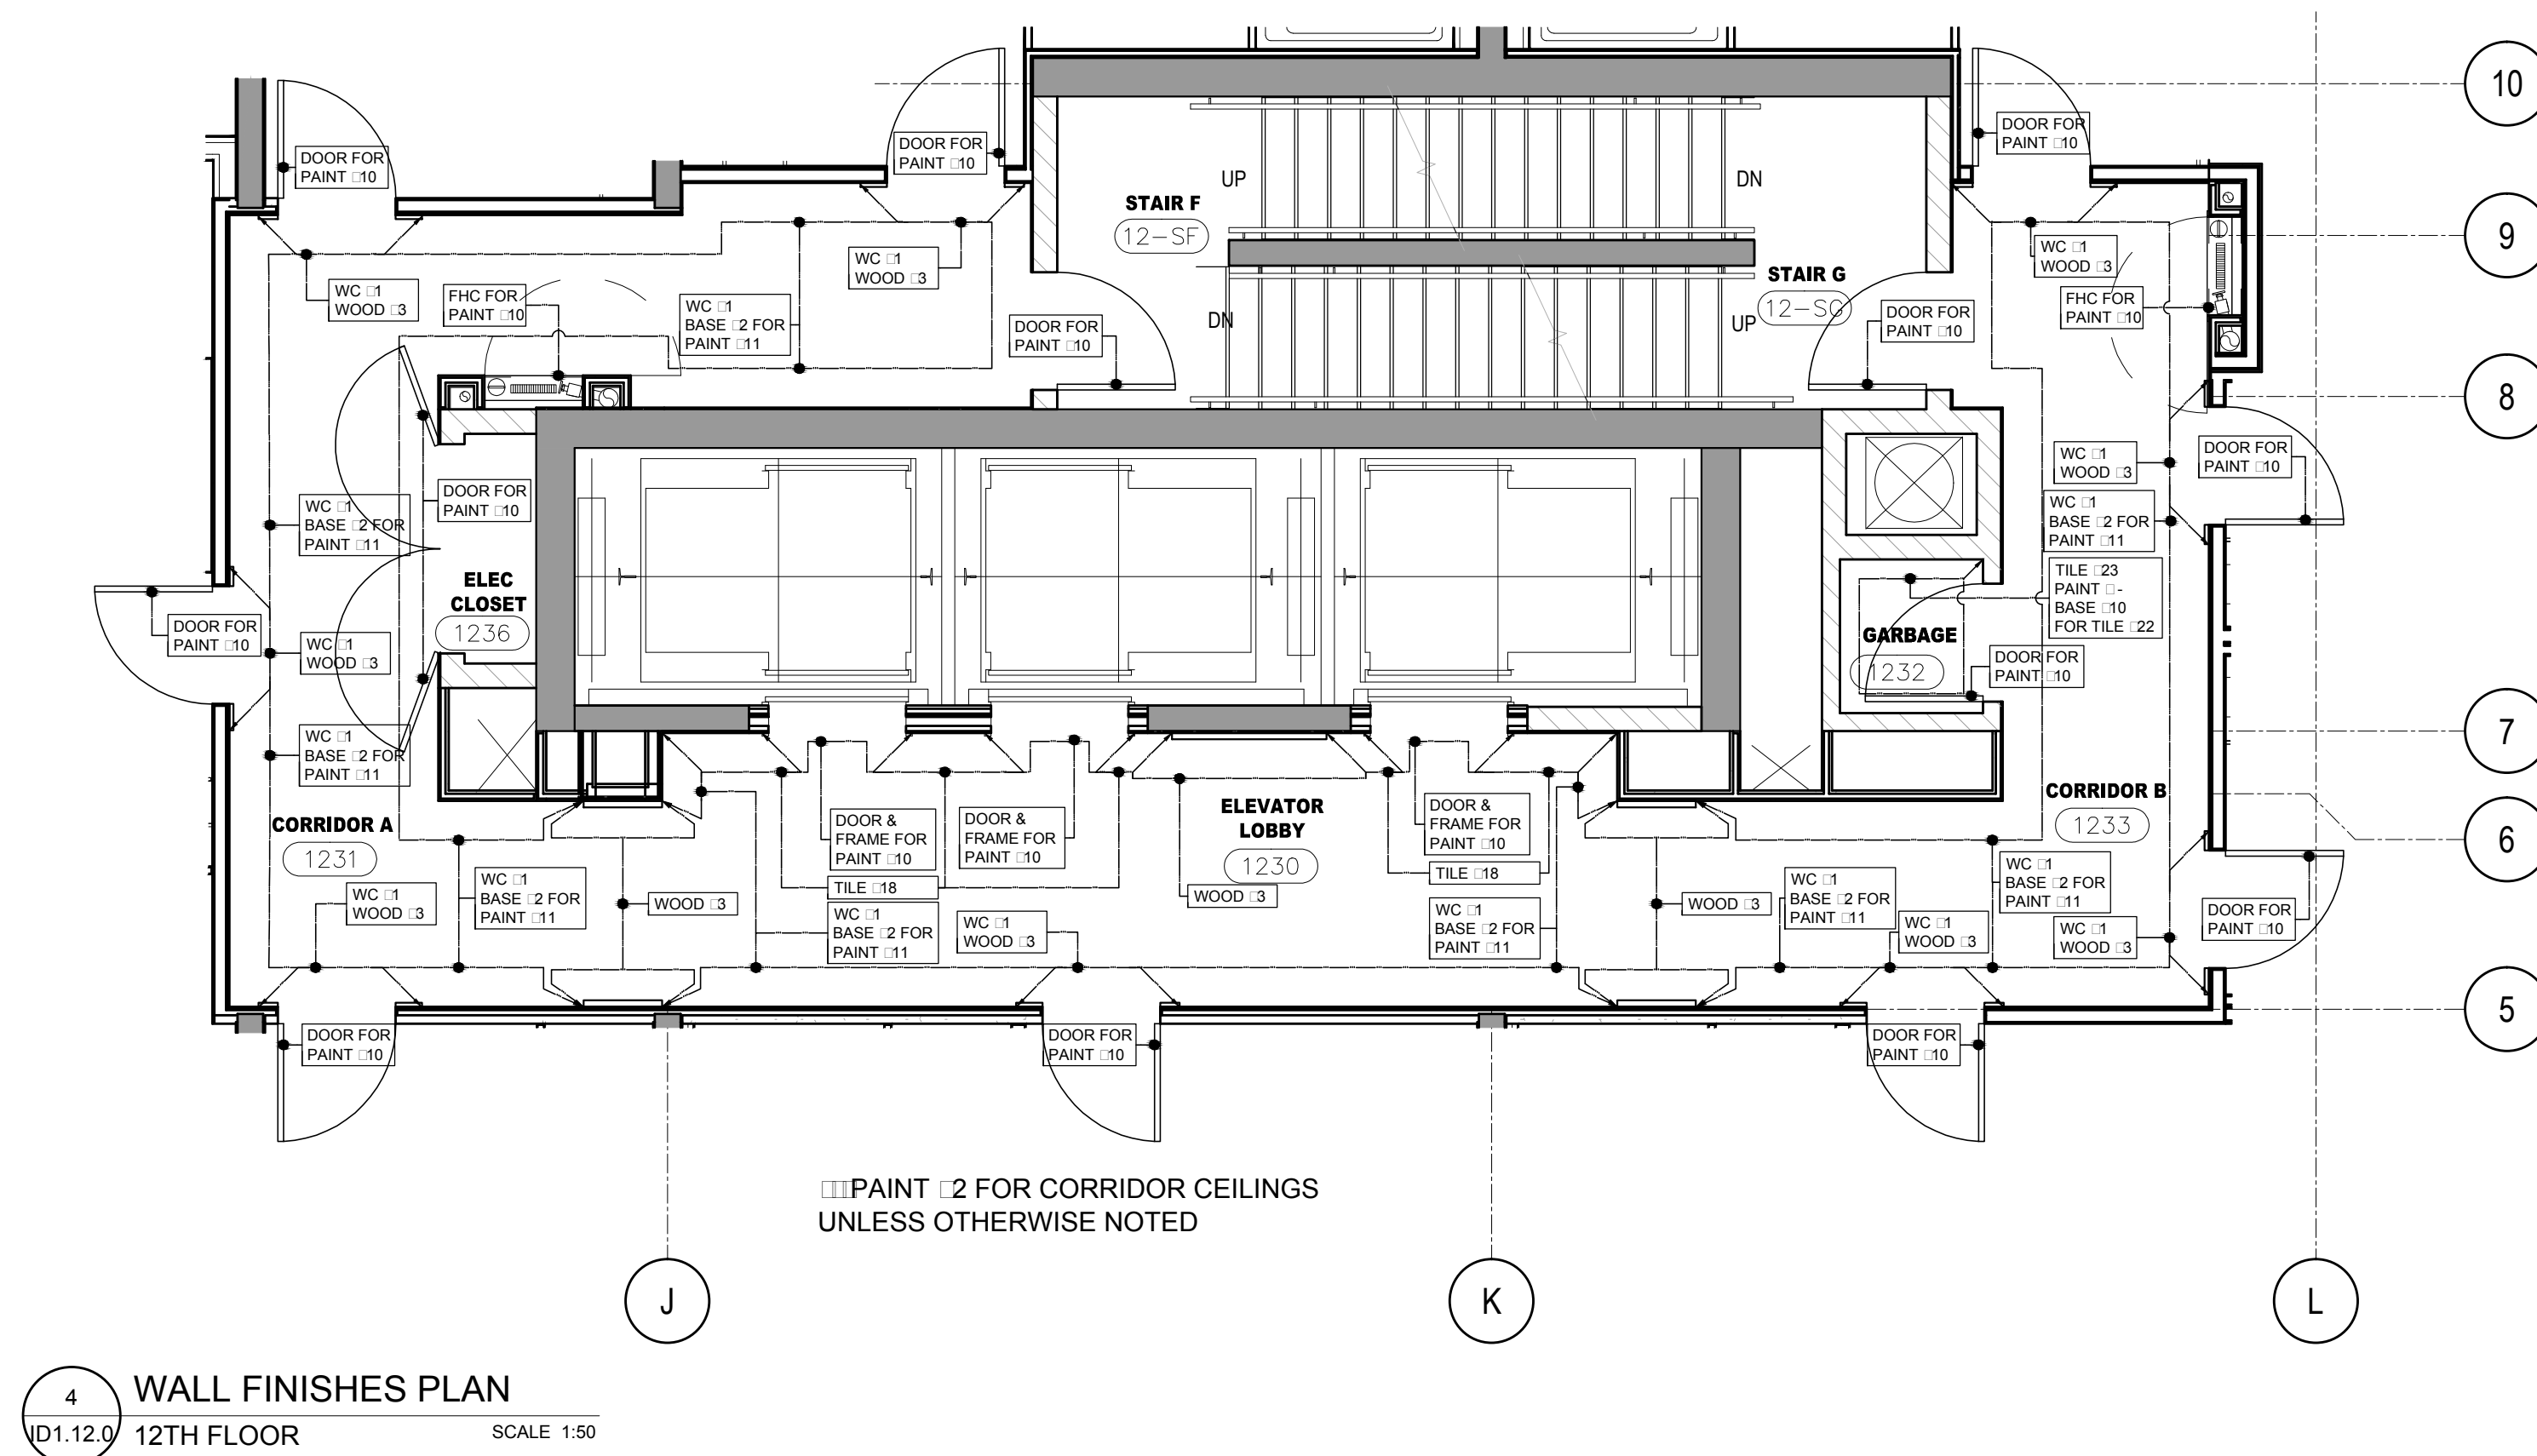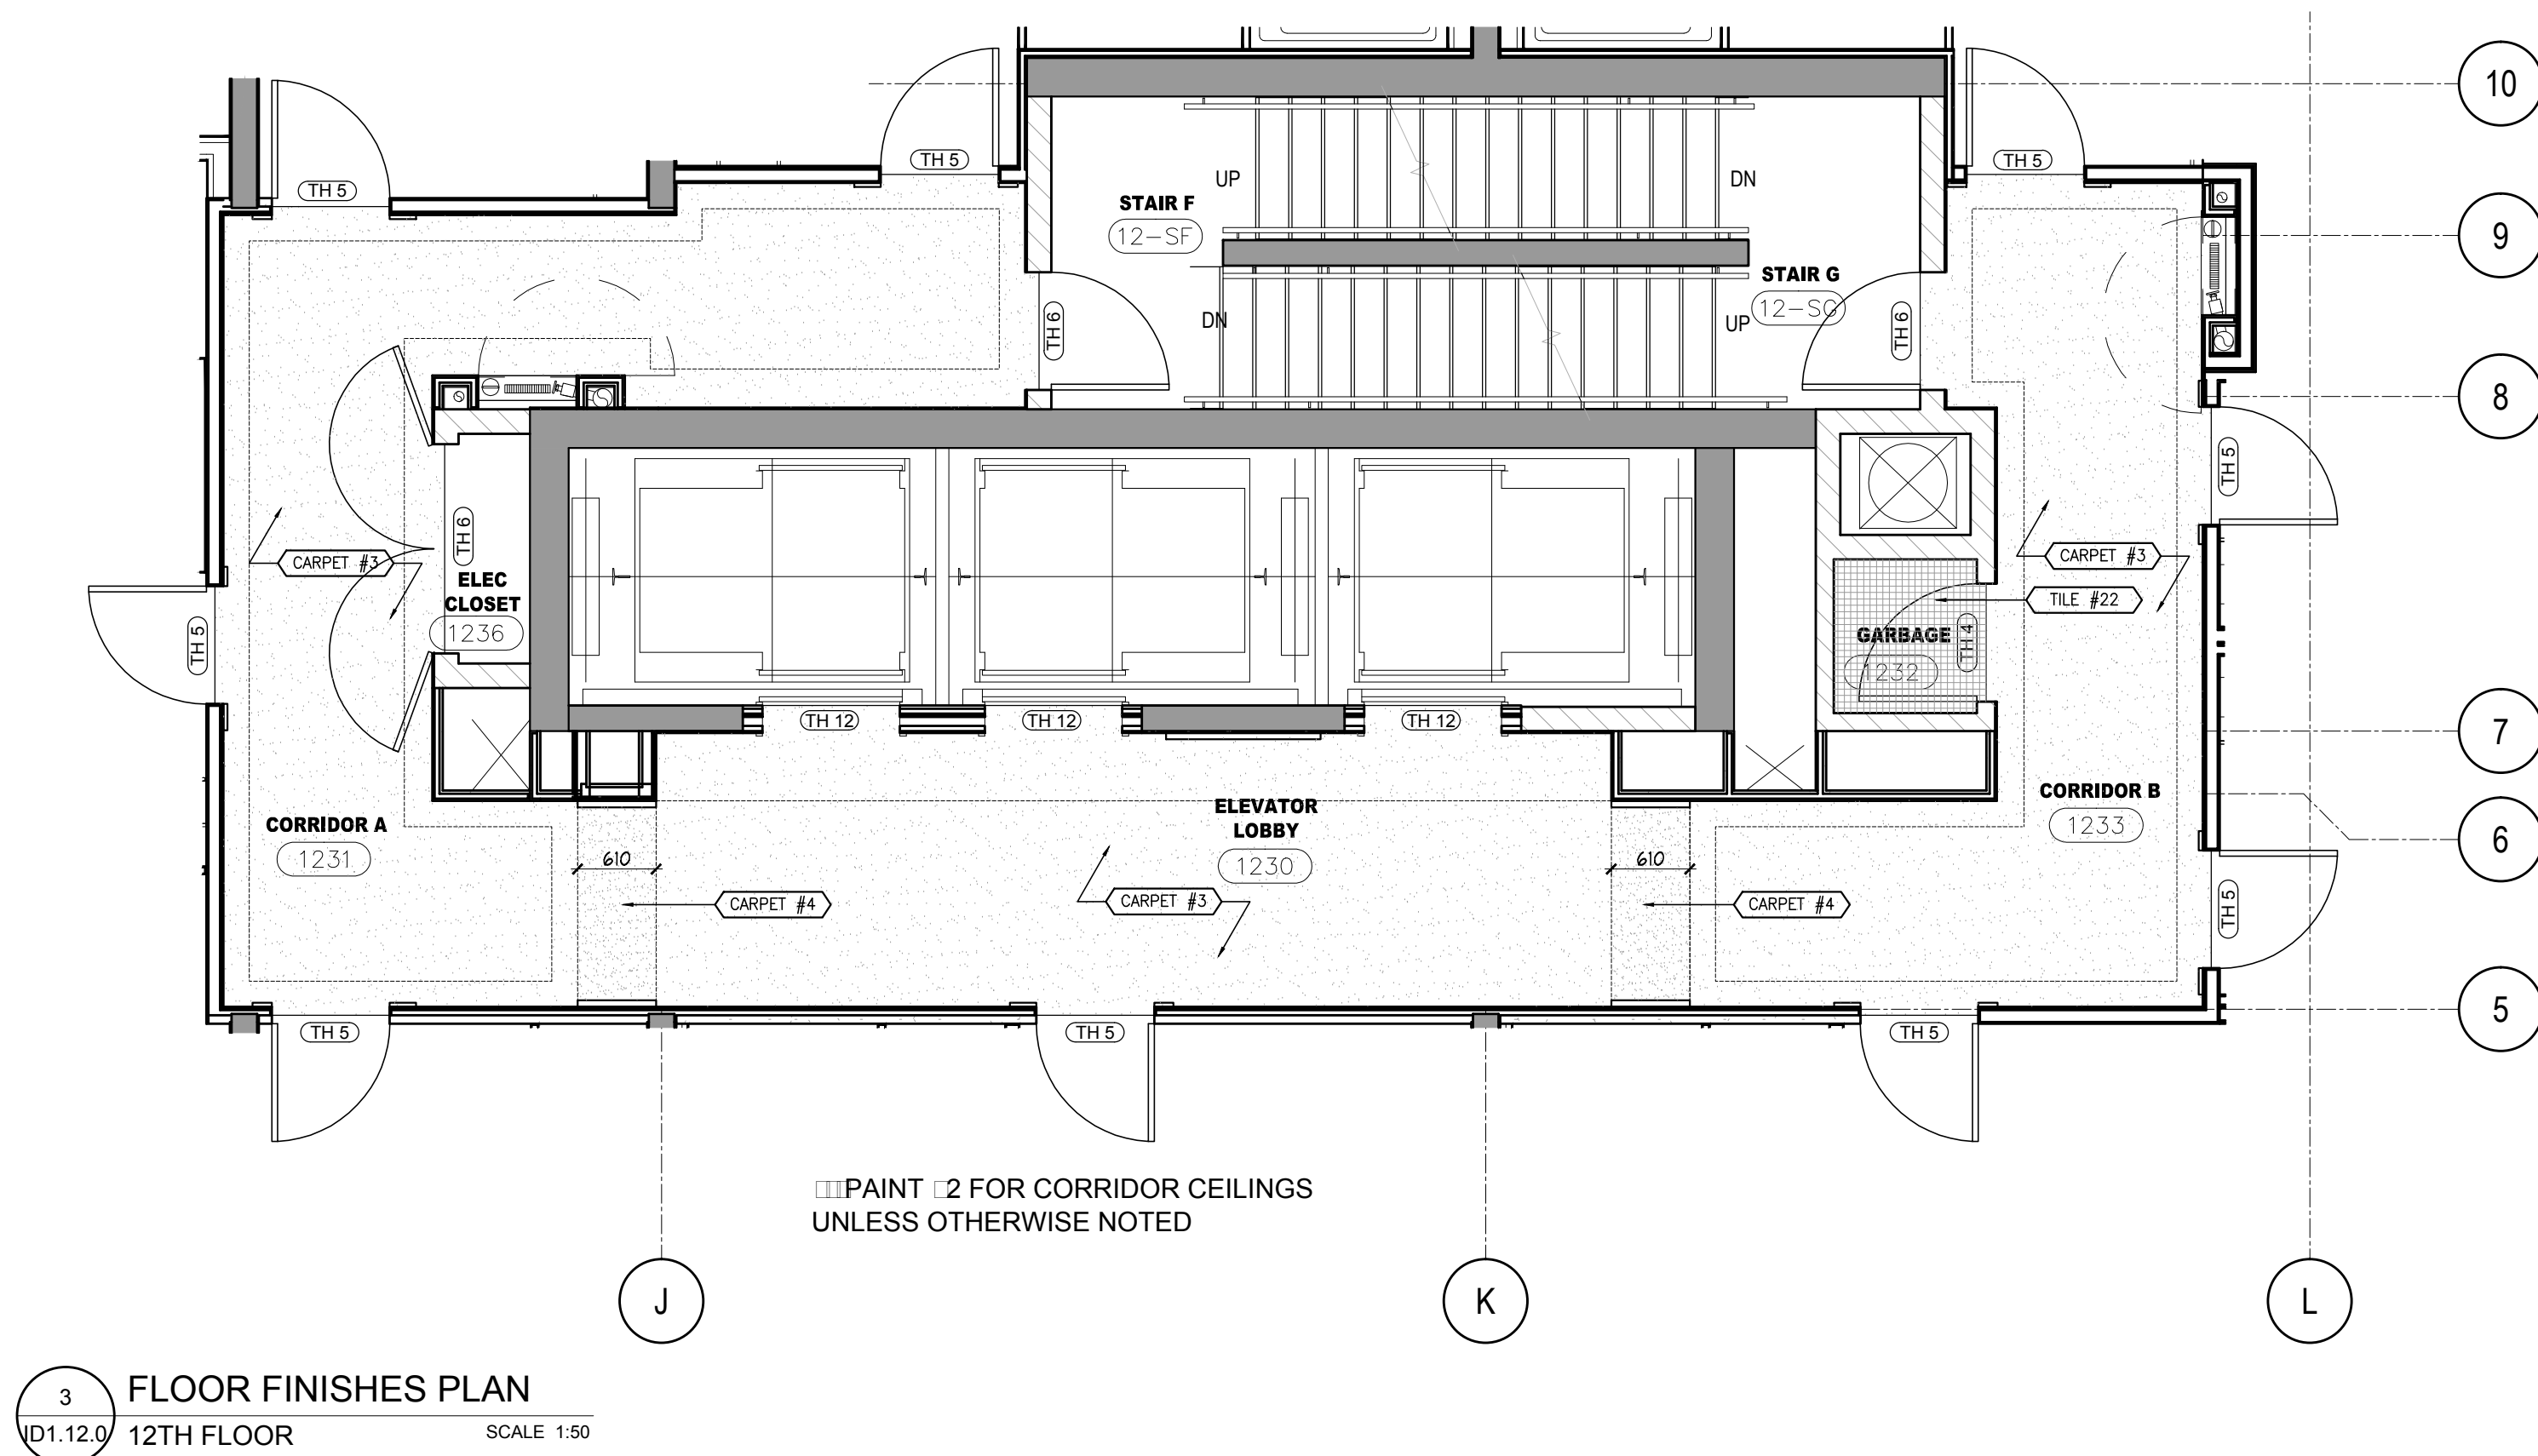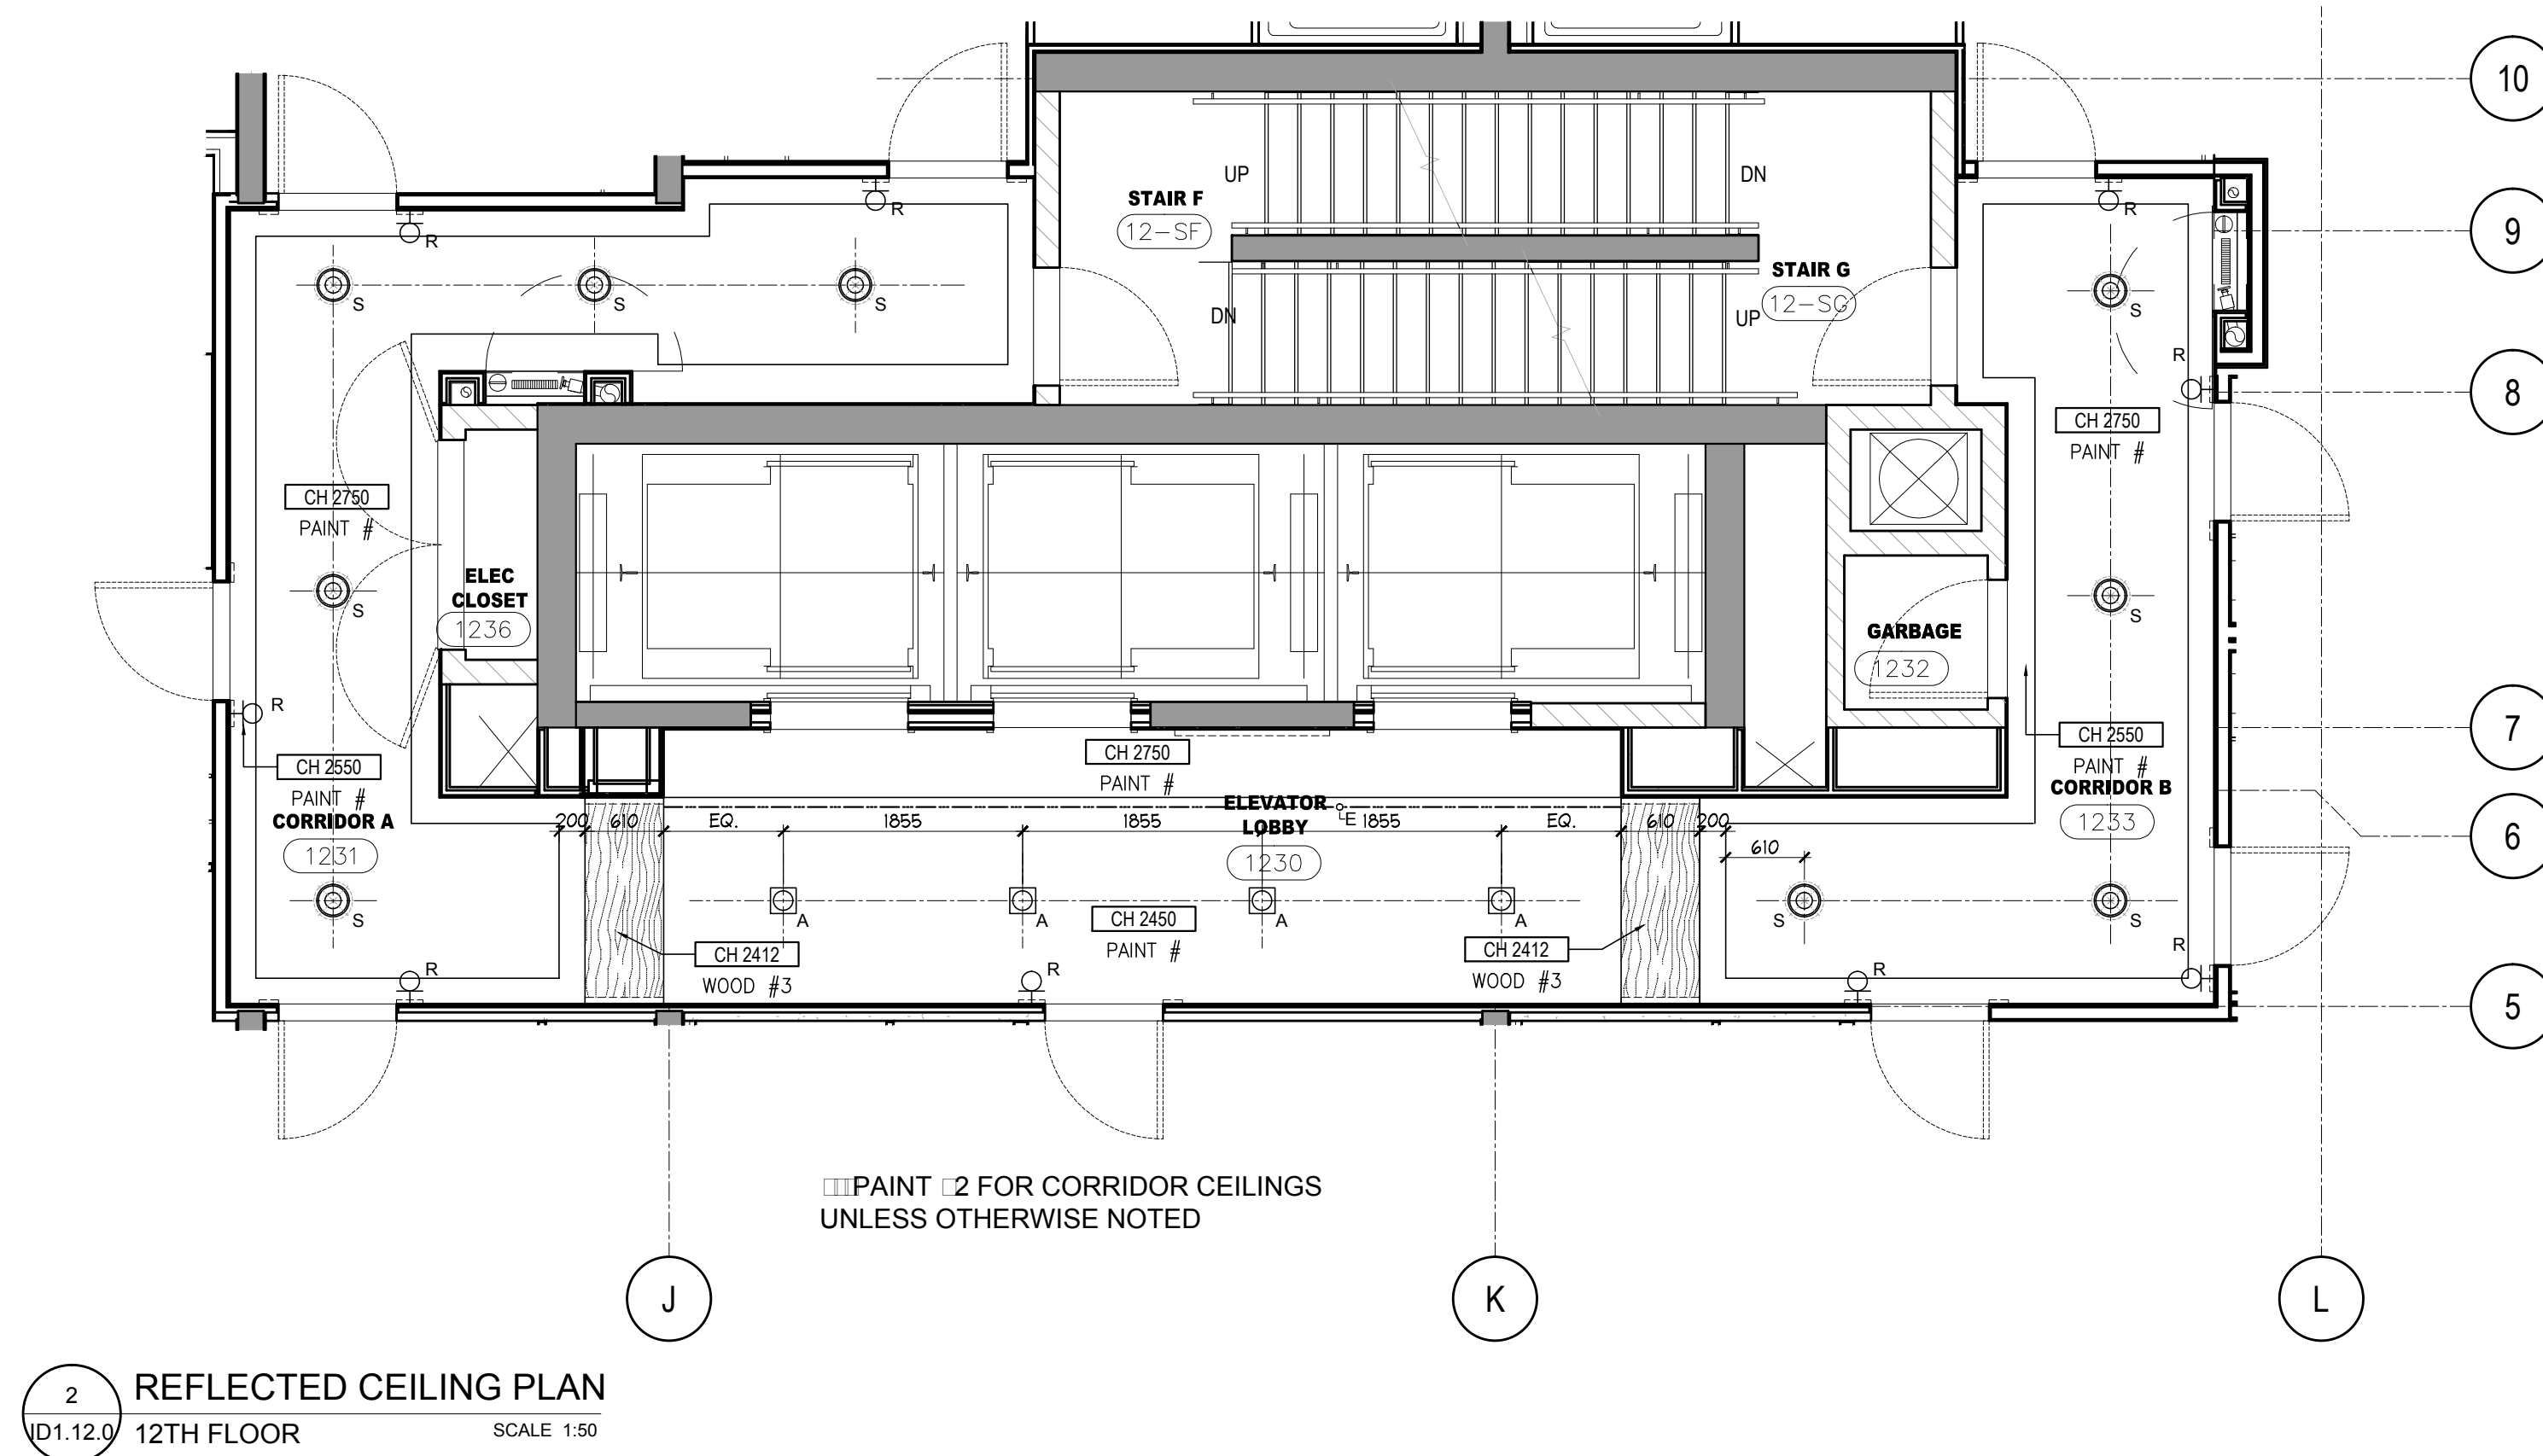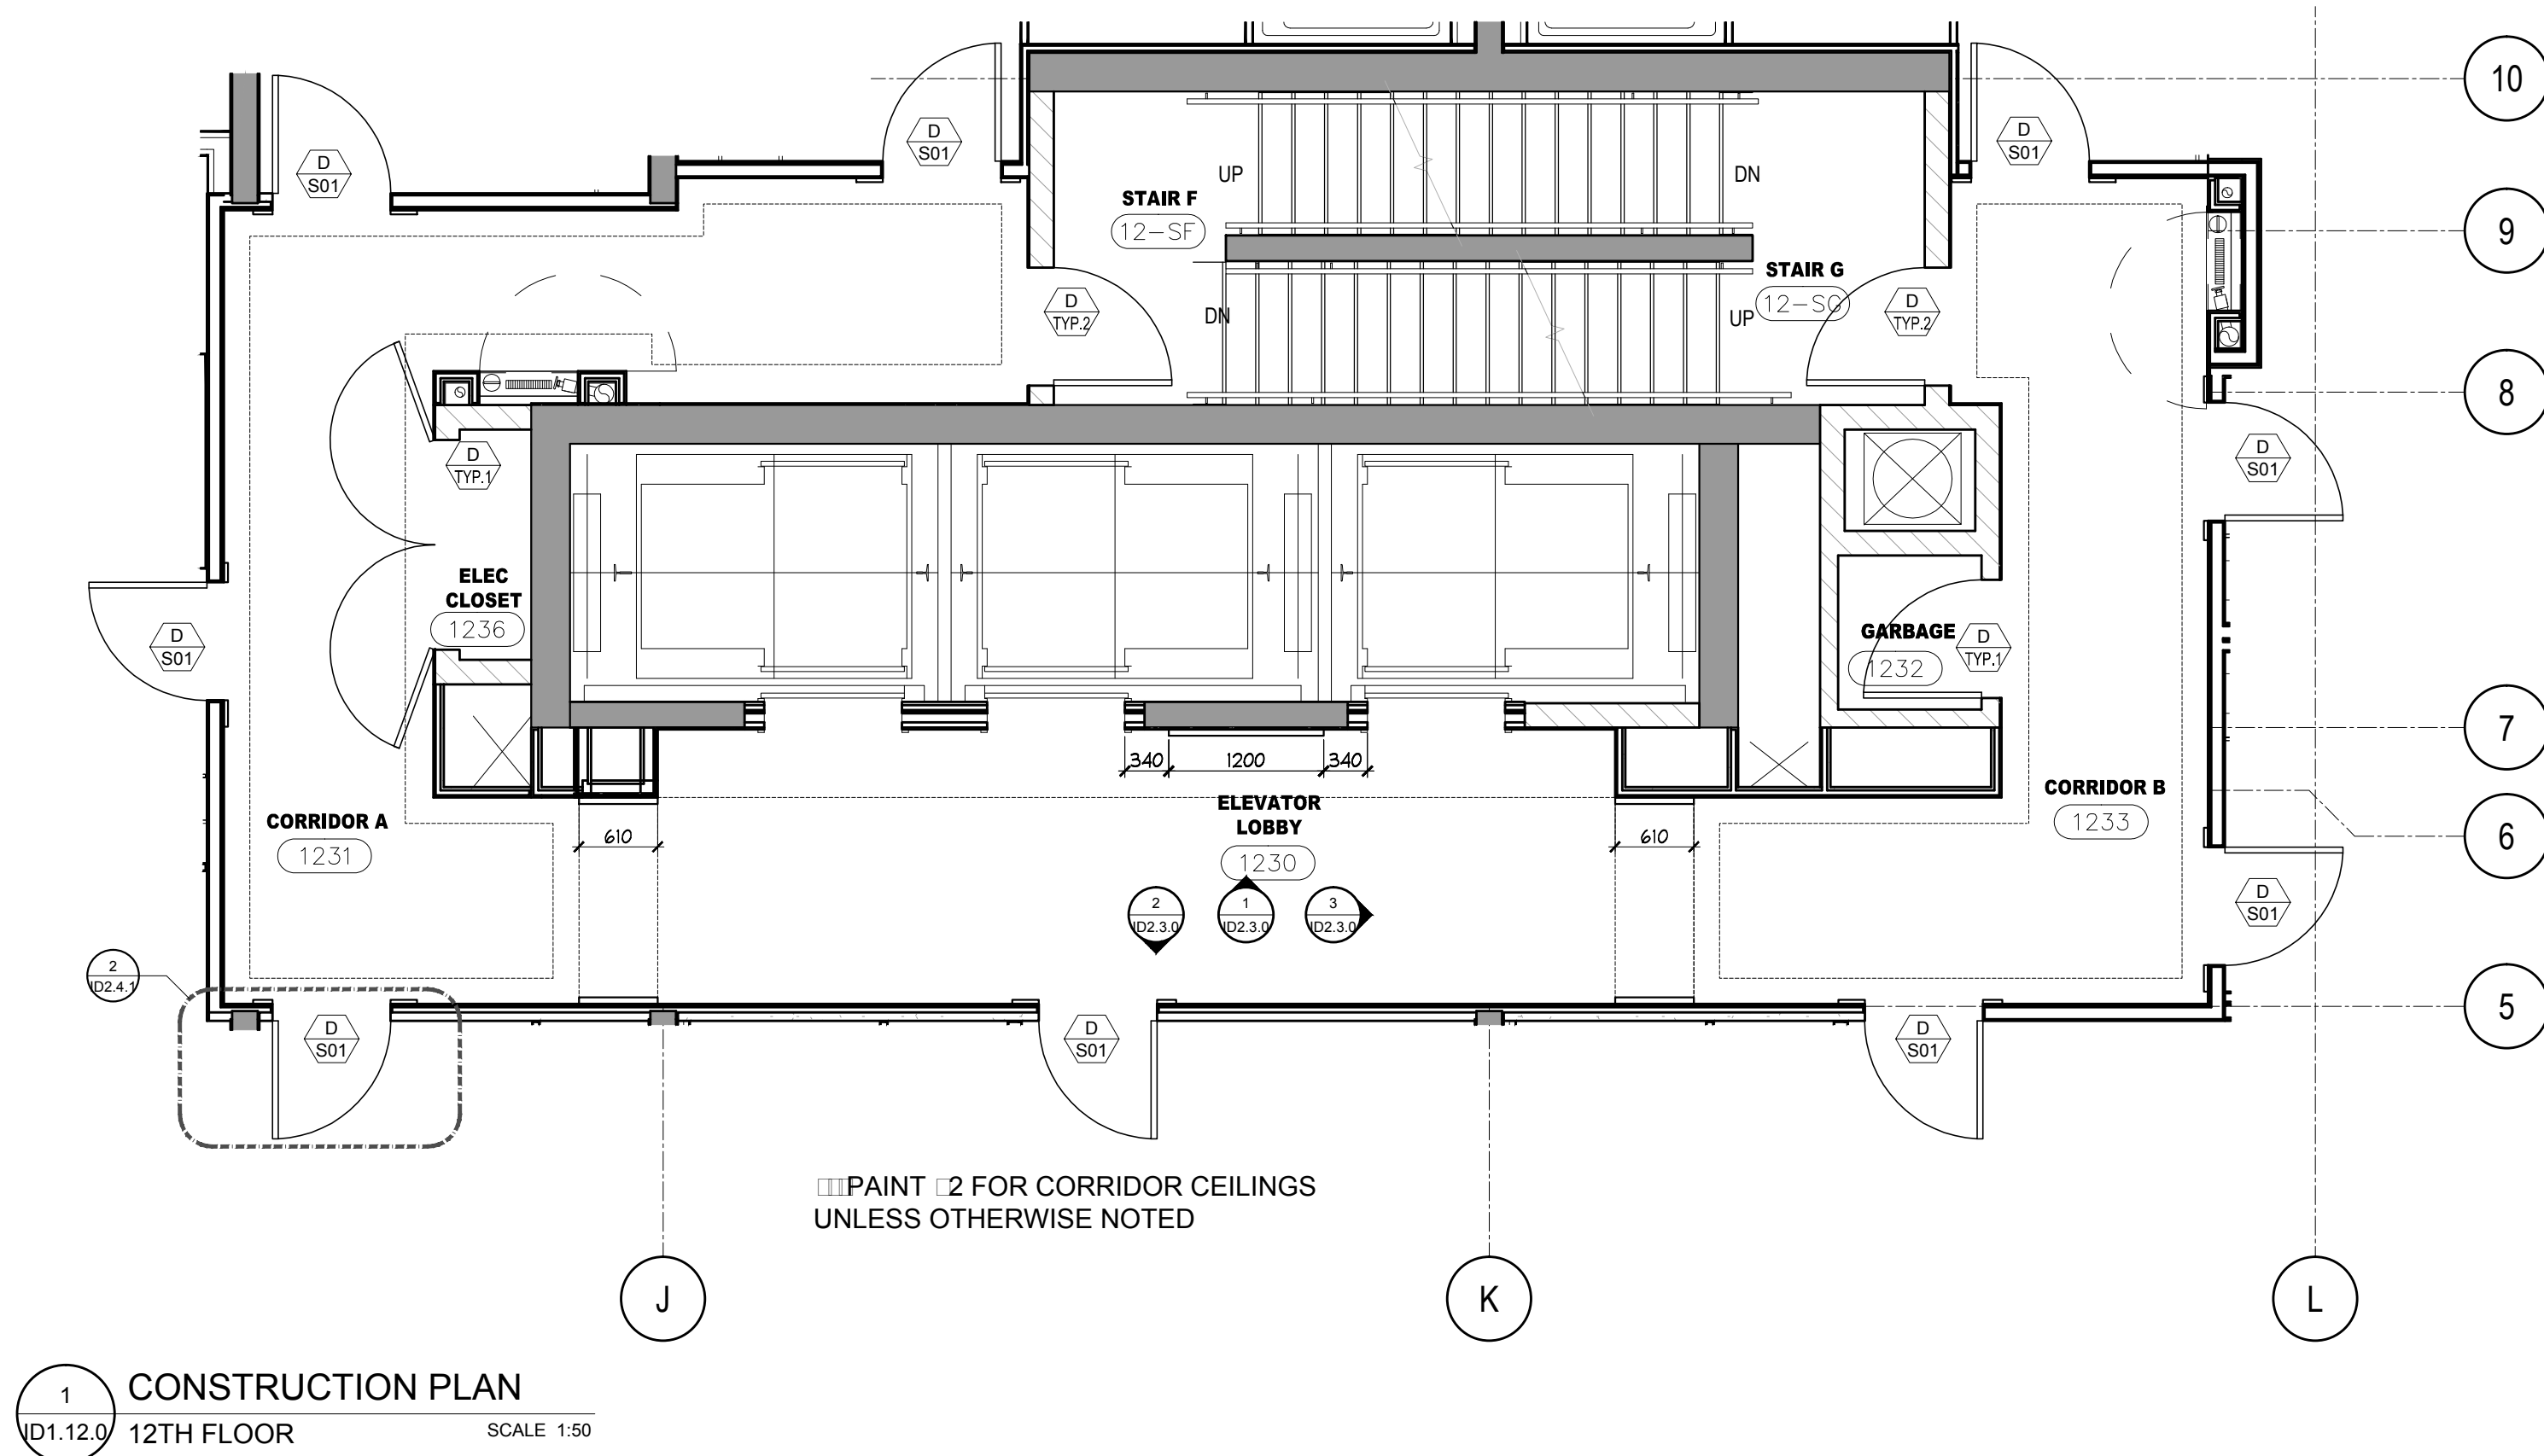

DO NOT SCALE DRAWINGS.

CONTRACTOR MUST VERIFY ALL DRAWINGS, DIMENSIONS, DETAILS AND SPECIFICATIONS AND REPORT ANY DISCREPANCIES TO UNION 31 INC. BEFORE PROCEEDING WITH WORK. MATERIALS MAY NOT BE SUBSTITUTED WITHOUT WRITTEN APPROVAL FROM UNION 31 INC.

ALL DRAWINGS AND SPECIFICATIONS ARE INSTRUMENTS OF SERVICE AND THE PROPERTY OF UNION 31 INC. WHICH MUST BE RETURNED AT THE COMPLETION OF THE WORK.

PRINTED: 30-May-17


ISSUED FOR
AS-BUILT

01	31 MAY / 17	ISSUED FOR AS-BUILT	SV
NO.	DATE	COMMENTS	INI
REVISIONS:			


UNION31

UNION31 INC.
183 BATHURST STREET, STE. 201
TORONTO, ON, M5T 2R7, CANADA
TEL: 416-597-1576 FAX: 416-597-2139


PROJECT NAME:		ALEXANDRA PARK MAIN BUILDING	
		BLOCK 11 ON, Canada	
PROJECT NO.:		13-949	
DRAWINGS:		13TH FLOOR CONSTRUCTION PLAN & REFLECTED CEILING PLAN & FLOOR & WALL FINISHES PLANS	
DATE STARTED: 07 AUG / 13		DRAWING NO.:	
SCALE: 1" = 50'		ID	
DRAWN BY: AP		1.13.0	
APPROVED BY: KC			

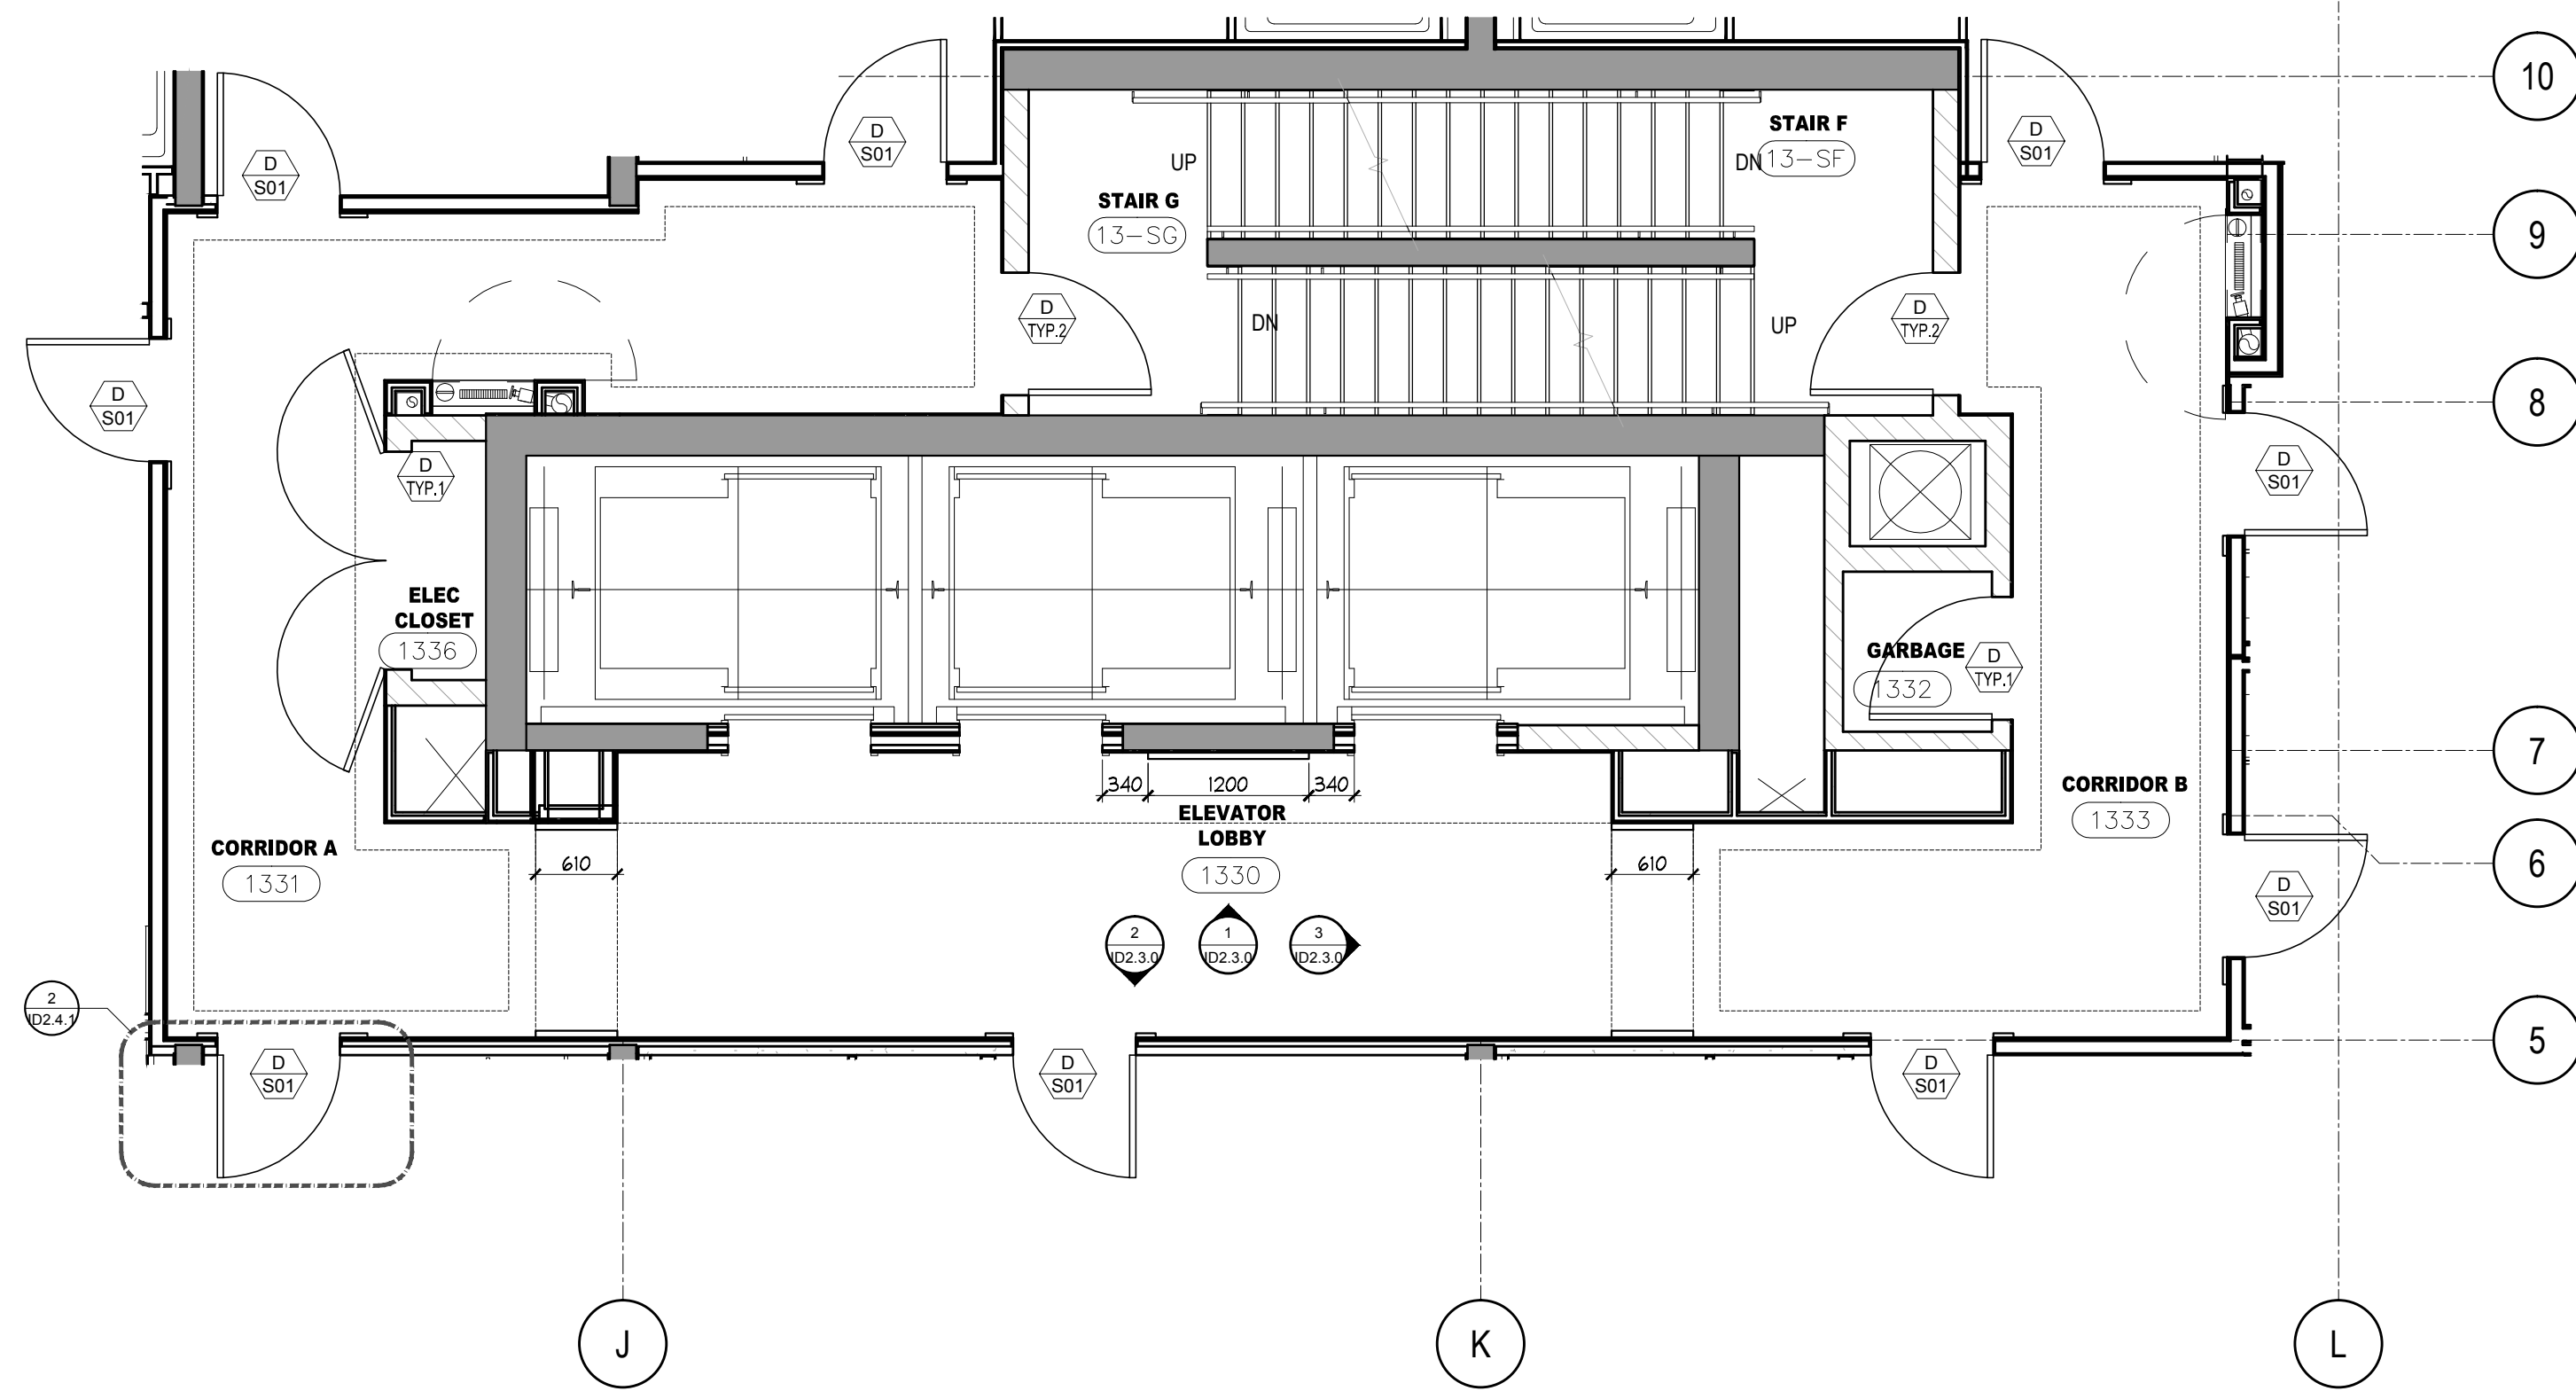


1 CONSTRUCTION PLAN
13TH FLOOR SCALE: 1/50

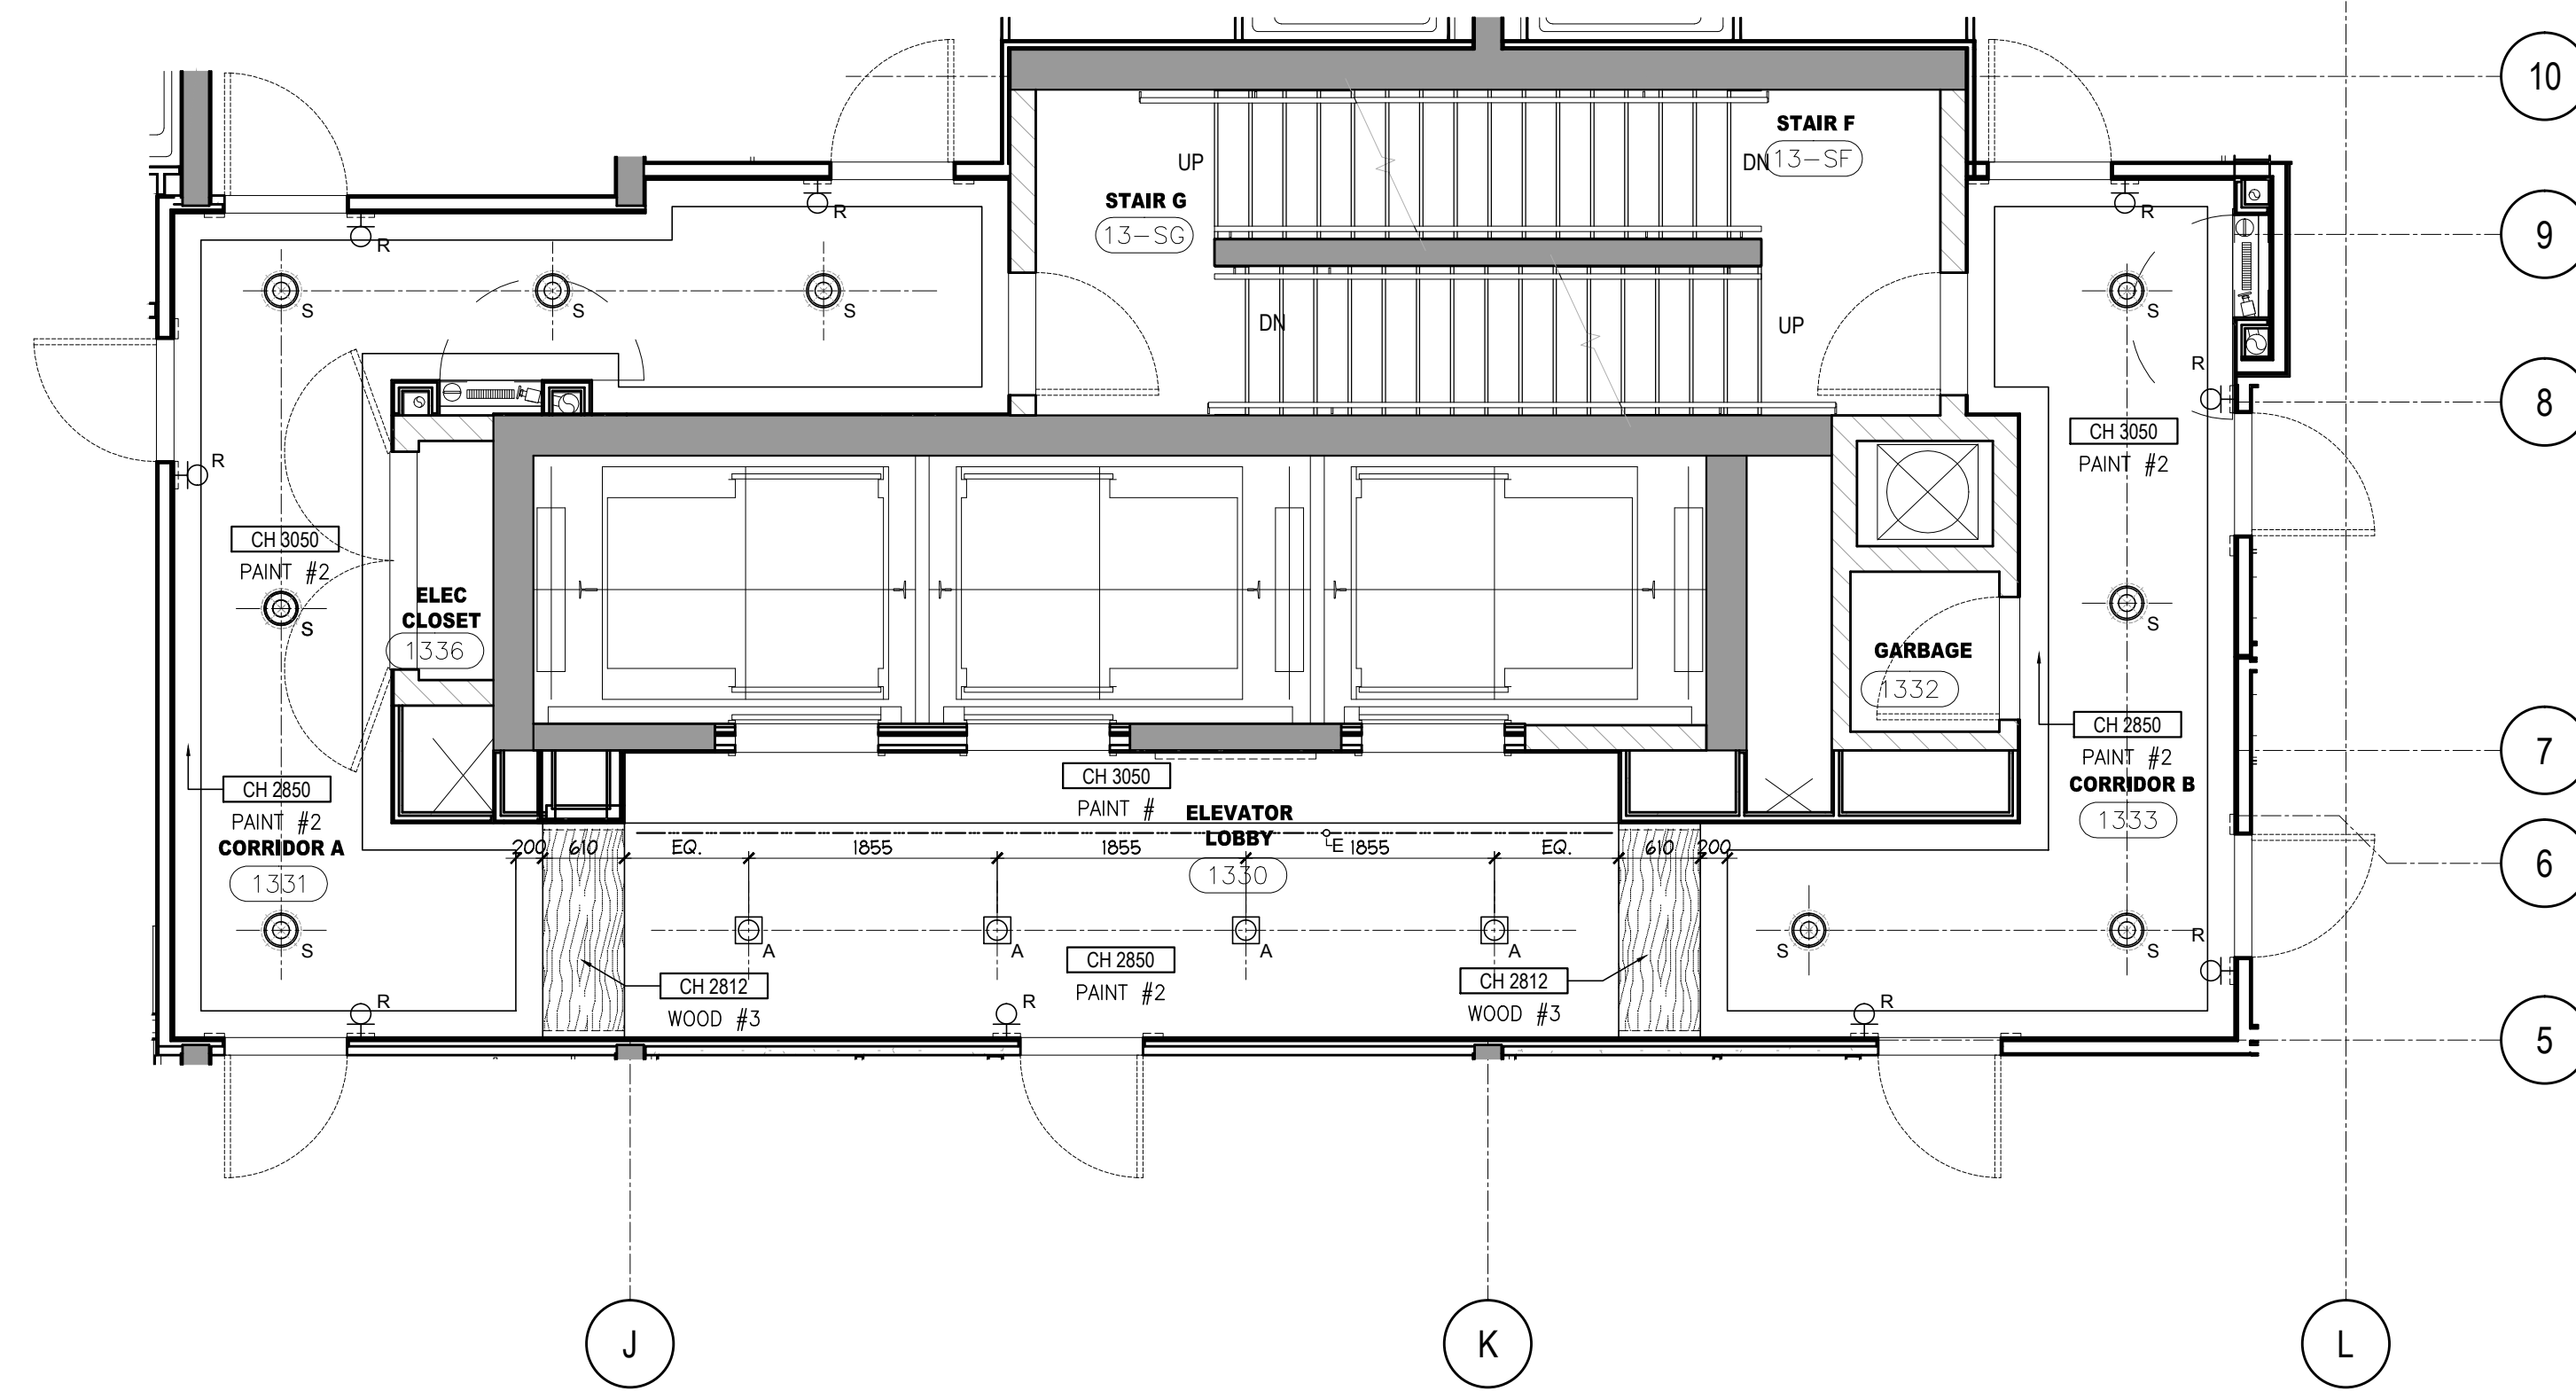

2 REFLECTED CEILING PLAN
13TH FLOOR SCALE: 1/50

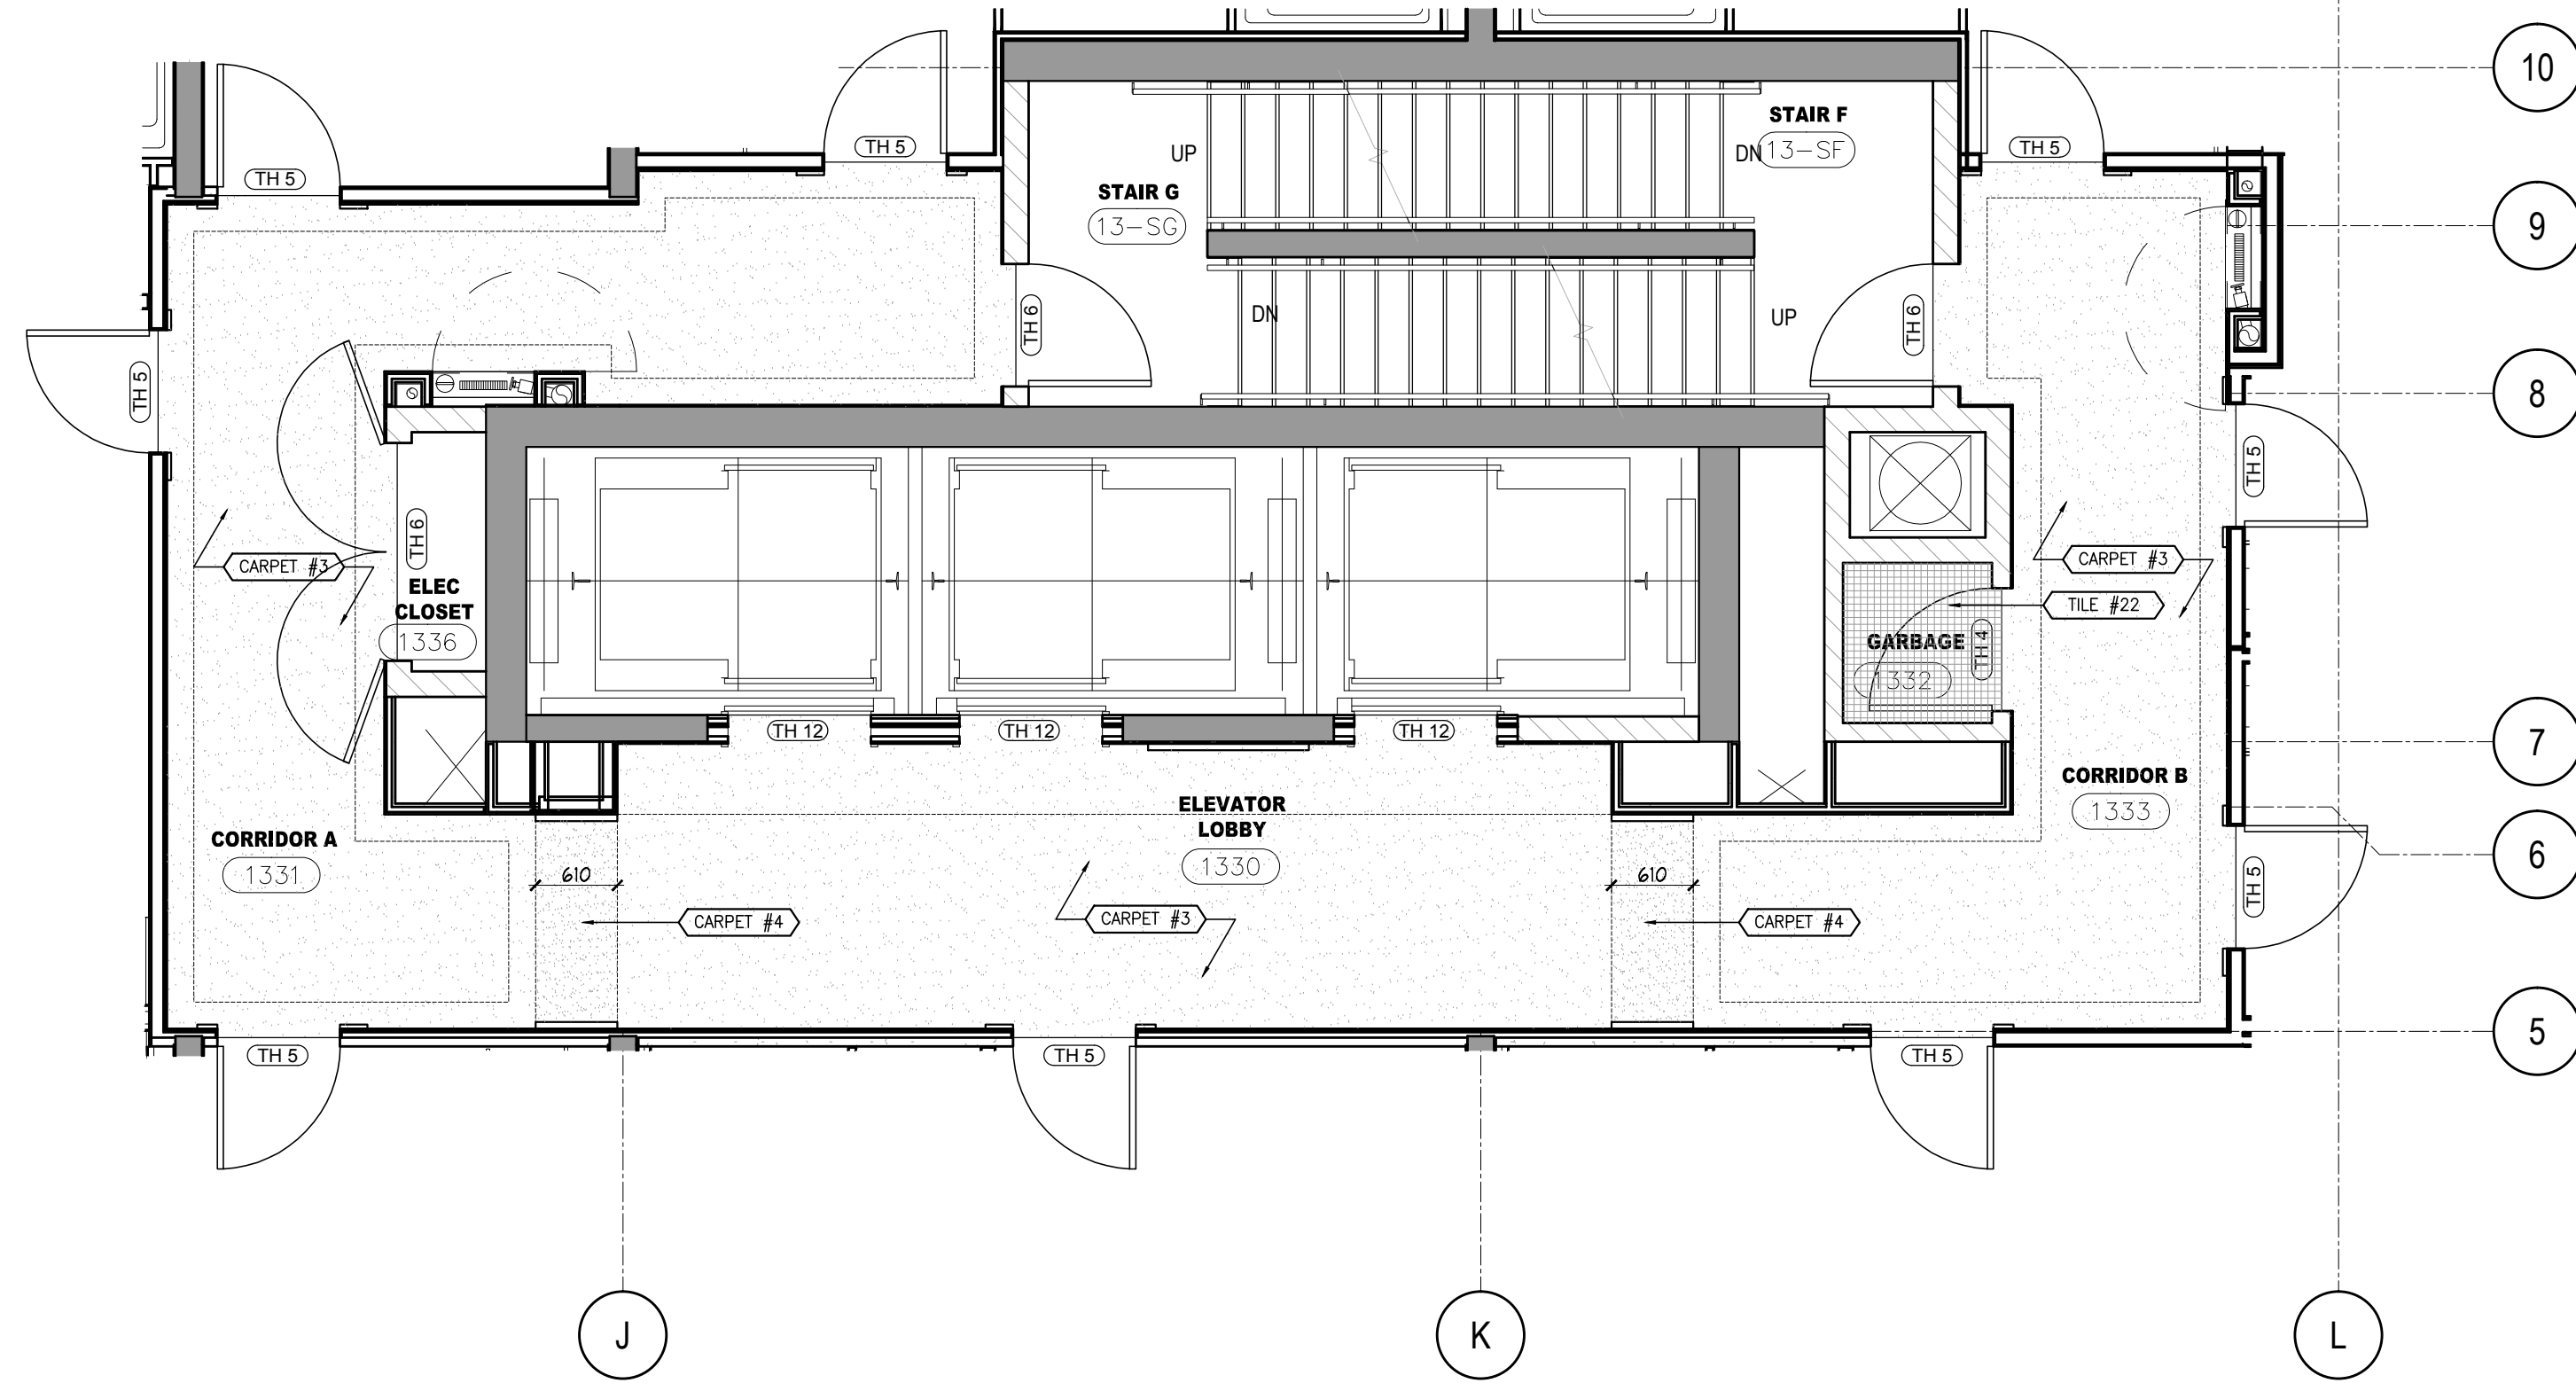

3 FLOOR FINISHES PLAN
13TH FLOOR SCALE: 1/50

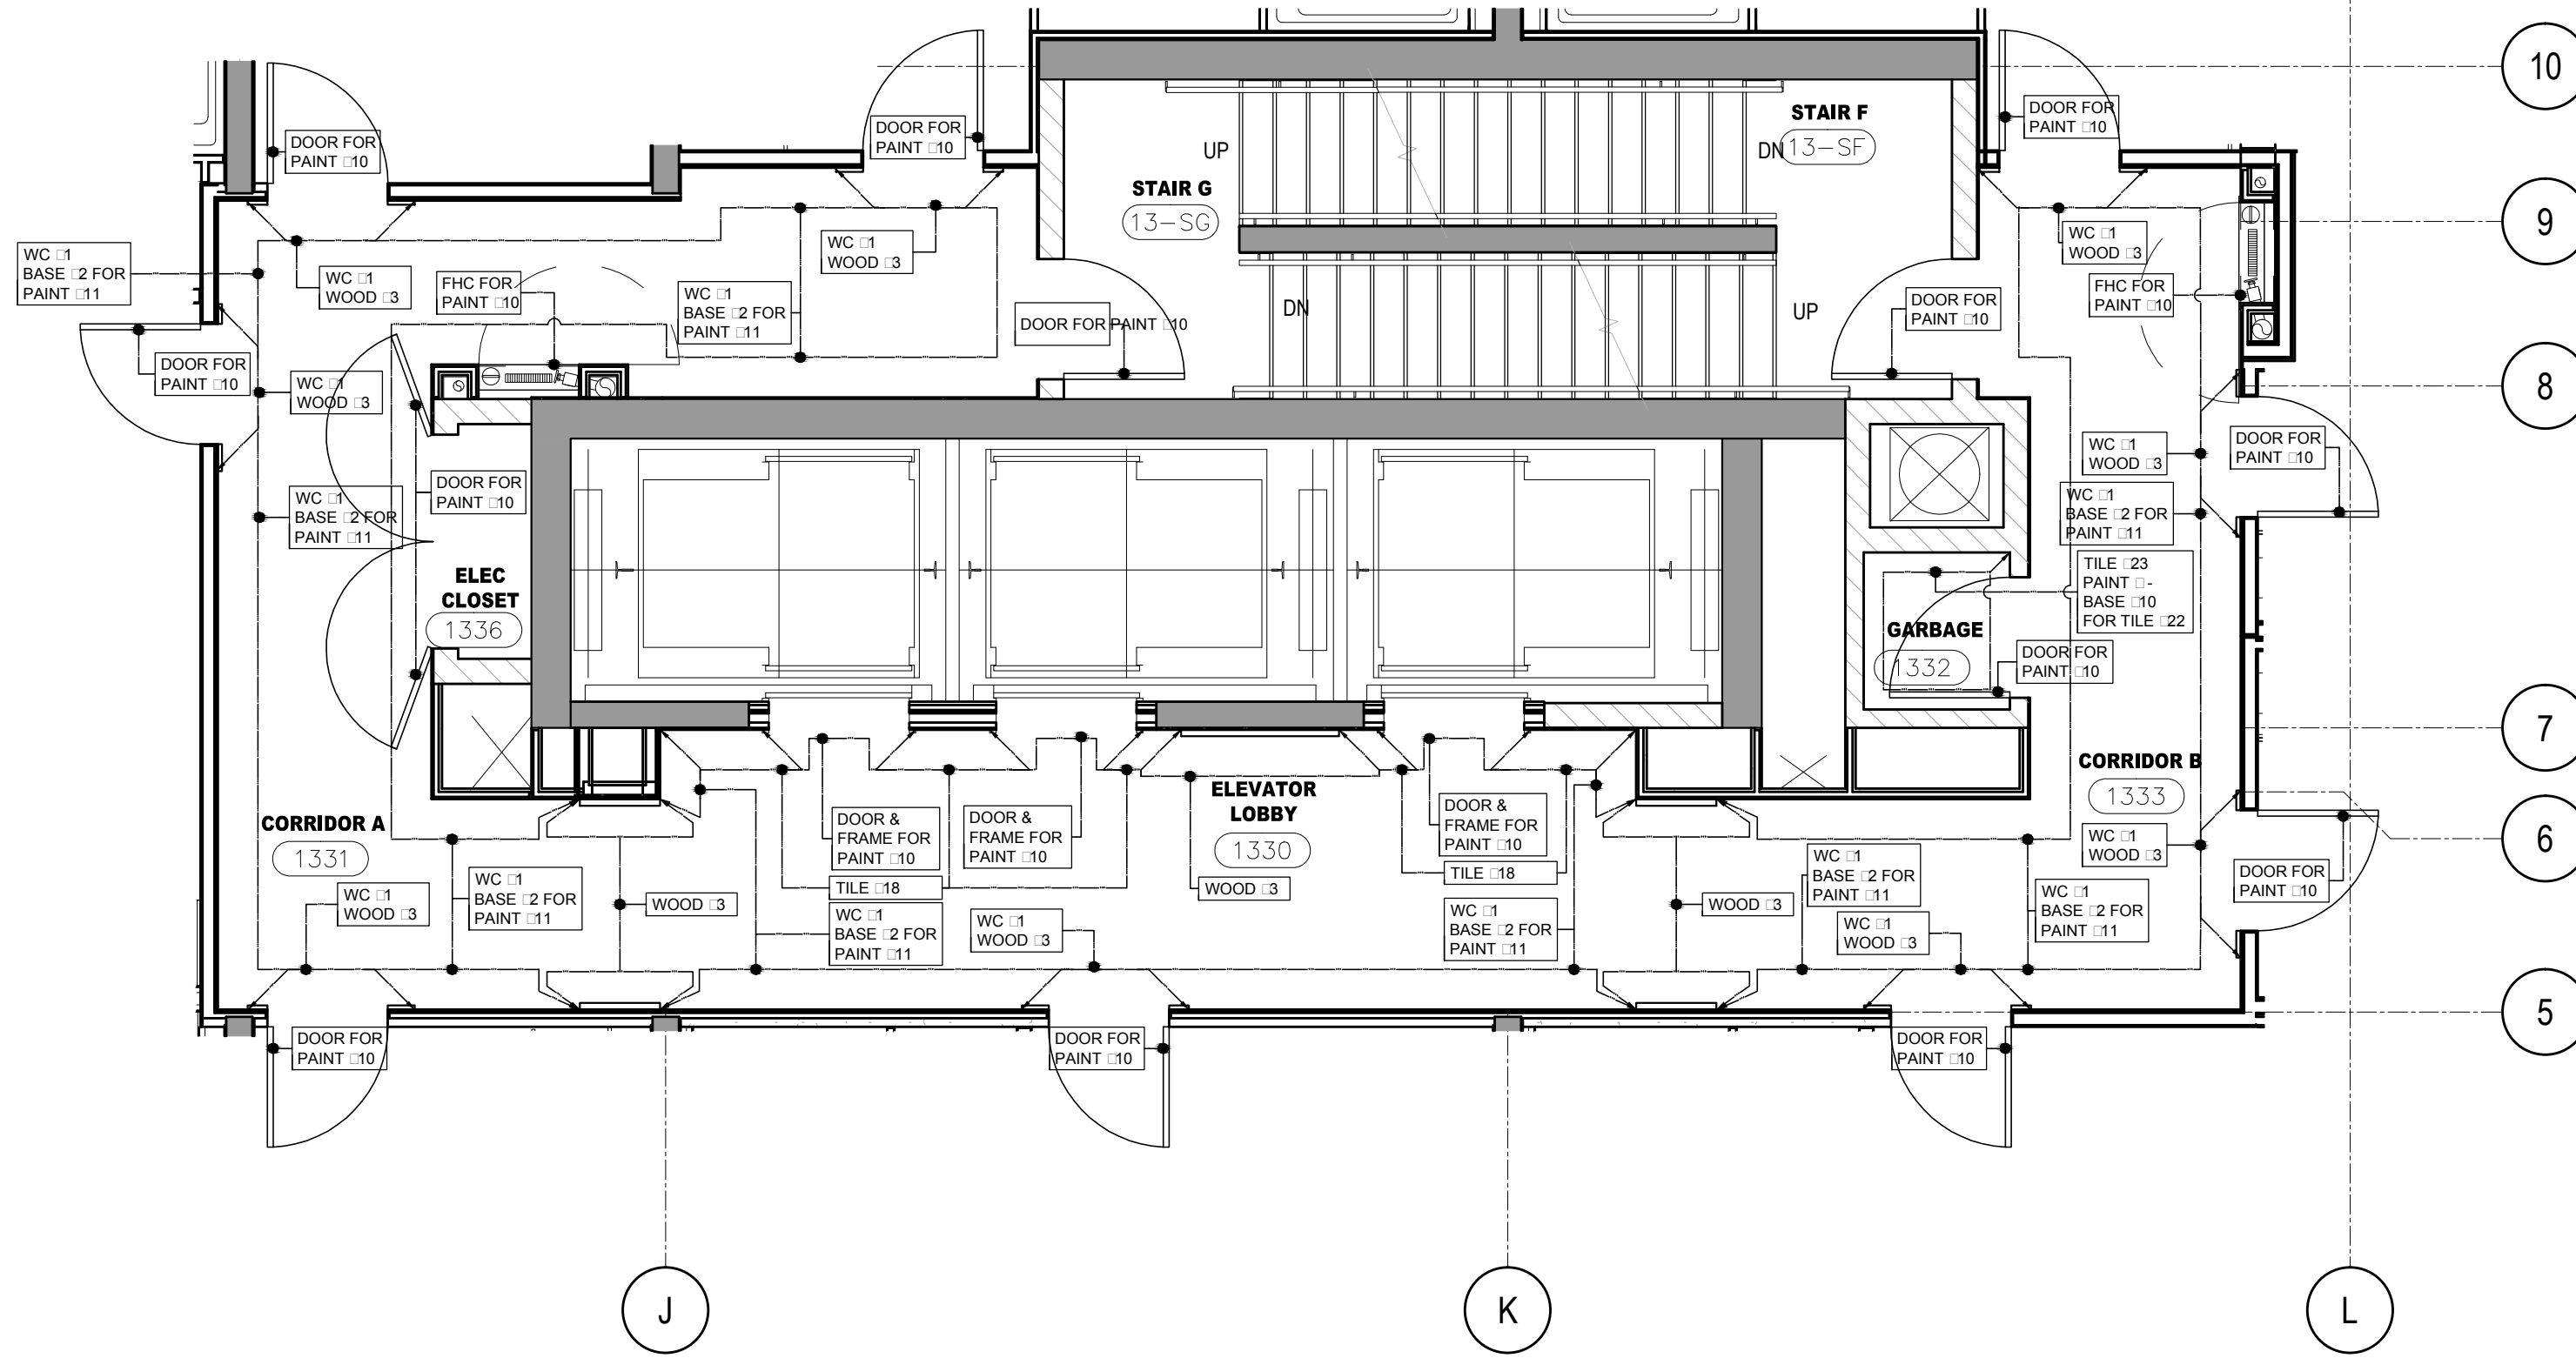

4 WALL FINISHES PLAN
13TH FLOOR SCALE: 1/50





DO NOT SCALE DRAWINGS.

CONTRACTOR MUST VERIFY ALL DRAWINGS, DIMENSIONS, DETAILS AND SPECIFICATIONS. AND REPORT ANY DISCREPANCIES TO UNION 31 INC. BEFORE PROCEEDING WITH WORK. MATERIALS MAY NOT BE SUBSTITUTED WITHOUT WRITTEN APPROVAL FROM UNION 31 INC.

ALL DRAWINGS AND SPECIFICATIONS ARE INSTRUMENTS OF SERVICE AND THE PROPERTY OF UNION 31 INC. WHICH MUST BE RETURNED AT THE COMPLETION OF THE WORK.

PRINTED: 30-May-17

ISSUED FOR
AS-BUILT

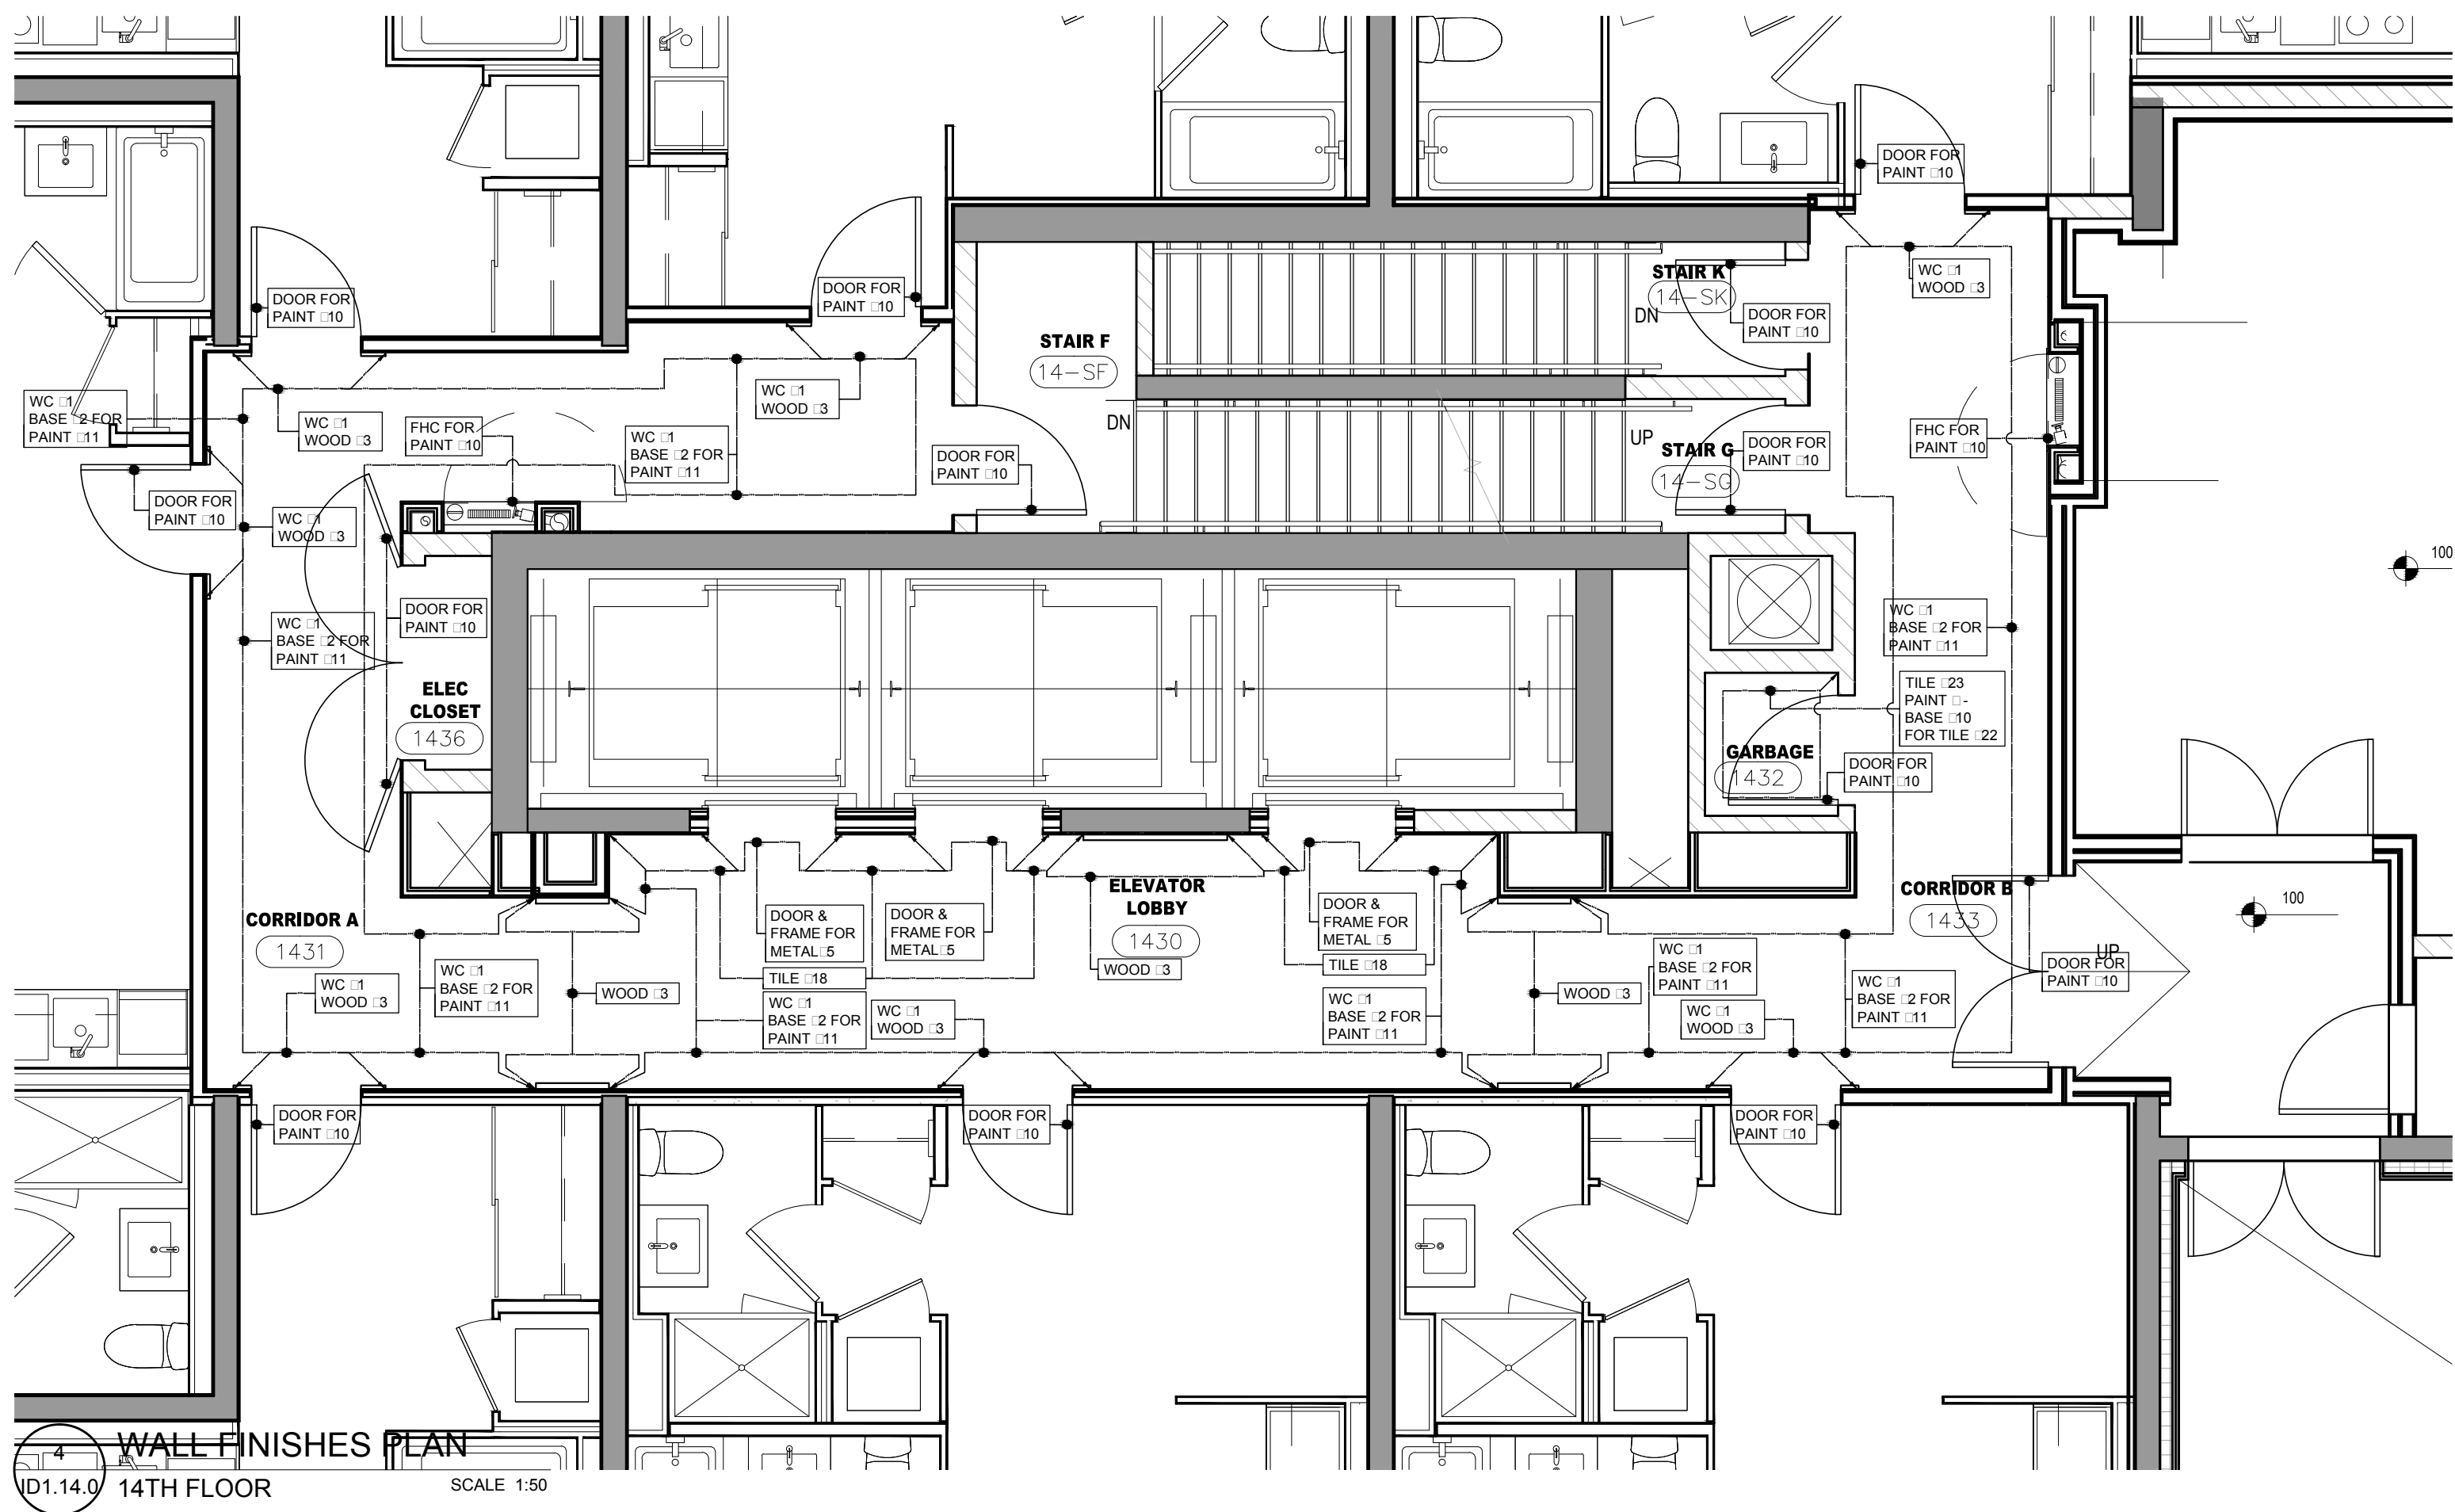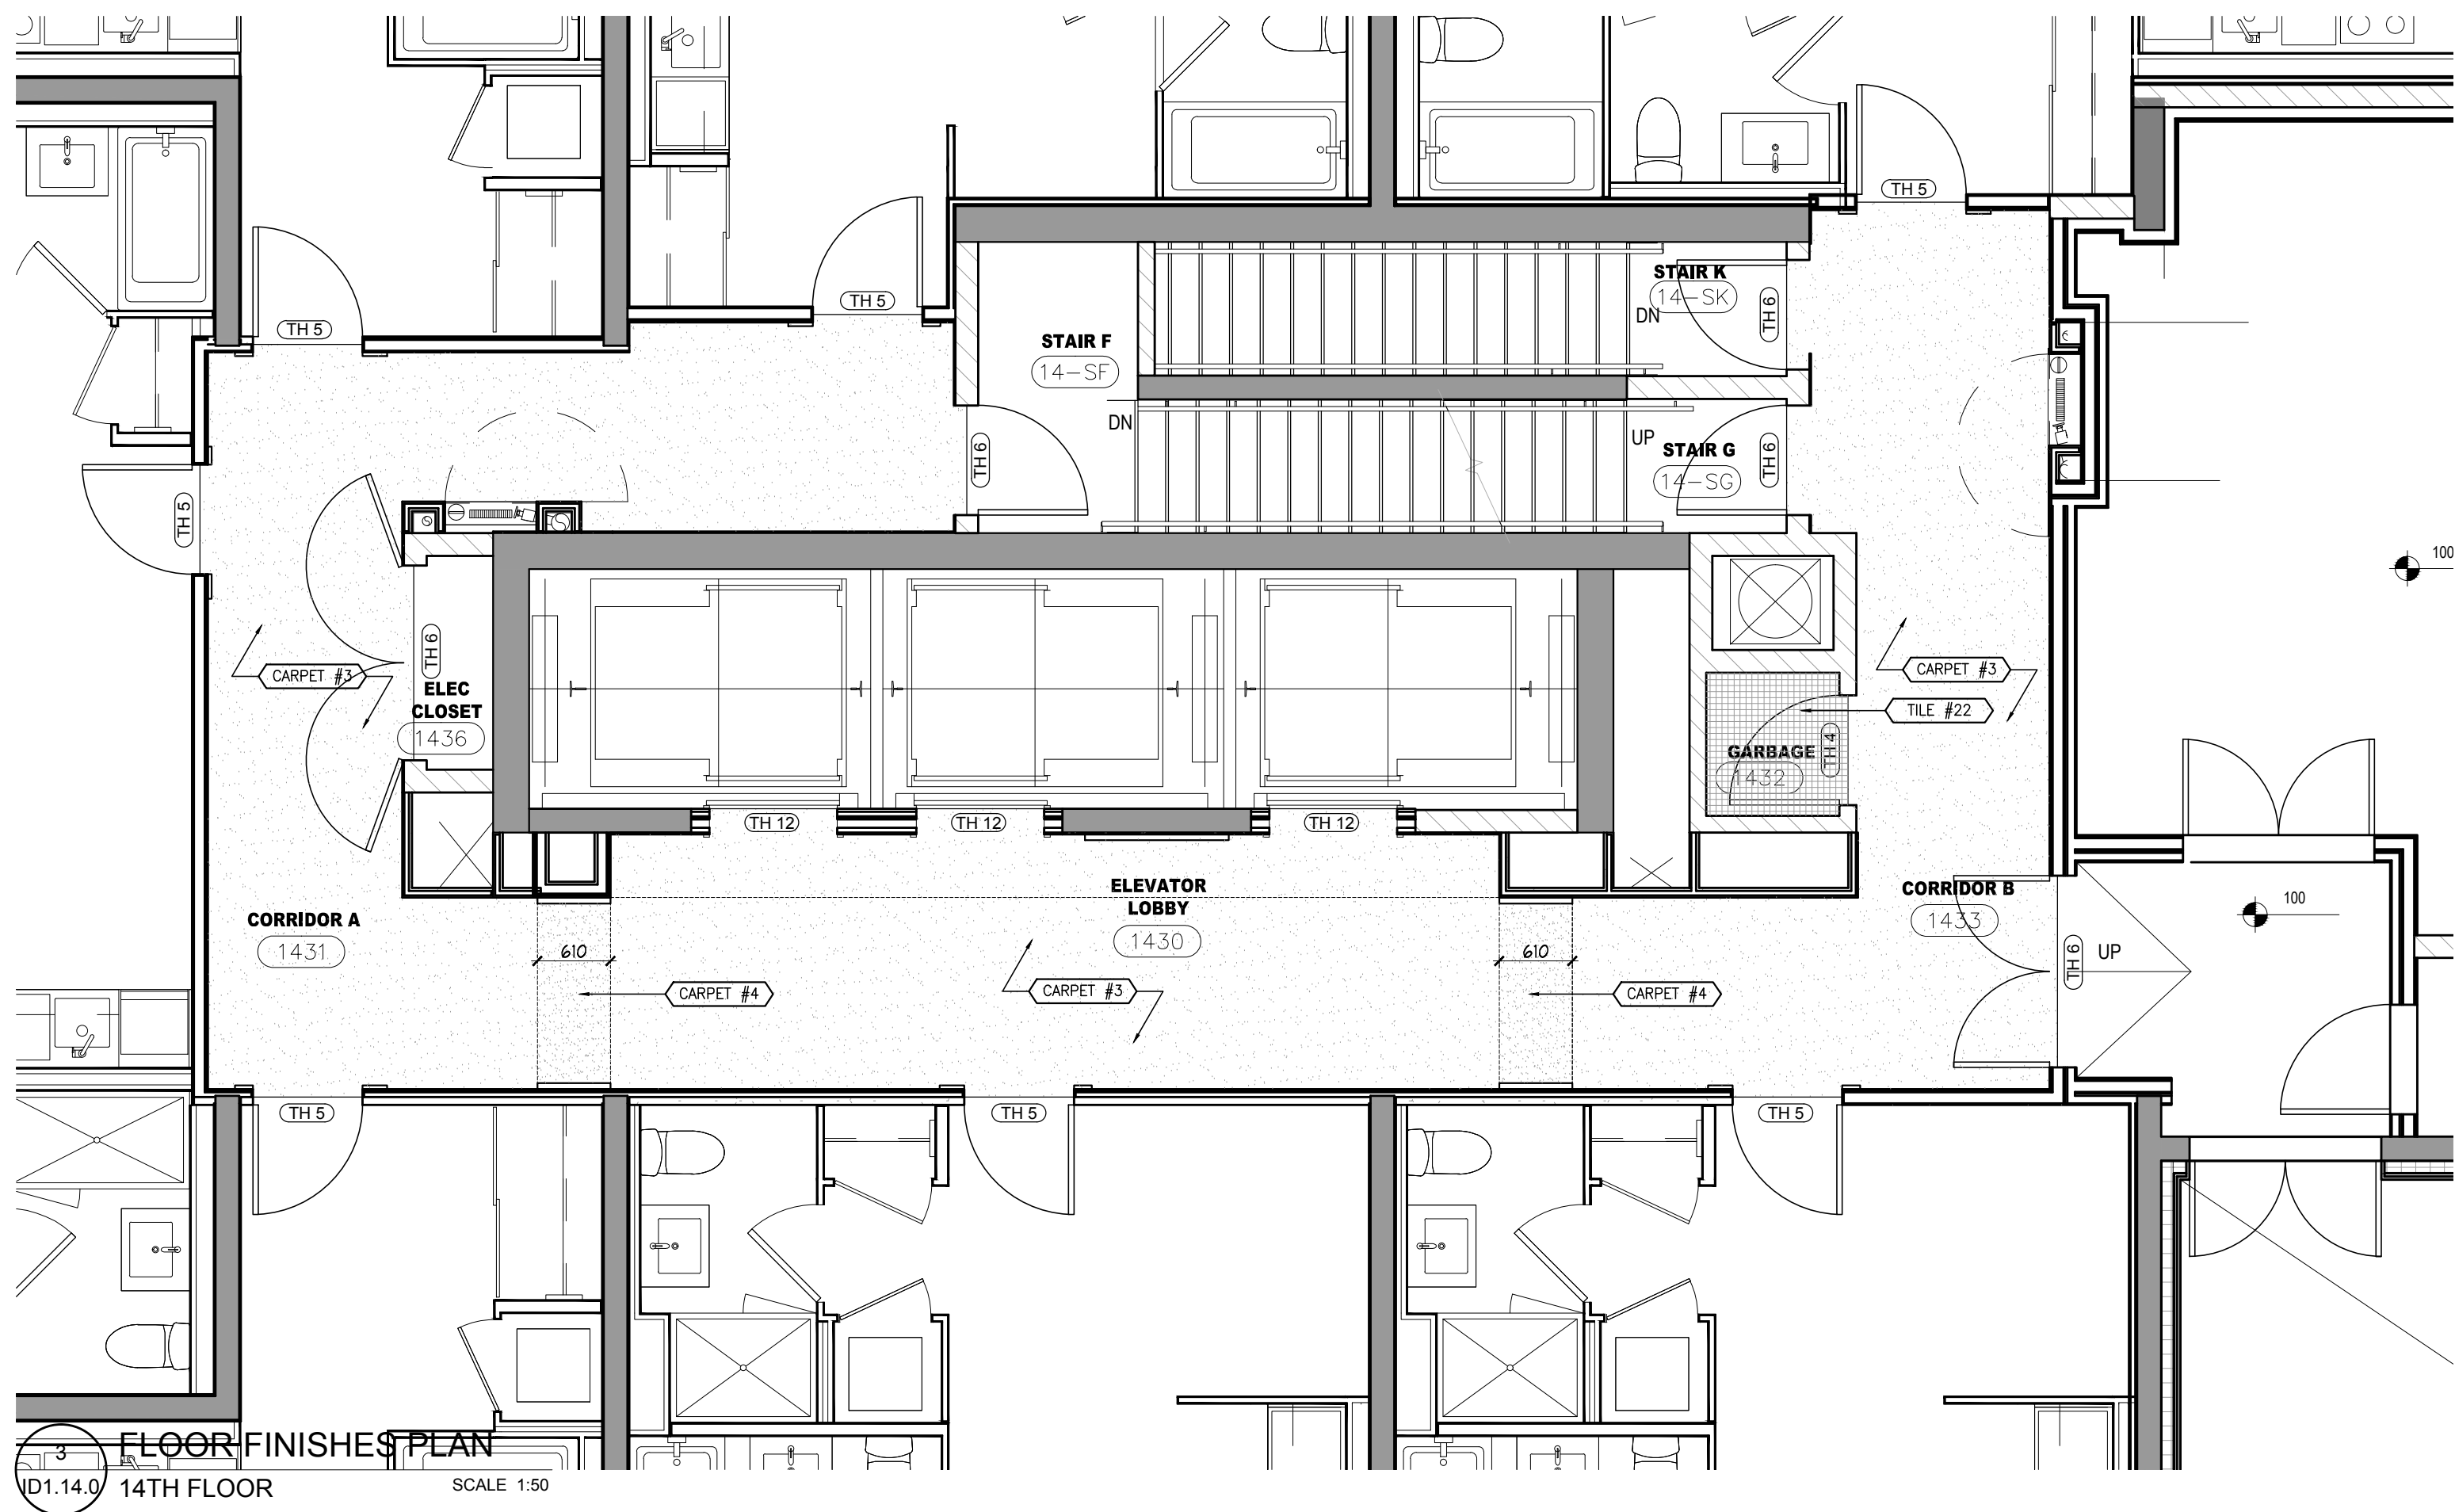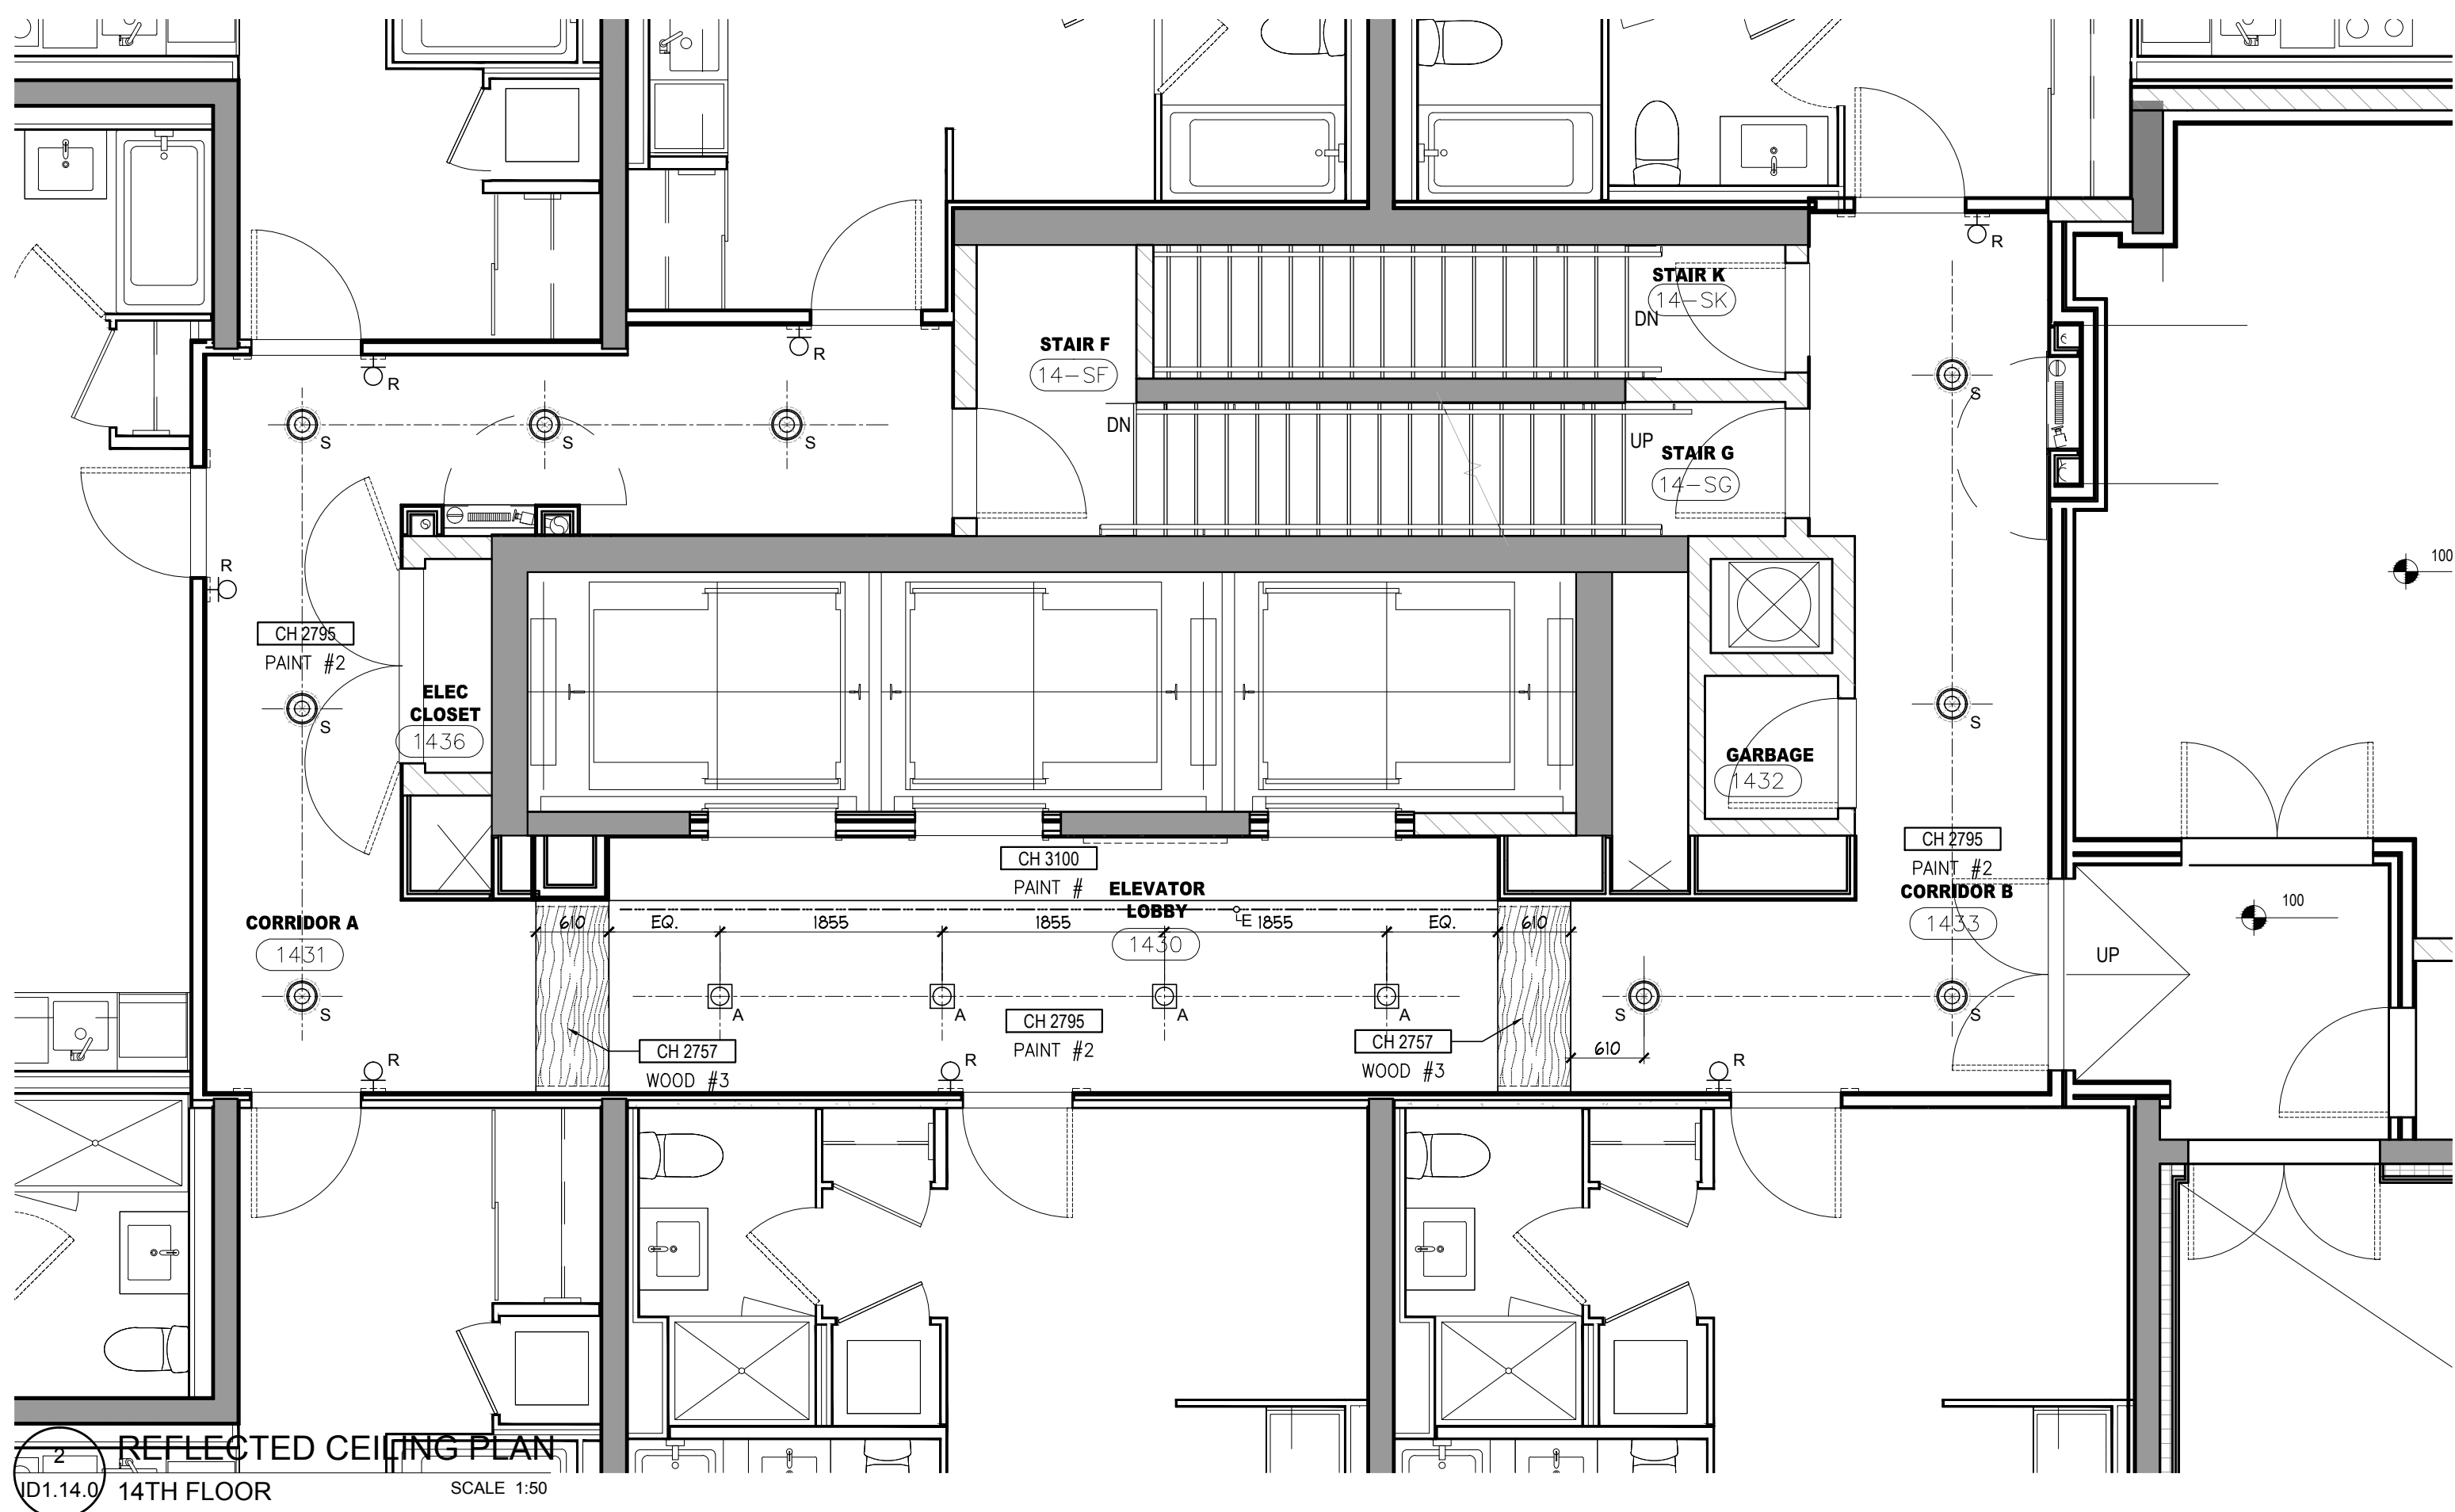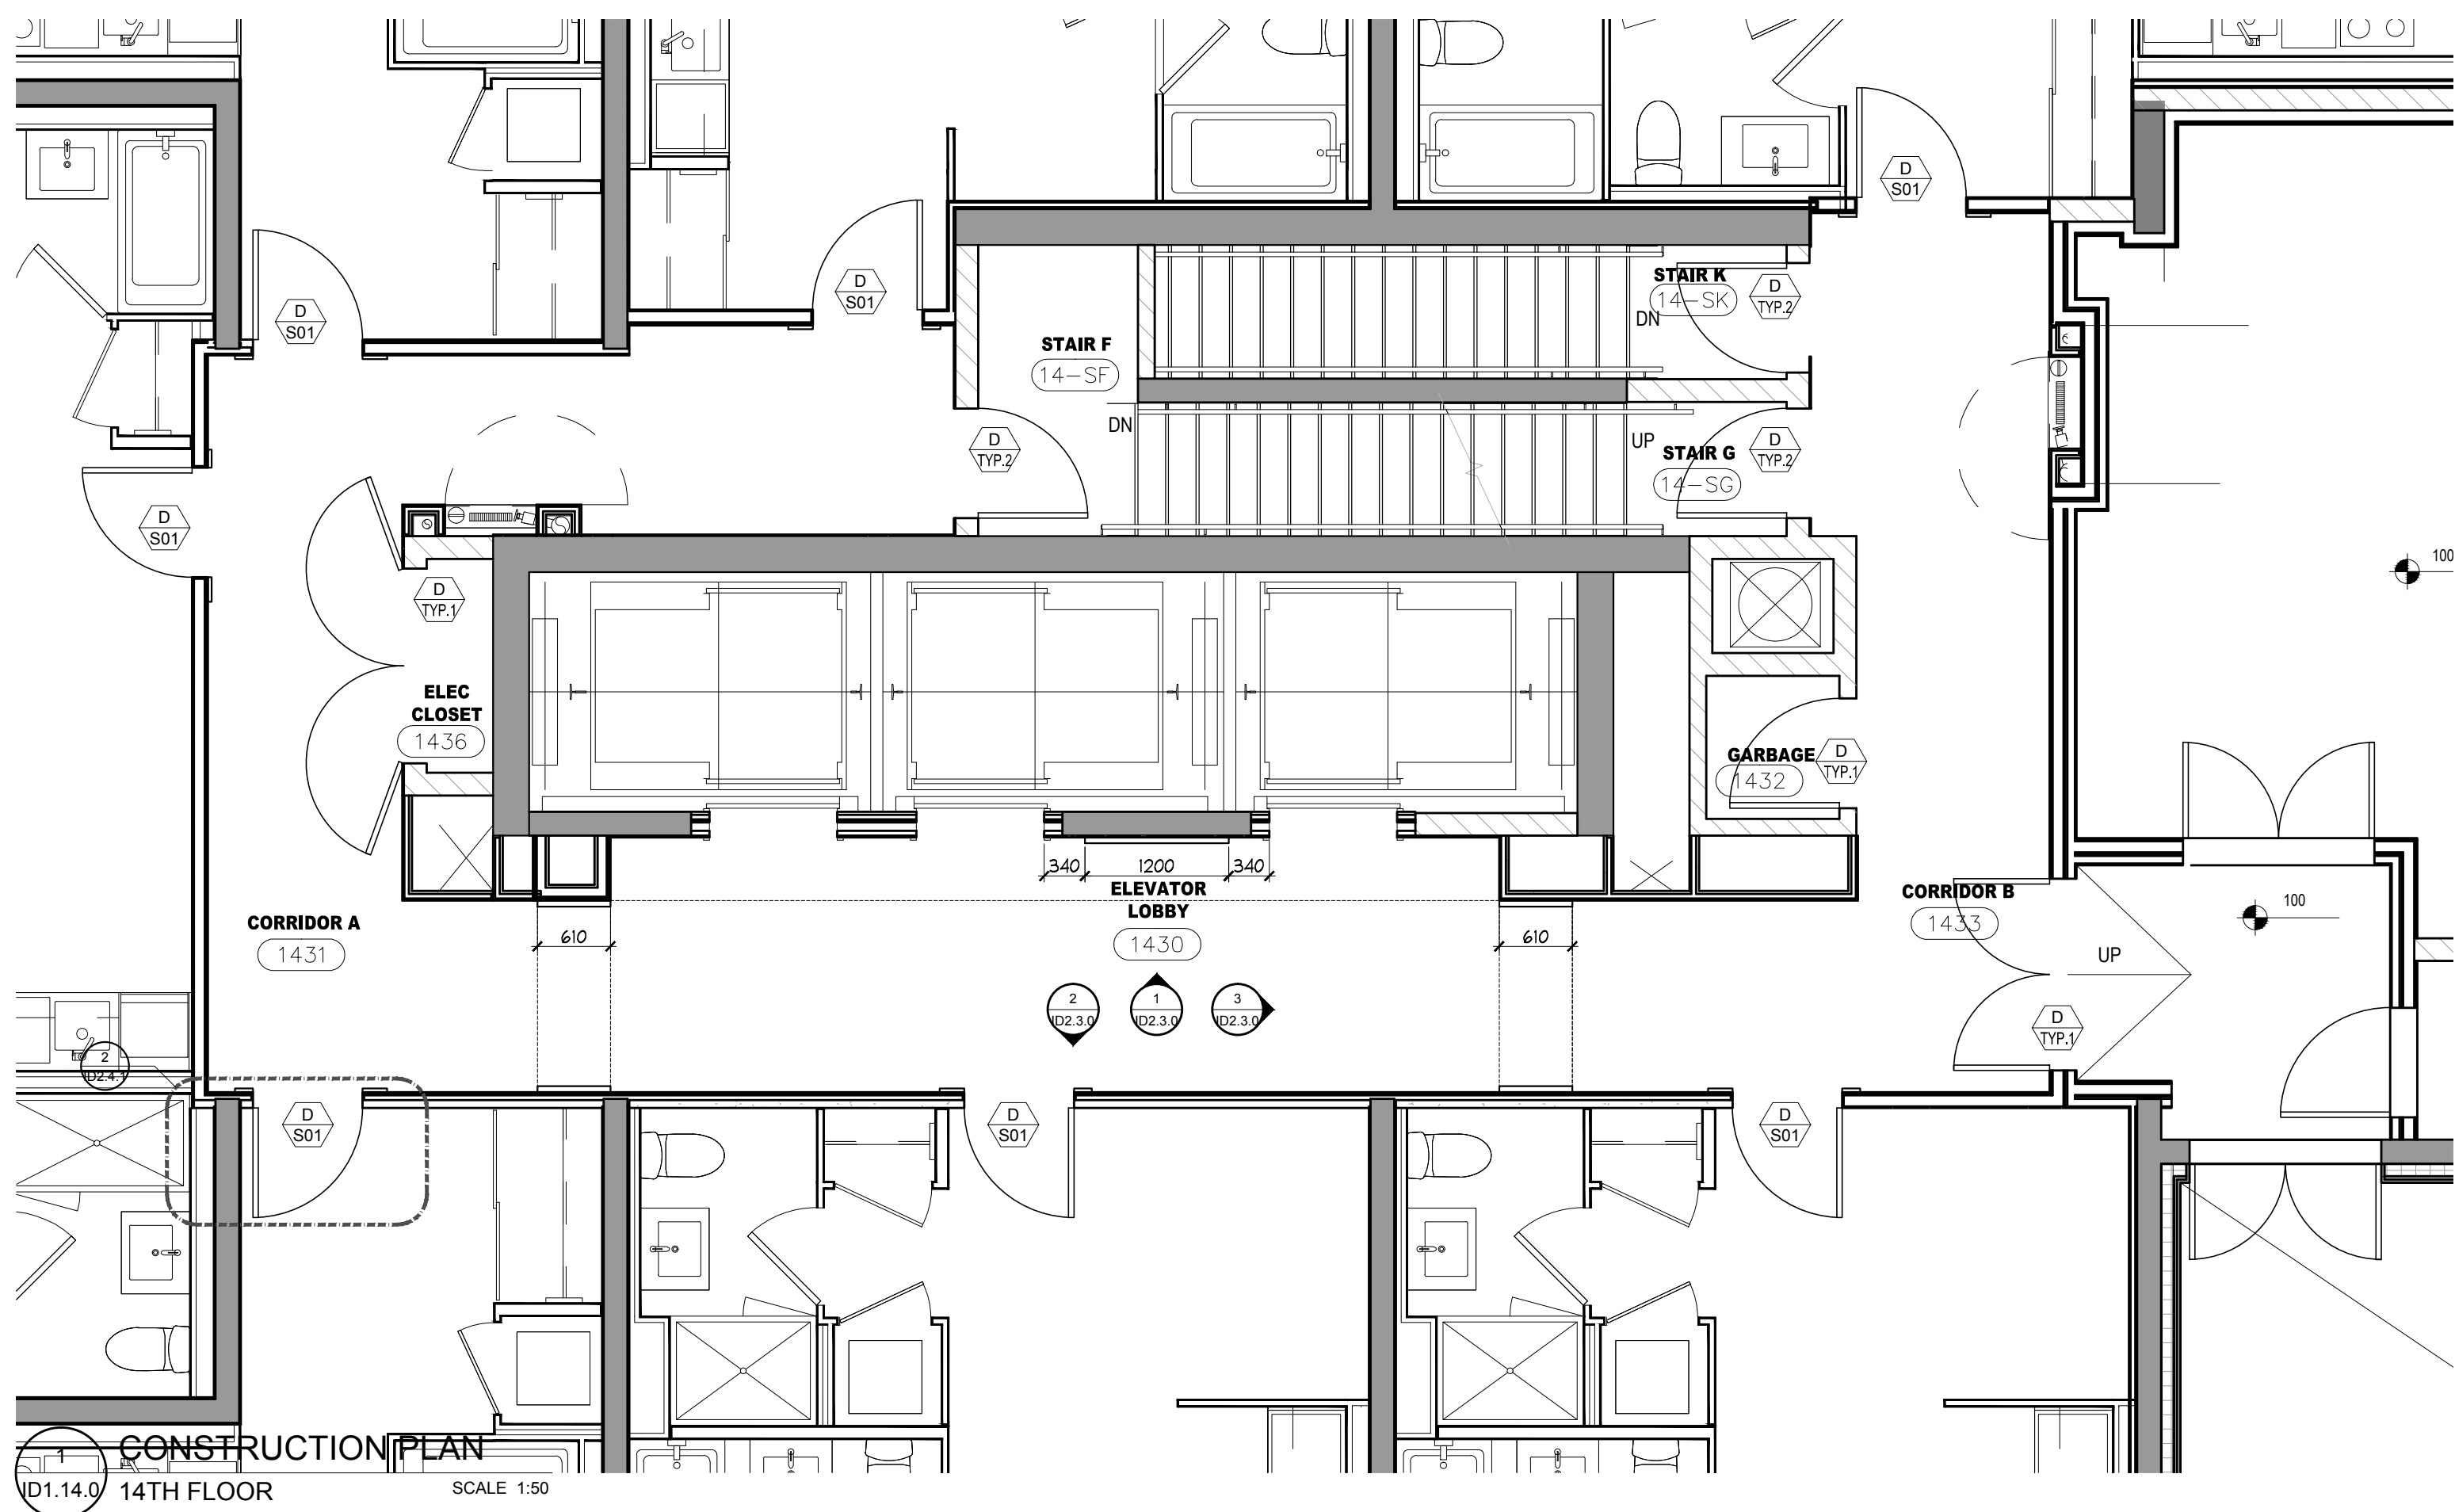

01	31 MAY / 17	ISSUED FOR AS-BUILT	SV
NO.	DATE	COMMENTS	INI
REVISIONS:			

UNION31

UNION31 INC.
183 BATHURST STREET, STE. 201
TORONTO, ON, M5T 2R7, CANADA
TEL: 416-597-1576 FAX: 416-597-2139

PROJECT NAME:			
ALEXANDRA PARK MAIN BUILDING			
BLOCK 11 ON, Canada			
PROJECT NO.: 13-949			
DRAWINGS:			
14TH FLOOR CONSTRUCTION PLAN & REFLECTED CEILING PLAN & FLOOR & WALL FINISHES PLANS			
DATE STARTED: 07 AUG / 13			
SCALE: 1" = 50'			
DRAWN BY: AP			
APPROVED BY: KC			
DRAWING NO.:			ID
			1.14.0

DO NOT SCALE DRAWINGS.

CONTRACTOR MUST VERIFY ALL DRAWINGS, DIMENSIONS, DETAILS AND SPECIFICATIONS AND REPORT ANY DISCREPANCIES TO UNION 31 INC. BEFORE PROCEEDING WITH WORK. MATERIALS MAY NOT BE SUBSTITUTED WITHOUT WRITTEN APPROVAL FROM UNION 31 INC.

ALL DRAWINGS AND SPECIFICATIONS ARE INSTRUMENTS OF SERVICE AND THE PROPERTY OF UNION 31 INC. WHICH MUST BE RETURNED AT THE COMPLETION OF THE WORK.

PRINTED: 30-MAY-17

ISSUED FOR
AS-BUILT

01	31 MAY / 17	ISSUED FOR AS-BUILT	SV
NO.	DATE	COMMENTS	INI
REVISIONS:			


UNION31

UNION31 INC.
183 BATHURST STREET, STE. 201
TORONTO, ON, M5T 2R7, CANADA
TEL: 416-597-1576 FAX: 416-597-2139


PROJECT NAME:	
ALEXANDRA PARK MAIN BUILDING	
BLOCK 11 ON, Canada	
PROJECT NO.:	13-949
DRAWINGS:	

TYPICAL ELEVATIONS


DATE STARTED:	07 AUG / 13	DRAWING NO.:
SCALE:	1 : 20	ID
DRAWN BY:	AP	2.0.0
APPROVED BY:	KC	

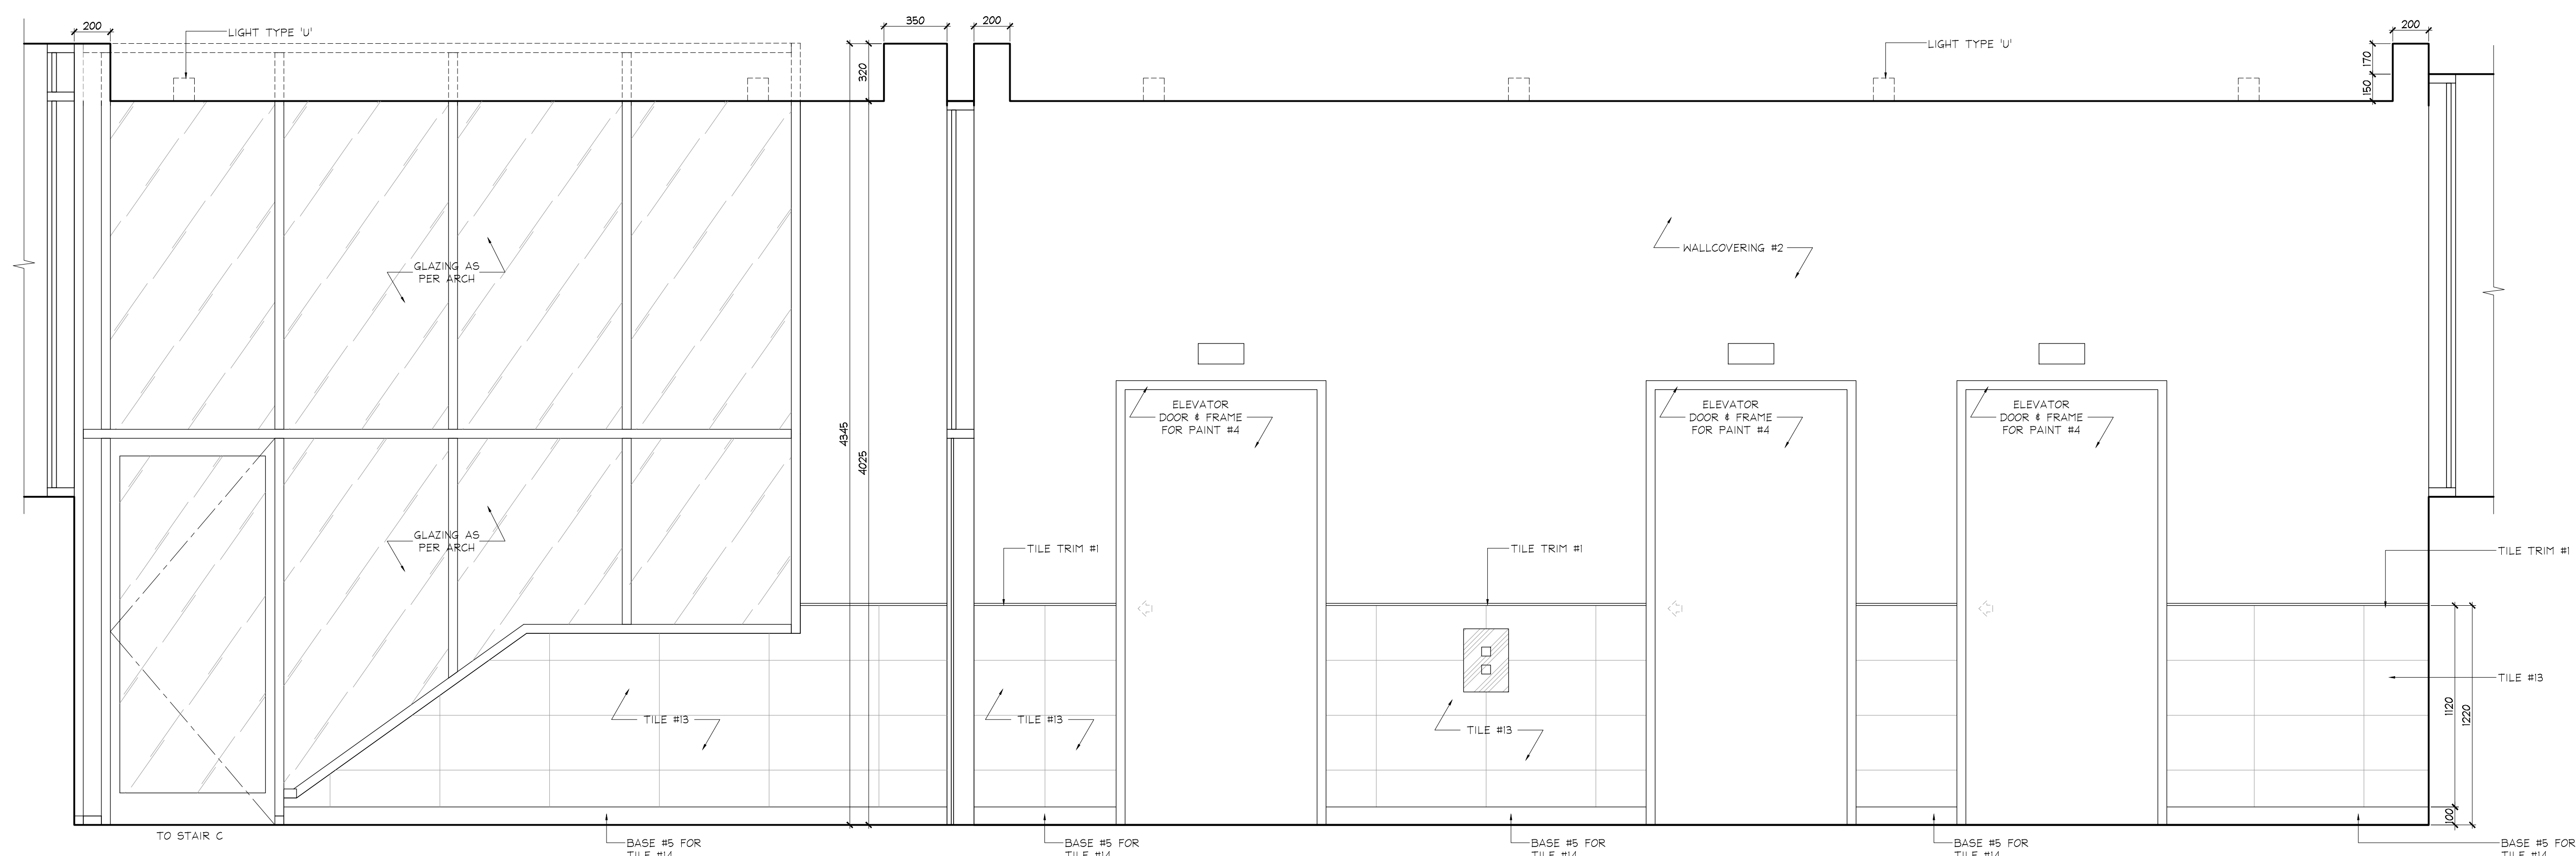


1 ELEVATION
P2 LEVEL
ELEVATOR LOBBY
SCALE 1:20

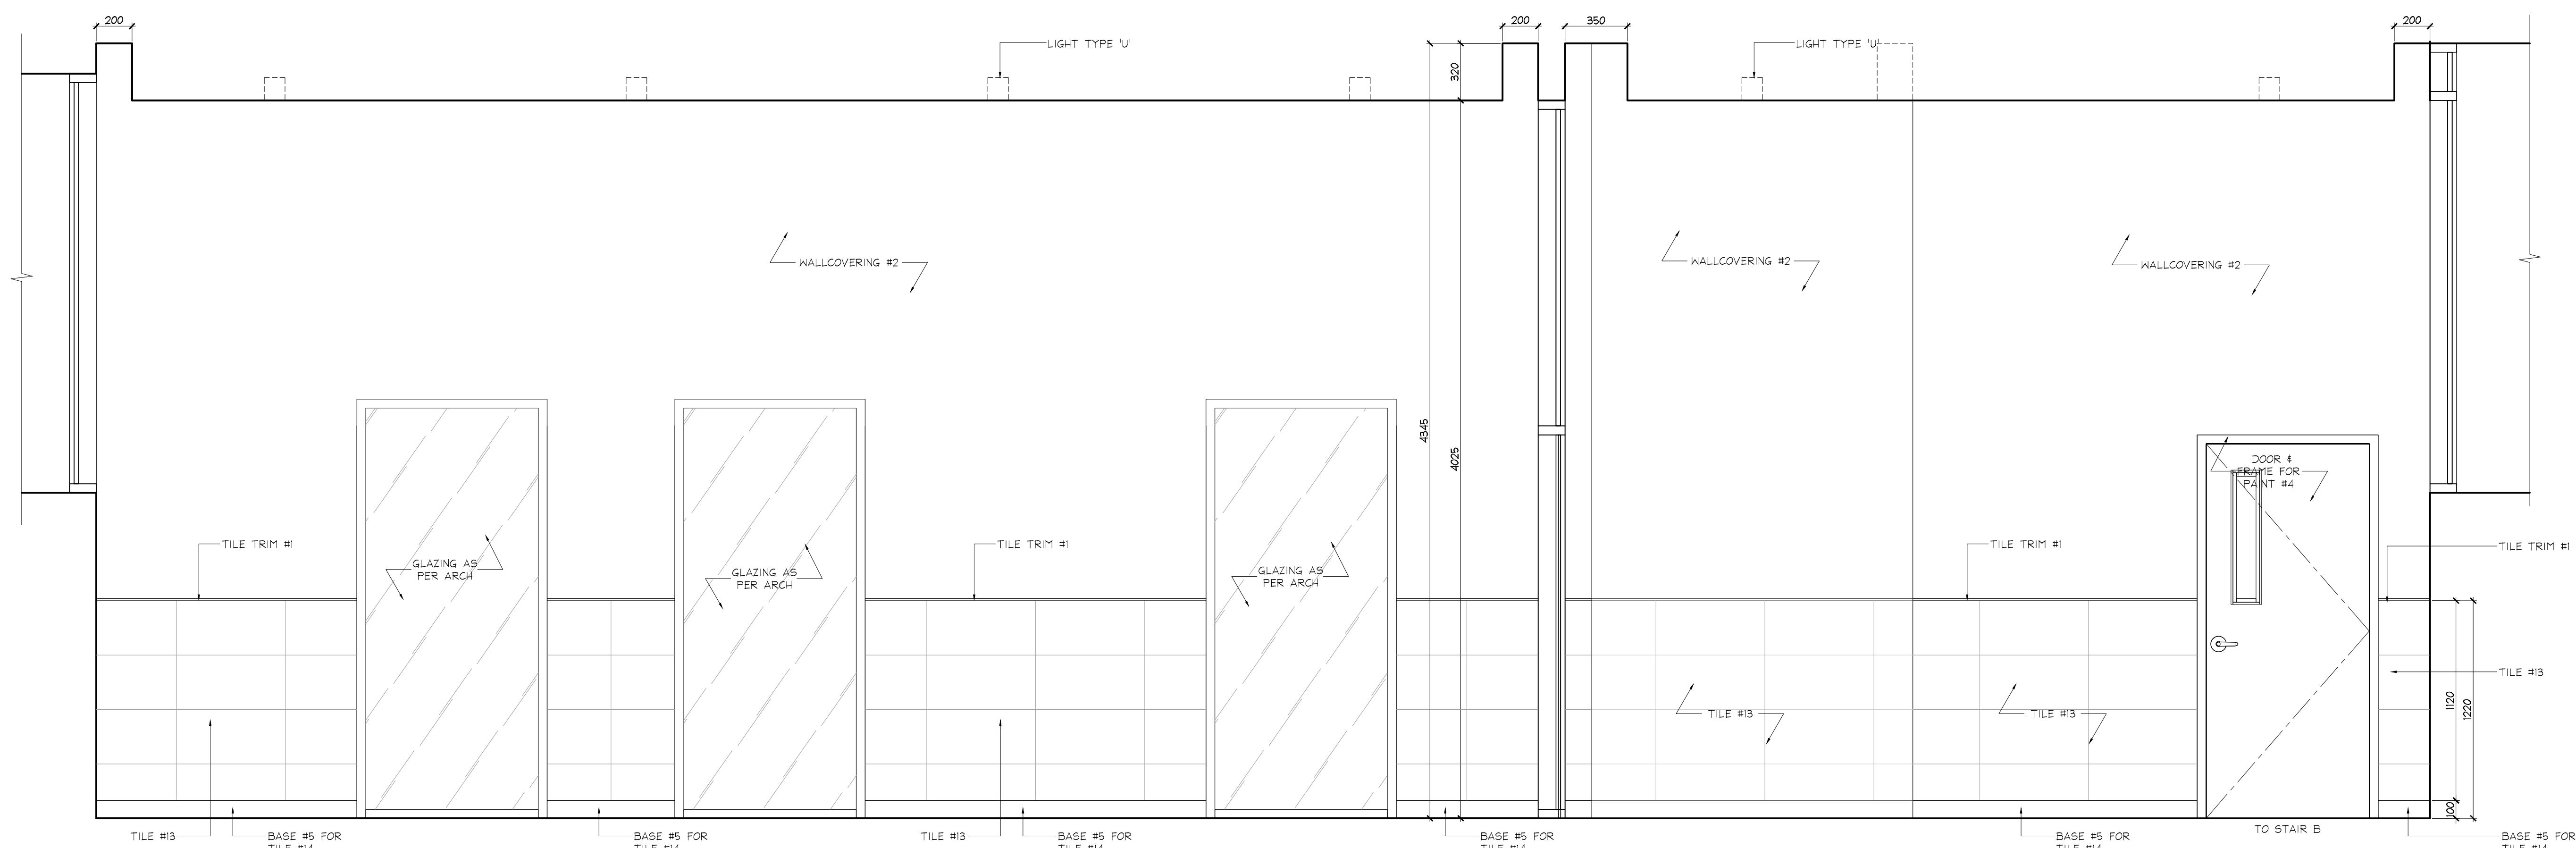


2 ELEVATION
P2 LEVEL
ELEVATOR LOBBY
SCALE 1:20

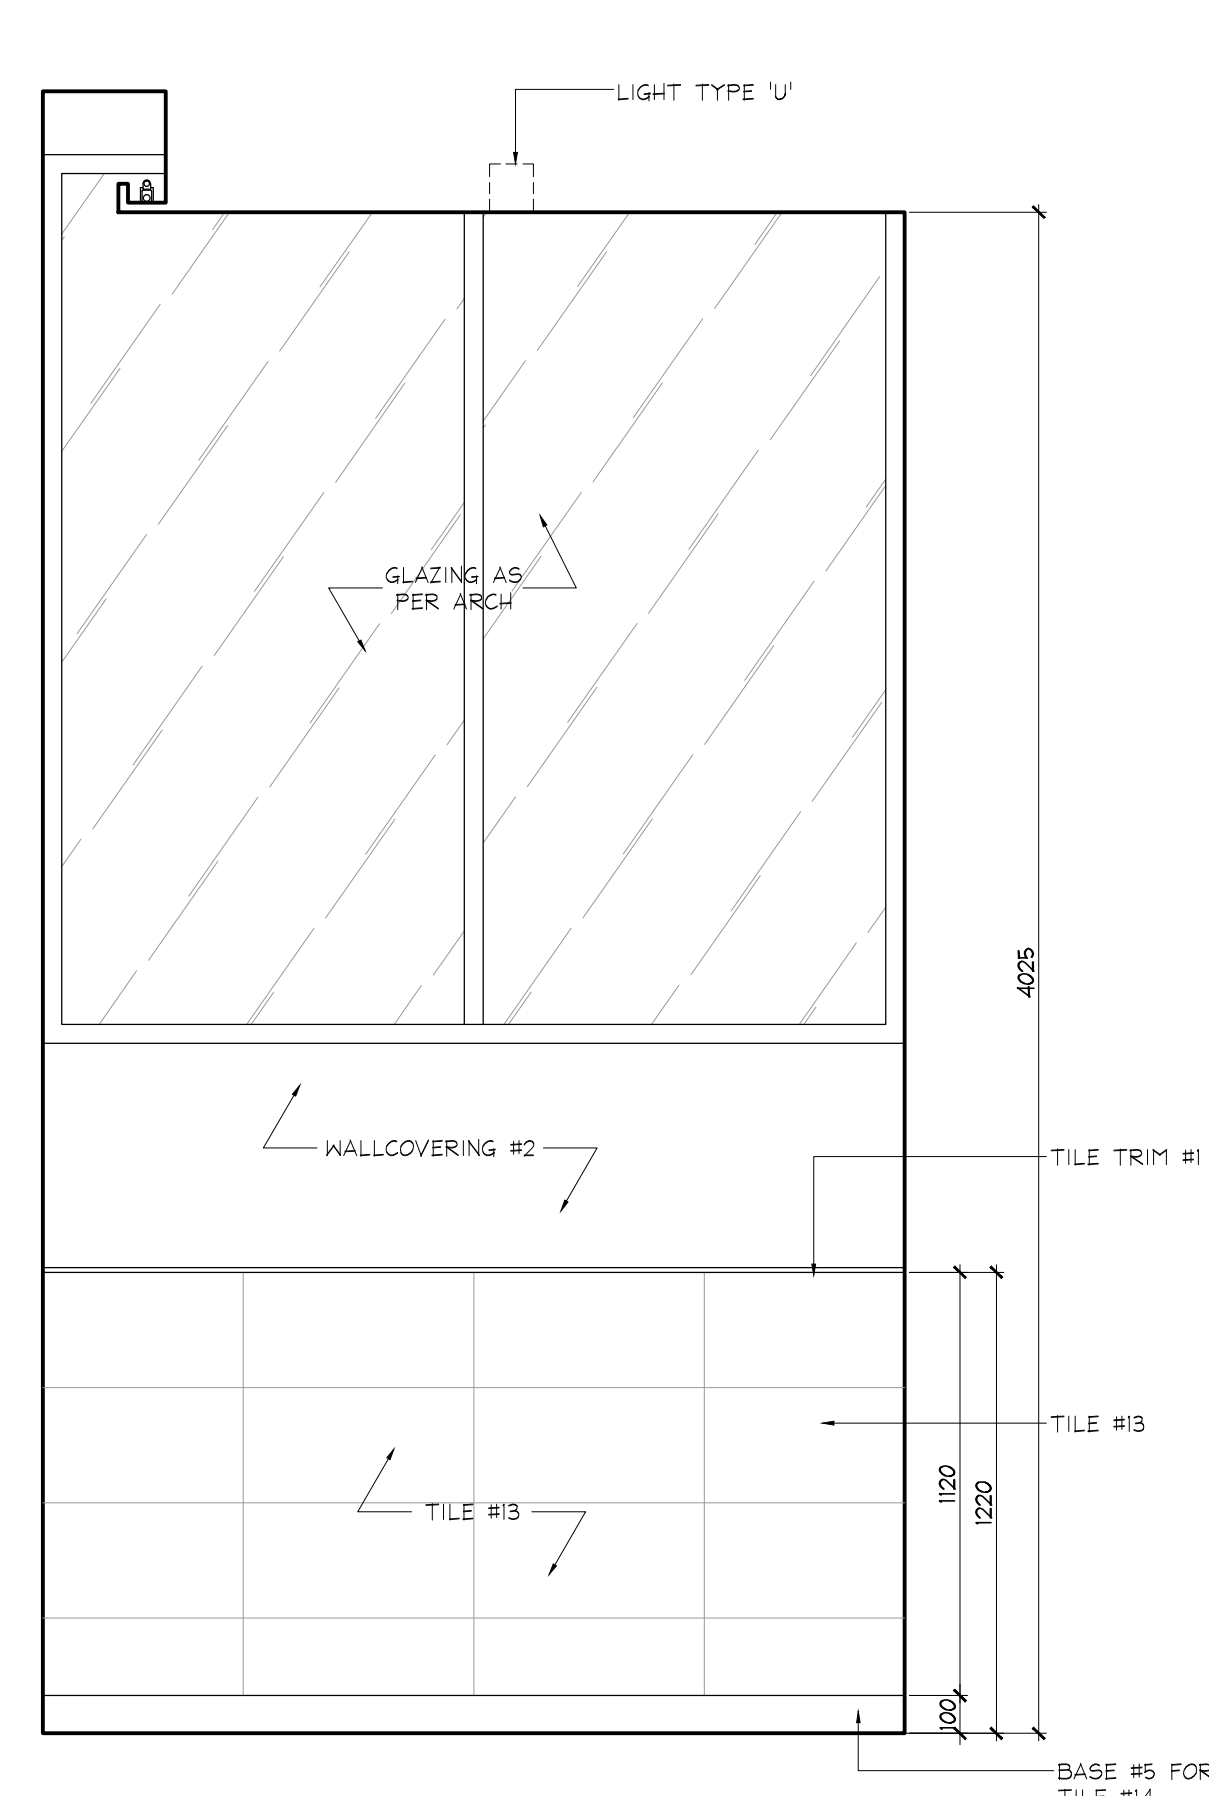


3 ELEVATION
P2 LEVEL
ELEVATOR LOBBY
SCALE 1:20

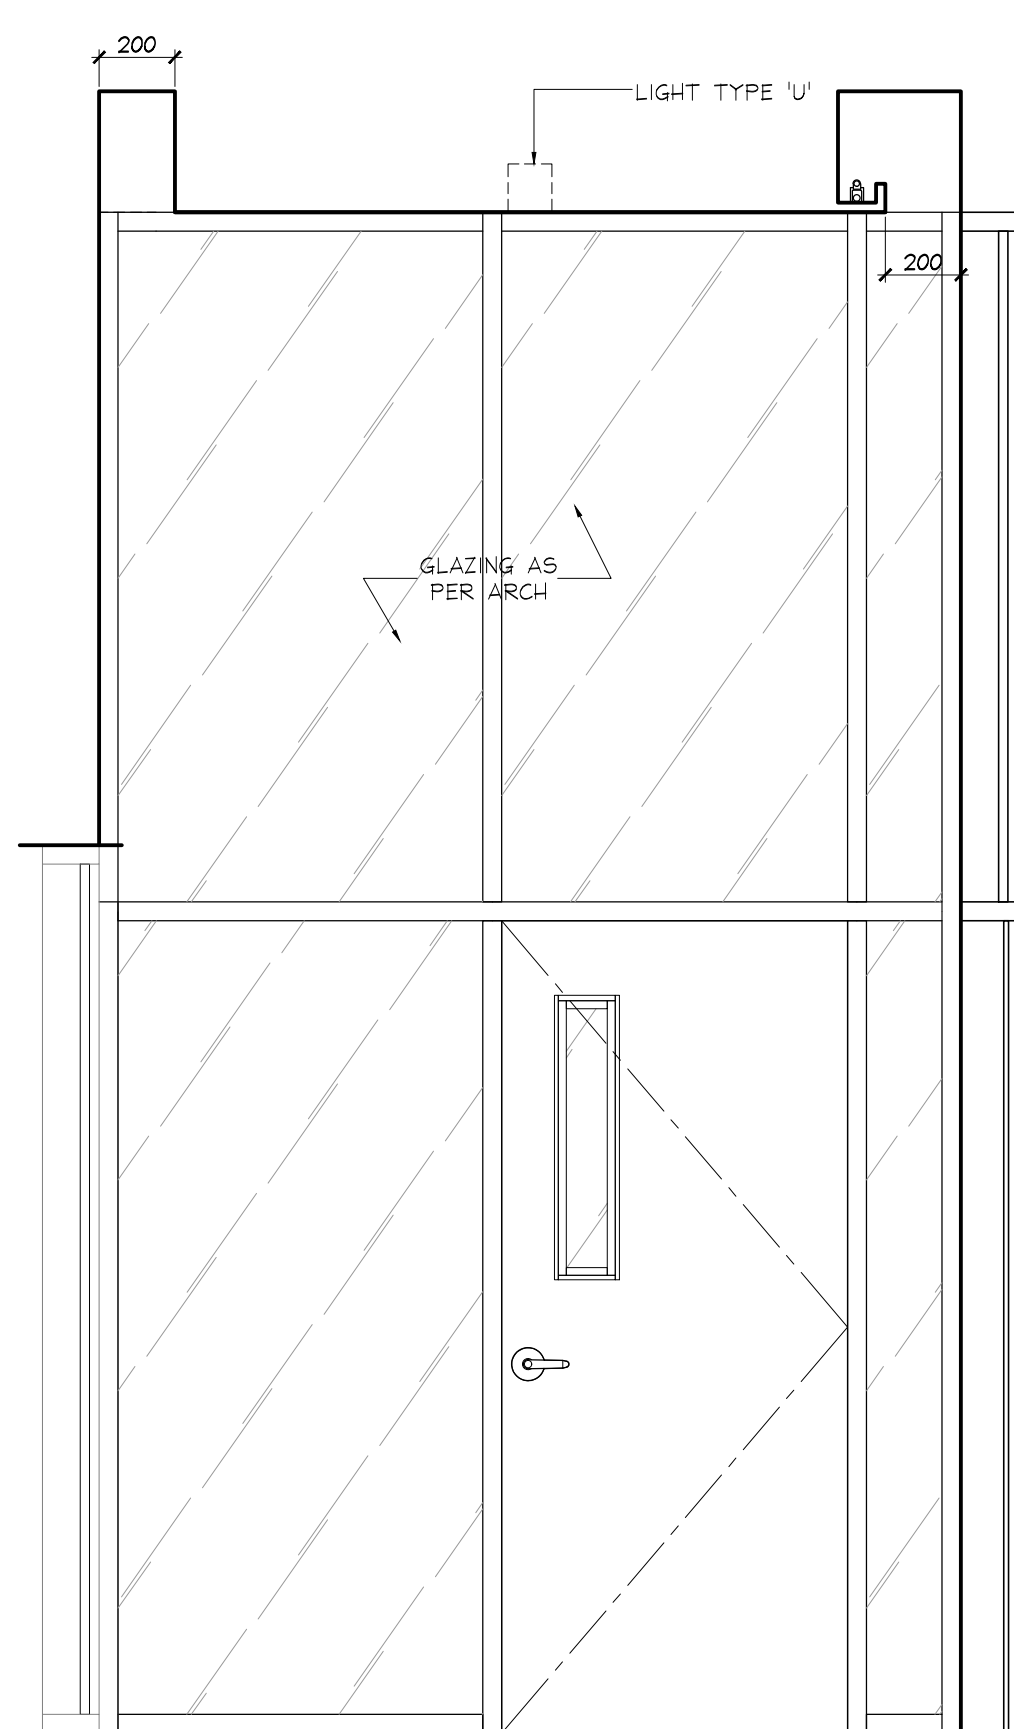

4 ELEVATION
P2 LEVEL
ELEVATOR LOBBY
SCALE 1:20

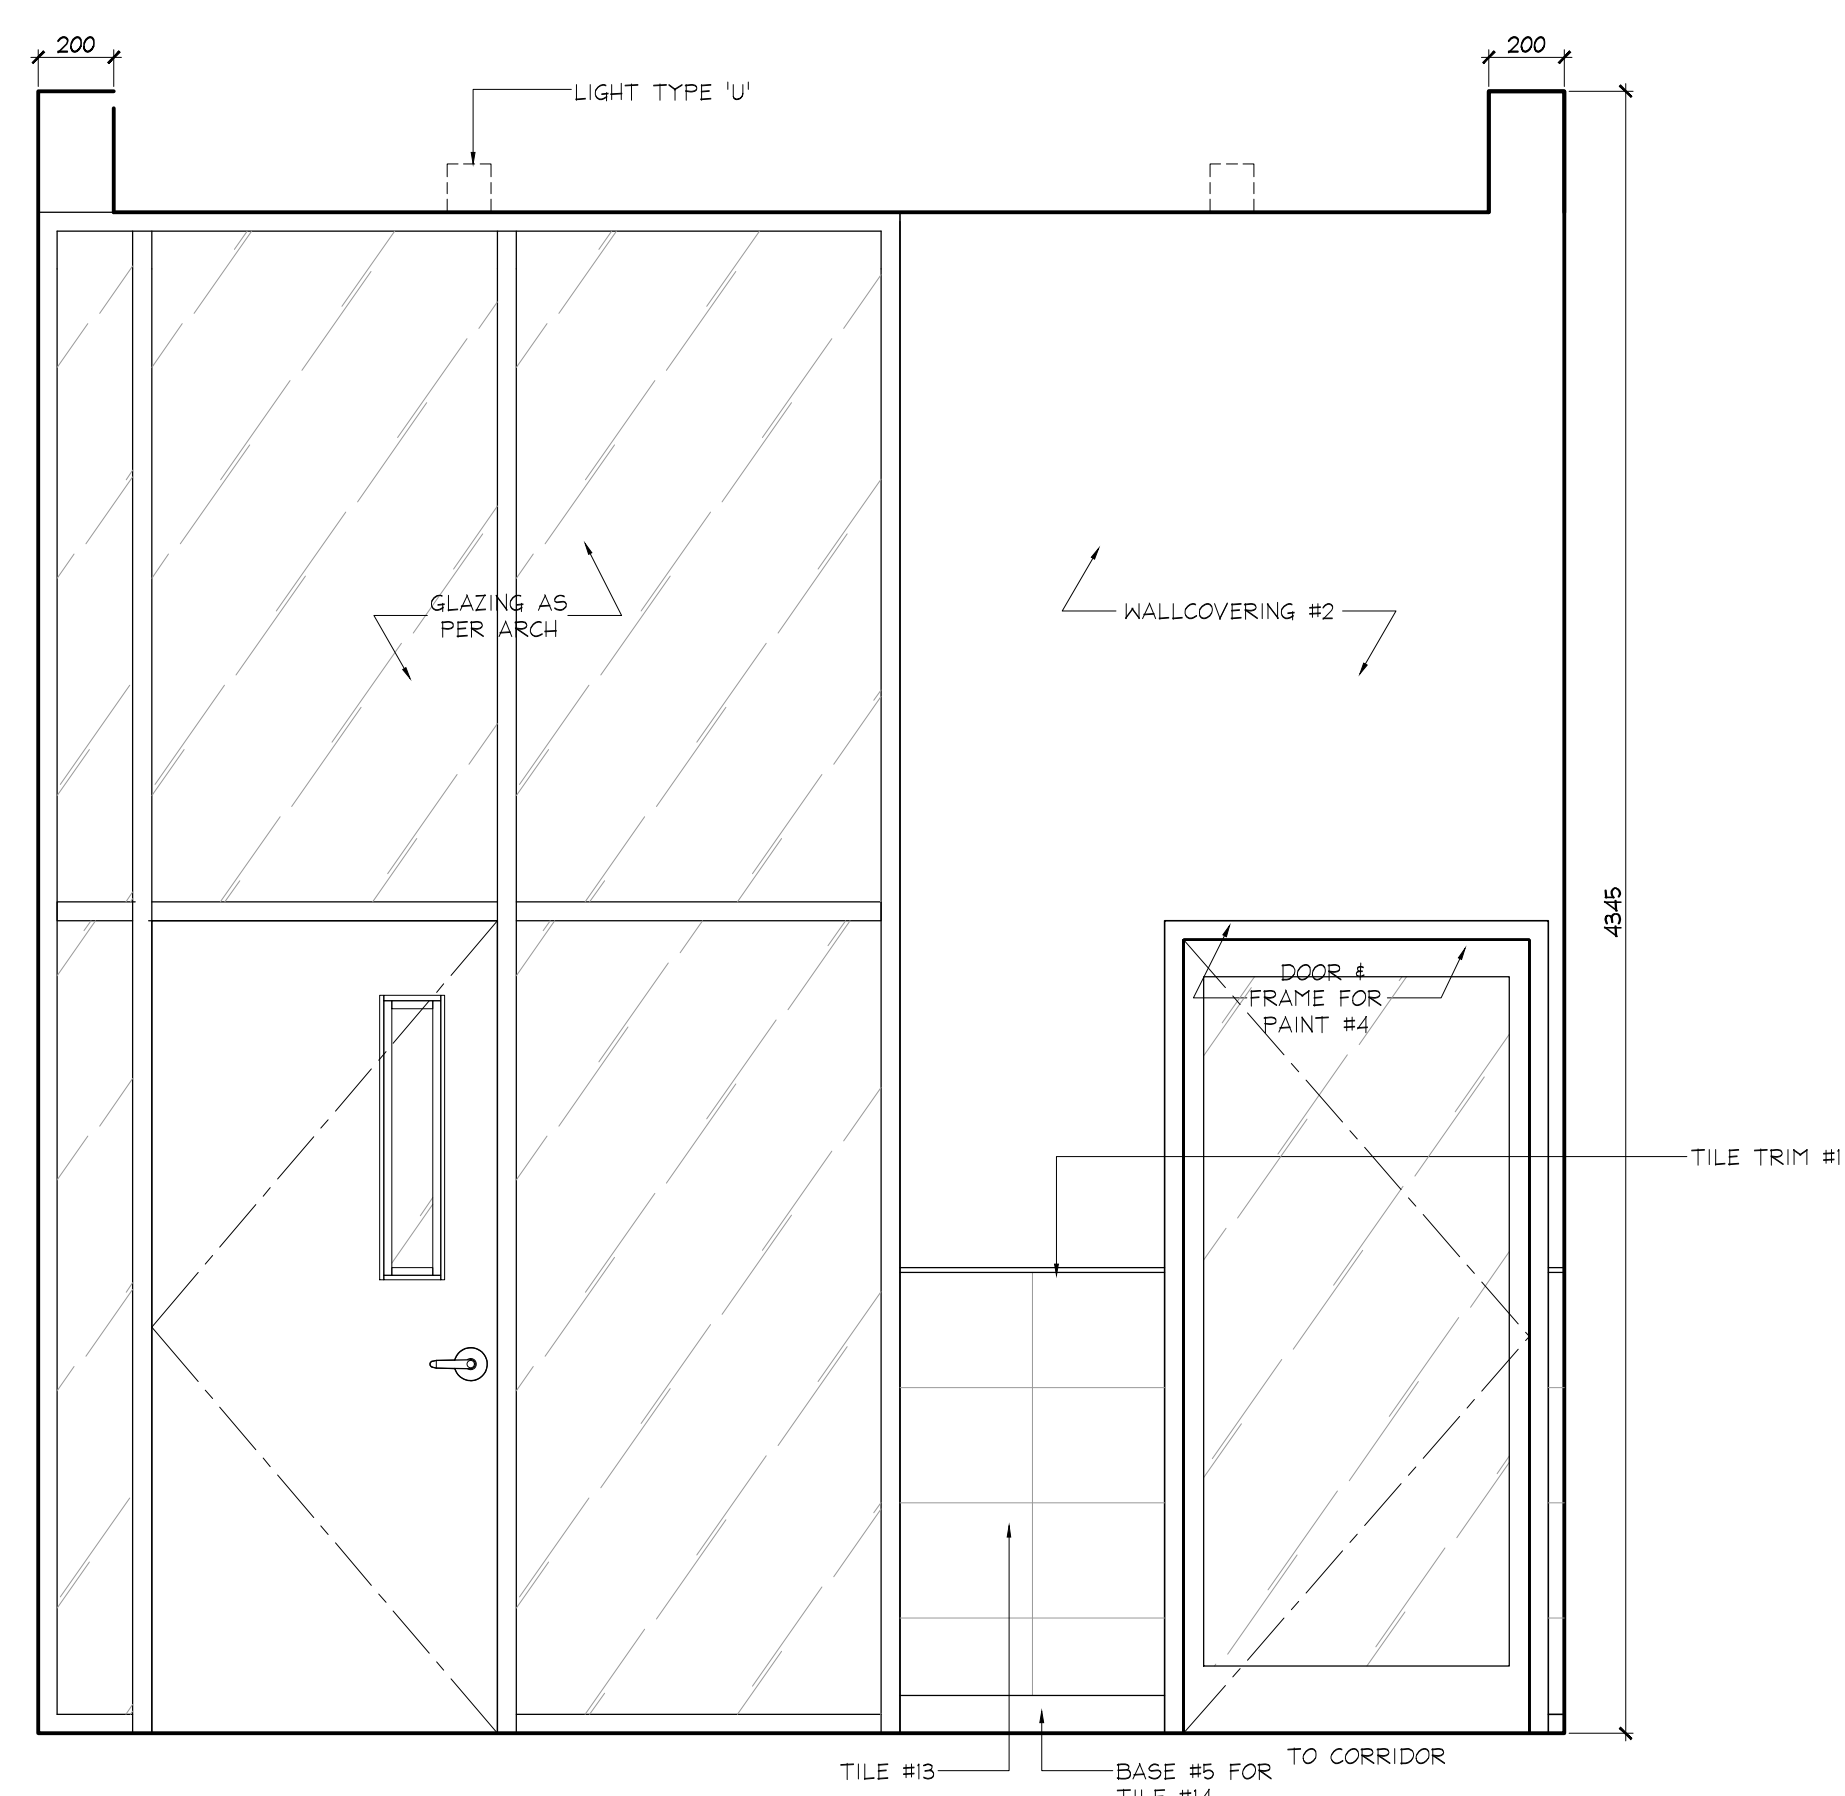

5 ELEVATION
P2 LEVEL
VESTIBULE
SCALE 1:20

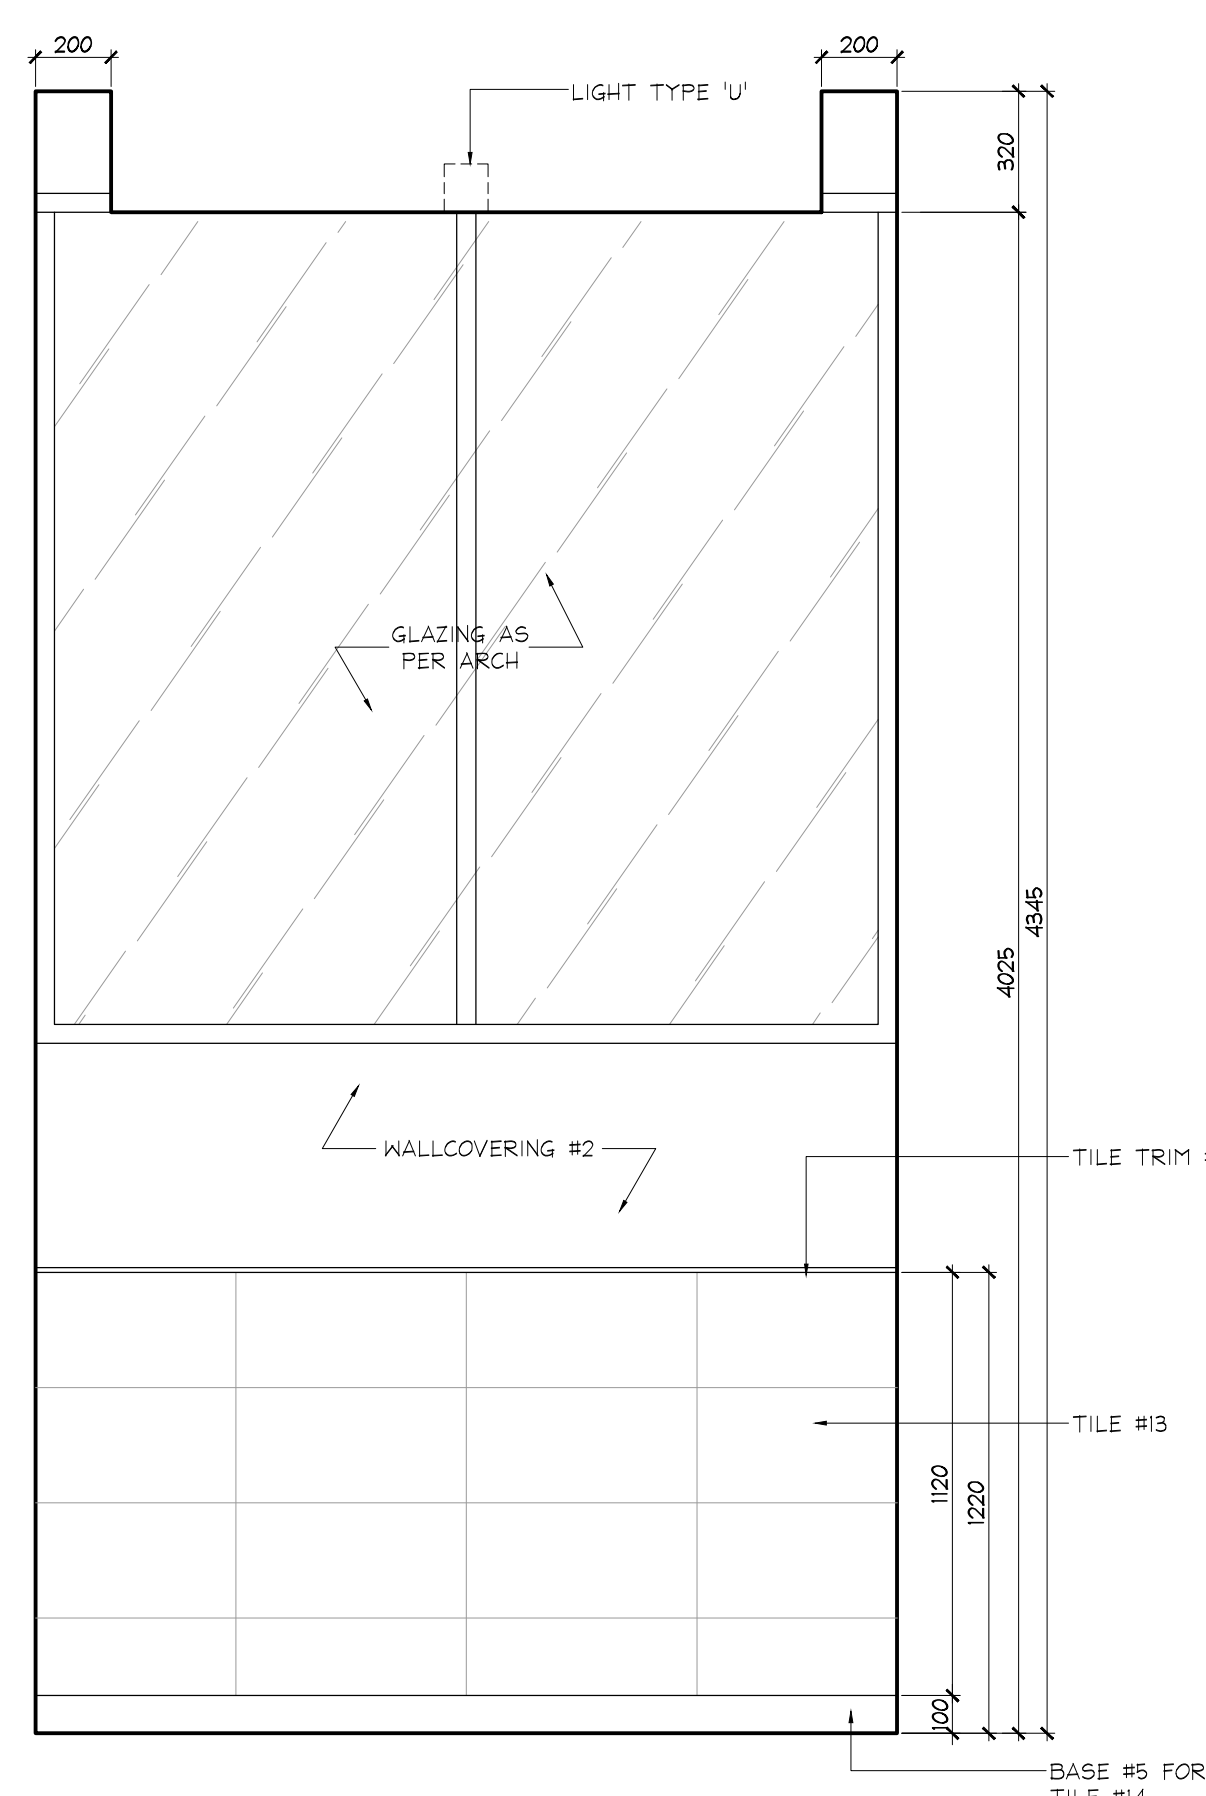

6 ELEVATION
P2 LEVEL
VESTIBULE
SCALE 1:20

DO NOT SCALE DRAWINGS.

CONTRACTOR MUST VERIFY ALL DRAWINGS, DIMENSIONS, DETAILS AND SPECIFICATIONS AND REPORT ANY DISCREPANCIES TO UNION 31 INC. BEFORE PROCEEDING WITH WORK. MATERIALS MAY NOT BE SUBSTITUTED WITHOUT WRITTEN APPROVAL FROM UNION 31 INC.

ALL DRAWINGS AND SPECIFICATIONS ARE INSTRUMENTS OF SERVICE AND THE PROPERTY OF UNION 31 INC. WHICH MUST BE RETURNED AT THE COMPLETION OF THE WORK.

PRINTED: 30-M8-17

ISSUED FOR
AS-BUILT

01	31 MAY / 17	ISSUED FOR AS-BUILT	SV
NO.	DATE	COMMENTS	INI
REVISIONS:			


UNION 31

UNION31 INC.
183 BATHURST STREET, STE. 201
TORONTO, ON, M5T 2R7, CANADA
TEL: 416-597-1576 FAX: 416-597-2139


PROJECT NAME:
**ALEXANDRA PARK
MAIN BUILDING**
BLOCK 11
ON, Canada
PROJECT NO.:
13-949
DRAWINGS:

PARKING LEVEL
ELEVATIONS


DATE STARTED:	07 AUG / 13	DRAWING NO.:	ID
SCALE:	1 : 20		2.0.1
DRAWN BY:	AP		
APPROVED BY:	KC		

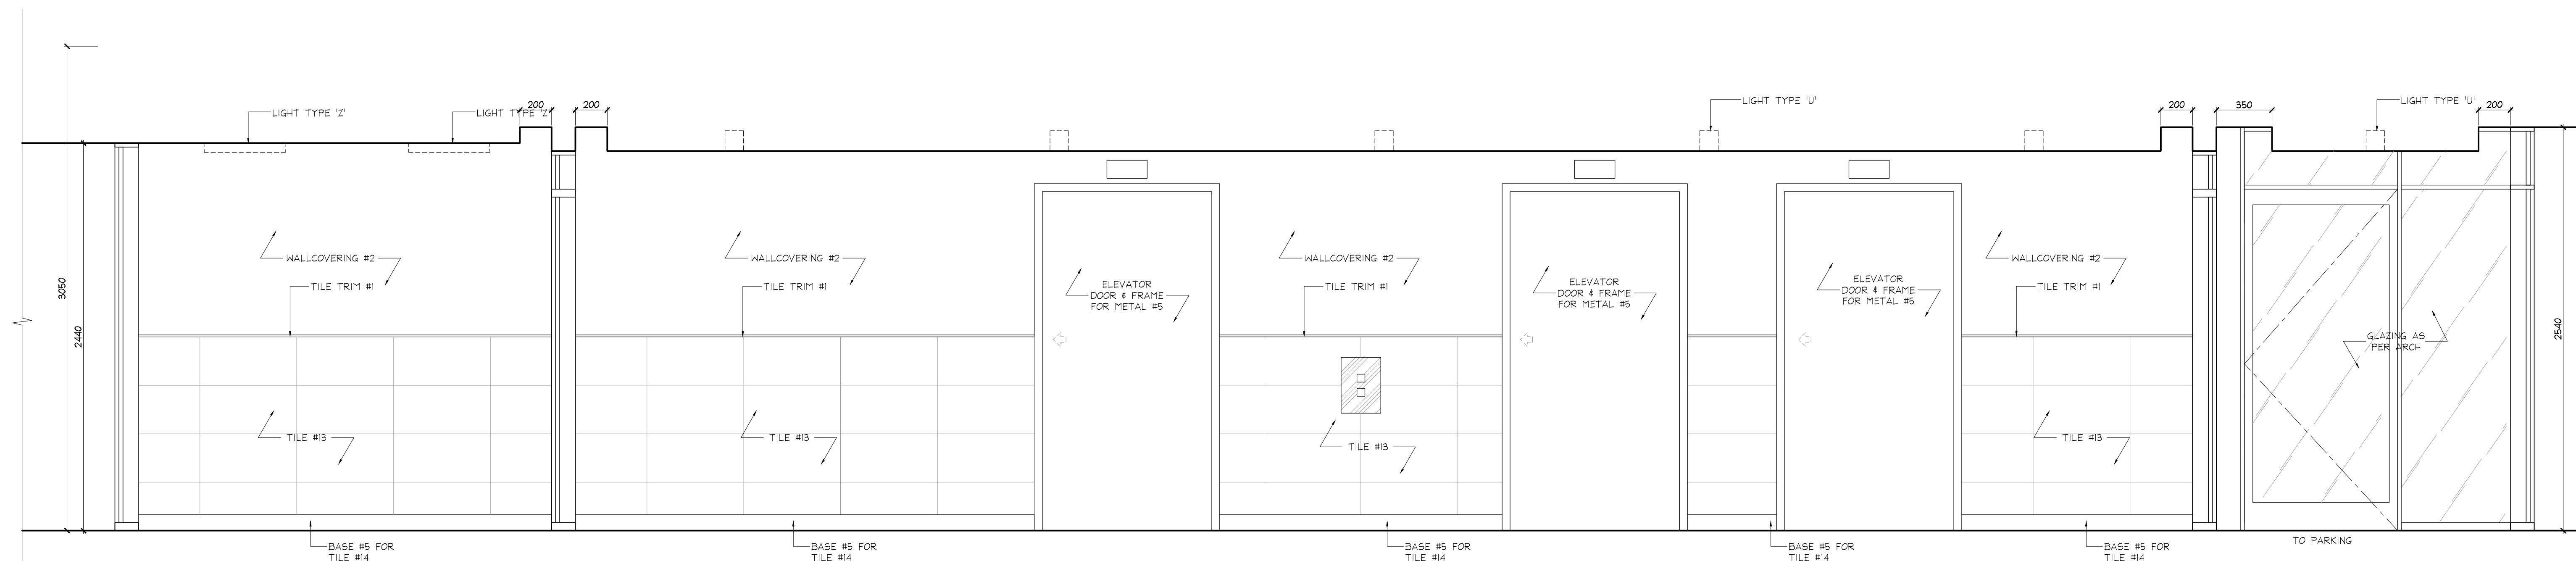


1 ELEVATION
ID2.0.1 P1 LEVEL
ELEVATOR LOBBY
SCALE 1:20

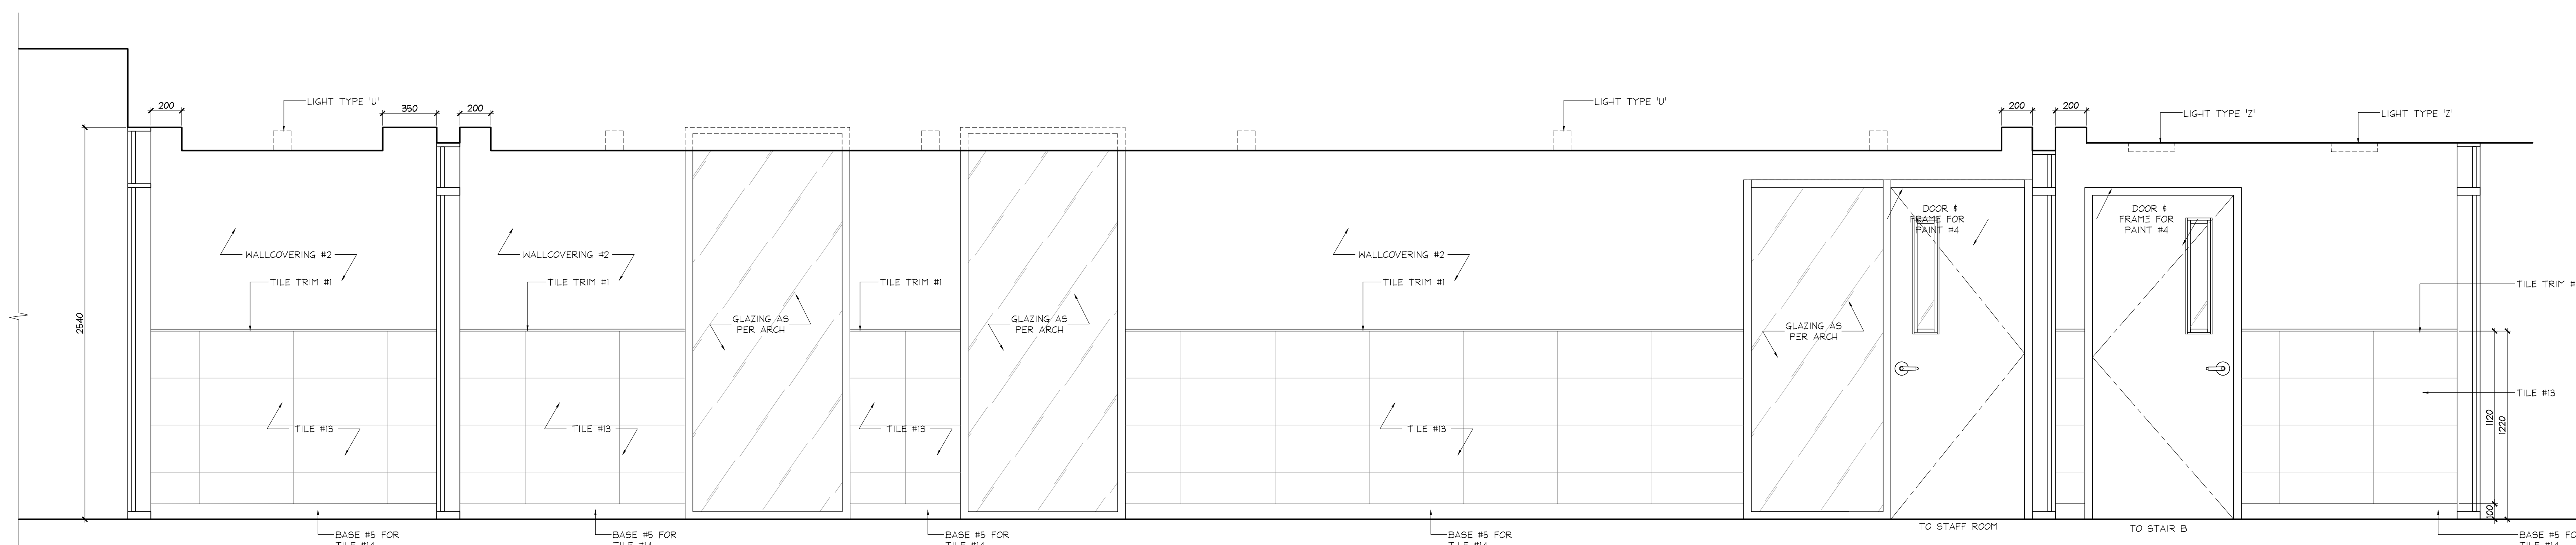


2 ELEVATION
ID2.0.1 P1 LEVEL
ELEVATOR LOBBY
SCALE 1:20

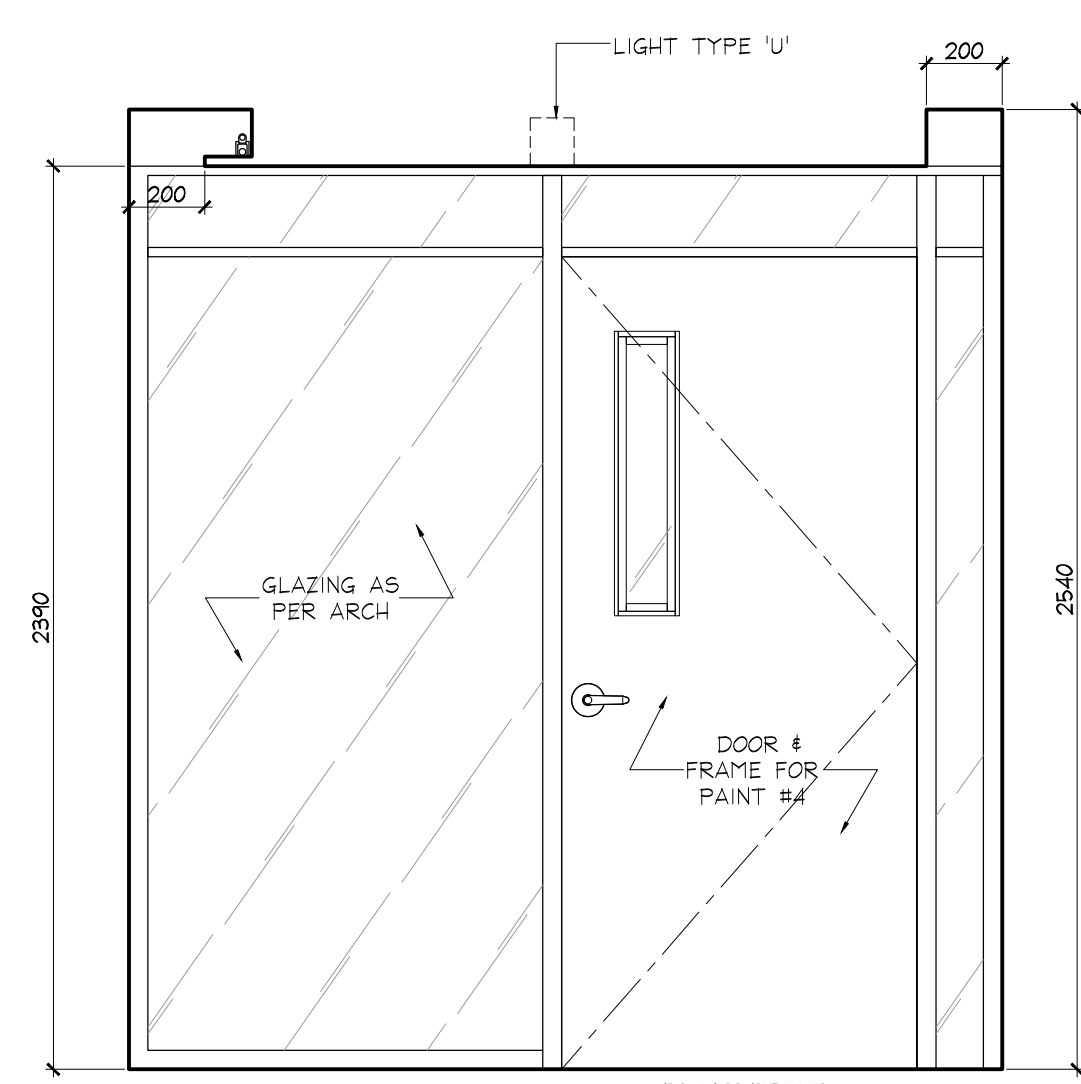


3 ELEVATION
ID2.0.1 P1 LEVEL
ELEVATOR LOBBY
SCALE 1:20

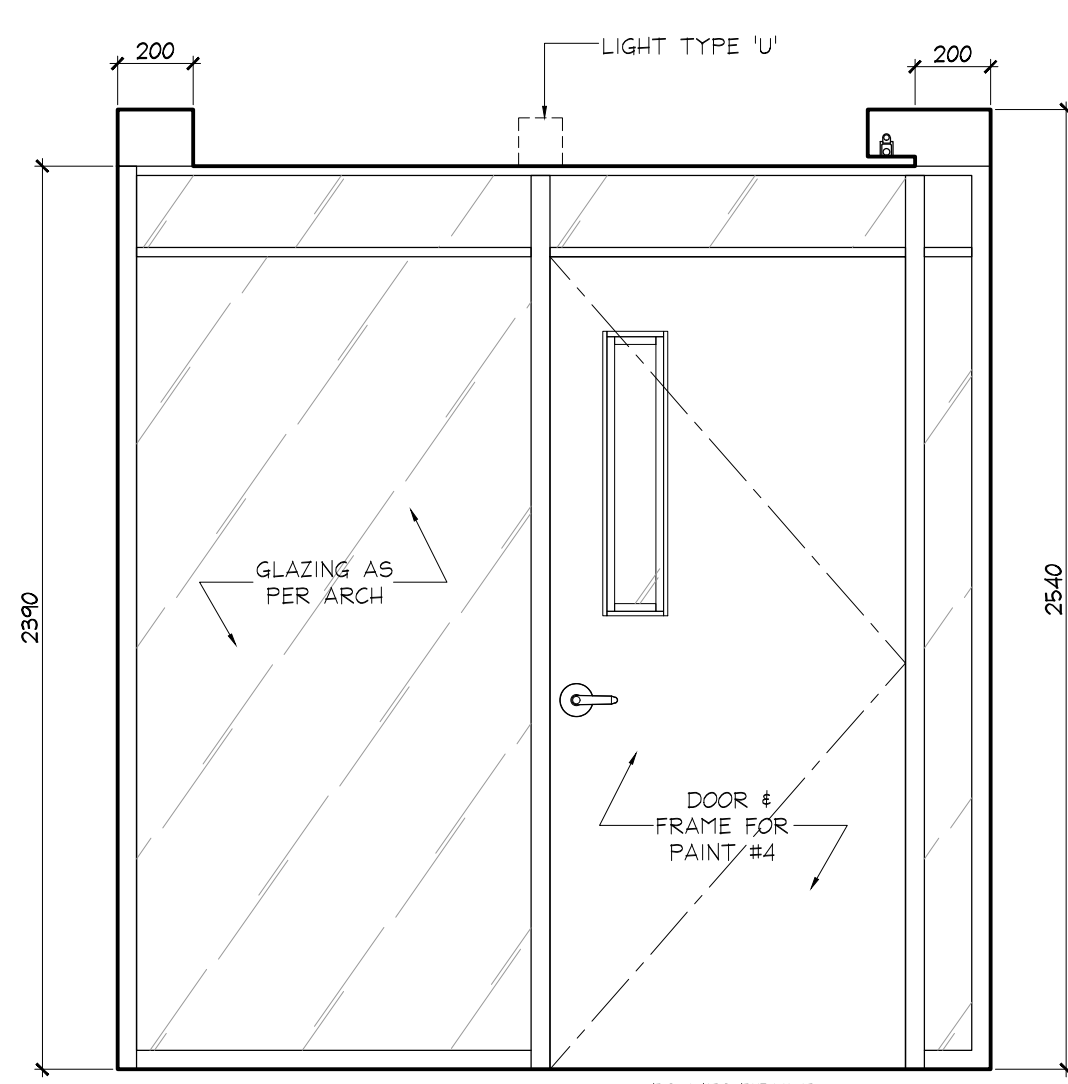


4 ELEVATION
ID2.0.1 P1 LEVEL
ELEVATOR LOBBY
SCALE 1:20

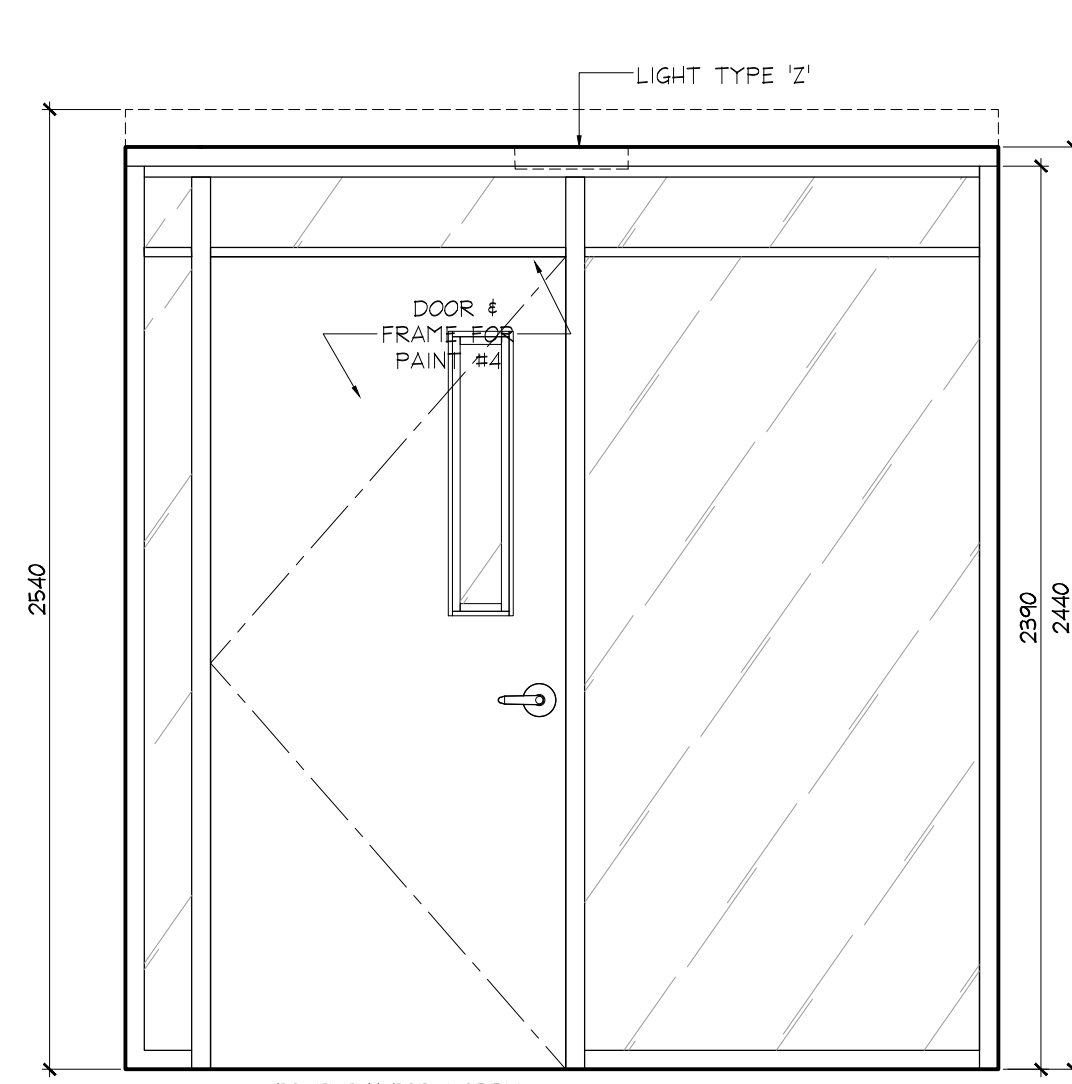


5 ELEVATION
ID2.0.1 P1 LEVEL
VESTIBULE
SCALE 1:20

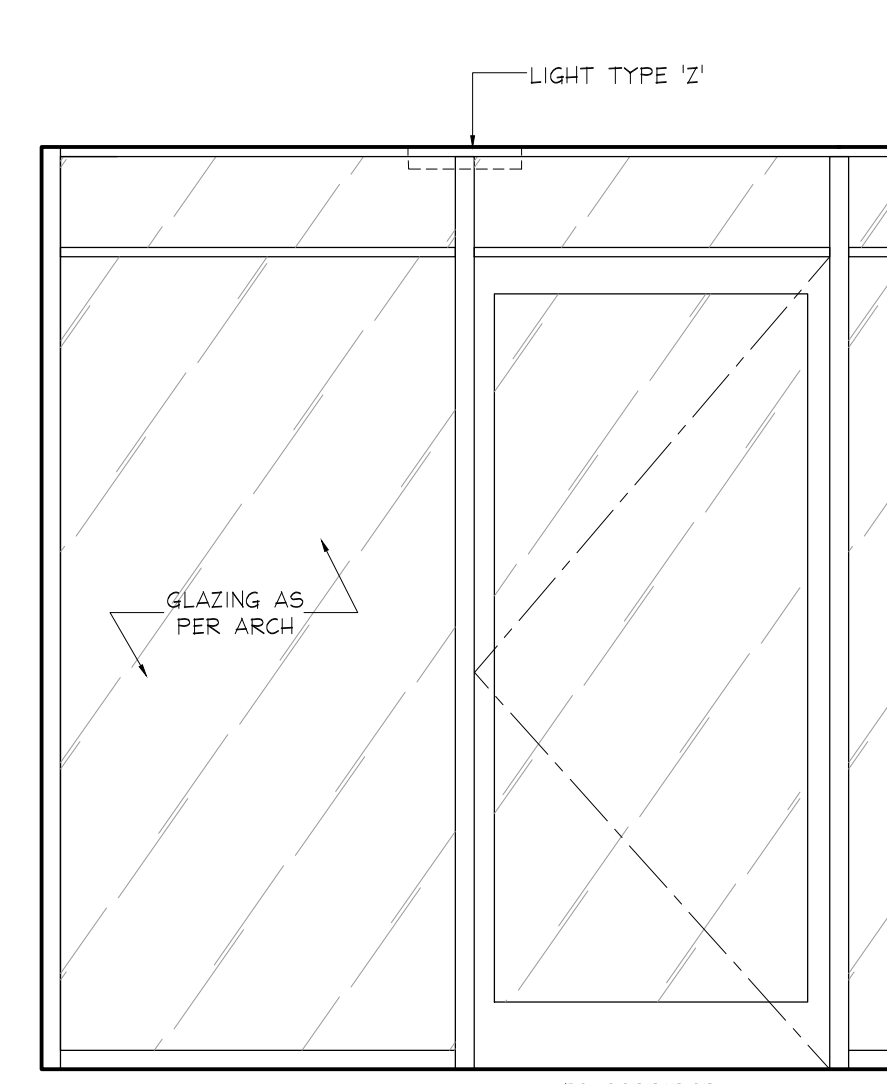

6 ELEVATION
ID2.0.1 P1 LEVEL
VESTIBULE
SCALE 1:20

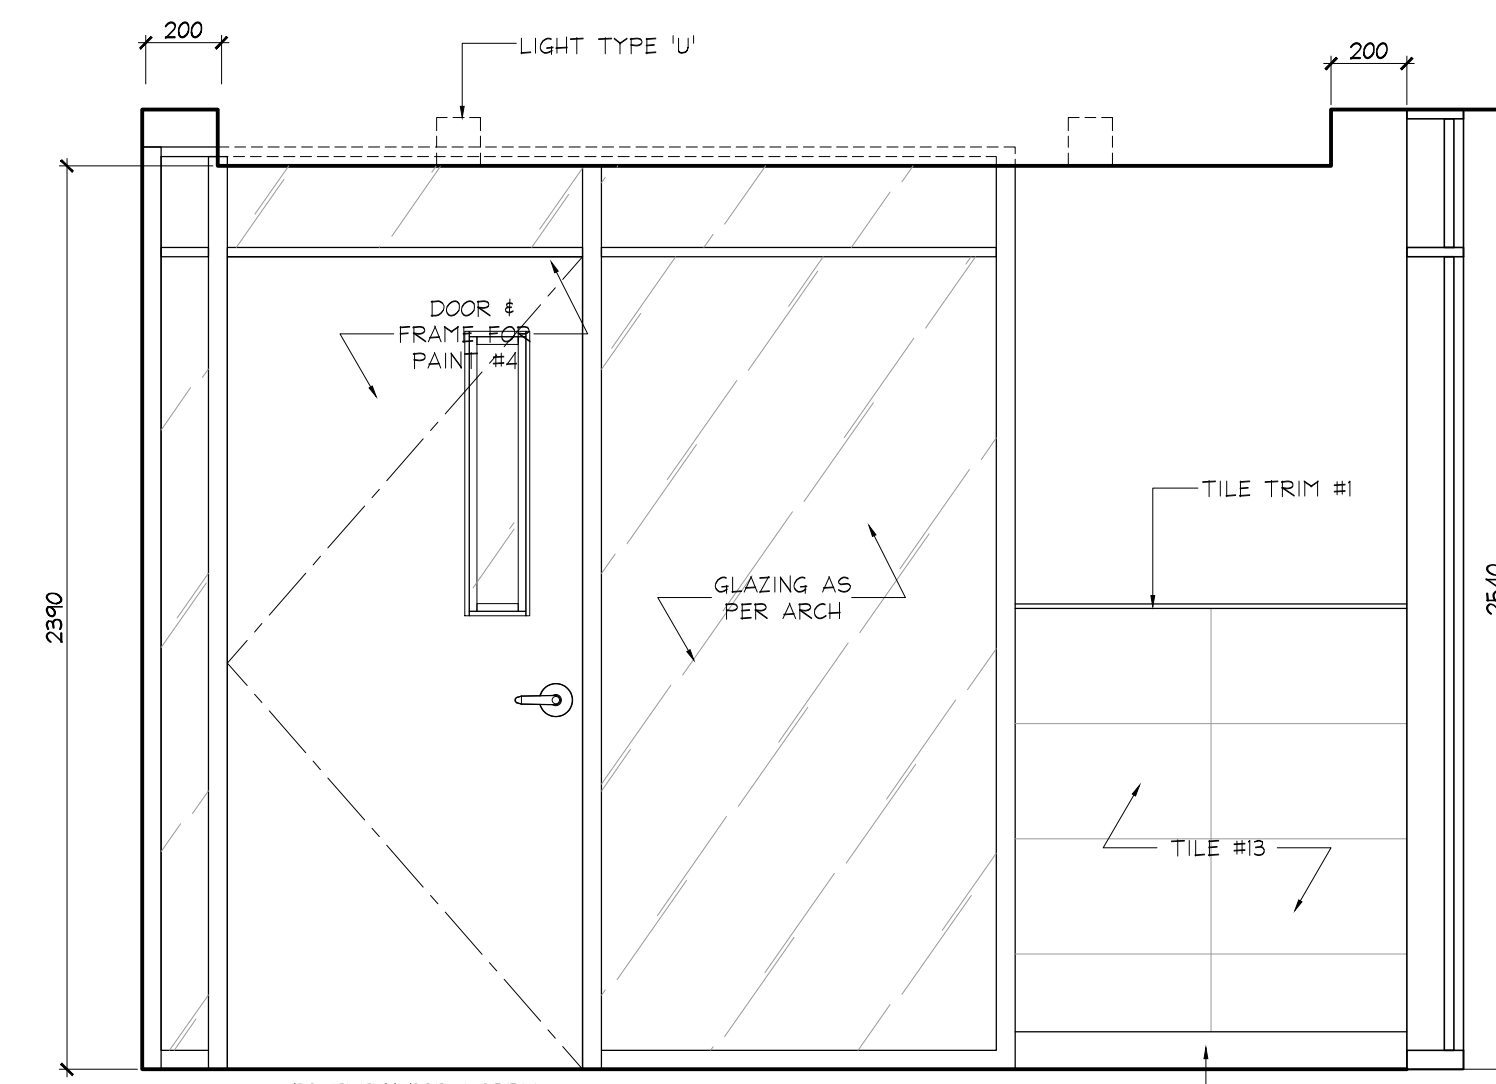

7 ELEVATION
ID2.0.1 P1 LEVEL
VESTIBULE
SCALE 1:20

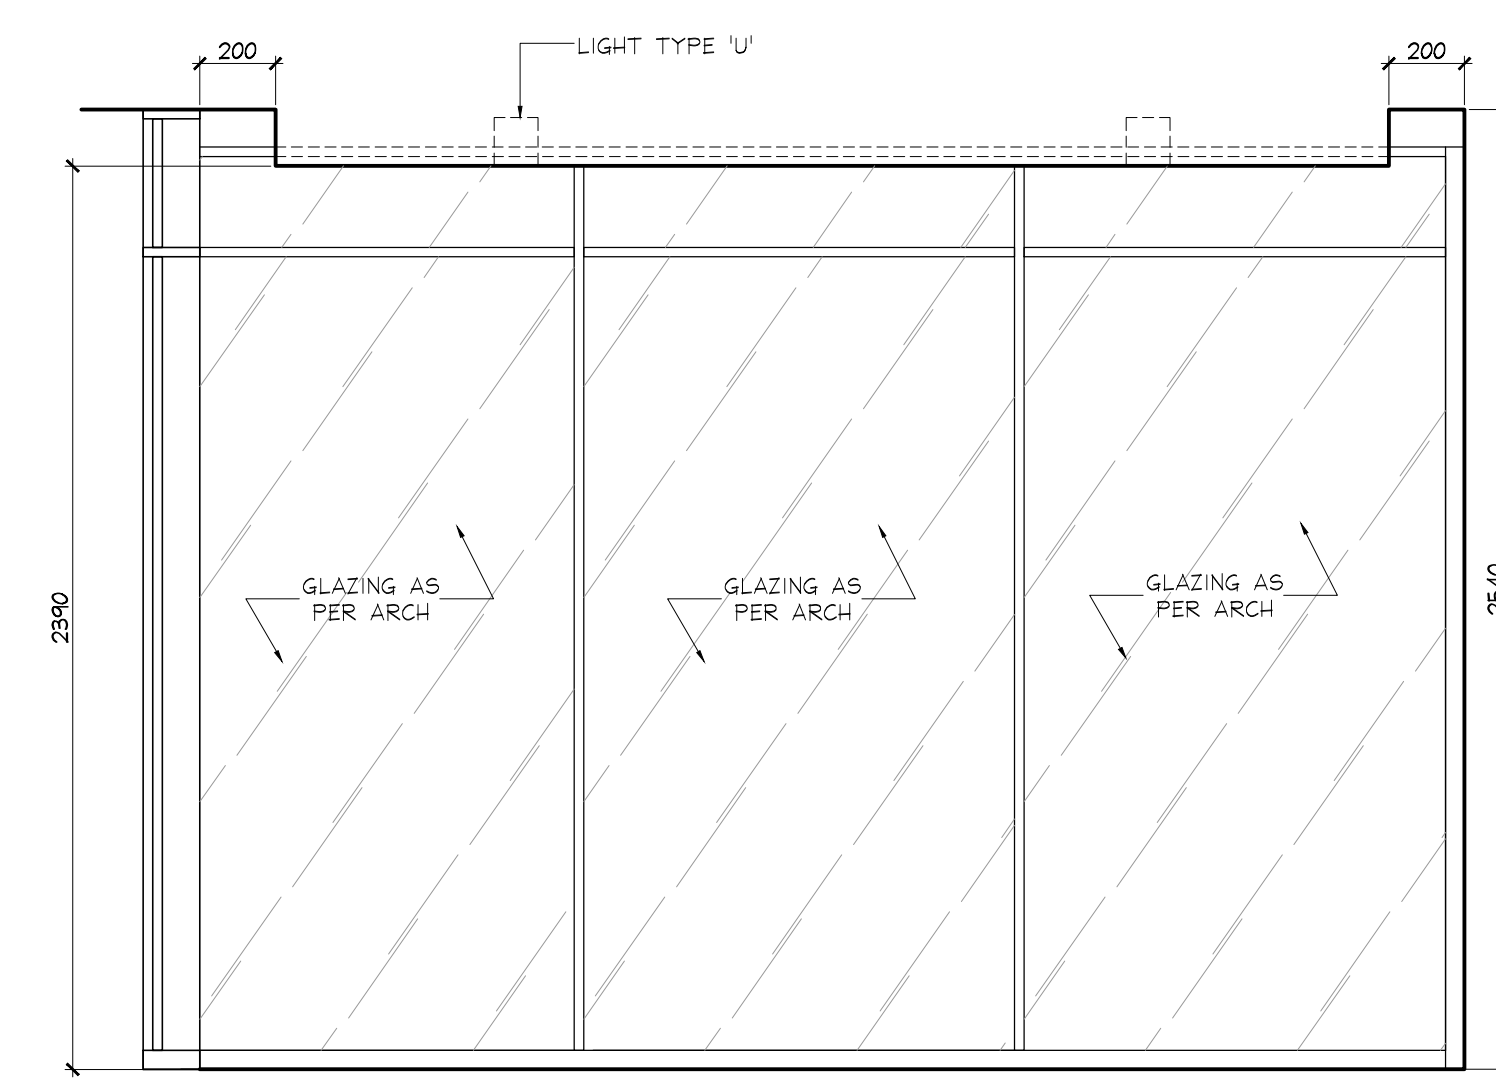

8 ELEVATION
ID2.0.1 P1 LEVEL
VESTIBULE
SCALE 1:20

DO NOT SCALE DRAWINGS.

CONTRACTOR MUST VERIFY ALL DRAWINGS, DIMENSIONS, DETAILS AND SPECIFICATIONS AND REPORT ANY DISCREPANCIES TO UNION 31 INC. BEFORE PROCEEDING WITH WORK. MATERIALS MAY NOT BE SUBSTITUTED WITHOUT WRITTEN APPROVAL FROM UNION 31 INC.

ALL DRAWINGS AND SPECIFICATIONS ARE INSTRUMENTS OF SERVICE AND THE PROPERTY OF UNION 31 INC. WHICH MUST BE RETURNED AT THE COMPLETION OF THE WORK.

PRINTED: 30-MAY-17

ISSUED FOR
AS-BUILT


NOTE:
INSTALL ALL BARRIER FREE
WASHROOM COMPONENTS
ACCORDING TO CBC
REQUIREMENTS

01	31 MAY / 17	ISSUED FOR AS-BUILT	SV
NO.	DATE	COMMENTS	INI
REVISIONS:			


UNION31

UNION31 INC.
183 BATHURST STREET, STE. 201
TORONTO, ON, M5T 2R7, CANADA
TEL: 416-597-1576 FAX: 416-597-2139


PROJECT NAME: ALEXANDRA PARK MAIN BUILDING BLOCK 11 ON, Canada	
PROJECT NO.: 13-949	
DRAWINGS: PARKING LEVEL ELEVATIONS	
DATE STARTED: 07 AUG / 13	DRAWING NO.: ID
SCALE: 1 : 20	
DRAWN BY: AP	2.0.2
APPROVED BY: KC	

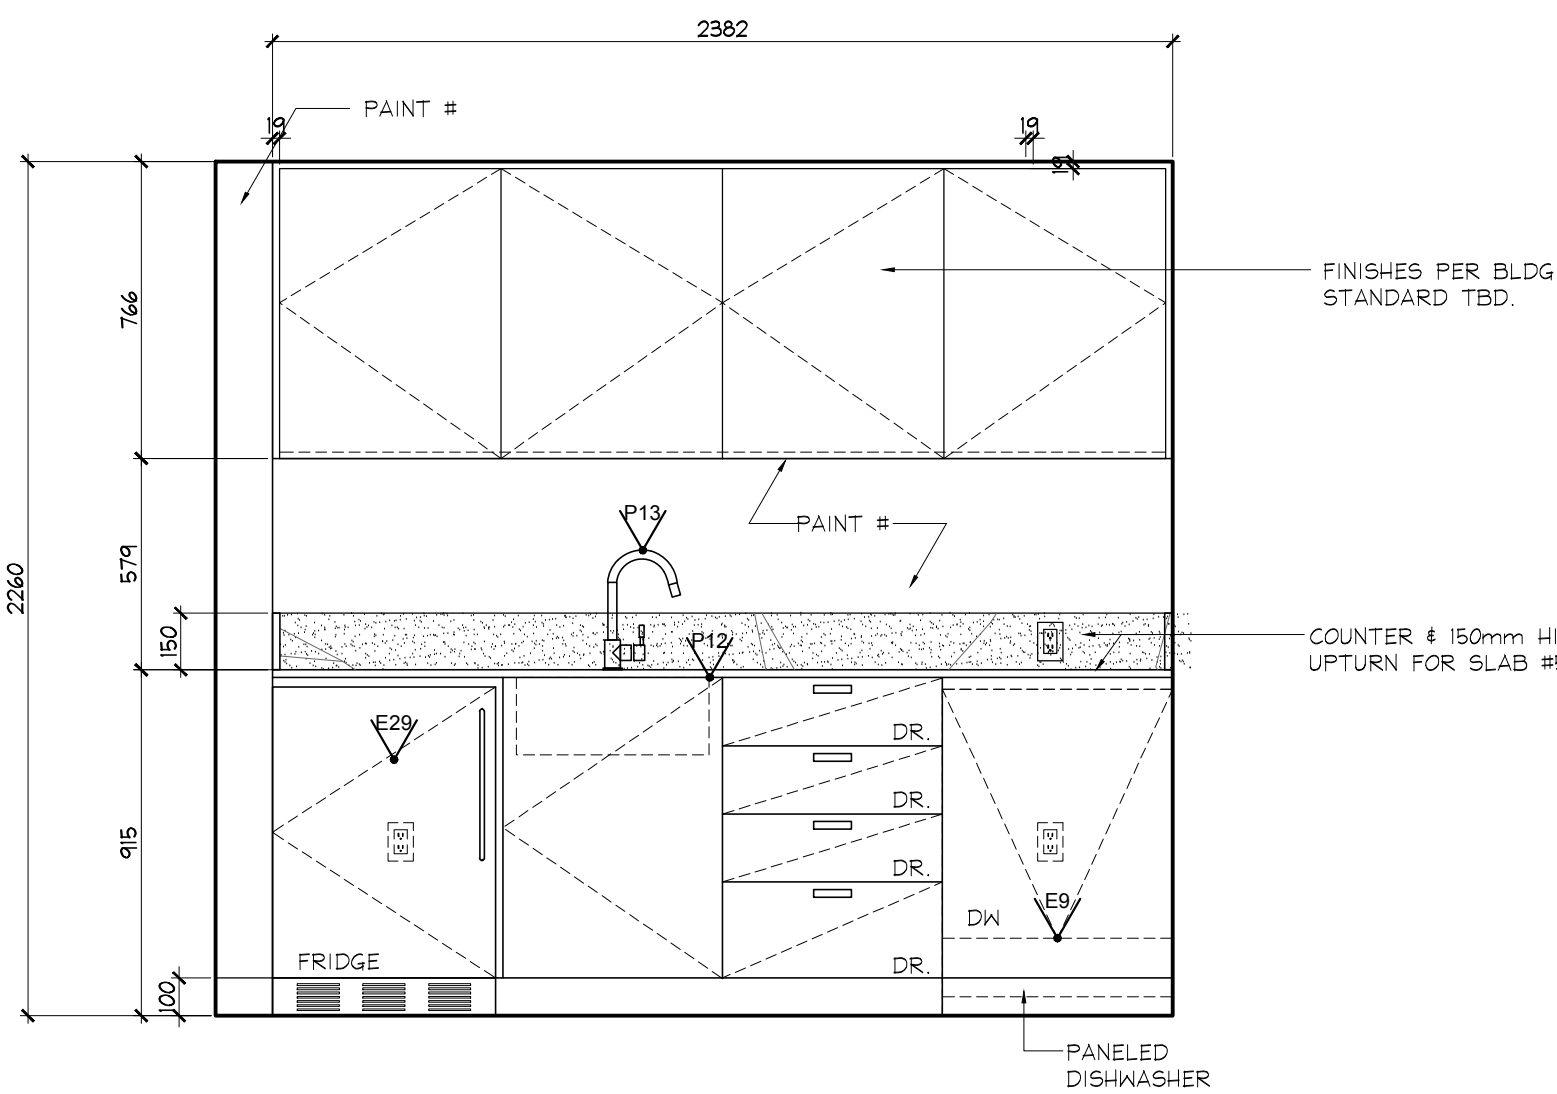


1 ELEVATION
ID2.0.2 P1 LEVEL
STAFF LUNCH ROOM
SCALE 1:20

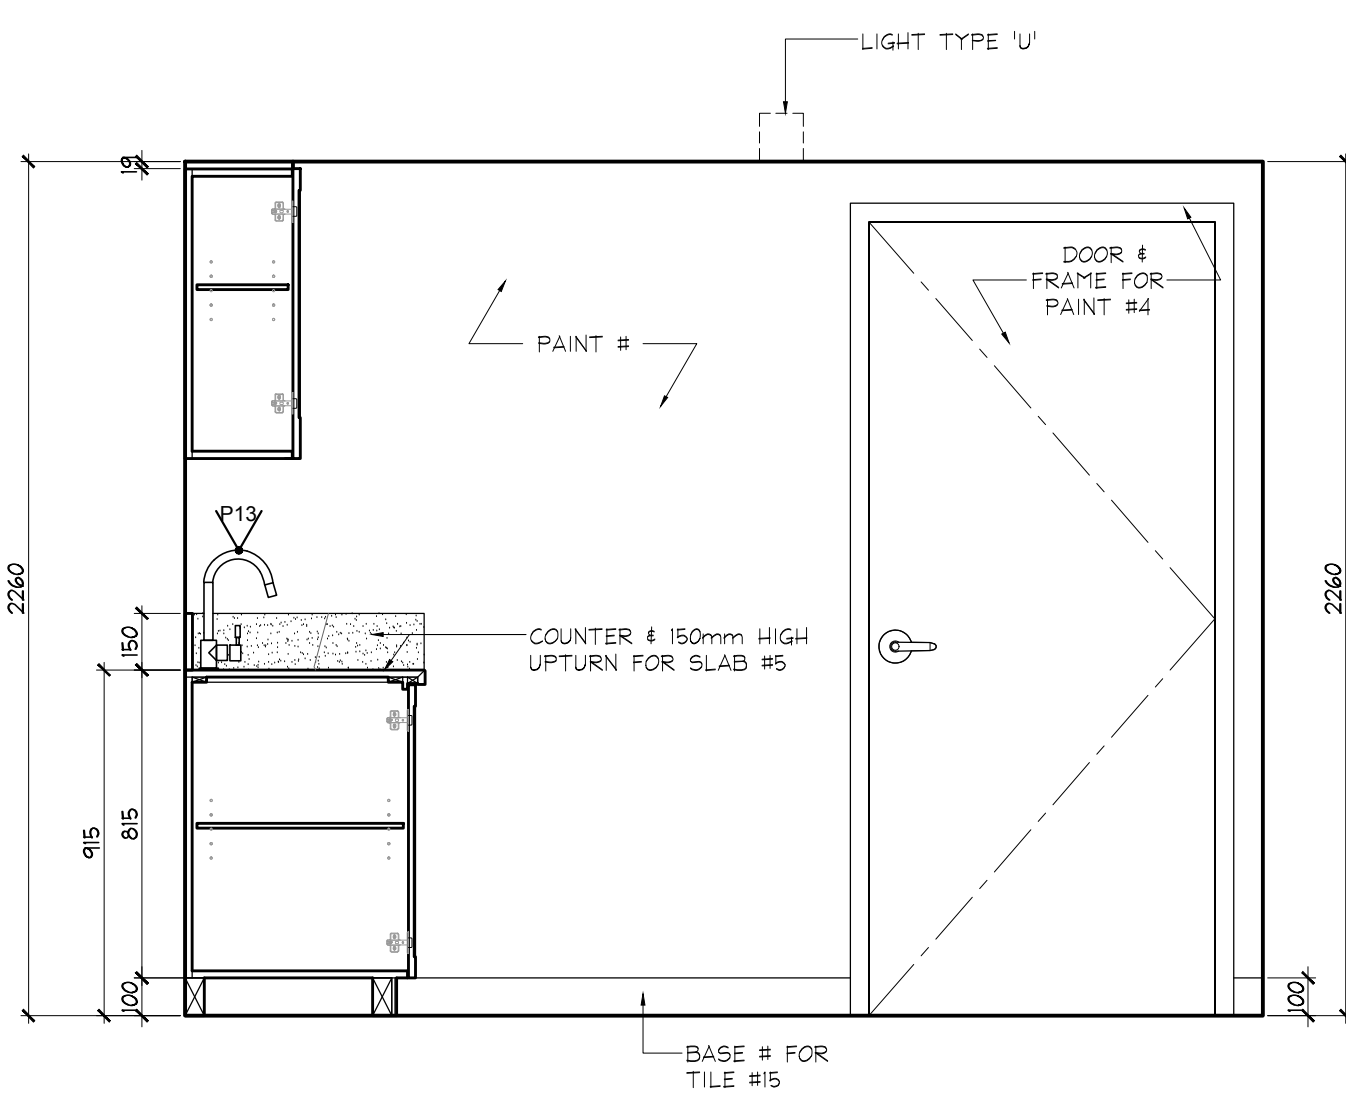


2 ELEVATION
ID2.0.2 P1 LEVEL
STAFF LUNCH ROOM
SCALE 1:20

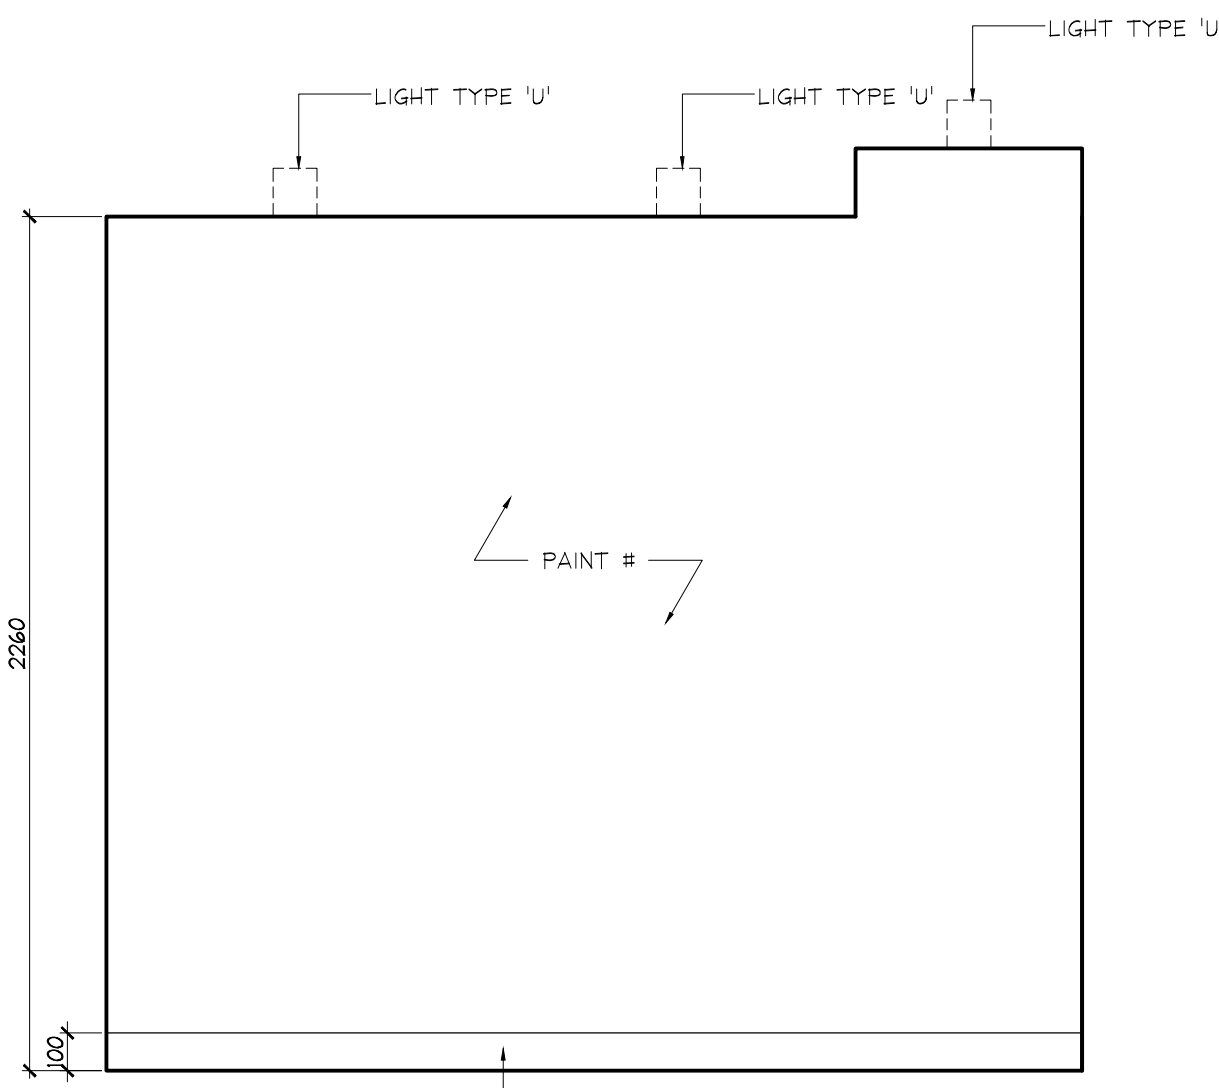


3 ELEVATION
ID2.0.2 P1 LEVEL
STAFF LUNCH ROOM
SCALE 1:20

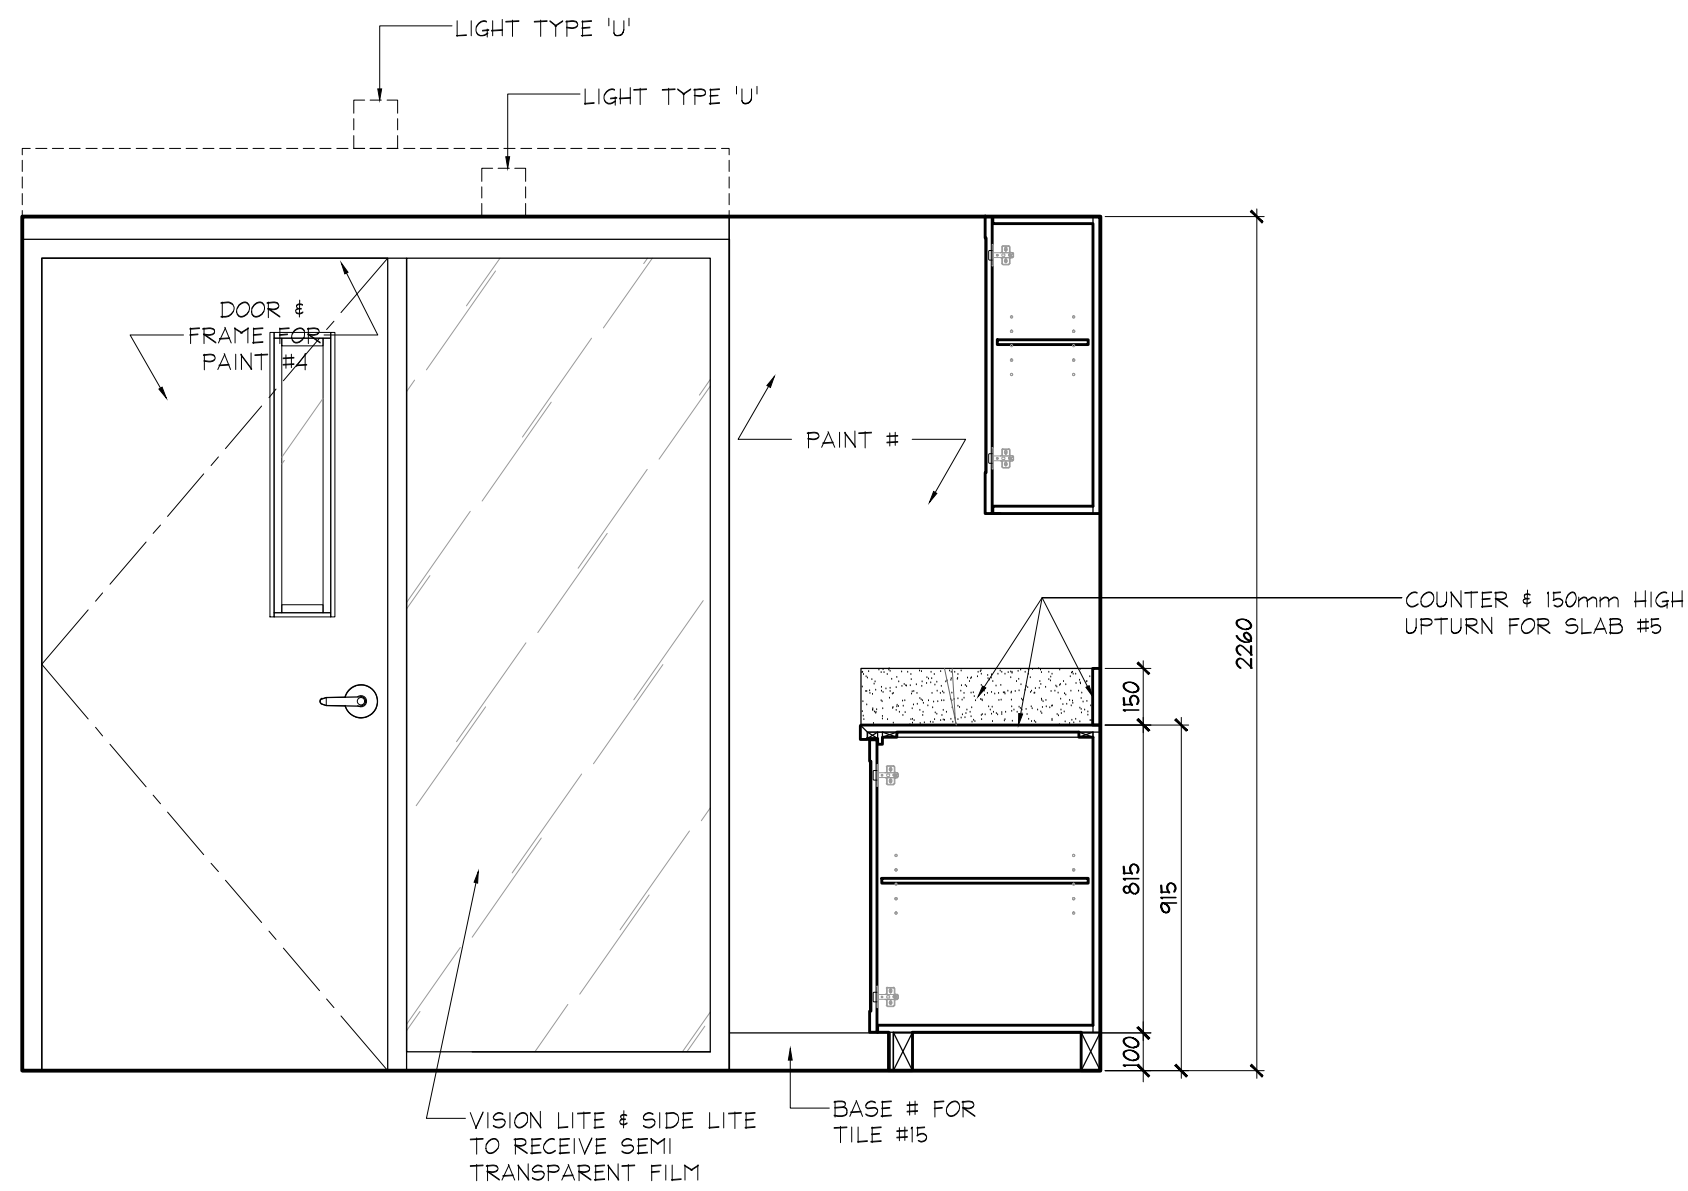


4 ELEVATION
ID2.0.2 P1 LEVEL
STAFF LUNCH ROOM
SCALE 1:20

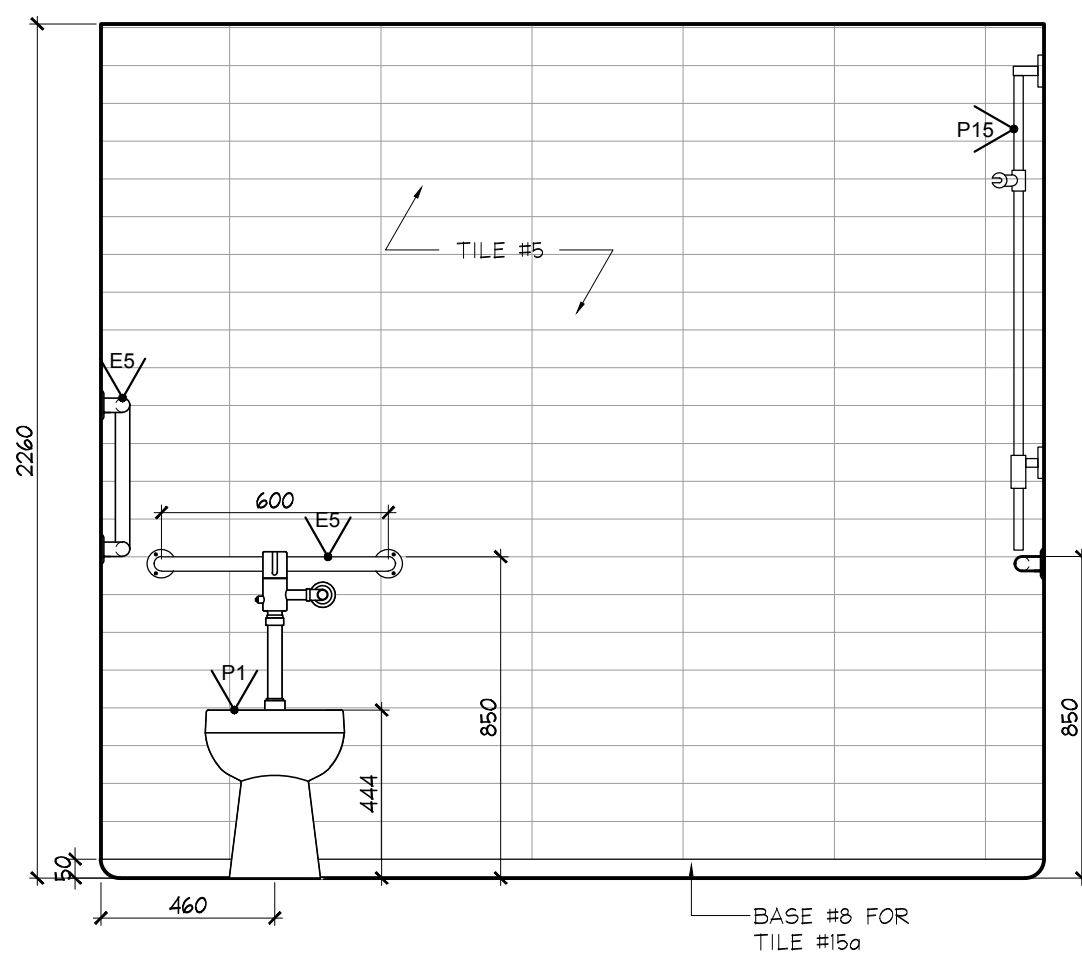


5 ELEVATION
ID2.0.2 P1 LEVEL
STAFF W/ CH / SHOWER ROOM
SCALE 1:20

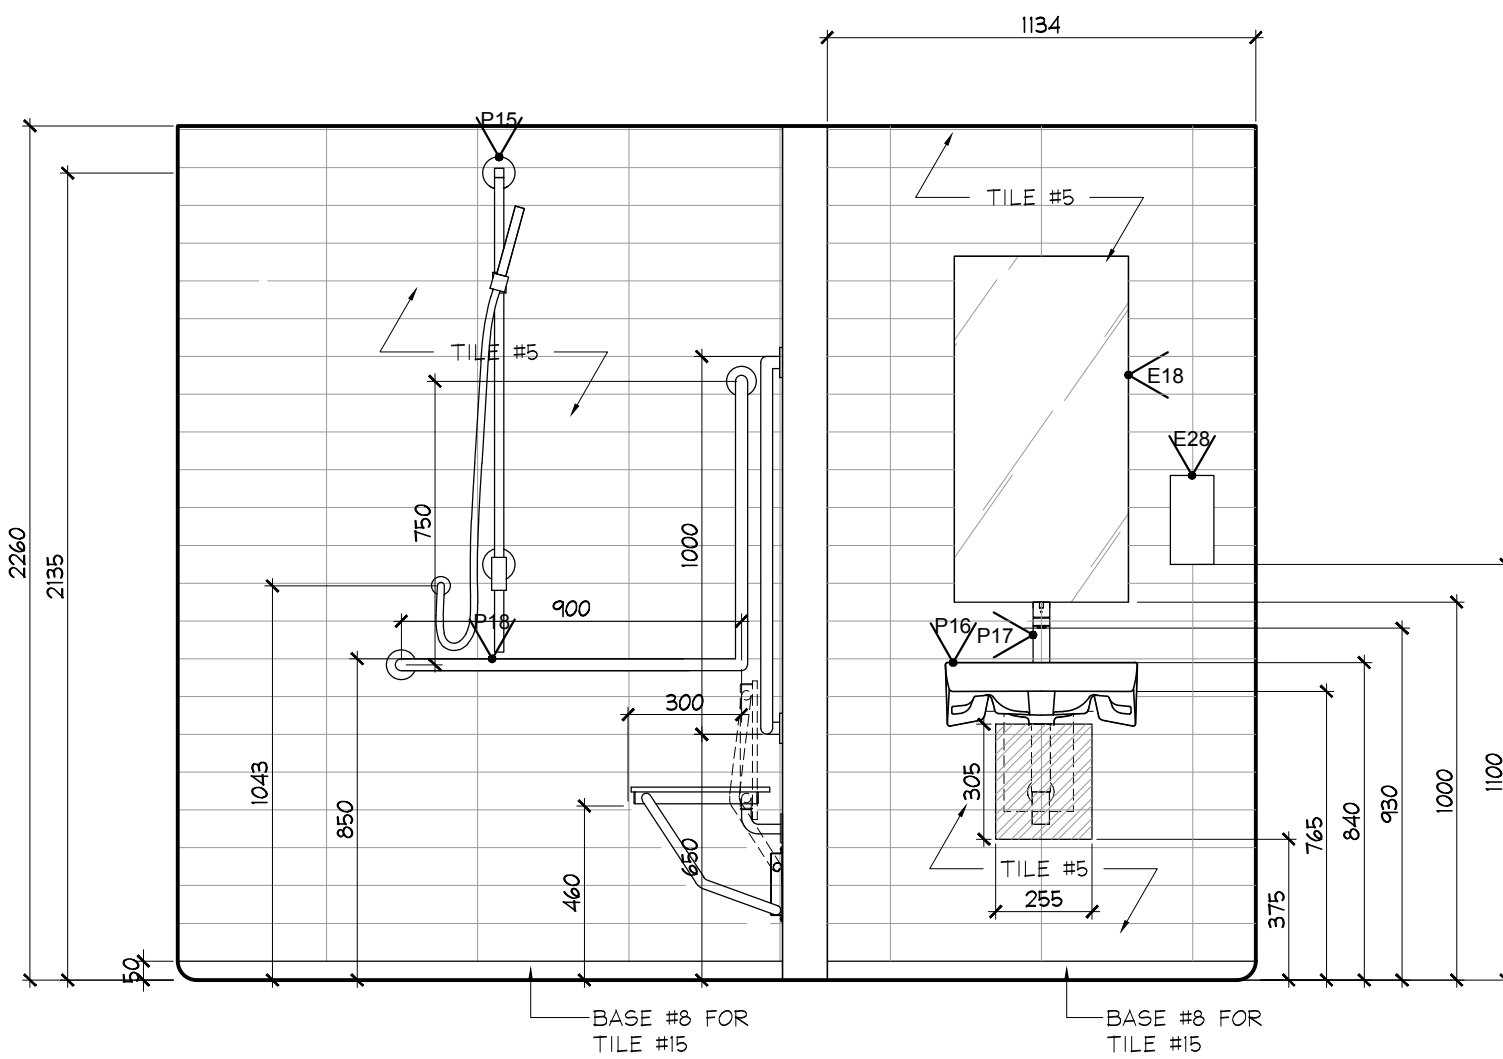


6 ELEVATION
ID2.0.2 P1 LEVEL
STAFF W/ CH / SHOWER ROOM
SCALE 1:20

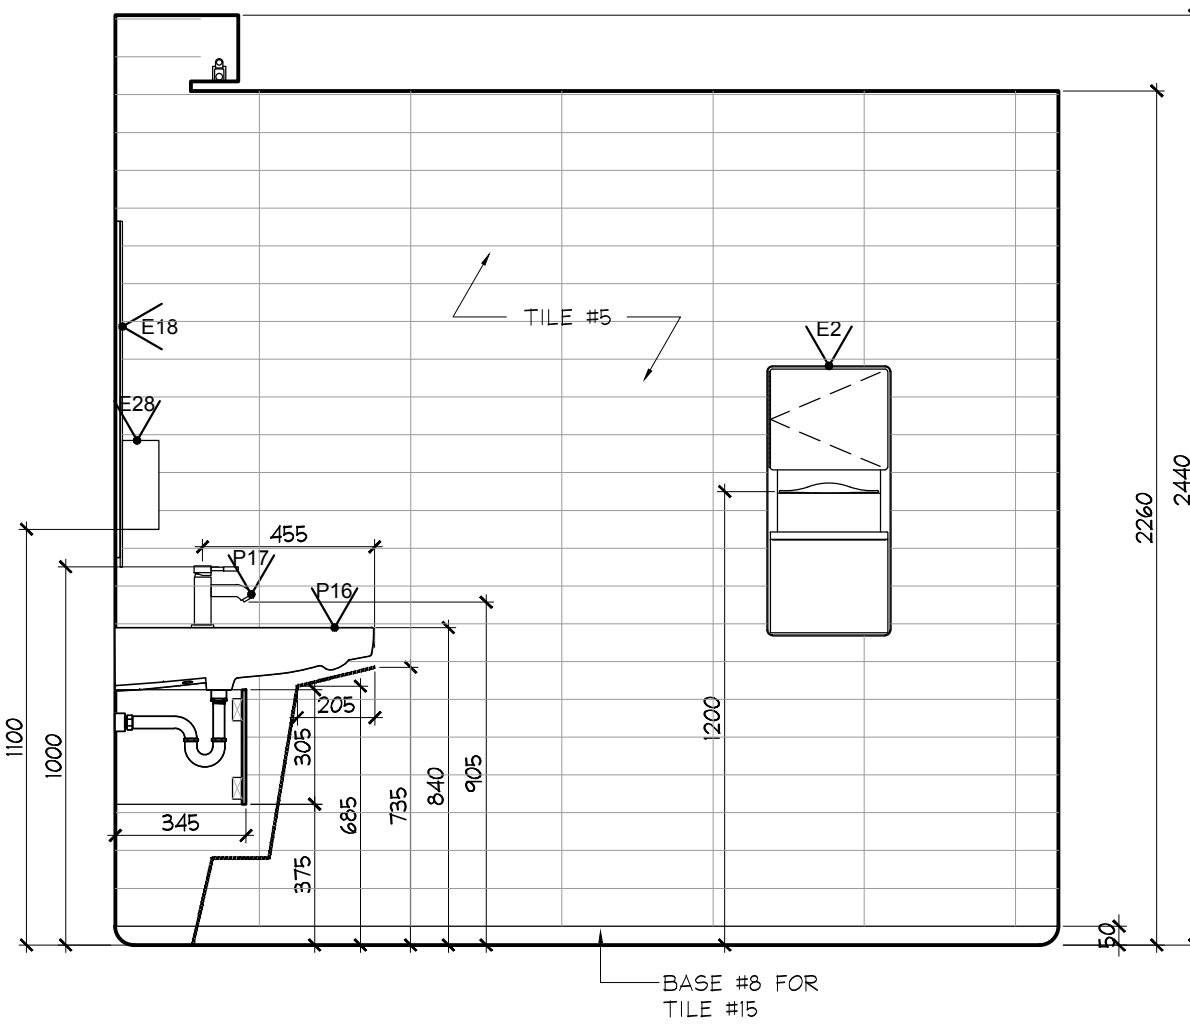


7 ELEVATION
ID2.0.2 P1 LEVEL
STAFF W/ CH / SHOWER ROOM
SCALE 1:20

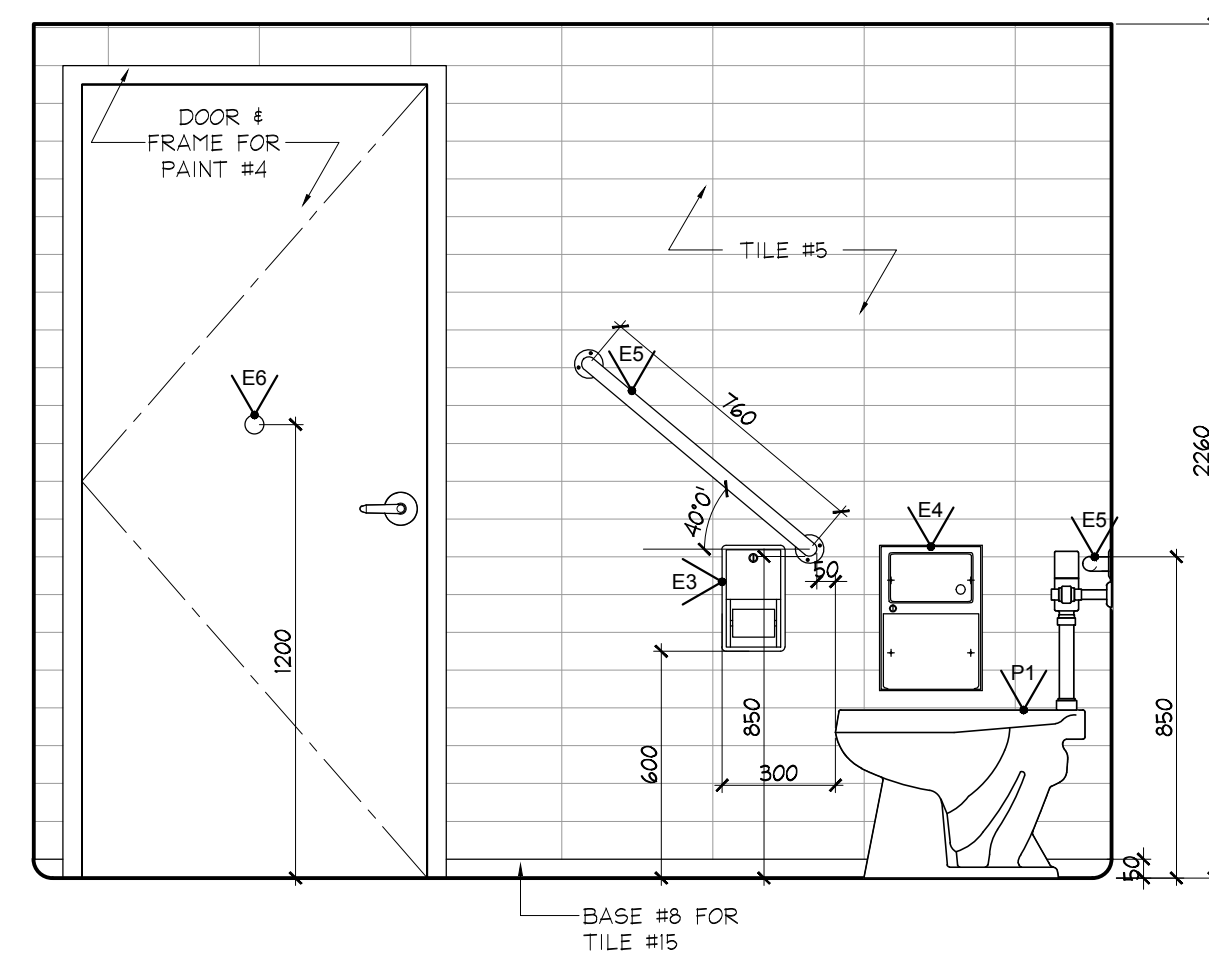


8 ELEVATION
ID2.0.2 P1 LEVEL
STAFF W/ CH / SHOWER ROOM
SCALE 1:20

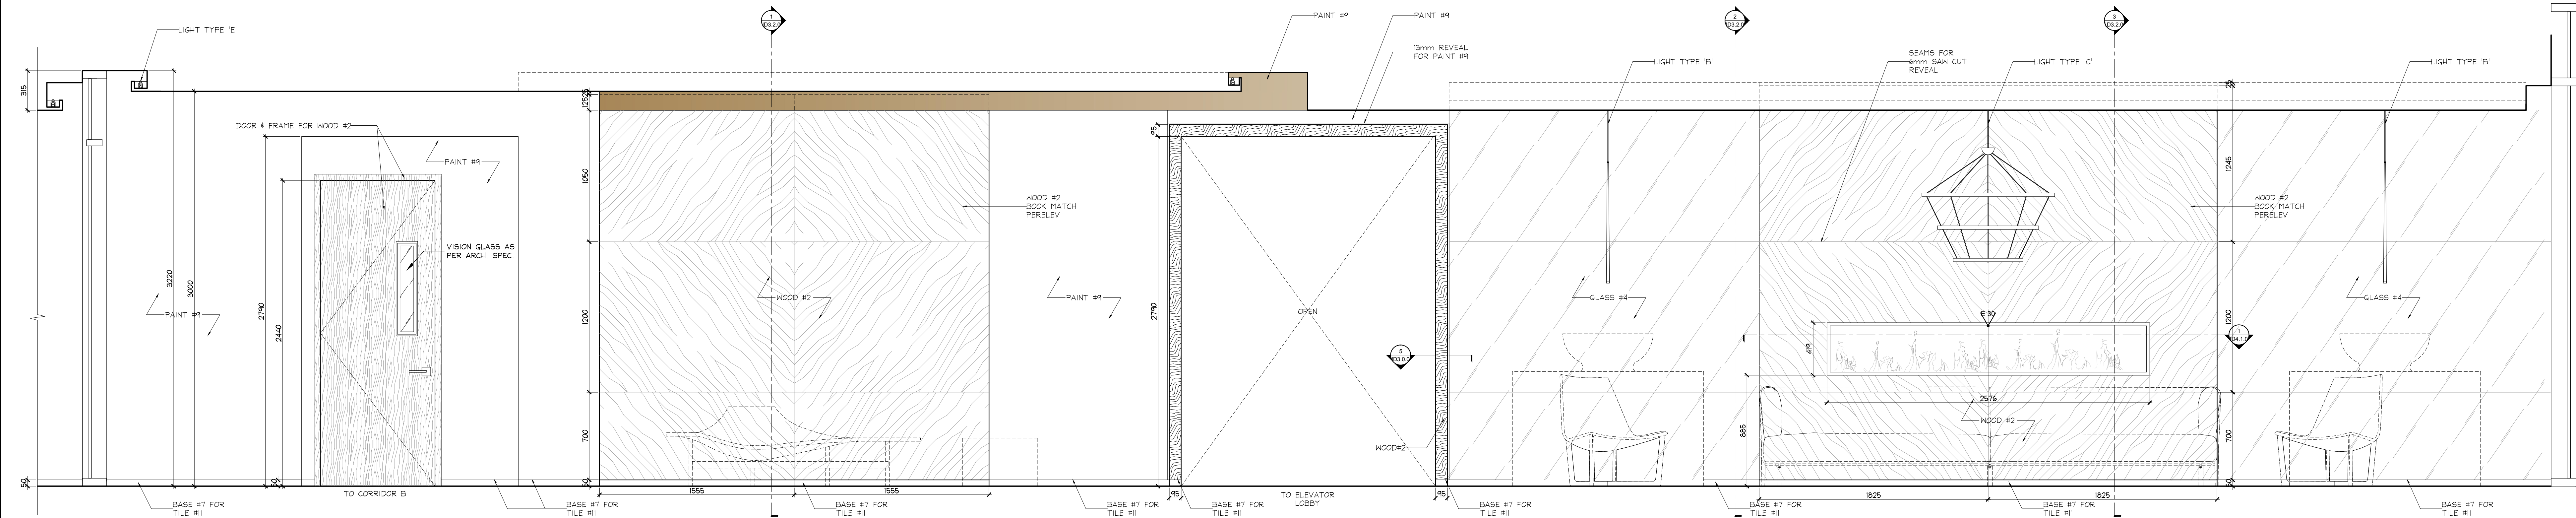


1
ELEVATION
GROUND FLOOR
RESIDENTIAL LOBBY
SCALE 1:20

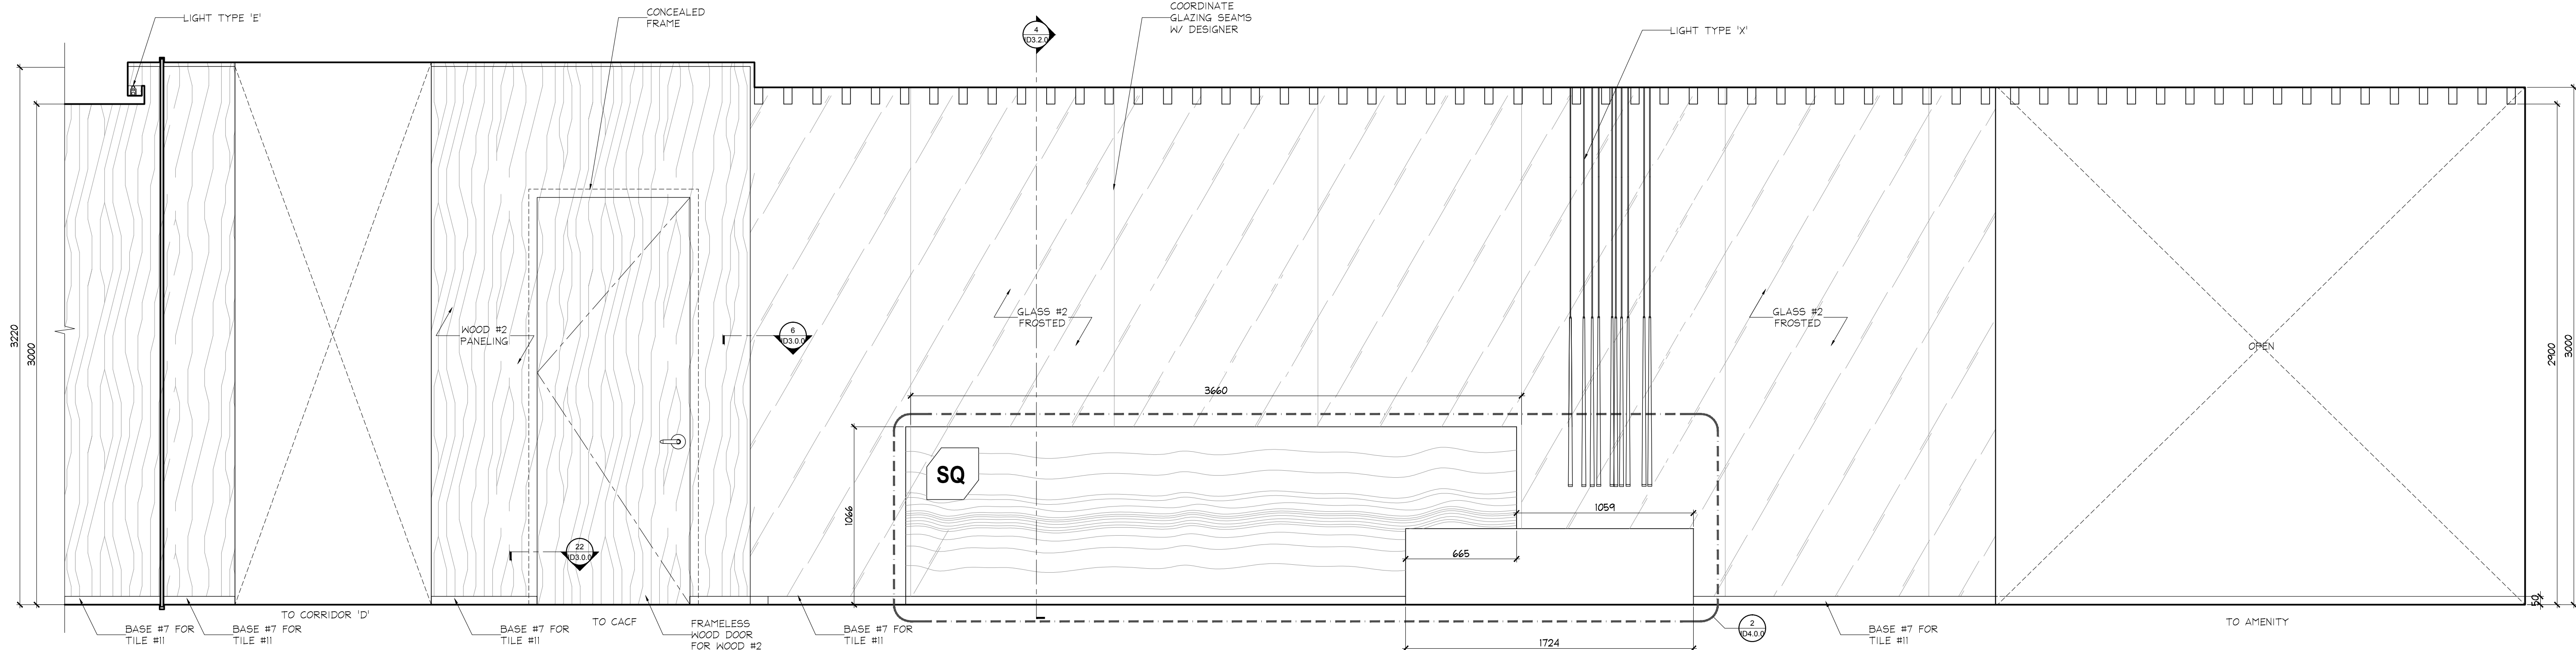


2
ELEVATION
GROUND FLOOR
RESIDENTIAL LOBBY
SCALE 1:20

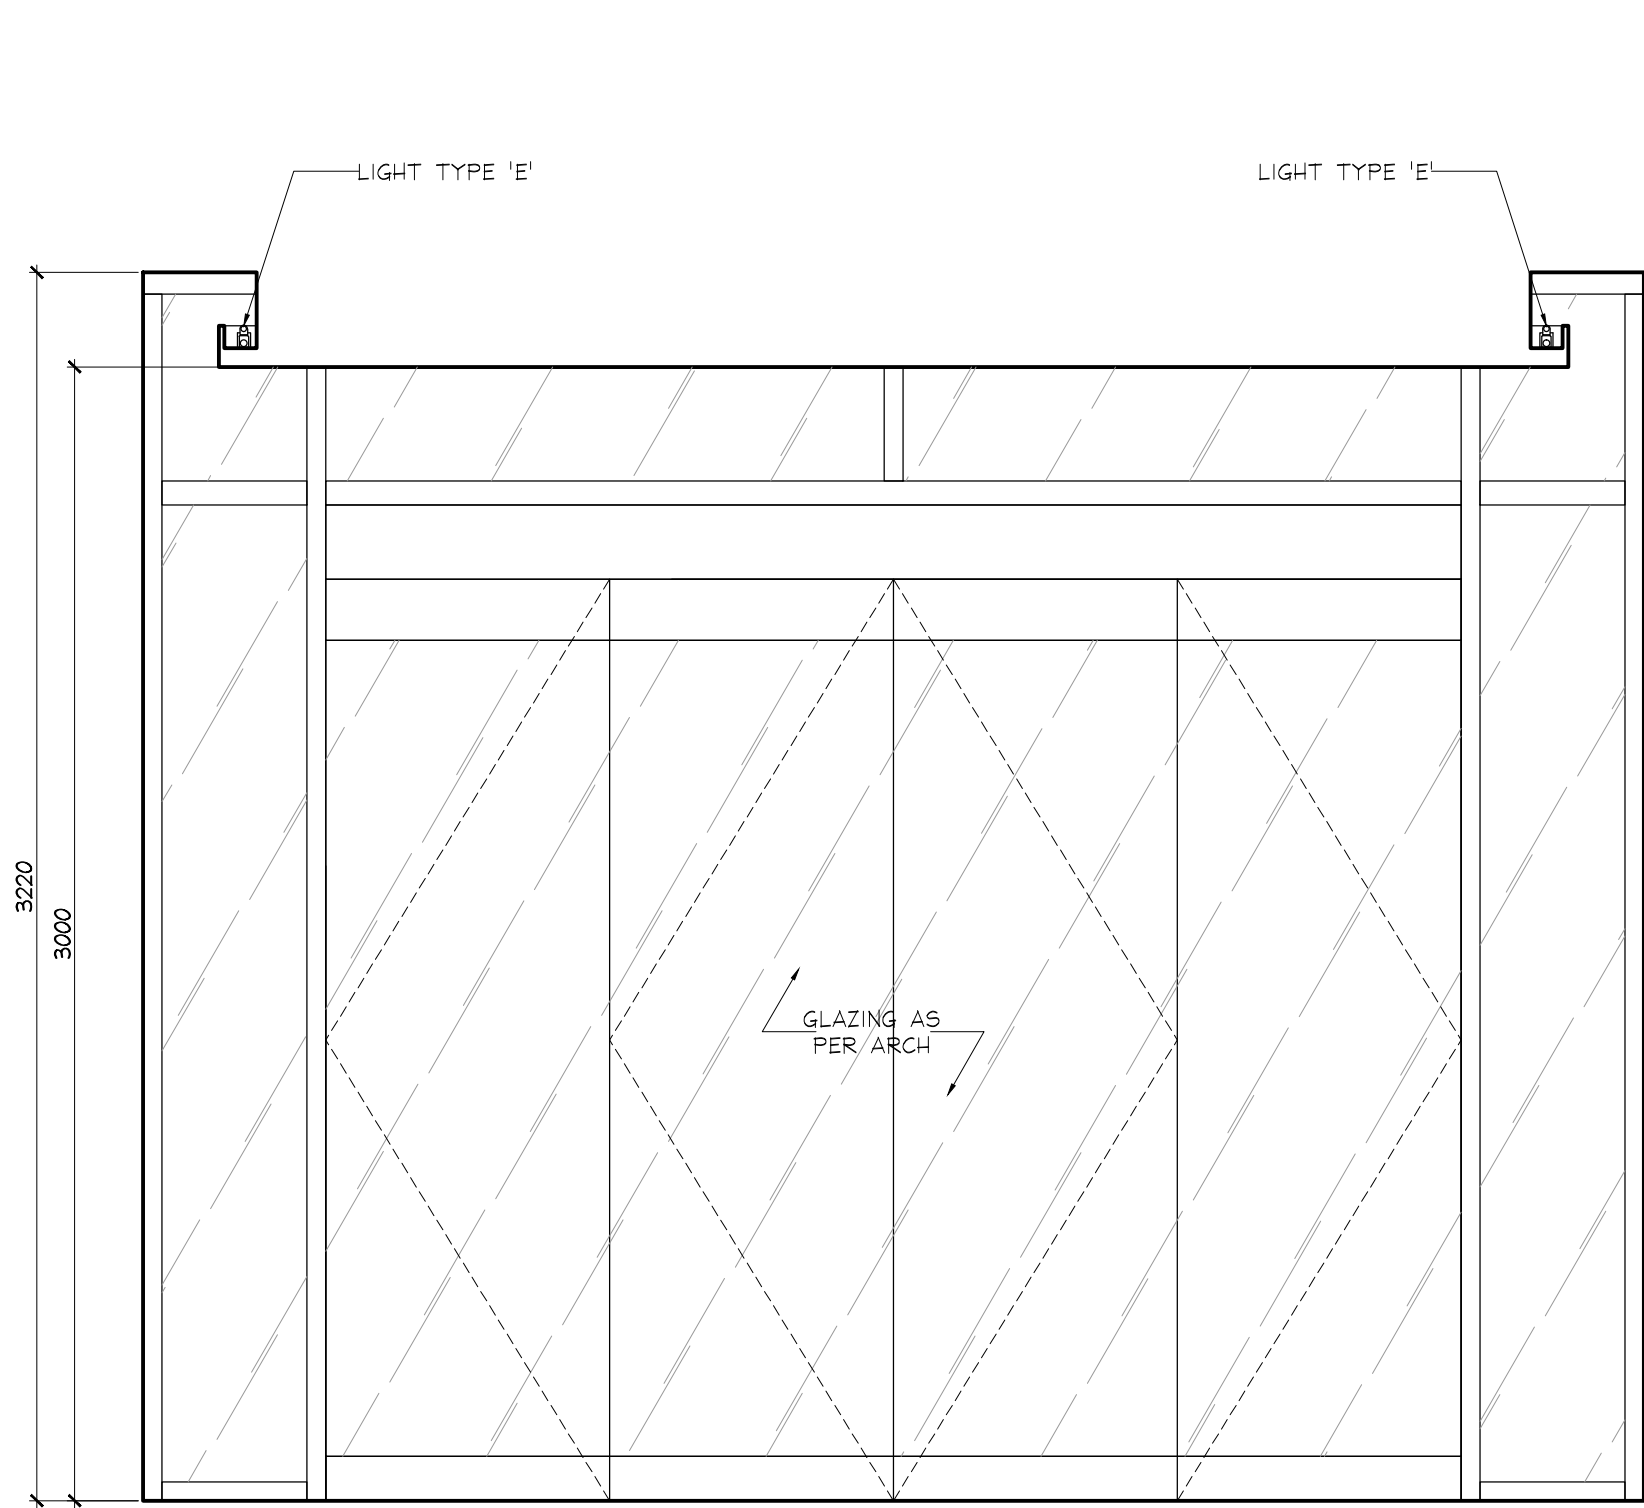


3
ELEVATION
GROUND FLOOR
EAST VESTIBULE
SCALE 1:20

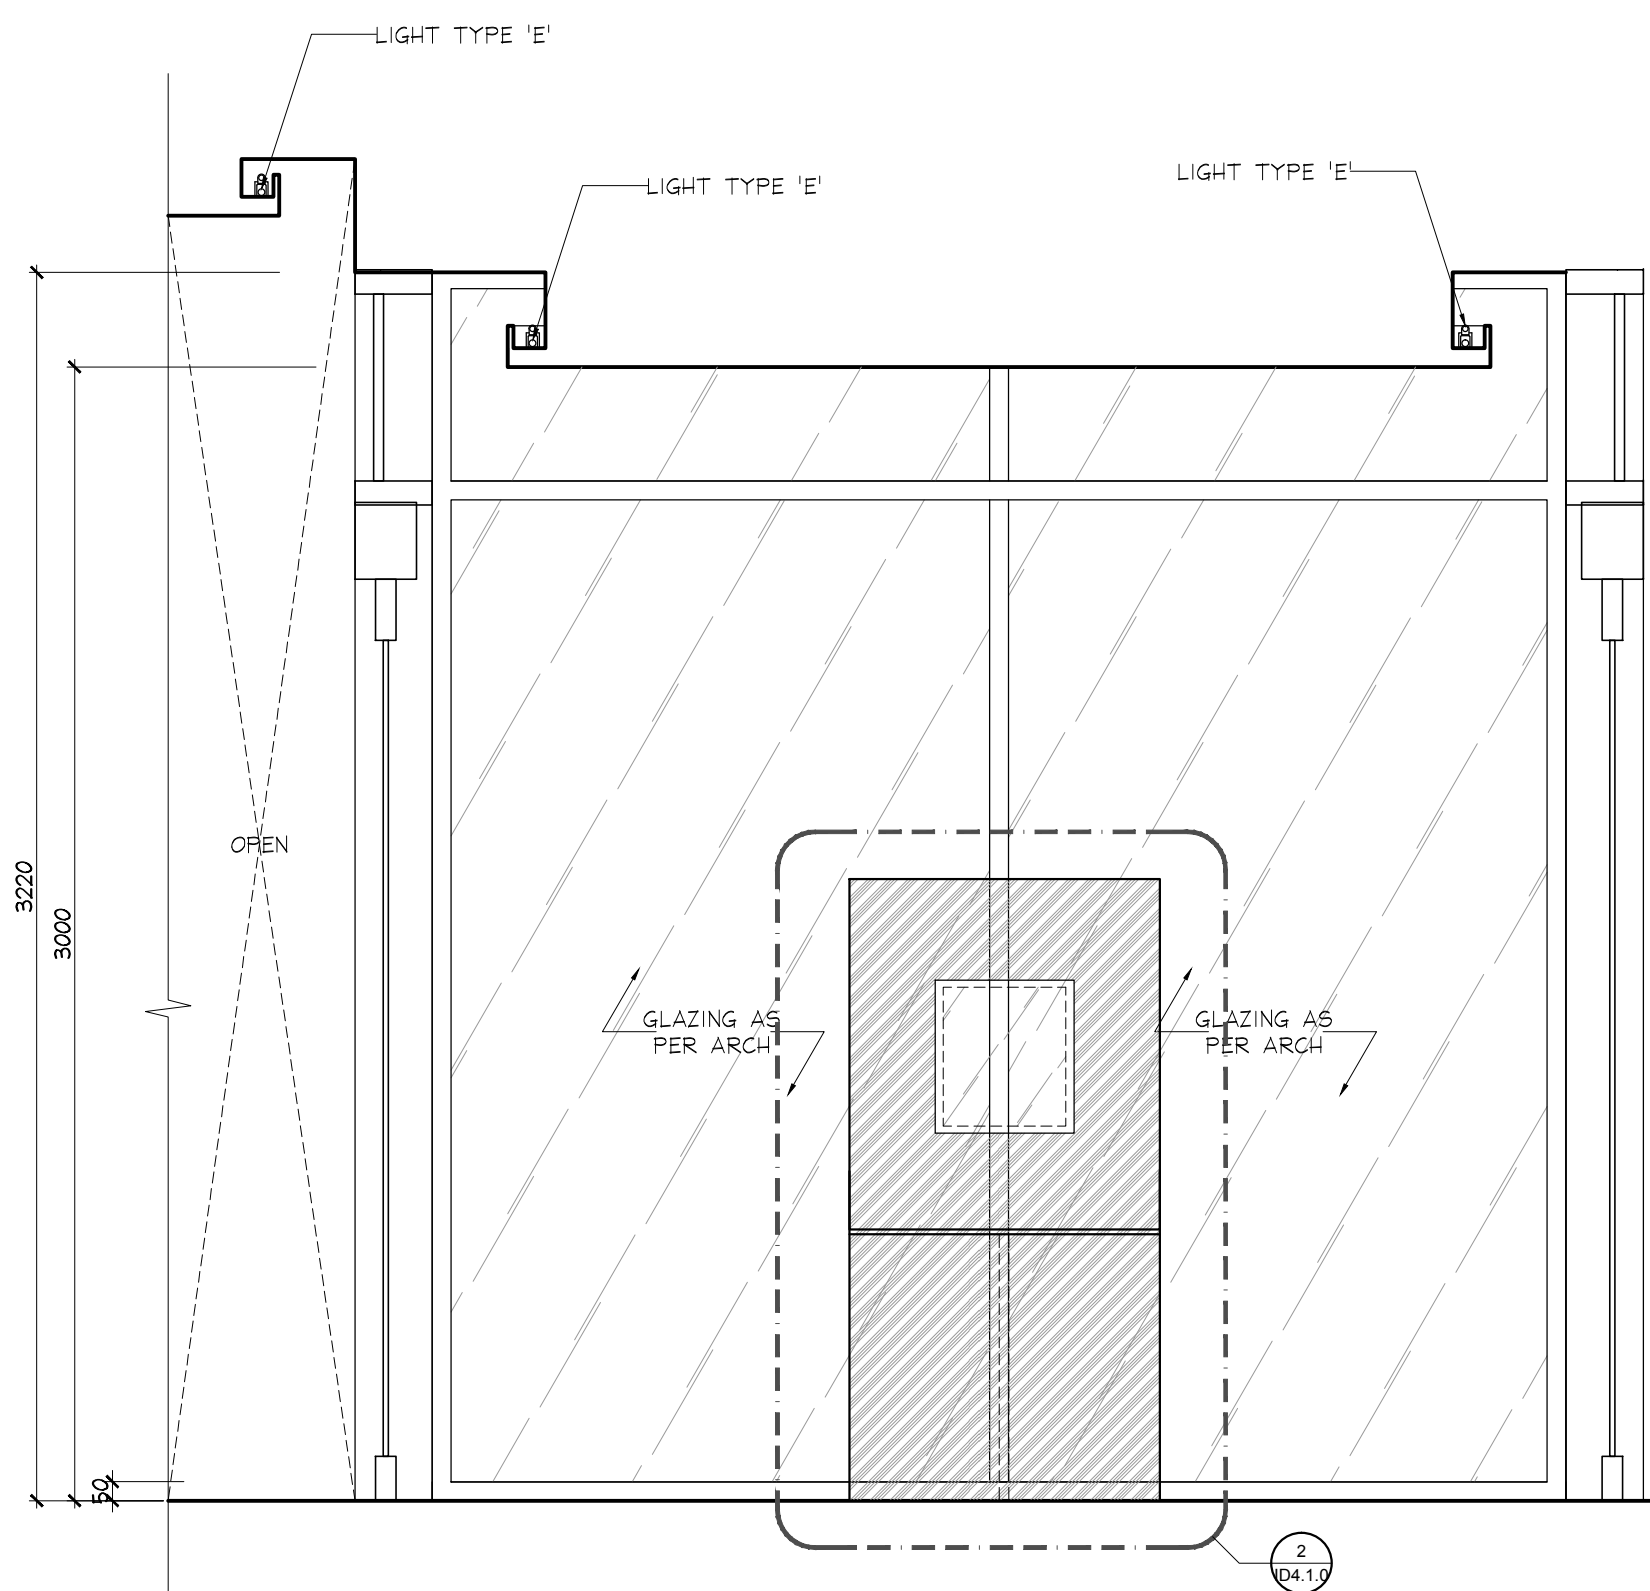

4
ELEVATION
GROUND FLOOR
EAST VESTIBULE
SCALE 1:20

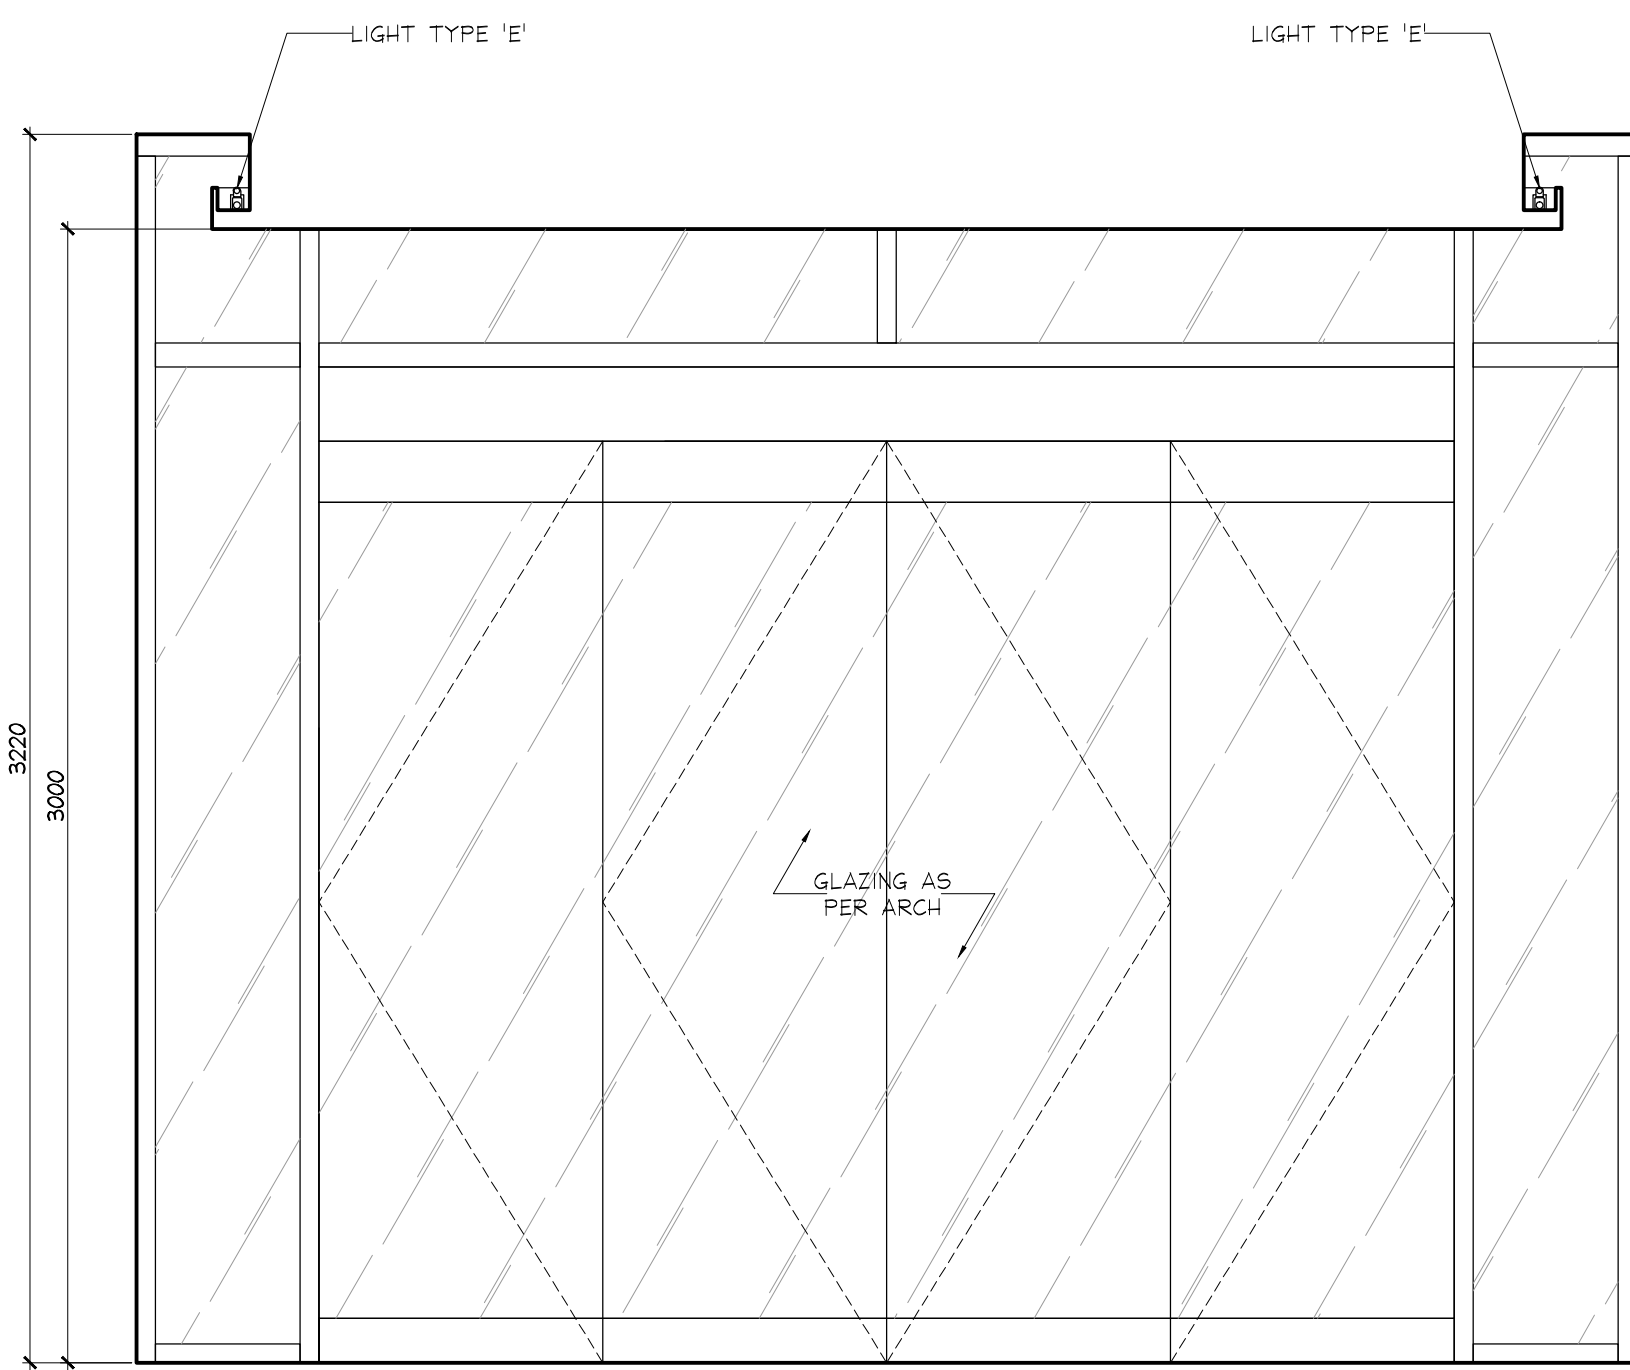

5
ELEVATION
GROUND FLOOR
EAST VESTIBULE
SCALE 1:20

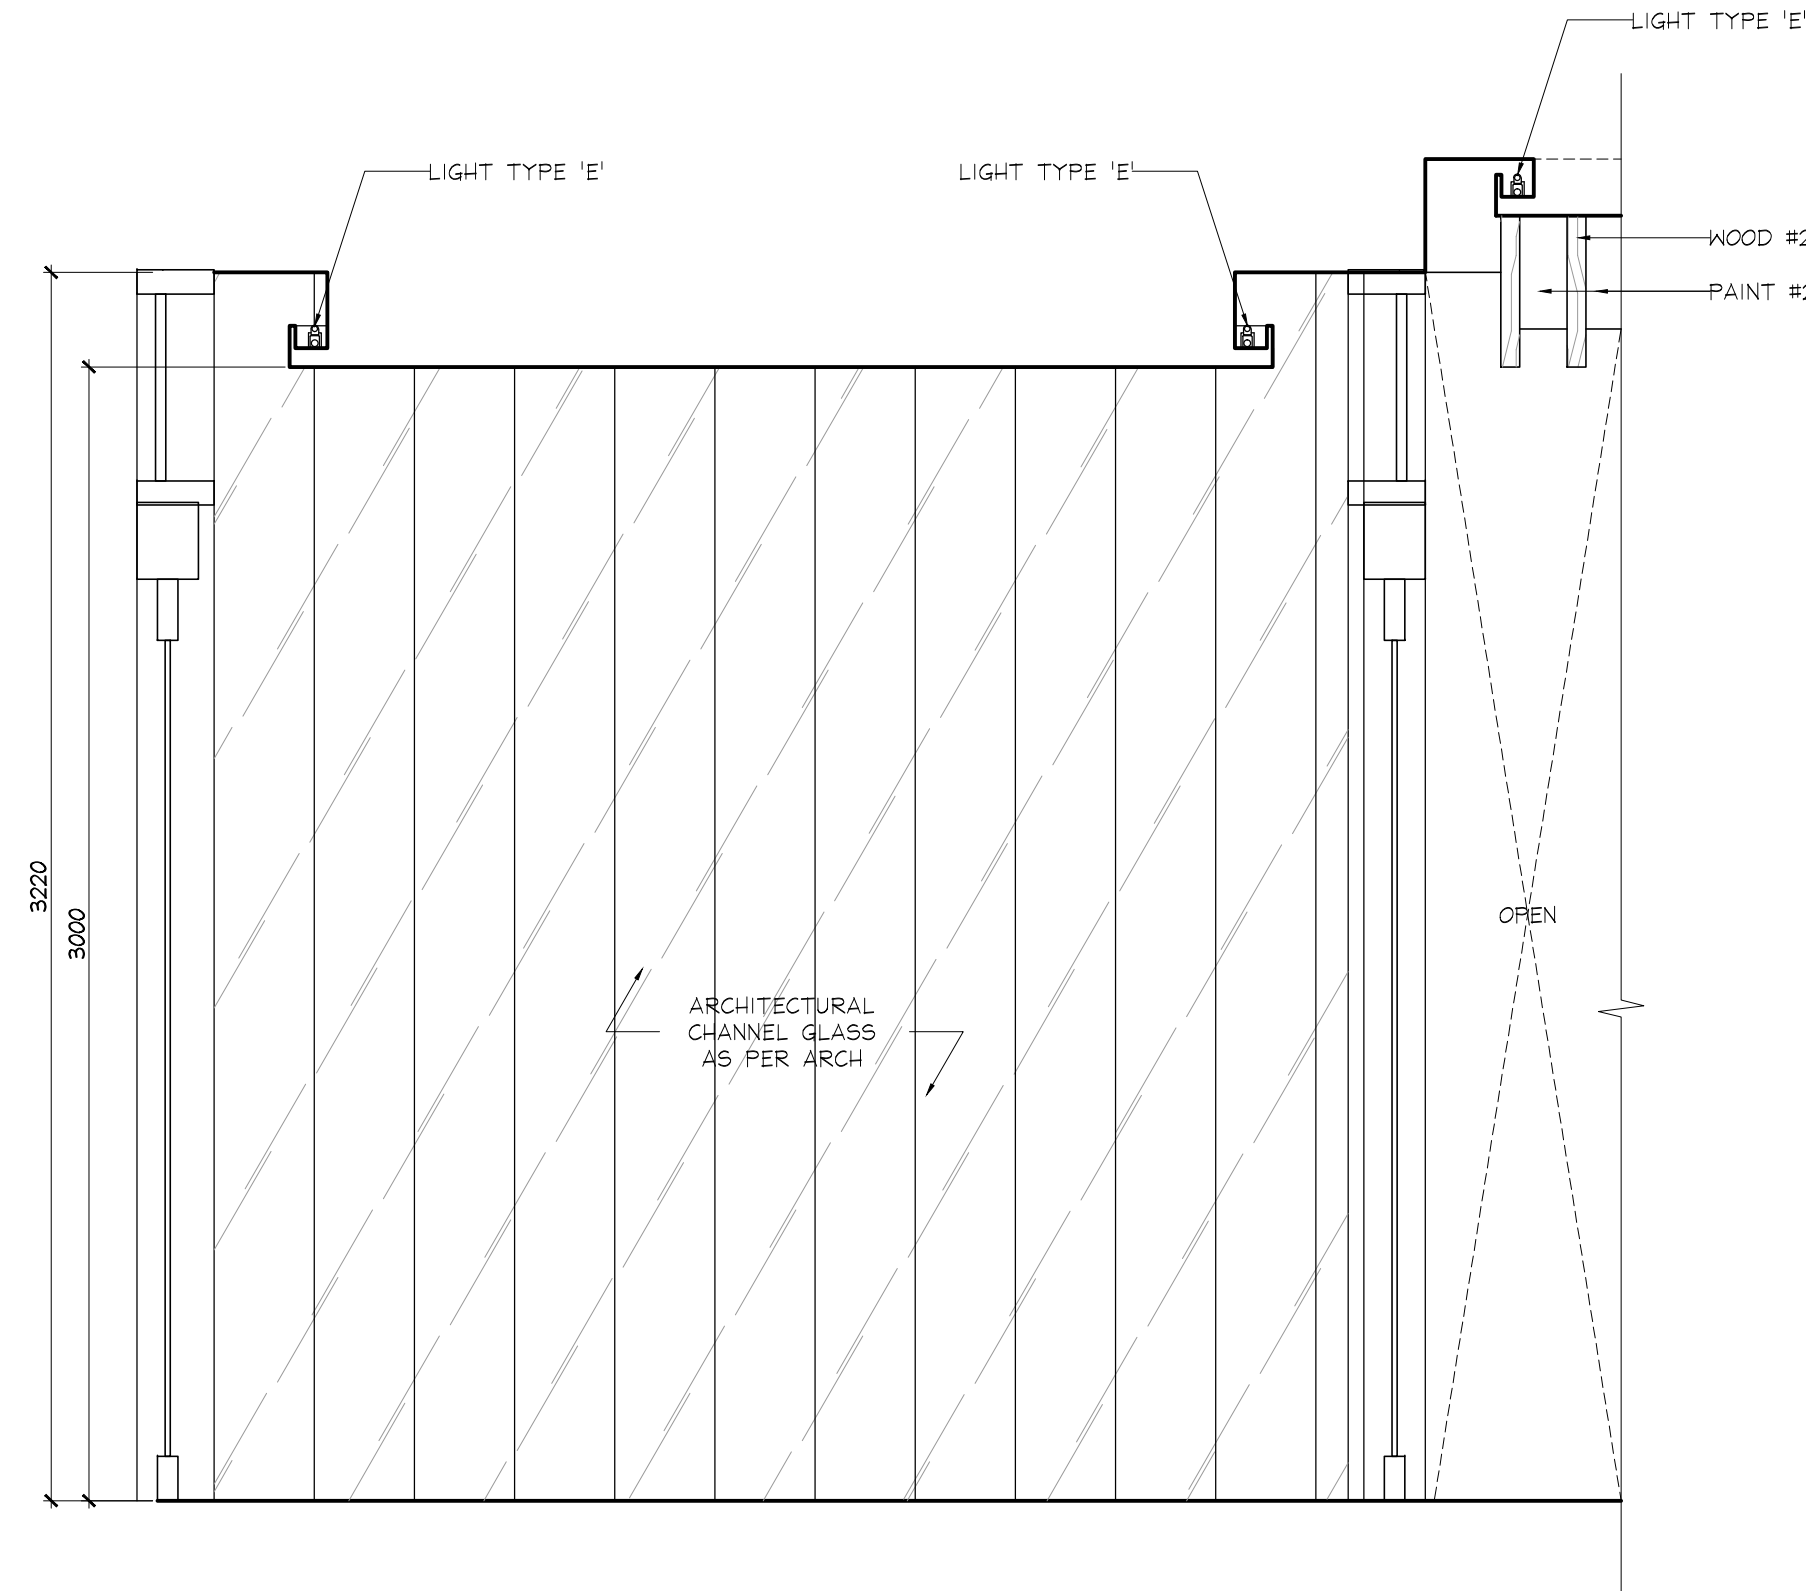

6
ELEVATION
GROUND FLOOR
EAST VESTIBULE
SCALE 1:20

DO NOT SCALE DRAWINGS.
CONTRACTOR MUST VERIFY ALL DRAWINGS, DIMENSIONS, DETAILS AND SPECIFICATIONS AND REPORT ANY DISCREPANCIES TO UNION 31 INC. BEFORE PROCEEDING WITH WORK. MATERIALS MAY NOT BE SUBSTITUTED WITHOUT WRITTEN APPROVAL FROM UNION 31 INC.
ALL DRAWINGS AND SPECIFICATIONS ARE INSTRUMENTS OF SERVICE AND THE PROPERTY OF UNION 31 INC. WHICH MUST BE RETURNED AT THE COMPLETION OF THE WORK.

PRINTED: 30-MAY-17

ISSUED FOR
AS-BUILT

01	31 MAY / 17	ISSUED FOR AS-BUILT	SV
NO.	DATE	COMMENTS	INI

UNION31

UNION31 INC.
183 BATHURST STREET, STE. 201
TORONTO, ON, M5T 2R7, CANADA
TEL: 416-597-1576 FAX: 416-597-2139

PROJECT NAME:	ALEXANDRA PARK MAIN BUILDING
BLOCK 11 ON, Canada	
PROJECT NO.:	13-949
DRAWINGS:	GROUND FLOOR ELEVATIONS

DATE STARTED:	07 AUG / 13	DRAWING NO.:	ID
SCALE:	1 : 20		2.1.0
DRAWN BY:	AP		
APPROVED BY:	KC		

CONTRACTOR MUST VERIFY ALL DRAWINGS, DIMENSIONS, DETAILS AND SPECIFICATIONS, AND REPORT ANY DISCREPANCIES TO UNION 31 INC. BEFORE PROCEEDING WITH WORK. MATERIALS MAY NOT BE SUBSTITUTED WITHOUT WRITTEN APPROVAL FROM UNION 31 INC.

ALL DRAWINGS AND SPECIFICATIONS ARE INSTRUMENTS OF SERVICE AND THE PROPERTY OF UNION 31 INC. WHICH MUST BE RETURNED AT THE COMPLETION OF THE WORK.

01	31 MAY / 17	ISSUED FOR AS-BUILT	
NO.	DATE	COMMENTS	
REVISIONS:			

UNION31 INC.
183 BATHURST STREET, STE 2
TORONTO, ON, M5T 2R7, CANADA
TEL: 416-597-1576 FAX: 416-597-2133

DATE STARTED: 07 AUG / 13	DRAWING NO.: ID 2.1.1
SCALE: 1 : 20	
DRAWN BY: AP	
APPROVED BY: KC	




DO NOT SCALE DRAWINGS.


CONTRACTOR MUST VERIFY ALL DRAWINGS, DIMENSIONS, DETAILS AND SPECIFICATIONS AND REPORT ANY DISCREPANCIES TO UNION 31 INC. BEFORE PROCEEDING WITH WORK. MATERIALS MAY NOT BE SUBSTITUTED WITHOUT WRITTEN APPROVAL FROM UNION 31 INC.

ALL DRAWINGS AND SPECIFICATIONS ARE INSTRUMENTS OF SERVICE AND THE PROPERTY OF UNION 31 INC. WHICH MUST BE RETURNED AT THE COMPLETION OF THE WORK.


PRINTED: 30-M8-17

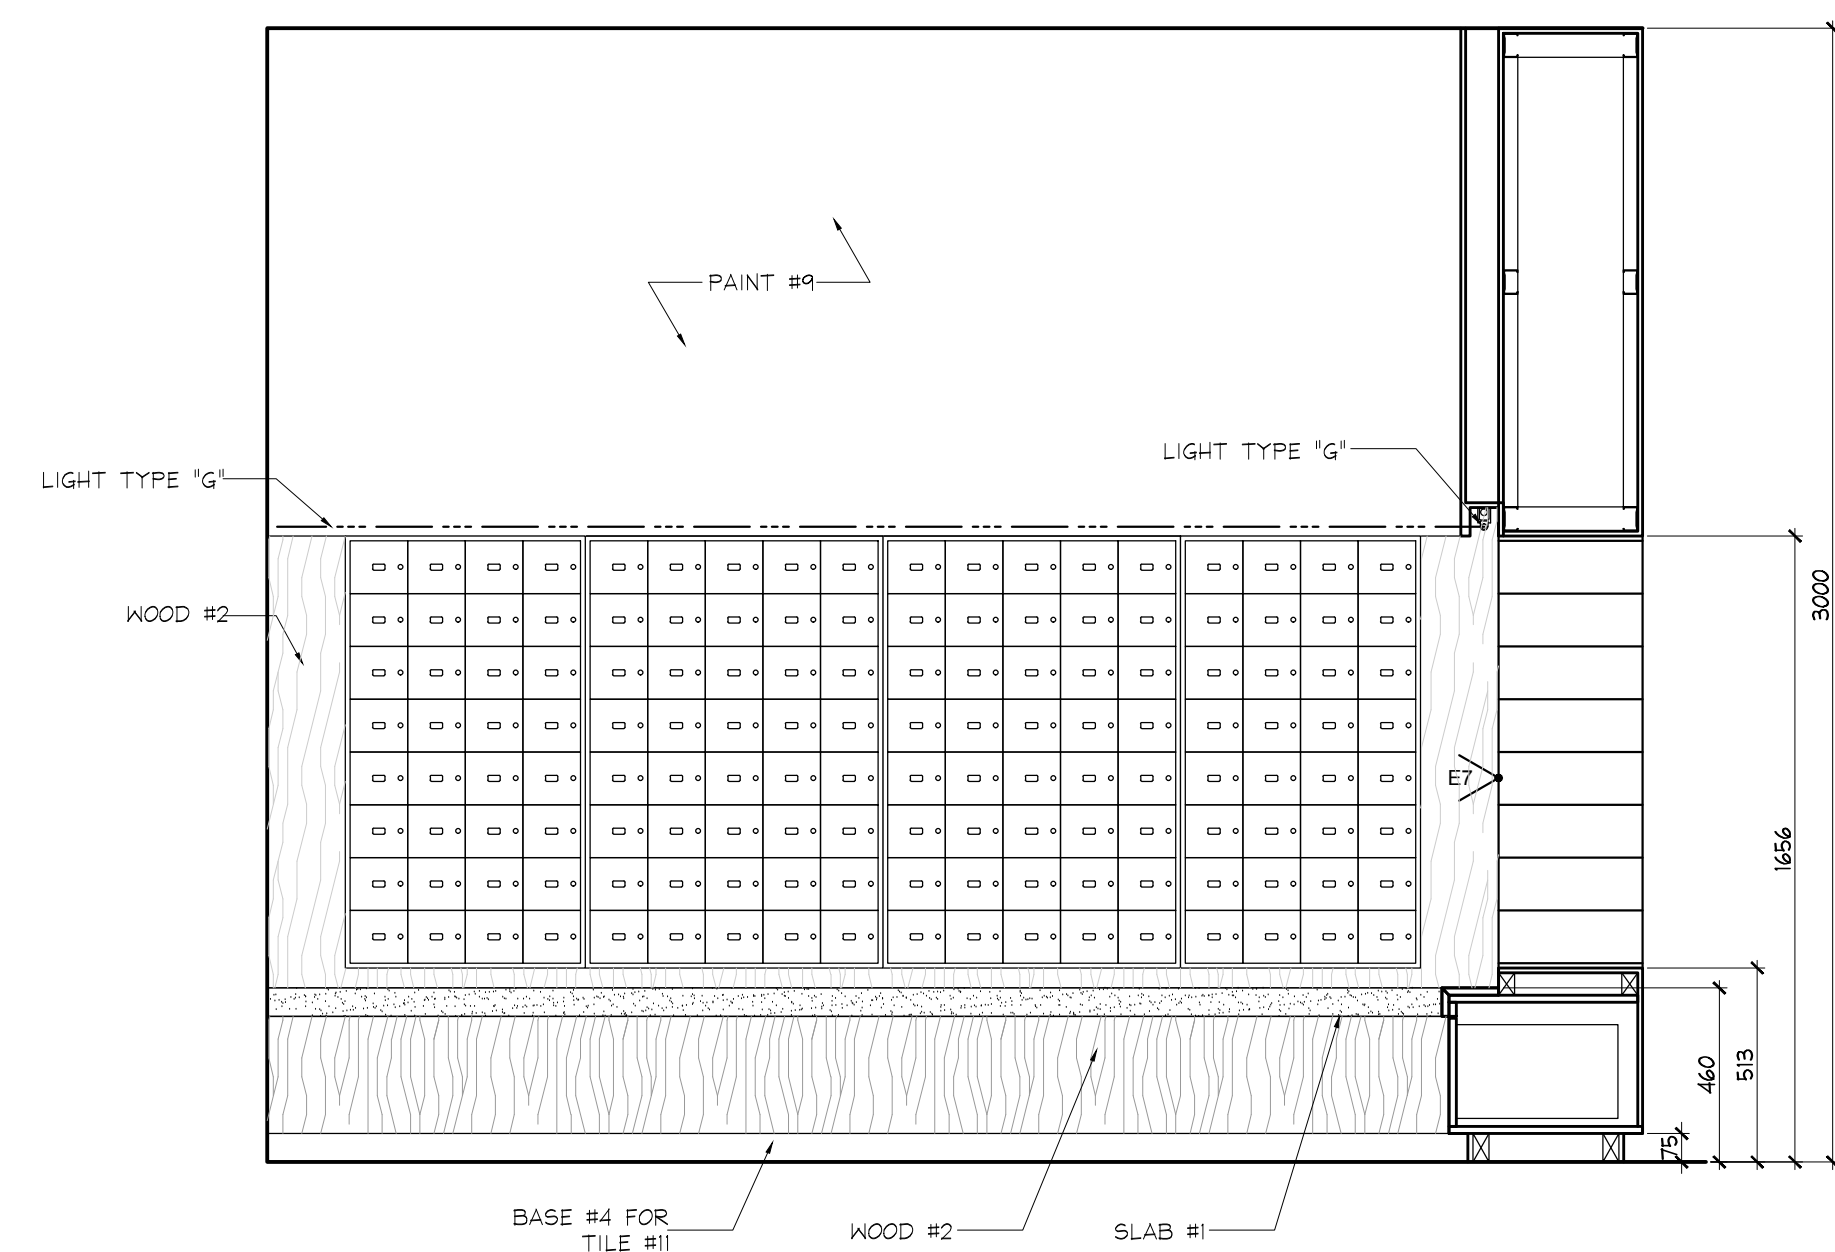


1 ELEVATION
ID2.1.2 GROUND FLOOR MAILROOM
SCALE 1:20

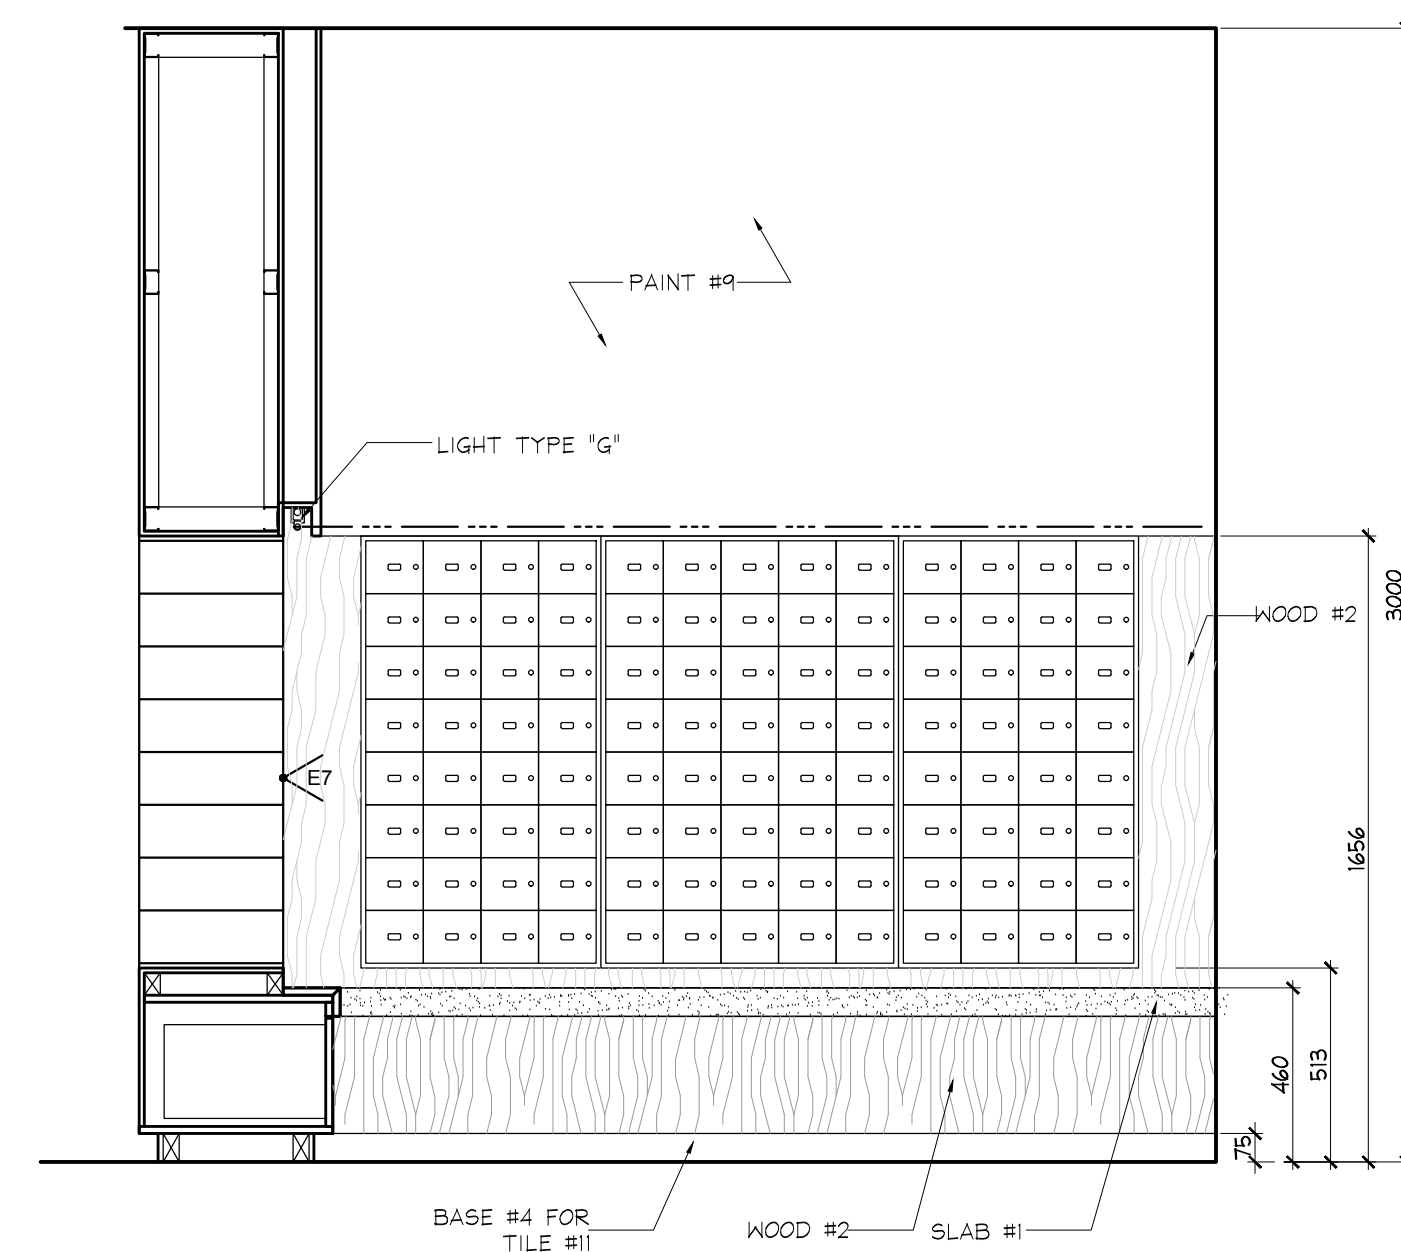


2 ELEVATION
ID2.1.2 GROUND FLOOR MAILROOM
SCALE 1:20

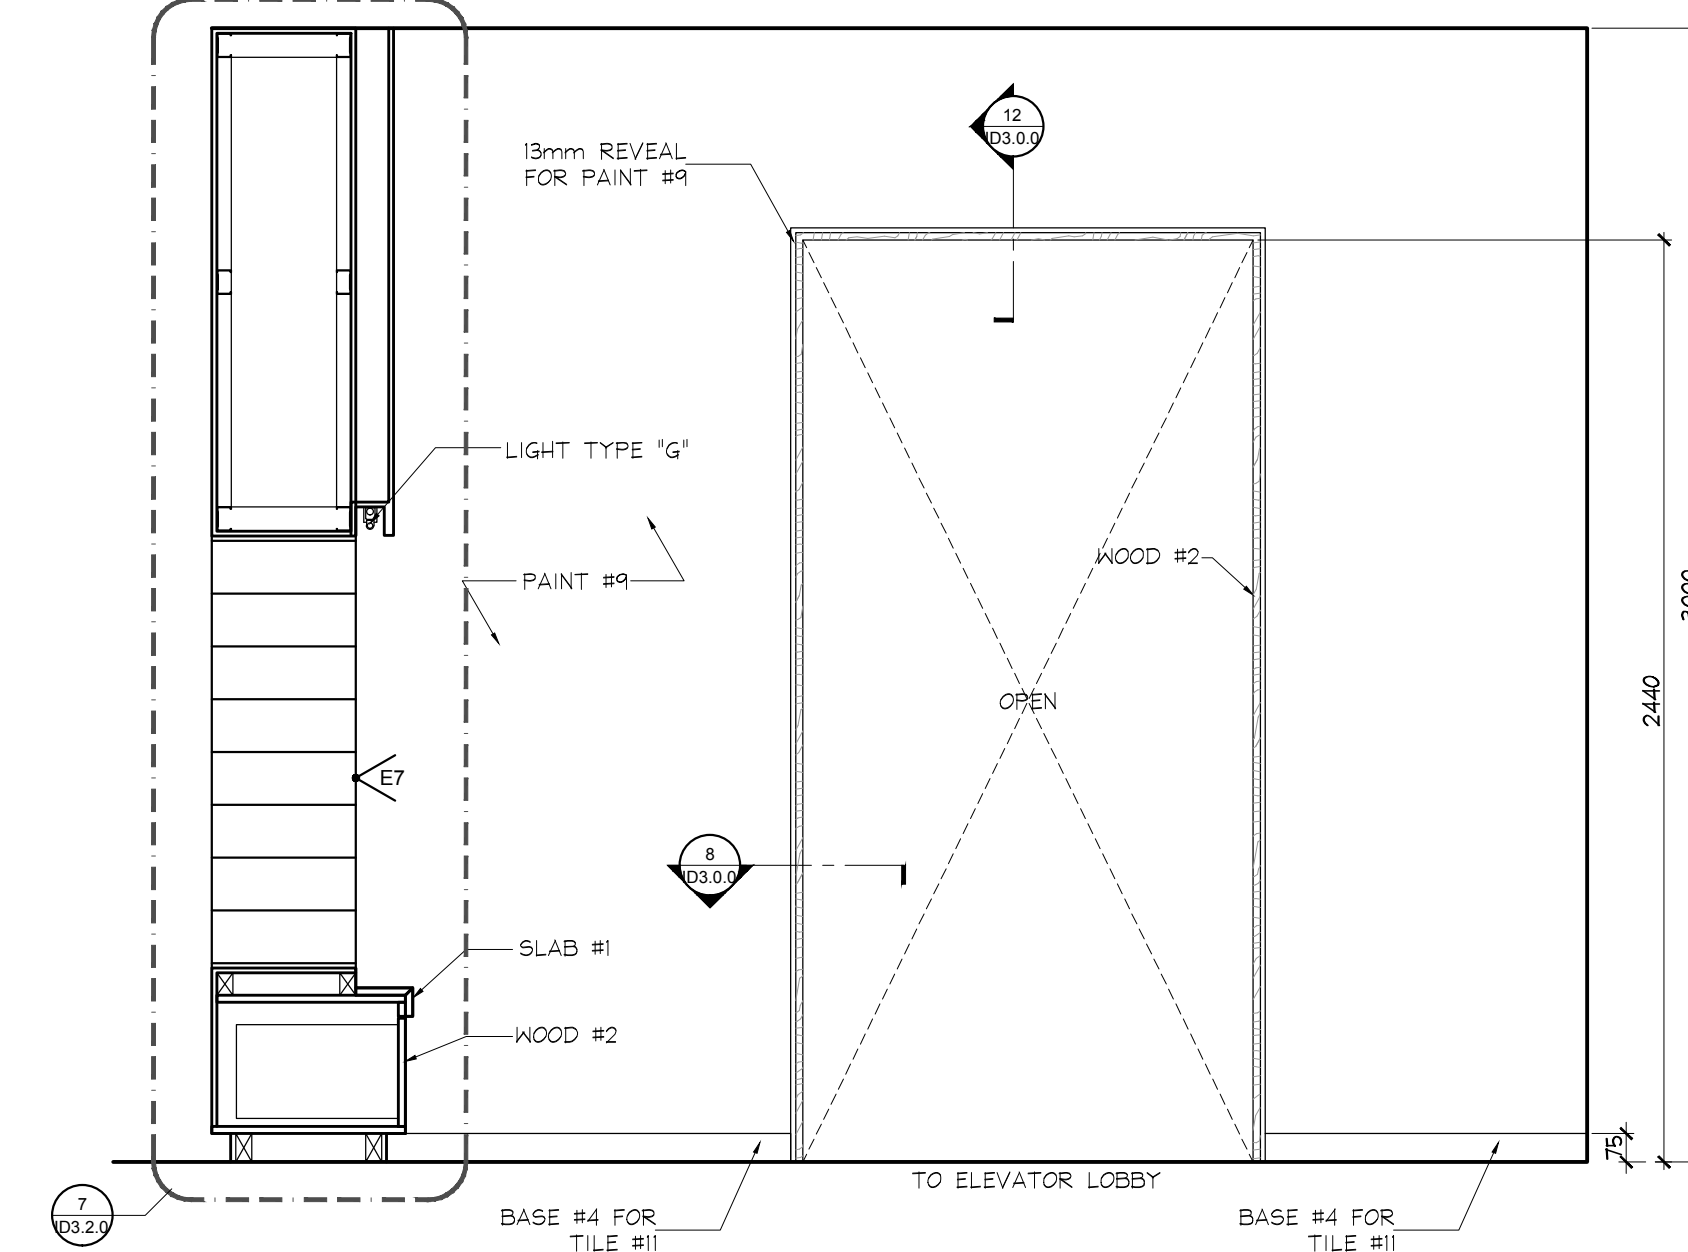


3 ELEVATION
ID2.1.2 GROUND FLOOR MAILROOM
SCALE 1:20

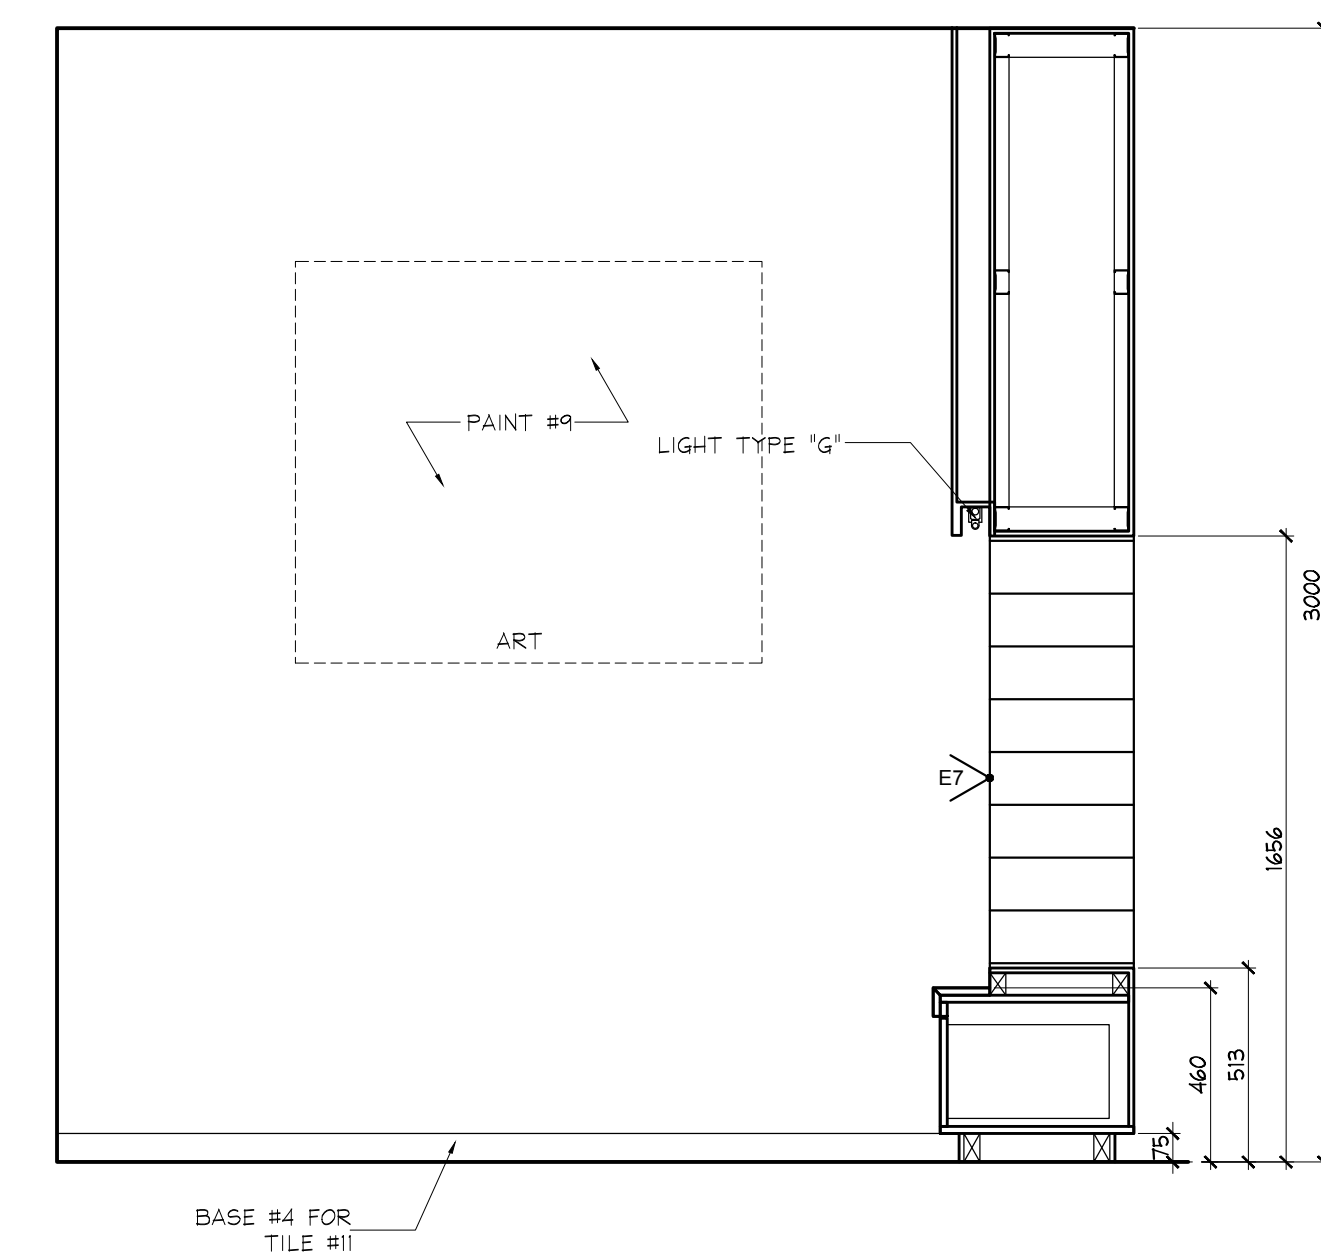

4 ELEVATION
ID2.1.2 GROUND FLOOR MAILROOM
SCALE 1:20

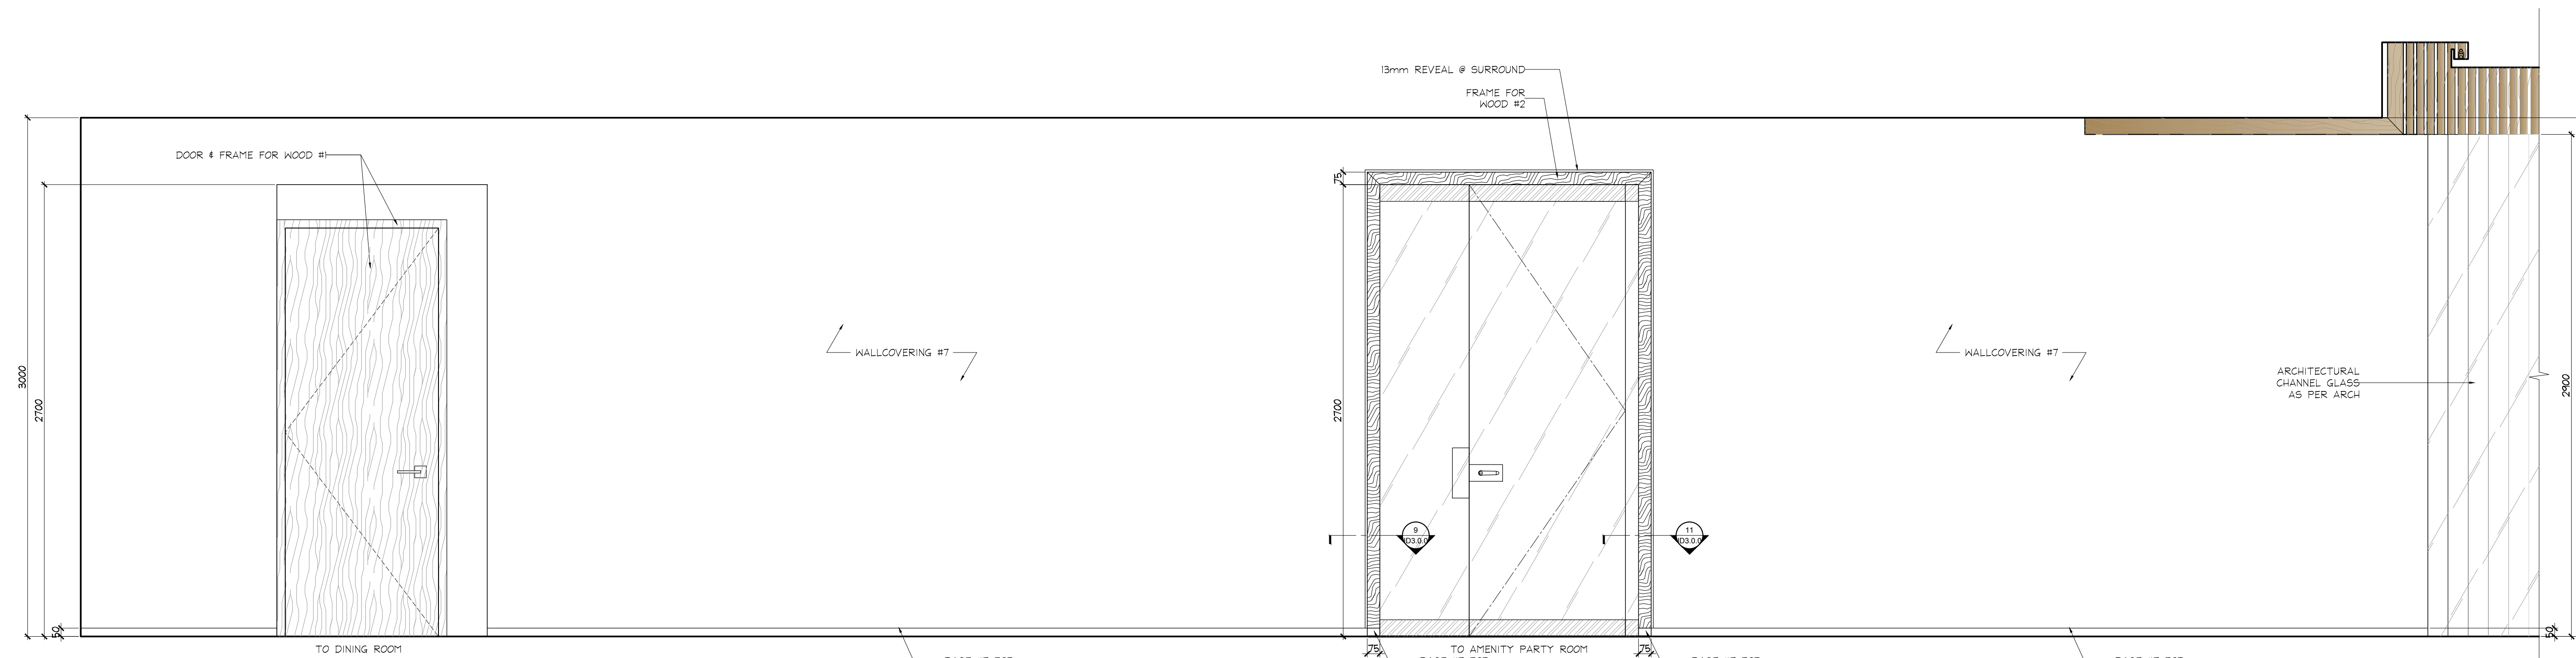

5 ELEVATION
ID2.1.2 GROUND FLOOR CORRIDOR C
SCALE 1:20

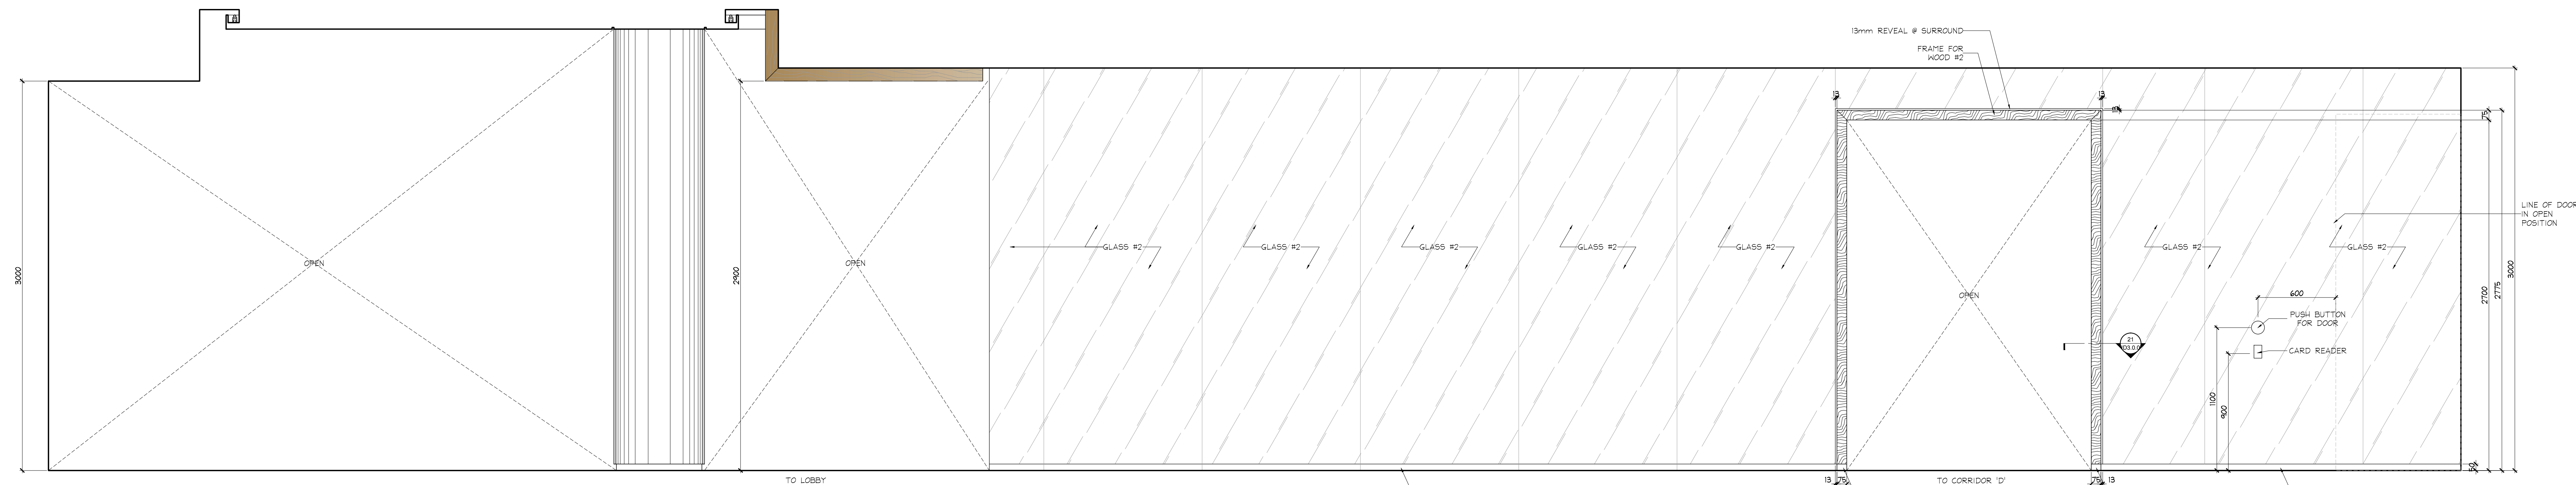

6 ELEVATION
ID2.1.2 GROUND FLOOR CORRIDOR C
SCALE 1:20

01	31 MAY / 17	ISSUED FOR AS-BUILT	SV
NO.	DATE	COMMENTS	INI

REVISIONS:

UNION 31 INC.
183 BATHURST STREET, STE. 201
TORONTO, ON, M5T 2R7, CANADA
TEL: 416-597-1576 FAX: 416-597-2139


PROJECT NAME:
ALEXANDRA PARK
MAIN BUILDING
BLOCK 11
ON, Canada
PROJECT NO.: 13-949
DRAWINGS:
GROUND FLOOR
ELEVATIONS

DATE STARTED: 07 AUG / 13	DRAWING NO.: ID
SCALE: 1 : 20	2.1.2
DRAWN BY: AP	
APPROVED BY: KC	


CONTRACTOR MUST VERIFY ALL DRAWINGS, DIMENSIONS, DETAILS AND SPECIFICATIONS, AND REPORT ANY DISCREPANCIES TO UNION 31 INC. BEFORE PROCEEDING WITH WORK. MATERIALS MAY NOT BE SUBSTITUTED WITHOUT WRITTEN APPROVAL FROM UNION 31 INC.

ALL DRAWINGS AND SPECIFICATIONS ARE INSTRUMENTS OF SERVICE AND THE PROPERTY OF UNION 31 INC. WHICH MUST BE RETURNED AT THE COMPLETION OF THE WORK.


1 ELEVATION
ID2.1.3 GROUND FLOOR
AMENITY PARTY ROOM SCALE 1:20

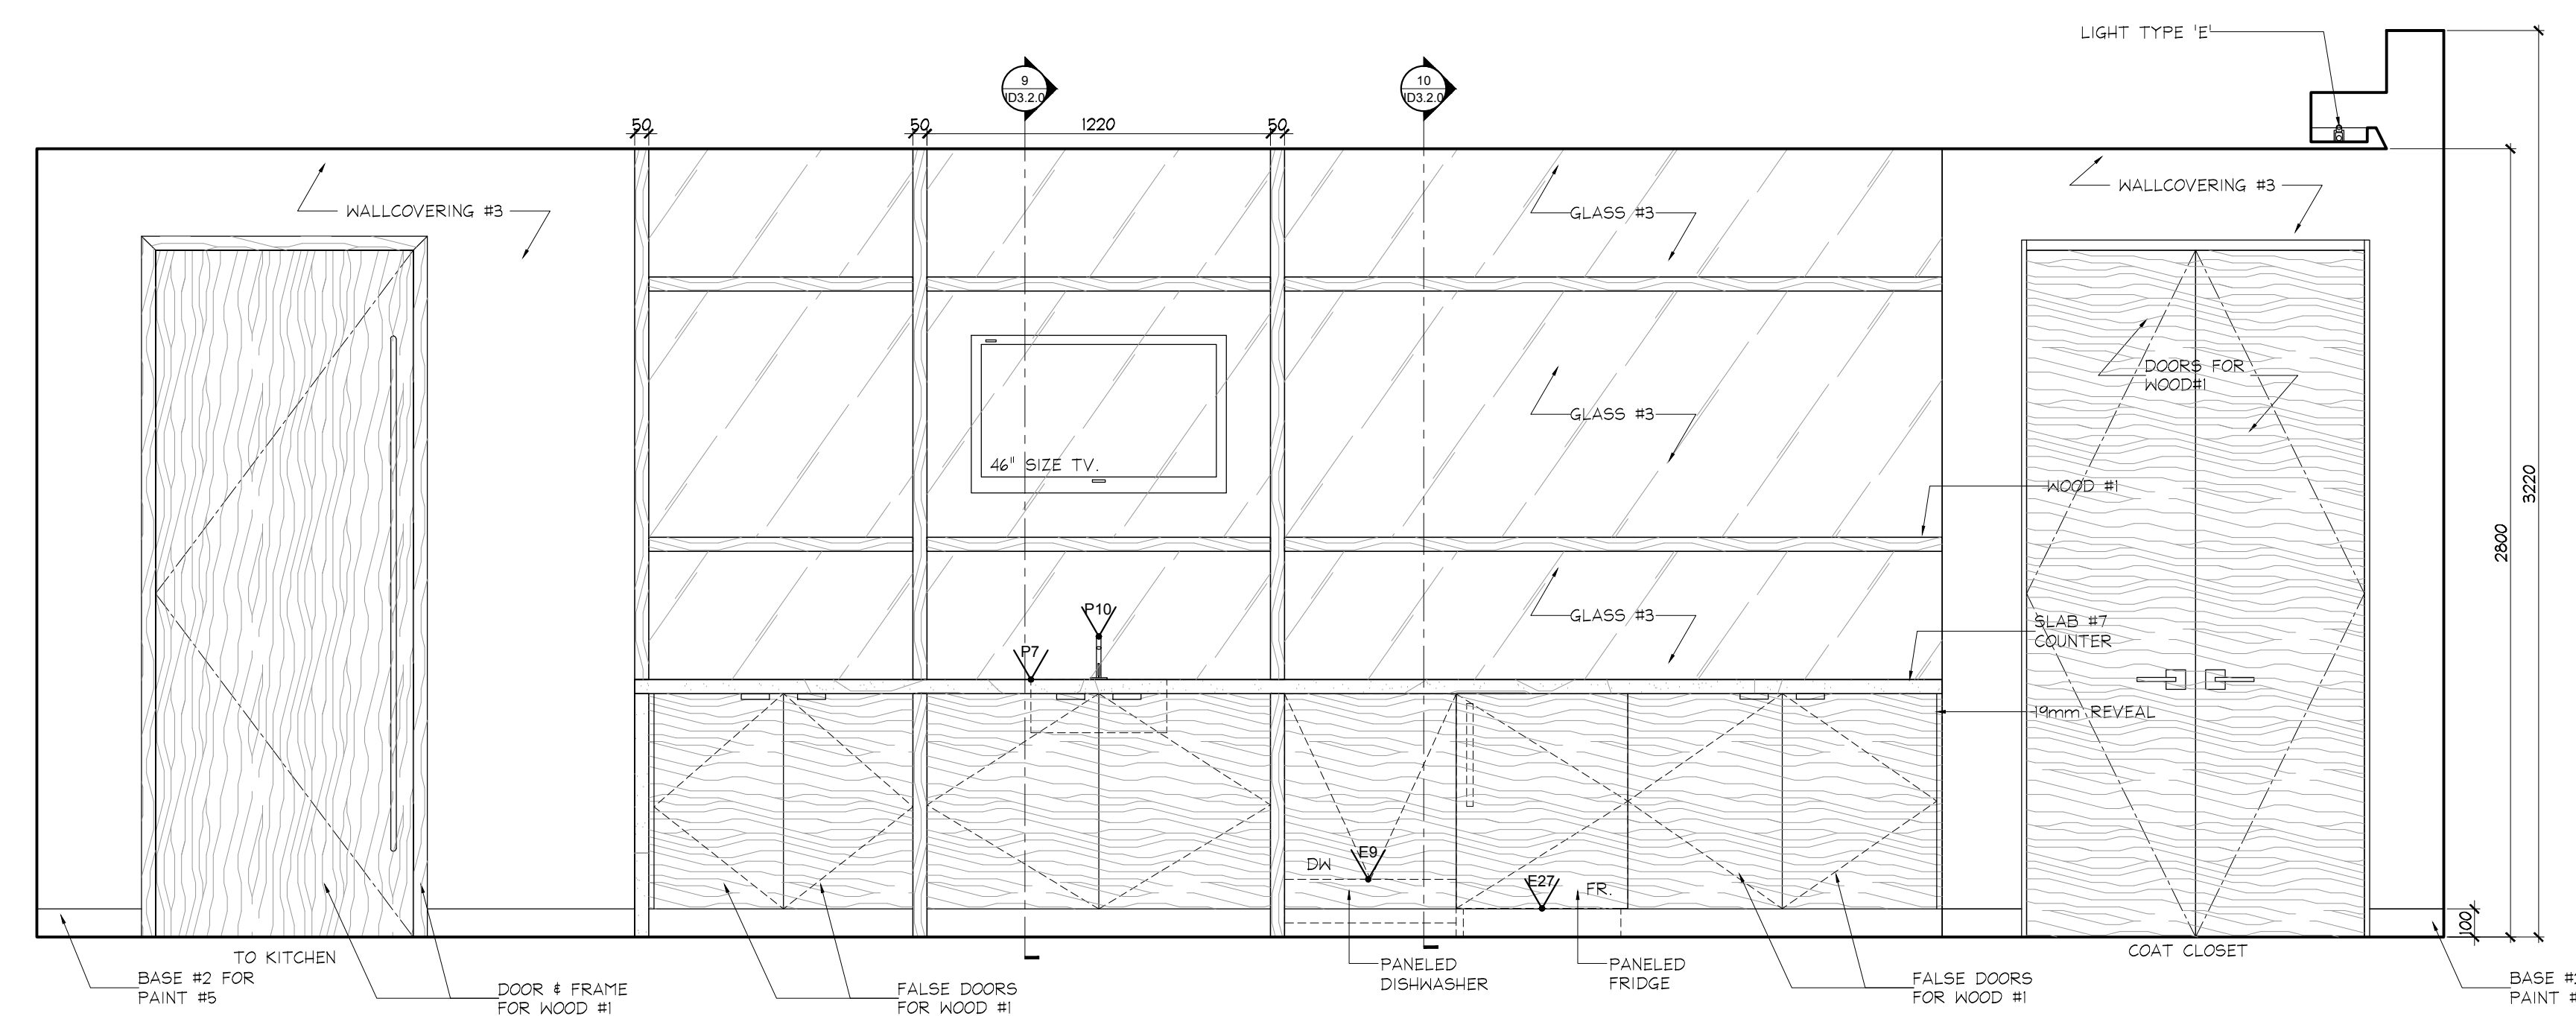

2 ELEVATION
ID2.1.3 GROUND FLOOR
AMENITY PARTY ROOM SCALE 1:20

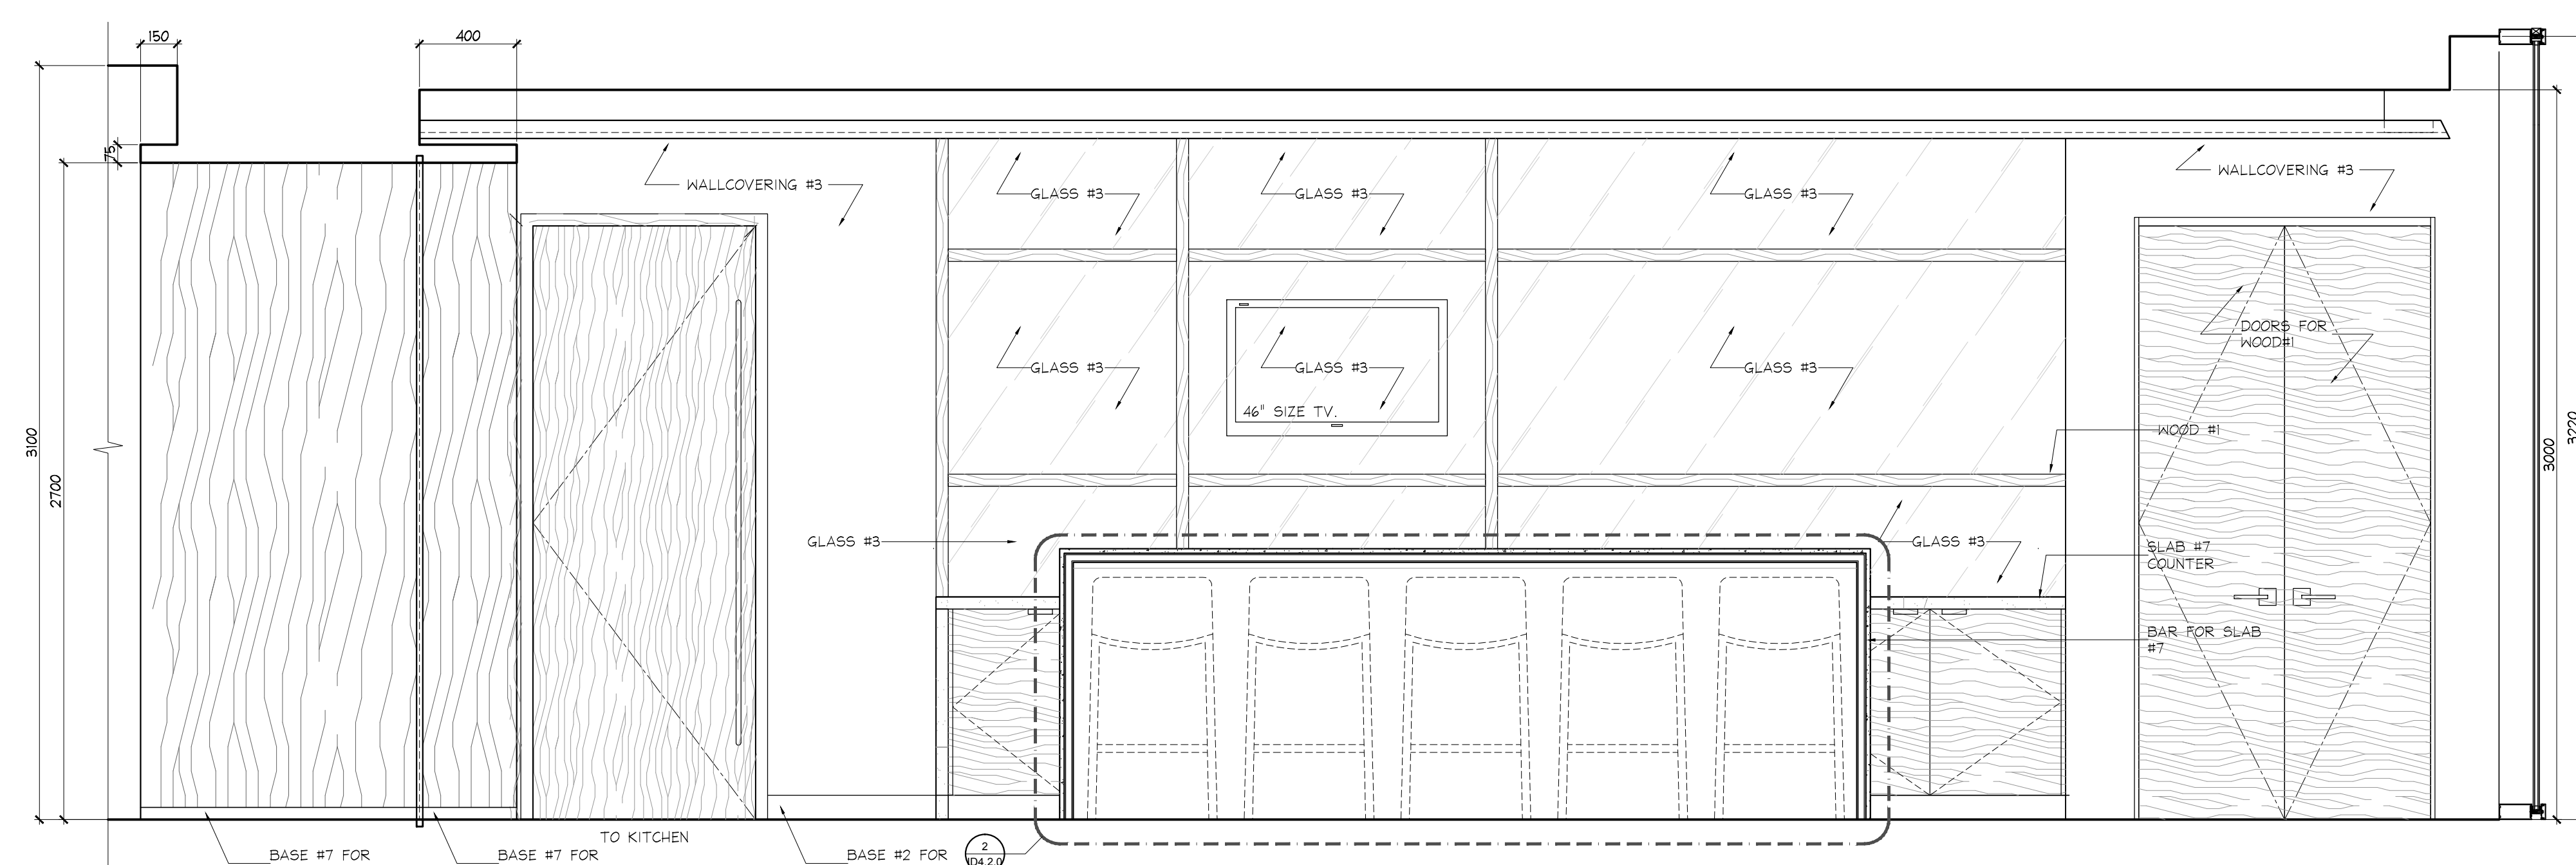

3 ELEVATION
ID2.1.3 GROUND FLOOR AMENITY PARTY ROOM SCALE 1:20

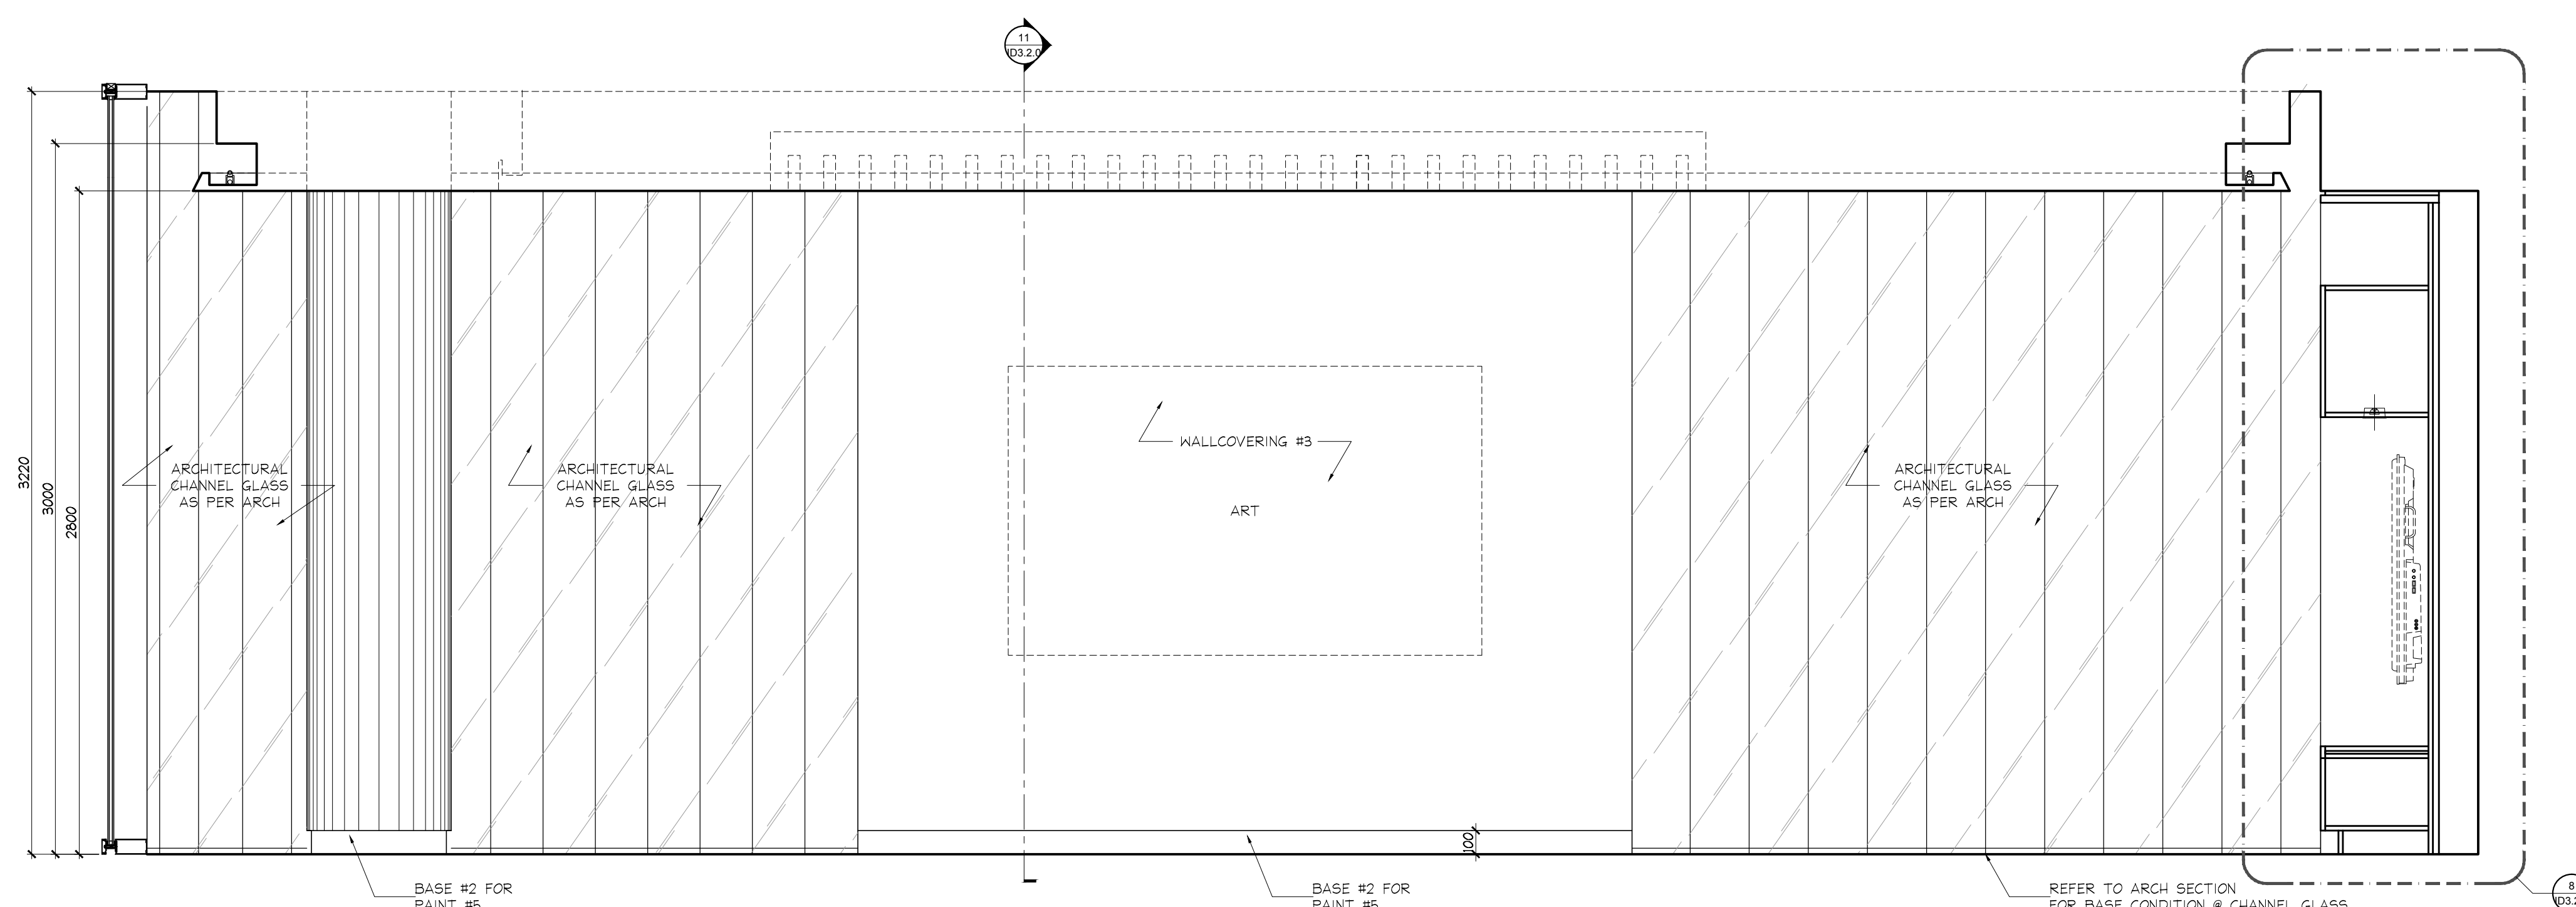

4 ELEVATION
ID2.1.3 GROUND FLOOR AMENITY PARTY ROOM SCALE 1:20

ISSUED FOR AS-BUILT

01	31 MAY / 17	ISSUED FOR AS-BUILT	
NO.	DATE	COMMENTS	
REVISIONS:			

1302

UNION31 INC.
183 BATHURST STREET, STE 201
TORONTO, ON, M5T 2R7, CANADA
TEL: 416-597-1576 FAX: 416-597-2139

PROJECT NAME

ALEXANDRA PARK
MAIN BUILDING


BLOCK 11

13,949


DRAWING/S:

GROUND FLOOR ELEVATIONS


DATE STARTED: 07 AUG / 13	DRAWING NO.: ID 2.1.3
SCALE: 1 : 20	
DRAWN BY: AP	
APPROVED BY: KC	

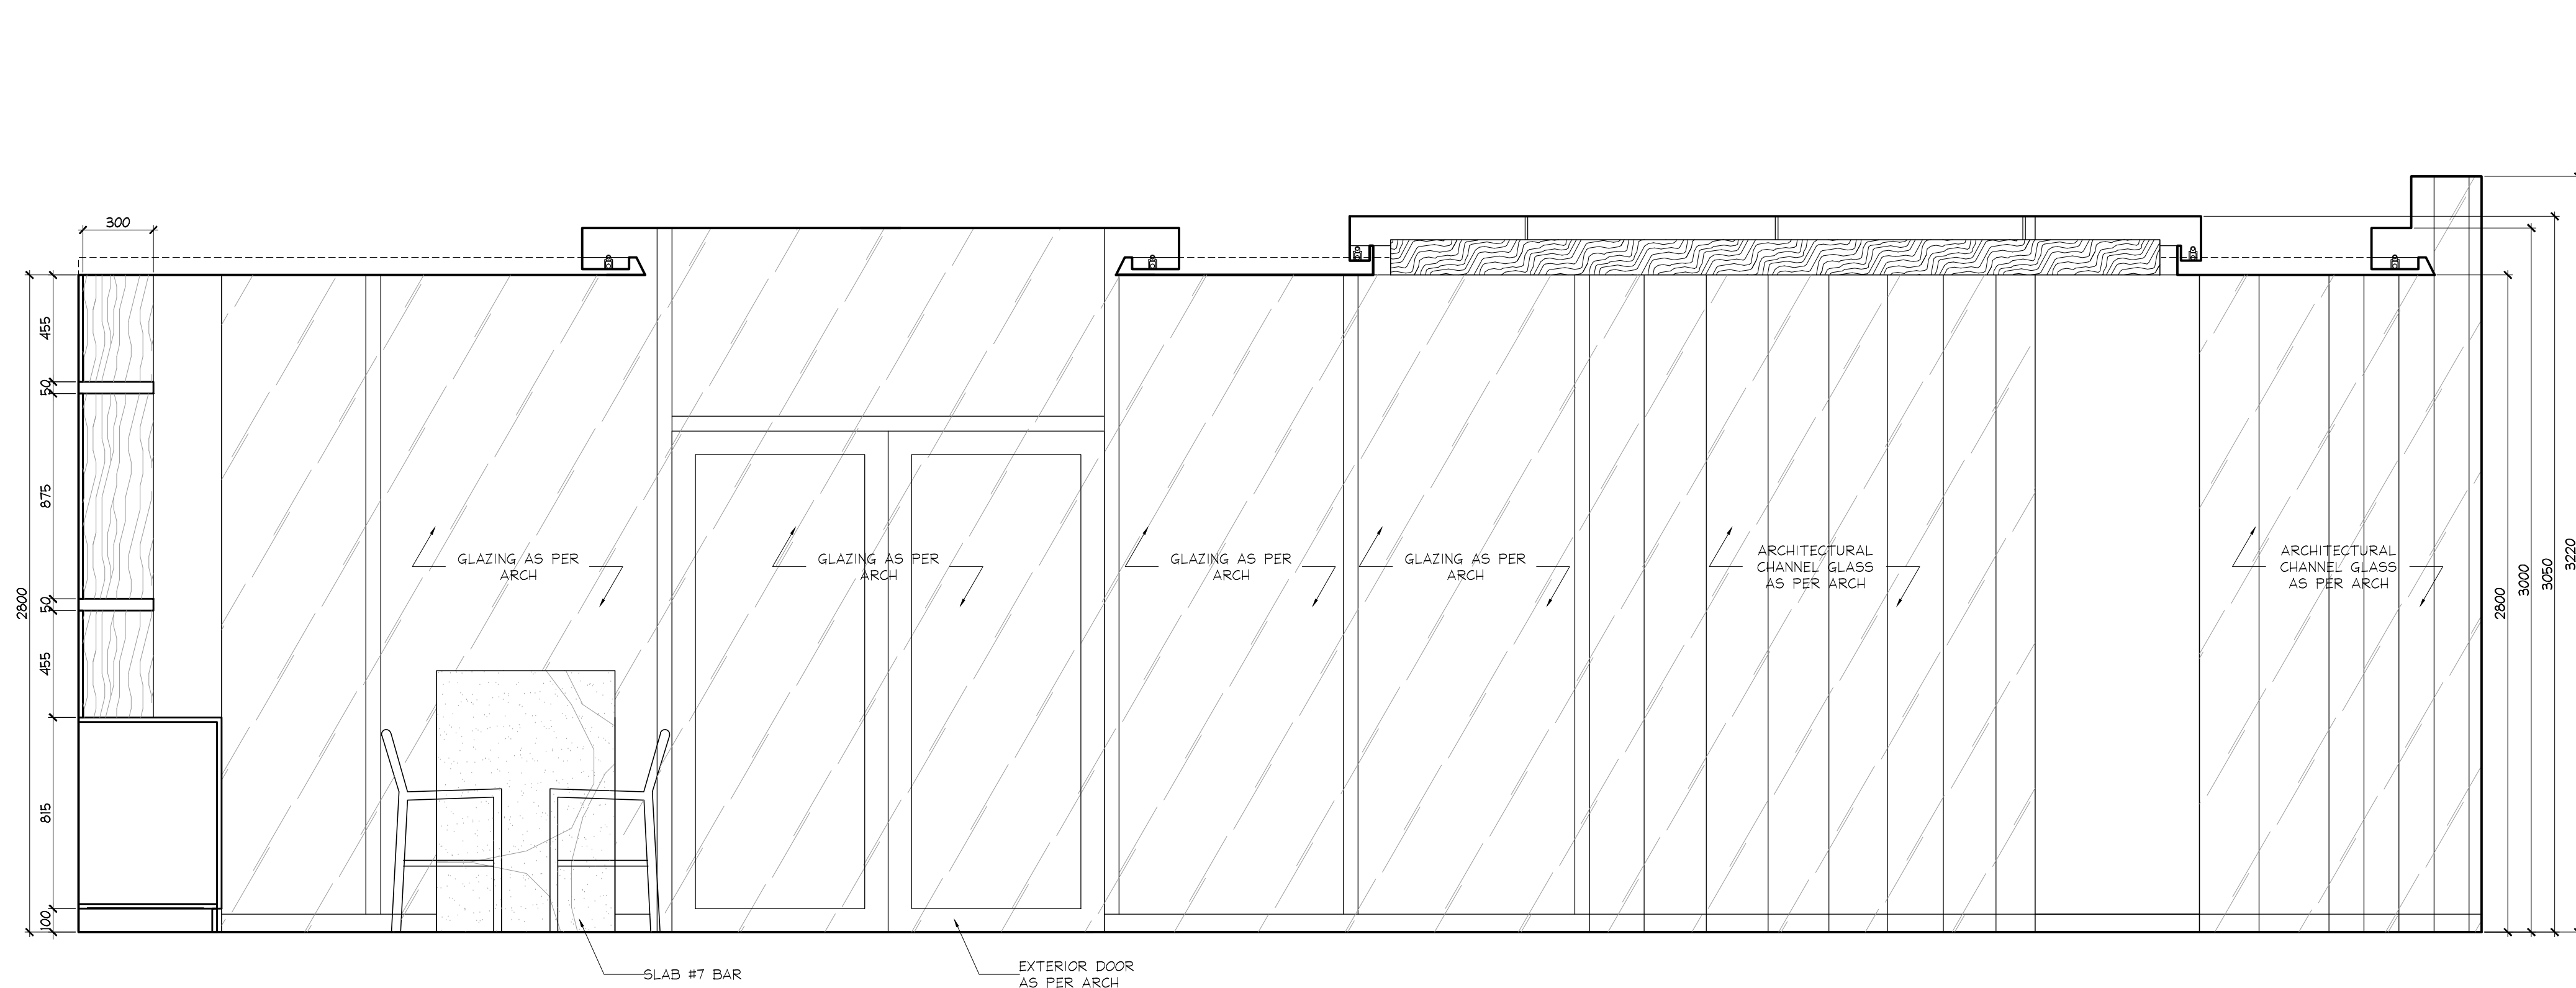


1 ELEVATION
ID2.14 GROUND FLOOR
AMENITY PARTY ROOM
SCALE 1:20

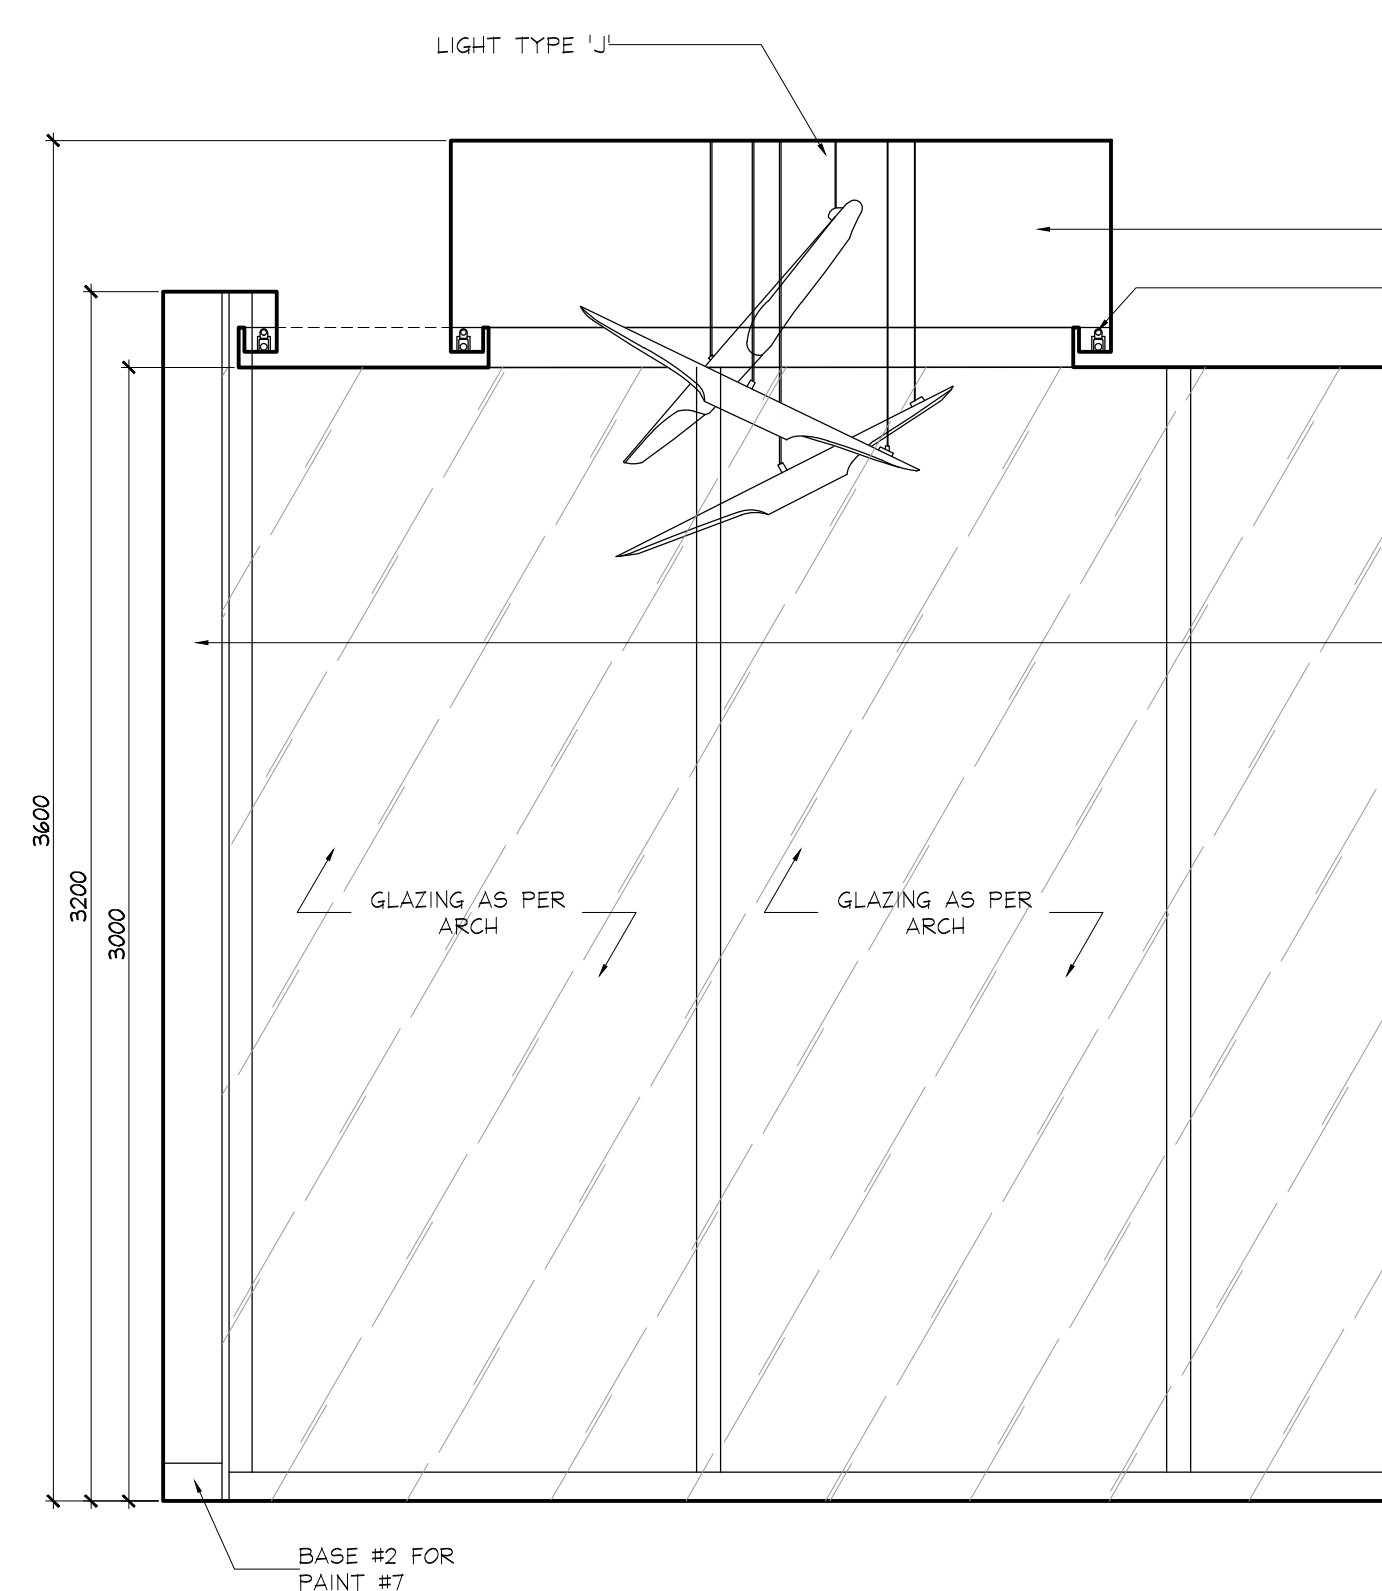


2 ELEVATION
ID2.14 GROUND FLOOR
DINING ROOM
SCALE 1:20

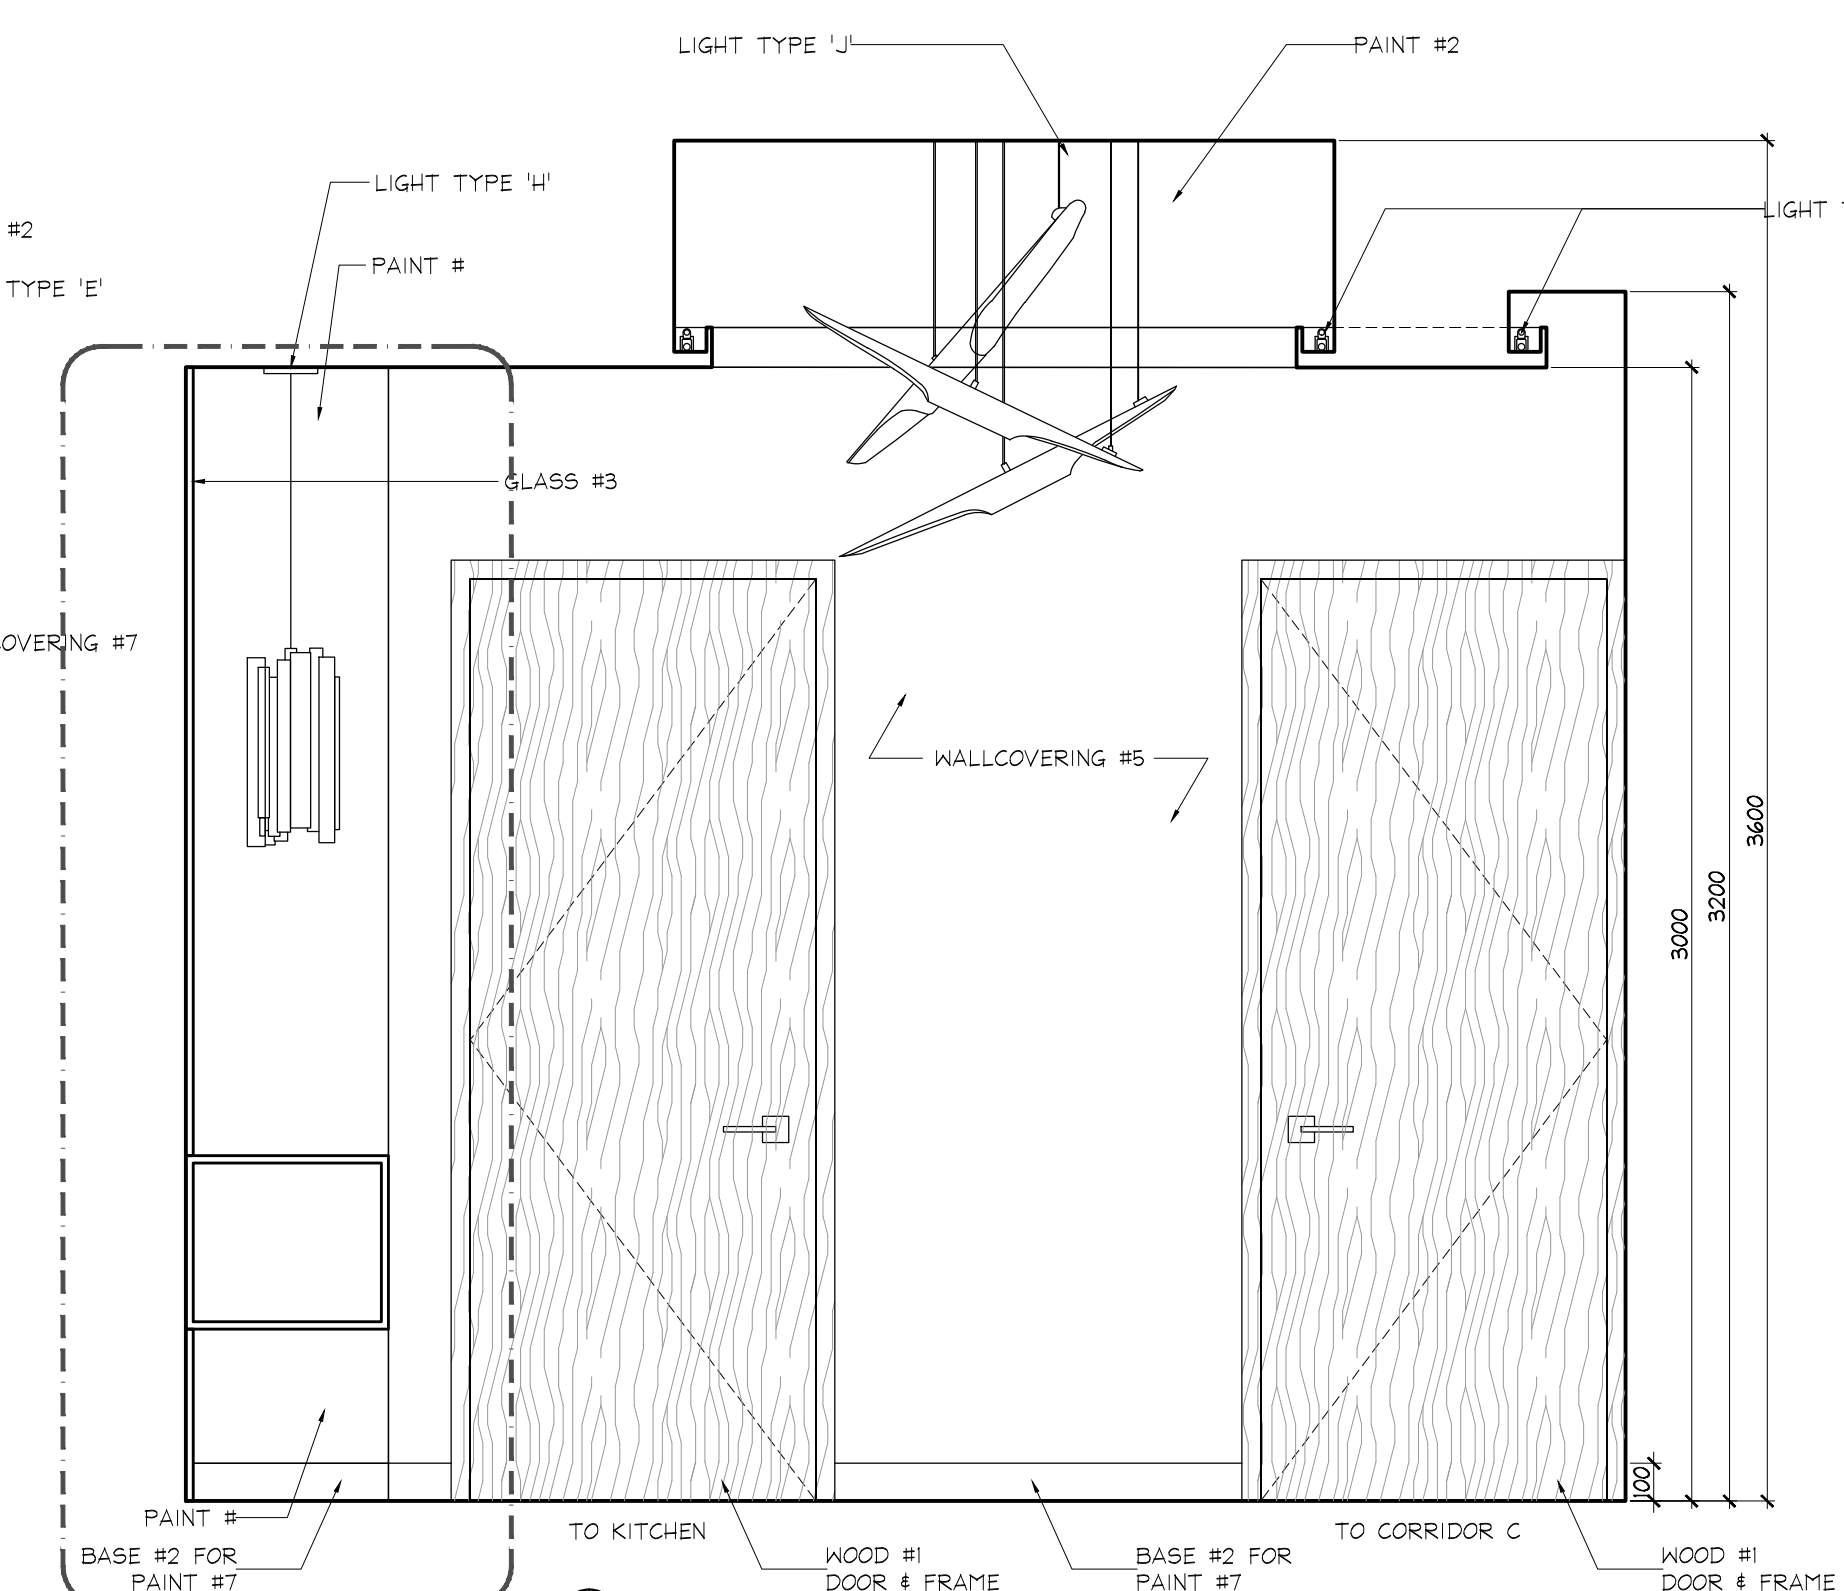


3 ELEVATION
ID2.14 GROUND FLOOR
DINING ROOM
SCALE 1:20

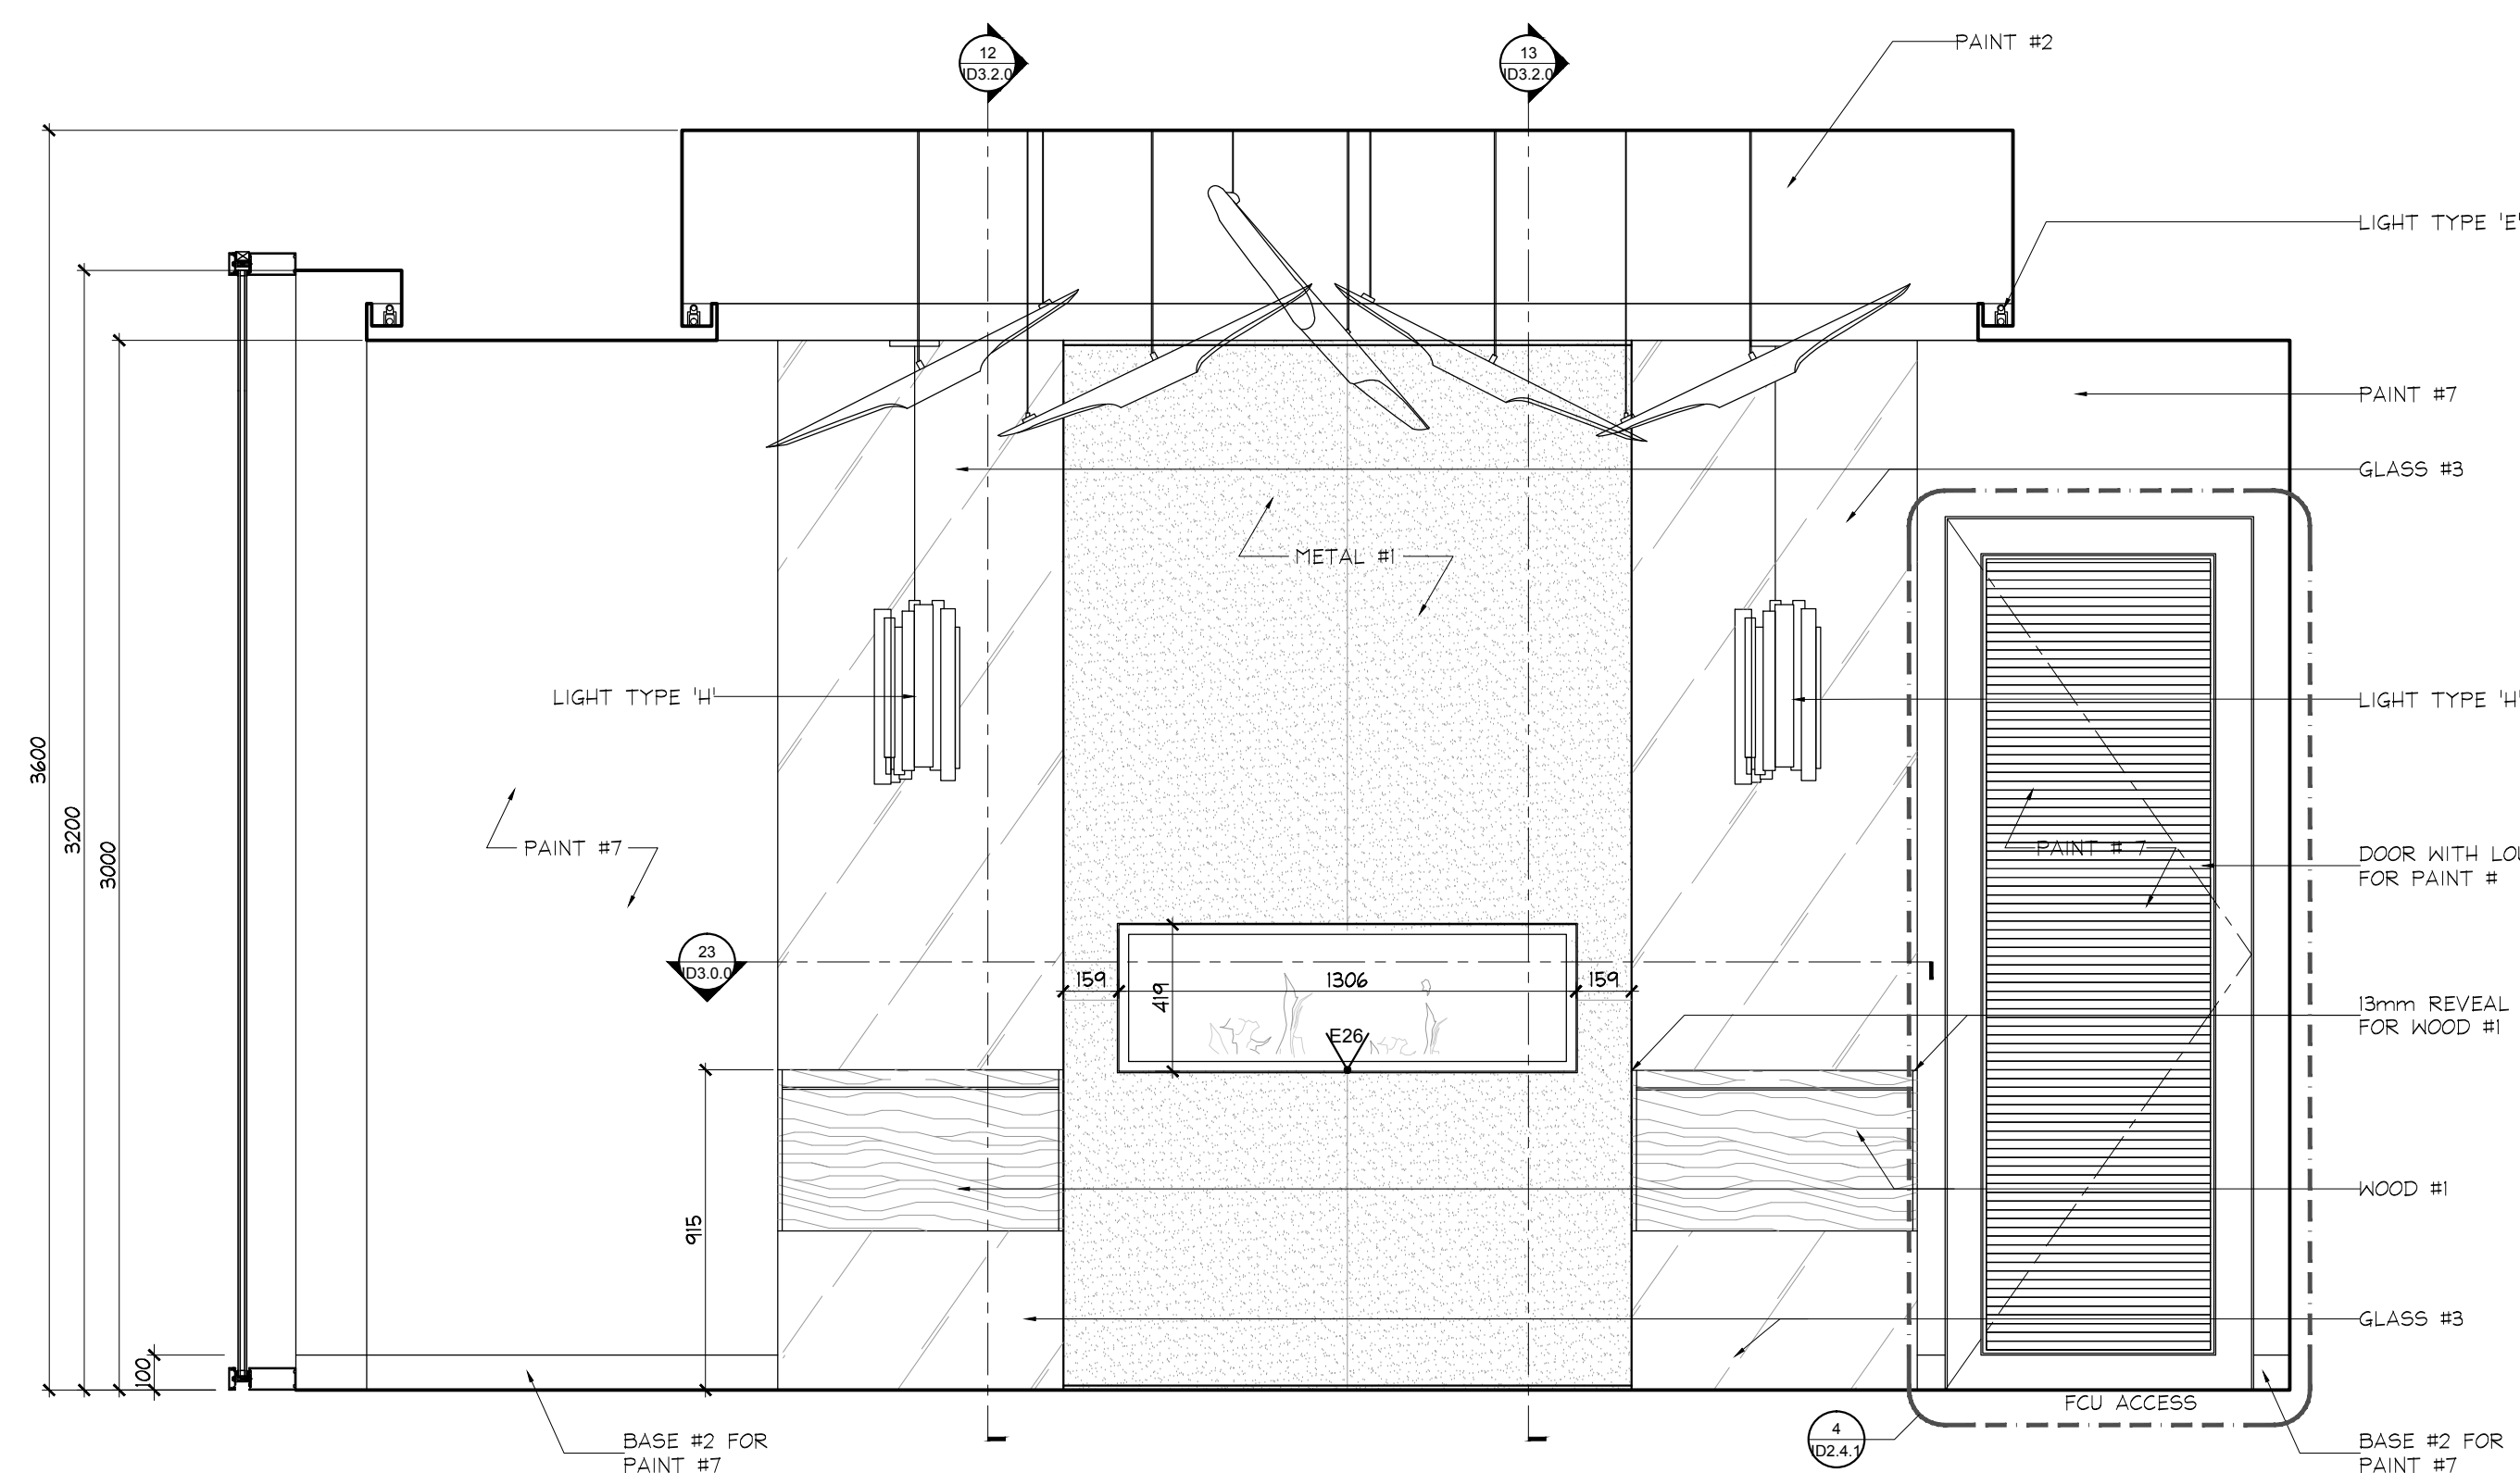


4 ELEVATION
ID2.14 GROUND FLOOR
DINING ROOM
SCALE 1:20

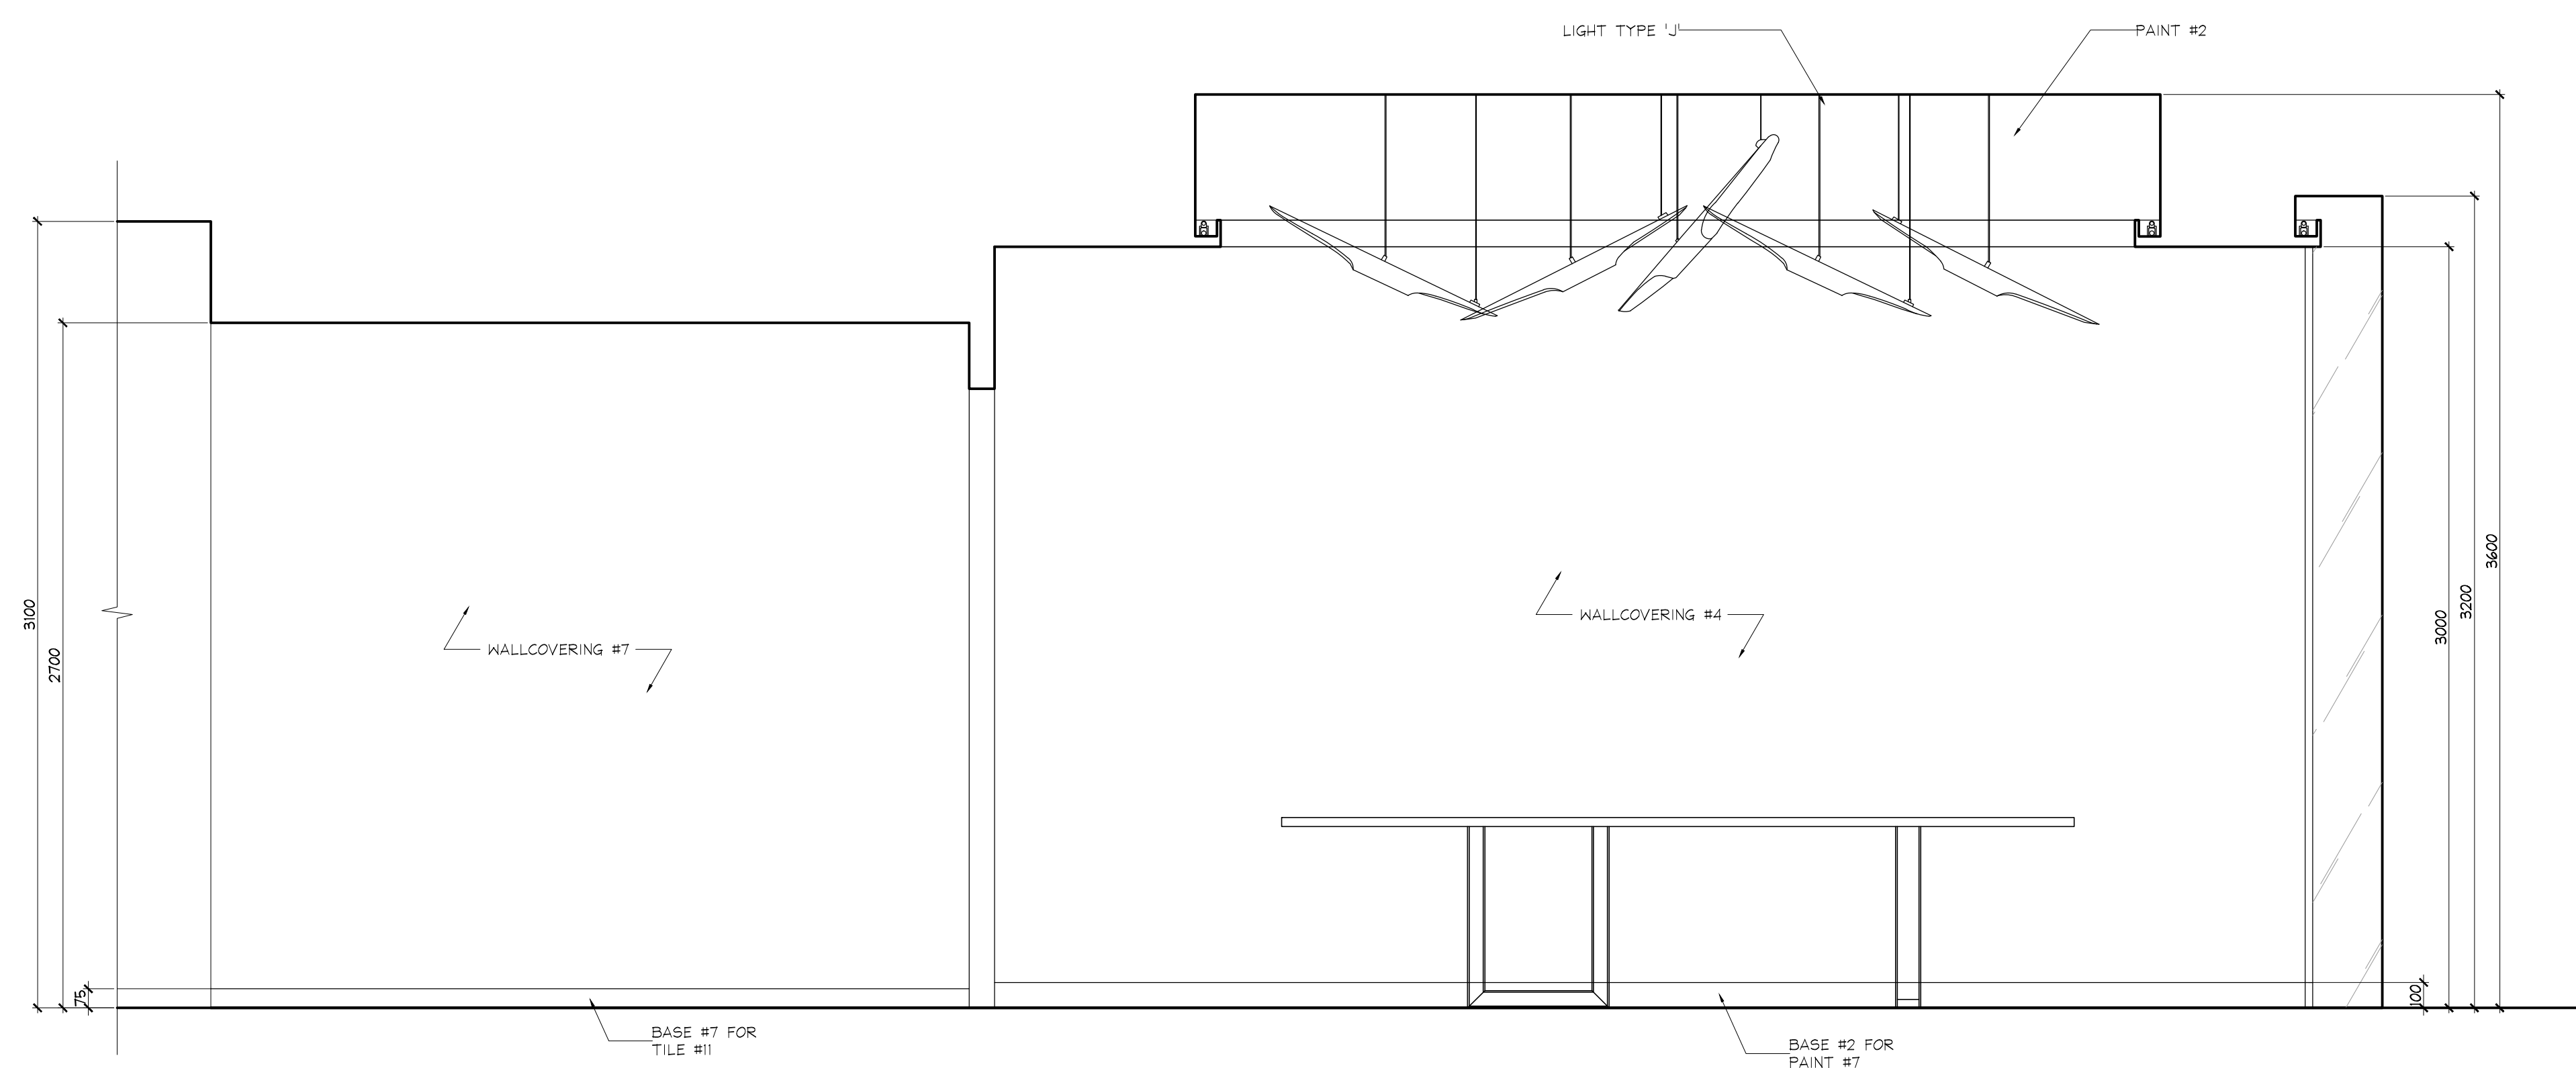


5 ELEVATION
ID2.14 GROUND FLOOR
DINING ROOM
SCALE 1:20

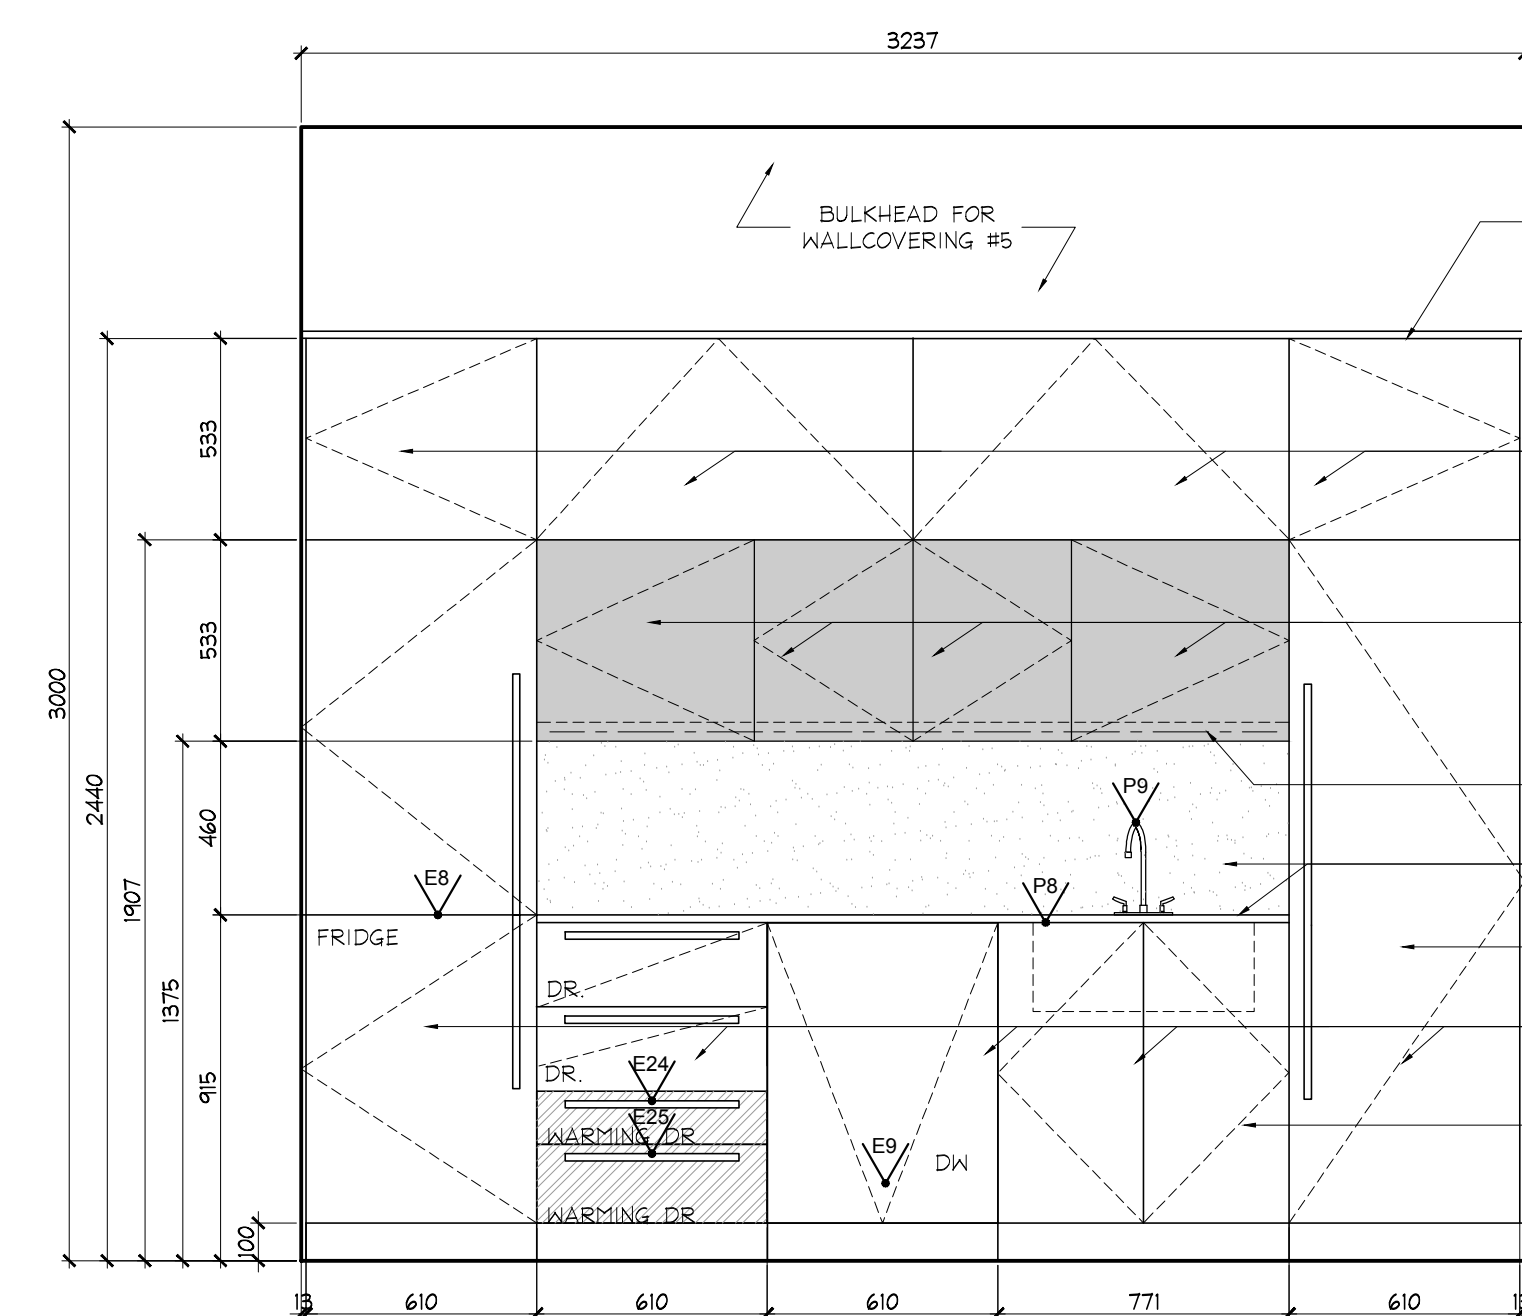


6 ELEVATION
ID2.14 GROUND FLOOR
KITCHEN
SCALE 1:20

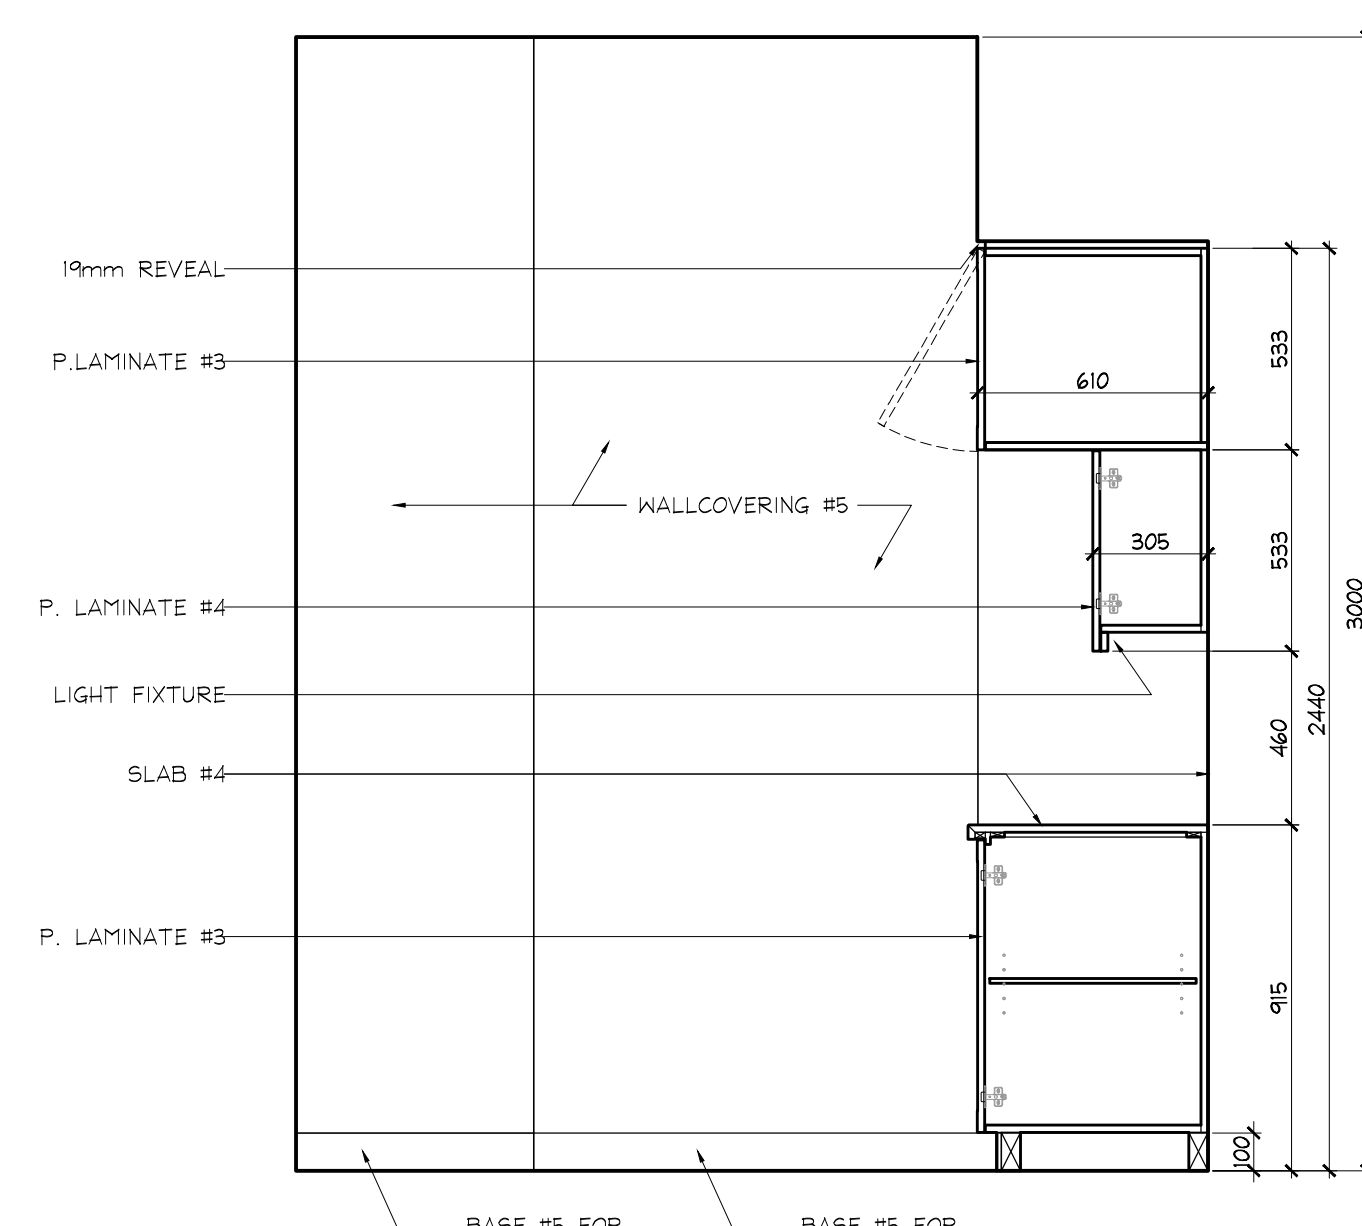

7 ELEVATION
ID2.14 GROUND FLOOR
KITCHEN
SCALE 1:20

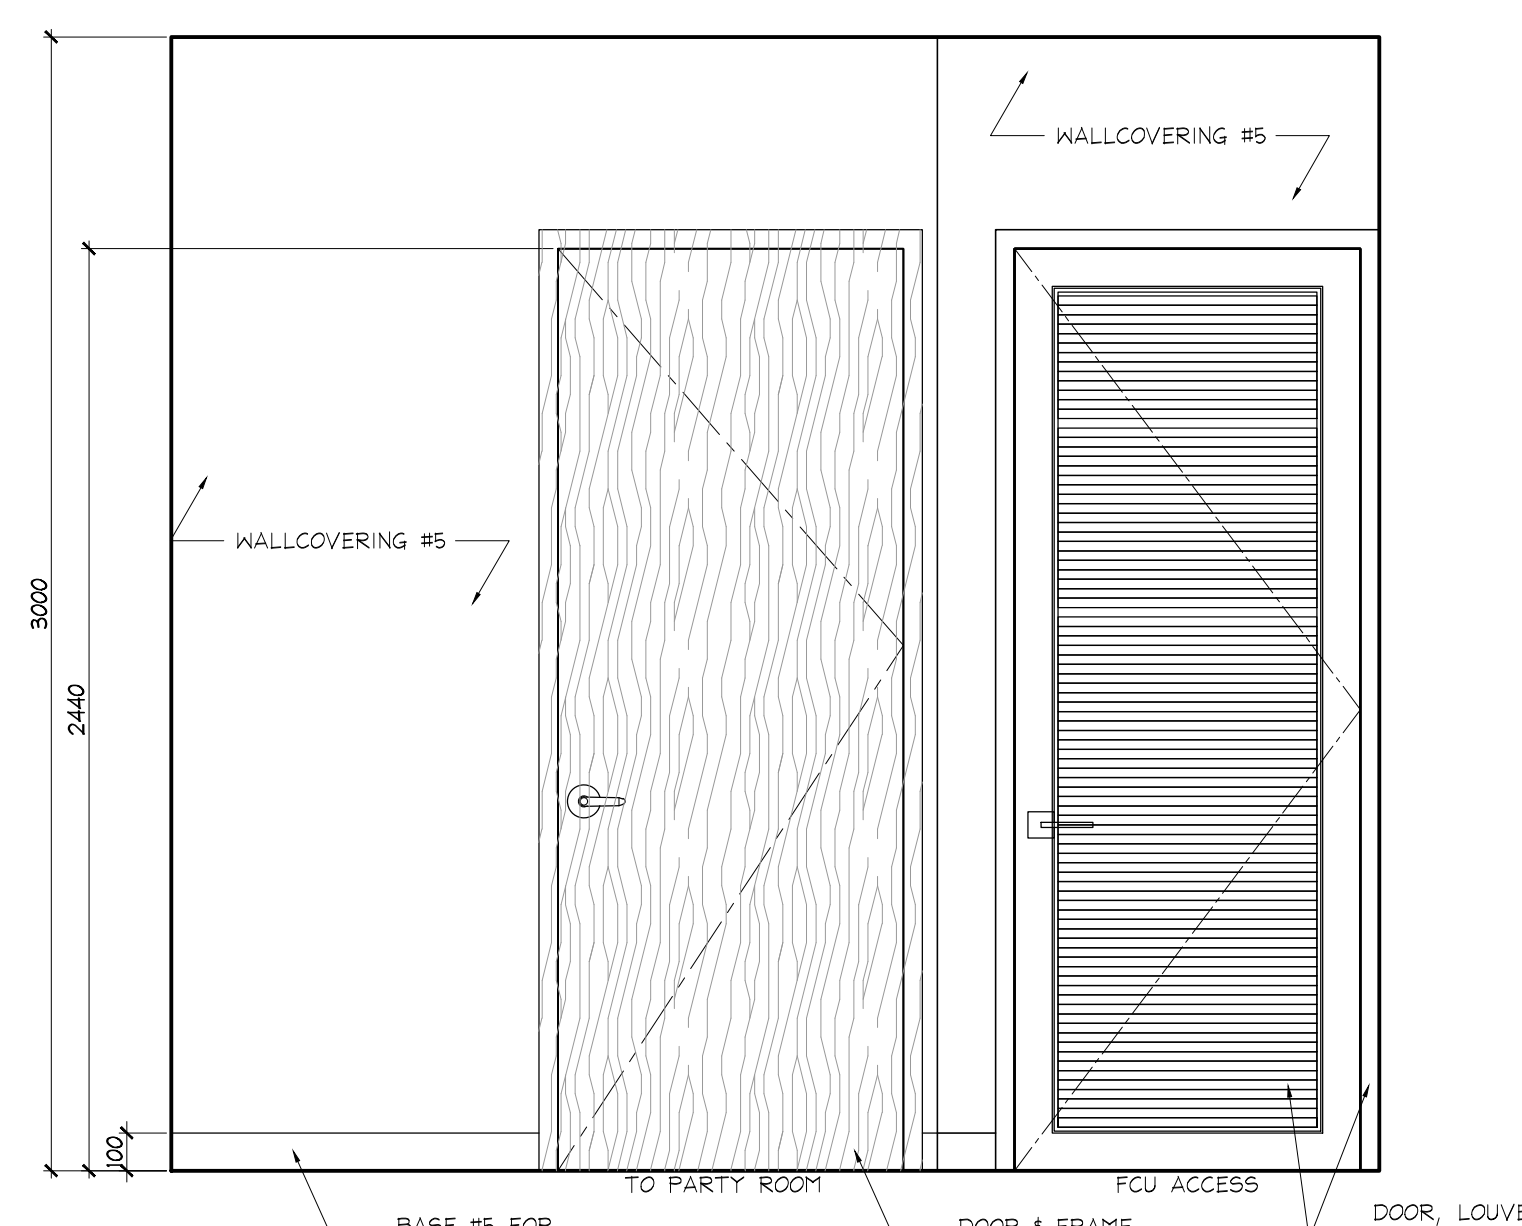

8 ELEVATION
ID2.14 GROUND FLOOR
KITCHEN
SCALE 1:20

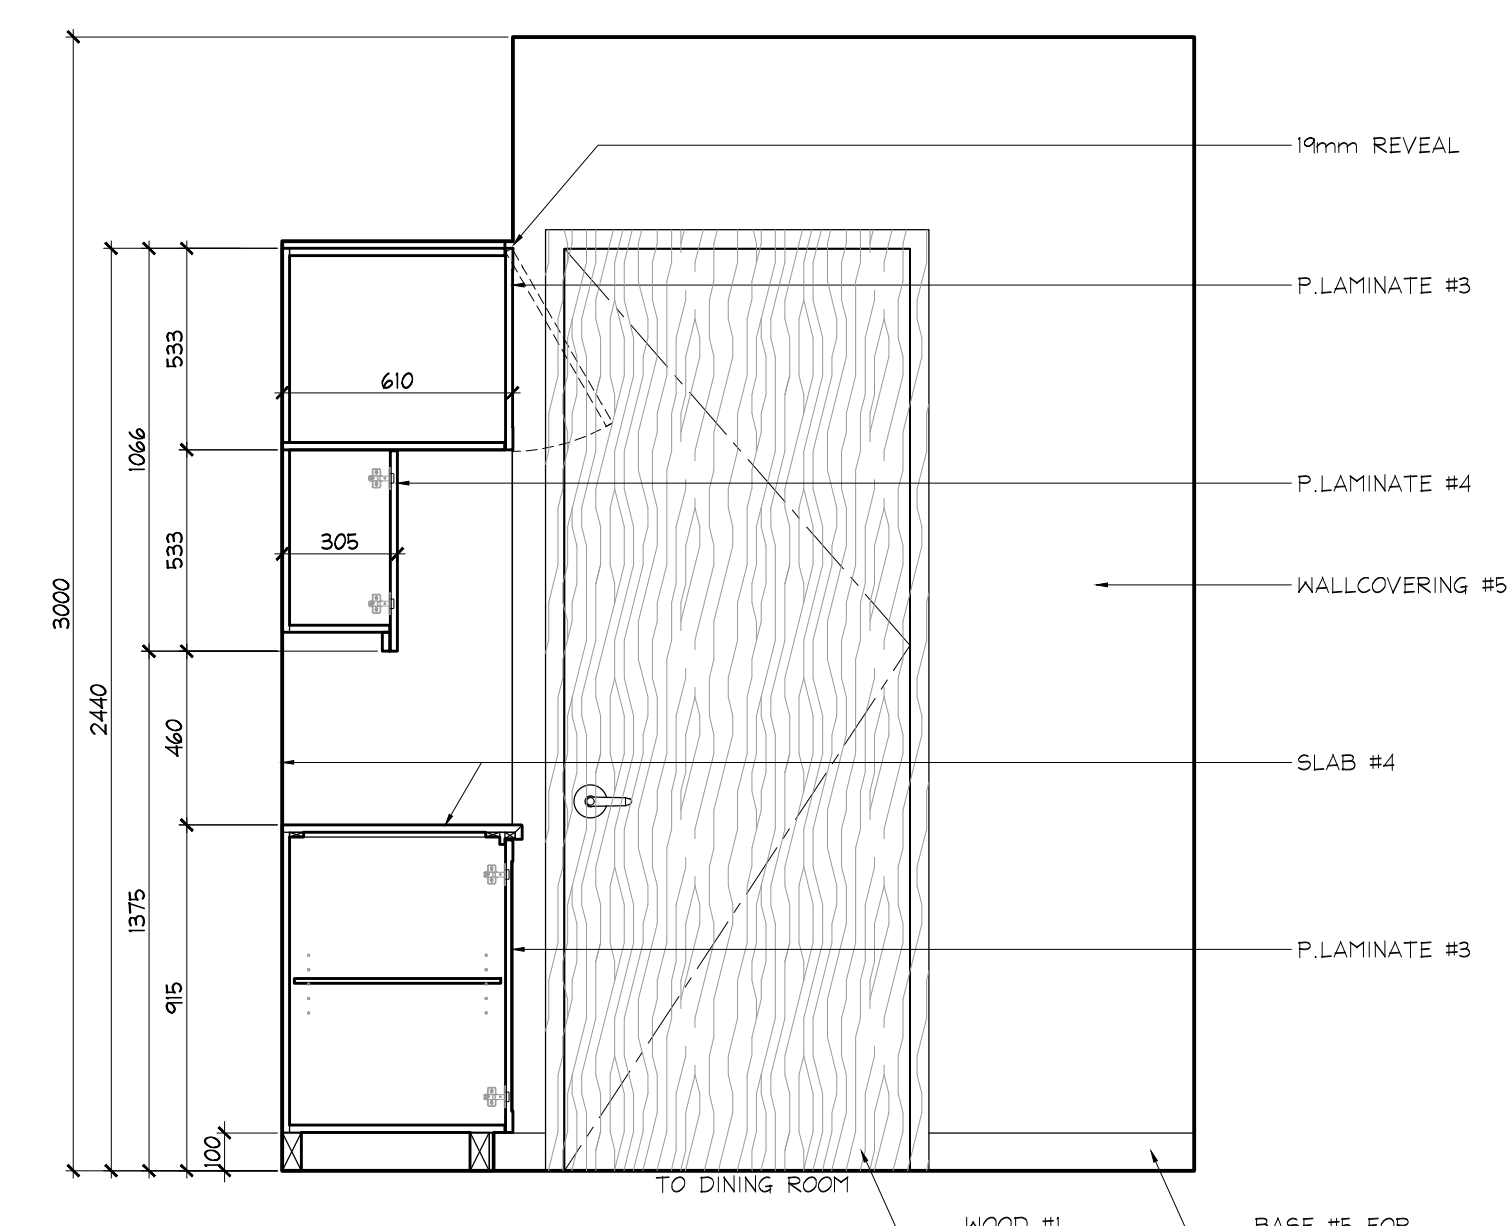

9 ELEVATION
ID2.14 GROUND FLOOR
KITCHEN
SCALE 1:20

DO NOT SCALE DRAWINGS.

CONTRACTOR MUST VERIFY ALL DRAWINGS, DIMENSIONS, DETAILS AND SPECIFICATIONS AND REPORT ANY DISCREPANCIES TO UNION 31 INC. BEFORE PROCEEDING WITH WORK. MATERIALS MAY NOT BE SUBSTITUTED WITHOUT WRITTEN APPROVAL FROM UNION 31 INC.

ALL DRAWINGS AND SPECIFICATIONS ARE INSTRUMENTS OF SERVICE AND THE PROPERTY OF UNION 31 INC. WHICH MUST BE RETURNED AT THE COMPLETION OF THE WORK.

PRINTED: 30-M8-17

ISSUED FOR
AS-BUILT

01	31 MAY / 17	ISSUED FOR AS-BUILT	SV
NO.	DATE	COMMENTS	INI

REVISIONS:

UNION 31

UNION31 INC.
183 BATHURST STREET, STE. 201
TORONTO, ON, M5T 2R7, CANADA
TEL: 416-597-1576 FAX: 416-597-2139

PROJECT NAME:
ALEXANDRA PARK
MAIN BUILDING
BLOCK 11
ON, Canada
PROJECT NO.:
13-949
DRAWINGS:
GROUND FLOOR
ELEVATIONS

DATE STARTED: 07 AUG / 13
SCALE: 1:20
DRAWN BY: AP
APPROVED BY: KC
DRAWING NO.:
ID
2.1.4

DO NOT SCALE DRAWINGS.

CONTRACTOR MUST VERIFY ALL DRAWINGS, DIMENSIONS, DETAILS AND SPECIFICATIONS AND REPORT ANY DISCREPANCIES TO UNION 31 INC. BEFORE PROCEEDING WITH WORK. MATERIALS MAY NOT BE SUBSTITUTED WITHOUT WRITTEN APPROVAL FROM UNION 31 INC.

ALL DRAWINGS AND SPECIFICATIONS ARE INSTRUMENTS OF SERVICE AND THE PROPERTY OF UNION 31 INC. WHICH MUST BE RETURNED AT THE COMPLETION OF THE WORK.

PRINTED: 30-MAR-17

ISSUED FOR
AS-BUILT

01	31 MAY / 17	ISSUED FOR AS-BUILT	SV
NO.	DATE	COMMENTS	INI







REVISIONS:

UNION31

UNION31 INC.
183 BATHURST STREET, STE. 201
TORONTO, ON, M5T 2R7, CANADA
TEL: 416-597-1576 FAX: 416-597-2139

PROJECT NAME:
**ALEXANDRA PARK
MAIN BUILDING**
BLOCK 11
ON, Canada
PROJECT NO.:
13-949
DRAWINGS:
**GROUND FLOOR
ELEVATIONS**

DATE STARTED: 07 AUG / 13	DRAWING NO.: ID 2.1.5
SCALE: 1 : 20	
DRAWN BY: AP	
APPROVED BY: KC	

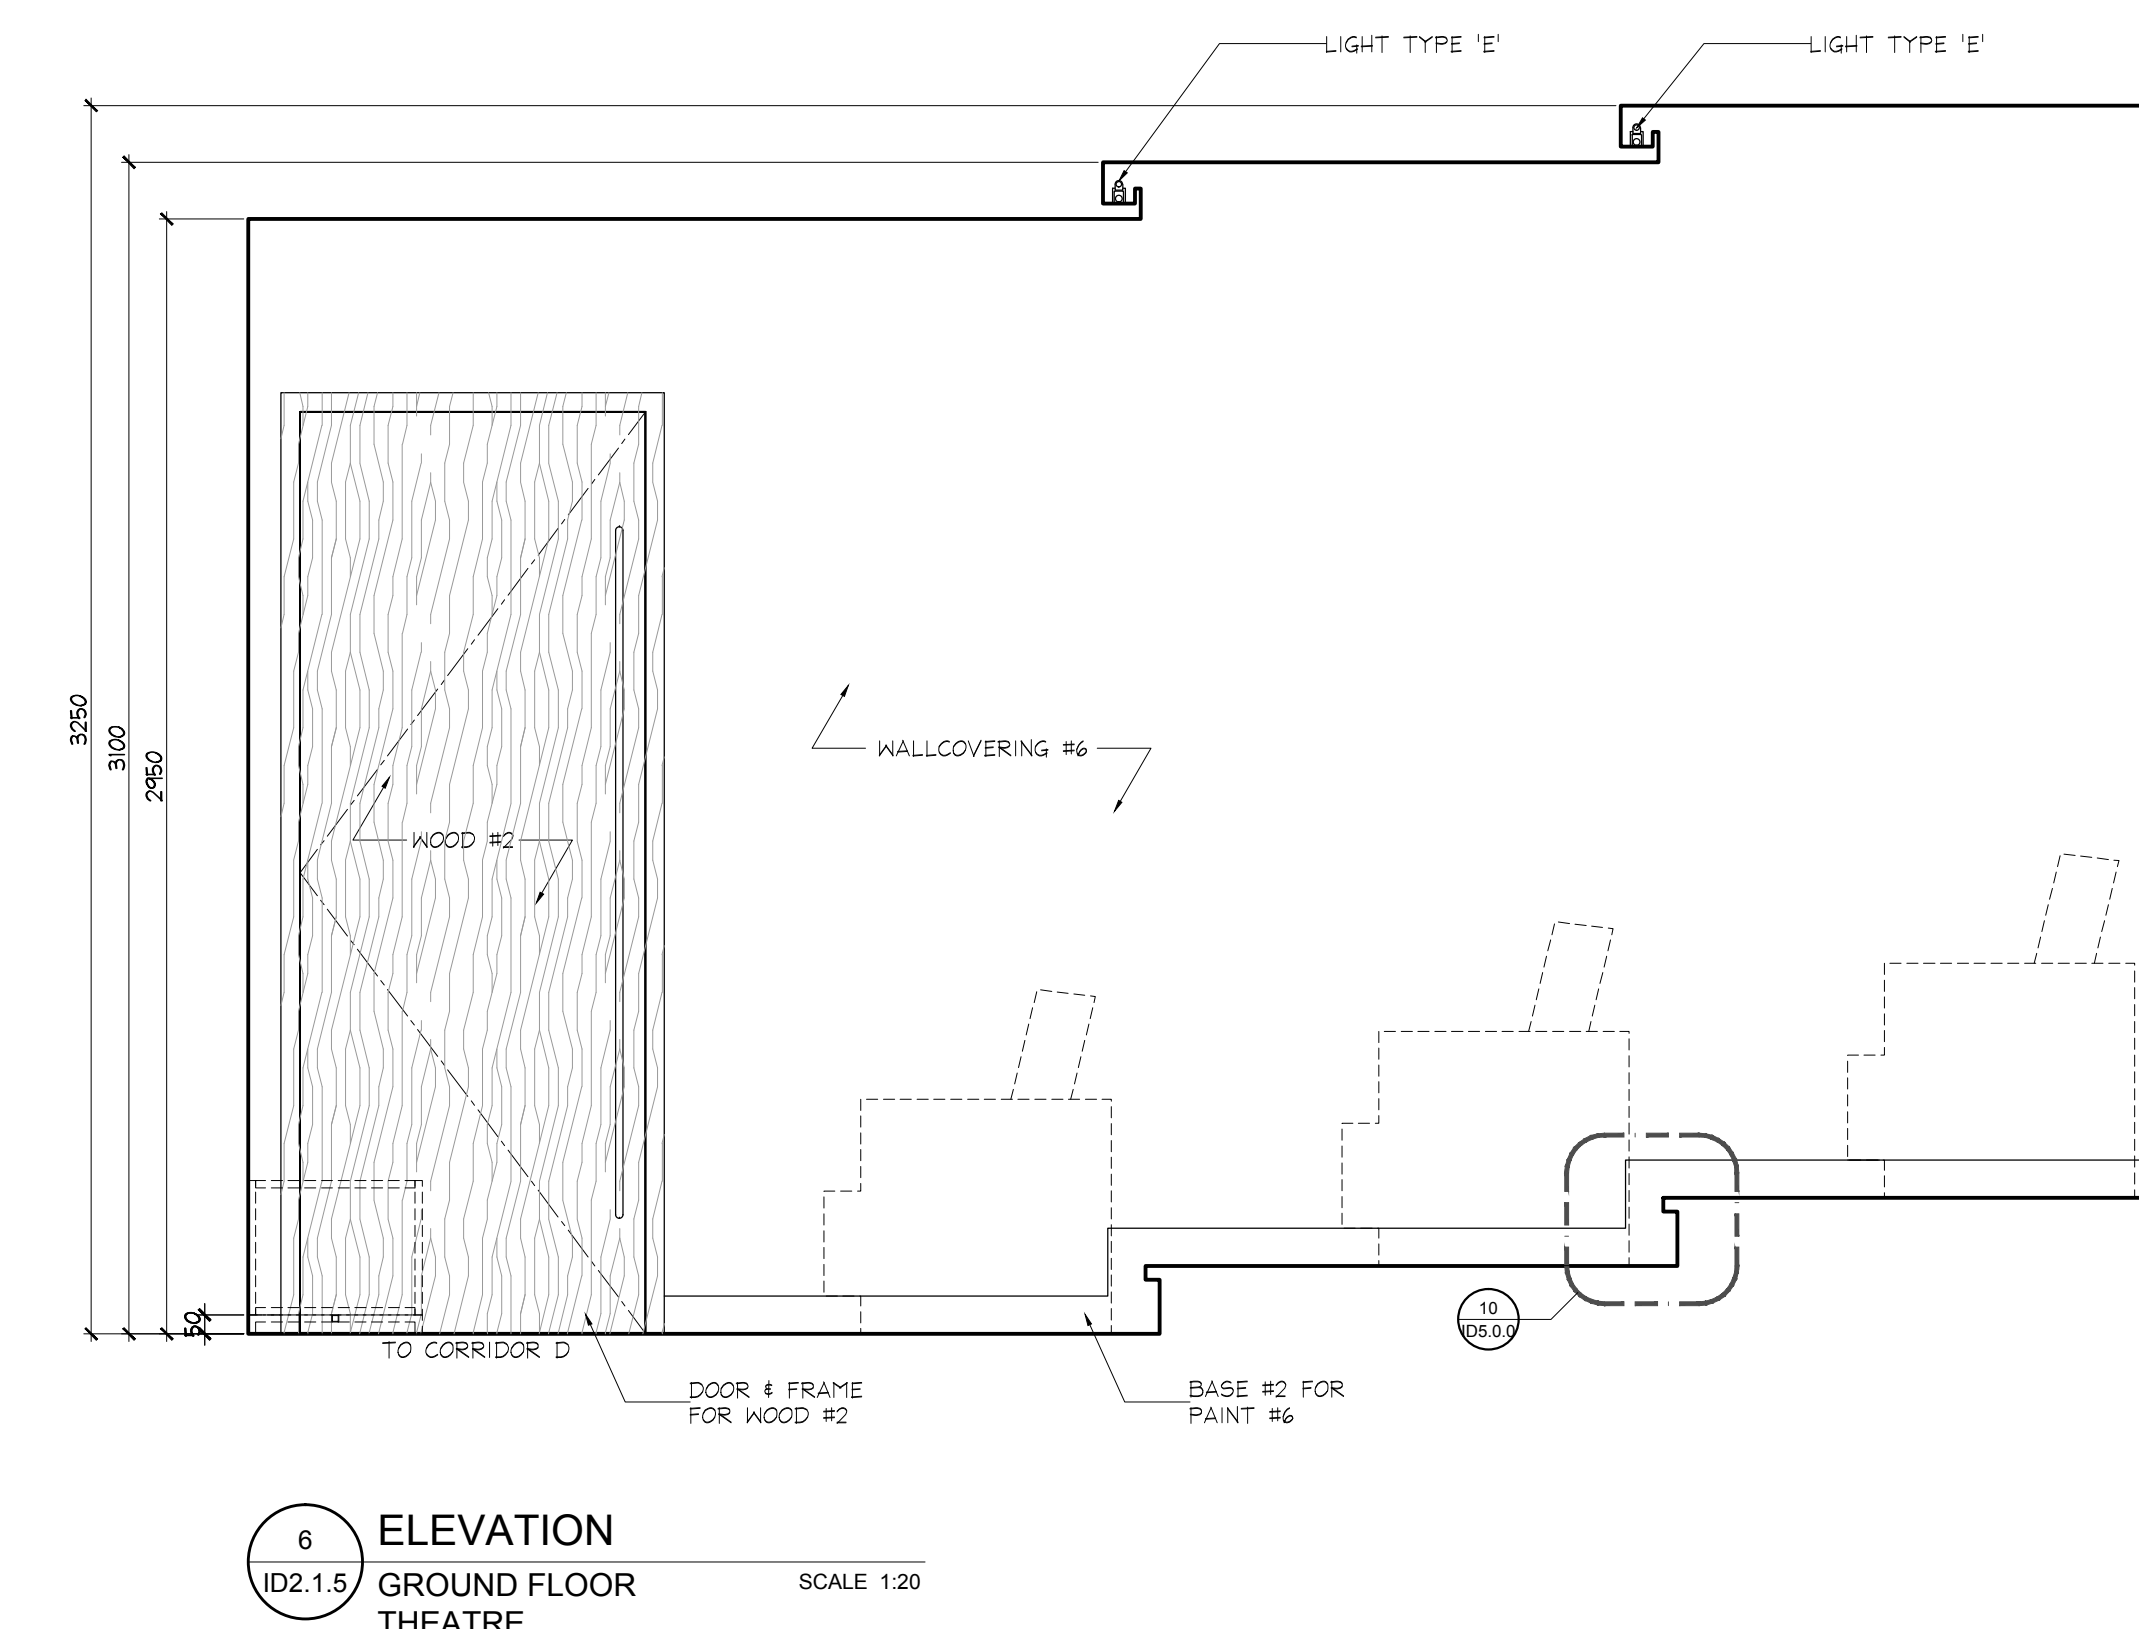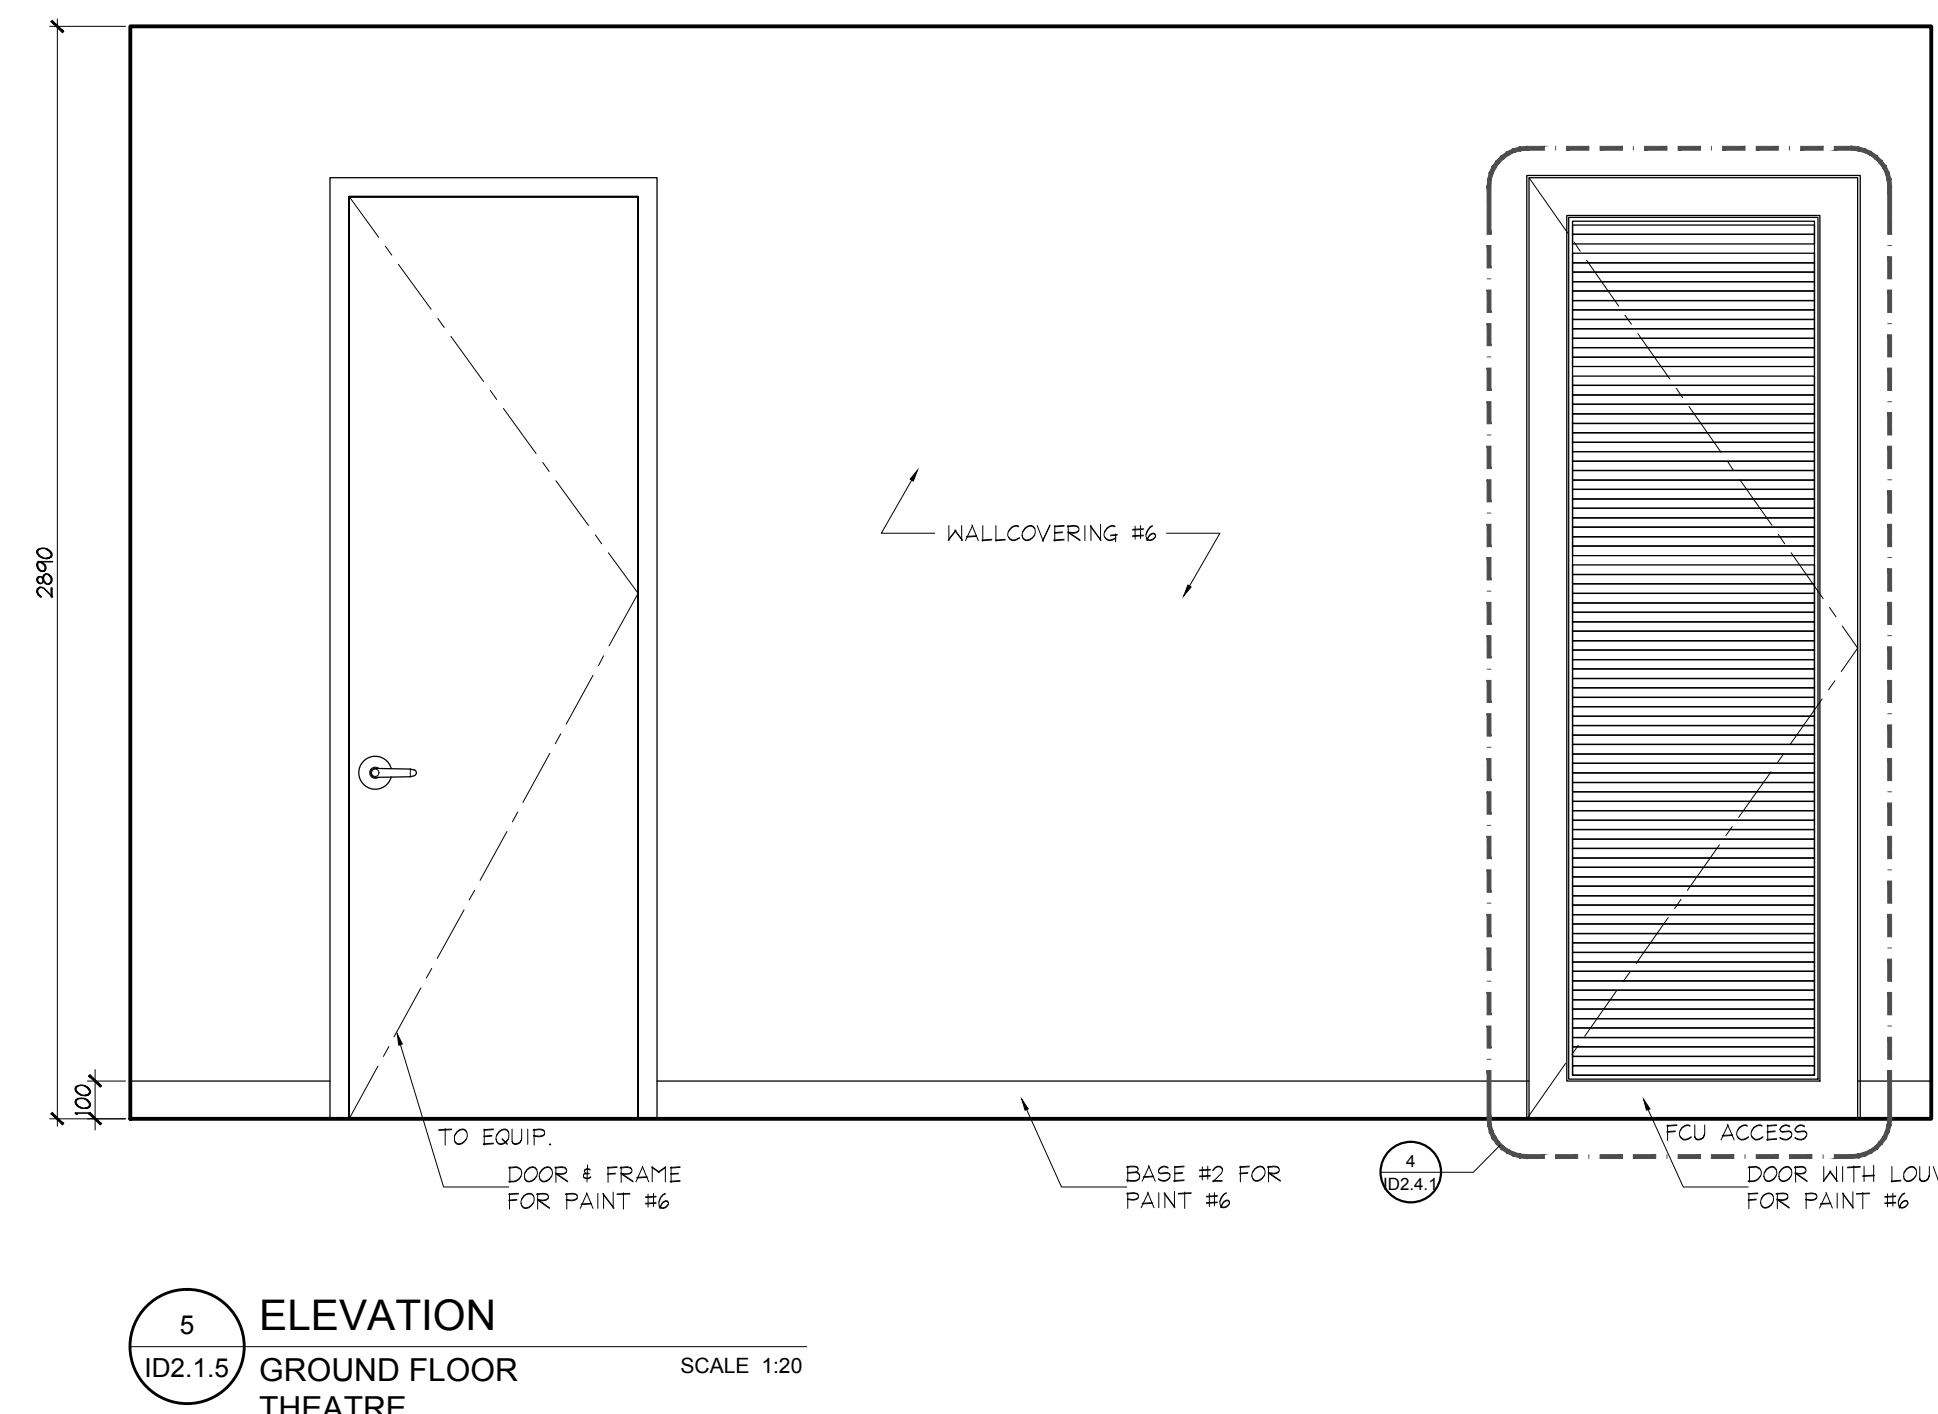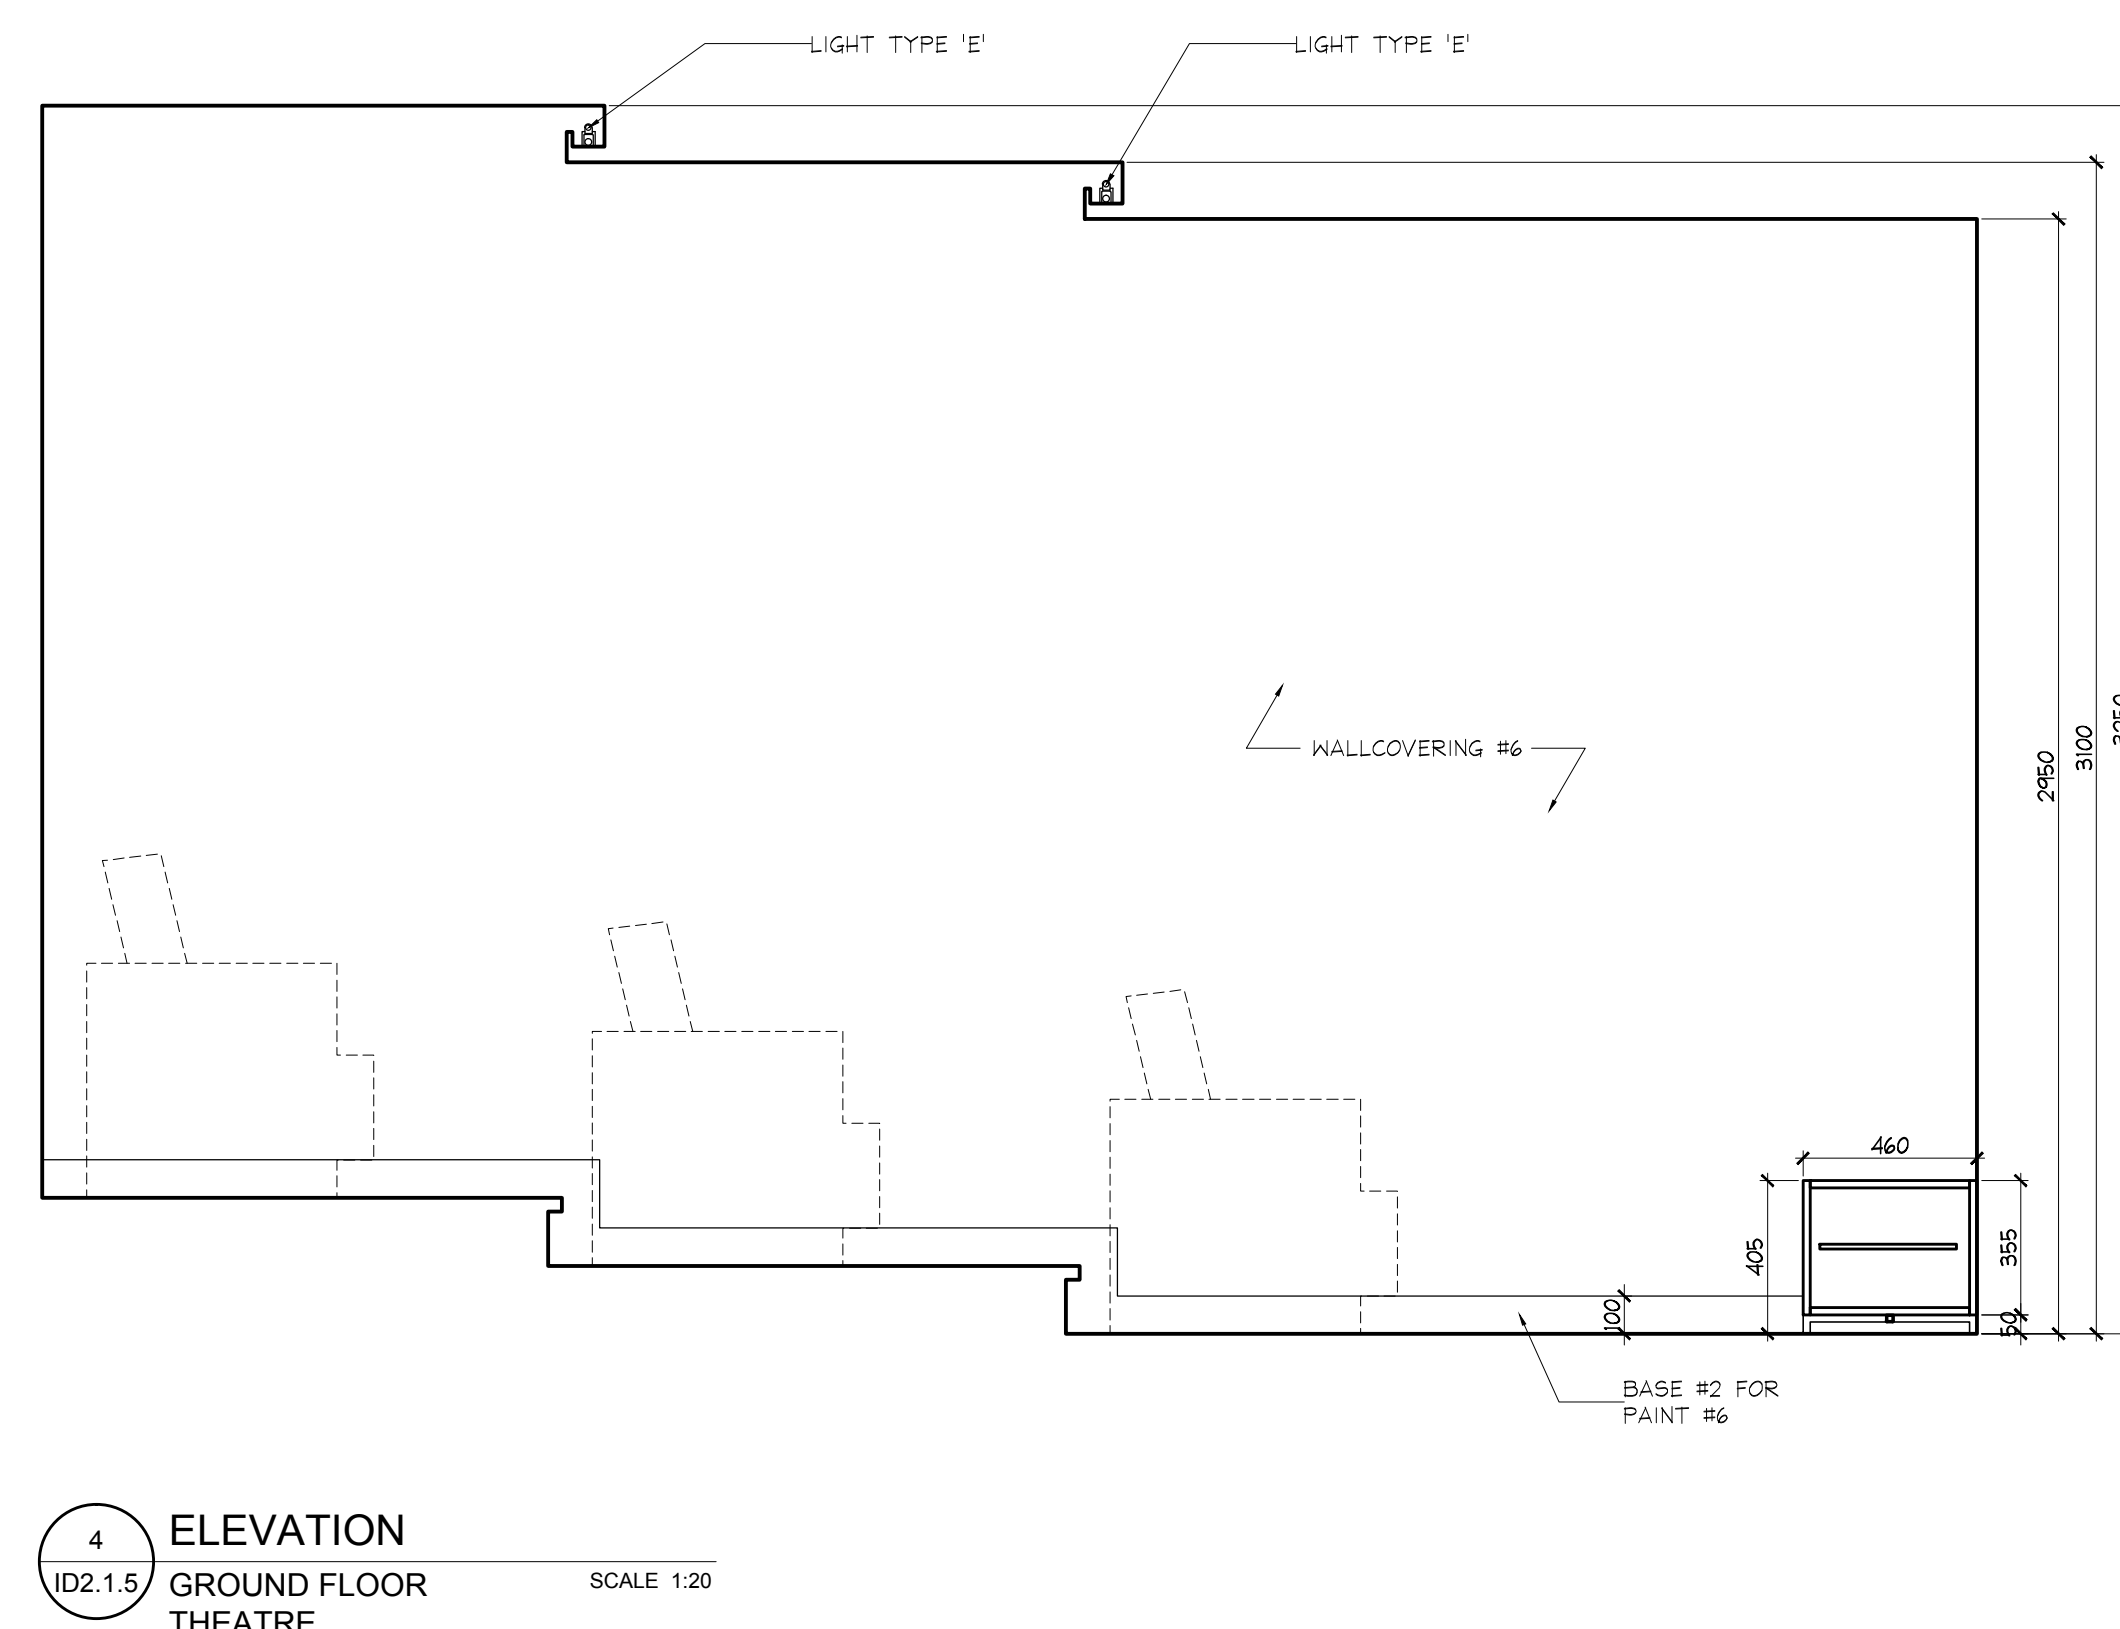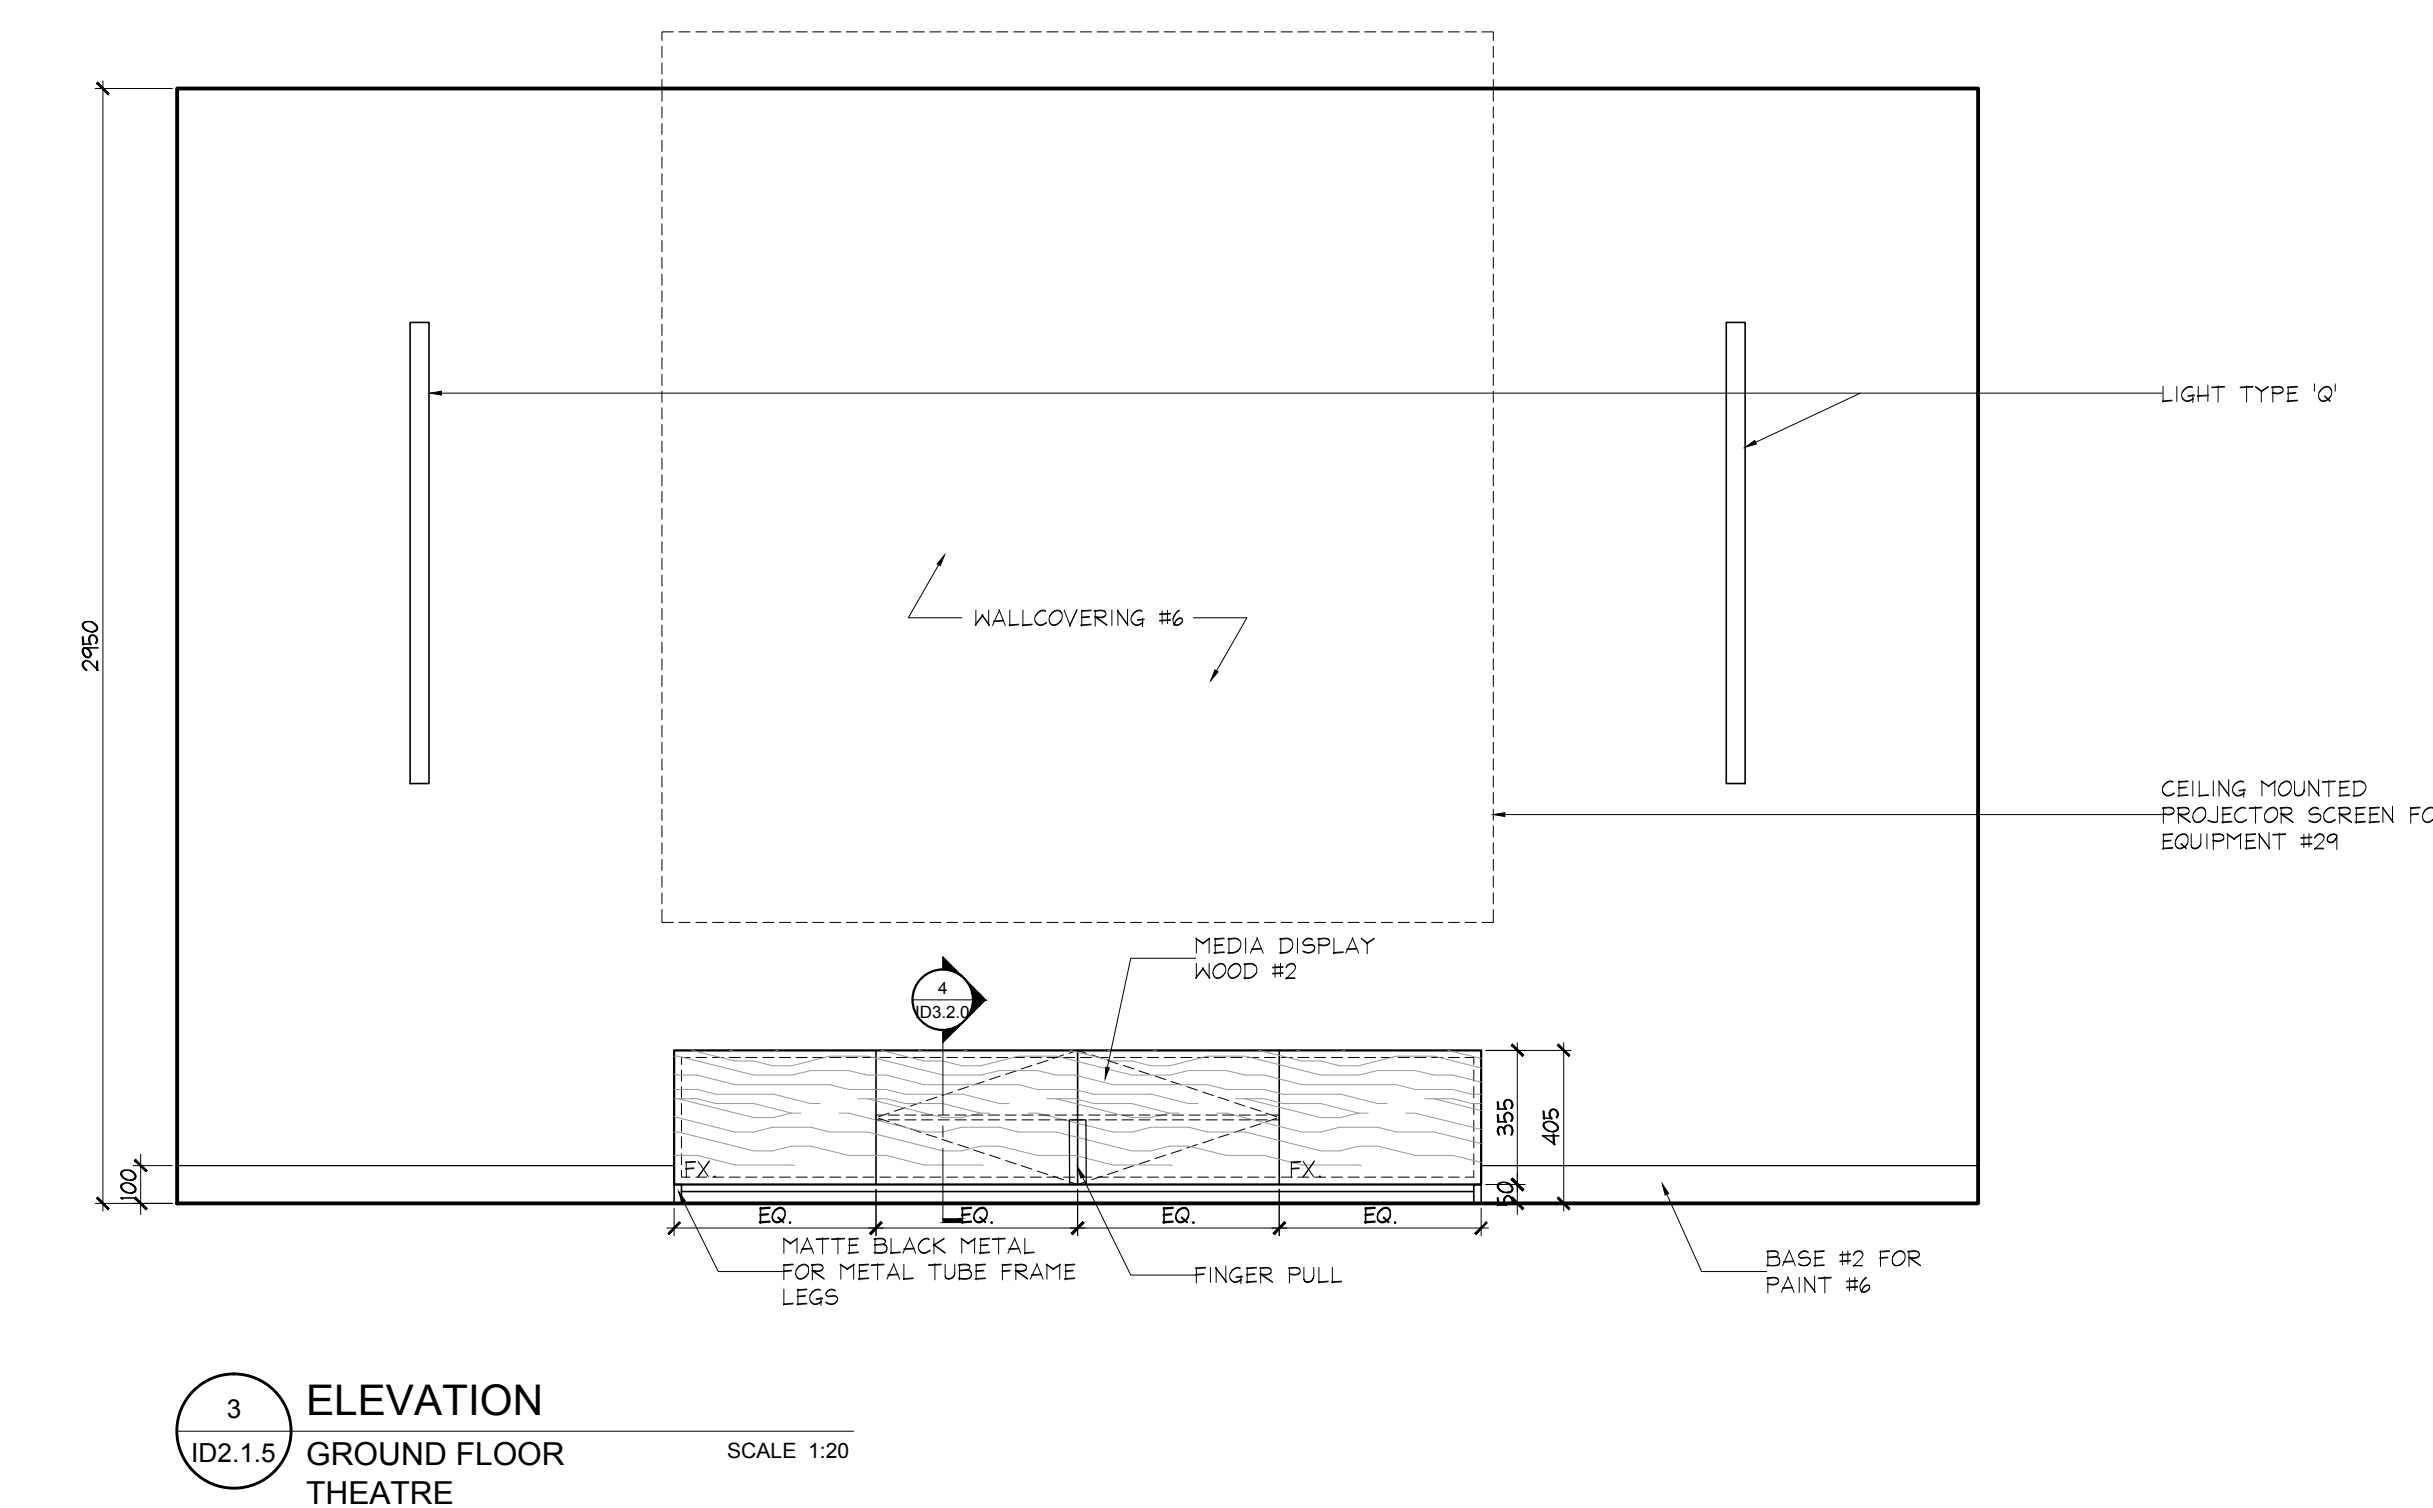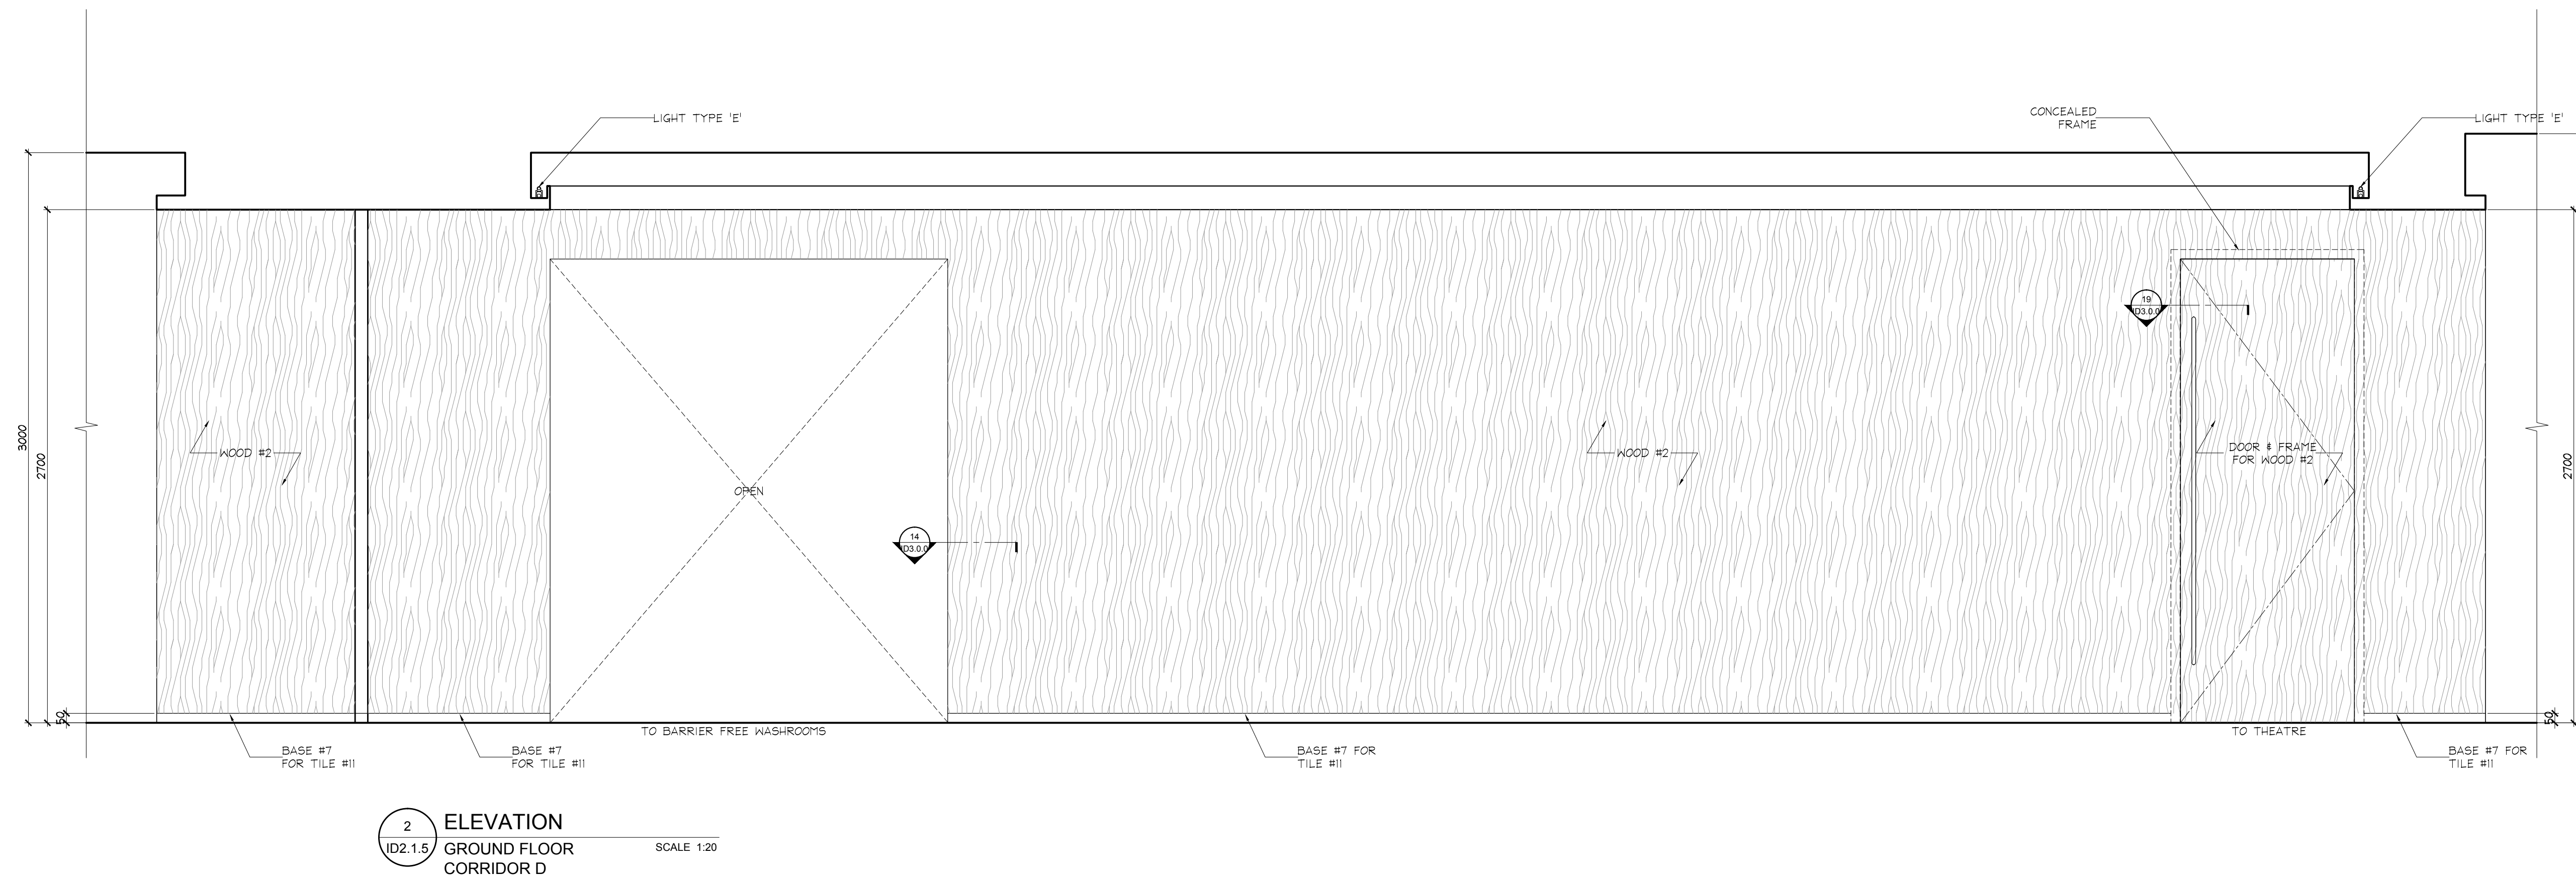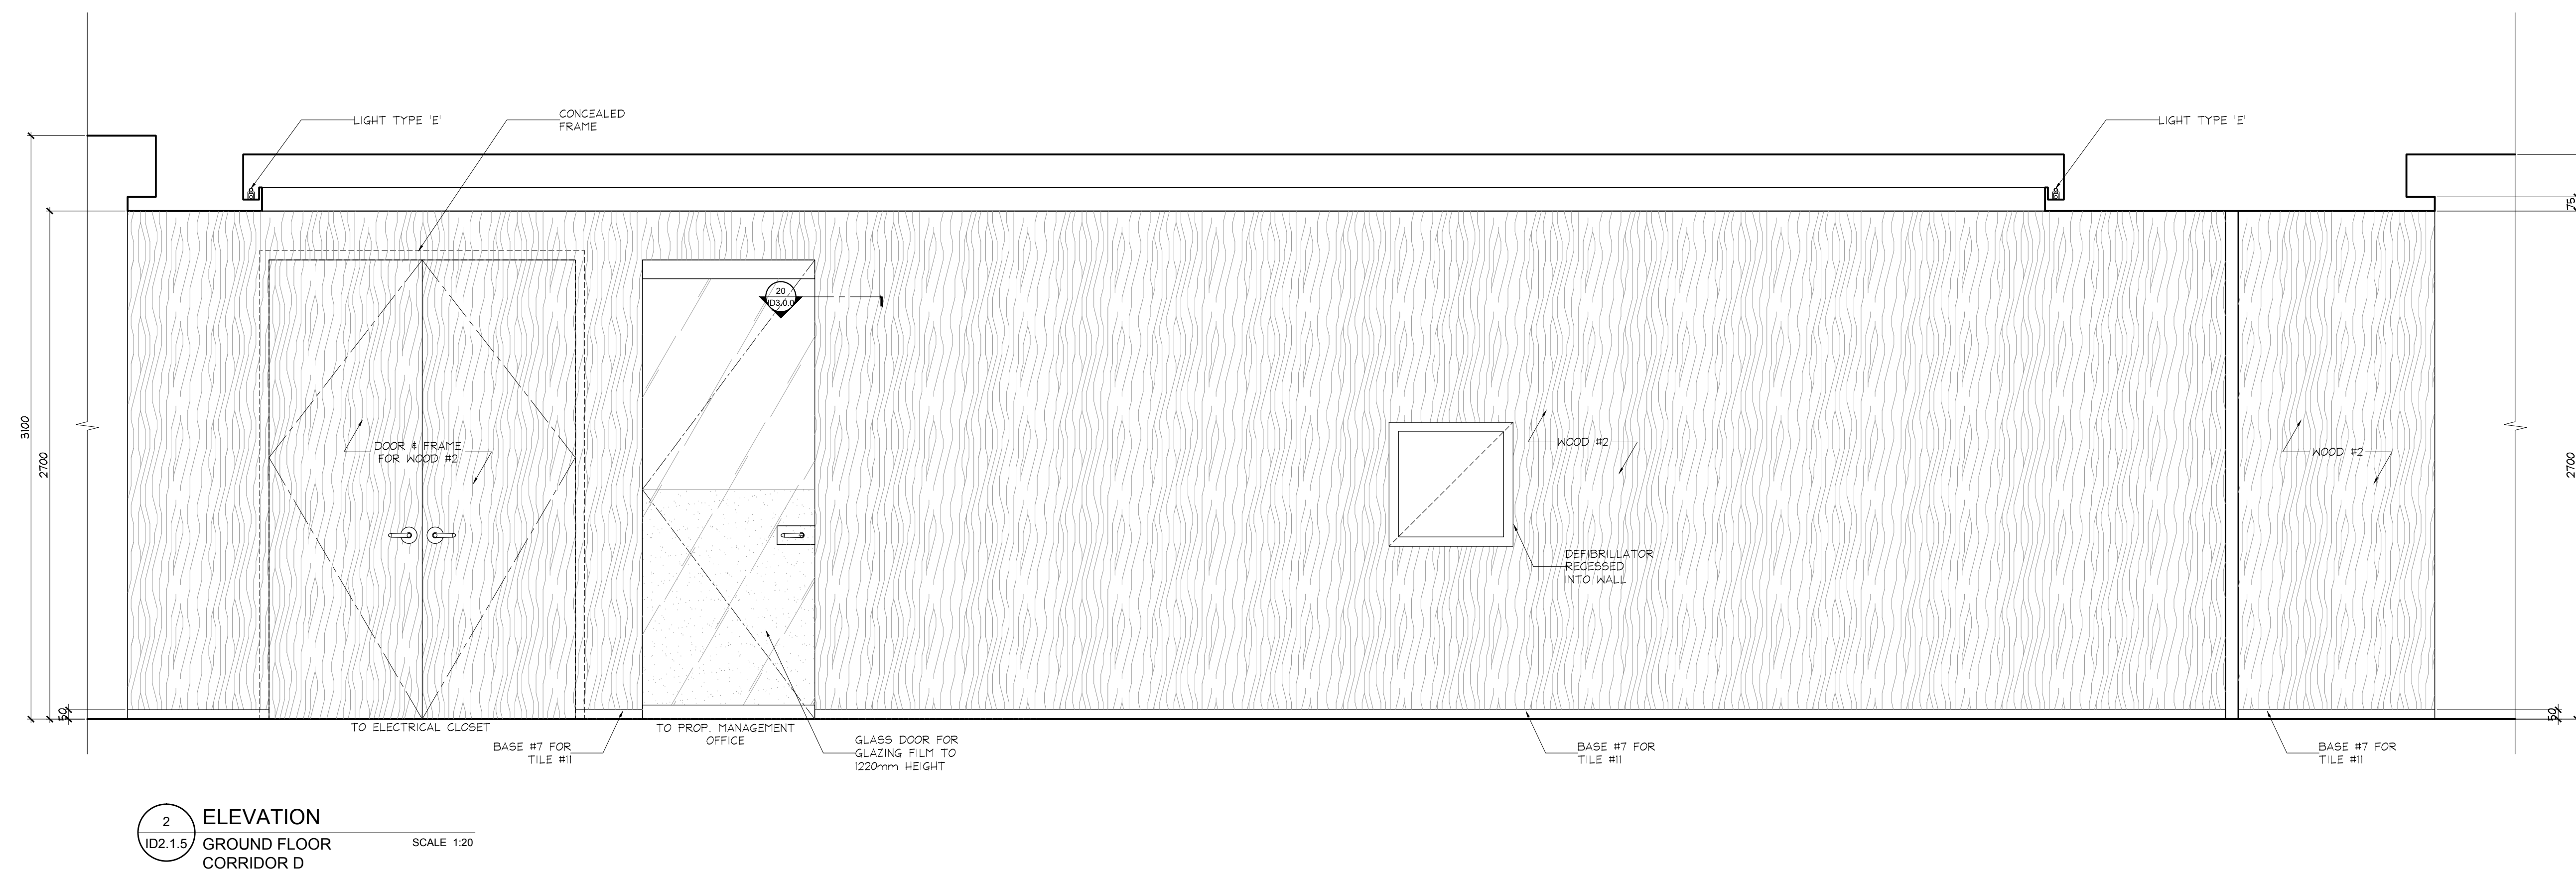

CONTRACTOR MUST VERIFY ALL DRAWINGS, DIMENSIONS, DETAILS AND SPECIFICATIONS, AND REPORT ANY DISCREPANCIES TO UNION 31 INC. BEFORE PROCEEDING WITH WORK. MATERIALS MAY NOT BE SUBSTITUTED WITHOUT WRITTEN APPROVAL FROM UNION 31 INC.

ALL DRAWINGS AND SPECIFICATIONS ARE INSTRUMENTS OF SERVICE AND THE PROPERTY OF UNION 31 INC. WHICH MUST BE RETURNED AT THE COMPLETION OF THE WORK.

DATE STARTED: 07 AUG / 13	DRAWING NO.: ID 2.1.6
SCALE: 1 : 20	
DRAWN BY: AP	
APPROVED BY: KC	

DO NOT SCALE DRAWINGS.

CONTRACTOR MUST VERIFY ALL DRAWINGS, DIMENSIONS, DETAILS AND SPECIFICATIONS. AND REPORT ANY DISCREPANCIES TO UNION 31 INC. BEFORE PROCEEDING WITH WORK. MATERIALS MAY NOT BE SUBSTITUTED WITHOUT WRITTEN APPROVAL FROM UNION 31 INC.

ALL DRAWINGS AND SPECIFICATIONS ARE INSTRUMENTS OF SERVICE AND THE PROPERTY OF UNION 31 INC. WHICH MUST BE RETURNED AT THE COMPLETION OF THE WORK.

PRINTED: 30MAR17

ISSUED FOR
AS-BUILT









01	31 MAY / 17	ISSUED FOR AS-BUILT	SV
NO.	DATE	COMMENTS	INI
REVISIONS:			

UNION31

UNION31 INC.
183 BATHURST STREET, STE. 201
TORONTO, ON, M5T 2R7, CANADA
TEL: 416-597-1576 FAX: 416-597-2139

PROJECT NAME:	
ALEXANDRA PARK MAIN BUILDING	
BLOCK 11 ON, Canada	
PROJECT NO.:	13-949
DRAWINGS:	
GROUND FLOOR ELEVATIONS	

DATE STARTED:	07 AUG / 13	DRAWING NO.:
SCALE:	1 : 20	ID
DRAWN BY:	AP	2.1.7
APPROVED BY:	KC	

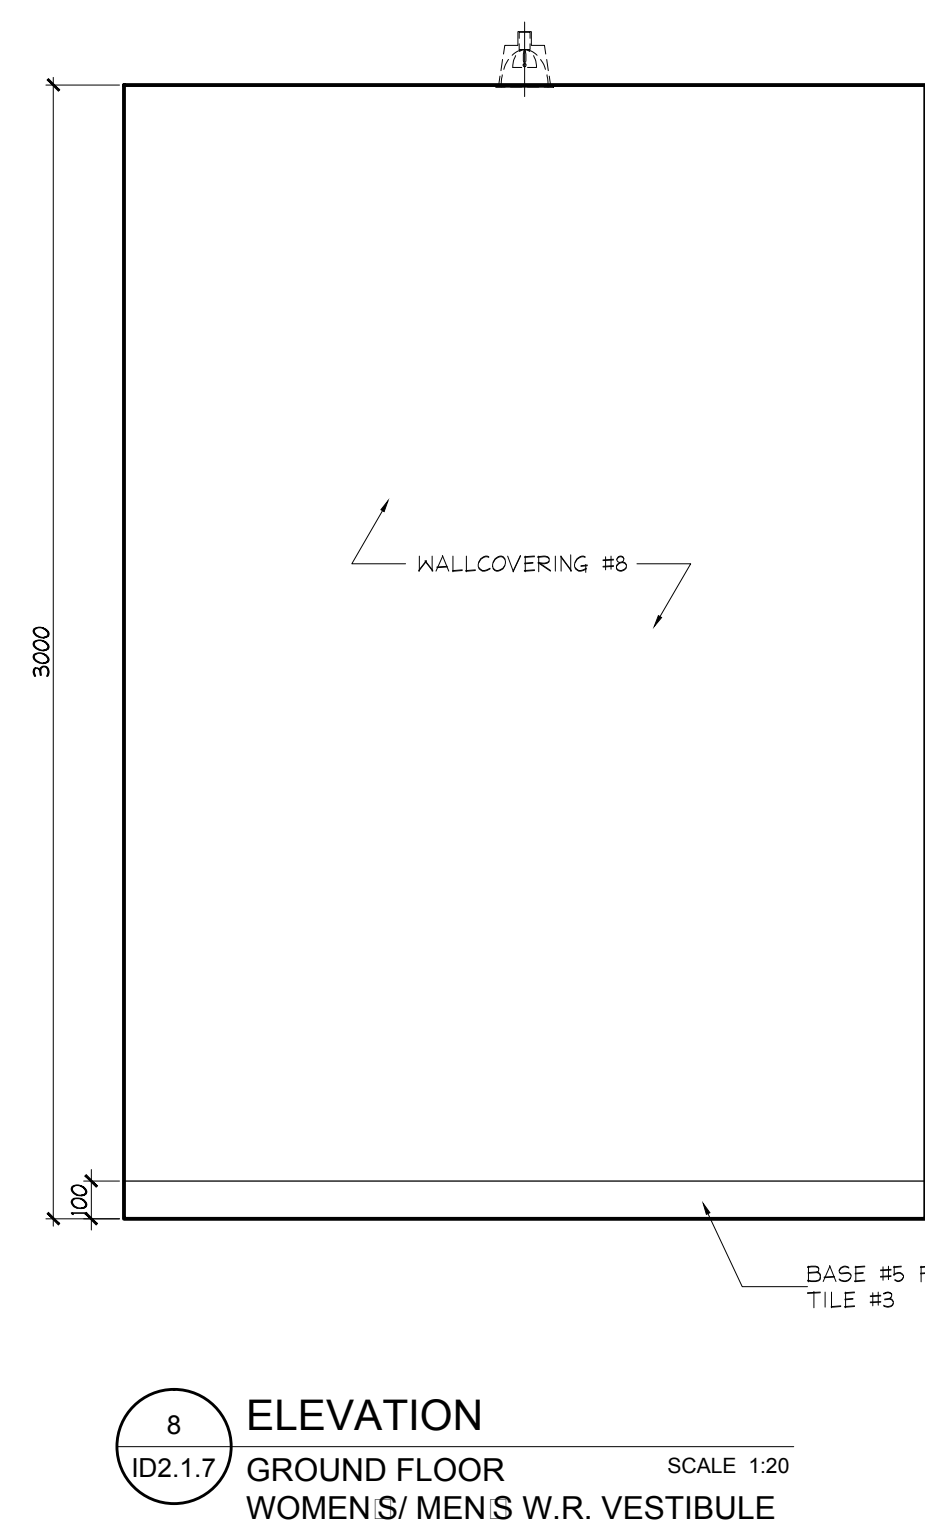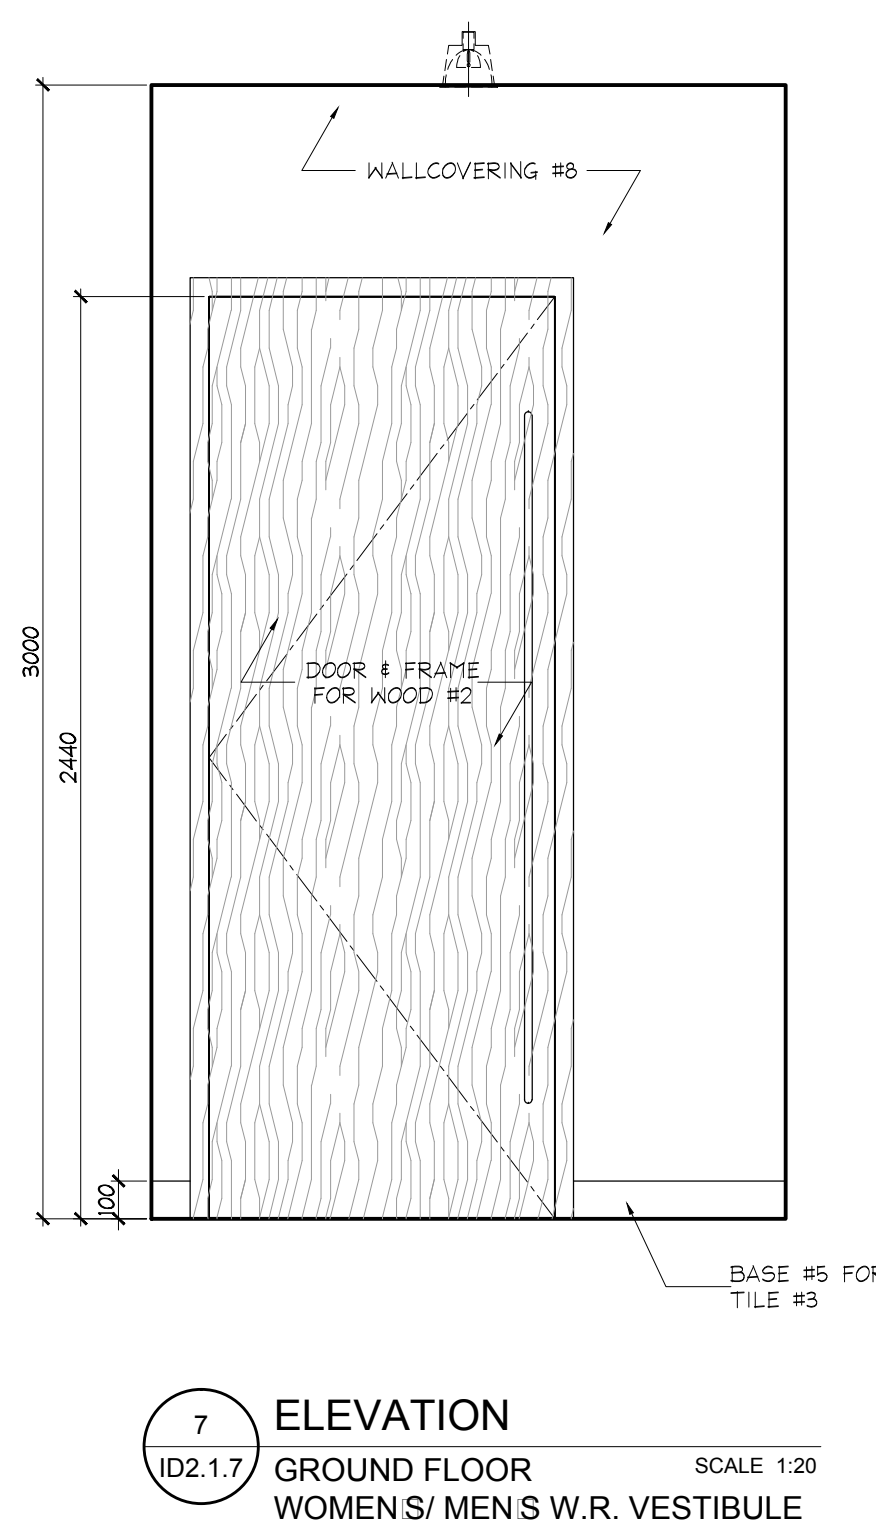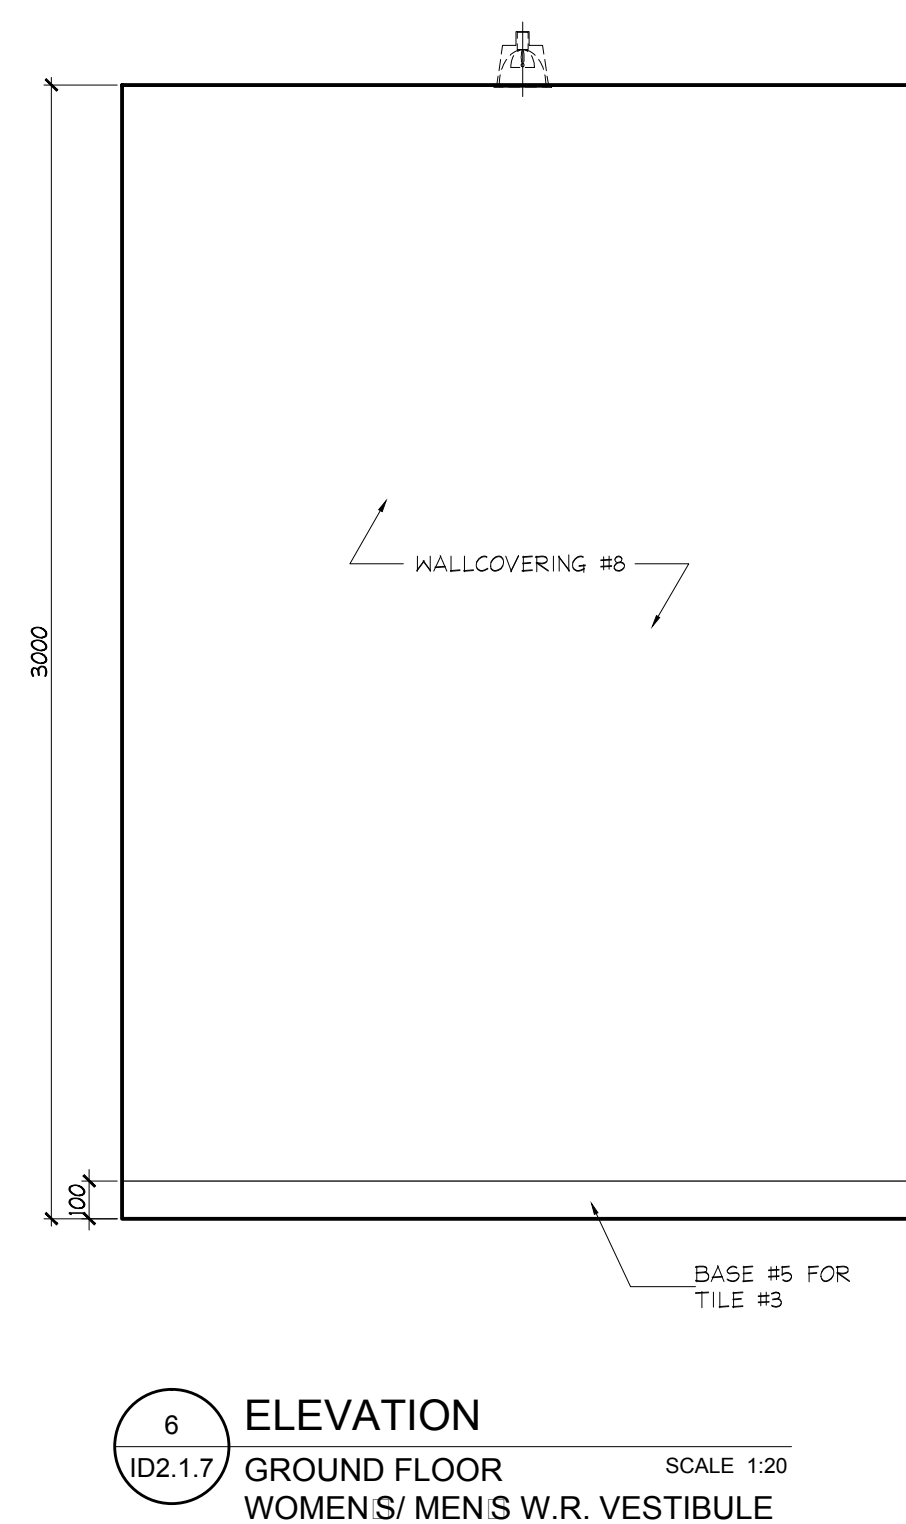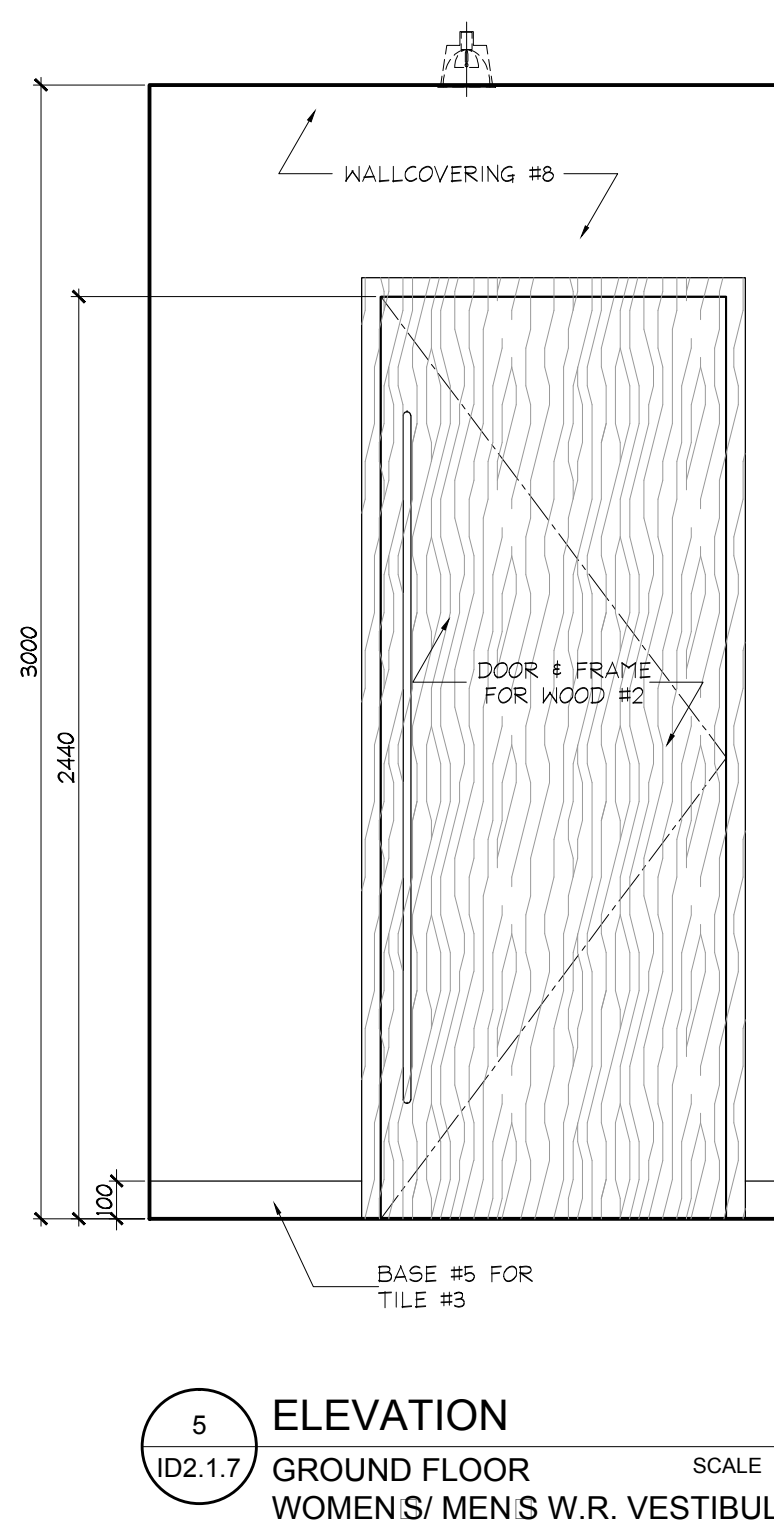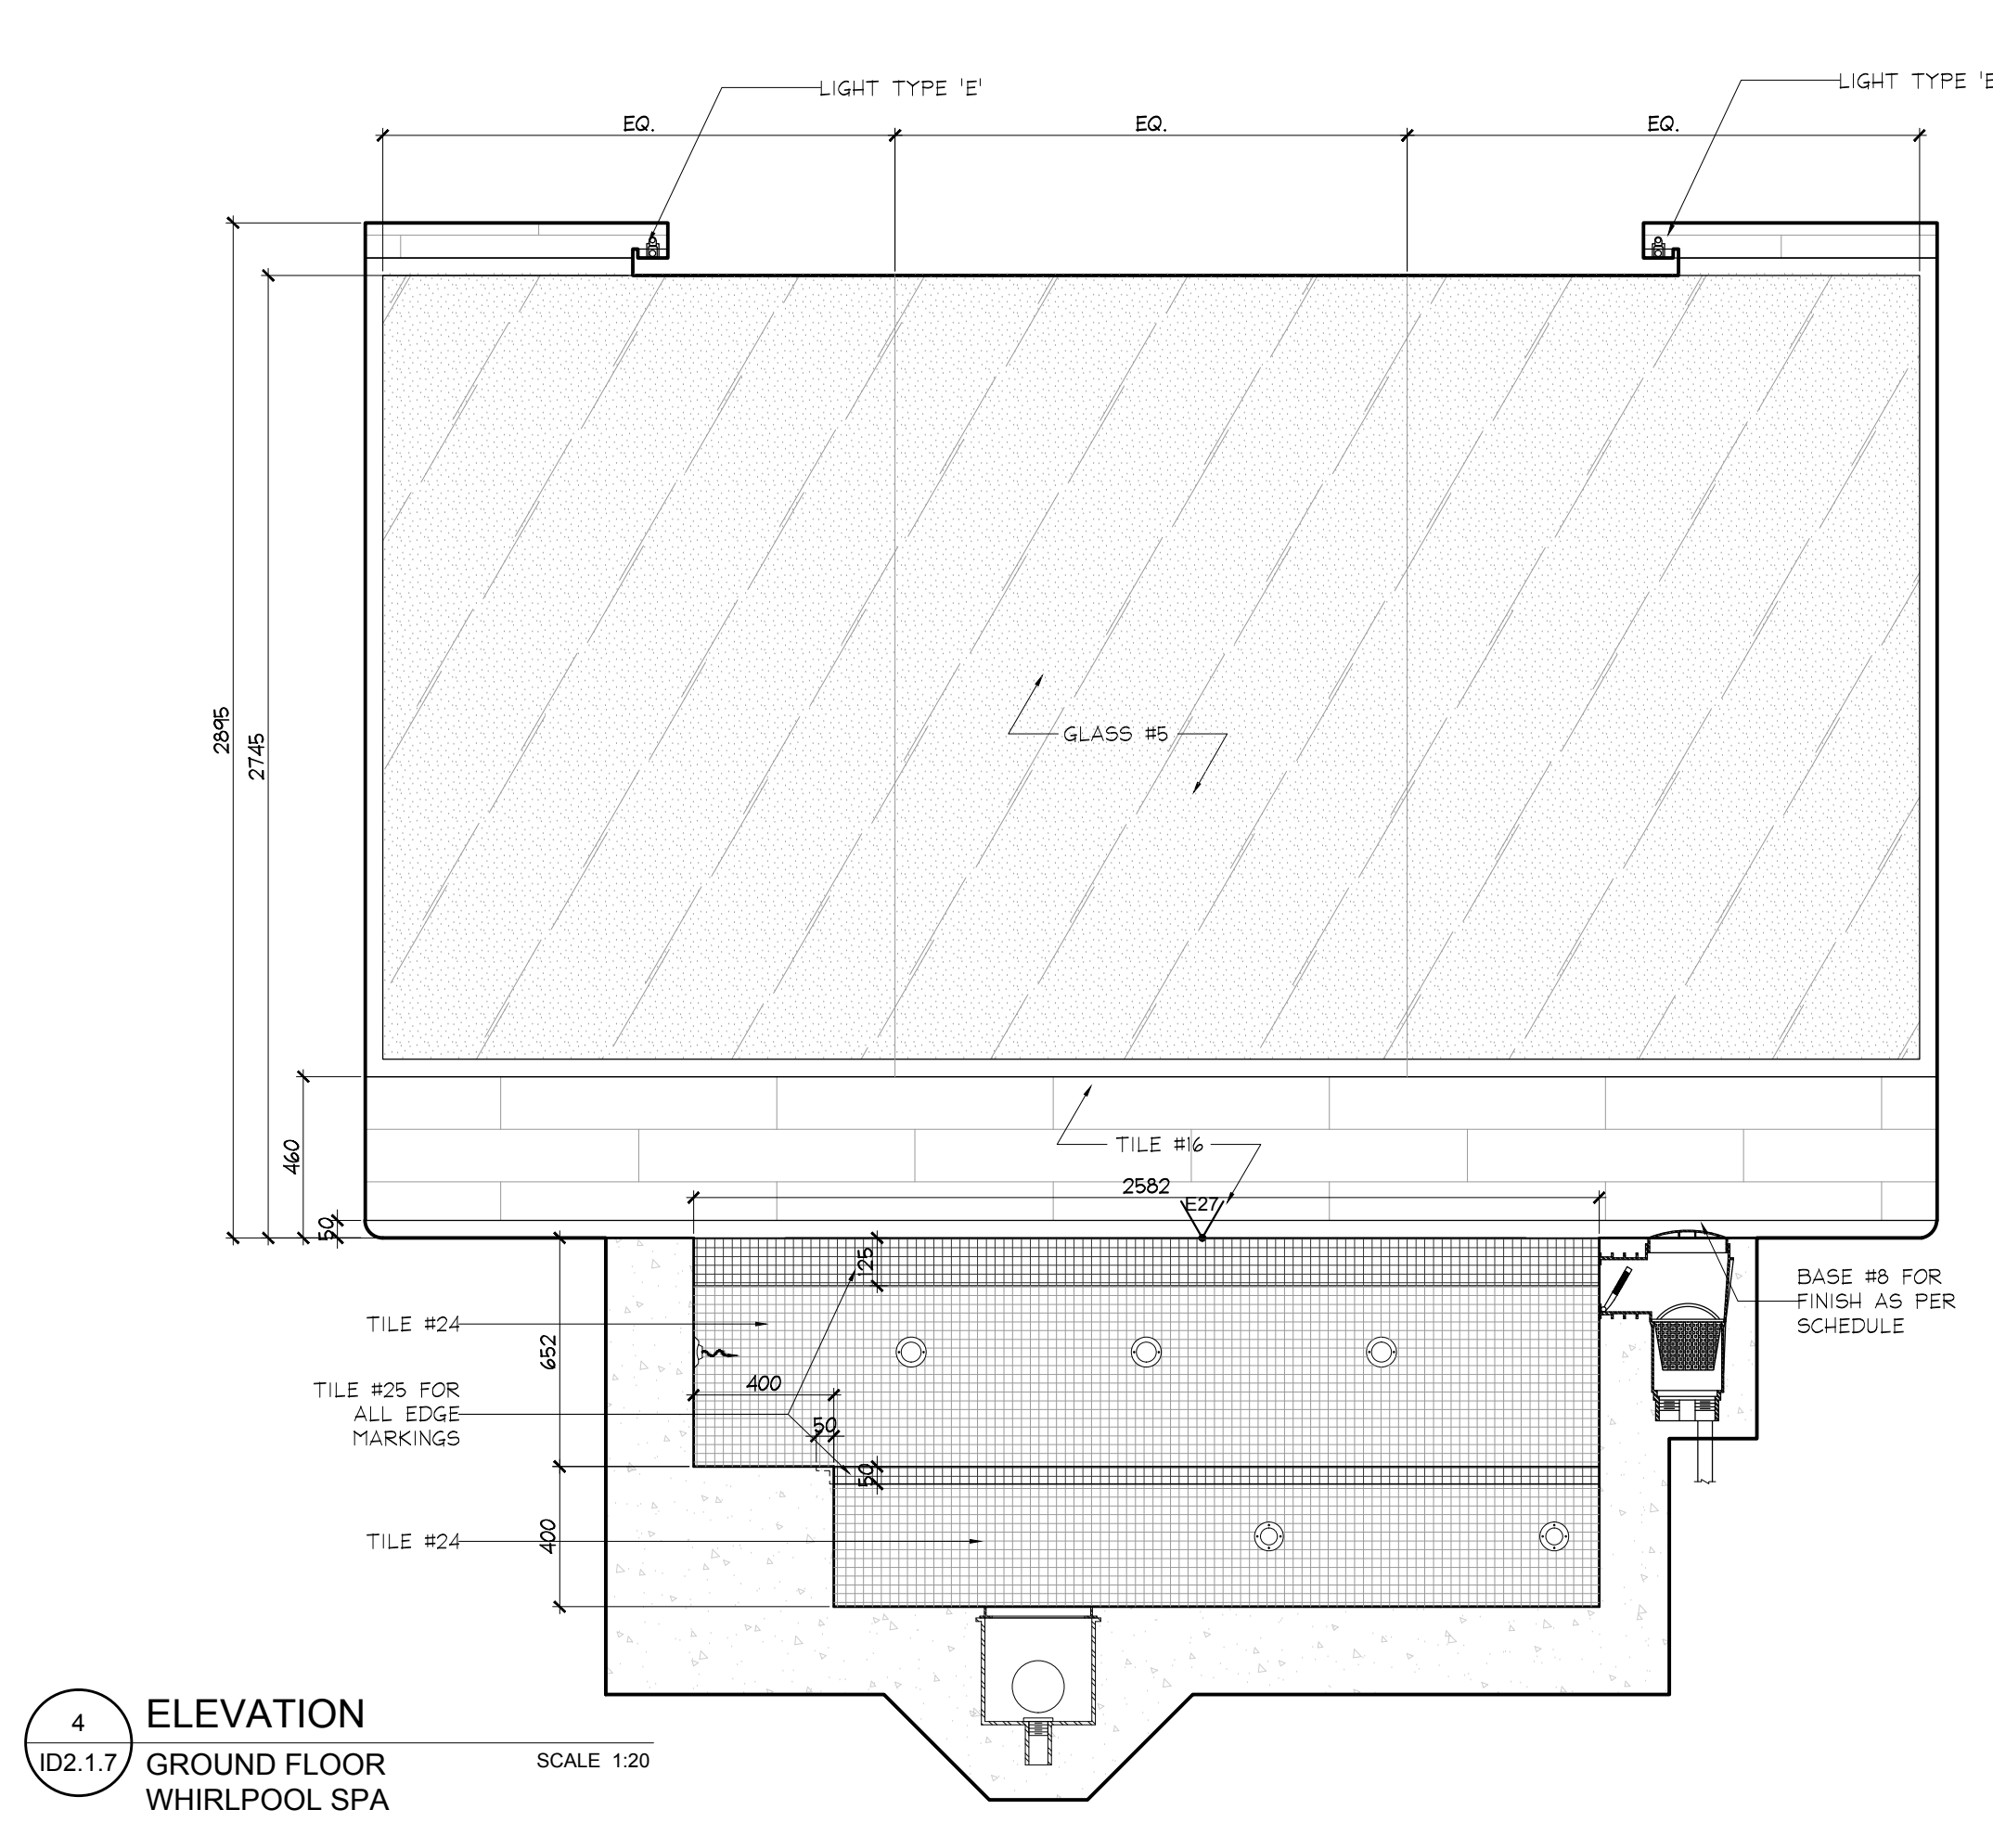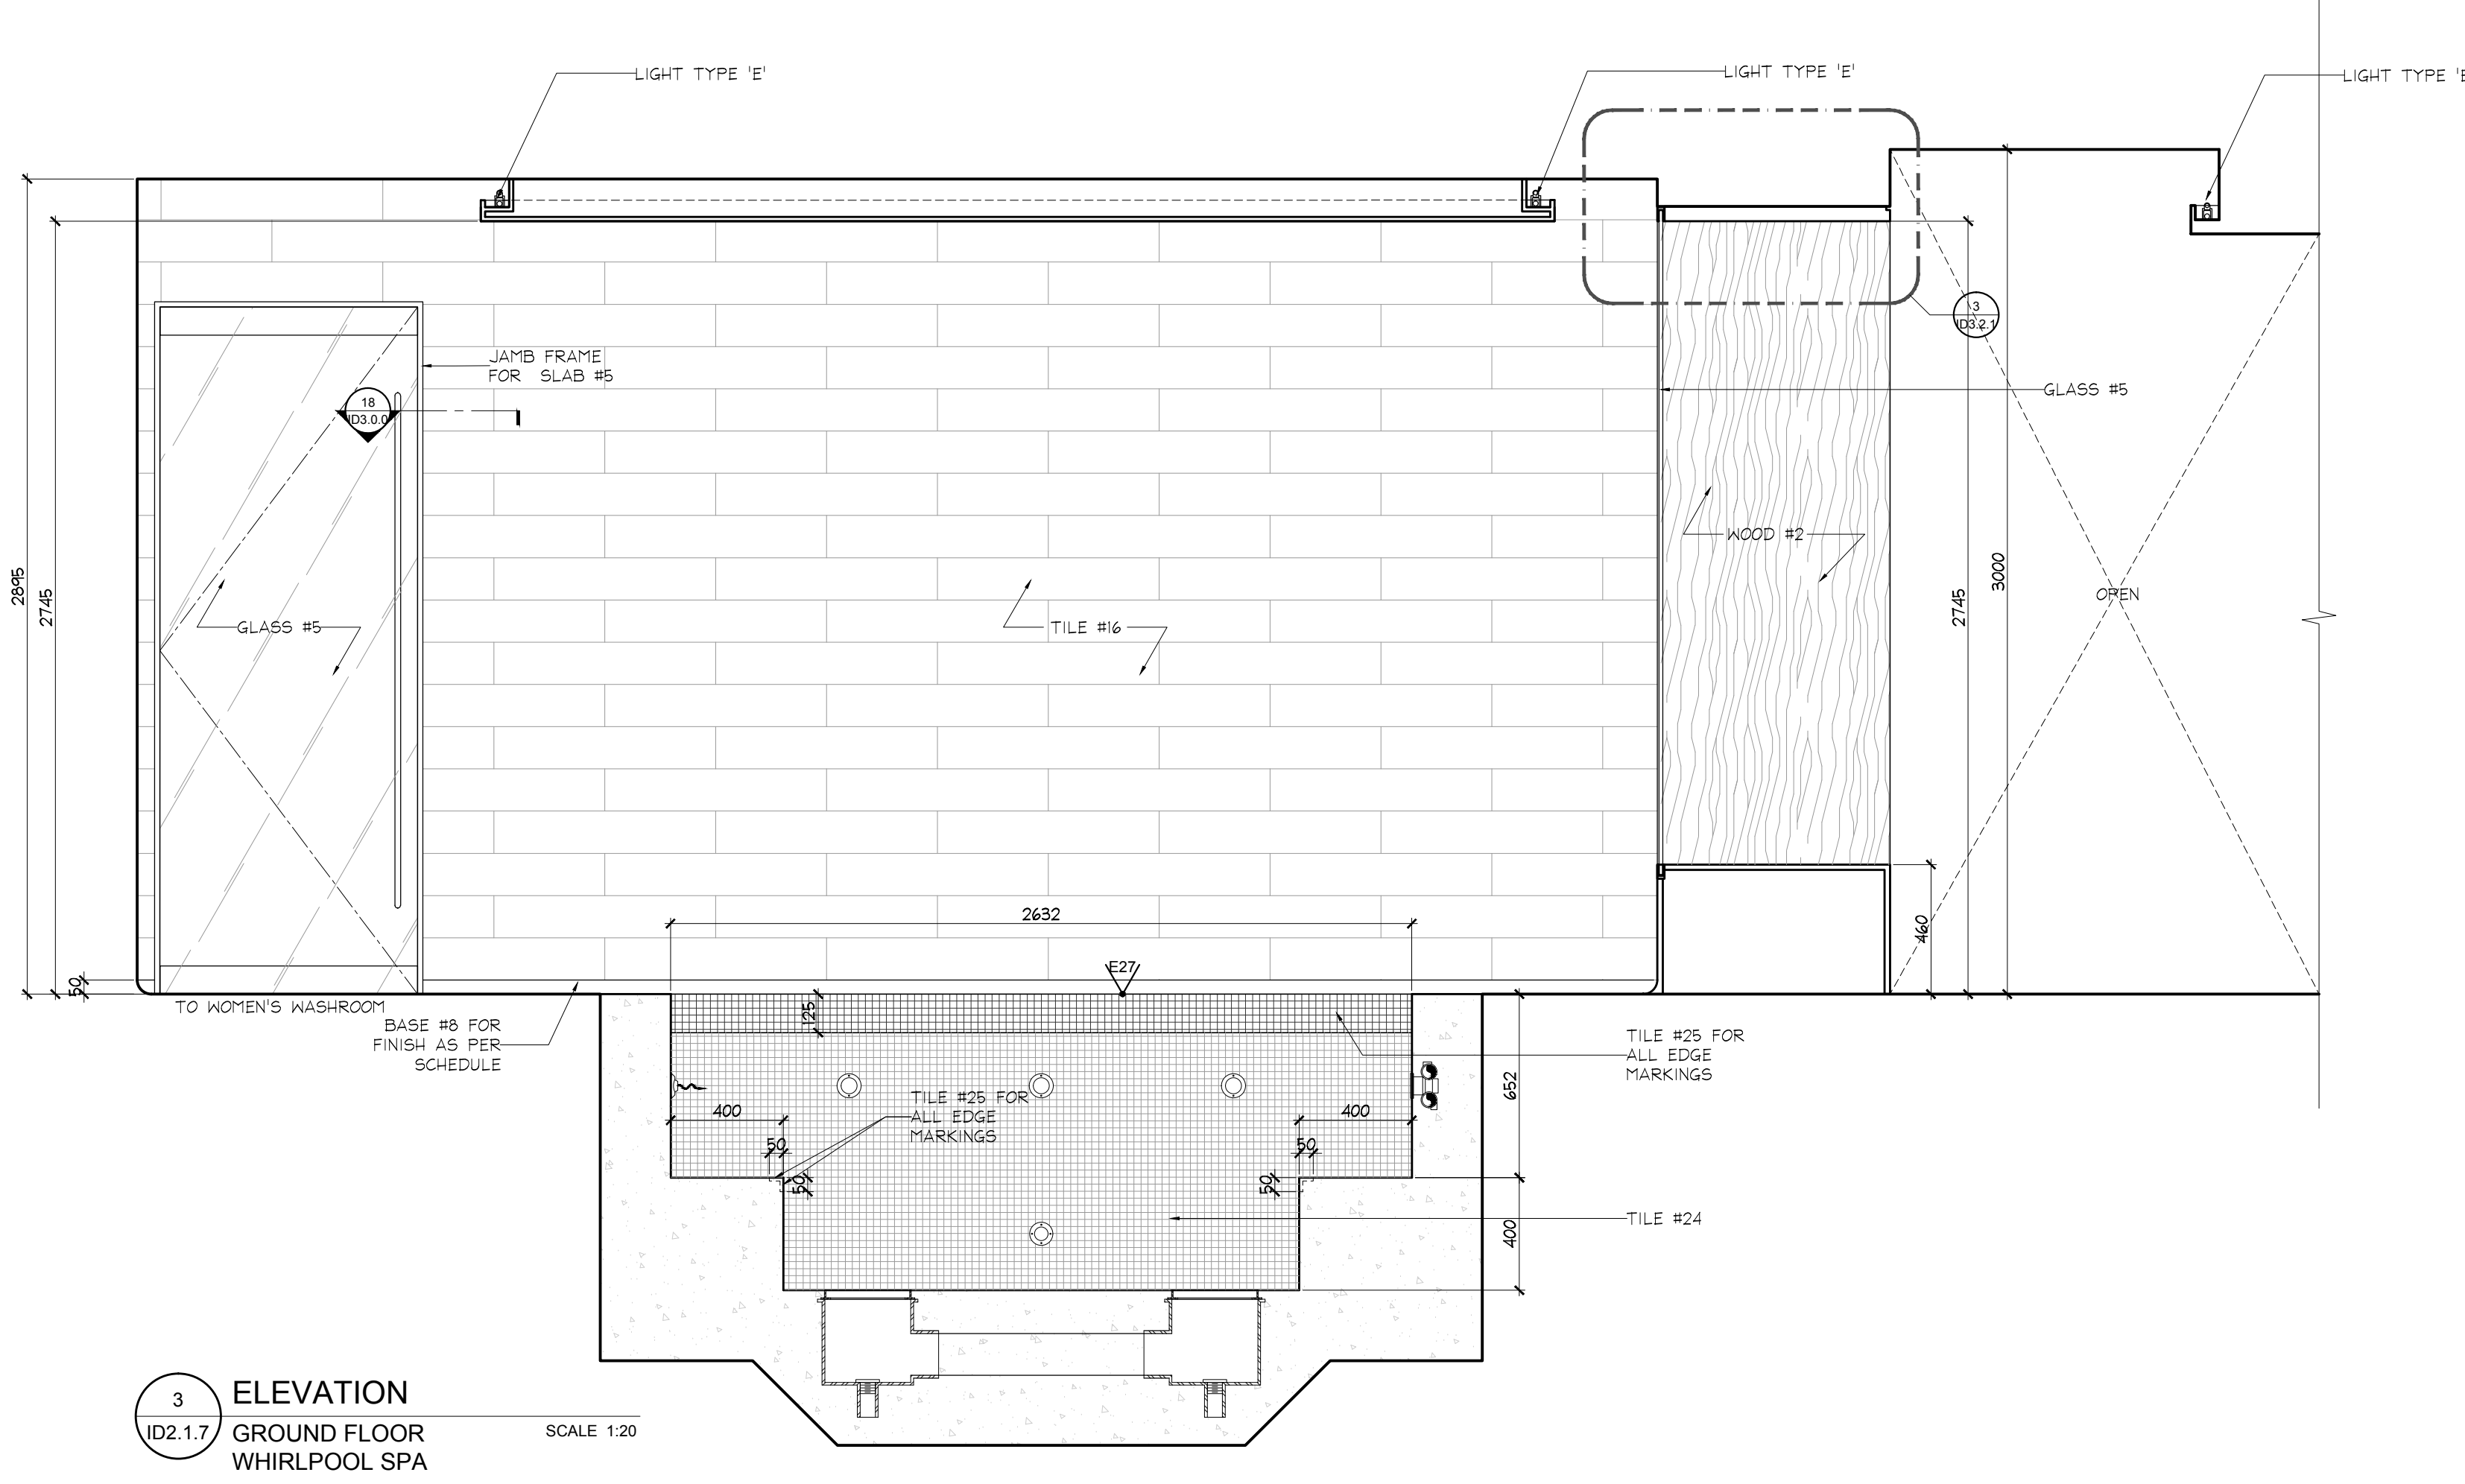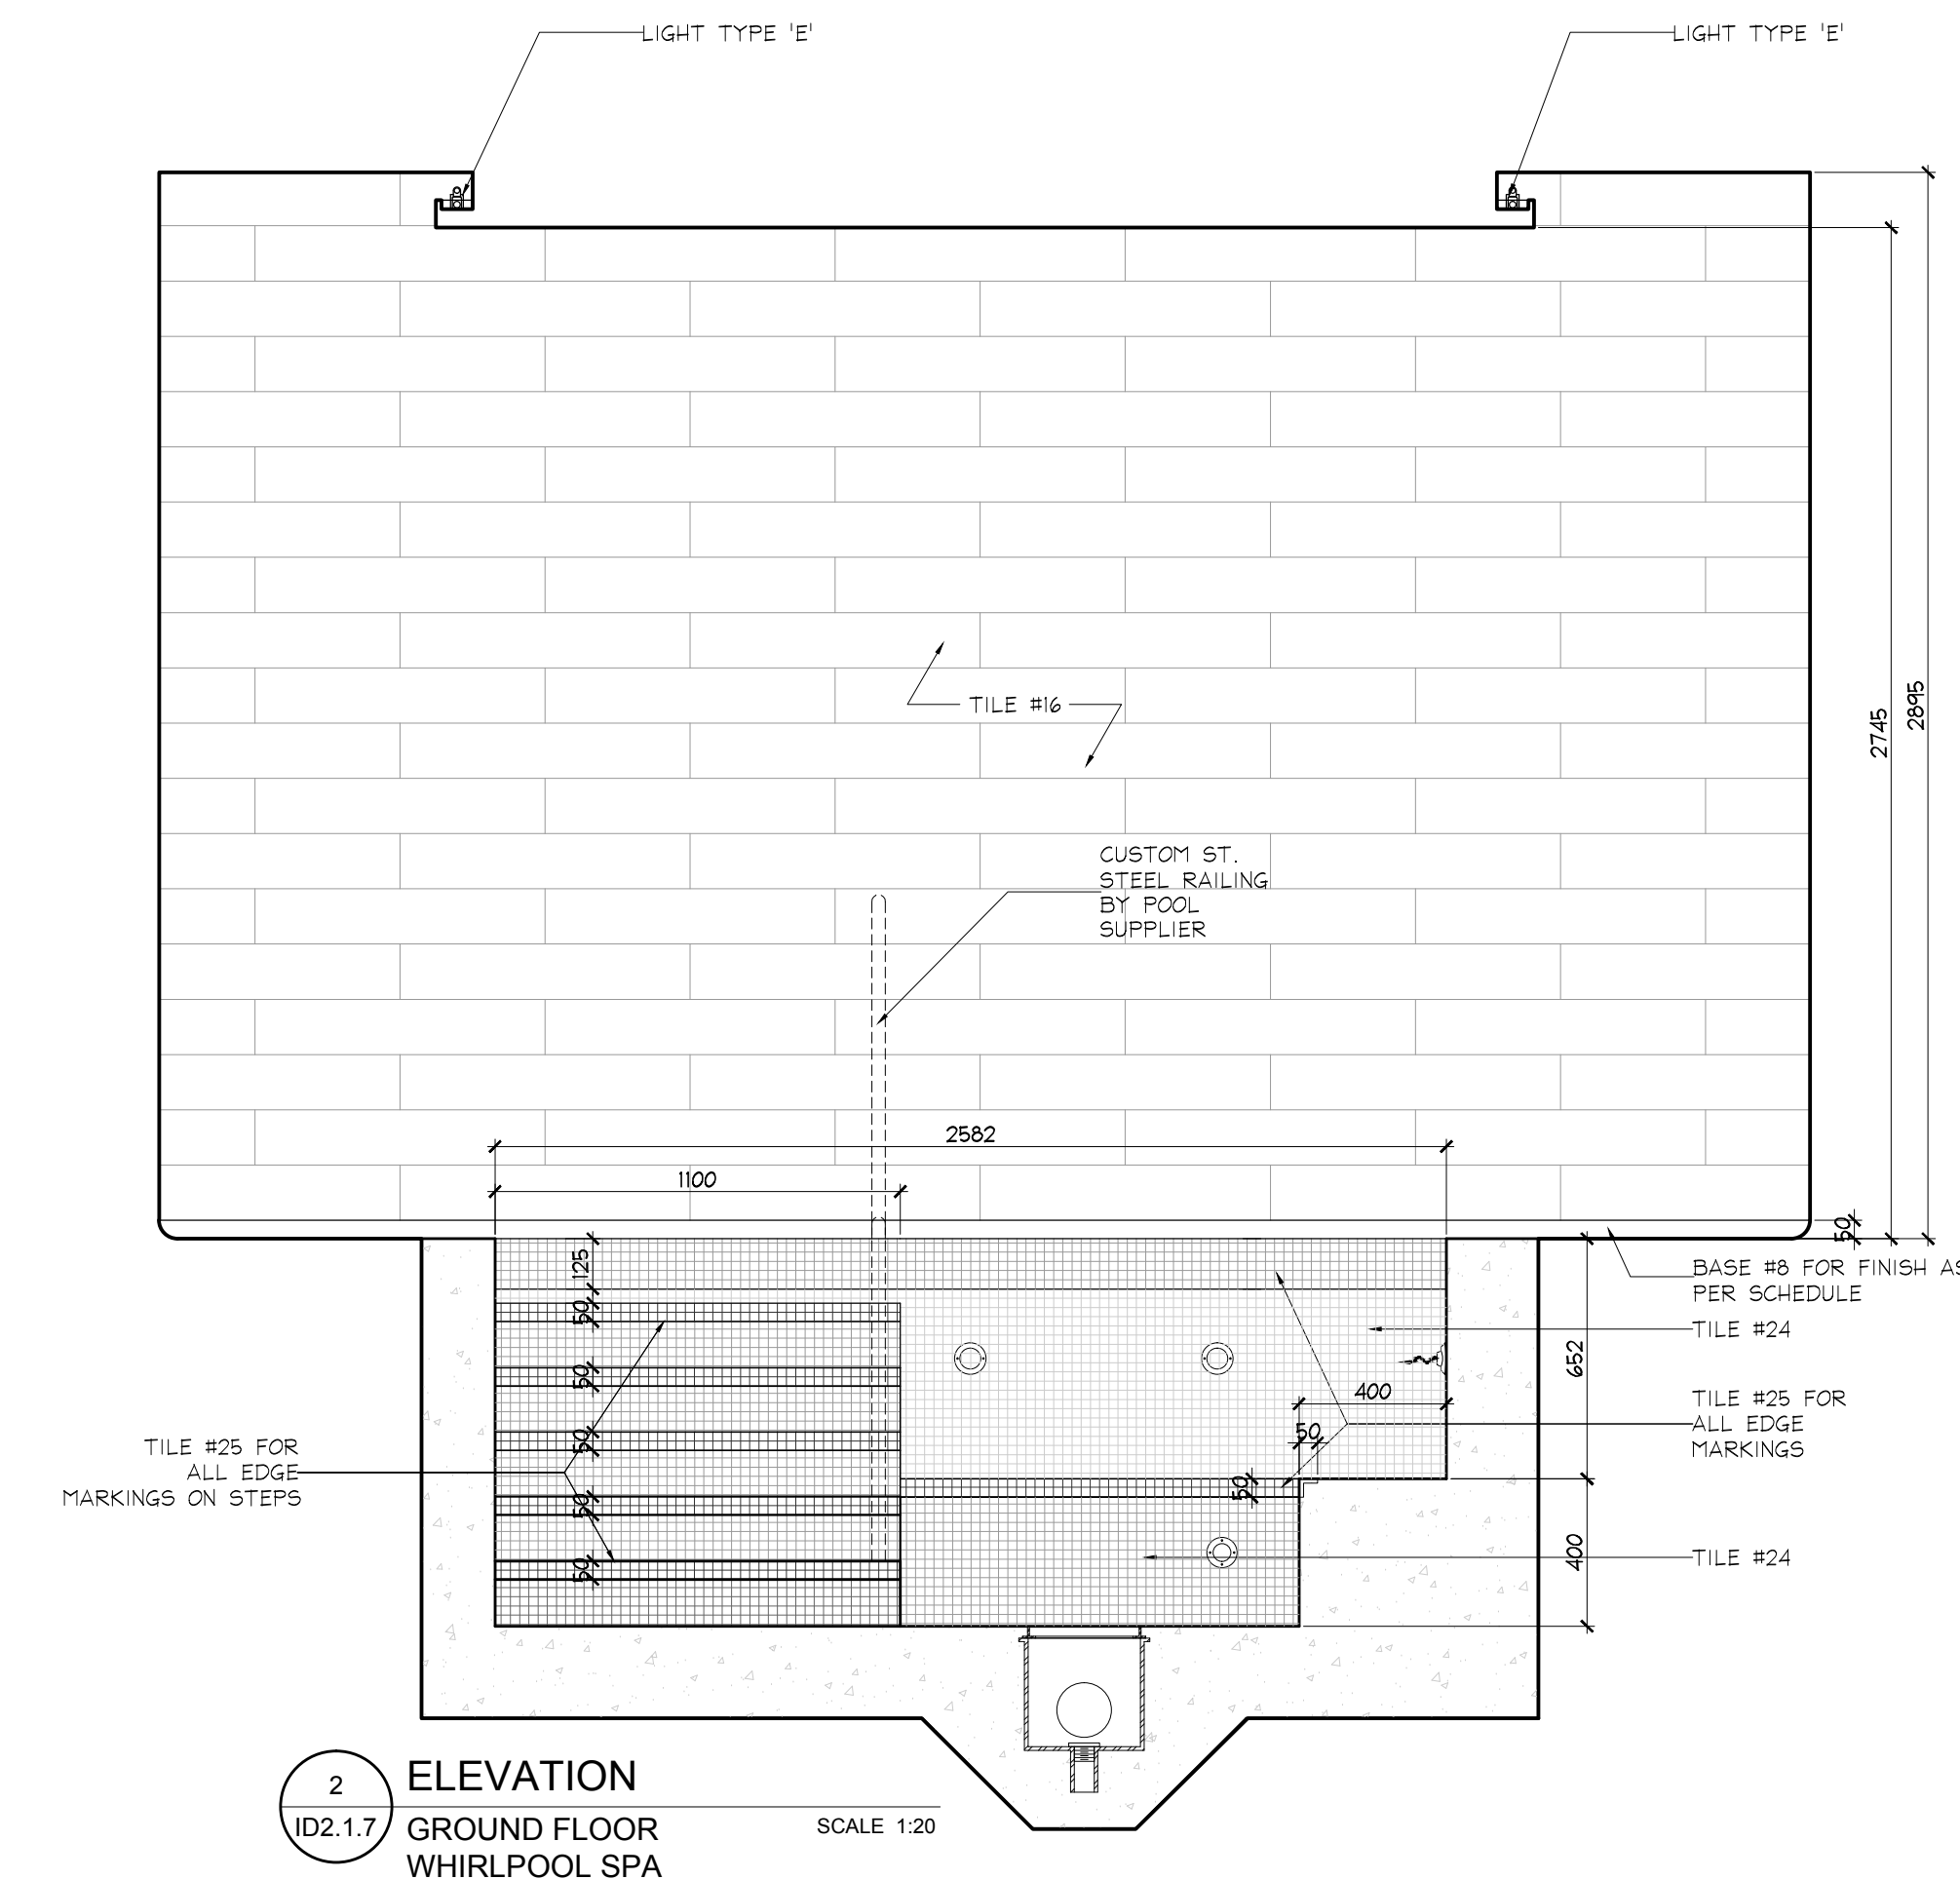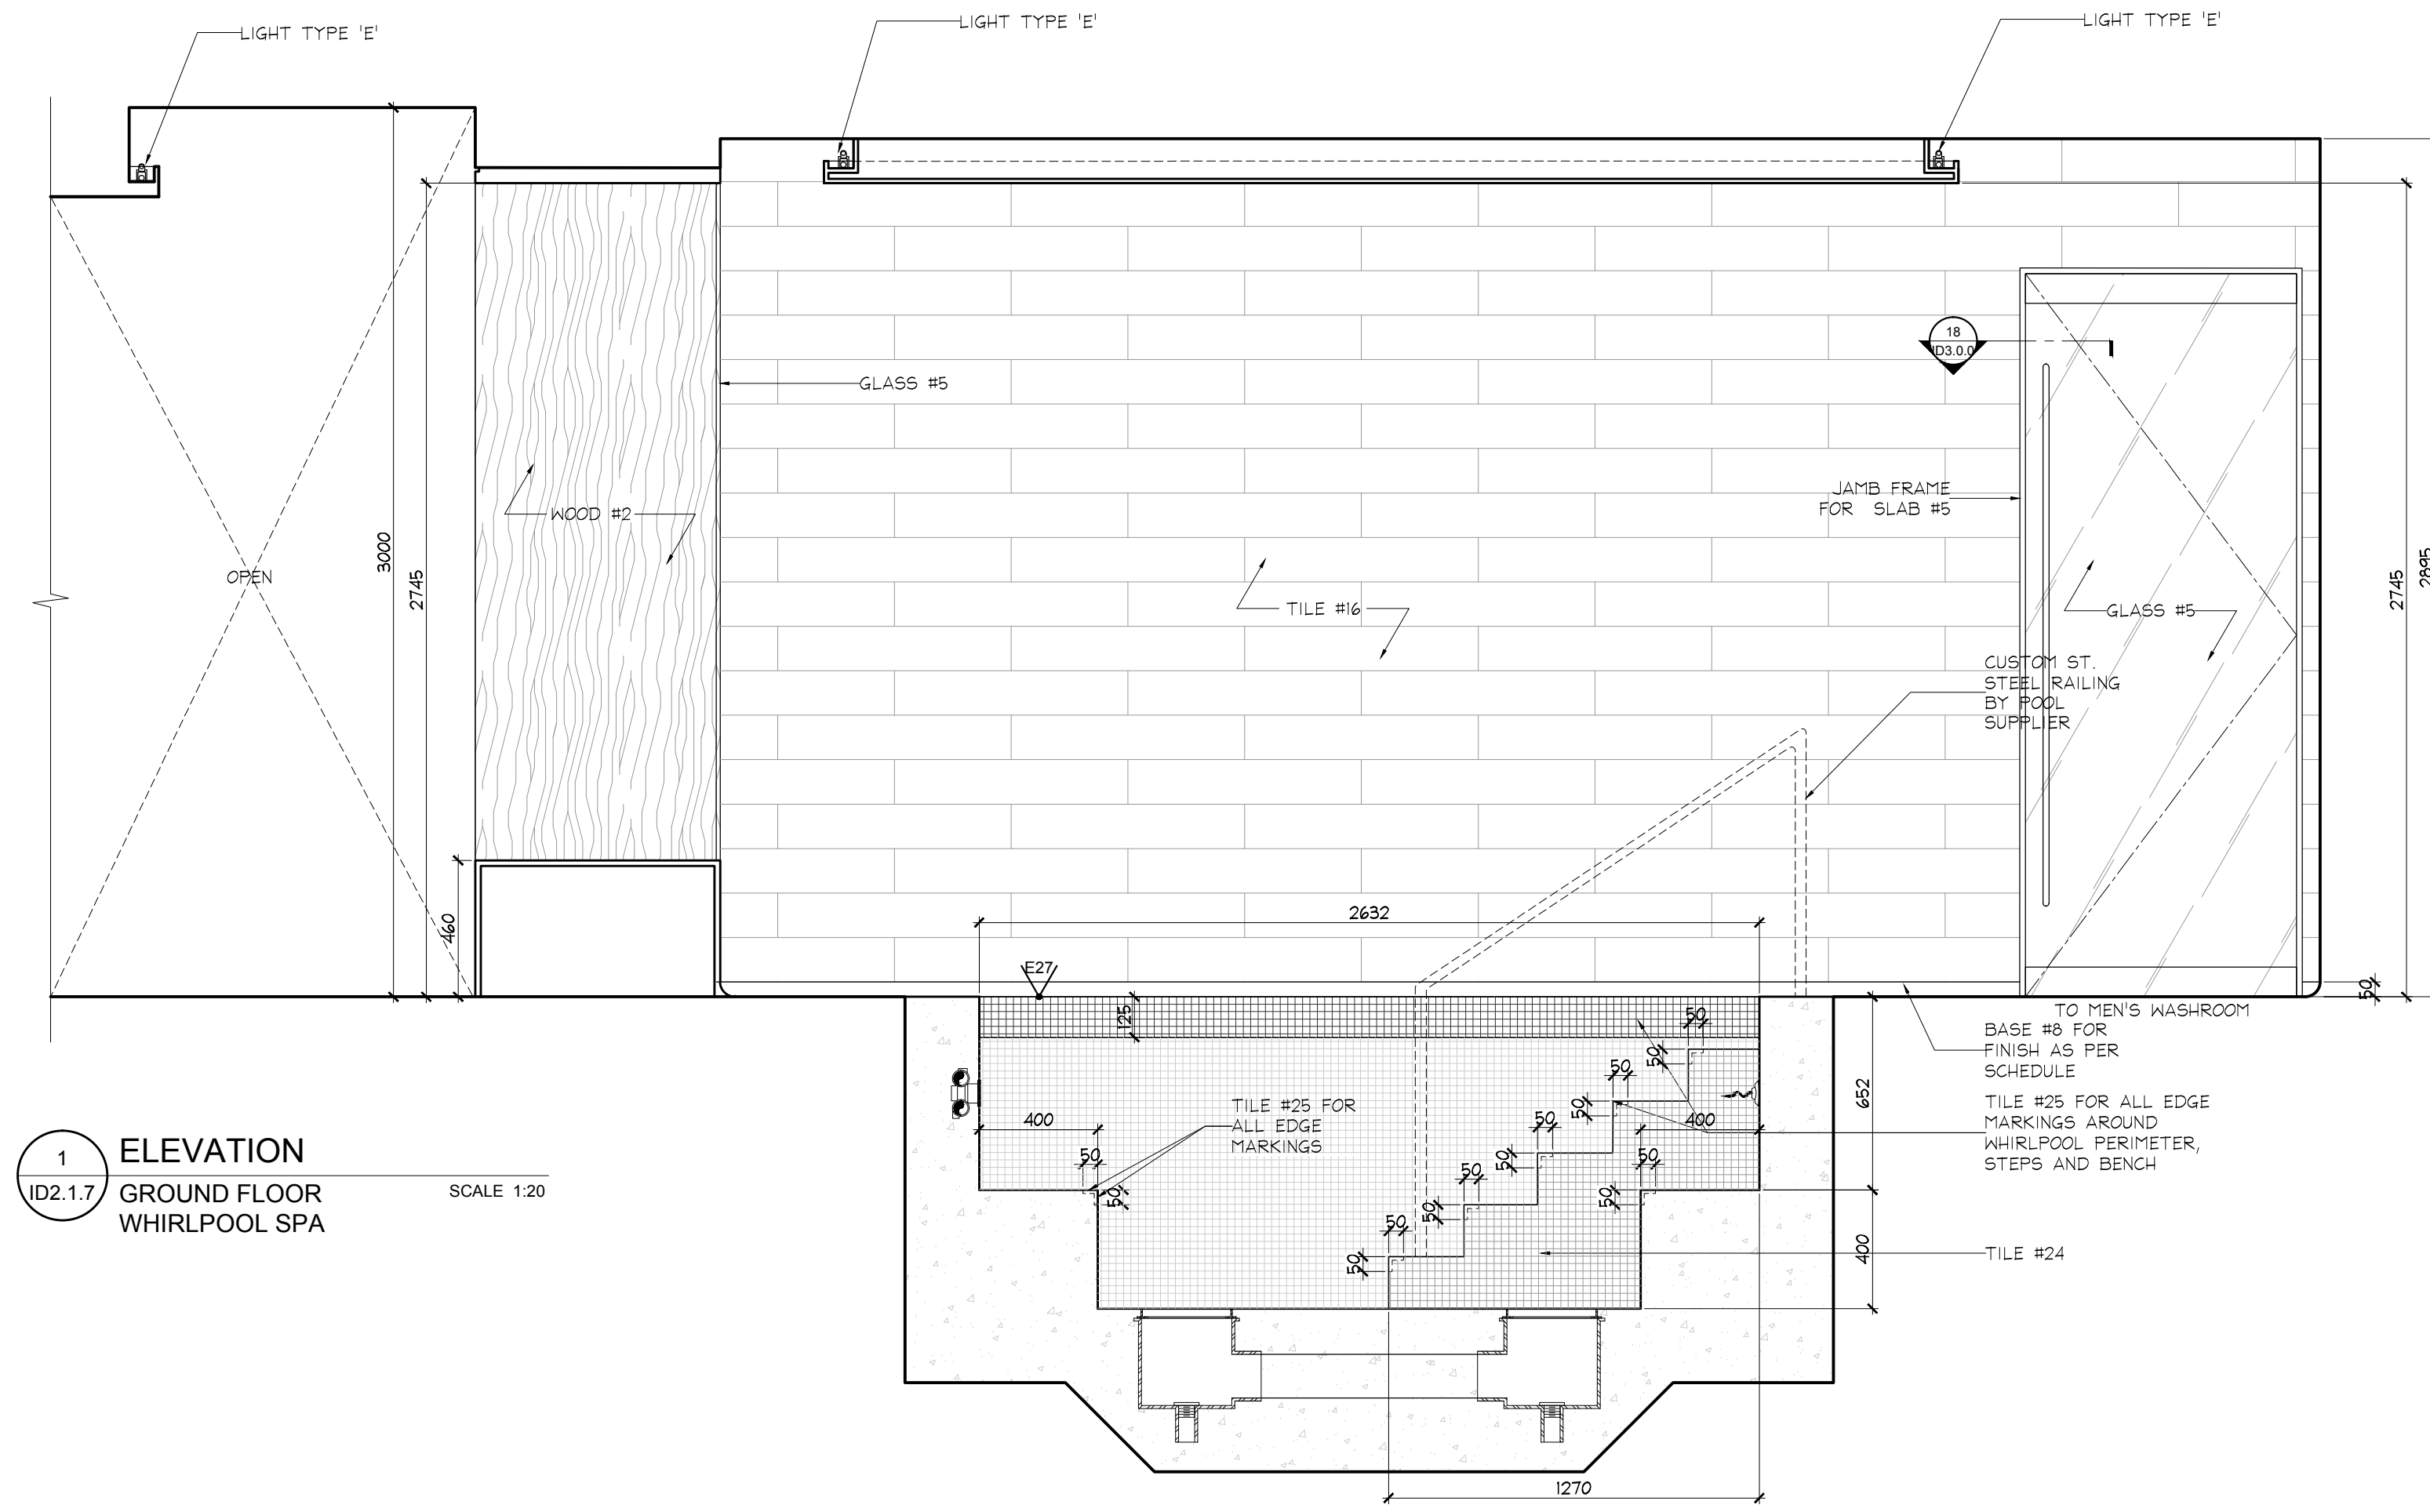

DO NOT SCALE DRAWINGS.

CONTRACTOR MUST VERIFY ALL DRAWINGS, DIMENSIONS, DETAILS AND SPECIFICATIONS AND REPORT ANY DISCREPANCIES TO UNION 31 INC. BEFORE PROCEEDING WITH WORK. MATERIALS MAY NOT BE SUBSTITUTED WITHOUT WRITTEN APPROVAL FROM UNION 31 INC.

ALL DRAWINGS AND SPECIFICATIONS ARE INSTRUMENTS OF SERVICE AND THE PROPERTY OF UNION 31 INC. WHICH MUST BE RETURNED AT THE COMPLETION OF THE WORK.

PRINTED: 30-M8-17

ISSUED FOR
AS-BUILT

01	31 MAY / 17	ISSUED FOR AS-BUILT	SV
NO.	DATE	COMMENTS	INI


UNION31

UNION31 INC.
183 BATHURST STREET, STE. 201
TORONTO, ON, M5T 2R7, CANADA
TEL: 416-597-1576 FAX: 416-597-2139


PROJECT NAME:	ALEXANDRA PARK MAIN BUILDING
BLOCK 11	ON, Canada
PROJECT NO.:	13-949
DRAWINGS:	

GROUND FLOOR
ELEVATIONS


DATE STARTED:	07 AUG / 13	DRAWING NO.:	ID
SCALE:	1 : 20		2.1.8
DRAWN BY:	AP		
APPROVED BY:	KC		

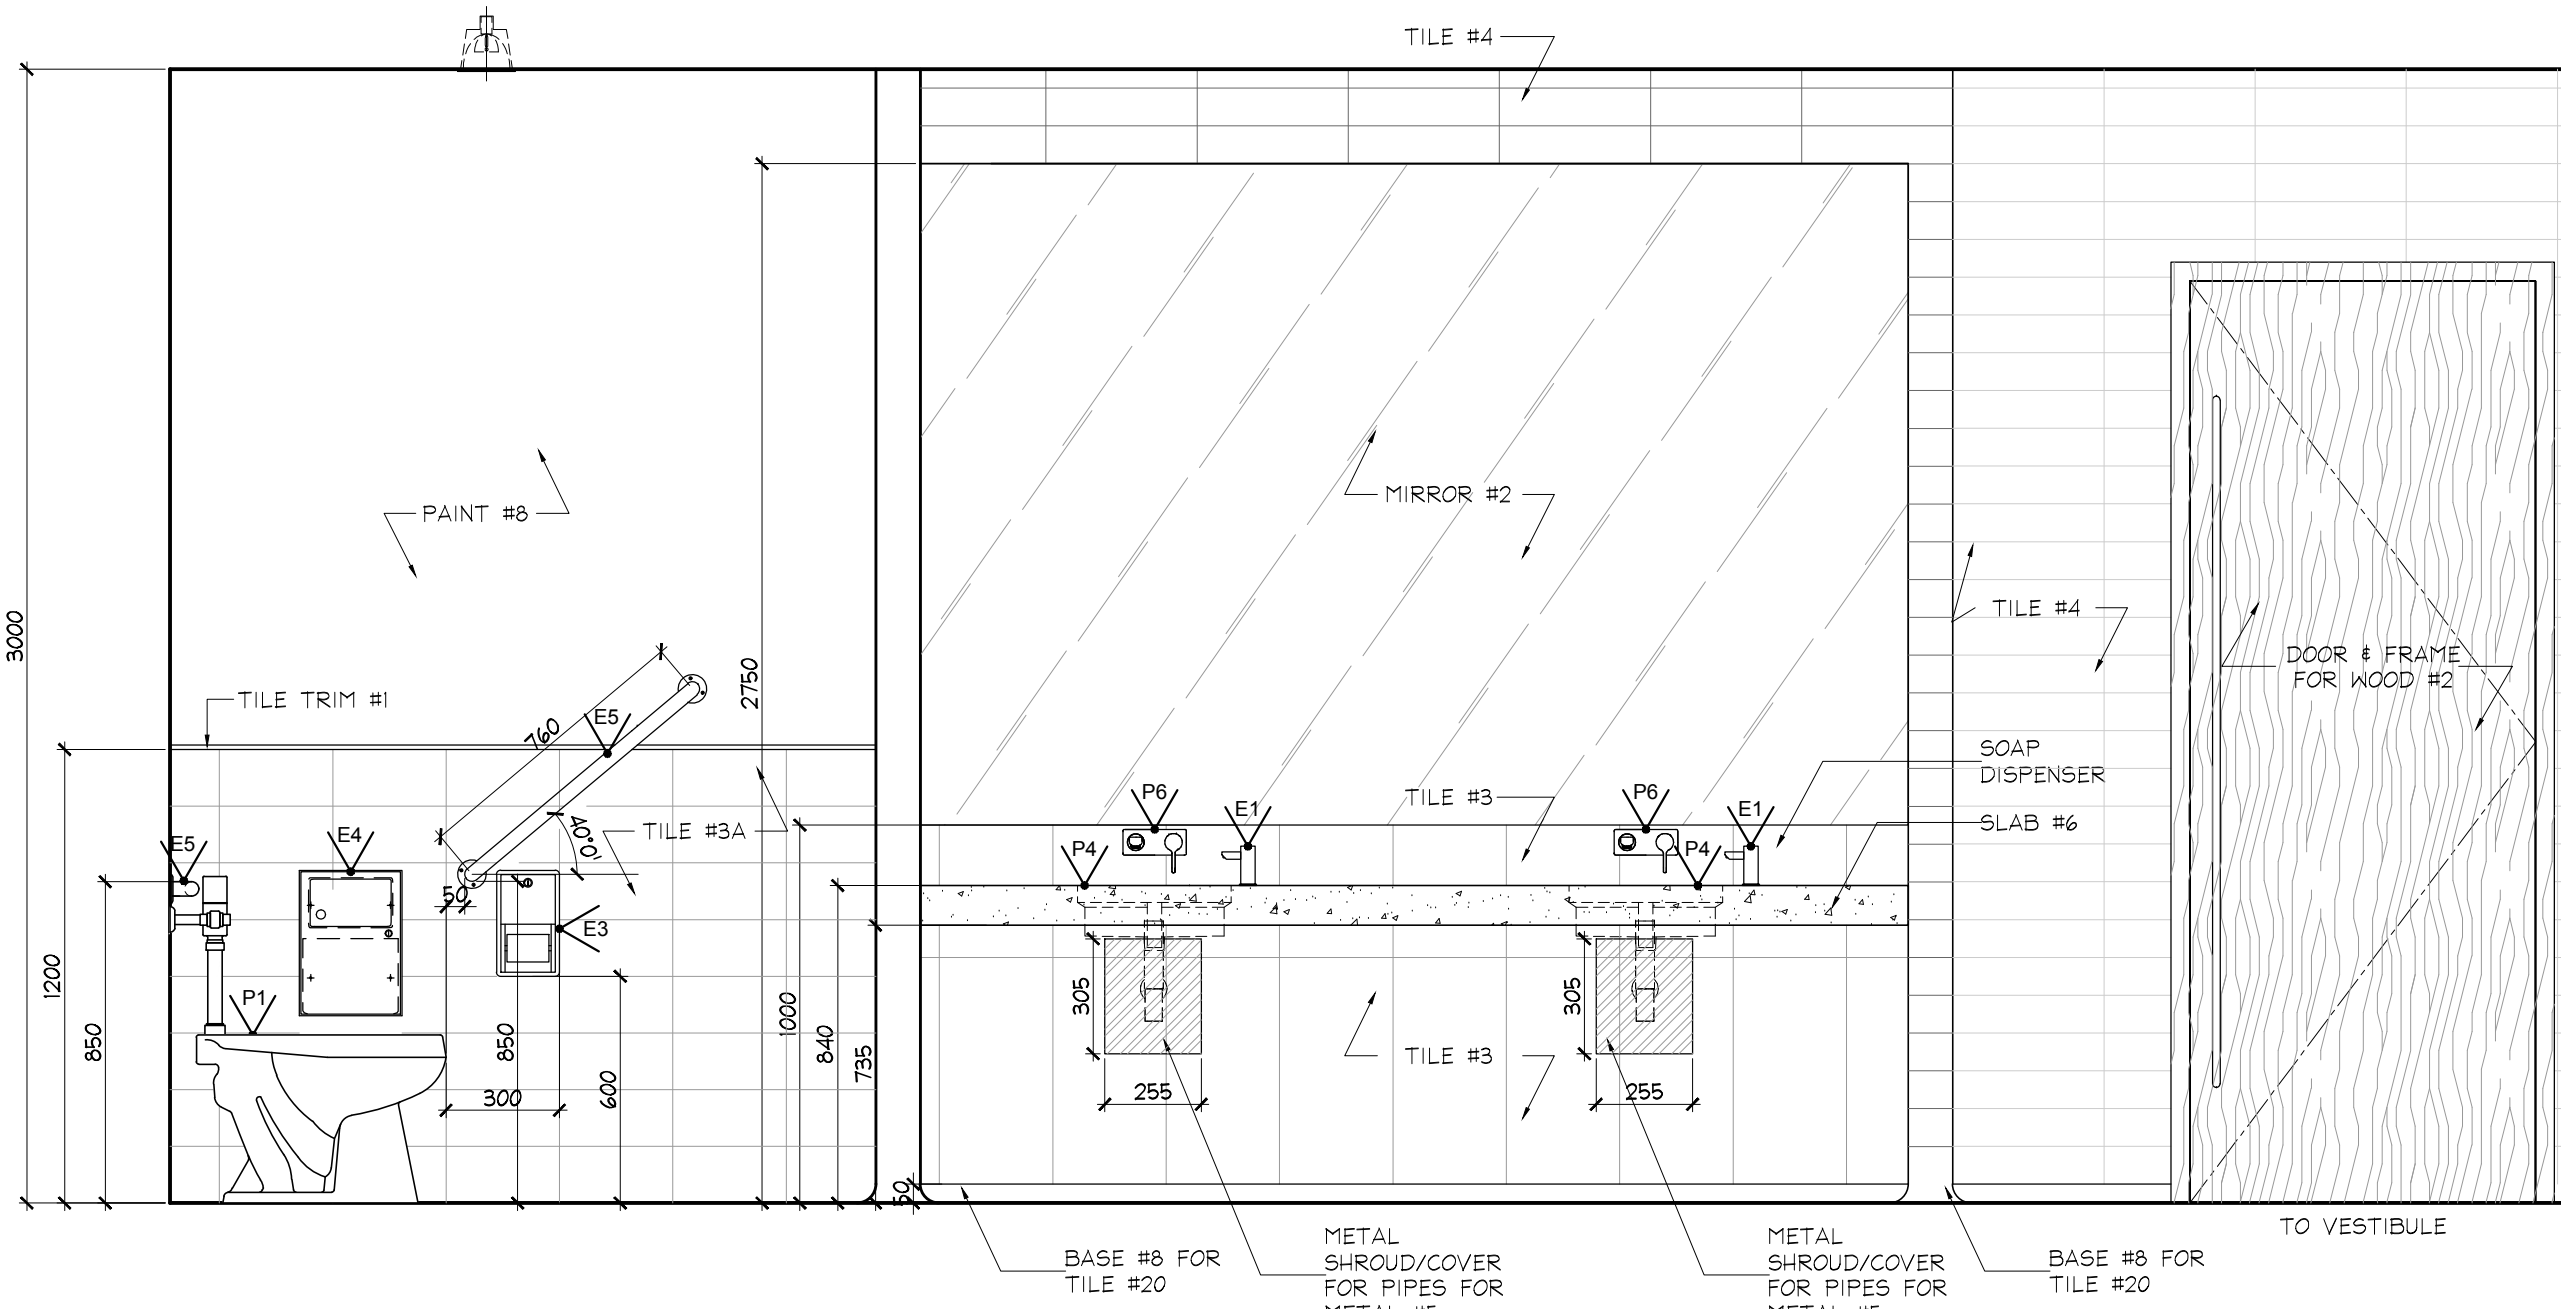


1 ELEVATION
ID2.1.8 GROUND FLOOR
WOMEN'S CHANGE ROOM
SCALE 1:20

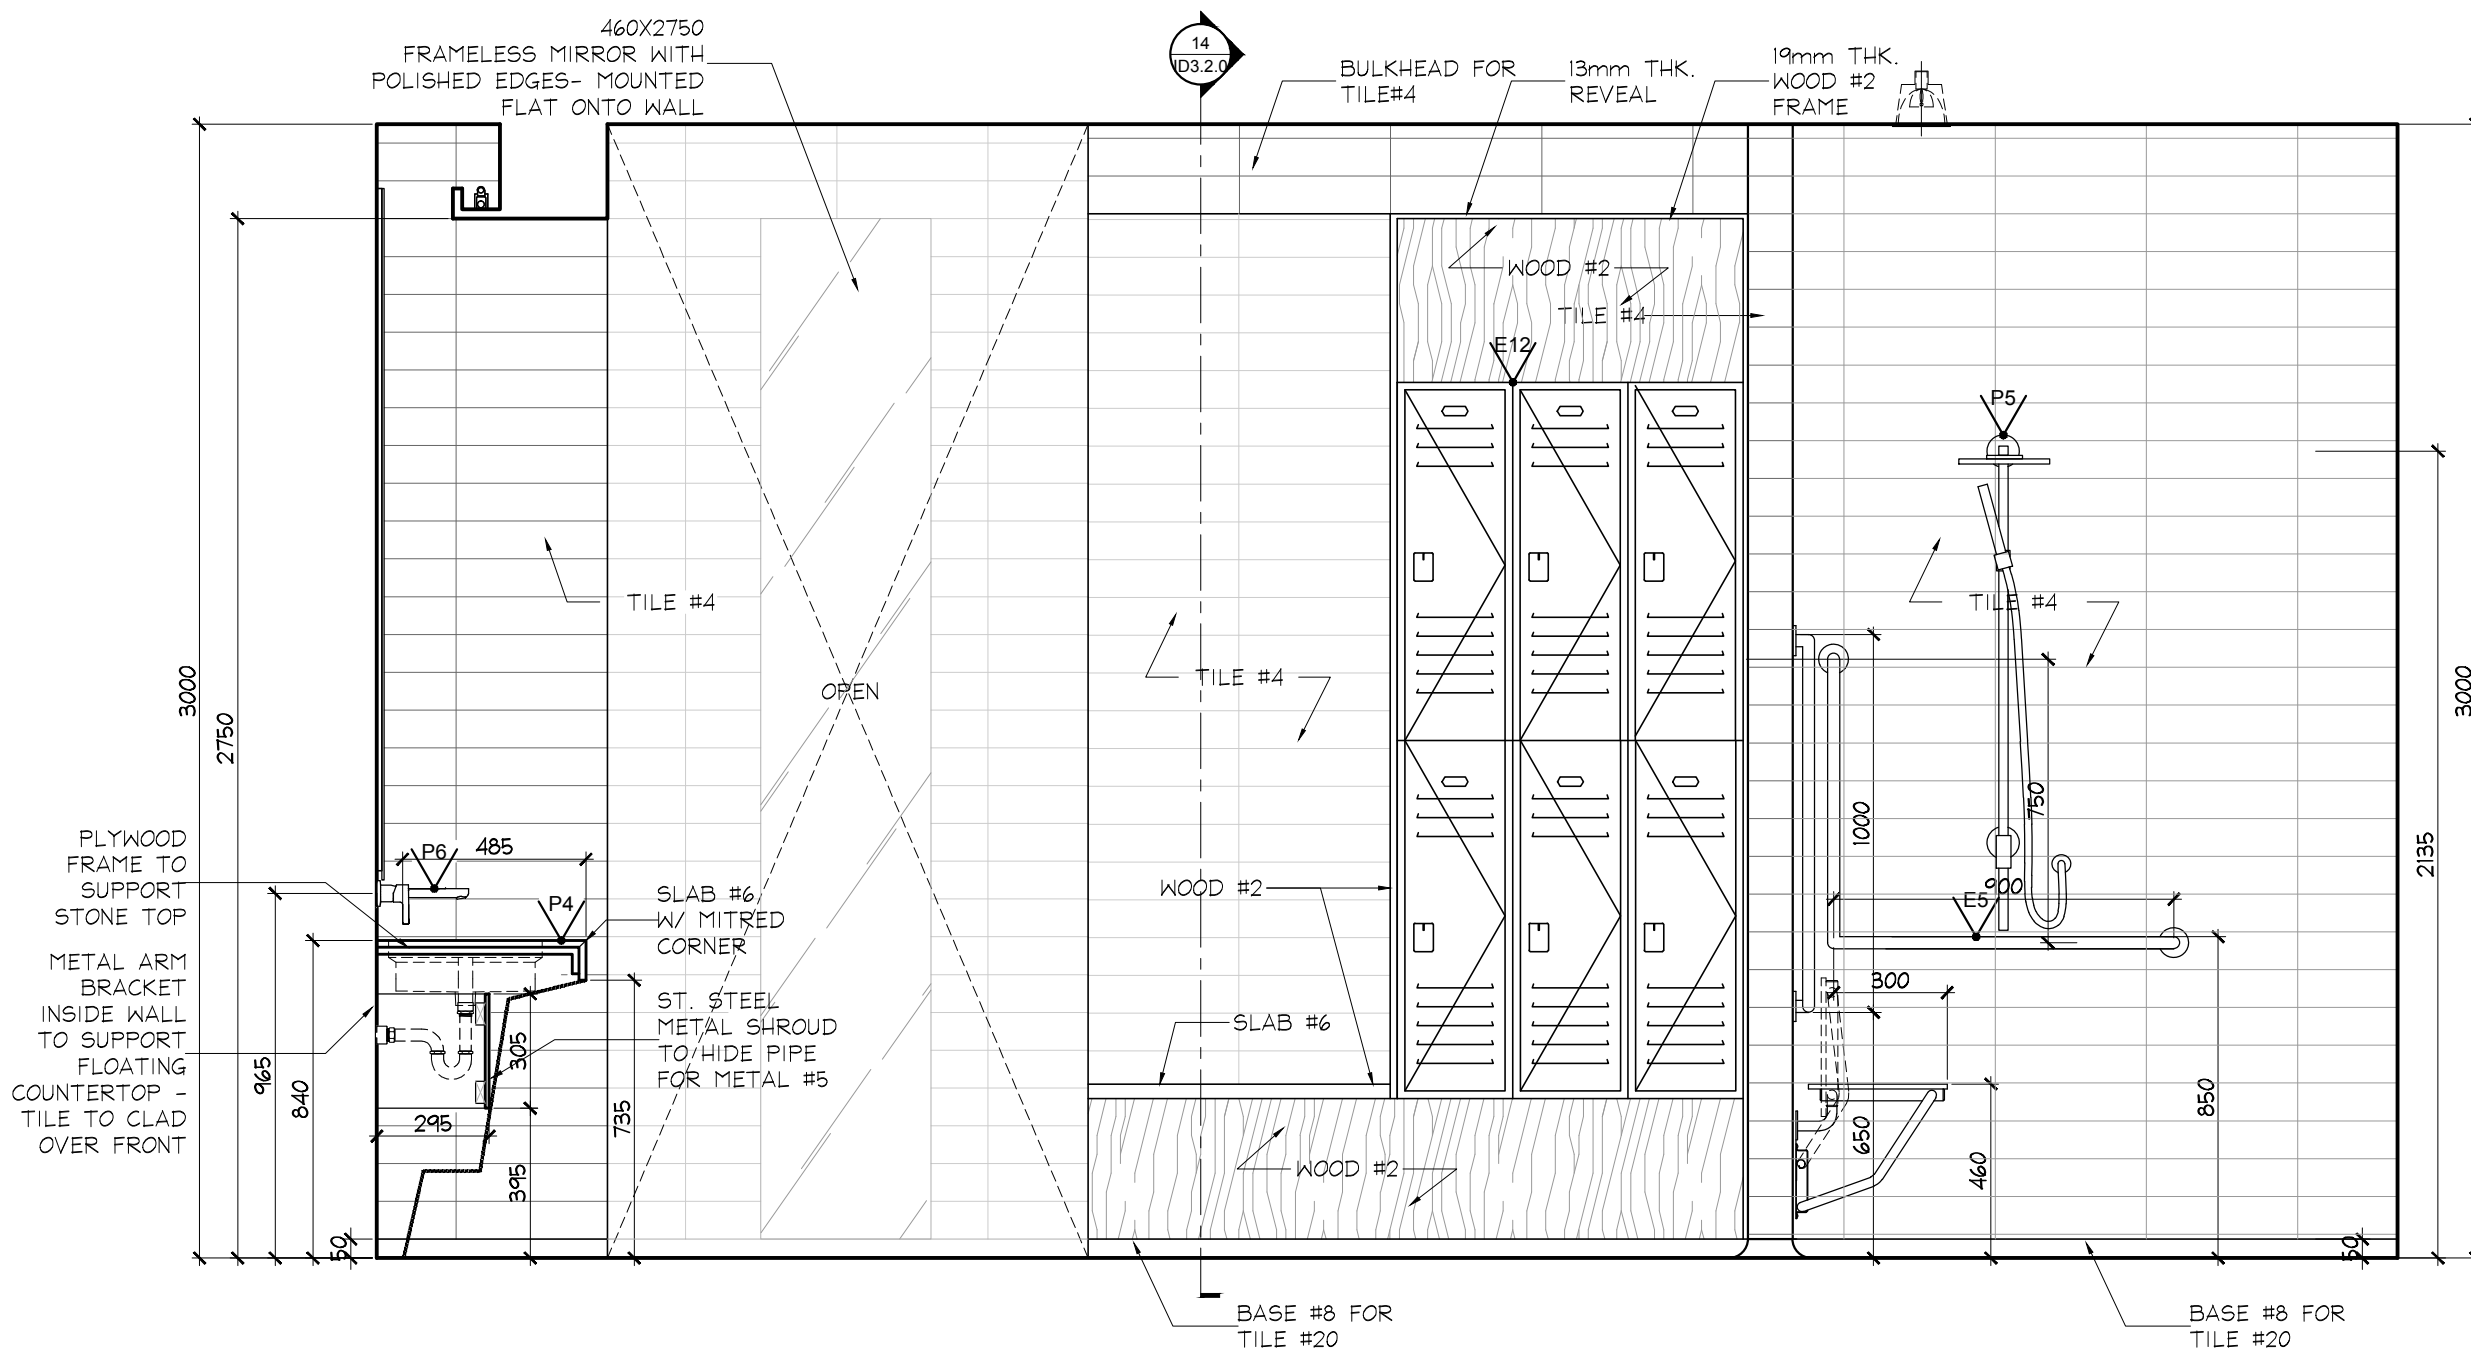


2 ELEVATION
ID2.1.8 GROUND FLOOR
WOMEN'S CHANGE ROOM
SCALE 1:20

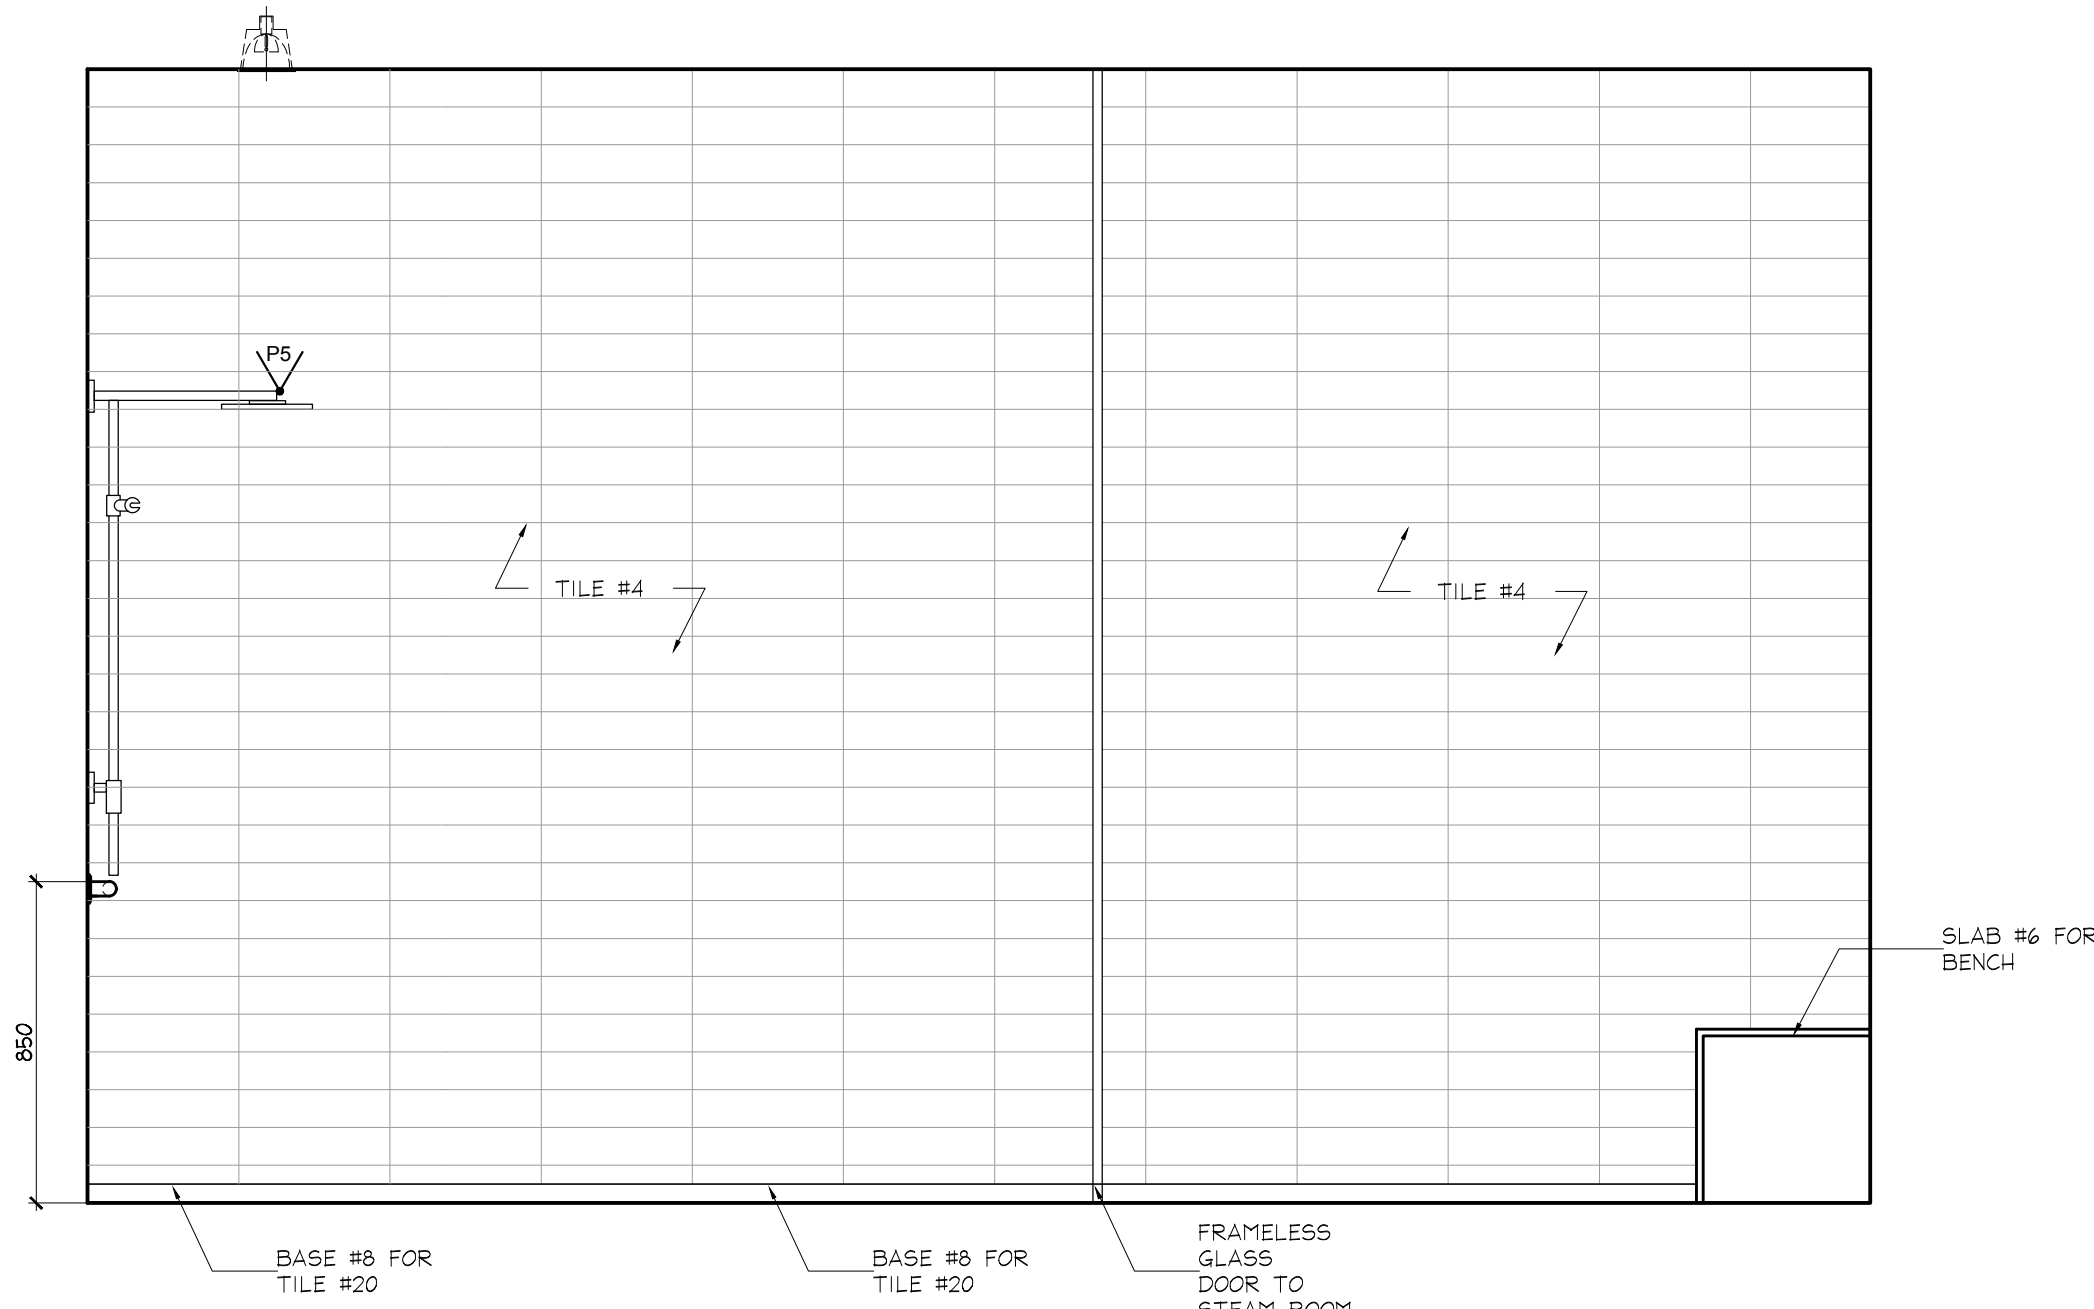

3 ELEVATION
ID2.1.8 GROUND FLOOR
WOMEN'S CHANGE ROOM
SCALE 1:20

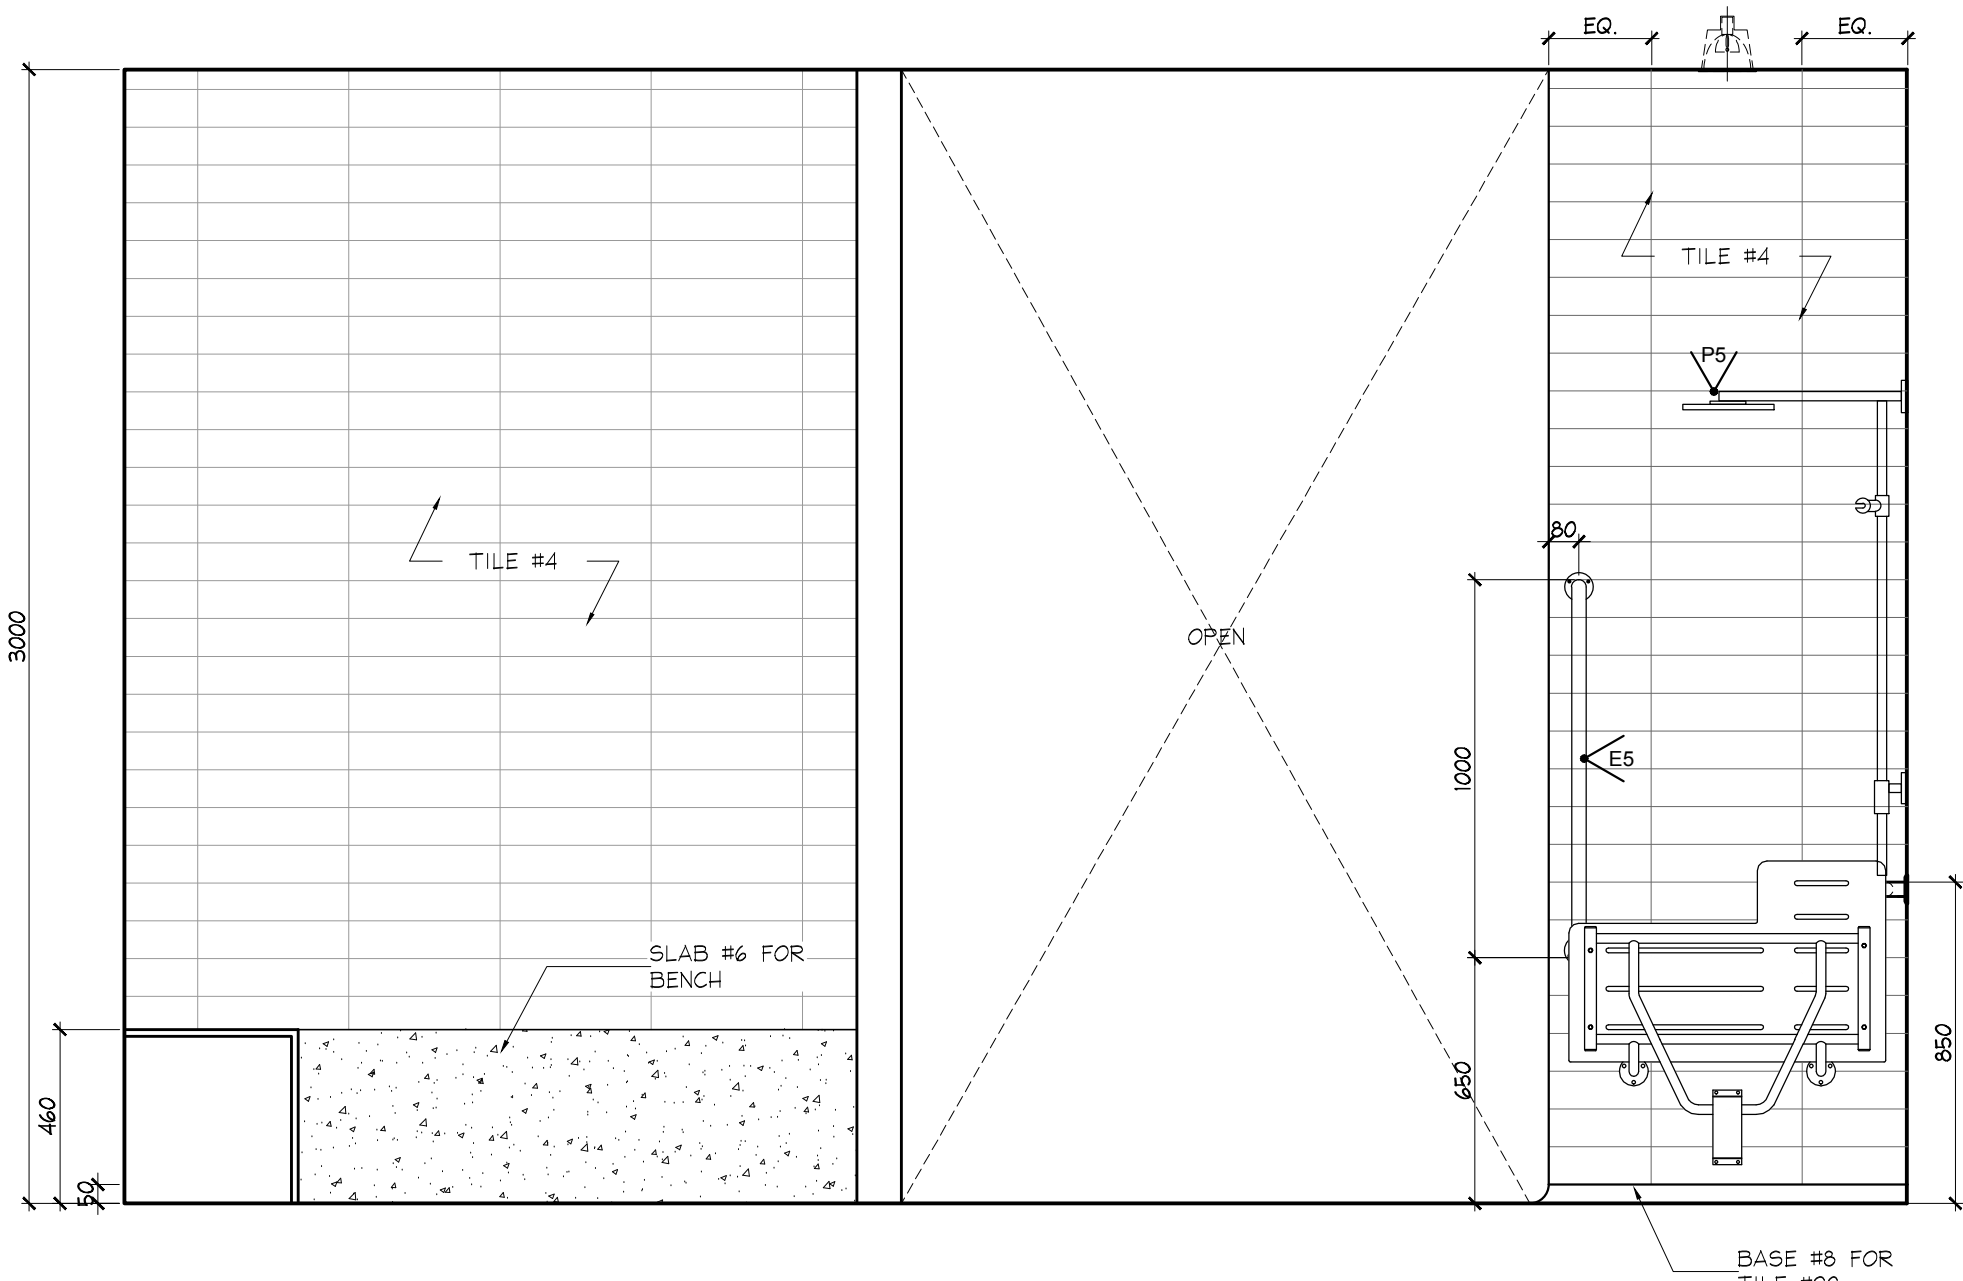


4 ELEVATION
ID2.1.8 GROUND FLOOR
WOMEN'S CHANGE ROOM
SCALE 1:20

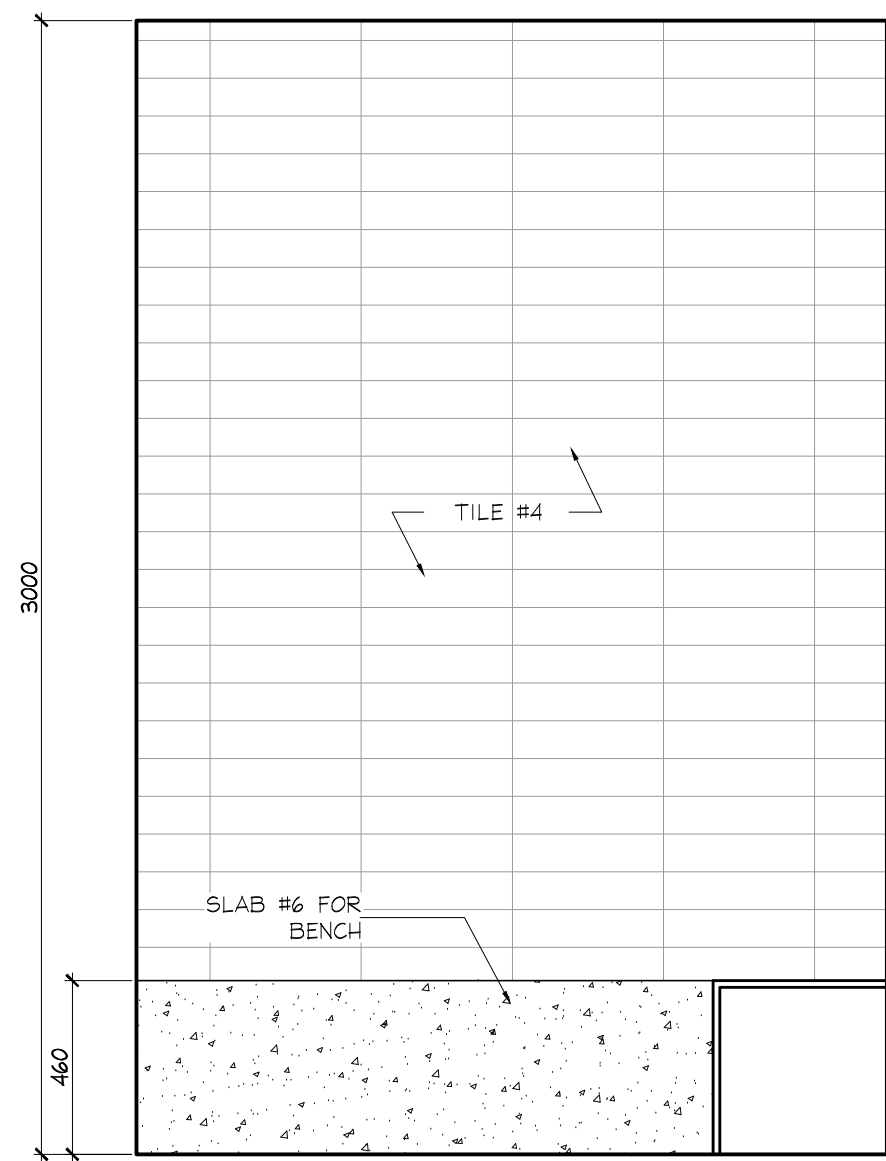


5 ELEVATION
ID2.1.8 GROUND FLOOR
WOMEN'S CHANGE ROOM - STEAM
SCALE 1:20




6 ELEVATION
ID2.1.8 GROUND FLOOR
WOMEN'S CHANGE ROOM
SCALE 1:20

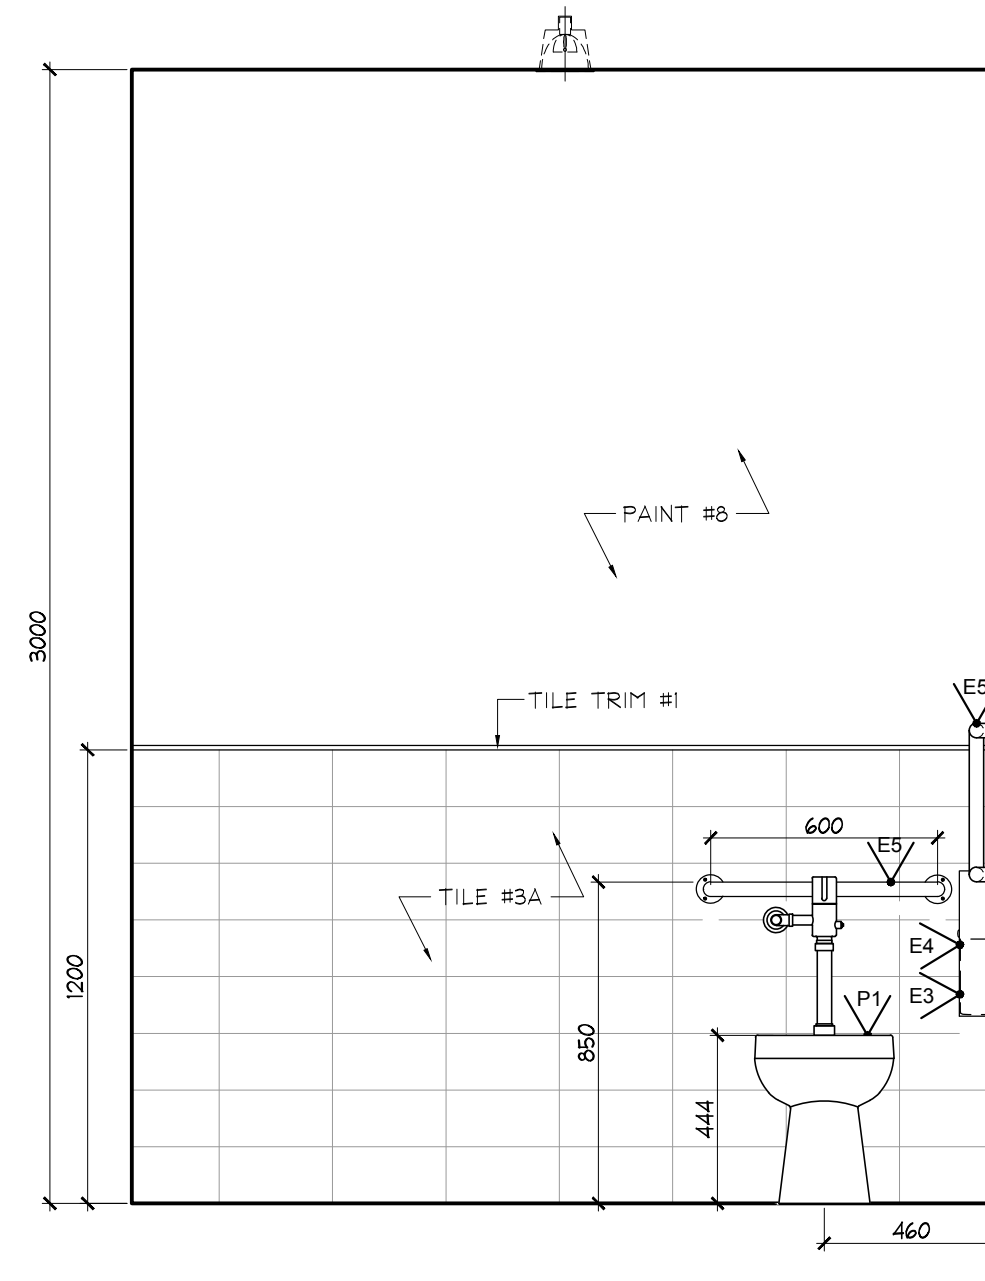


7 ELEVATION
ID2.1.8 GROUND FLOOR
WOMEN'S CHANGE ROOM
SCALE 1:20

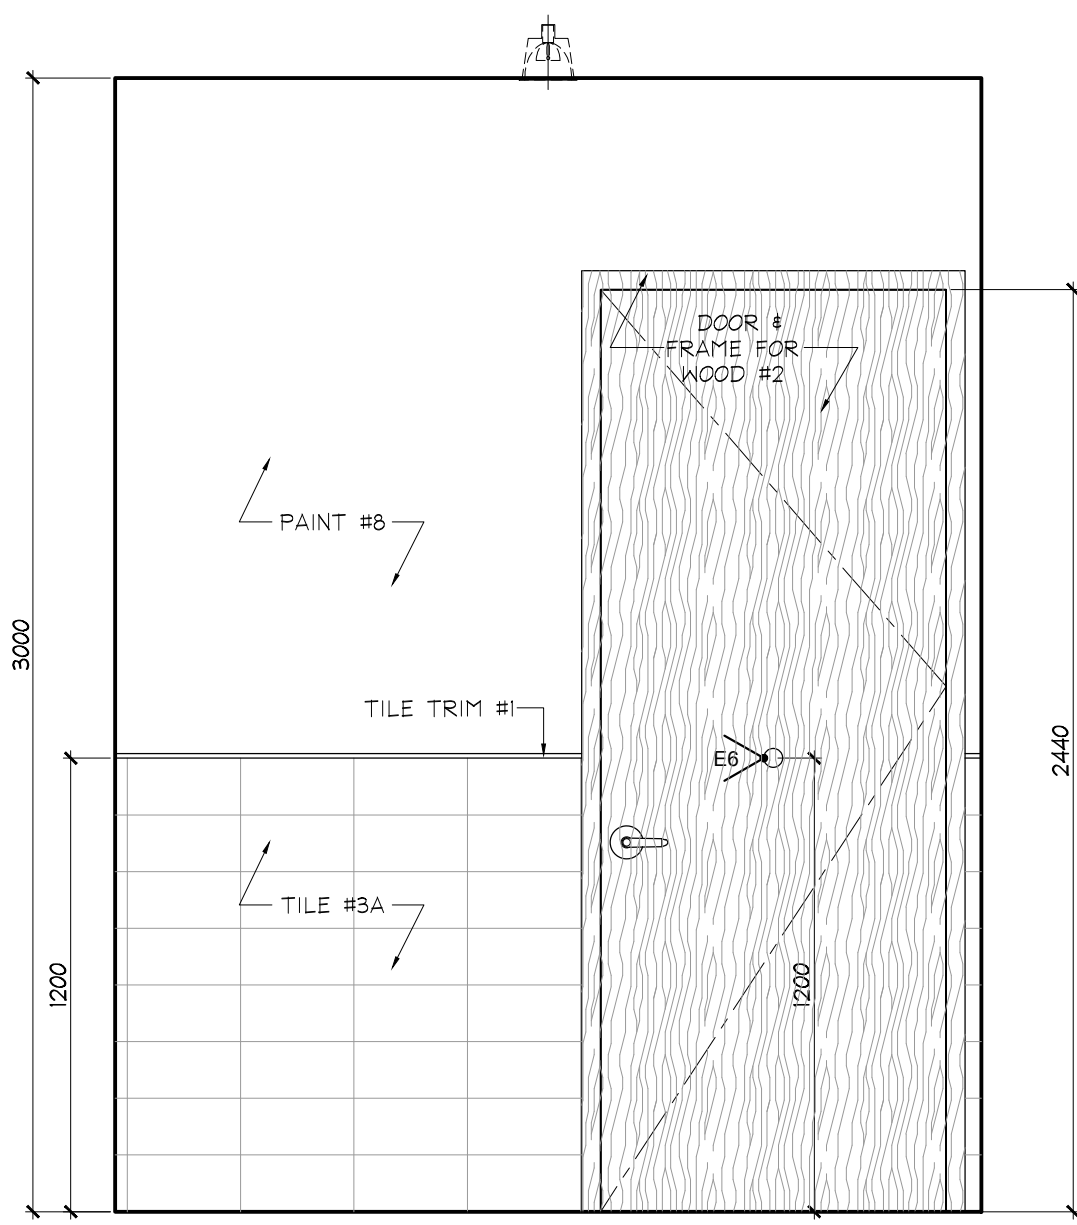


8 ELEVATION
ID2.1.8 GROUND FLOOR
WOMEN'S CHANGE ROOM
SCALE 1:20

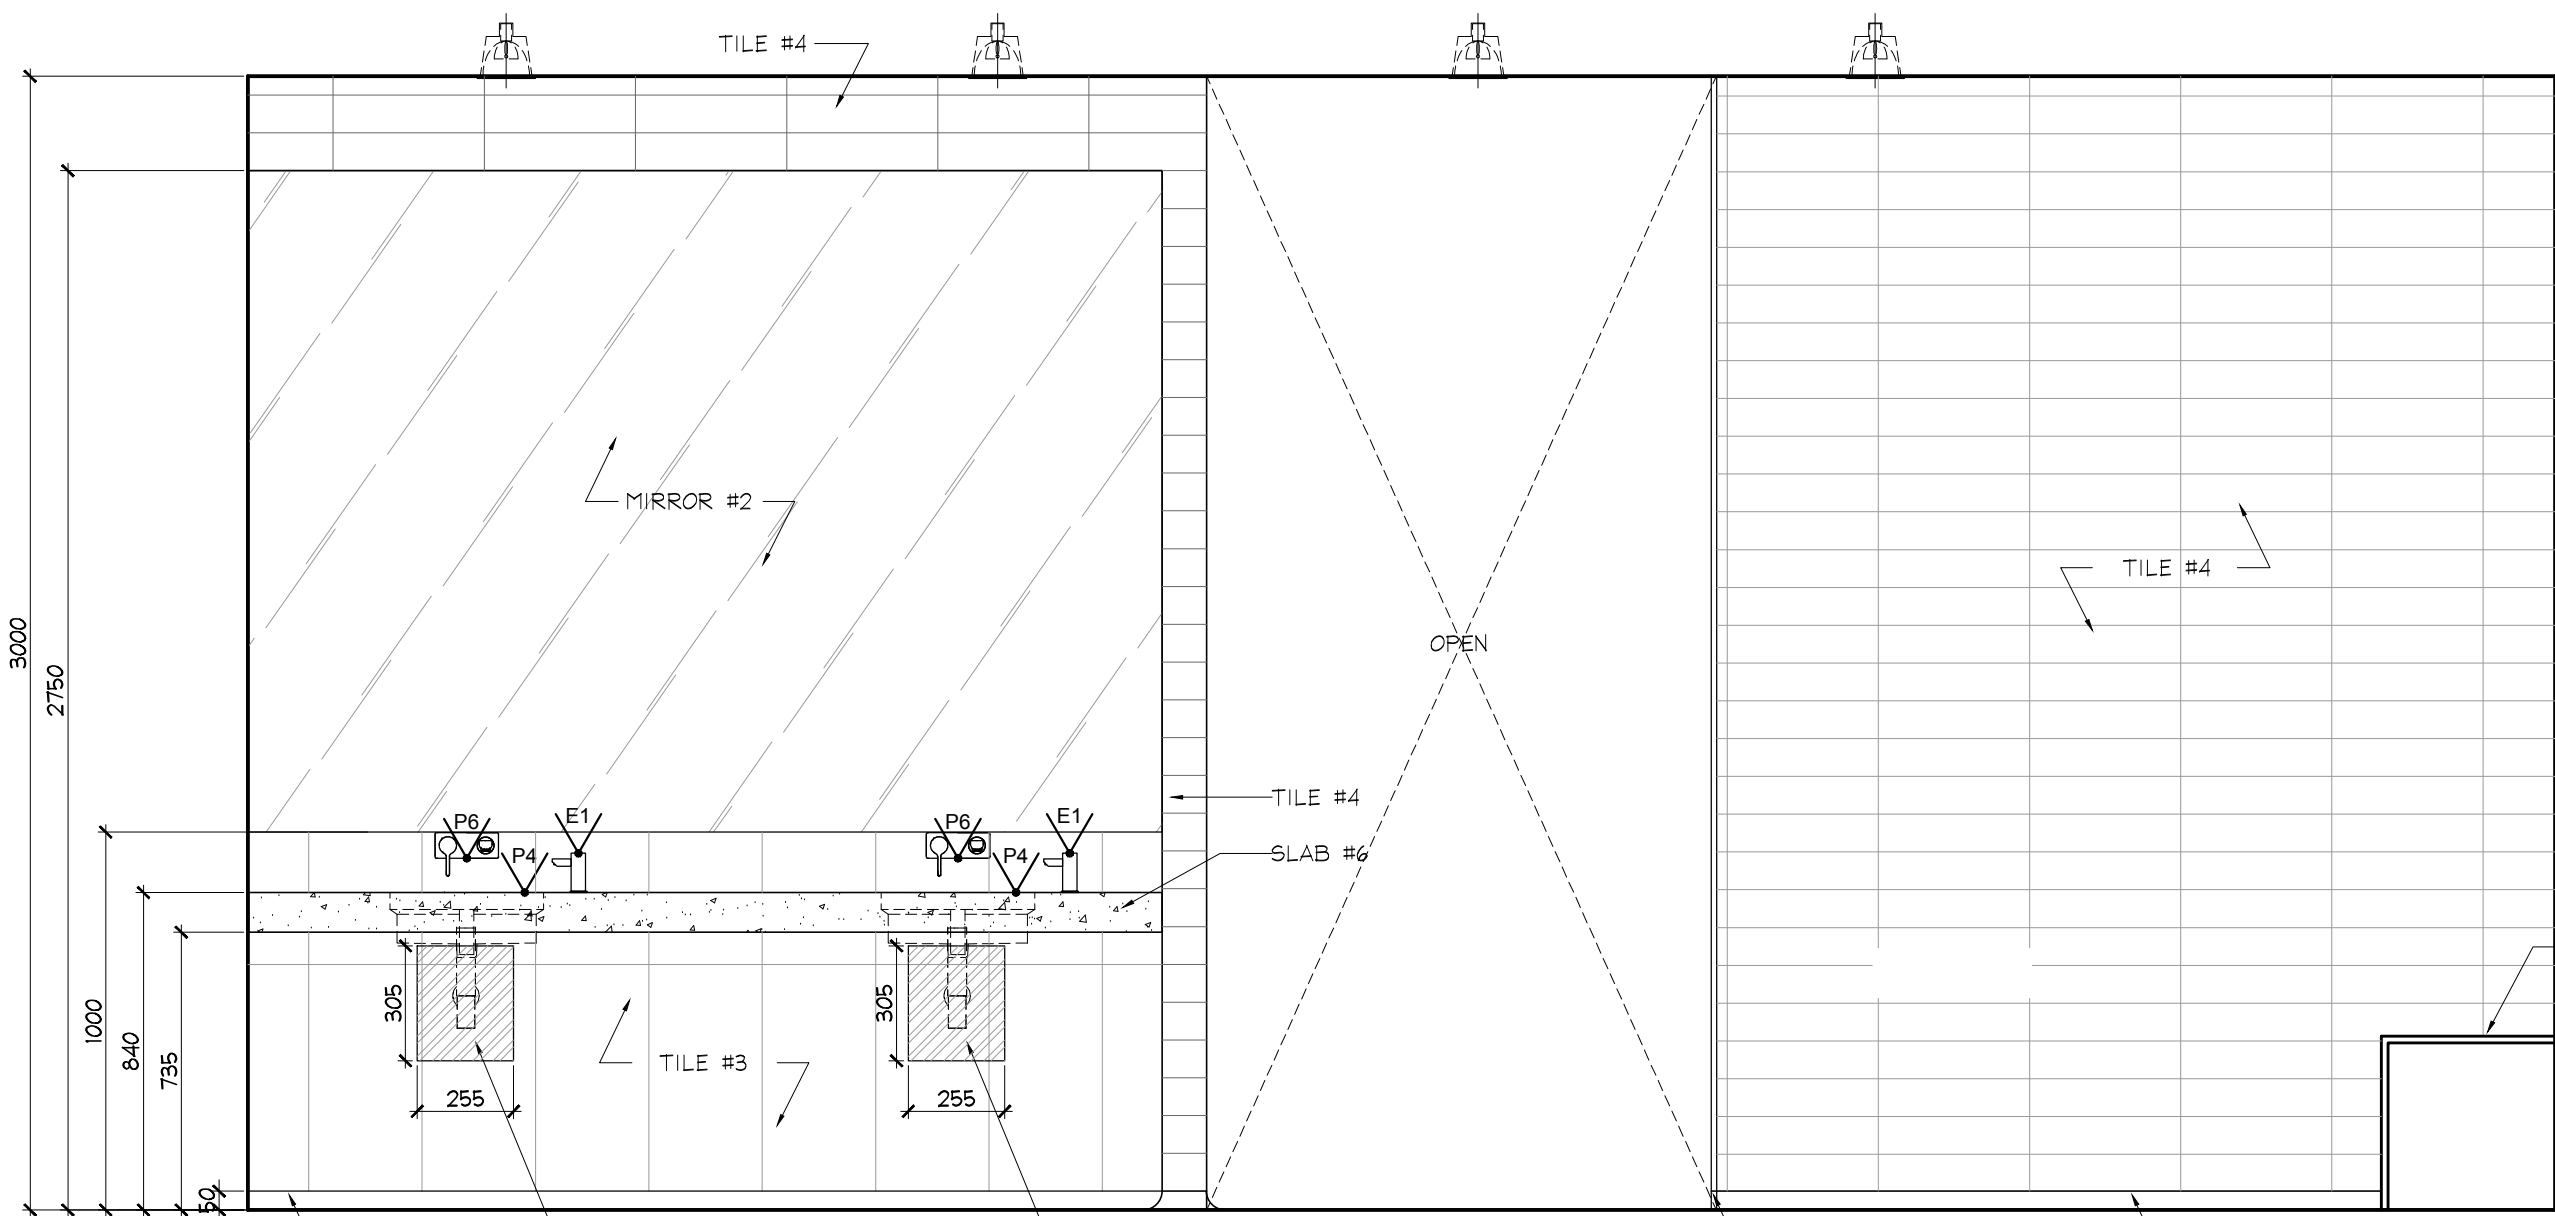


1 ELEVATION
ID2.1.9 GROUND FLOOR
MEN'S CHANGE ROOM
SCALE 1:20

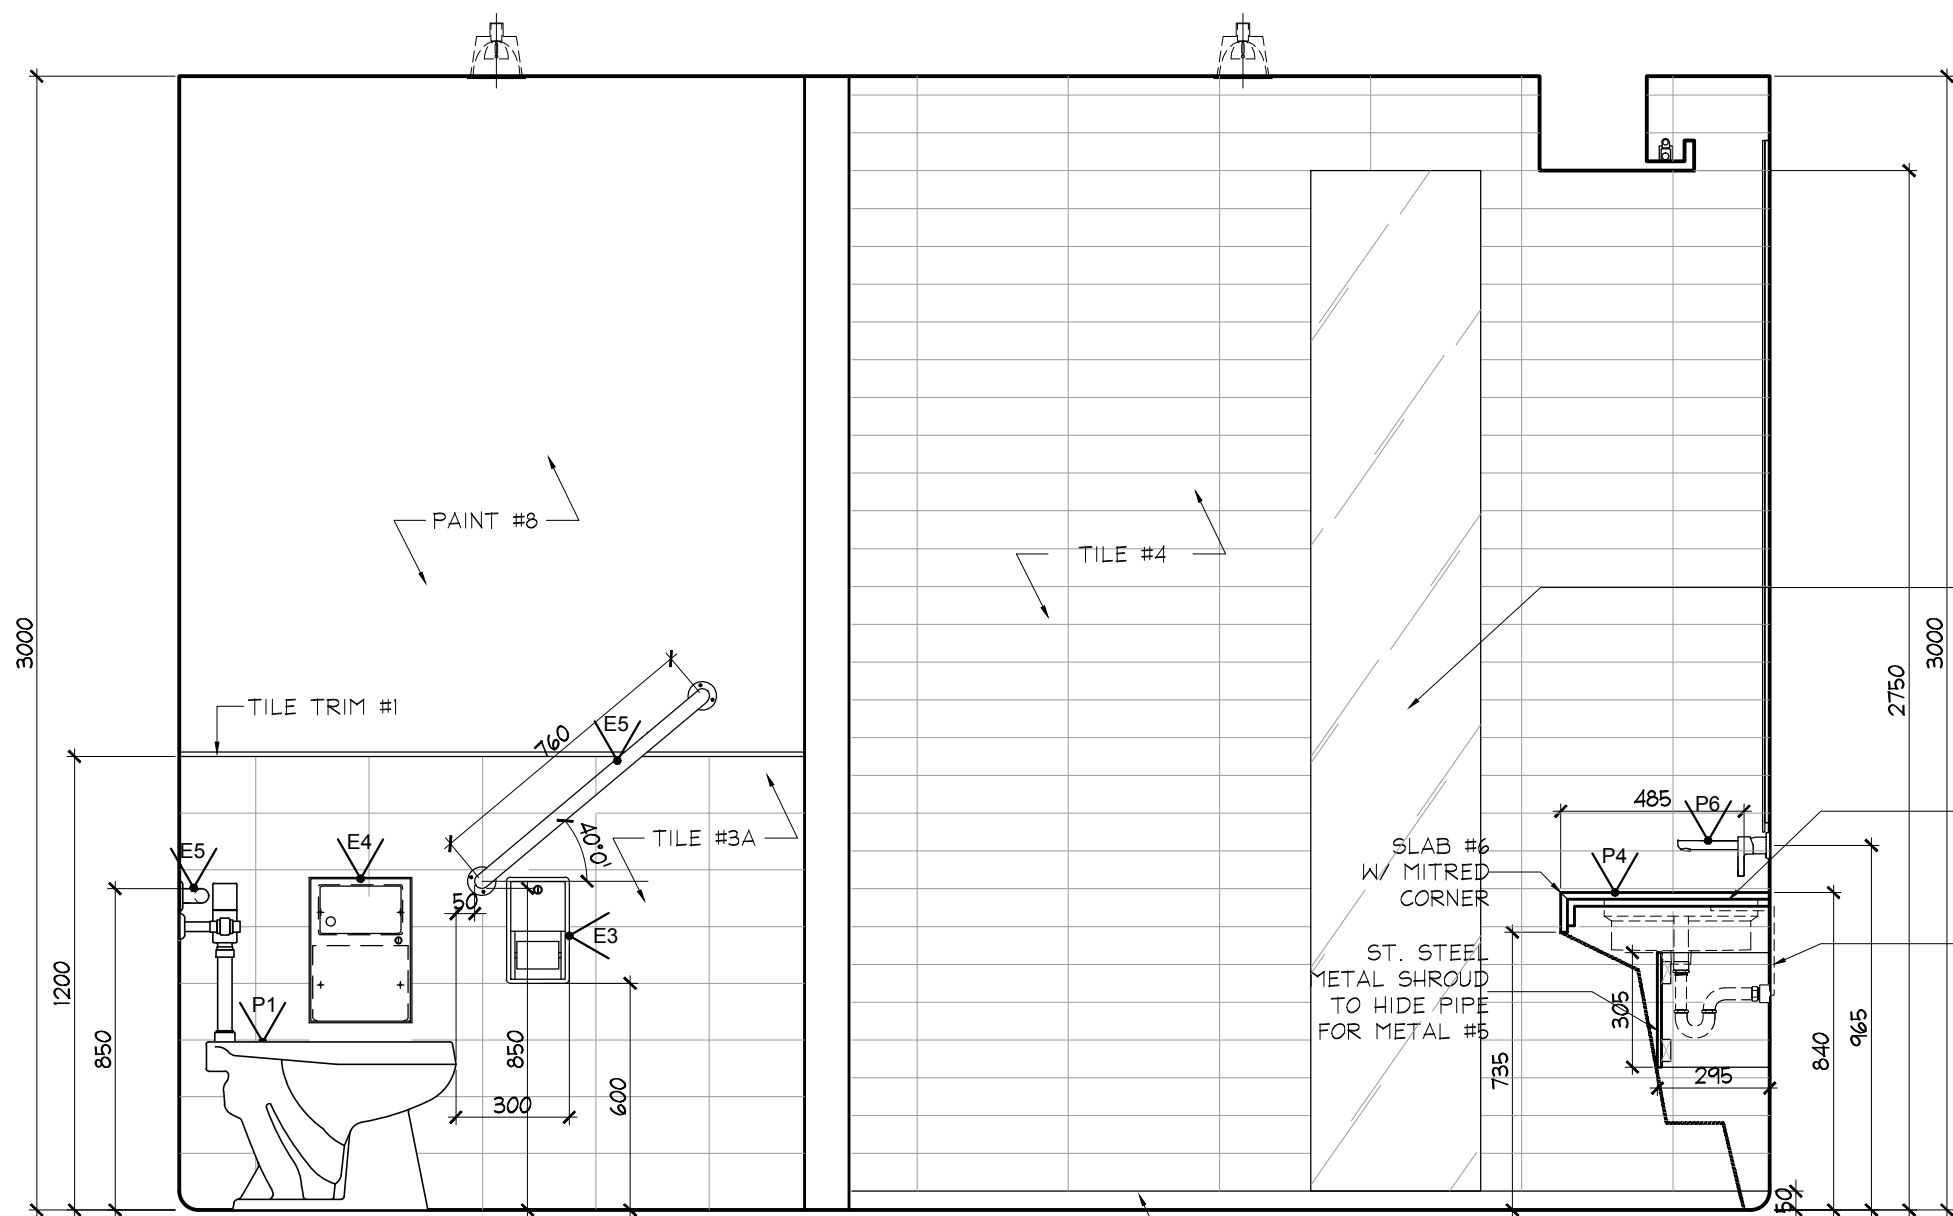


2 ELEVATION
ID2.1.9 GROUND FLOOR
MEN'S CHANGE ROOM
SCALE 1:20

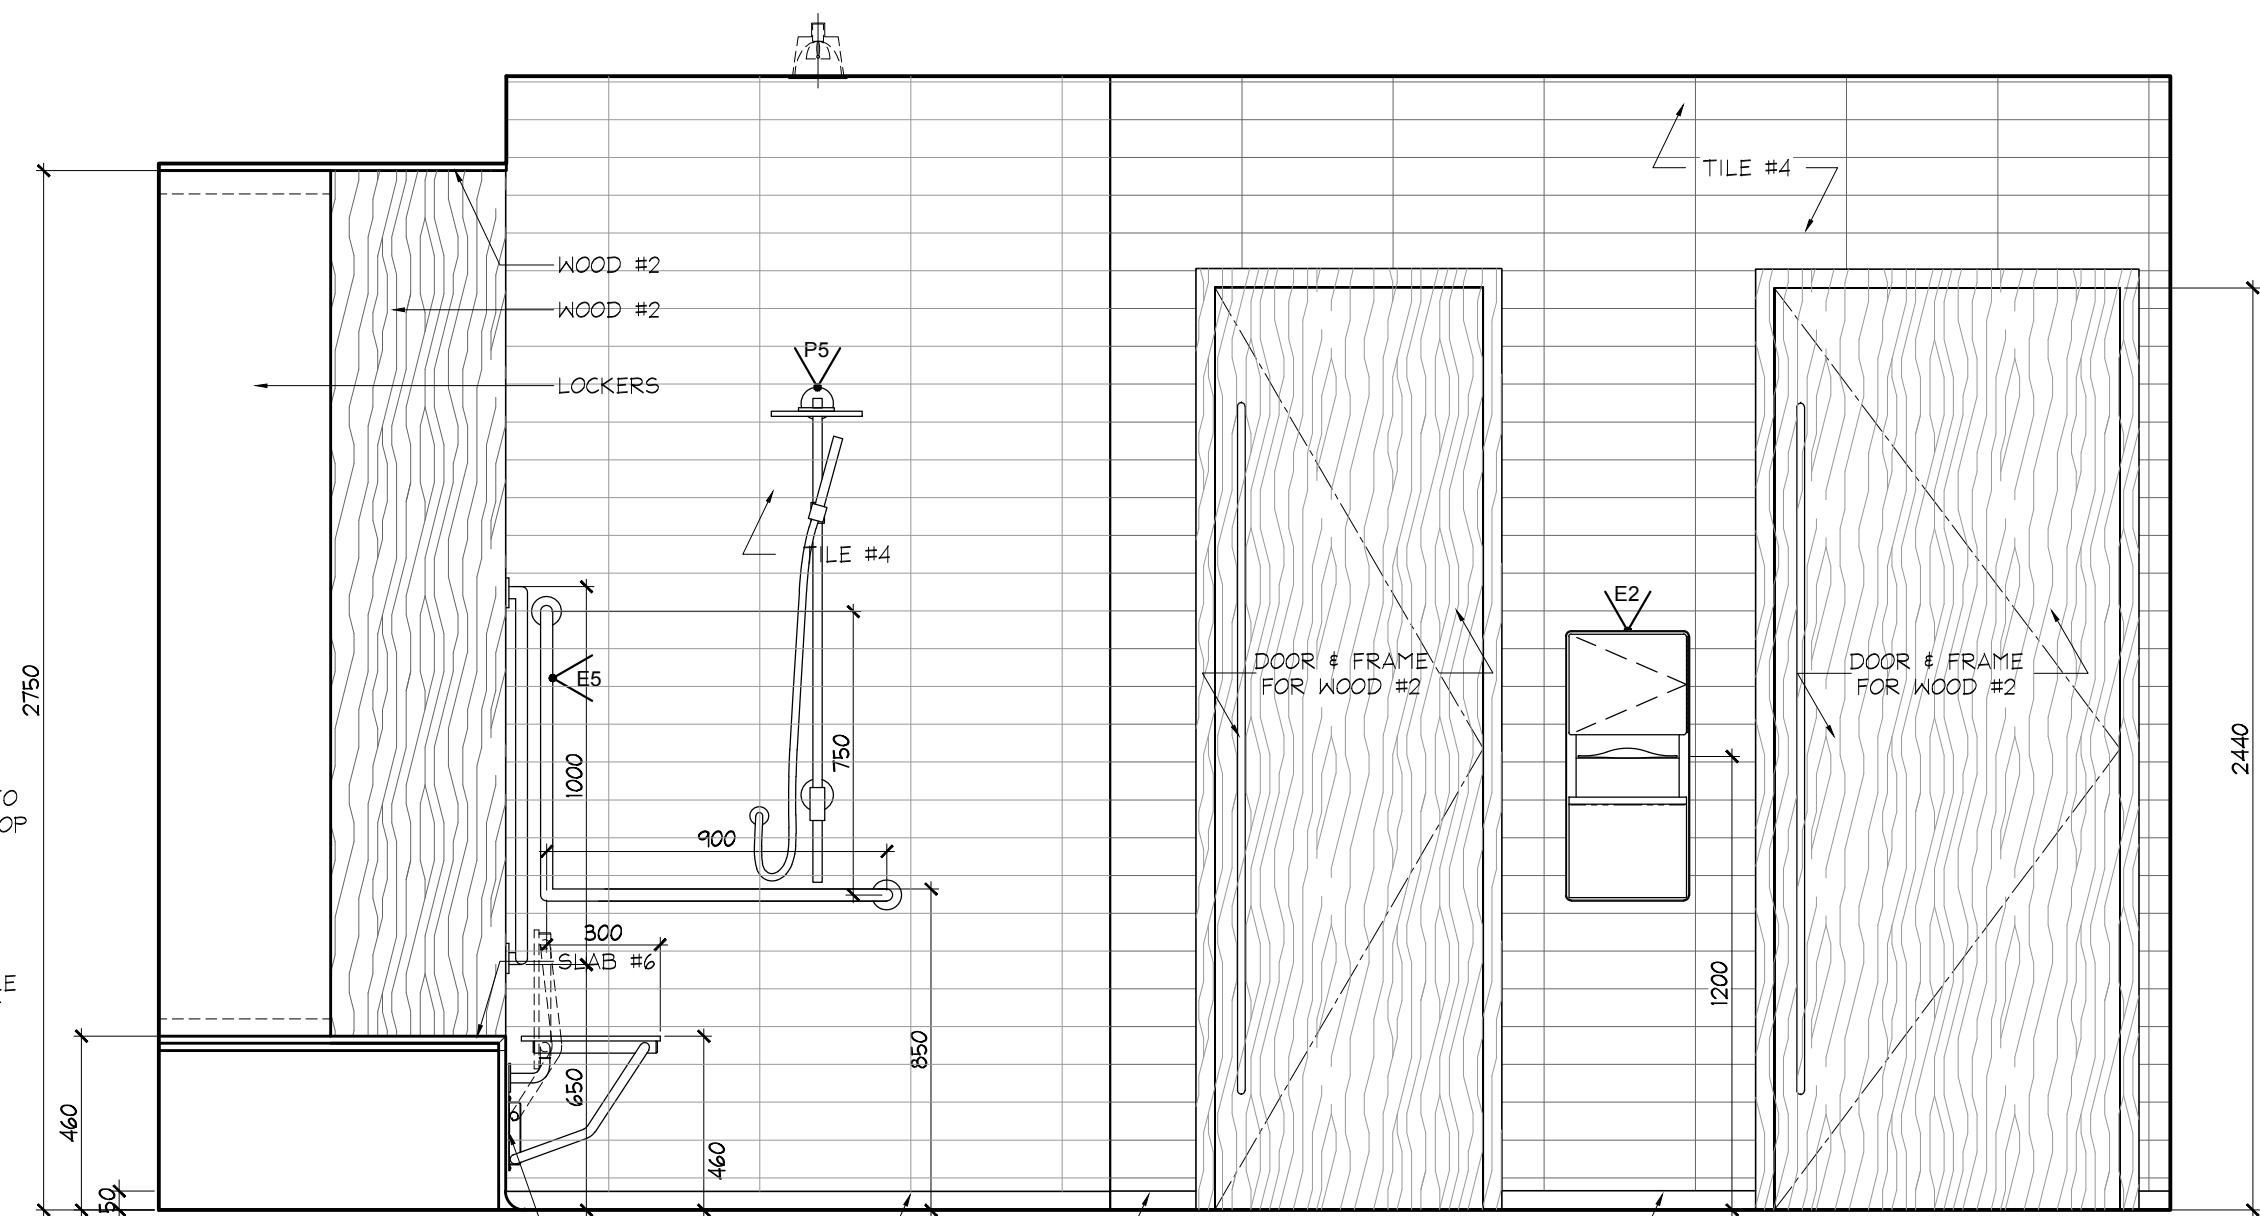


3 ELEVATION
ID2.1.9 GROUND FLOOR
MEN'S CHANGE ROOM
SCALE 1:20

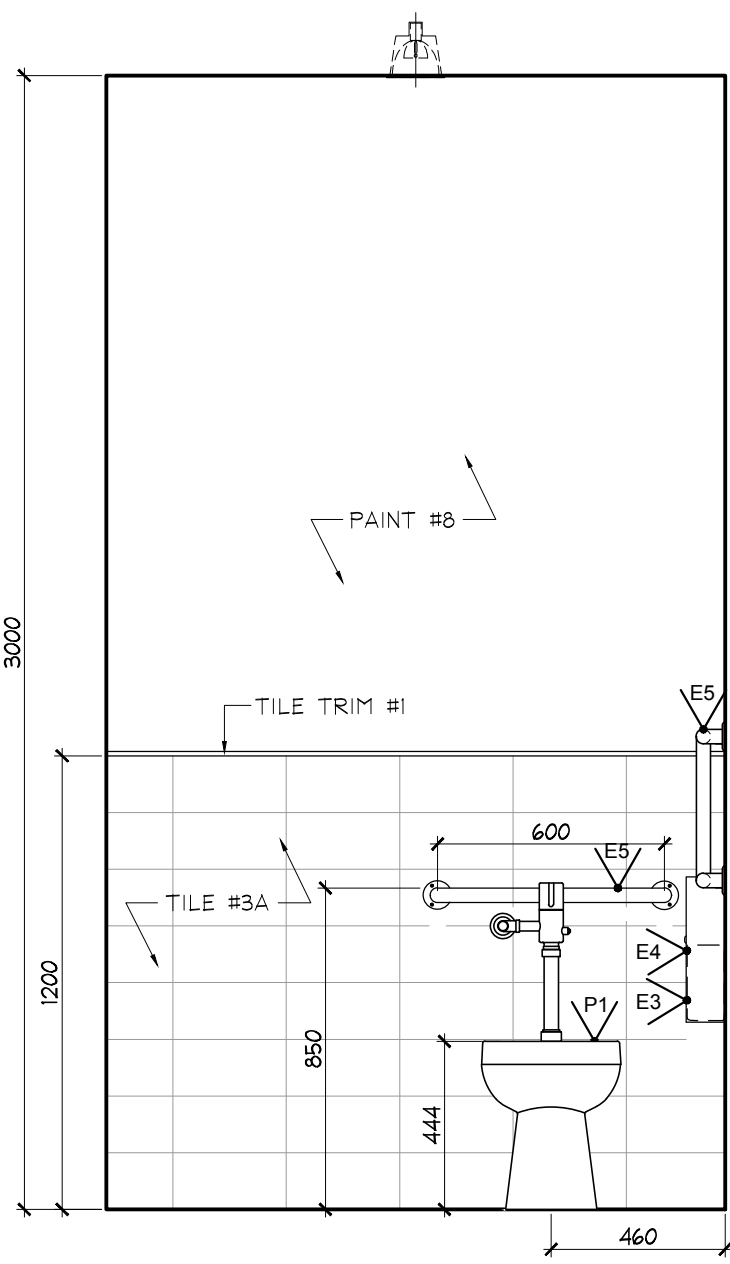


4 ELEVATION
ID2.1.9 GROUND FLOOR
MEN'S CHANGE ROOM
SCALE 1:20

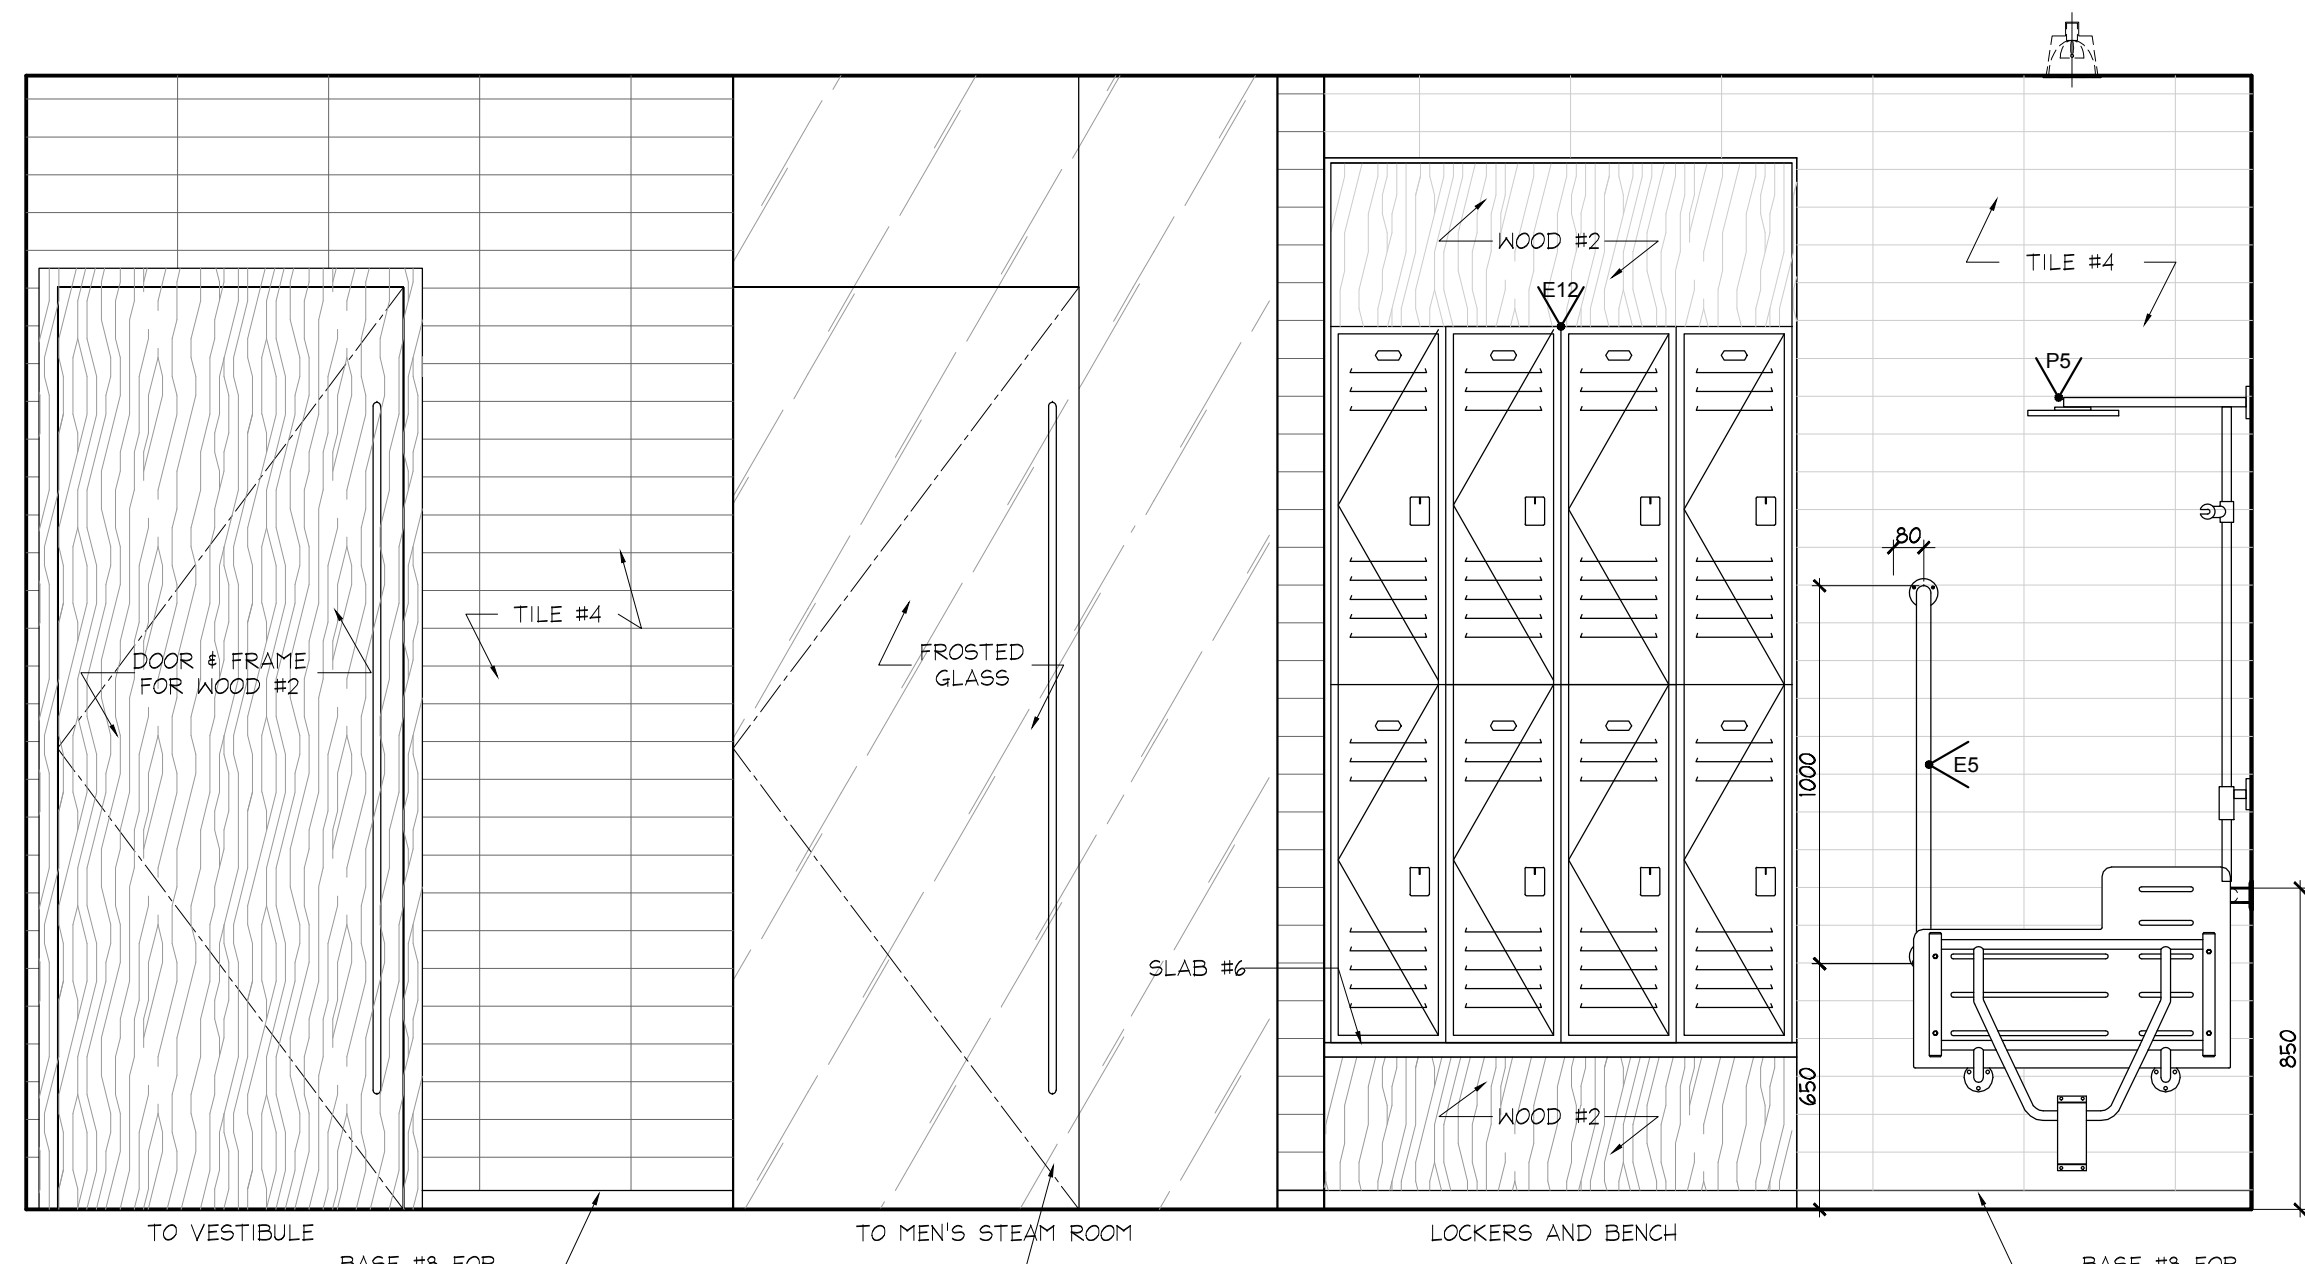


5 ELEVATION
ID2.1.9 GROUND FLOOR
MEN'S CHANGE ROOM
SCALE 1:20

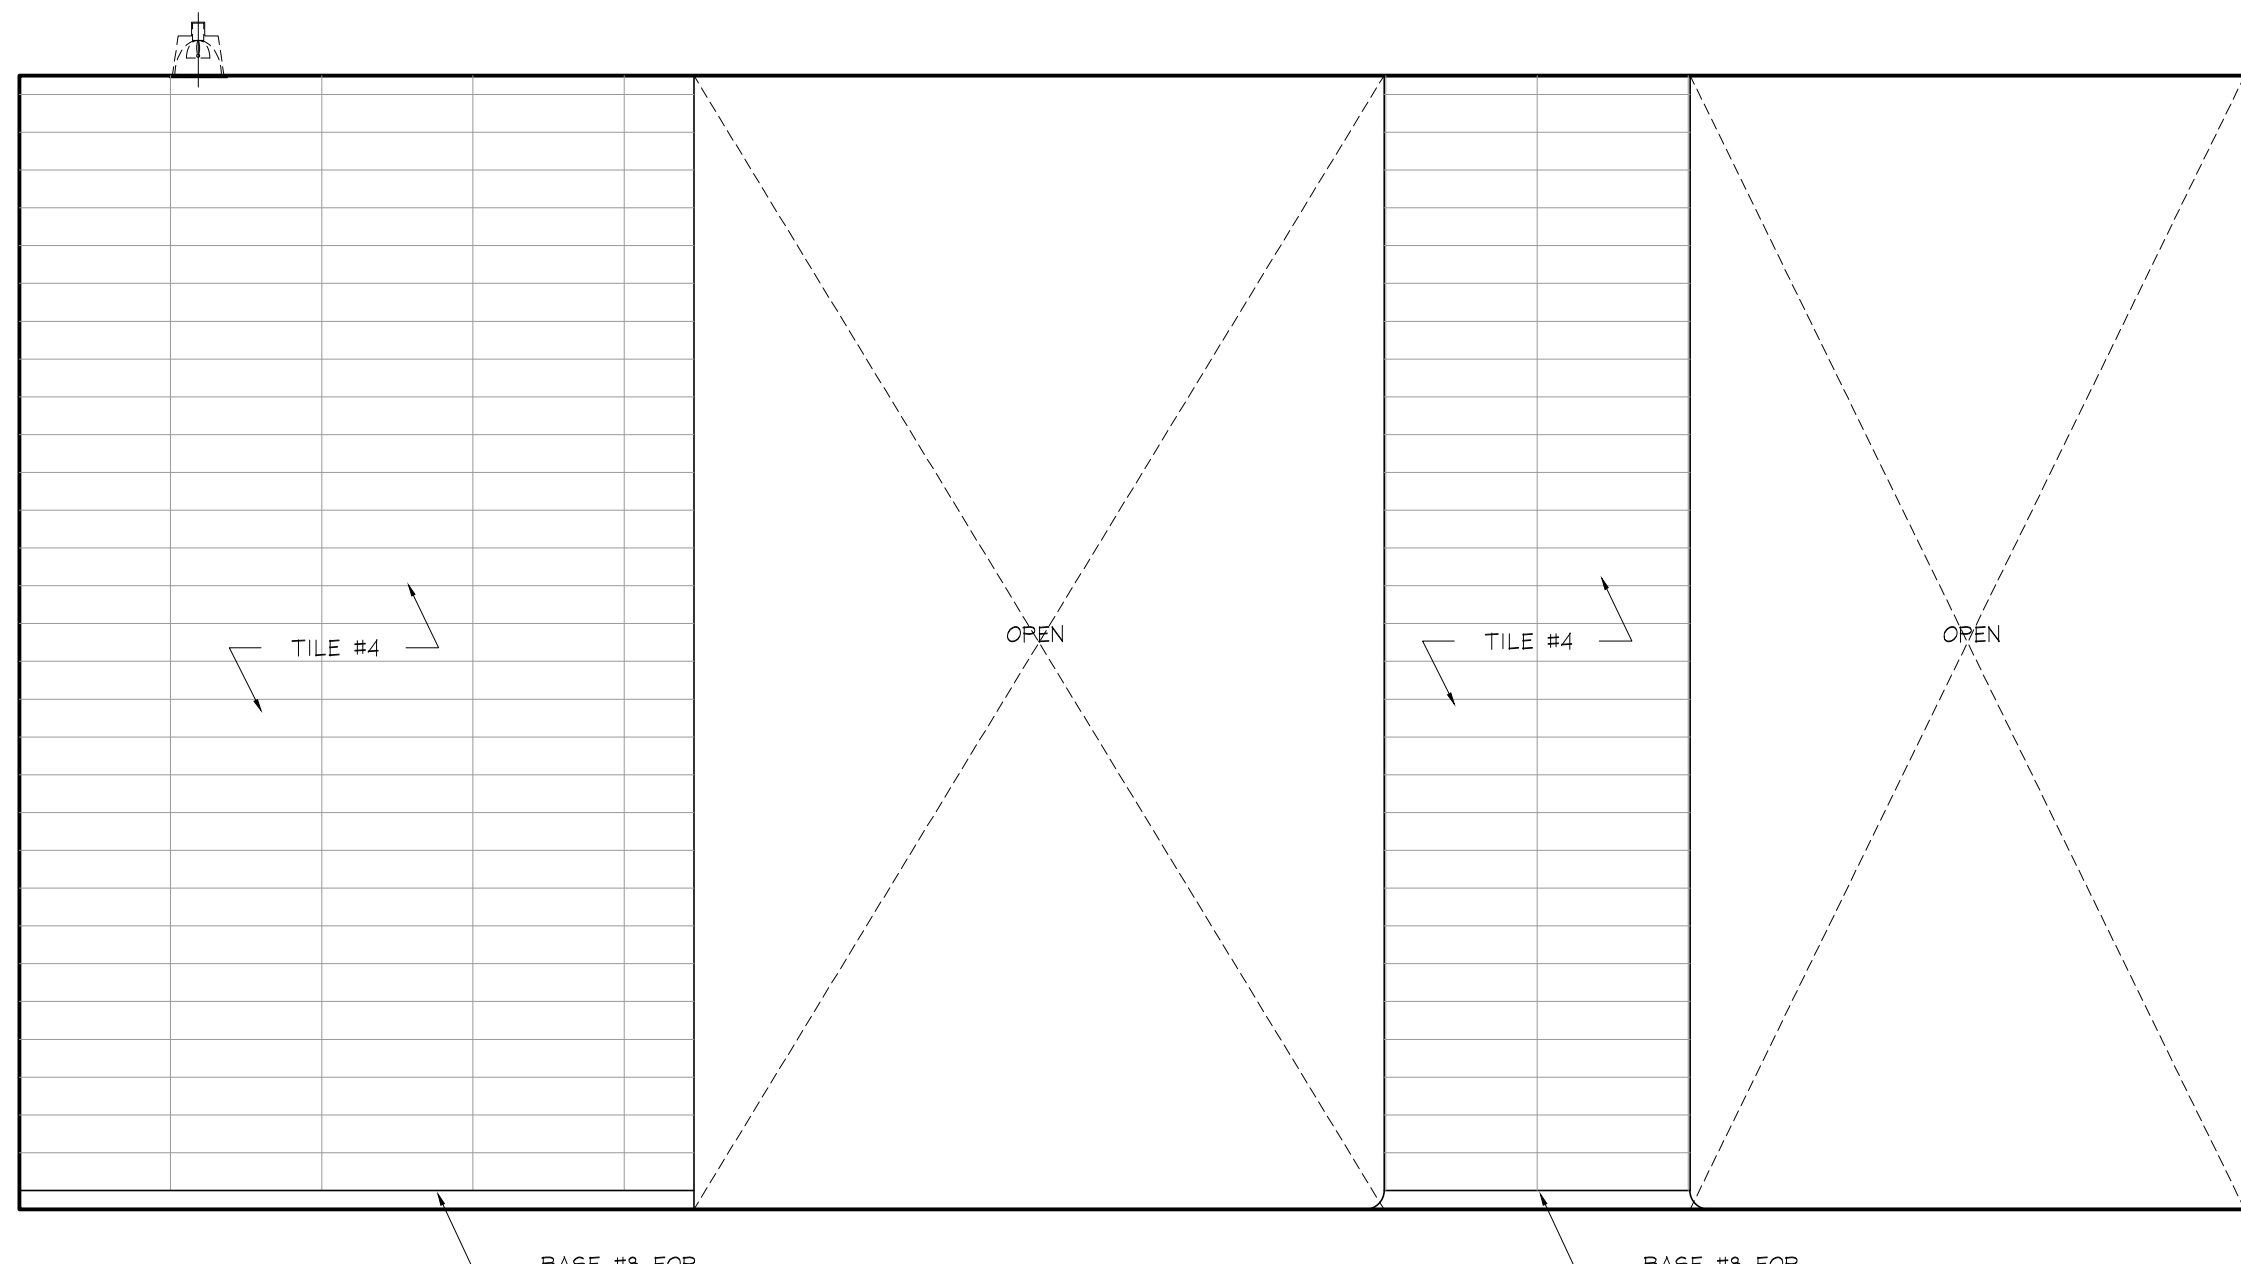

6 ELEVATION
ID2.1.9 GROUND FLOOR
MEN'S CHANGE ROOM
SCALE 1:20

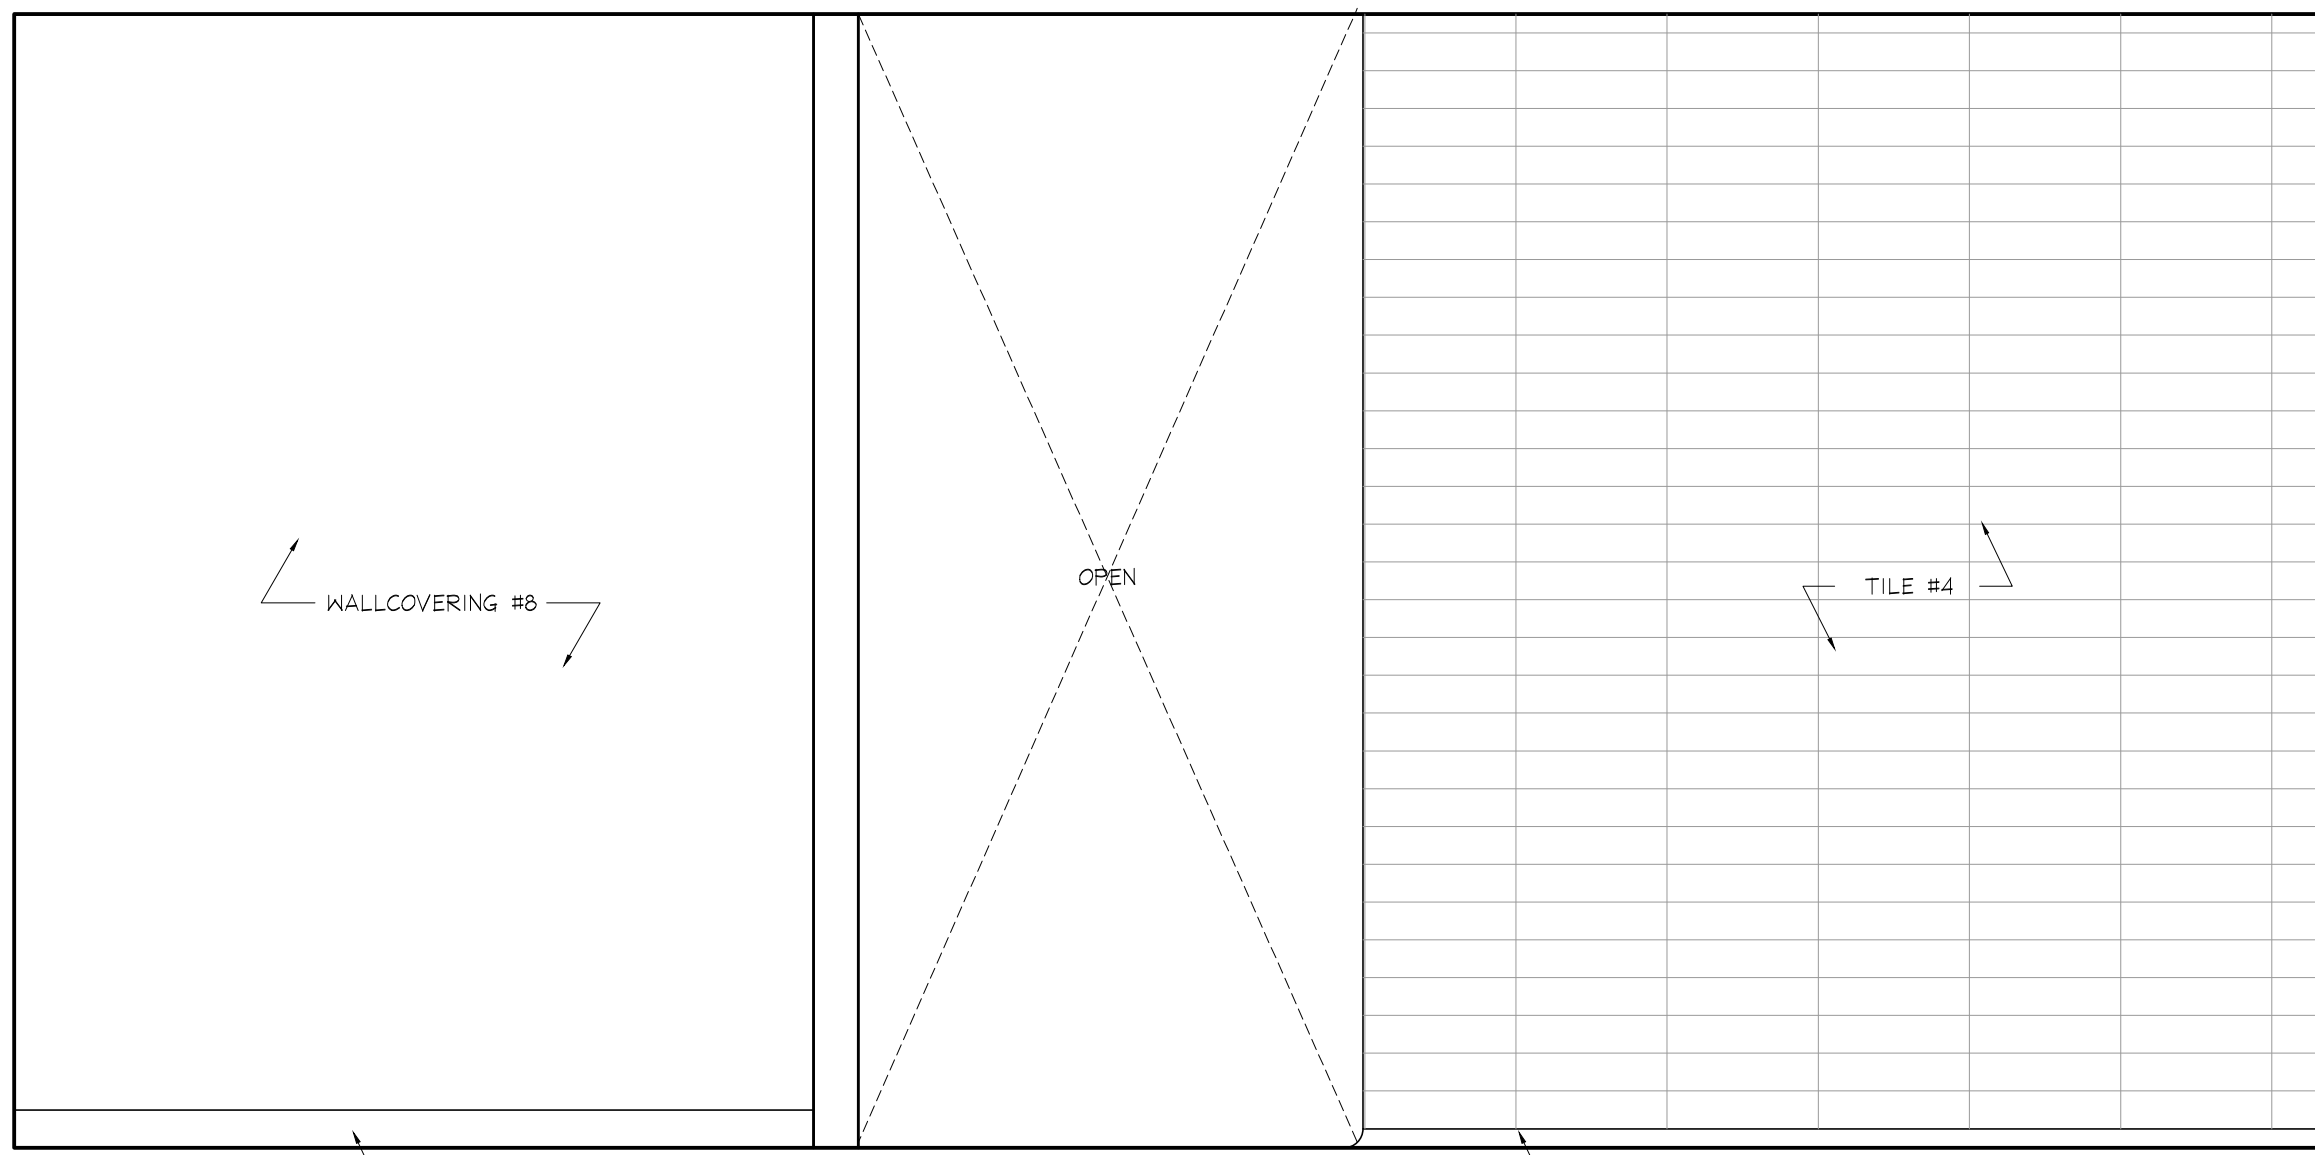

7 ELEVATION
ID2.1.9 GROUND FLOOR
MEN'S CHANGE ROOM
SCALE 1:20

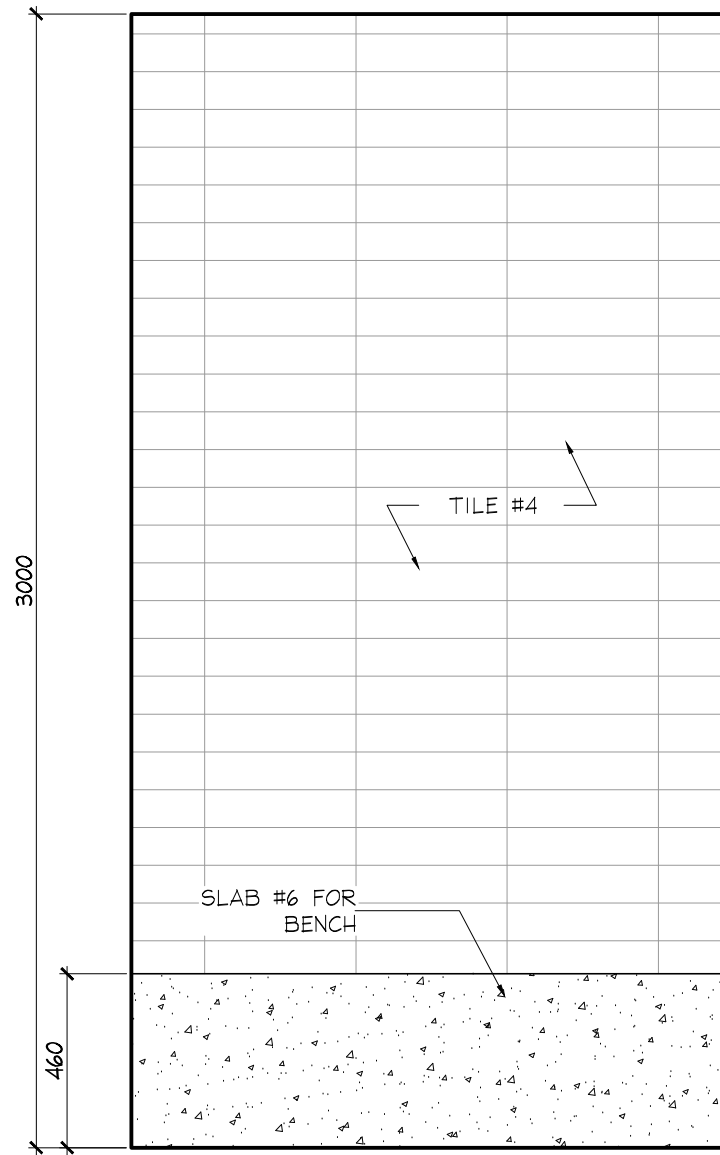

8 ELEVATION
ID2.1.9 GROUND FLOOR
MEN'S CHANGE ROOM
SCALE 1:20

DO NOT SCALE DRAWINGS.

CONTRACTOR MUST VERIFY ALL DRAWINGS, DIMENSIONS, DETAILS AND SPECIFICATIONS AND REPORT ANY DISCREPANCIES TO UNION 31 INC. BEFORE PROCEEDING WITH WORK. MATERIALS MAY NOT BE SUBSTITUTED WITHOUT WRITTEN APPROVAL FROM UNION 31 INC. ALL DRAWINGS AND SPECIFICATIONS ARE INSTRUMENTS OF SERVICE AND THE PROPERTY OF UNION 31 INC. WHICH MUST BE RETURNED AT THE COMPLETION OF THE WORK.

PRINTED: 30-MAY-17

ISSUED FOR
AS-BUILT

01	31 MAY / 17	ISSUED FOR AS-BUILT	SV
NO.	DATE	COMMENTS	INI

REVISIONS:


UNION31

UNION31 INC.
183 BATHURST STREET, STE. 201
TORONTO, ON, M5T 2R7, CANADA
TEL: 416-597-1576 FAX: 416-597-2139


PROJECT NAME:	ALEXANDRA PARK MAIN BUILDING
BLOCK 11	ON, Canada
PROJECT NO.:	13-949
DRAWINGS:	GROUND FLOOR ELEVATIONS

DATE STARTED:	07 AUG / 13	DRAWING NO.:	ID
SCALE:	1 : 20	DRAWN BY:	AP
APPROVED BY:	KC	2.1.9	


NOTE:
INSTALL ALL BARRIER FREE
WASHROOM COMPONENTS
ACCORDING TO OBC
REQUIREMENTS

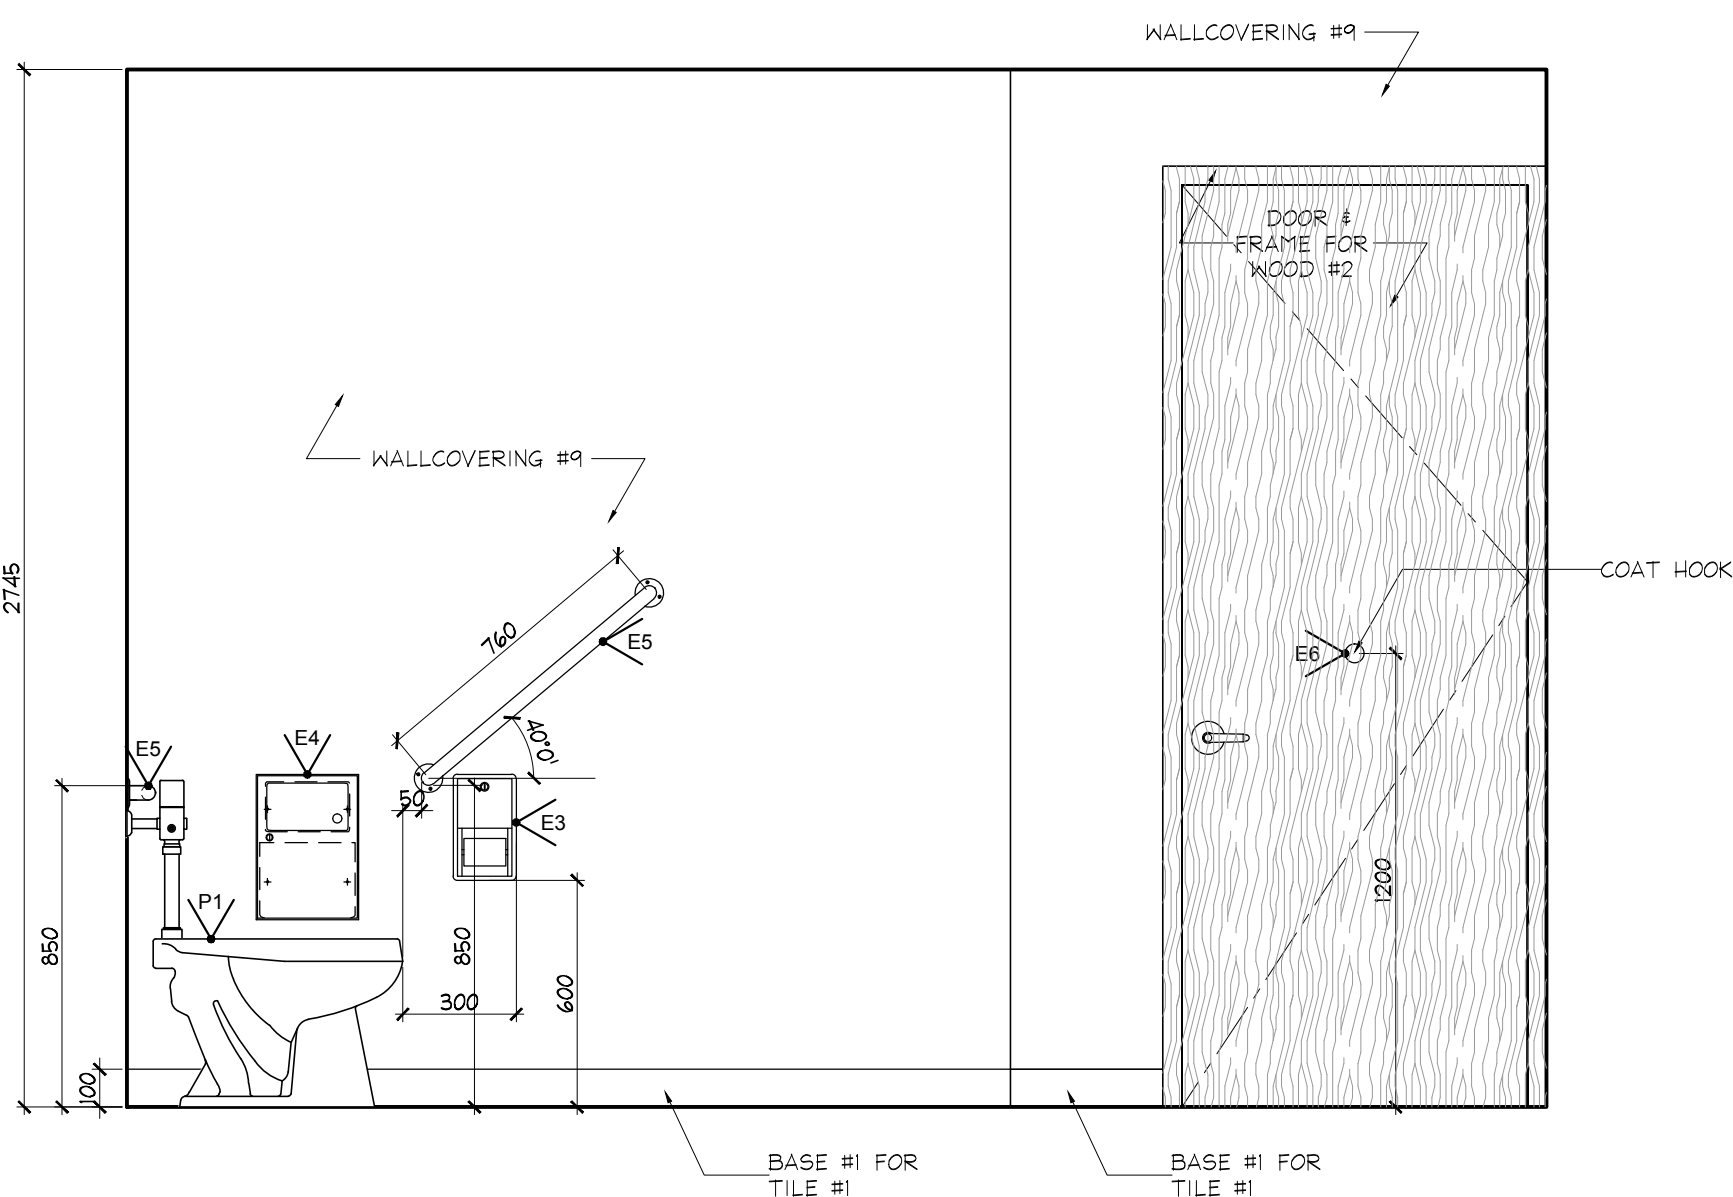


1 ELEVATION
02.1.10 GROUND FLOOR
B.F. WASHROOM SCALE 1:20

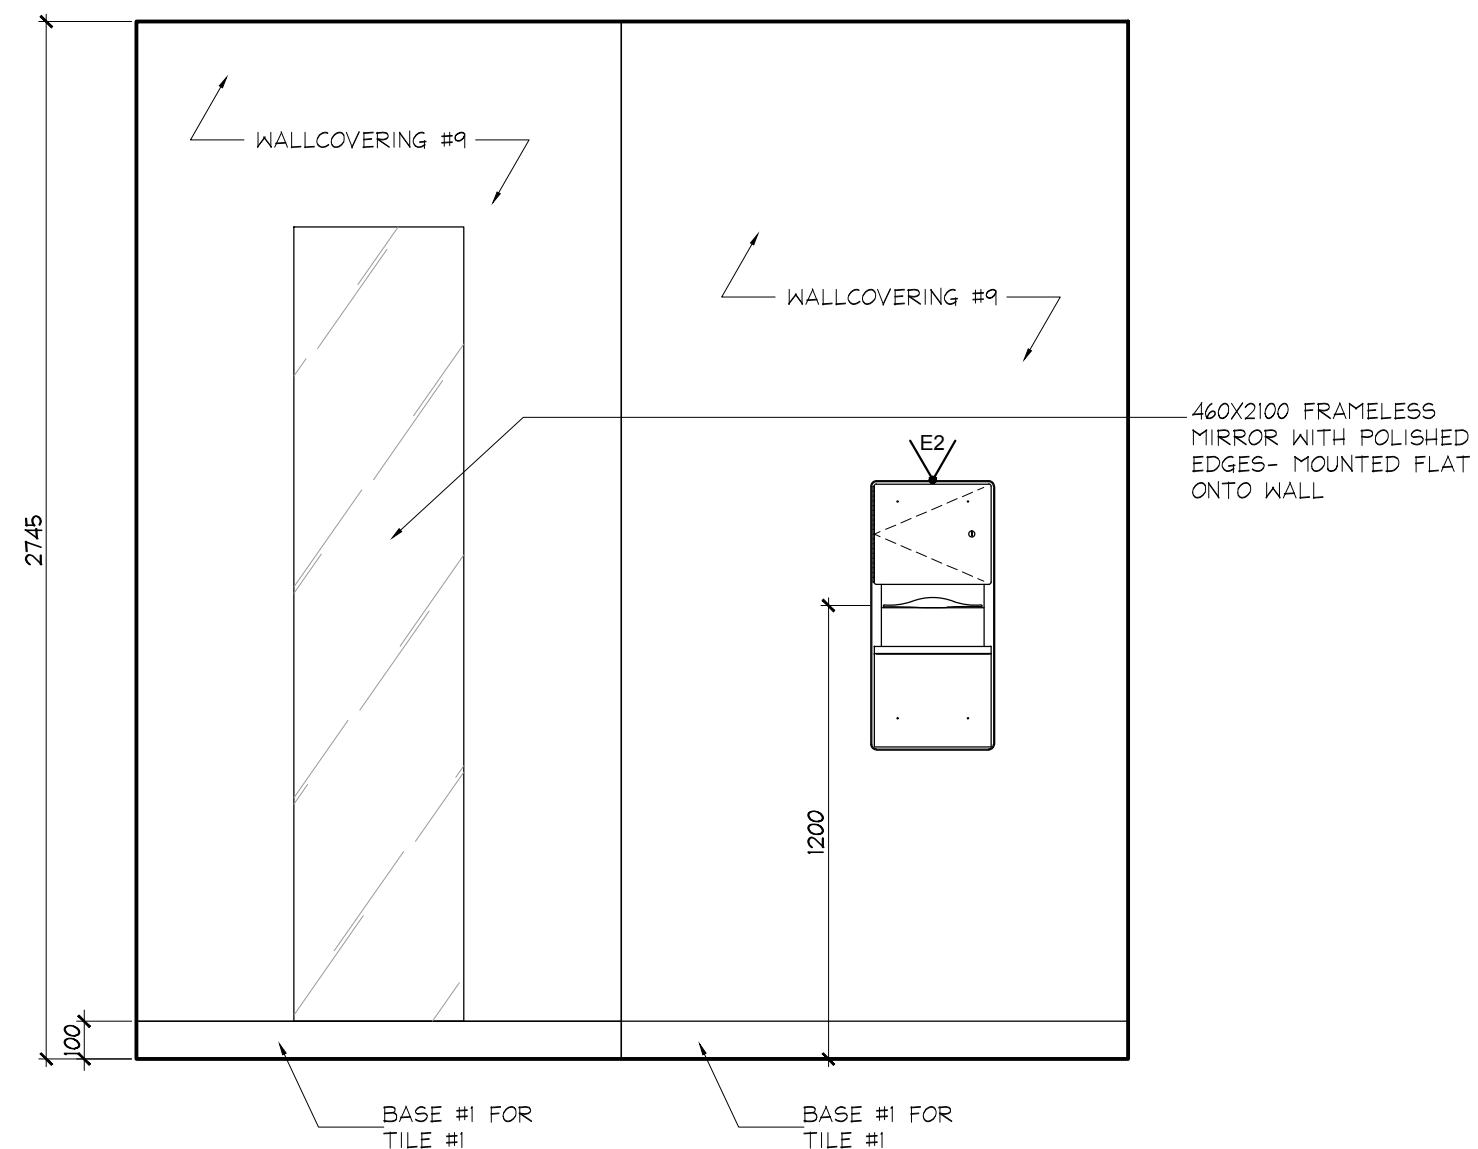


2 ELEVATION
02.1.10 GROUND FLOOR
B.F. WASHROOM SCALE 1:20

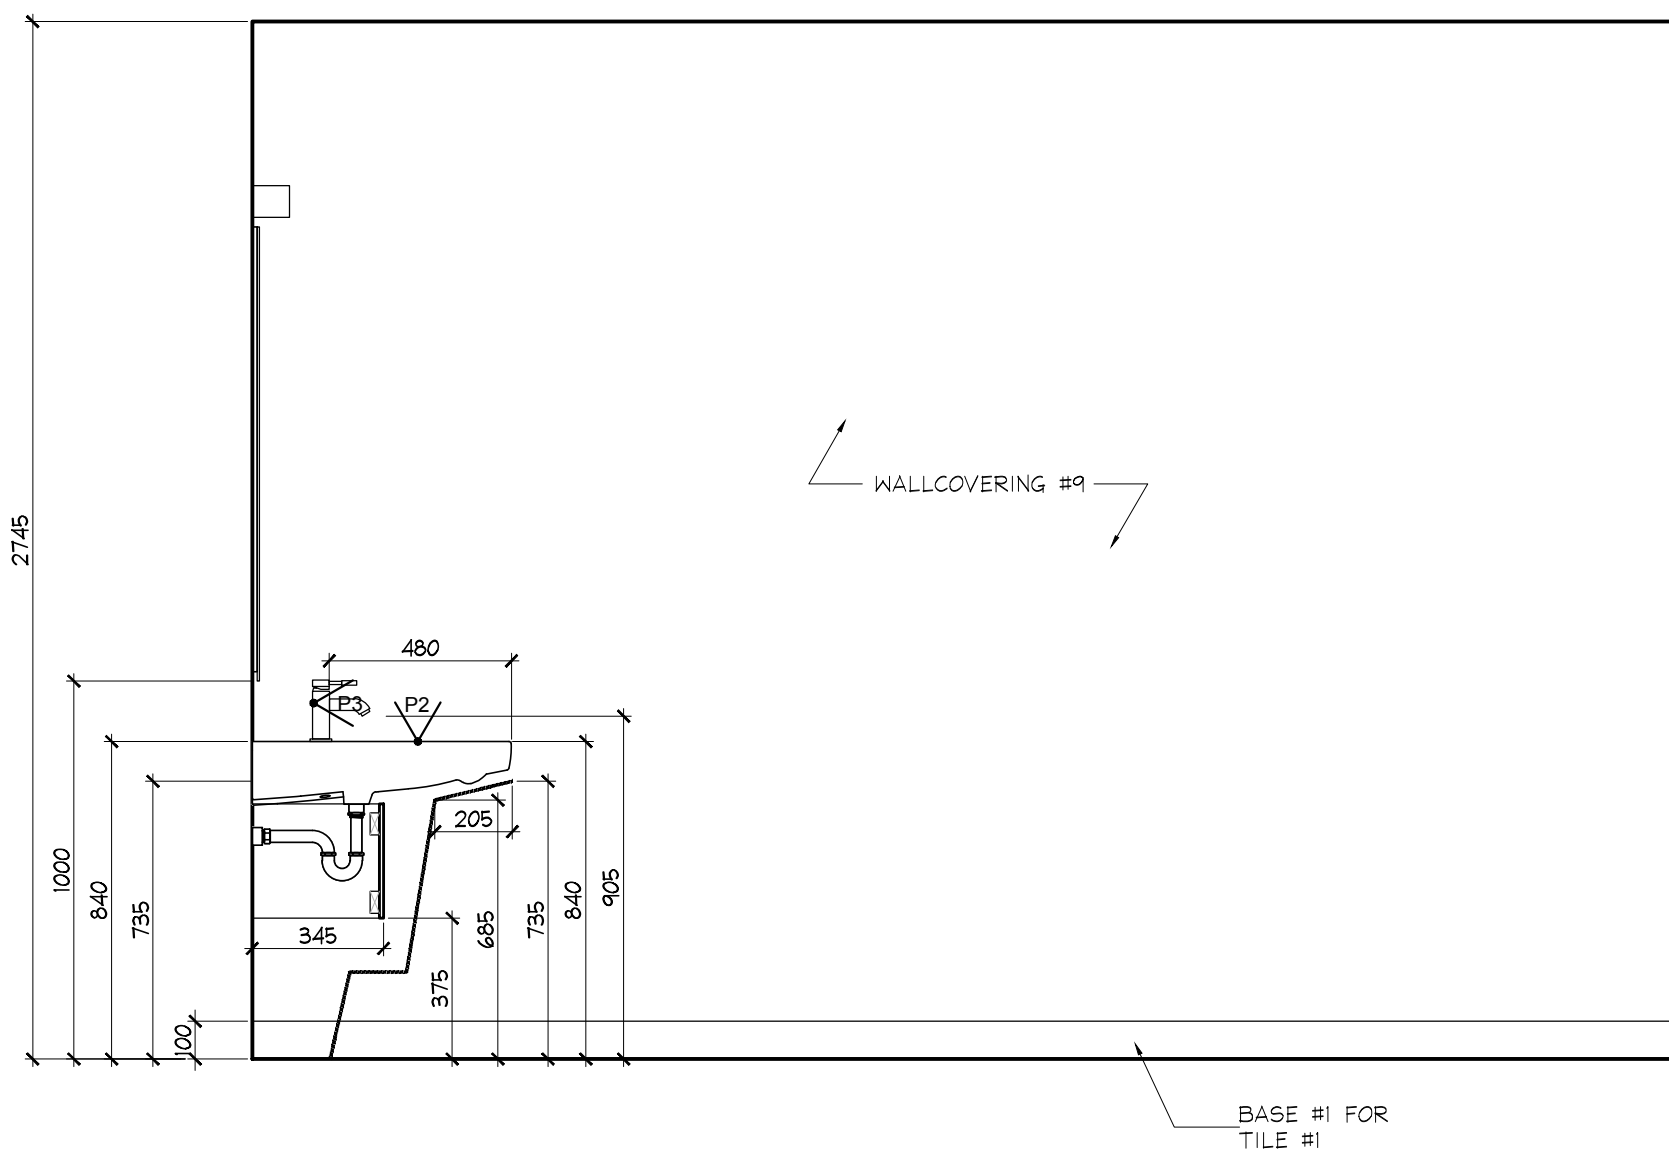


3 ELEVATION
02.1.10 GROUND FLOOR
B.F. WASHROOM SCALE 1:20

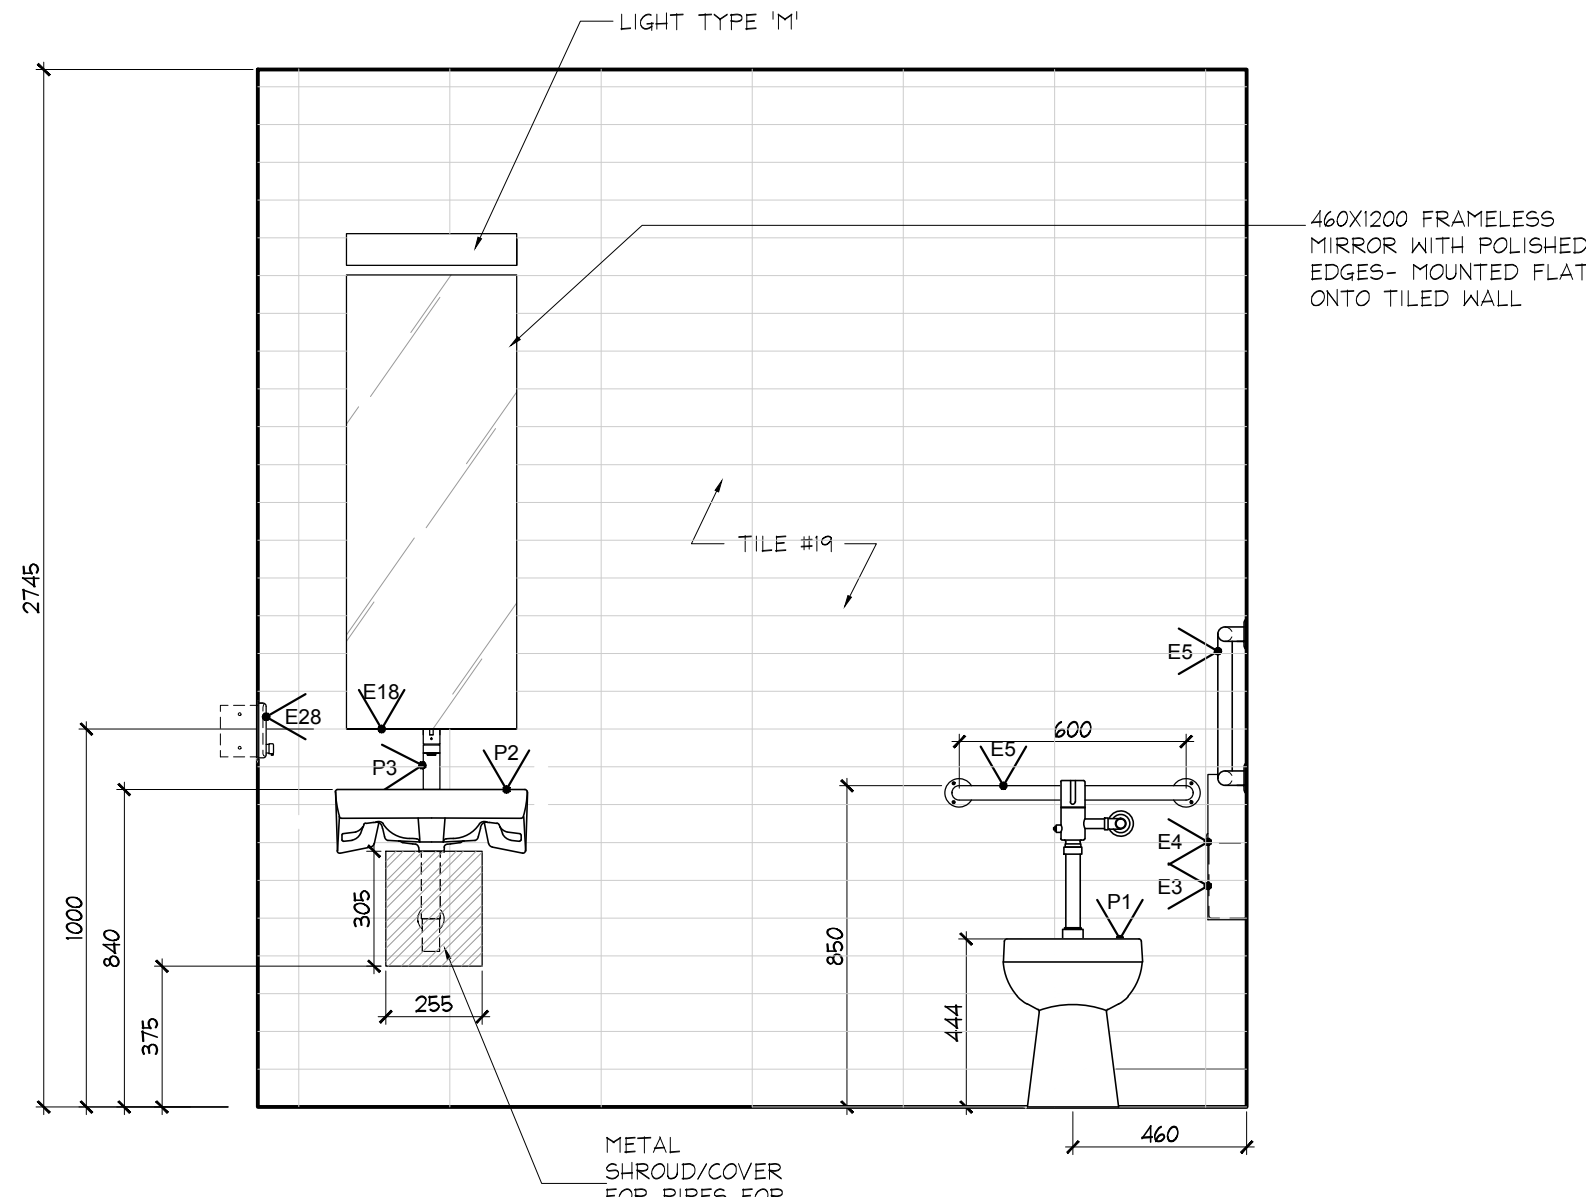


4 ELEVATION
02.1.10 GROUND FLOOR
B.F. WASHROOM SCALE 1:20

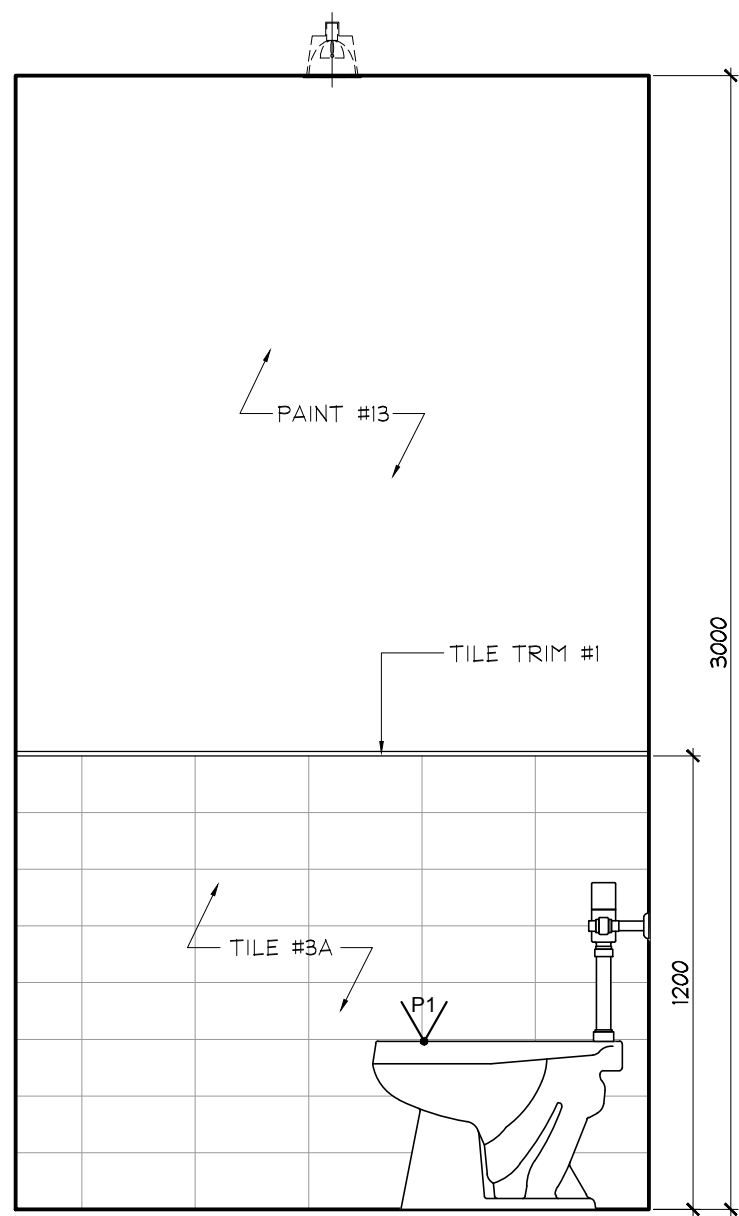


5 ELEVATION
02.1.10 GROUND FLOOR
WOMEN'S & MEN'S WASHROOM SCALE 1:20

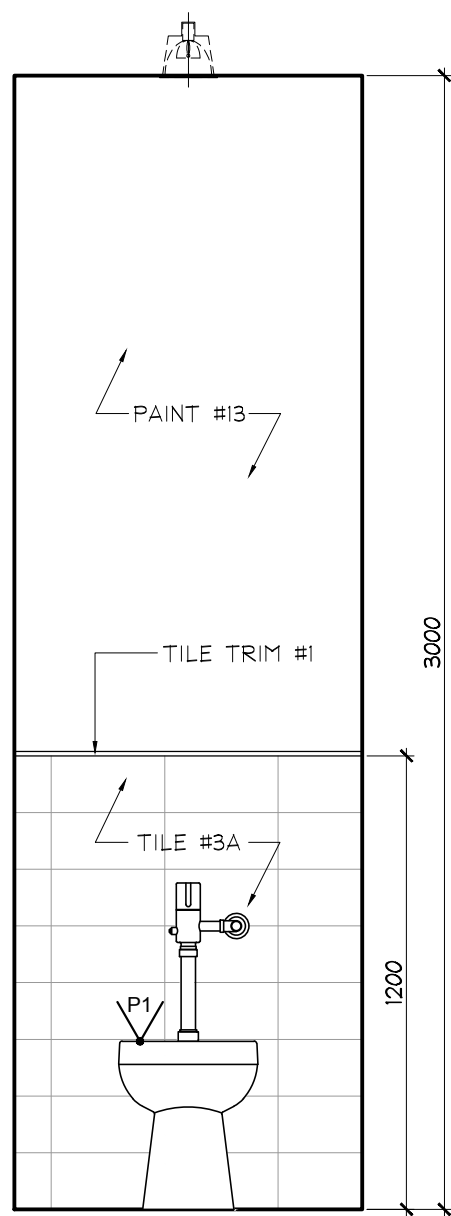

6 ELEVATION
02.1.10 GROUND FLOOR
WOMEN'S / MEN'S WASHROOM SCALE 1:20

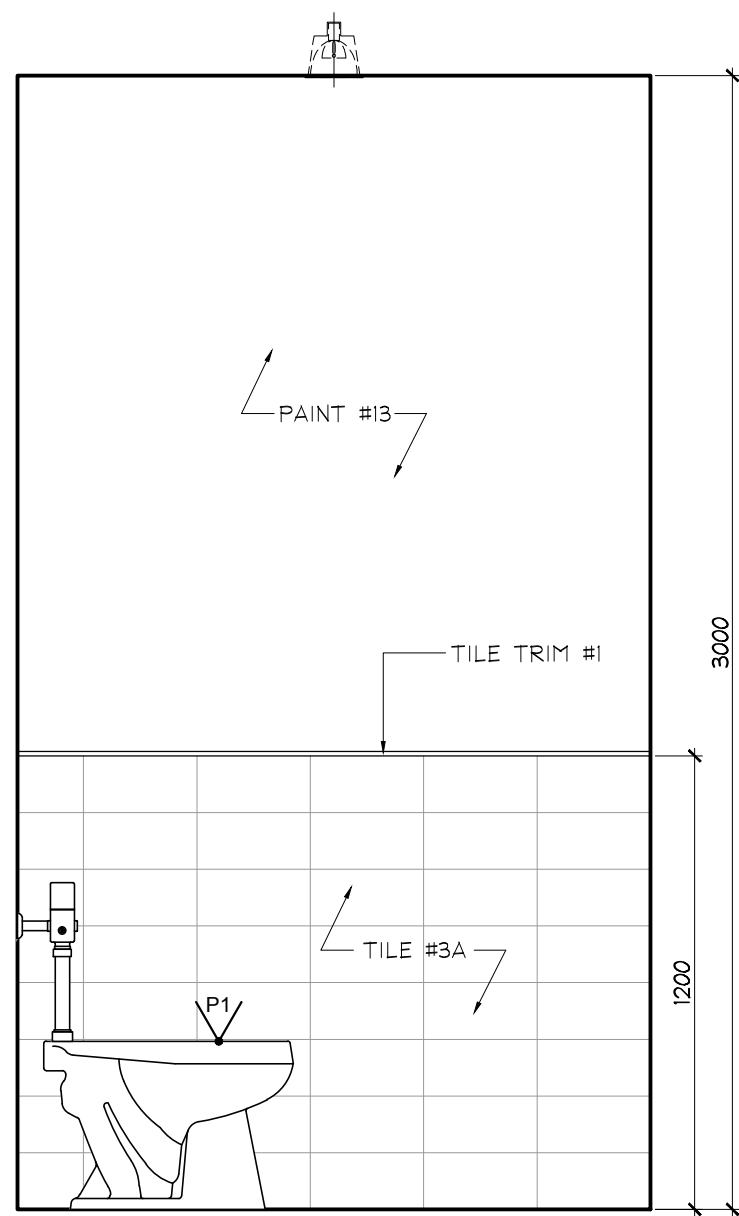

7 ELEVATION
02.1.10 GROUND FLOOR
WOMEN'S & MEN'S WASHROOM SCALE 1:20

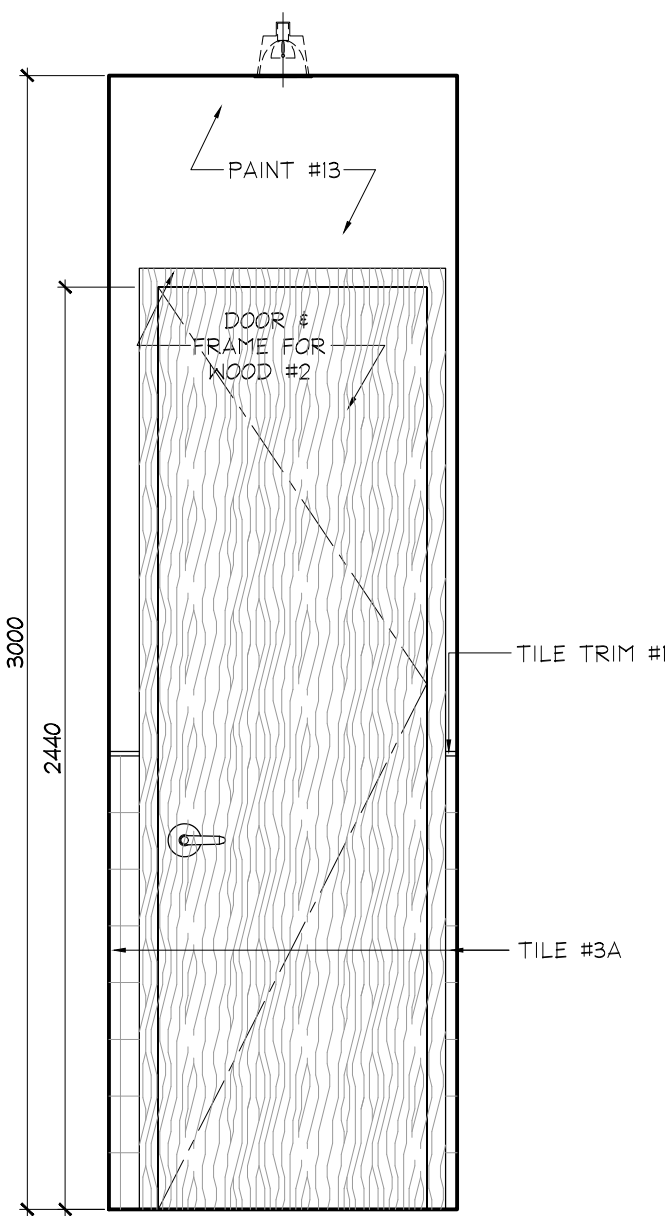

8 ELEVATION
02.1.10 GROUND FLOOR
WOMEN'S & MEN'S WASHROOM SCALE 1:20

DO NOT SCALE DRAWINGS.

CONTRACTOR MUST VERIFY ALL DRAWINGS, DIMENSIONS, DETAILS AND SPECIFICATIONS AND REPORT ANY DISCREPANCIES TO UNION 31 INC. BEFORE PROCEEDING WITH WORK. MATERIALS MAY NOT BE SUBSTITUTED WITHOUT WRITTEN APPROVAL FROM UNION 31 INC.

ALL DRAWINGS AND SPECIFICATIONS ARE INSTRUMENTS OF SERVICE AND THE PROPERTY OF UNION 31 INC. WHICH MUST BE RETURNED AT THE COMPLETION OF THE WORK.

PRINTED: 30-M8-17

ISSUED FOR
AS-BUILT

01	31 MAY / 17	ISSUED FOR AS-BUILT	SV
NO.	DATE	COMMENTS	INI
REVISIONS:			

UNION31

UNION31 INC.
183 BATHURST STREET, STE. 201
TORONTO, ON, M5T 2R7, CANADA
TEL: 416-597-1576 FAX: 416-597-2139

PROJECT NAME: ALEXANDRA PARK MAIN BUILDING BLOCK 11 ON, Canada	
PROJECT NO.: 13-949	
DRAWINGS: GROUND FLOOR ELEVATIONS	
DATE STARTED: 07 AUG / 13	DRAWING NO.: ID
SCALE: 1 : 20	2.1.10
DRAWN BY: AP	
APPROVED BY: KC	

DO NOT SCALE DRAWINGS.

CONTRACTOR MUST VERIFY ALL DRAWINGS, DIMENSIONS, DETAILS AND SPECIFICATIONS AND REPORT ANY DISCREPANCIES TO UNION 31 INC. BEFORE PROCEEDING WITH WORK. MATERIALS MAY NOT BE SUBSTITUTED WITHOUT WRITTEN APPROVAL FROM UNION 31 INC.

ALL DRAWINGS AND SPECIFICATIONS ARE INSTRUMENTS OF SERVICE AND THE PROPERTY OF UNION 31 INC. WHICH MUST BE RETURNED AT THE COMPLETION OF THE WORK.

PRINTED: 30-M8-17

ISSUED FOR
AS-BUILT


01	31 MAY / 17	ISSUED FOR AS-BUILT	SV
NO.	DATE	COMMENTS	INI
REVISIONS:			

UNION31


UNION31 INC.
183 BATHURST STREET, STE. 201
TORONTO, ON, M5T 2R7, CANADA
TEL: 416-597-1576 FAX: 416-597-2139

PROJECT NAME:		ALEXANDRA PARK MAIN BUILDING
PROJECT NO.:		13-949
DRAWINGS:		GROUND FLOOR ELEVATIONS


DATE STARTED:	07 AUG / 13	DRAWING NO.:	ID
SCALE:	1 : 20		2.1.11
DRAWN BY:	AP		
APPROVED BY:	KC		

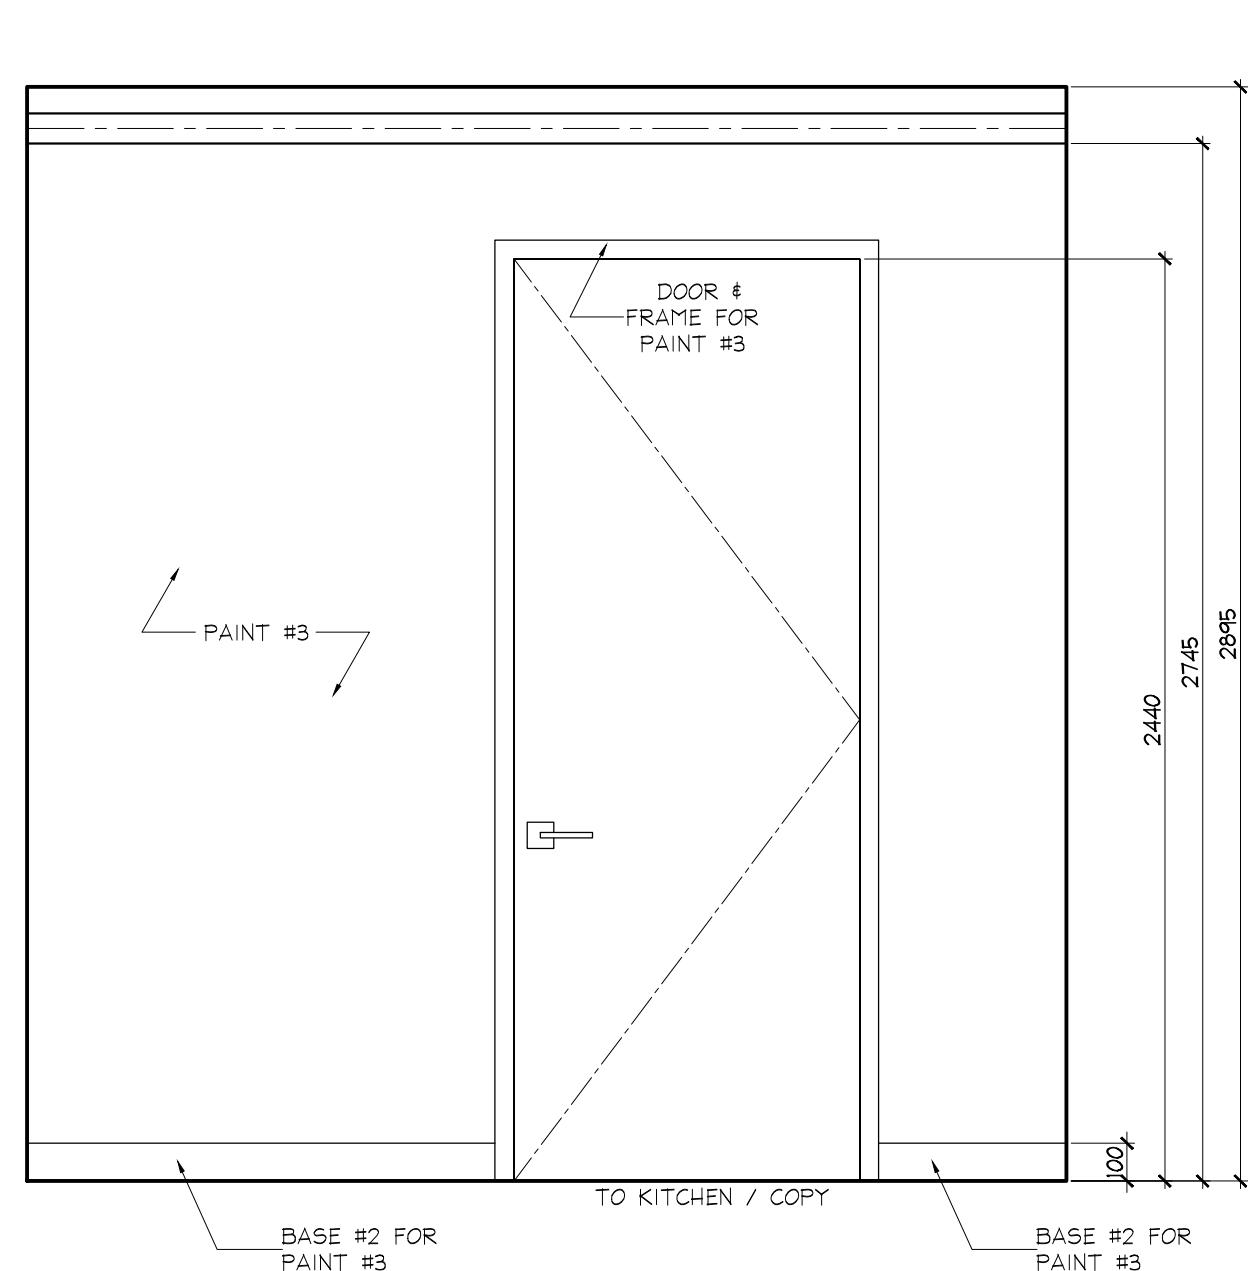


1 ELEVATION
GROUND FLOOR
PROPERTY MANAGEMENT OFFICE
SCALE 1:20

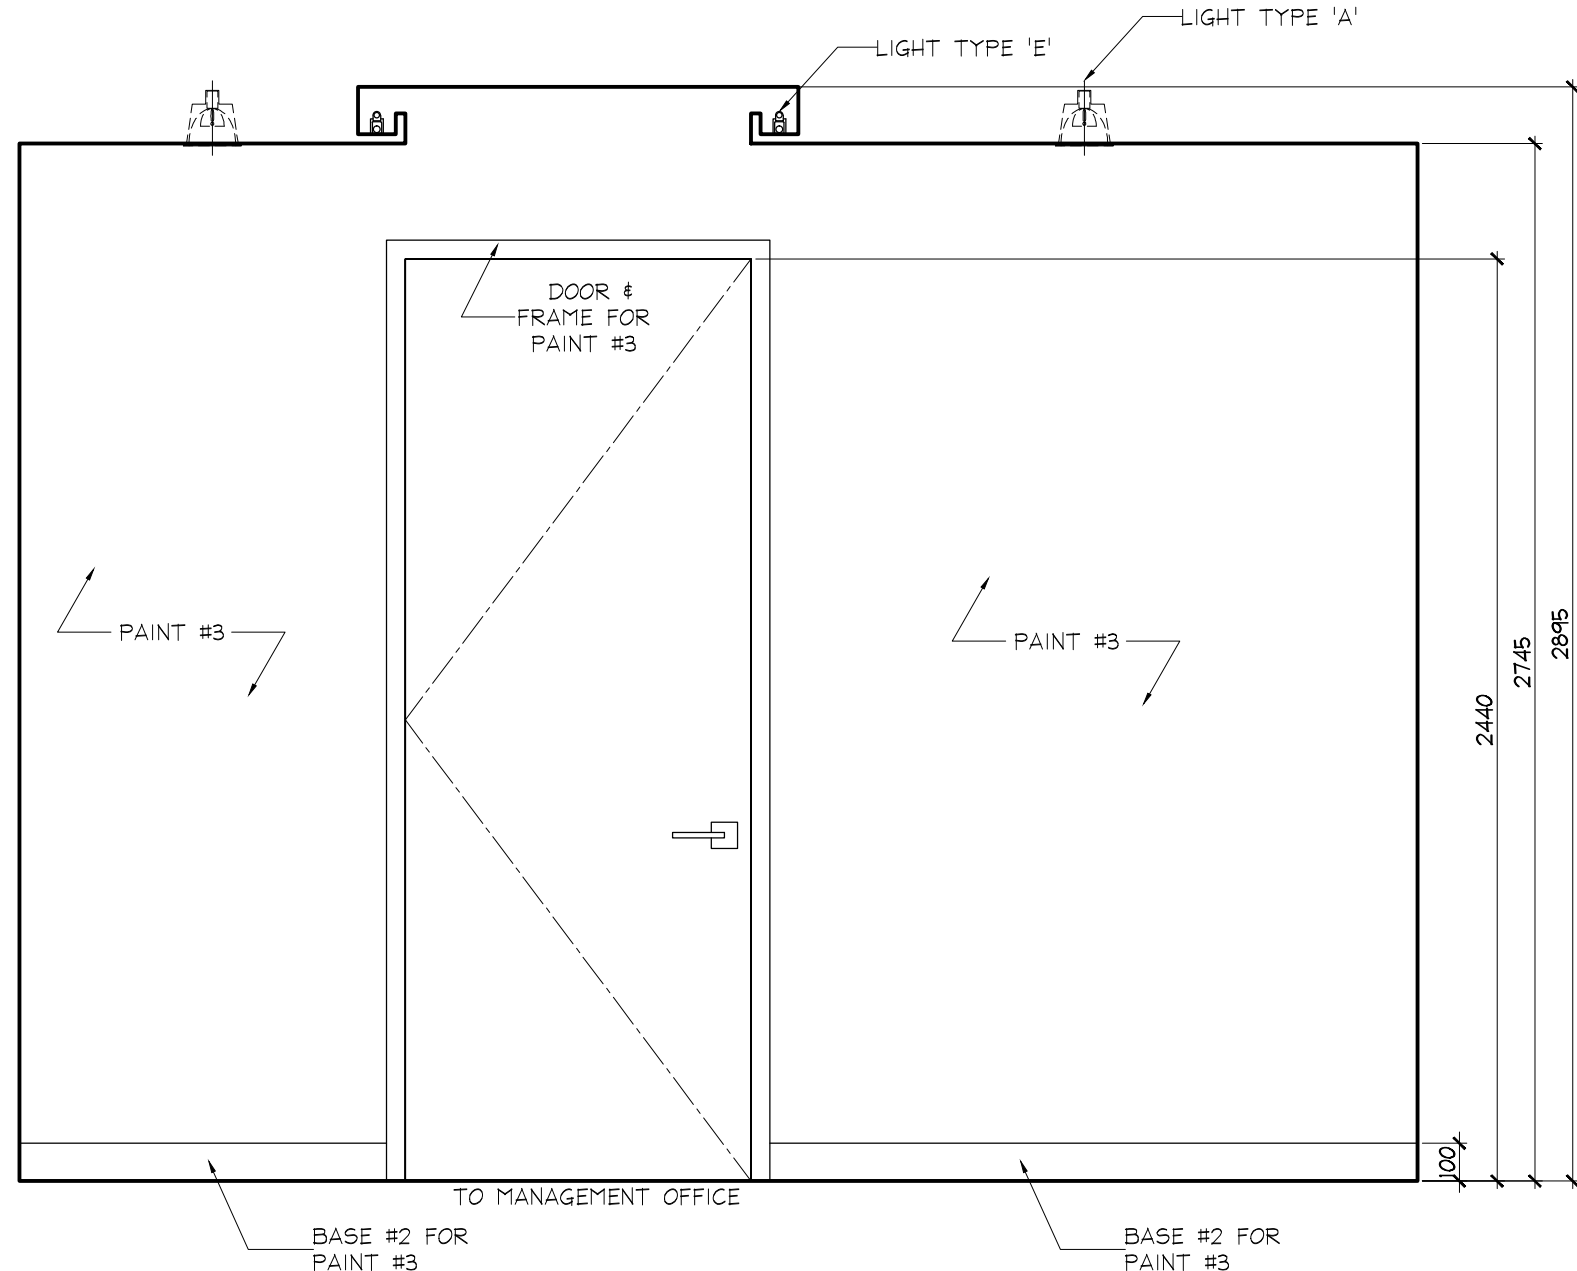


2 ELEVATION
GROUND FLOOR
PROPERTY MANAGEMENT OFFICE
SCALE 1:20

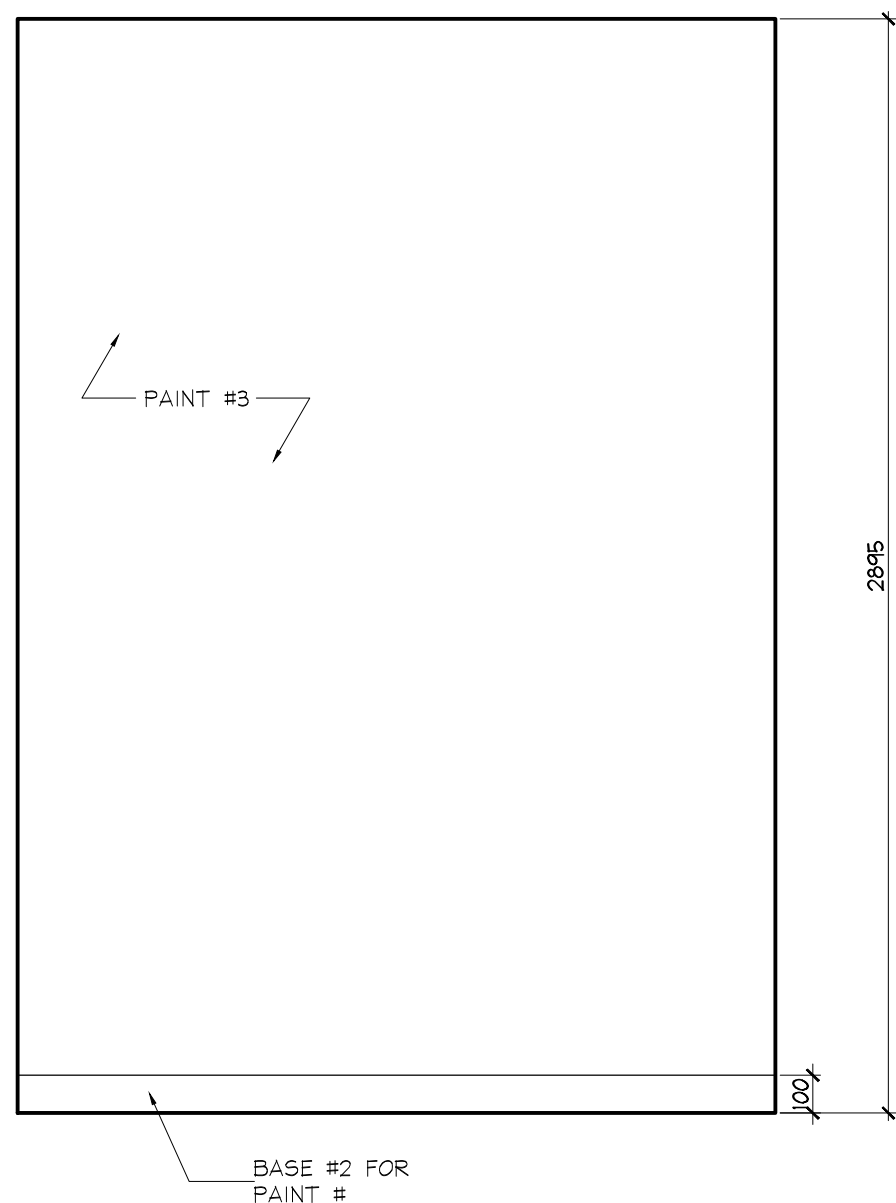


3 ELEVATION
GROUND FLOOR
MANAGEMENT OFFICE
SCALE 1:20

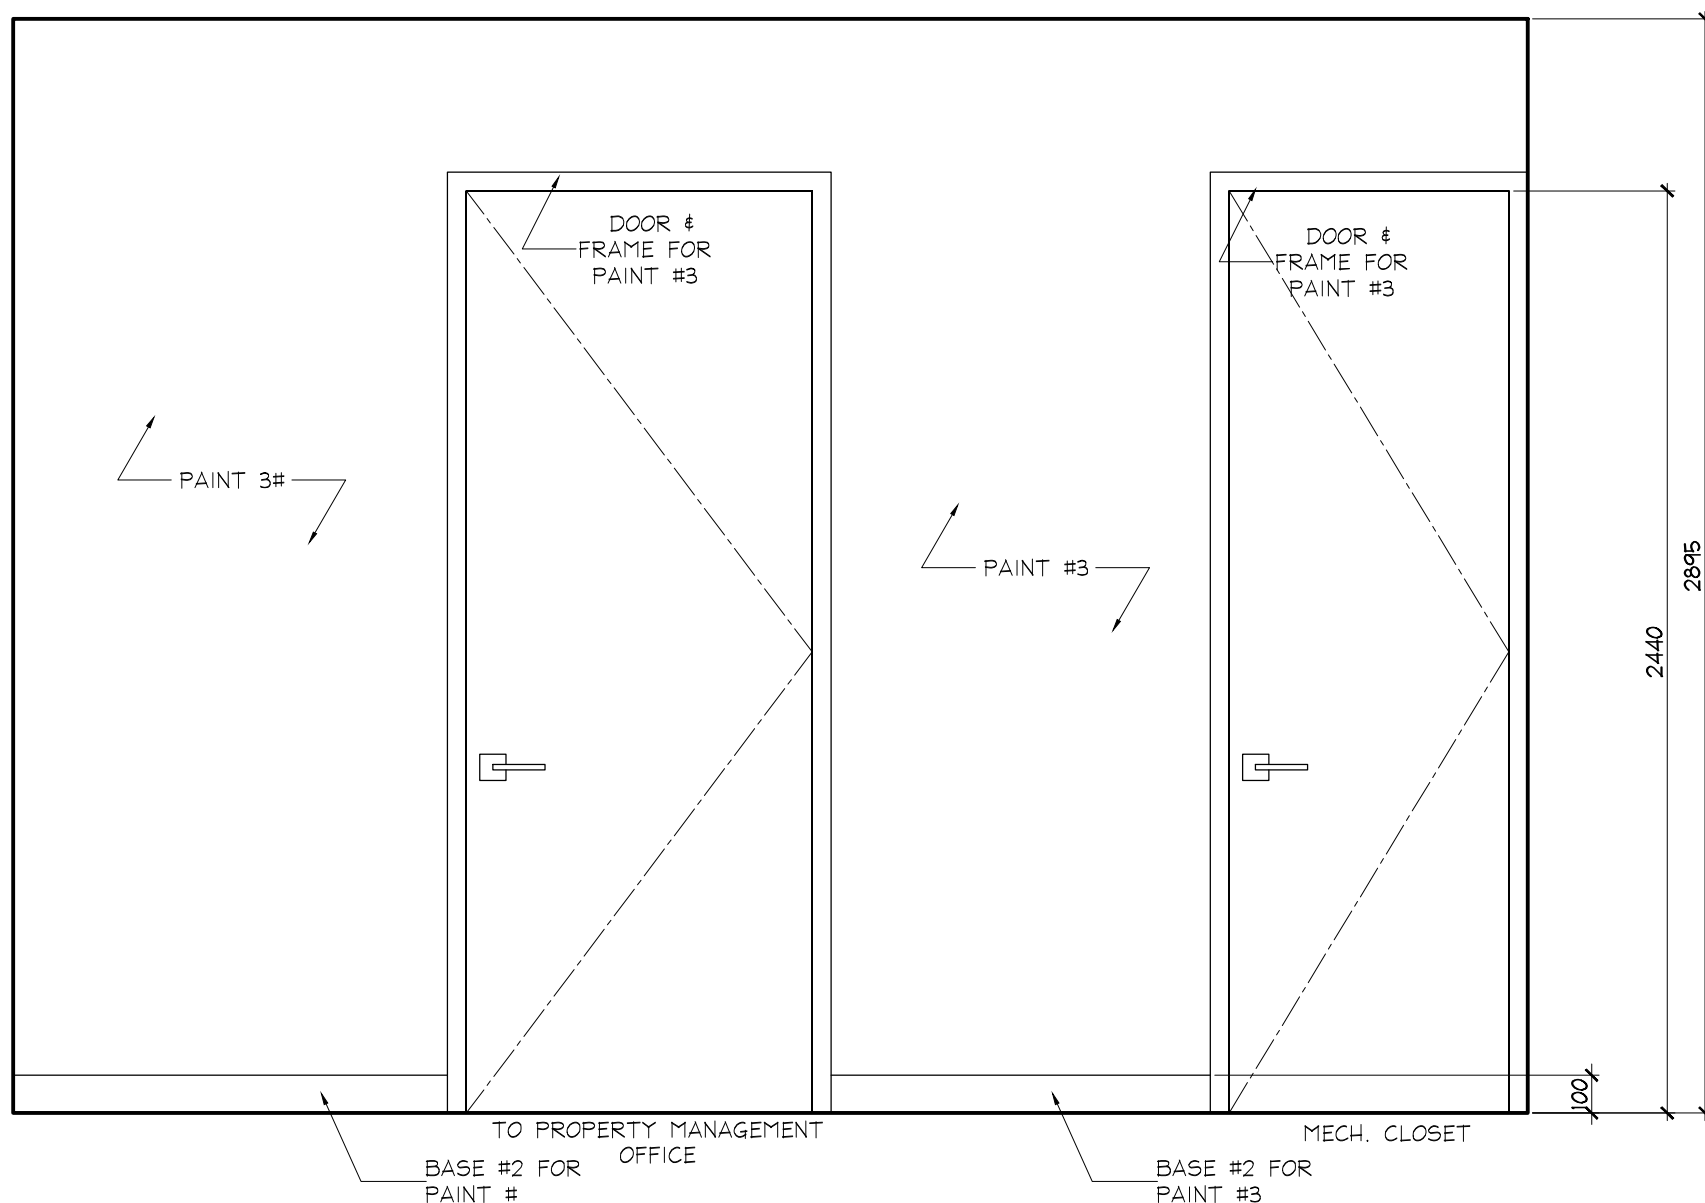


4 ELEVATION
GROUND FLOOR
MANAGEMENT OFFICE
SCALE 1:20

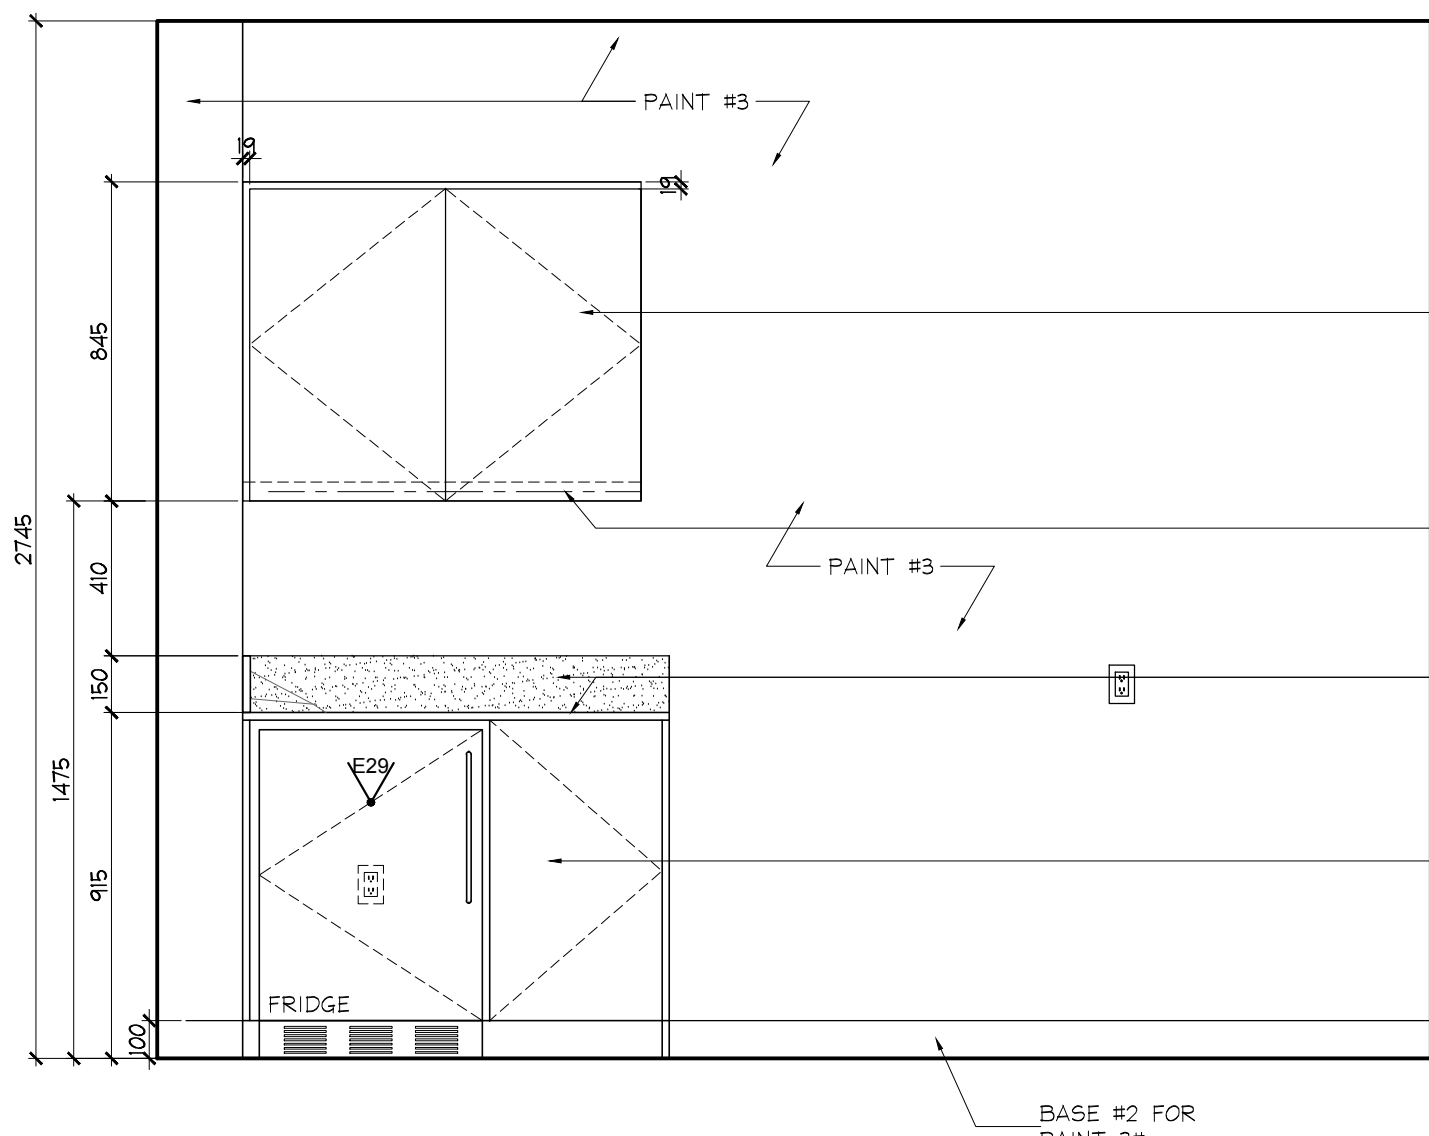


5 ELEVATION
GROUND FLOOR
MANAGEMENT KITCHEN
SCALE 1:20

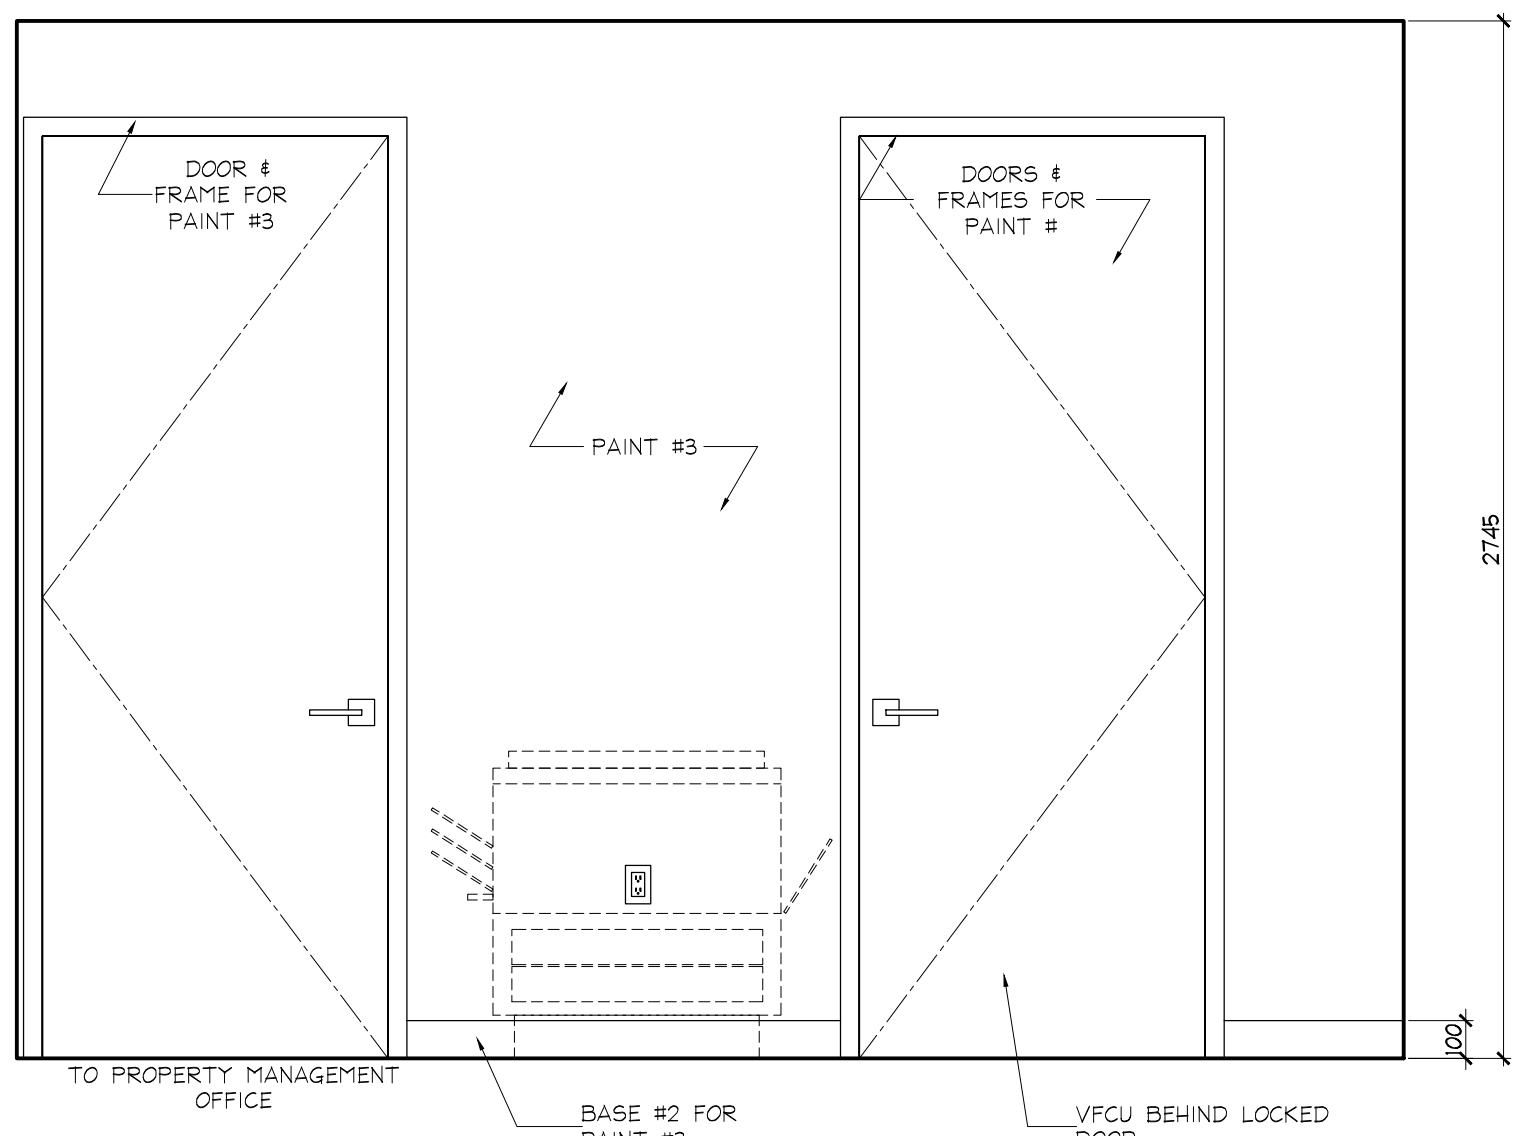

6 ELEVATION
GROUND FLOOR
MANAGEMENT KITCHEN
SCALE 1:20

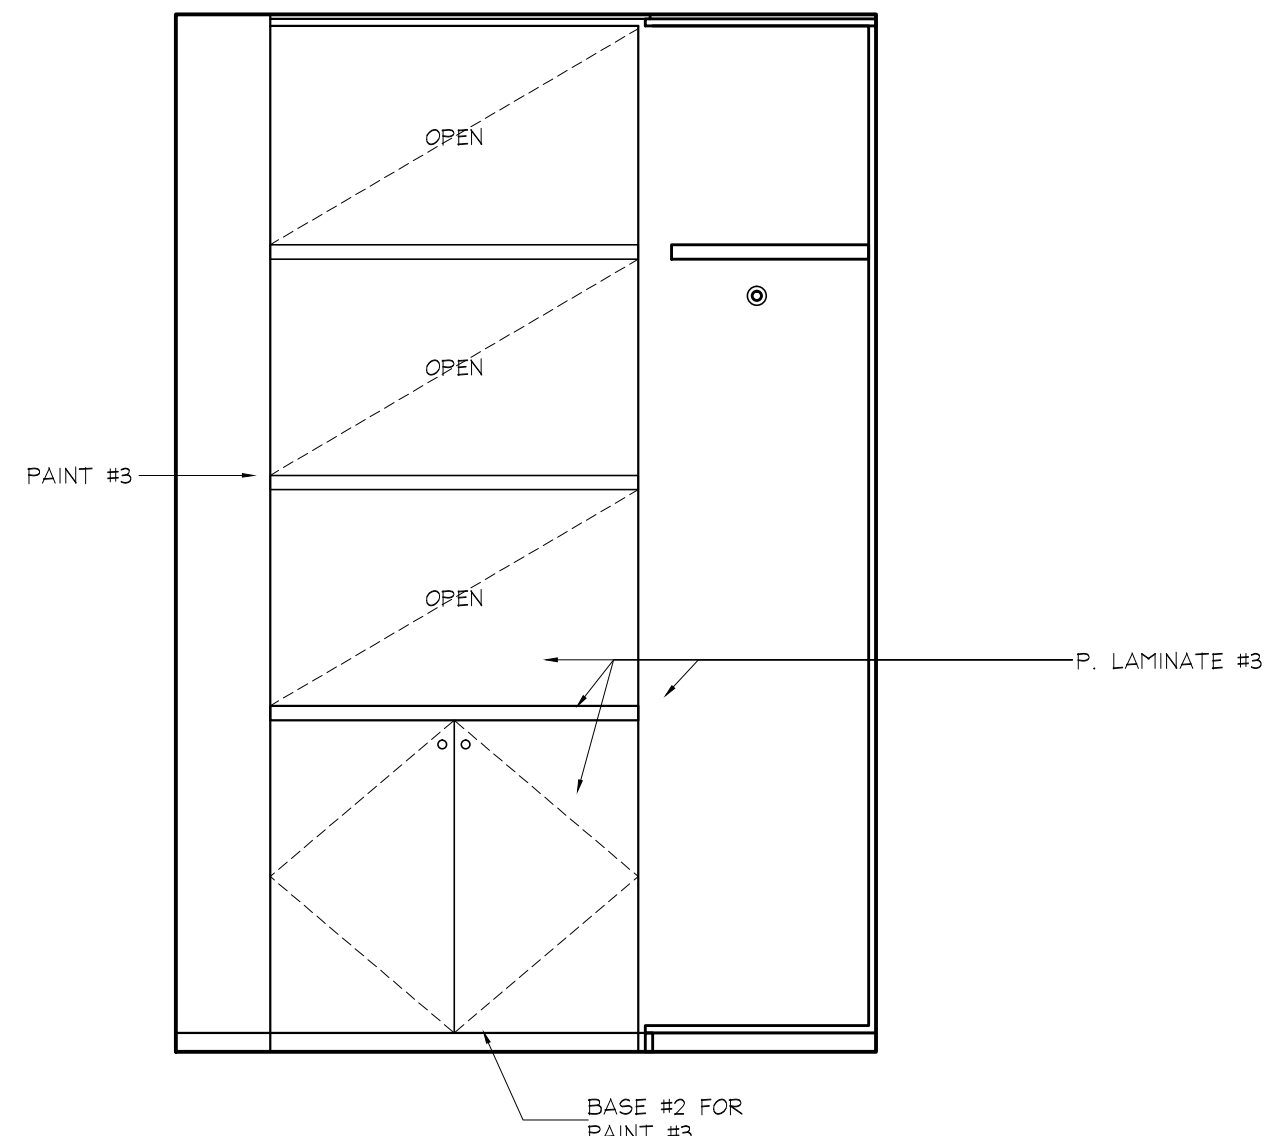


7 ELEVATION
GROUND FLOOR
PARCEL ROOM
SCALE 1:20

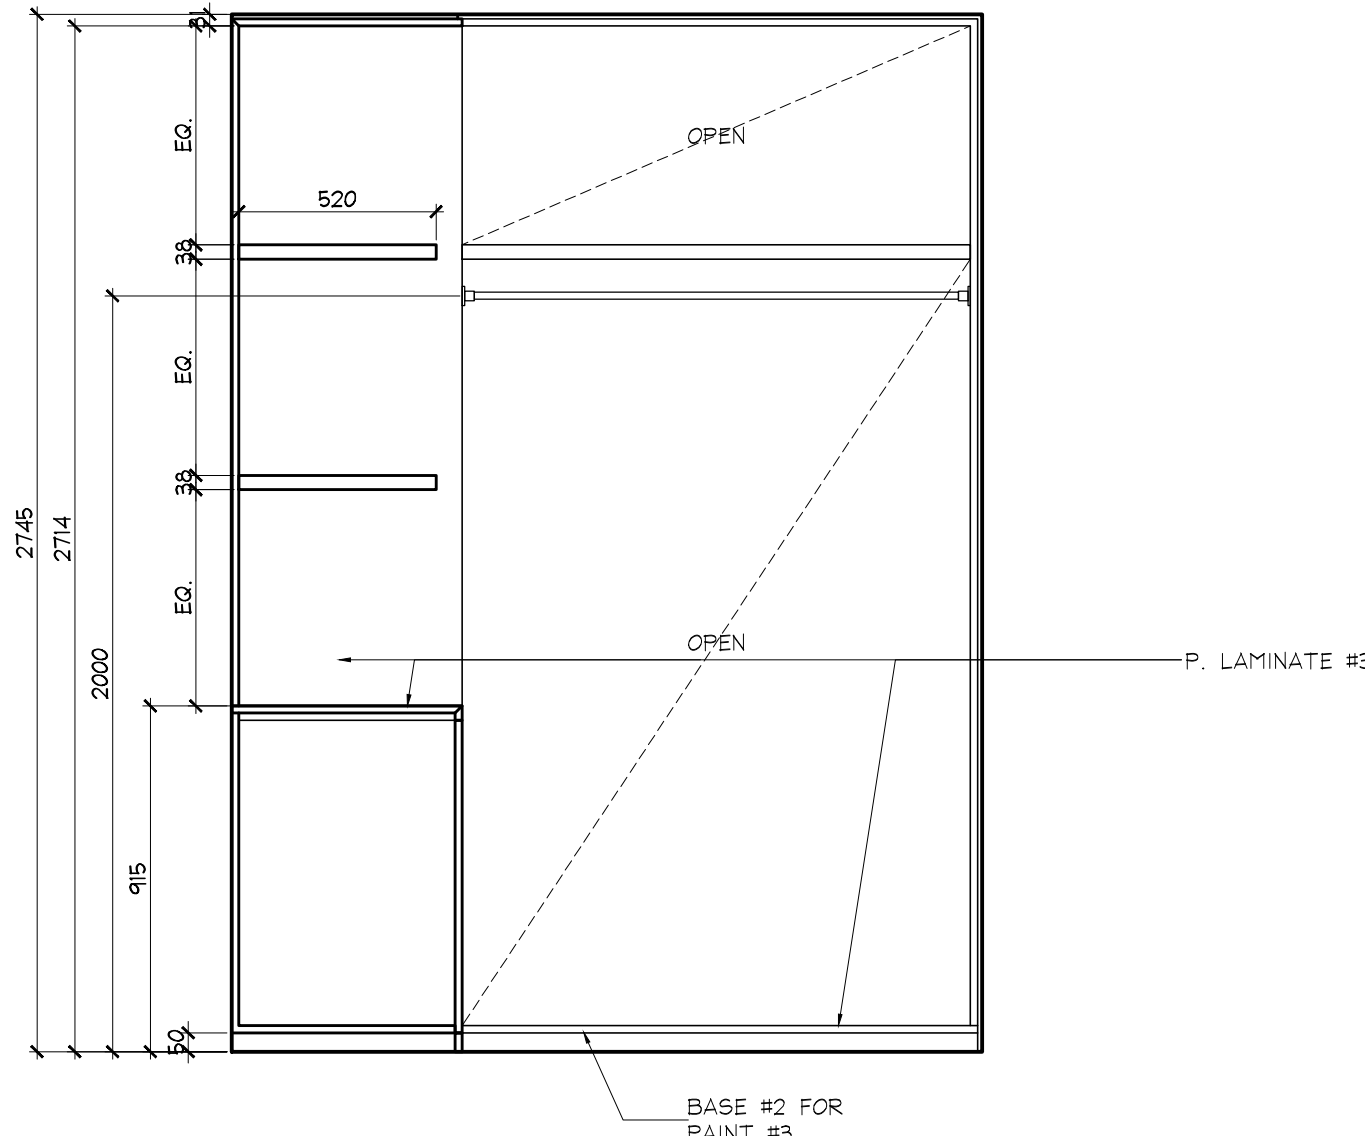


8 ELEVATION
GROUND FLOOR
PARCEL ROOM
SCALE 1:20


NOTE:
INSTALL ALL BARRIER FREE
HARDFOOT COMPONENTS
ACCORDING TO CBC
REQUIREMENTS

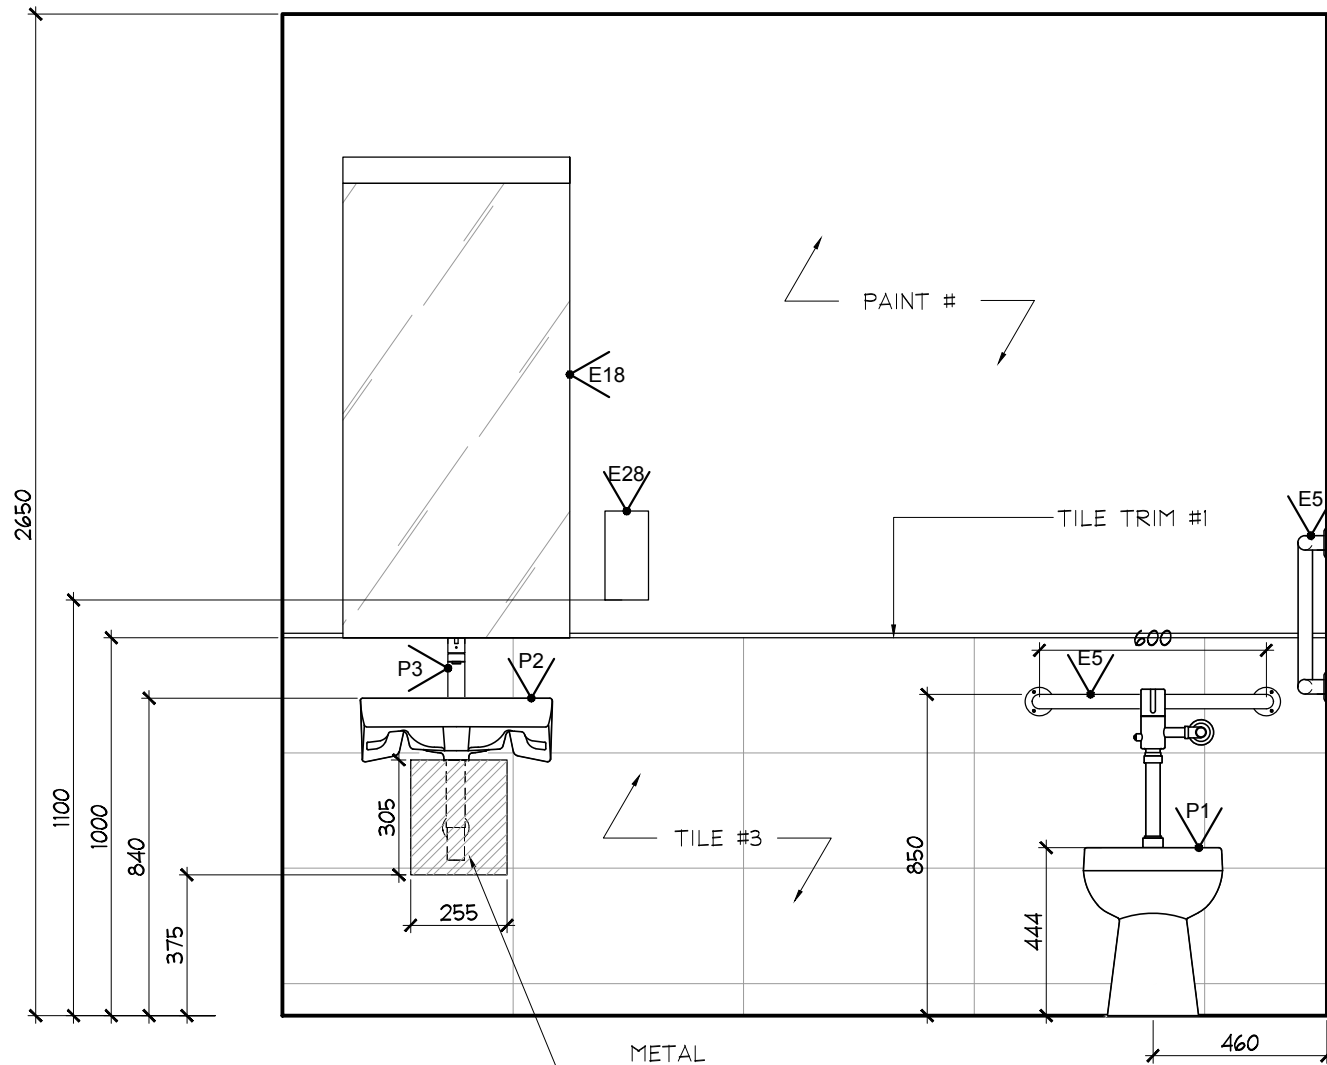


1 ELEVATION
ID2.2.0 9 TH FLOOR
AMENITY BATHROOM SCALE 1:20

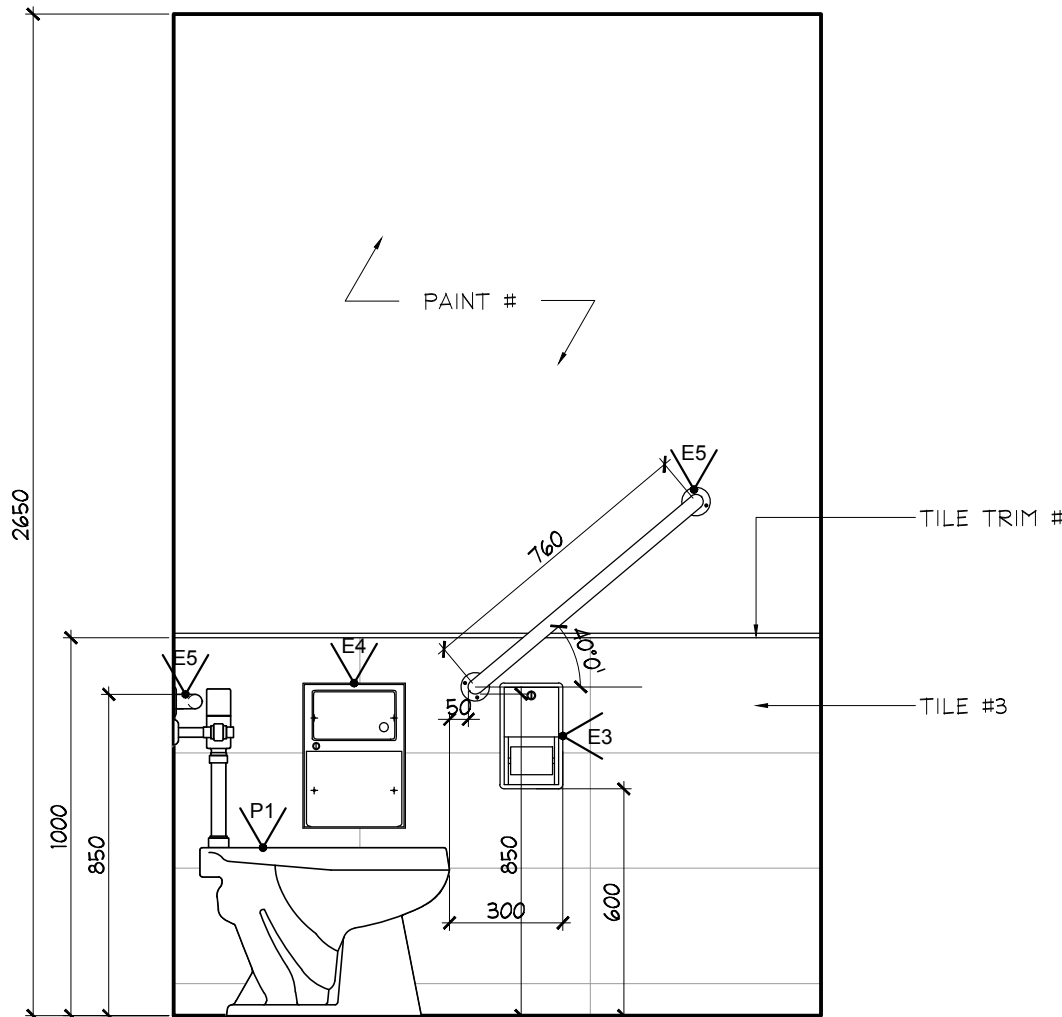

2 ELEVATION
ID2.2.0 9 TH FLOOR
AMENITY SCALE 1:20

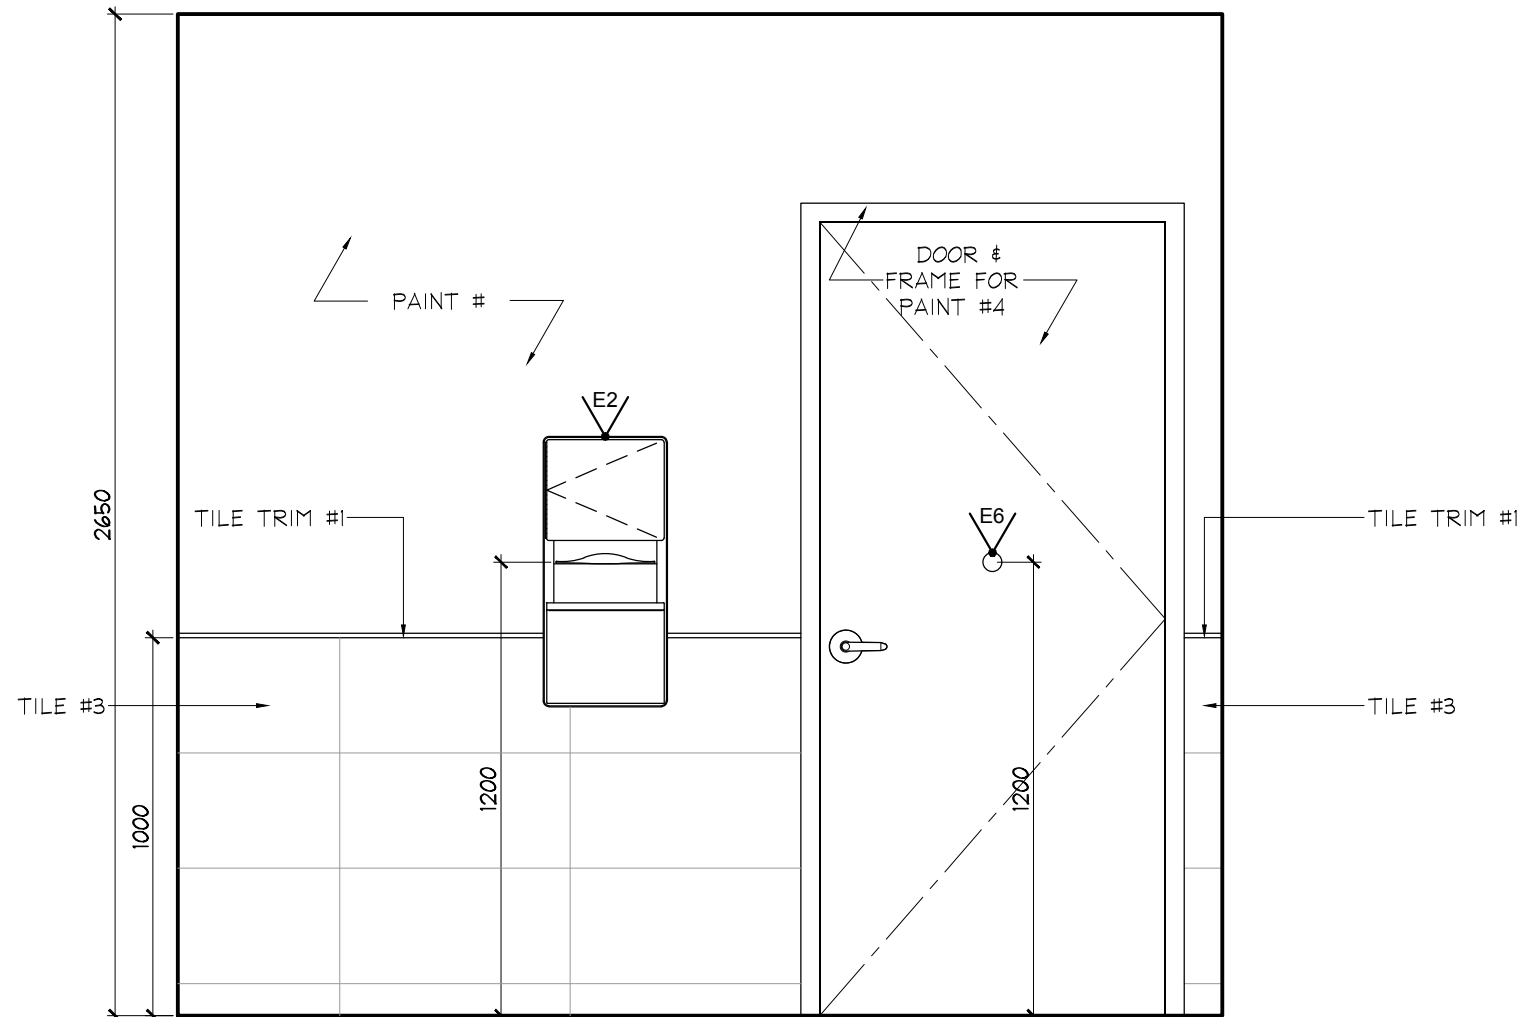

3 ELEVATION
ID2.2.0 9 TH FLOOR
AMENITY SCALE 1:20

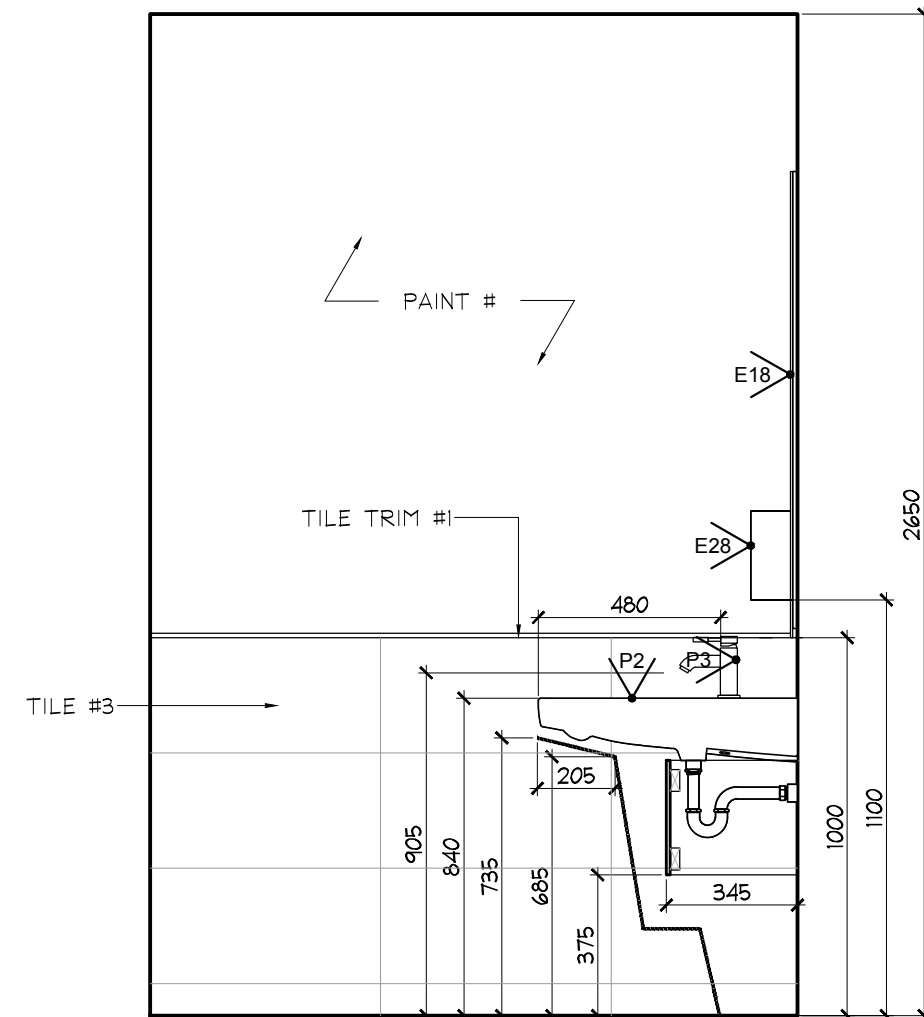

4 ELEVATION
ID2.2.0 9 TH FLOOR
AMENITY SCALE 1:20

DO NOT SCALE DRAWINGS.
CONTRACTOR MUST VERIFY ALL DRAWINGS, DIMENSIONS,
DETAILS AND SPECIFICATIONS AND REPORT ANY
DISCREPANCIES TO UNION 31 INC. BEFORE PROCEEDING
WITH WORK. MATERIALS MAY NOT BE SUBSTITUTED
WITHOUT WRITTEN APPROVAL FROM UNION 31 INC.
ALL DRAWINGS AND SPECIFICATIONS ARE INSTRUMENTS
OF SERVICE AND THE PROPERTY OF UNION 31 INC. WHICH
MUST BE RETURNED AT THE COMPLETION OF THE WORK.

PRINTED: 30-May-17

ISSUED FOR
AS-BUILT

01	31 MAY / 17	ISSUED FOR AS-BUILT	SV
NO.	DATE	COMMENTS	INI

REVISIONS:

UNION31

UNION31 INC.
183 BATHURST STREET, STE. 201
TORONTO, ON, M5T 2R7, CANADA
TEL: 416-597-1576 FAX: 416-597-2139

PROJECT NAME: ALEXANDRA PARK MAIN BUILDING BLOCK 11 ON, Canada	
PROJECT NO.: 13-949	
DRAWINGS: 9 TH FLOOR ELEVATIONS	
DATE STARTED: 07 AUG / 13	DRAWING NO.: ID
SCALE: 1 : 20	
DRAWN BY: AP	2.2.0
APPROVED BY: KC	


DO NOT SCALE DRAWINGS.

CONTRACTOR MUST VERIFY ALL DRAWINGS, DIMENSIONS, DETAILS AND SPECIFICATIONS AND REPORT ANY DISCREPANCIES TO UNION 31 INC. BEFORE PROCEEDING WITH WORK. MATERIALS MAY NOT BE SUBSTITUTED WITHOUT WRITTEN APPROVAL FROM UNION 31 INC.


ALL DRAWINGS AND SPECIFICATIONS ARE INSTRUMENTS OF SERVICE AND THE PROPERTY OF UNION 31 INC. WHICH MUST BE RETURNED AT THE COMPLETION OF THE WORK.

PRINTED: 30-May-17


ISSUED FOR
AS-BUILT

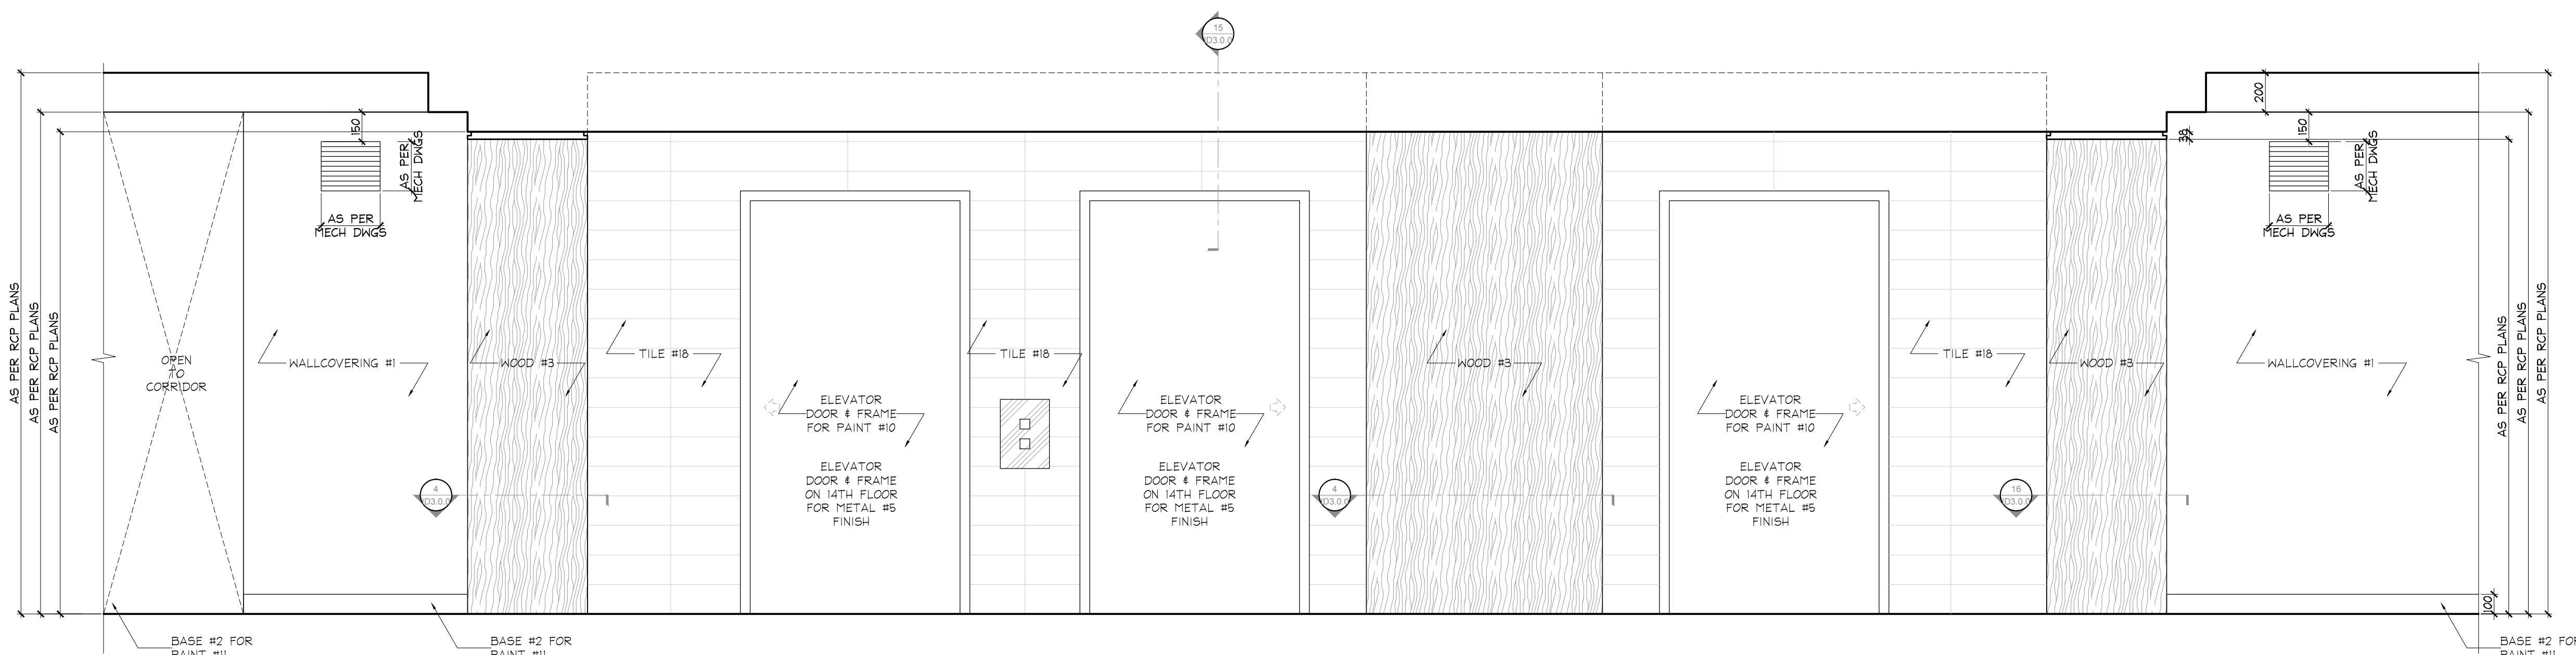

1 ELEVATION
ID2.3.0 TYPICAL CORRIDOR
ELEVATOR LOBBY SCALE 1:20

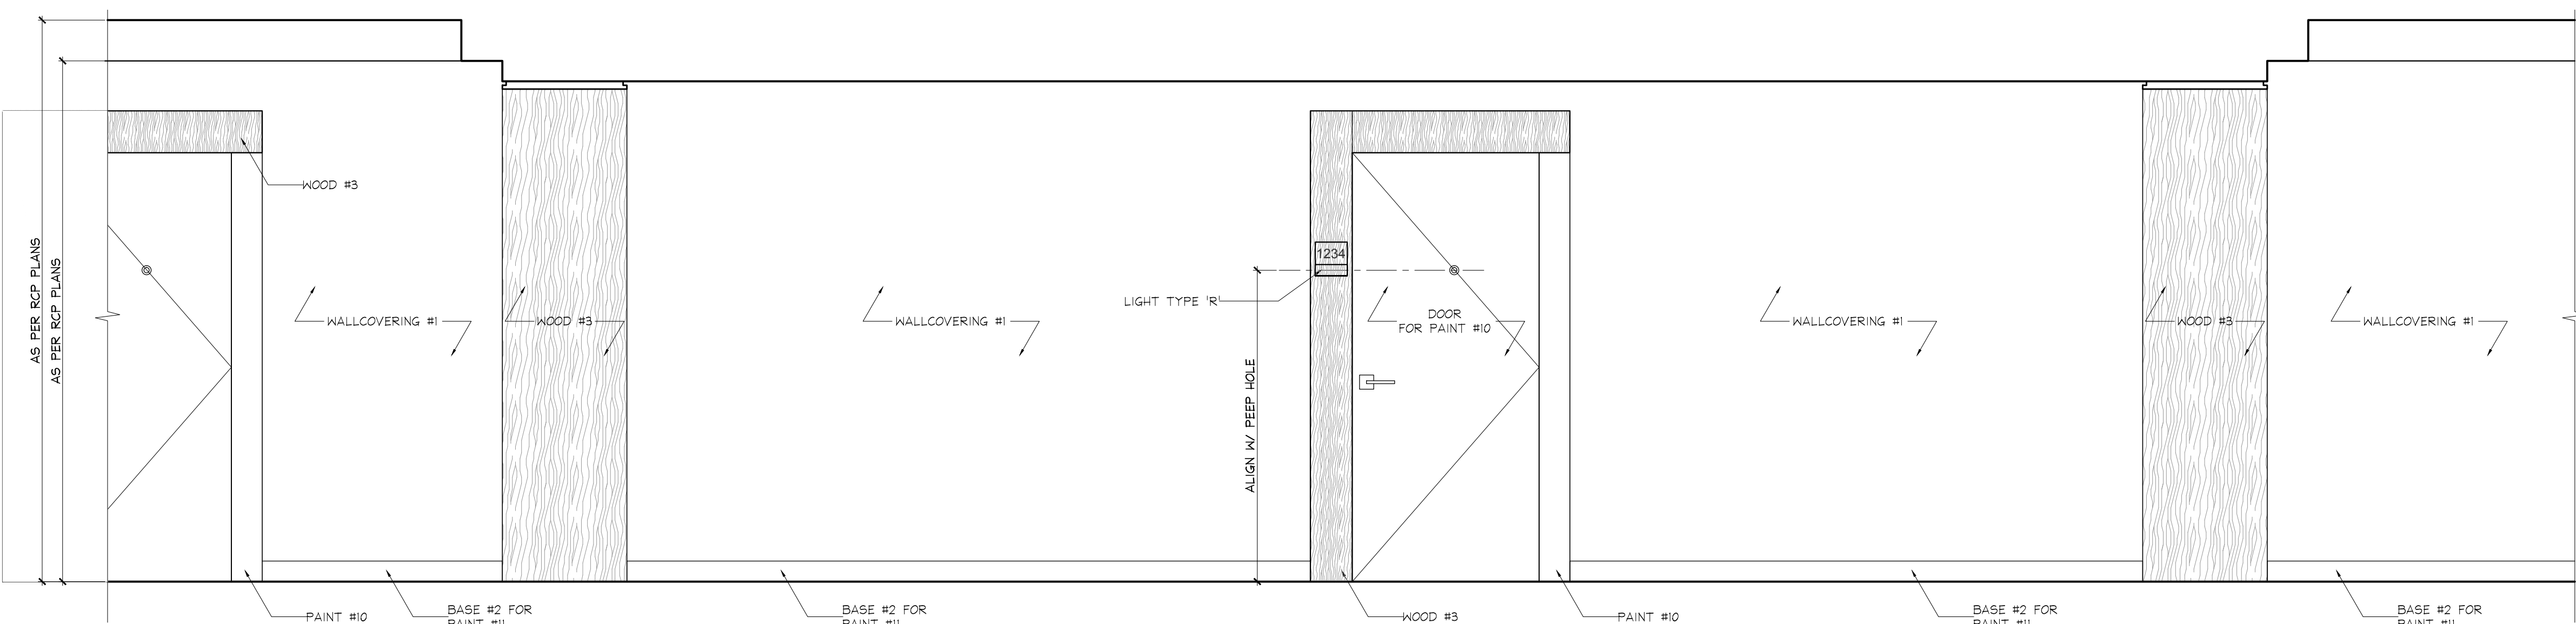

2 ELEVATION
ID2.3.0 TYPICAL CORRIDOR
ELEVATOR LOBBY SCALE 1:20

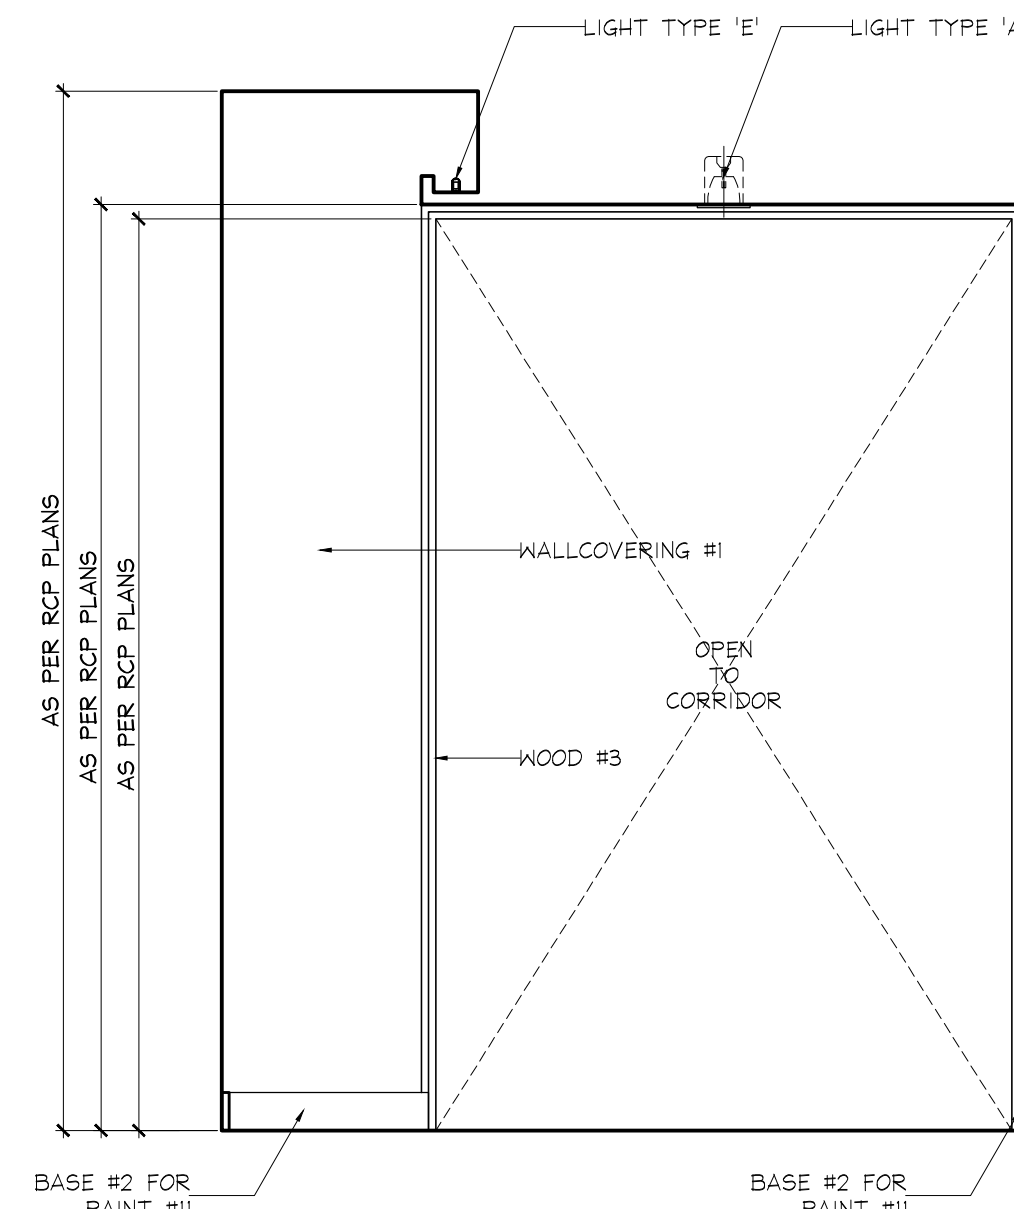


3 ELEVATION
ID2.3.0 TYPICAL CORRIDOR
ELEVATOR LOBBY SCALE 1:20

01	31 MAY / 17	ISSUED FOR AS-BUILT	SV
NO.	DATE	COMMENTS	INI
REVISIONS:			


UNION31

UNION31 INC.
183 BATHURST STREET, STE. 201
TORONTO, ON, M5T 2R7, CANADA
TEL: 416-597-1576 FAX: 416-597-2139


PROJECT NAME:		ALEXANDRA PARK MAIN BUILDING	
PROJECT NO.:		13-949	
DRAWINGS:		TYPICAL ELEVATIONS	
DATE STARTED:	07 AUG / 13	DRAWING NO.:	ID
SCALE:	1 : 20		2.3.0
DRAWN BY:	AP		
APPROVED BY:	KC		

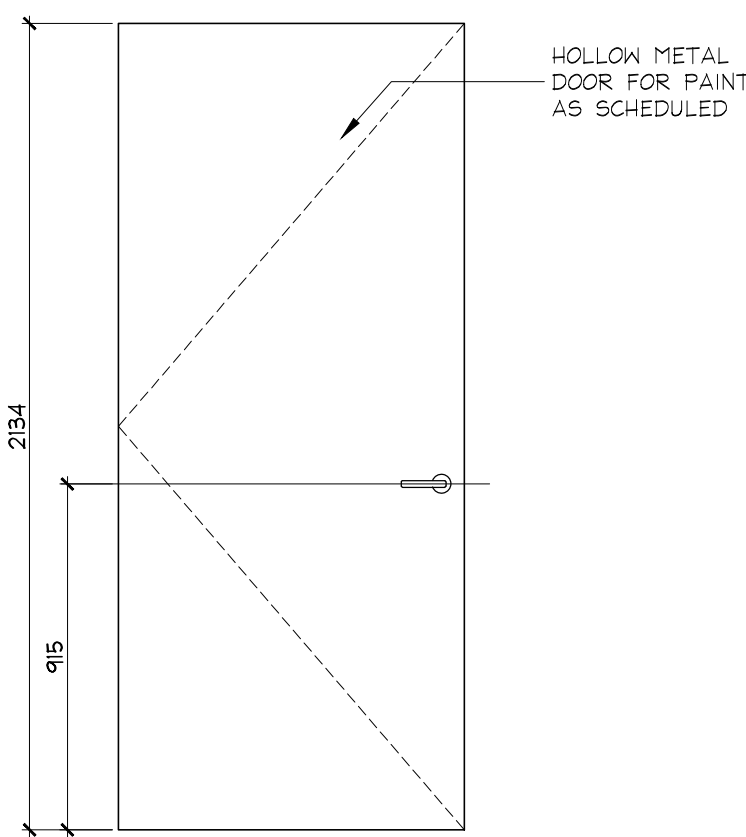


TYPICAL
TYPE "TYP.1"
LOCKER DOORS

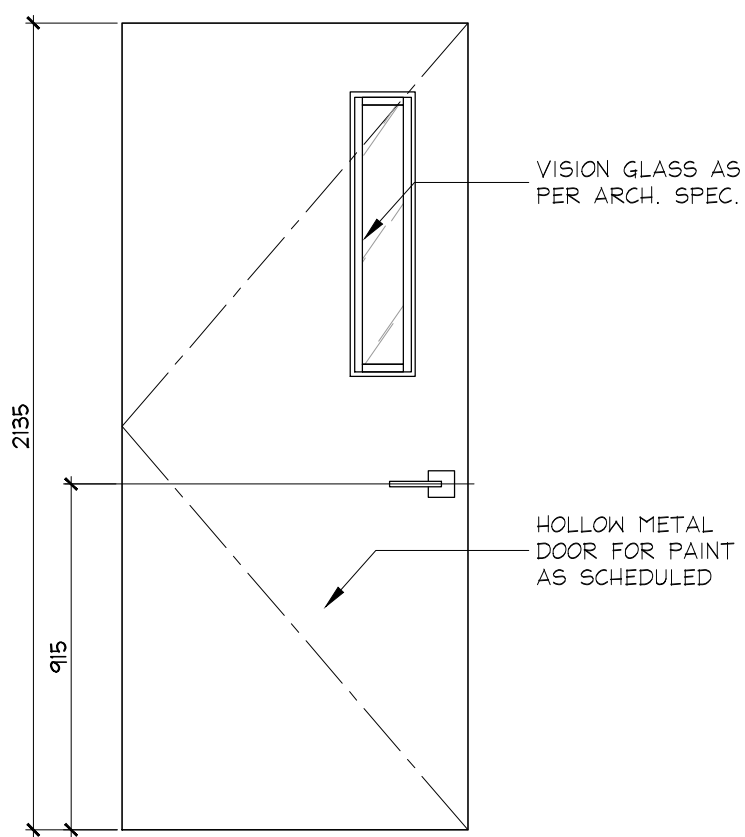


TYP. EXIT STAIR
DOORS "TYP.2"

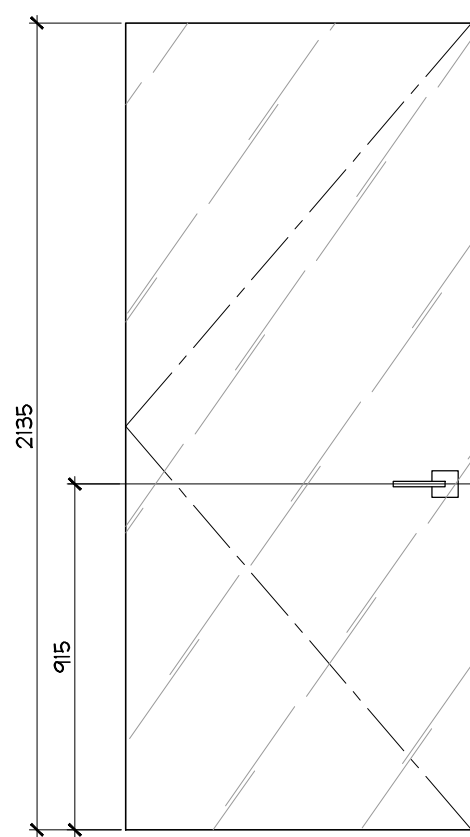


PARKING LEVEL 2
DOORS P201.1, P201.X, P201.3

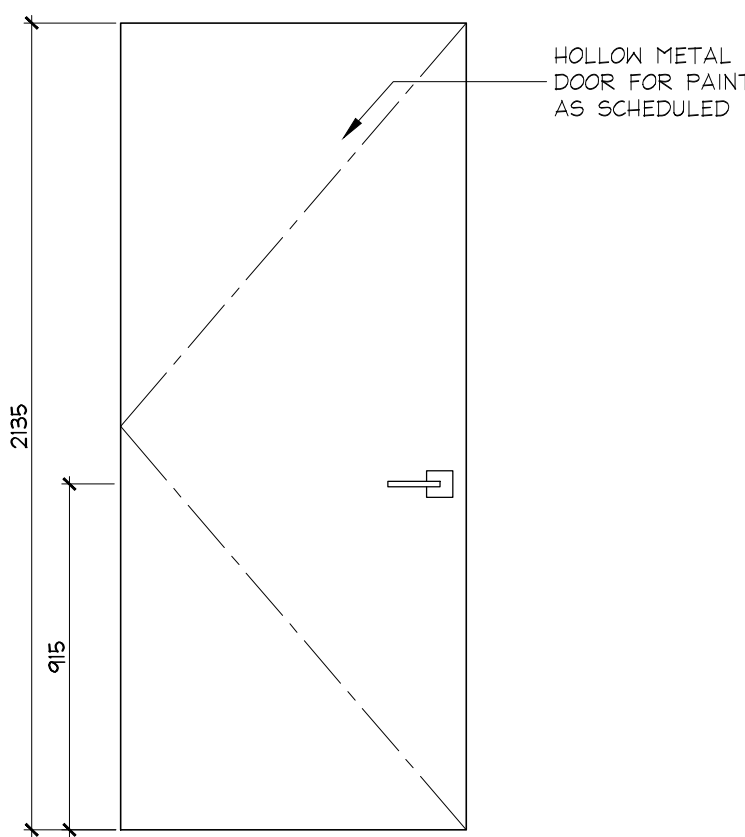


PARKING LEVEL 2
DOOR P201.2

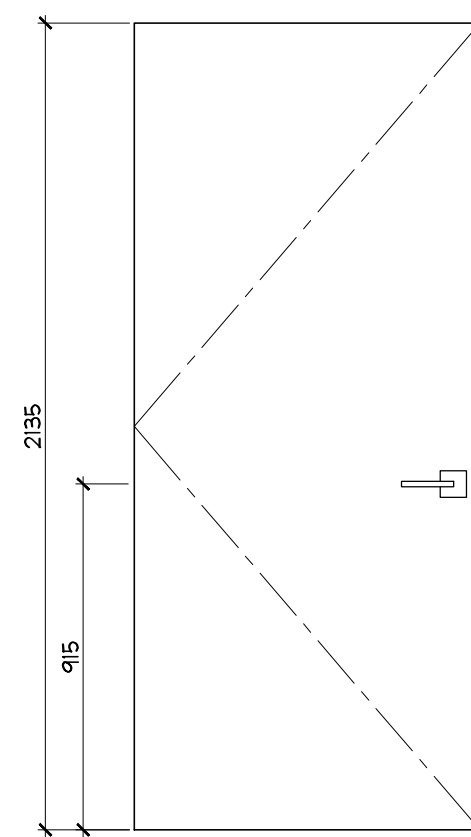


PARKING LEVEL 1
DOORS P110.1, P101

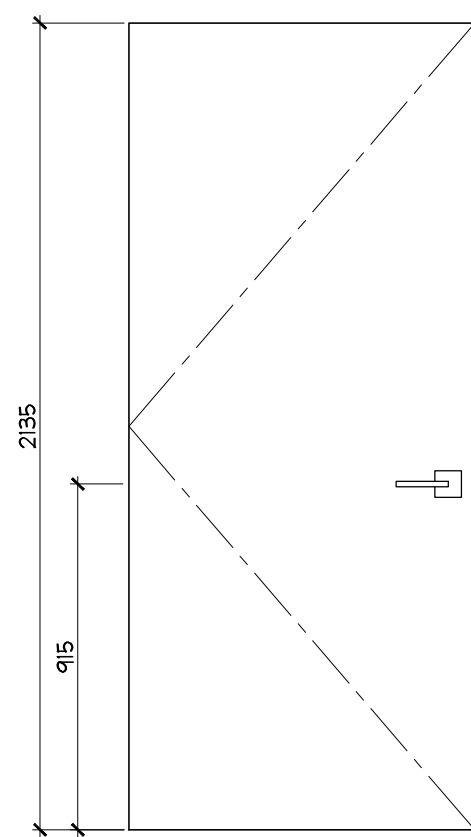


PARKING LEVEL 1
DOORS P110.1, P130

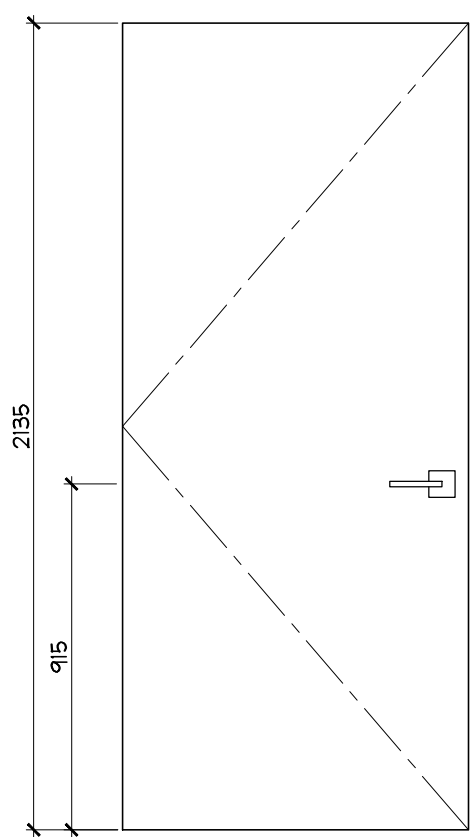


PARKING LEVEL 1
DOOR P117

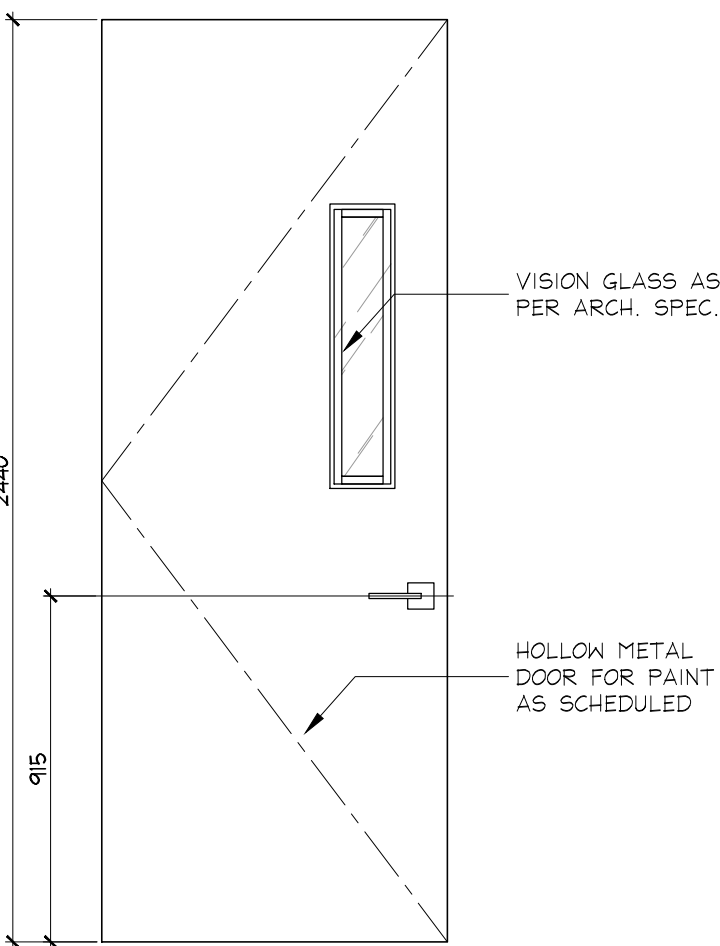


GROUND FLOOR
DOOR 145.2

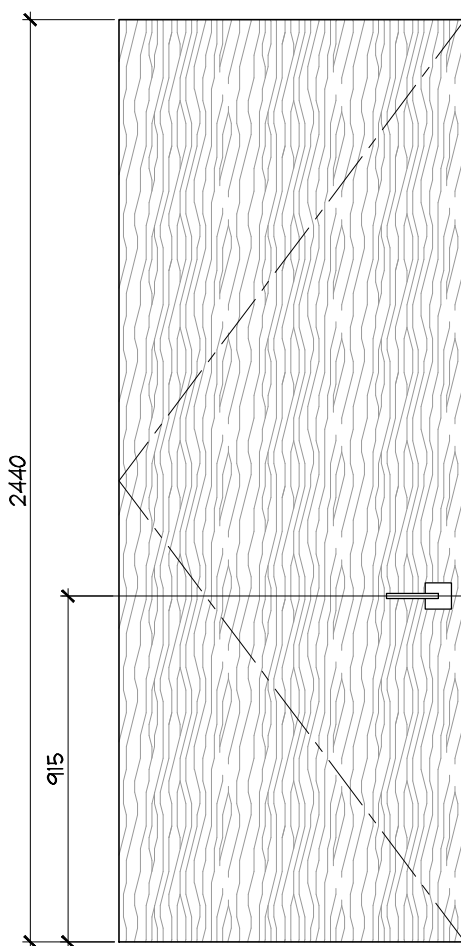


GROUND FLOOR
DOOR 138
MAIL SORTING

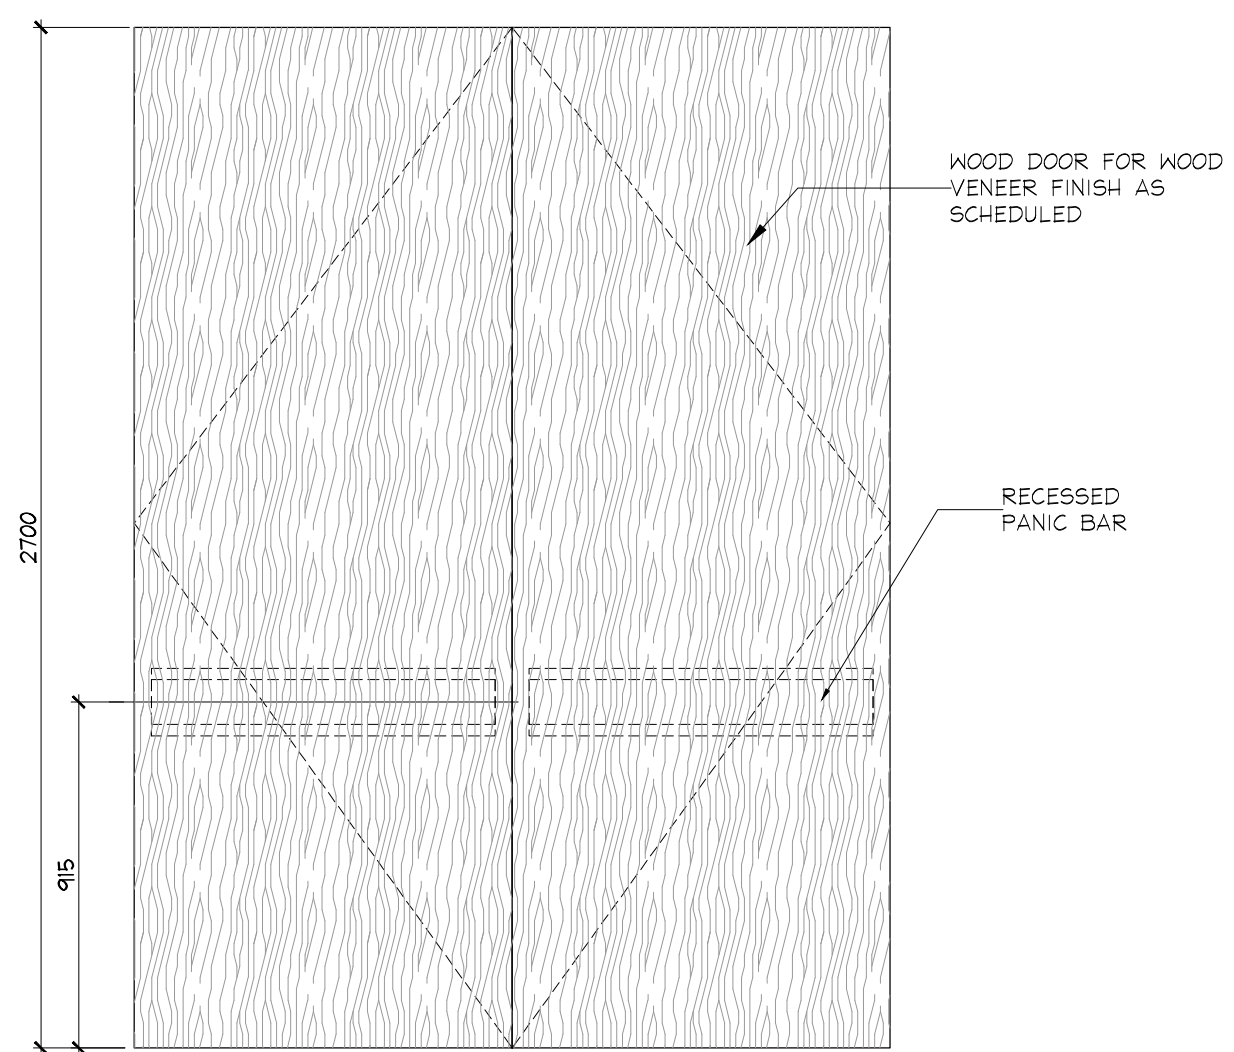


GROUND FLOOR
DOOR 140
ELEVATOR LOBBY

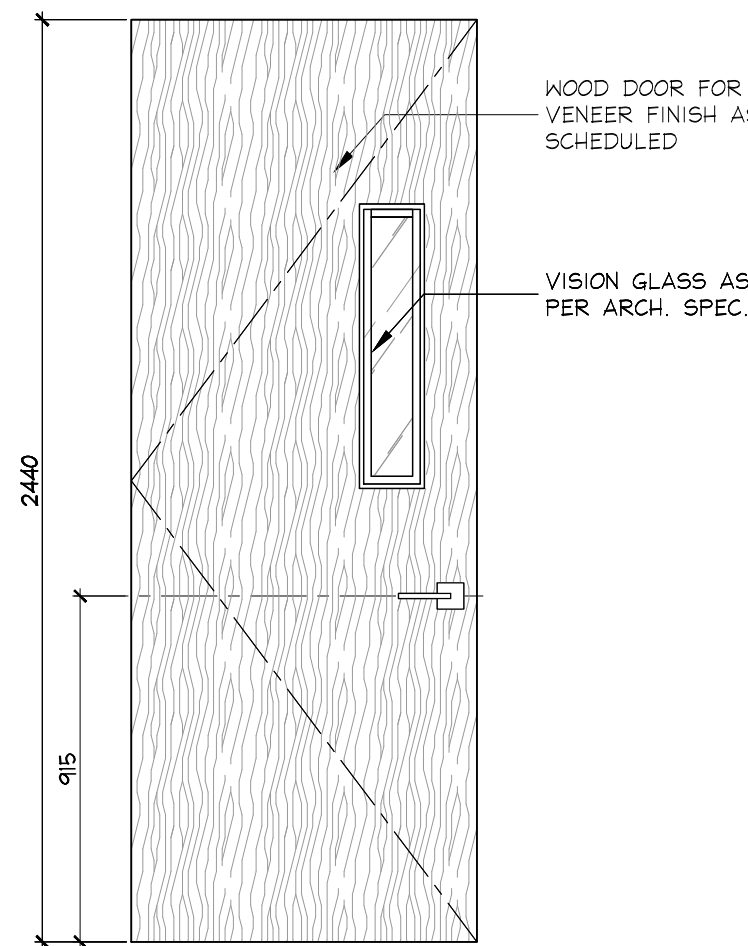


GROUND FLOOR
DOOR 140.2
CORRIDOR B TO LOBBY

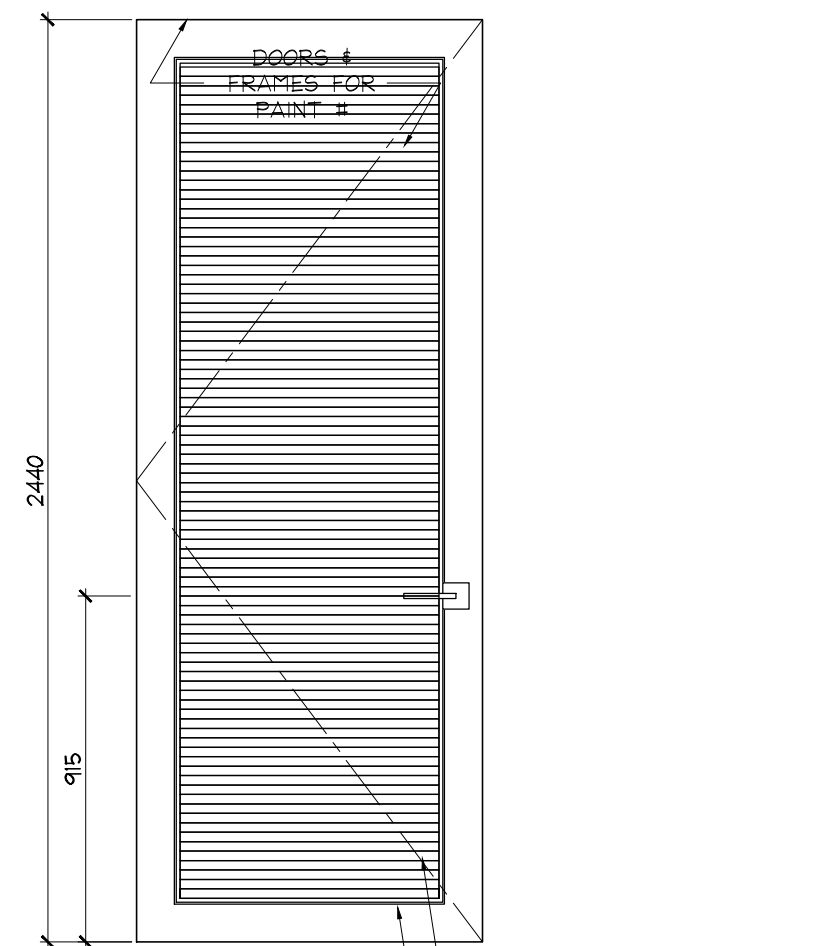


GROUND FLOOR
DOORS 143A
VFCU ACCESS DOOR

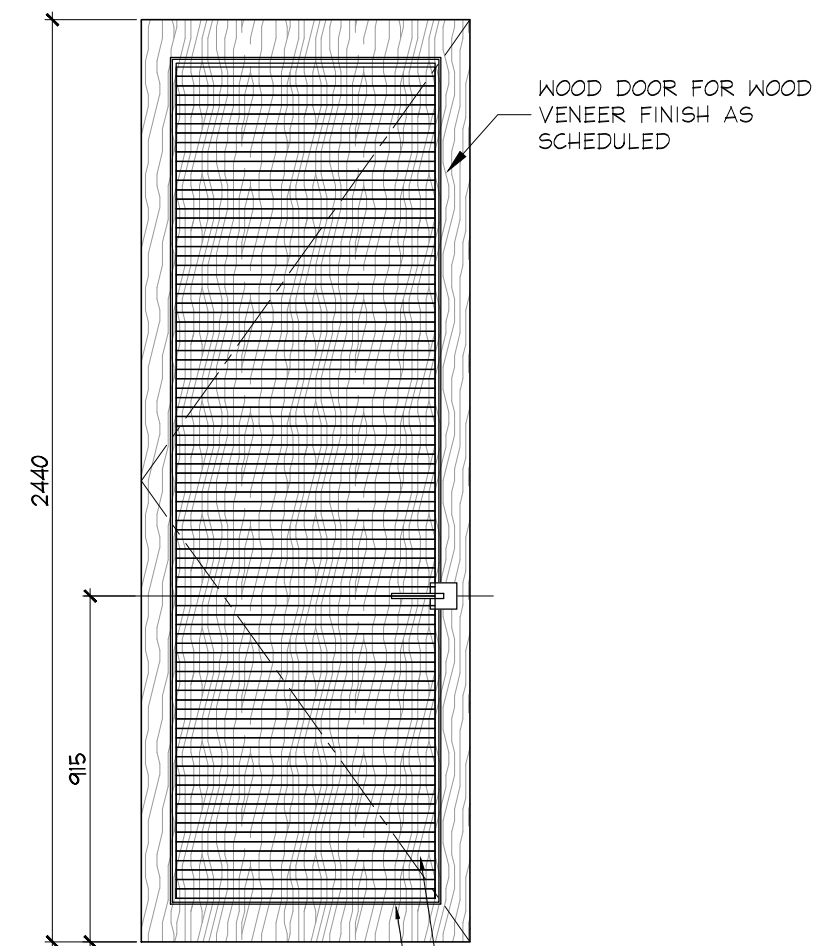


GROUND FLOOR
DOORS 143B, 143C
VFCU ACCESS DOOR

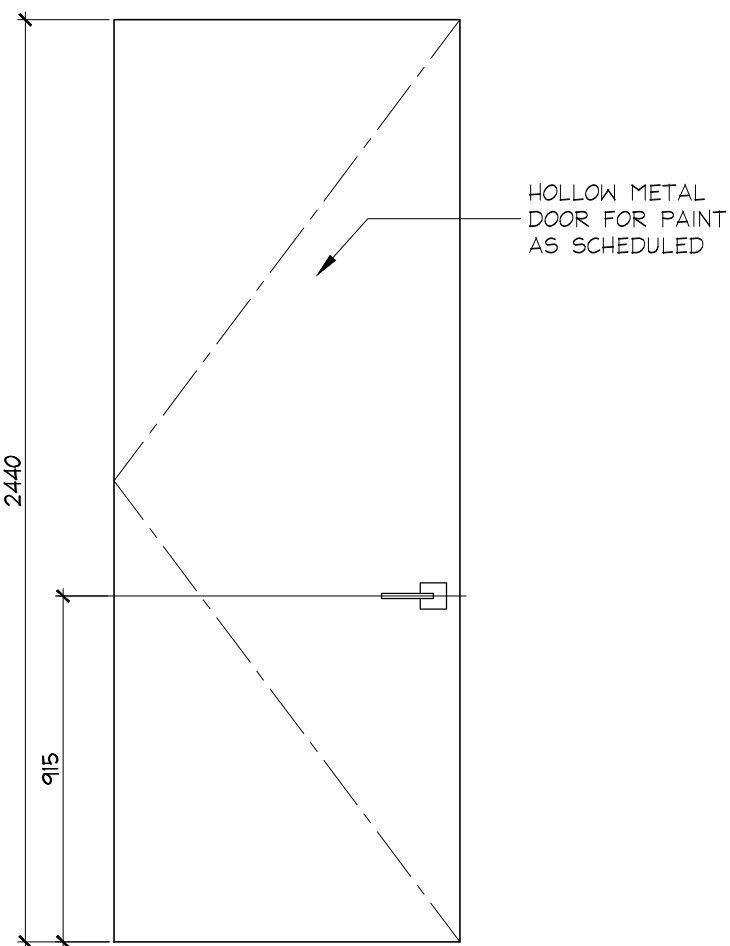


GROUND FLOOR
DOOR 144

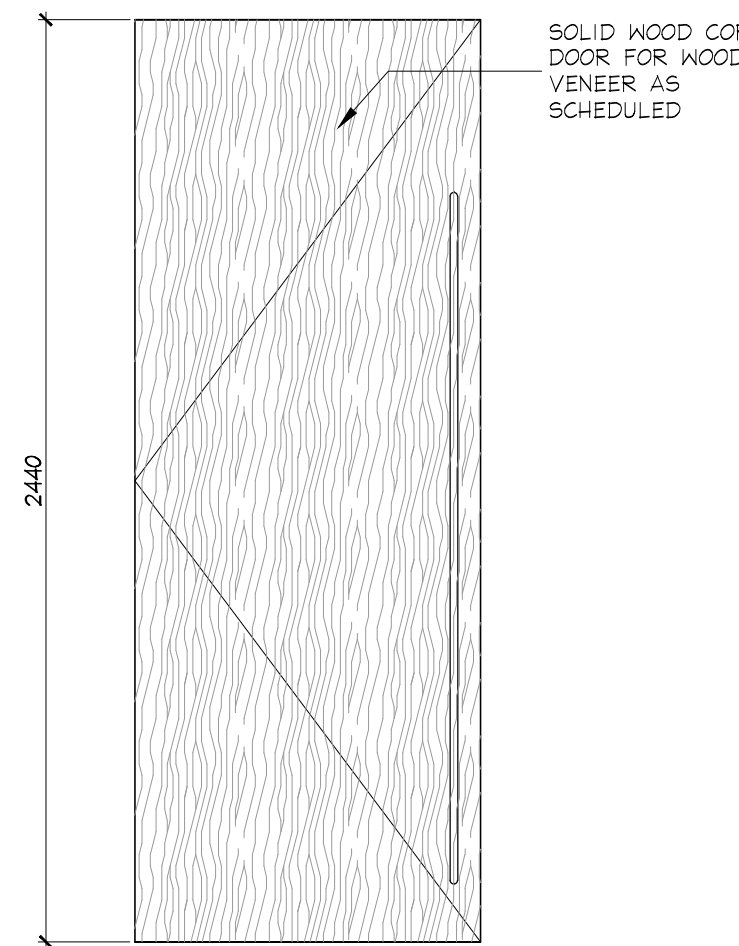


GROUND FLOOR
DOORS 146A, 146B, 151A, 151B, 148, 153
MEN'S / WOMEN'S CHANGEROOM VESTIBULE
AMENITY KITCHENETTE

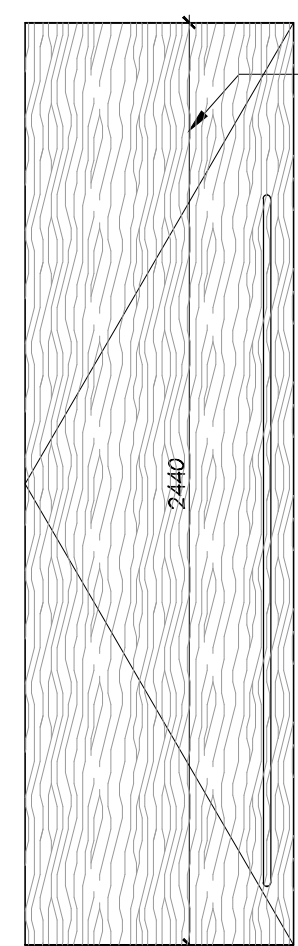


GROUND FLOOR
DOORS 147, 152
MEN'S / WOMEN'S WC

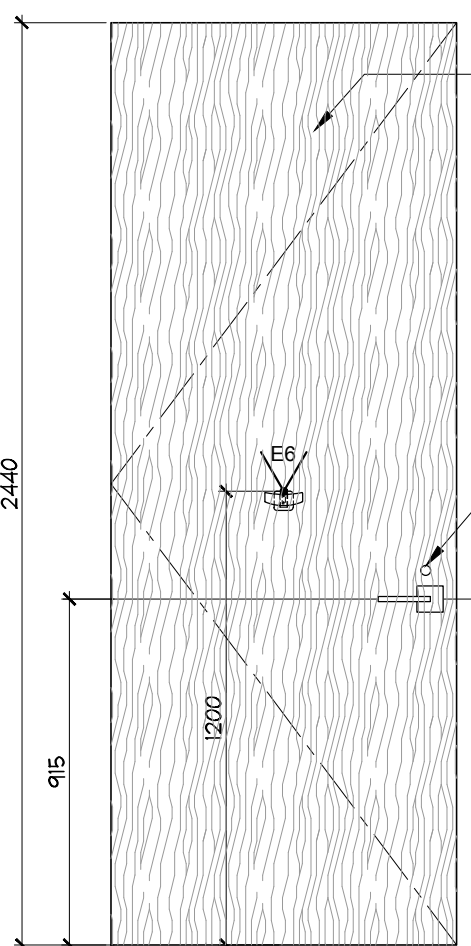


GROUND FLOOR
DOORS 148, 153
(INTERIOR)
MEN'S / WOMEN'S WC BF

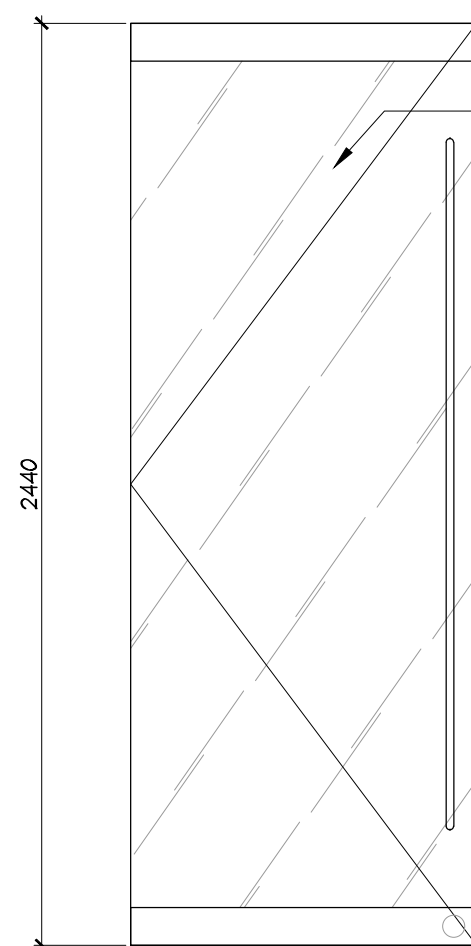


GROUND FLOOR
DOORS 149.1, 149.2
MEN'S / WOMEN'S CHANGEROOM TO
WHIRLPOOL SPA

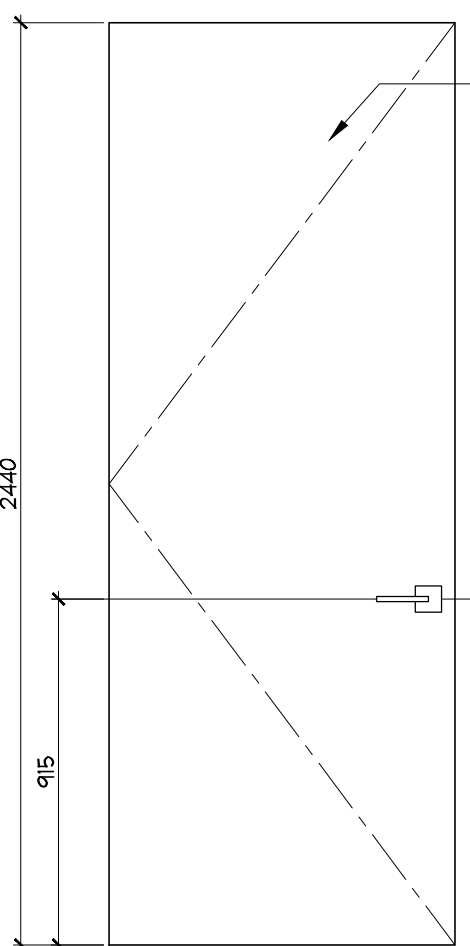


GROUND FLOOR
DOOR 150
JANITOR CLOSET IN WOMEN'S
CHANGEROOM

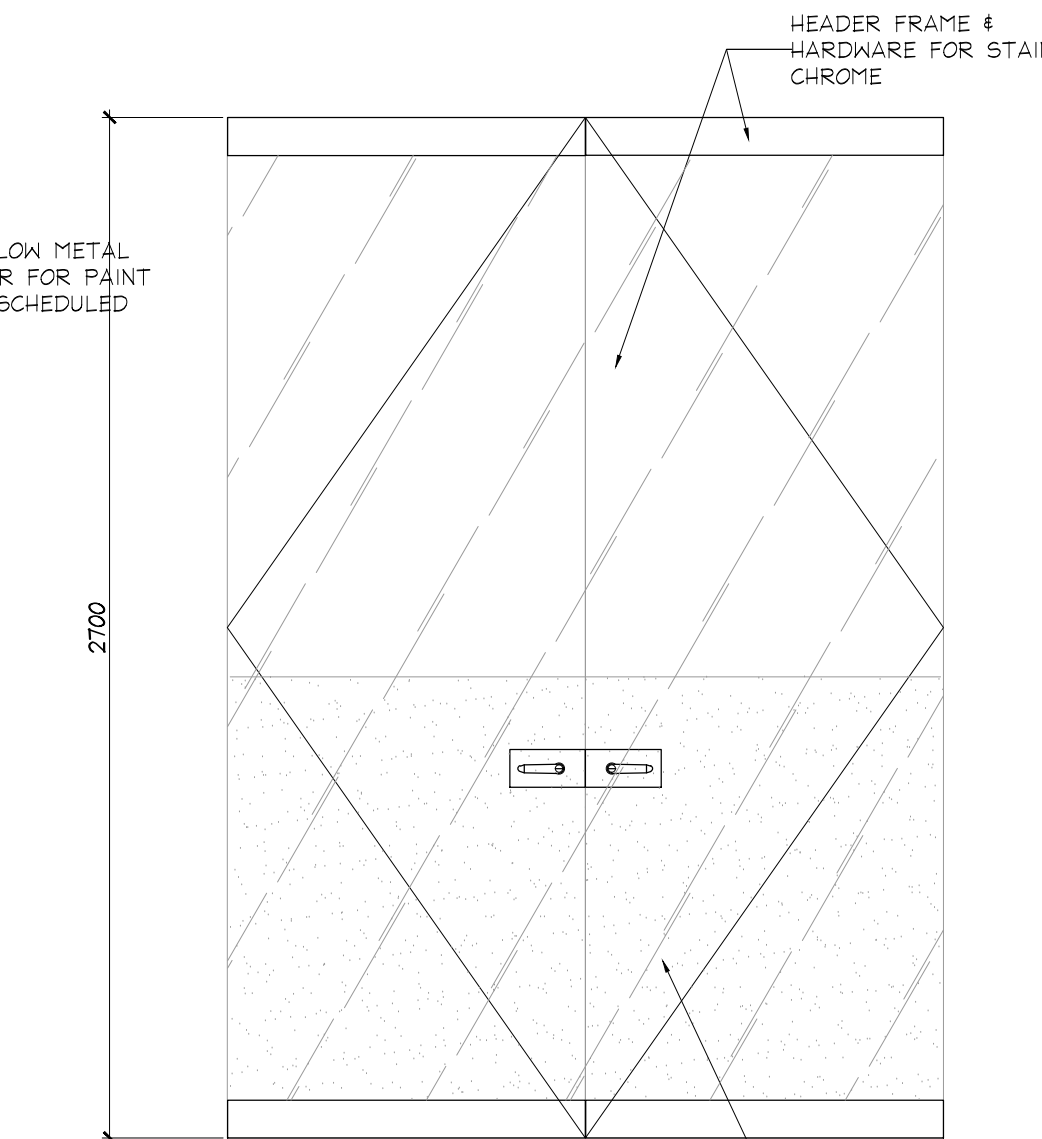


GROUND FLOOR
DOOR 154
CORRIDOR D TO FITNESS AREA

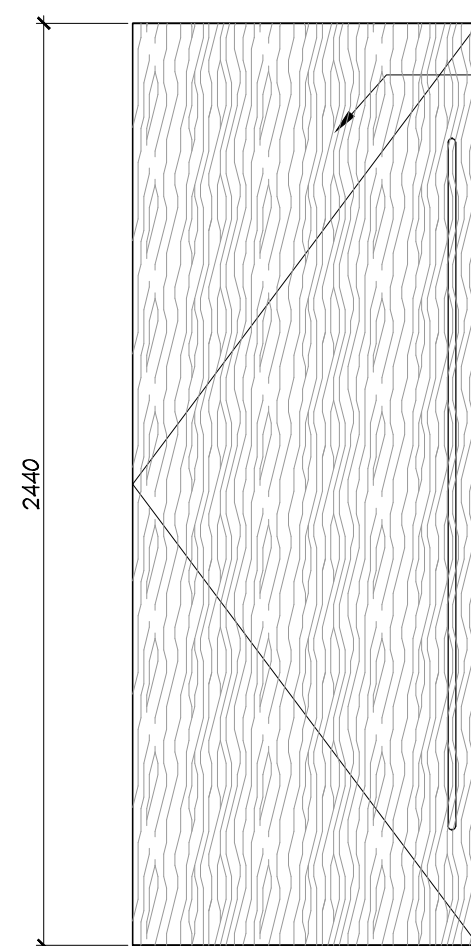


GROUND FLOOR
DOORS 156, 157
BARRIER FREE WC

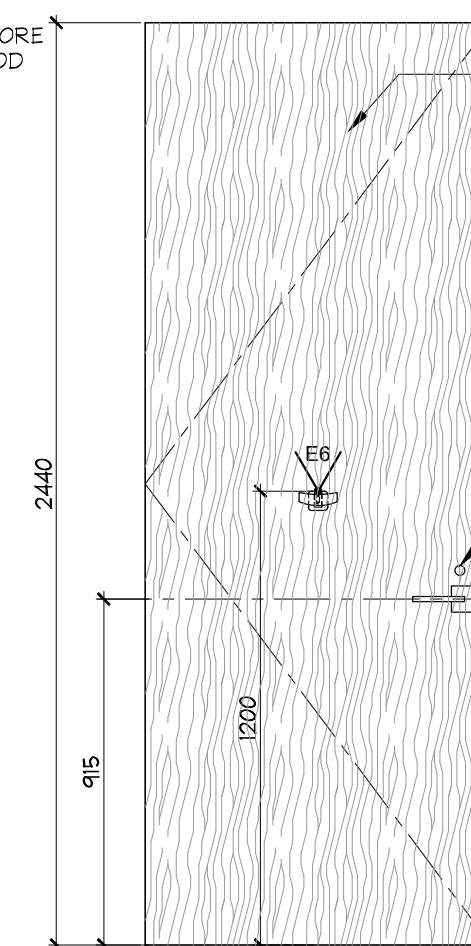


GROUND FLOOR
DOORS 156, 157
(INTERIOR)
BARRIER FREE WC

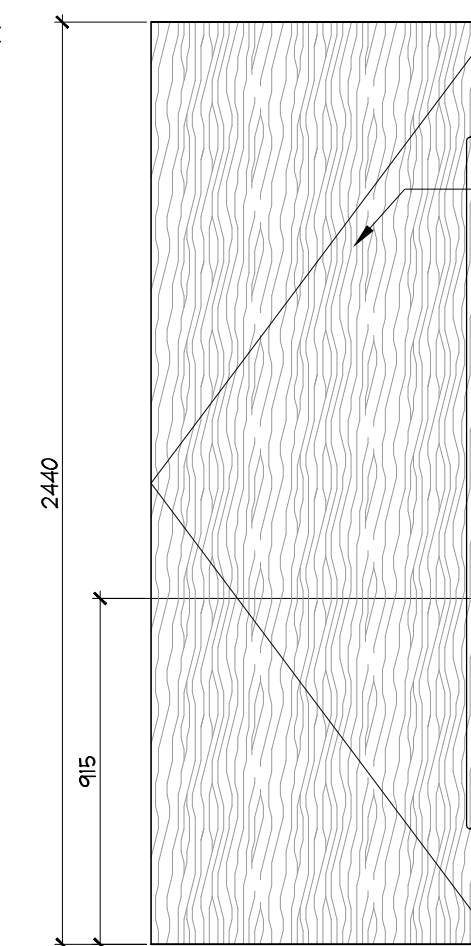


GROUND FLOOR
DOOR 158
THEATRE

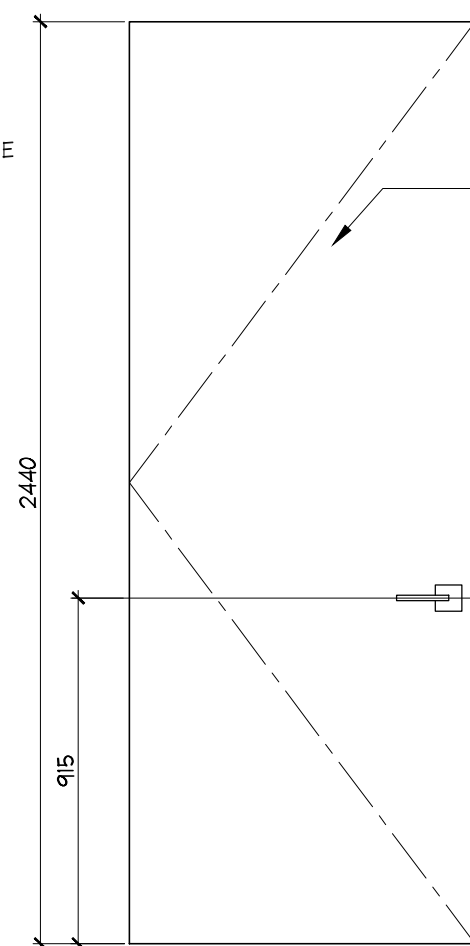


GROUND FLOOR
DOOR 158C
THEATRE EQUIP.

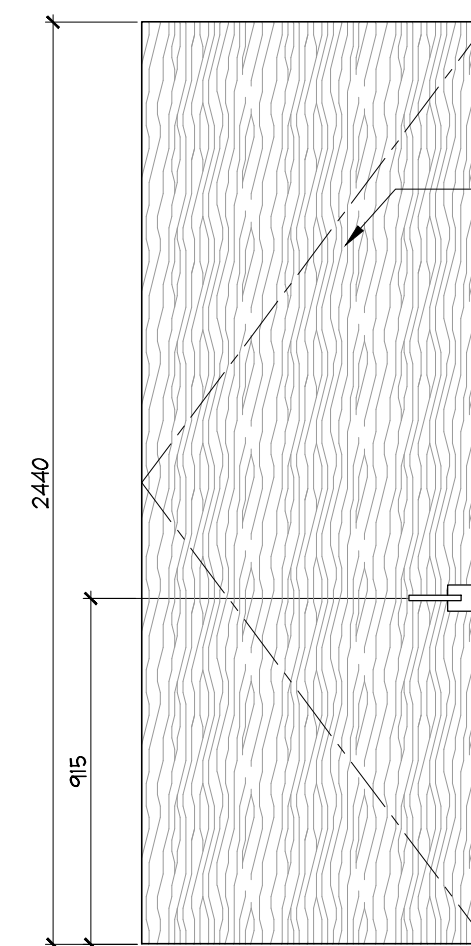


GROUND FLOOR
DOORS 168, 169
CACF PARCEL ROOM

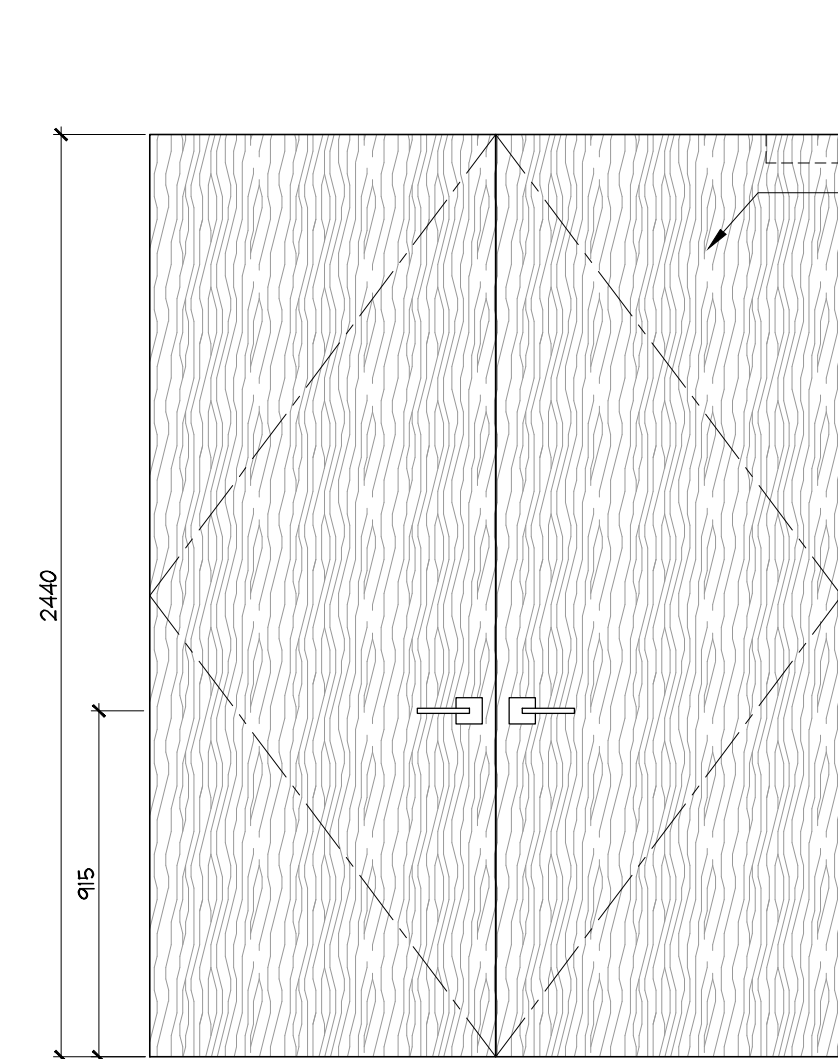


GROUND FLOOR
DOOR 154
CORRIDOR D ELECTRICAL CLOSET

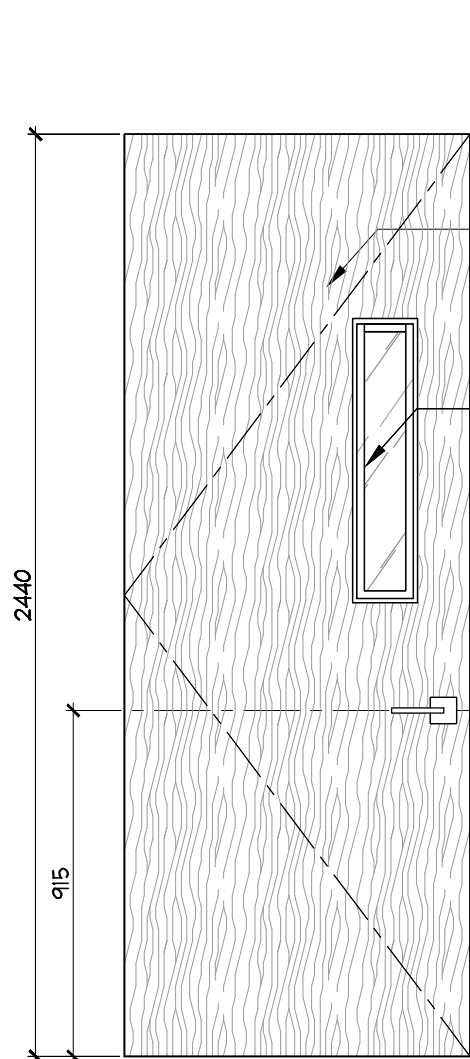


GROUND FLOOR
DOOR 160.1
CORRIDOR C TO CORRIDOR A

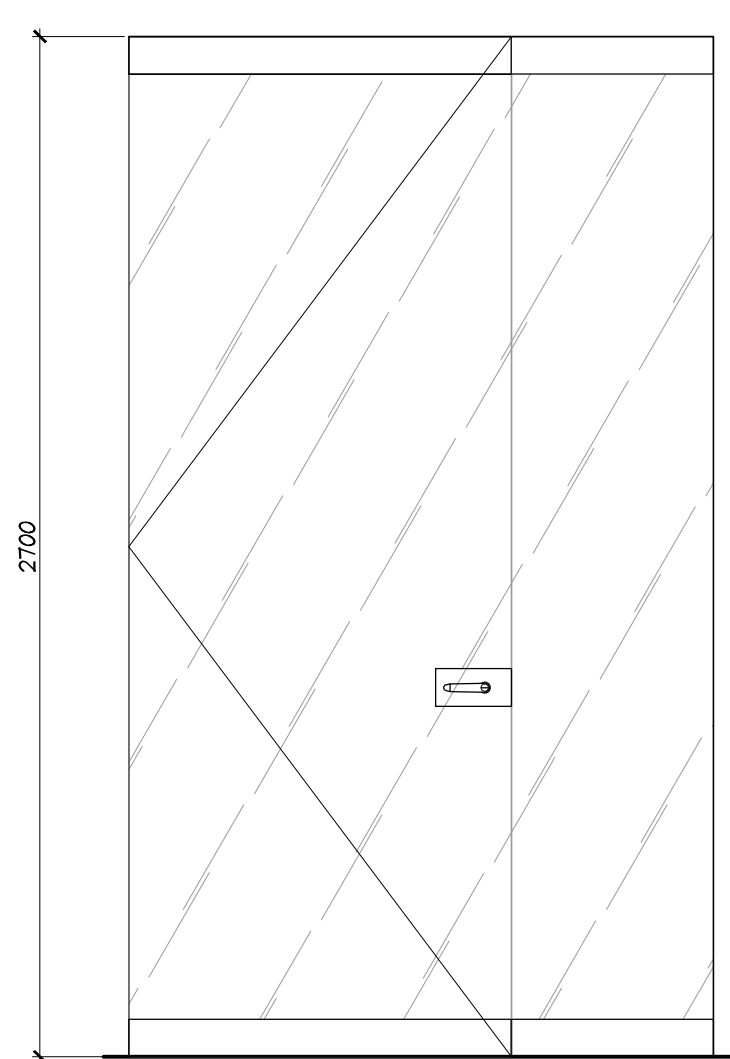


GROUND FLOOR
DOOR 160.2
PARTY ROOM AMENITY

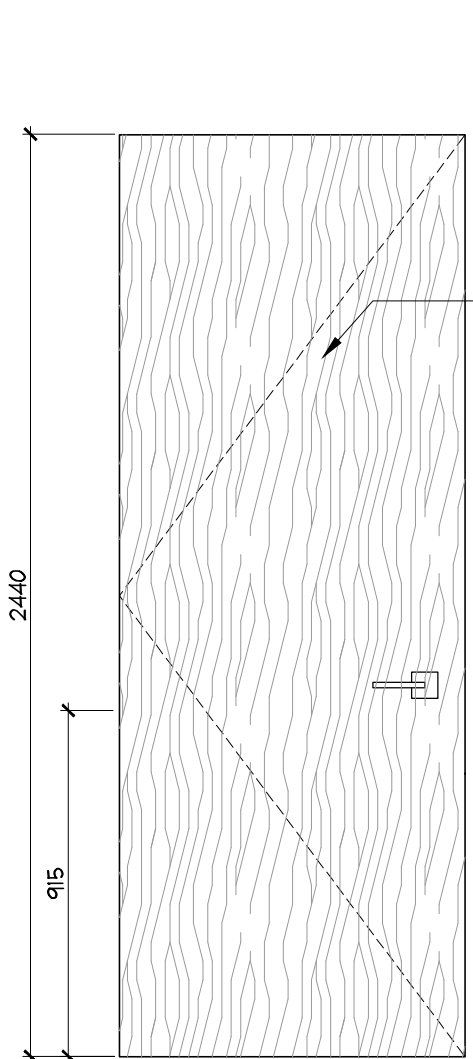


GROUND FLOOR
DOORS 161.1, 161.2
DINING ROOM

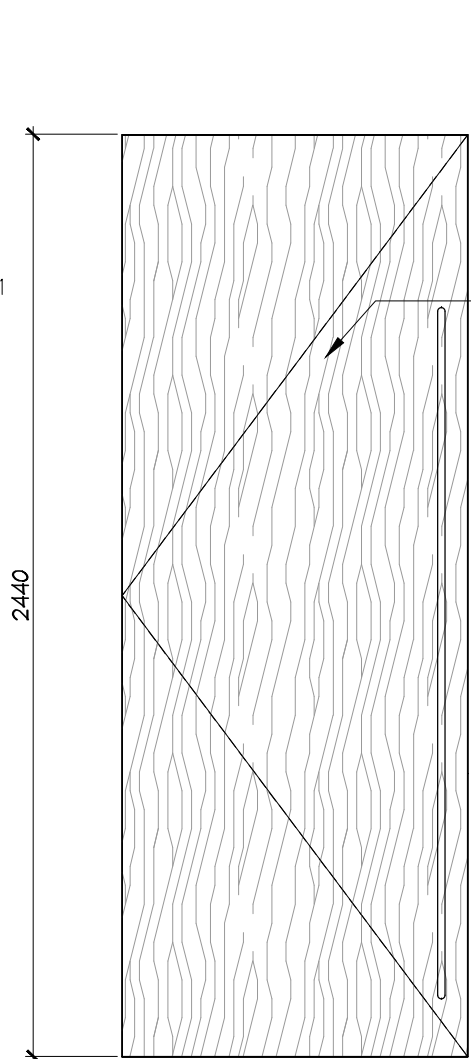


GROUND FLOOR
DOORS 162
KITCHEN

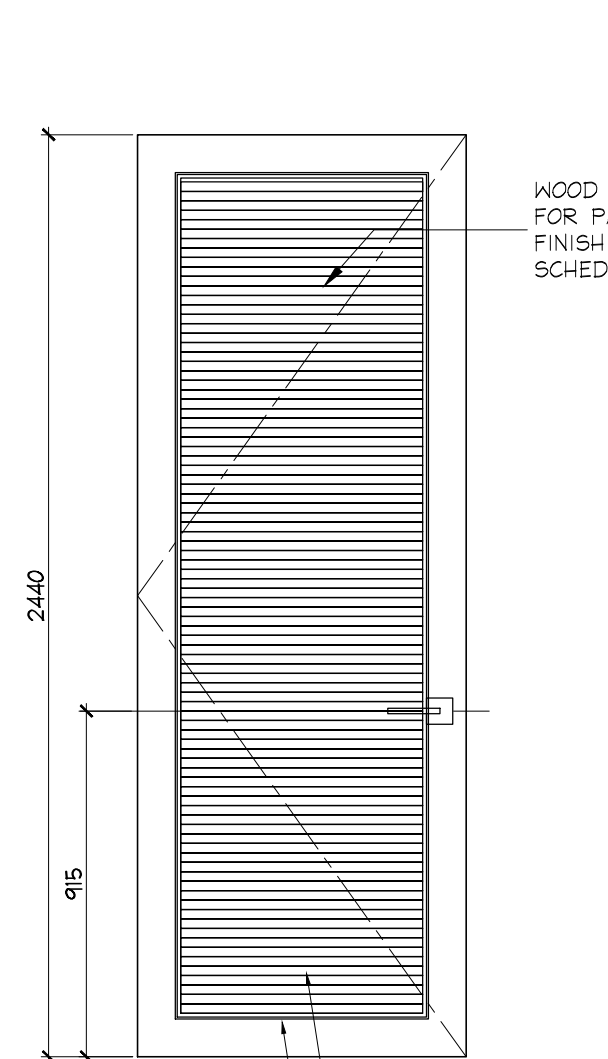


GROUND FLOOR
DOORS 162A, 163A
VFCU ACCESS DOOR

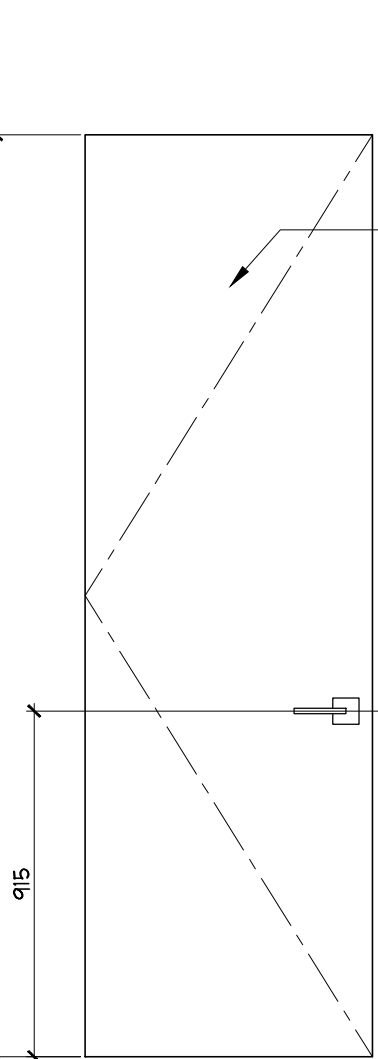


GROUND FLOOR
DOOR 163B
CLOSET DOOR

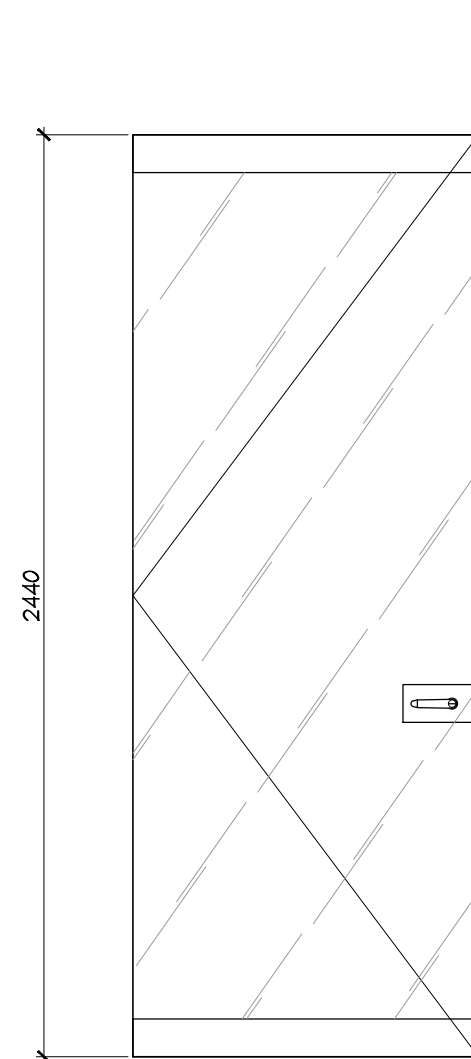

GROUND FLOOR
DOOR 164
PROPERTY MANAGEMENT
OFFICE

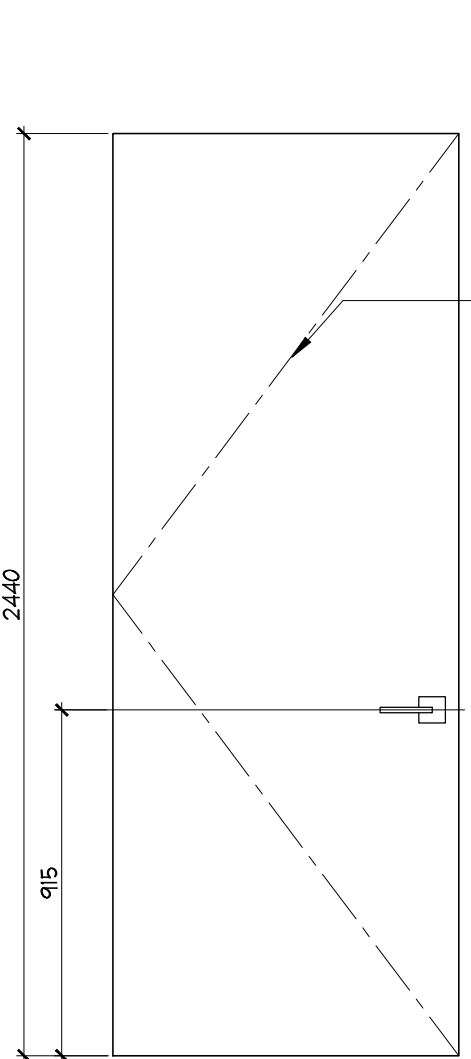

GROUND FLOOR
DOORS 166.1, 167
PROPERTY MANAGEMENT
OFFICE

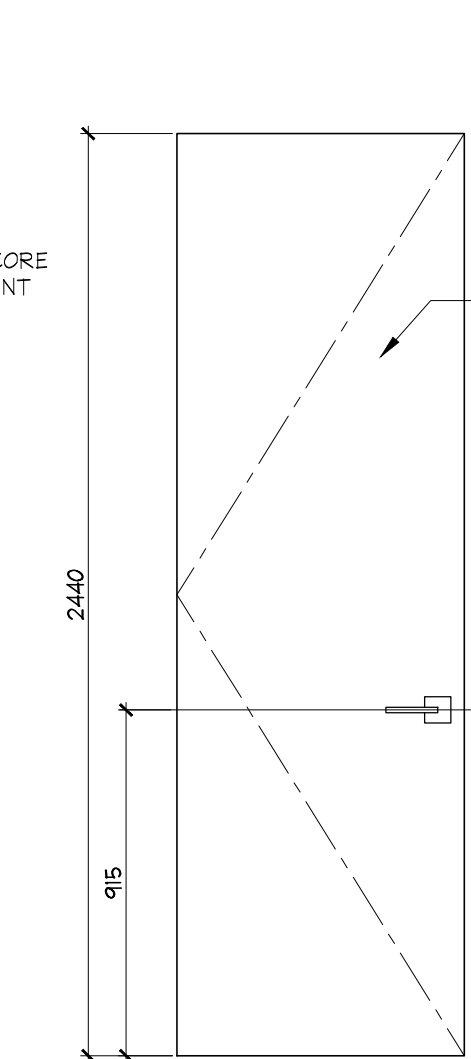

GROUND FLOOR
DOOR 166.2
MANAGEMENT OFFICE
(MECHANICAL CLOSET)

DO NOT SCALE DRAWINGS.

CONTRACTOR MUST VERIFY ALL DRAWINGS, DIMENSIONS, DETAILS AND SPECIFICATIONS. AND REPORT ANY DISCREPANCIES TO UNION 31 INC. BEFORE PROCEEDING WITH WORK. MATERIALS MAY NOT BE SUBSTITUTED WITHOUT WRITTEN APPROVAL FROM UNION 31 INC.

ALL DRAWINGS AND SPECIFICATIONS ARE INSTRUMENTS OF SERVICE AND THE PROPERTY OF UNION 31 INC. WHICH MUST BE RETURNED AT THE COMPLETION OF THE WORK.

PRINTED: 30-May-17

ISSUED FOR AS-BUILT

01	31 MAY 17	ISSUED FOR AS-BUILT	SV
NO.	DATE	COMMENTS	INI

REVISIONS:

UNION31

UNION31 INC.
183 BATHURST STREET, STE. 201
TORONTO, ON, M5T 2R7, CANADA
TEL: 416-597-1576 FAX: 416-597-2139

PROJECT NAME:		ALEXANDRA PARK MAIN BUILDING	
PROJECT NO.:		13-949	
DRAWINGS:		DOOR ELEVATIONS	
DATE STARTED:		07 AUG / 13	
SCALE:		AS NOTED	
DRAWN BY:		SM	
APPROVED BY:		KC	
DRAWING NO.:		ID	
		2.4.0	

CONTRACTOR MUST VERIFY ALL DRAWINGS, DIMENSIONS, DETAILS AND SPECIFICATIONS, AND REPORT ANY DISCREPANCIES TO UNION 31 INC. BEFORE PROCEEDING WITH WORK. MATERIALS MAY NOT BE SUBSTITUTED WITHOUT WRITTEN APPROVAL FROM UNION 31 INC.

ALL DRAWINGS AND SPECIFICATIONS ARE INSTRUMENTS OF SERVICE AND THE PROPERTY OF UNION 31 INC. WHICH MUST BE RETURNED AT THE COMPLETION OF THE WORK.

DATE STARTED: 07 AUG / 13	DRAWING NO.: ID 2.4.1
SCALE: AS NOTED	
DRAWN BY: SM	
APPROVED BY: KC	


DO NOT SCALE DRAWINGS.

CONTRACTOR MUST VERIFY ALL DRAWINGS, DIMENSIONS, DETAILS AND SPECIFICATIONS AND REPORT ANY DISCREPANCIES TO UNION 31 INC. BEFORE PROCEEDING WITH WORK. MATERIALS MAY NOT BE SUBSTITUTED WITHOUT WRITTEN APPROVAL FROM UNION 31 INC.


ALL DRAWINGS AND SPECIFICATIONS ARE INSTRUMENTS OF SERVICE AND THE PROPERTY OF UNION 31 INC. WHICH MUST BE RETURNED AT THE COMPLETION OF THE WORK.

PRINTED: 30-Ma-17


ISSUED FOR
AS-BUILT

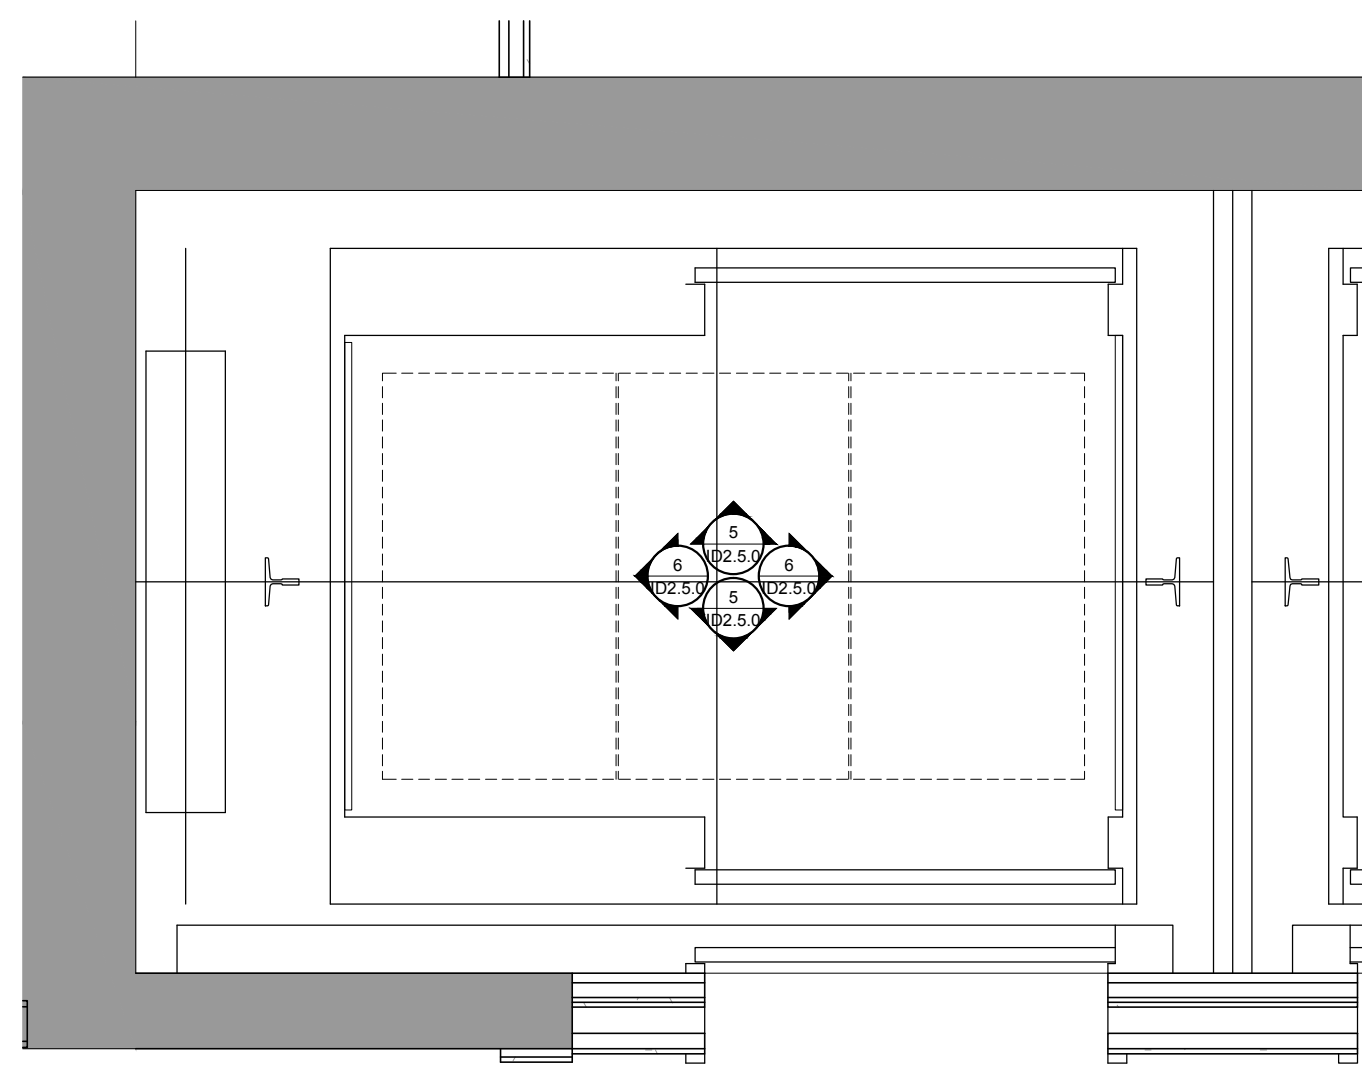


1
TYP. ELEVATOR CAB
CONSTRUCTION PLAN
SCALE 1:20

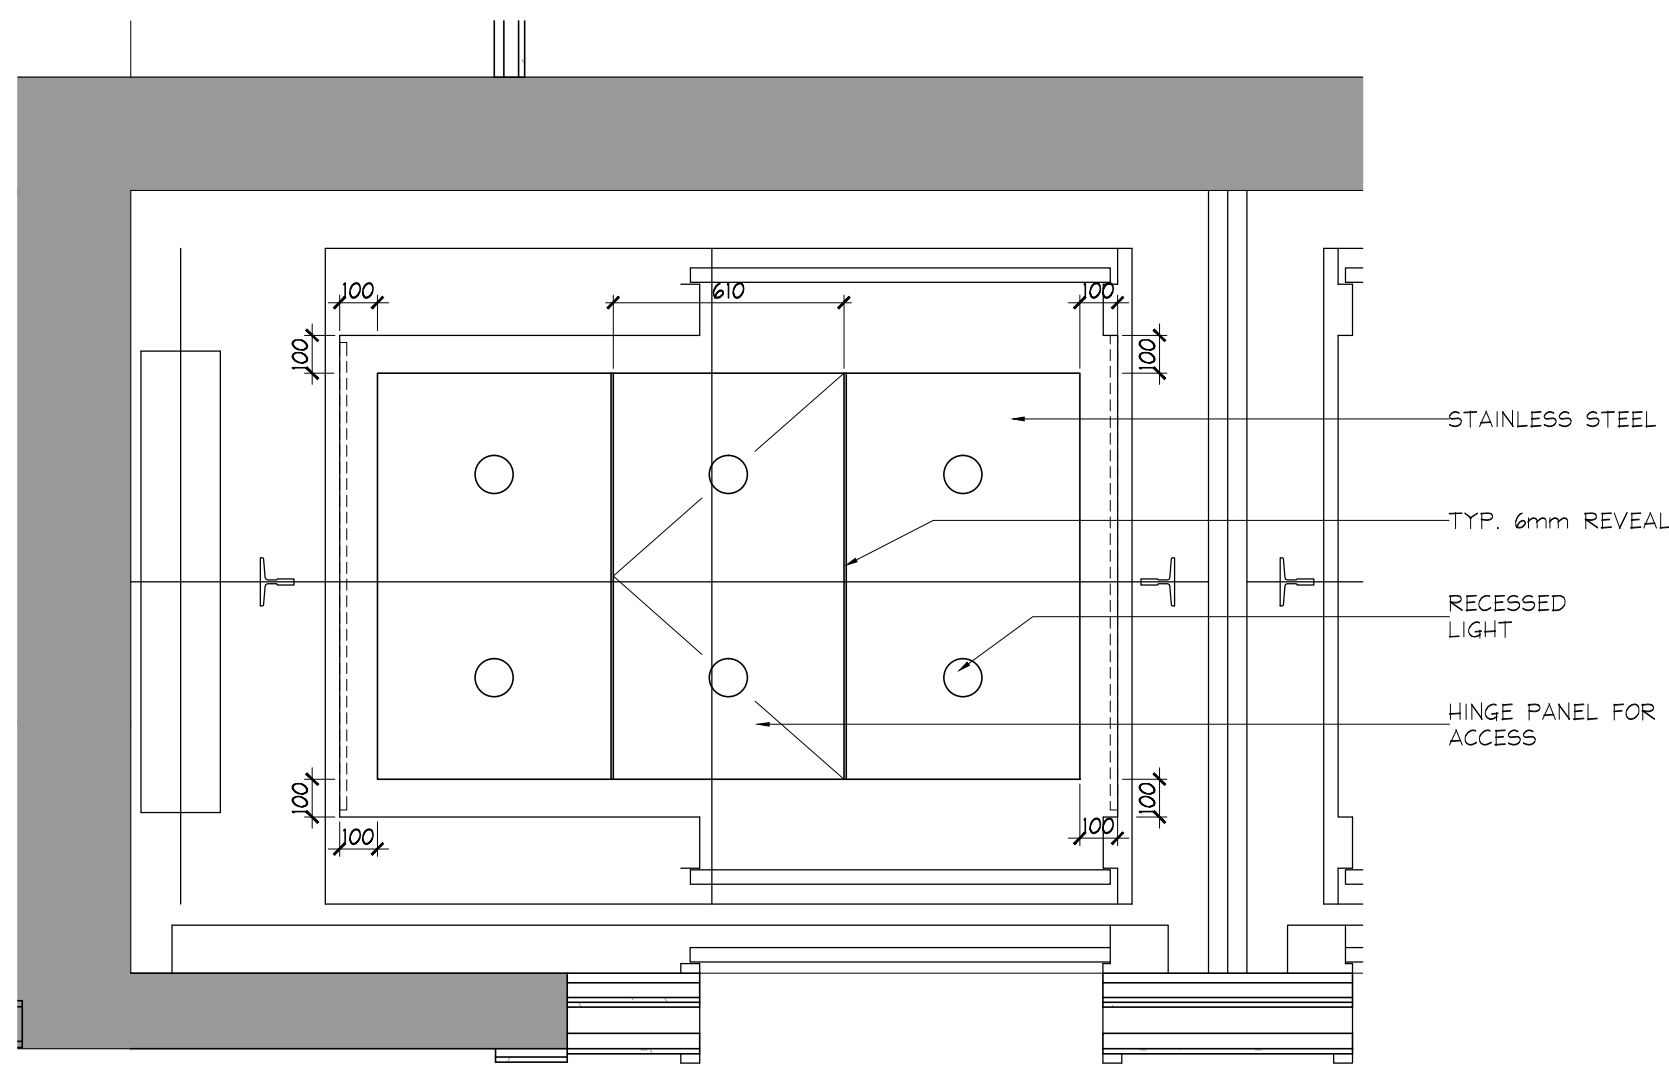


2
TYP. ELEVATOR CAB
REFLECTED CEILING PLAN
SCALE 1:20

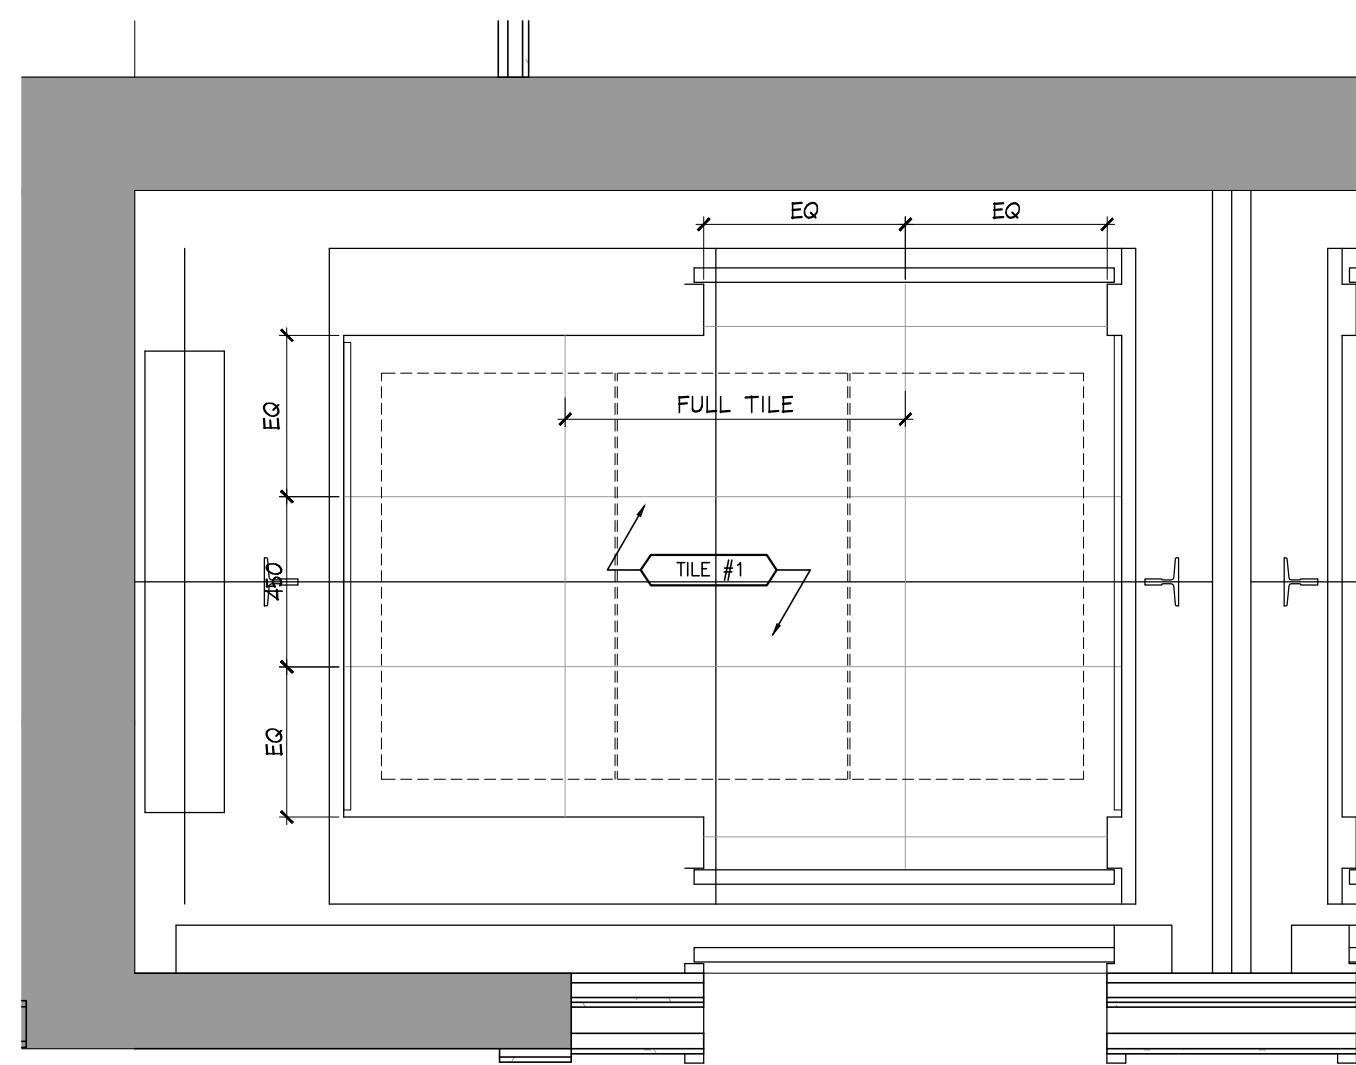


3
TYP. ELEVATOR CAB
FLOOR FINISHES PLAN
SCALE 1:20

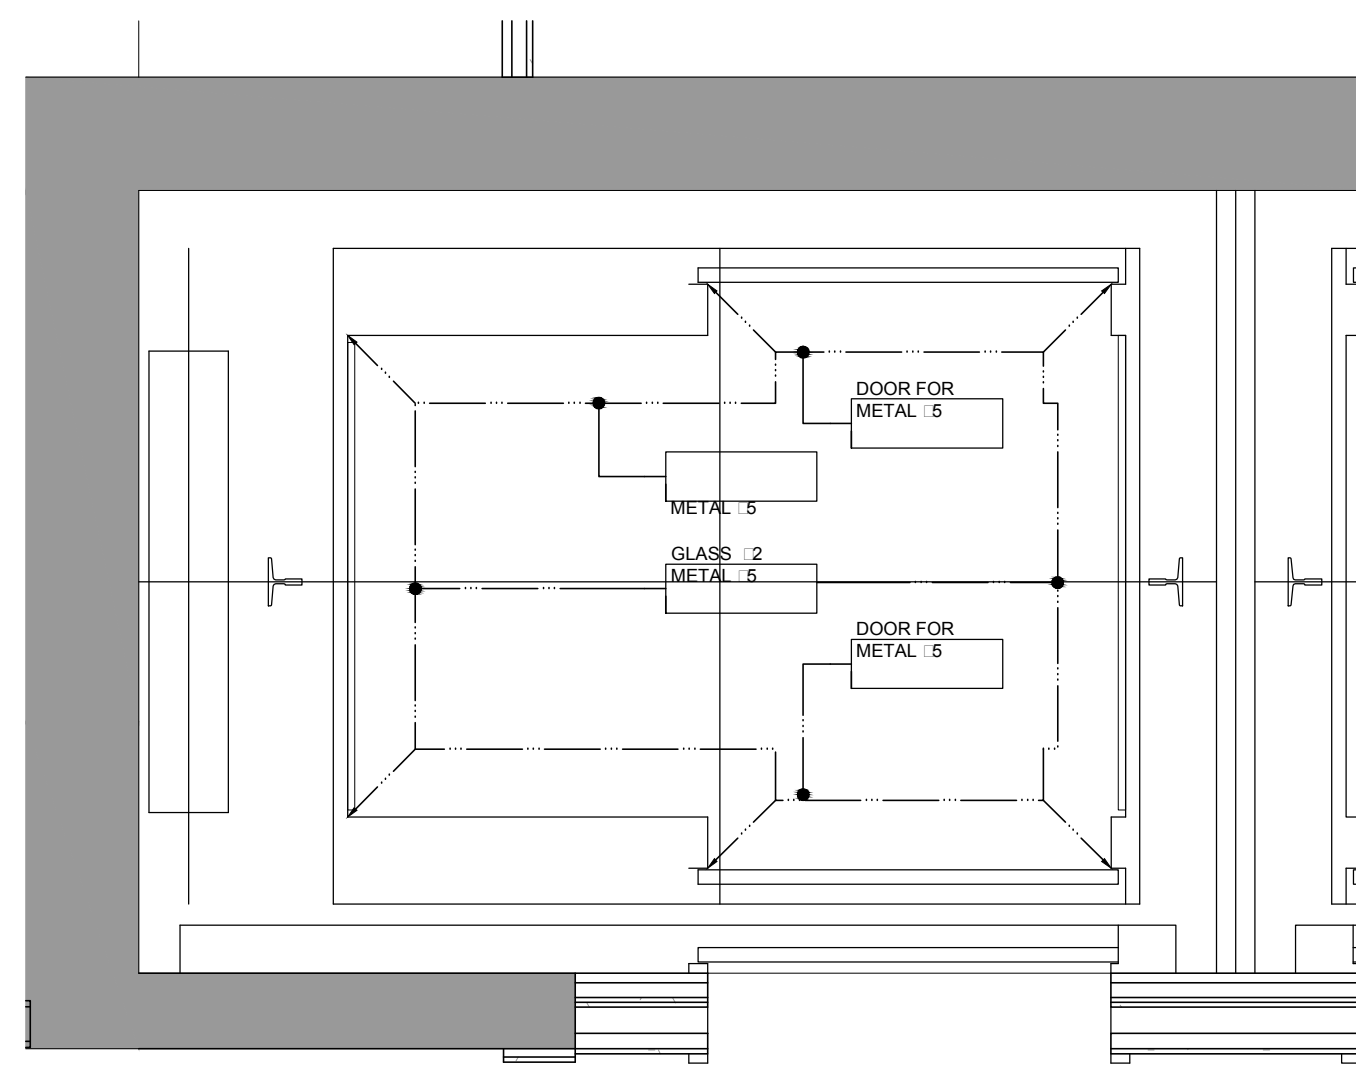


4
TYP. ELEVATOR CAB
WALL FINISHES PLAN
SCALE 1:20

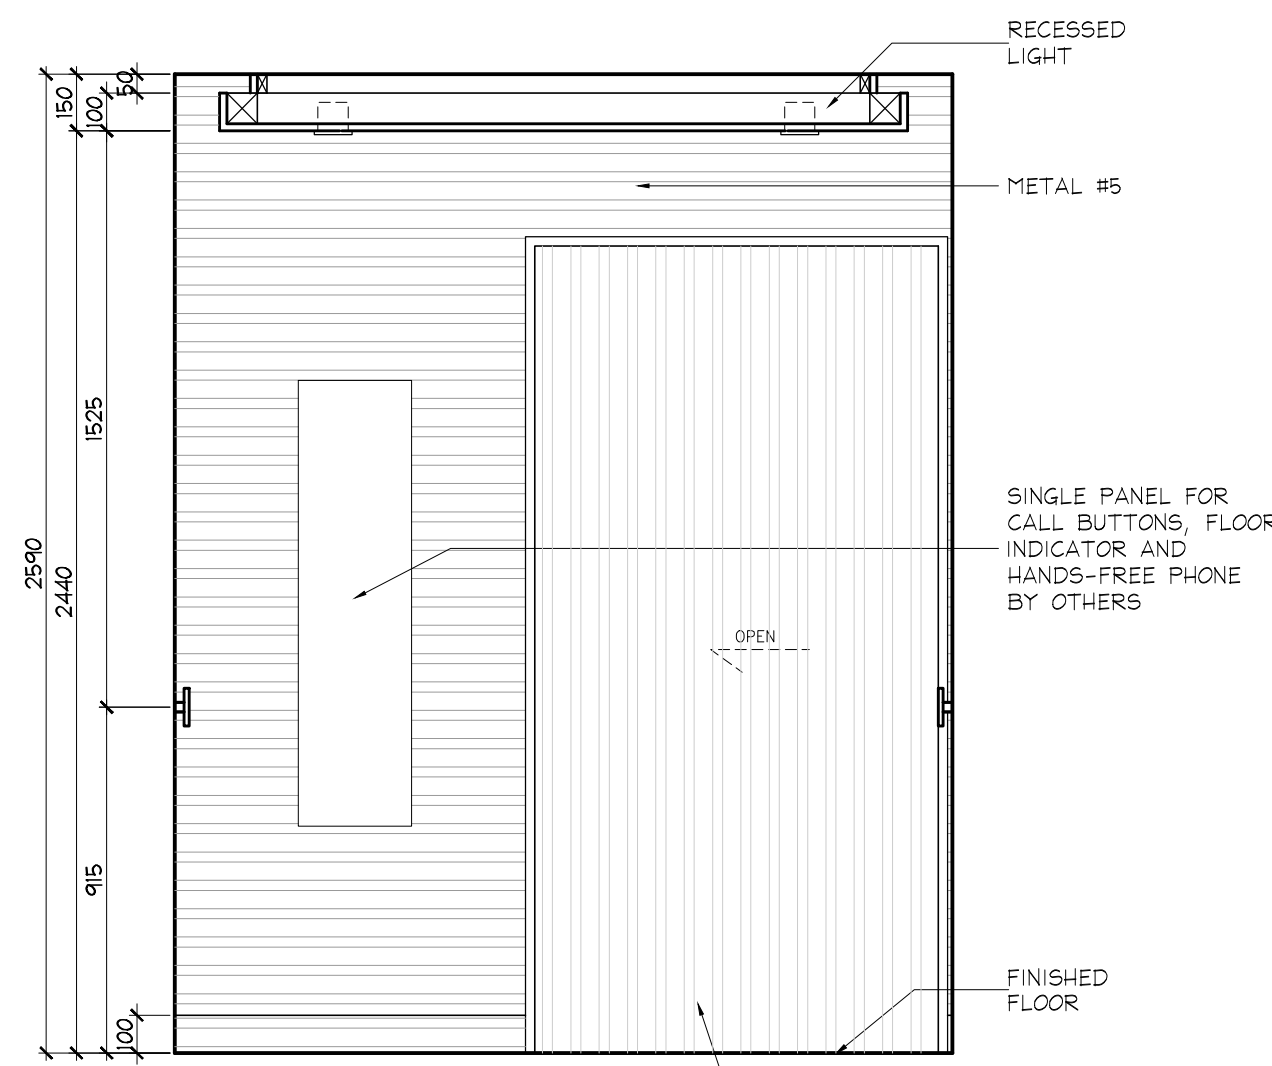


5
TYP. ELEVATOR CAB
ELEVATION
SCALE 1:20

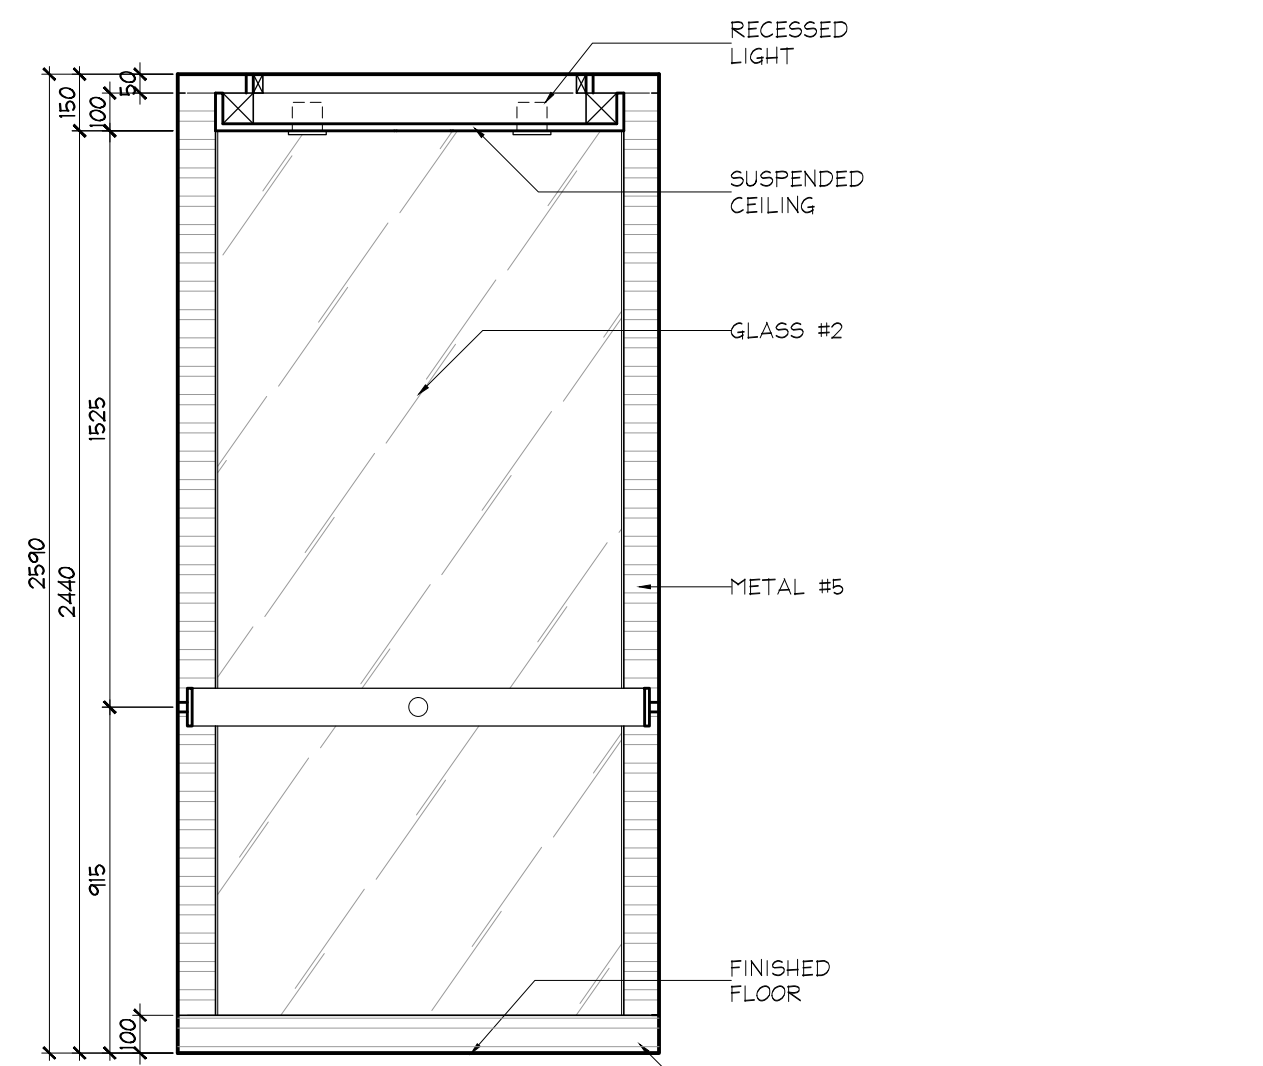


6
TYP. ELEVATOR CAB
ELEVATION
SCALE 1:20

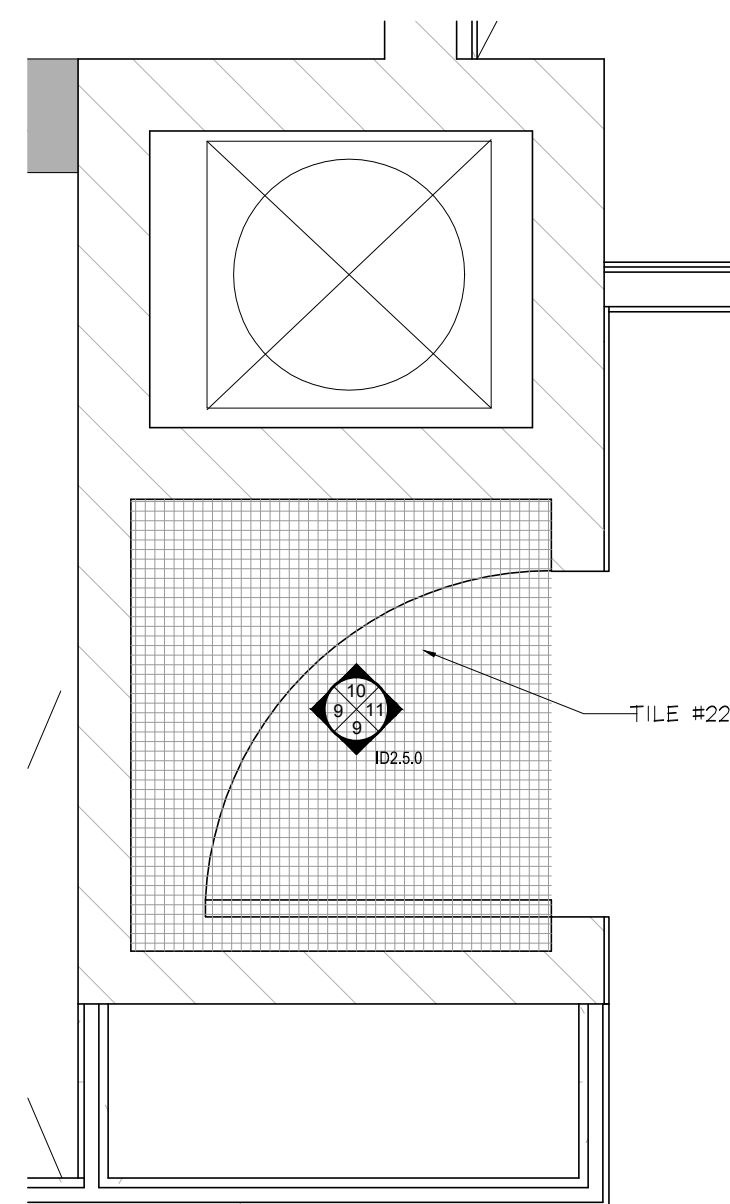


8
PLAN
GARBAGE CHUTE
SCALE 1:20

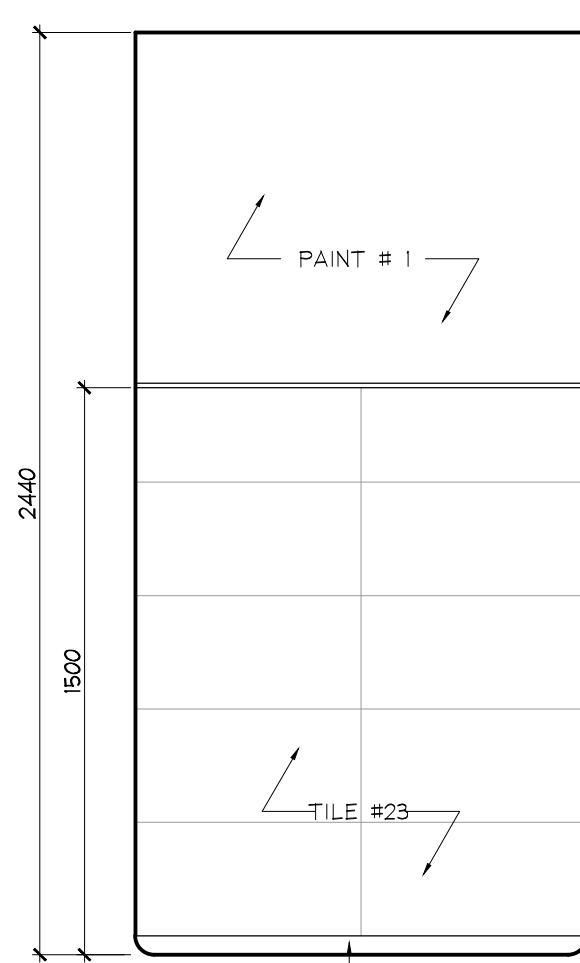

9
ELEVATION
GARBAGE CHUTE
SCALE 1:20

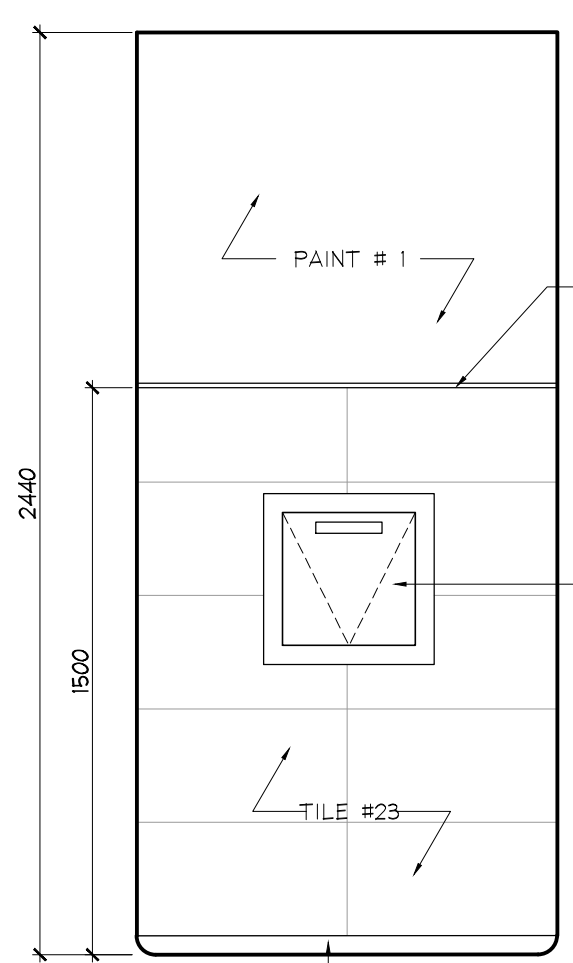

10
ELEVATION
GARBAGE CHUTE
SCALE 1:20

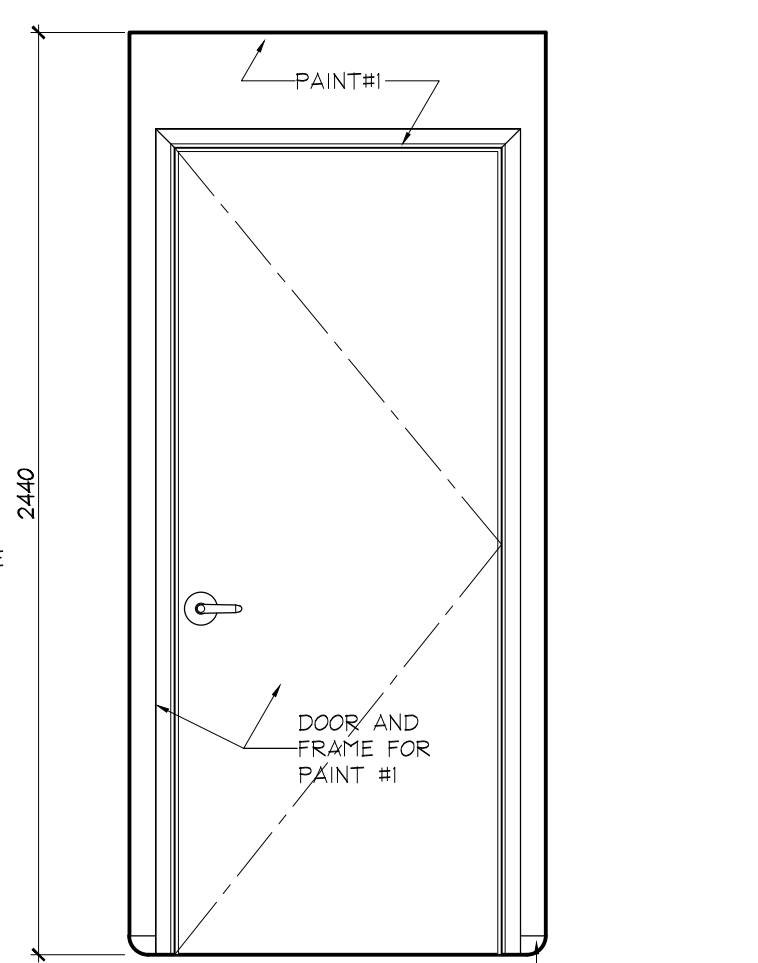

11
ELEVATION
GARBAGE CHUTE
SCALE 1:20

01	31 MAY / 17	ISSUED FOR AS-BUILT	SV
NO.	DATE	COMMENTS	INI

REVISIONS:





UNION31

UNION31 INC.
183 BATHURST STREET, STE. 201
TORONTO, ON, M5T 2R7, CANADA
TEL: 416-597-1576 FAX: 416-597-2139

PROJECT NAME:	ALEXANDRA PARK MAIN BUILDING
BLOCK 11	ON, Canada
PROJECT NO.:	13-949

DRAWINGS:
ELEVATOR CAB & GARBAGE CHUTE
PLANS, ELEVATIONS & DETAILS


DATE STARTED:	07 AUG / 13	DRAWING NO.:	ID
SCALE:	1:20	DRAWN BY:	AP
APPROVED BY:	KC		2.5.0

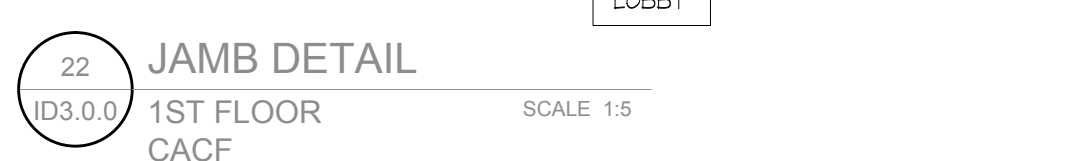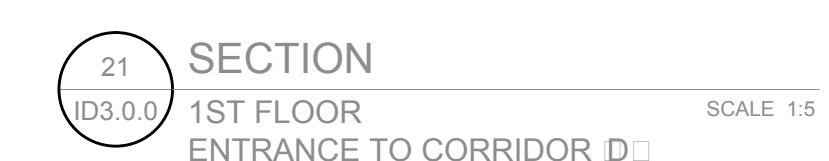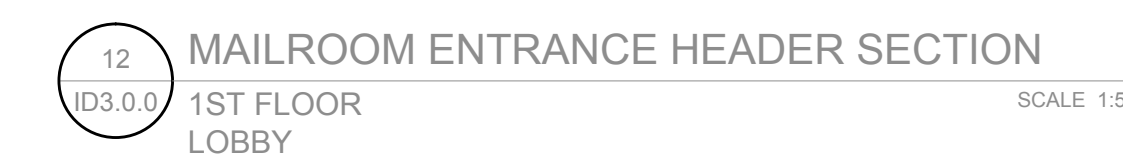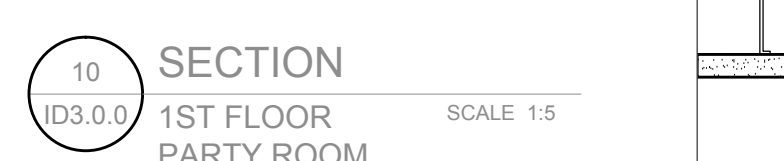


PRINTED: 20 May 17

ISSUED FOR
AS-BUILT


DATE STARTED: 07 AUG / 13	DRAWING NO.: ID 3.0.0
SCALE: AS NOTED	
DRAWN BY: SM	
APPROVED BY: KC	

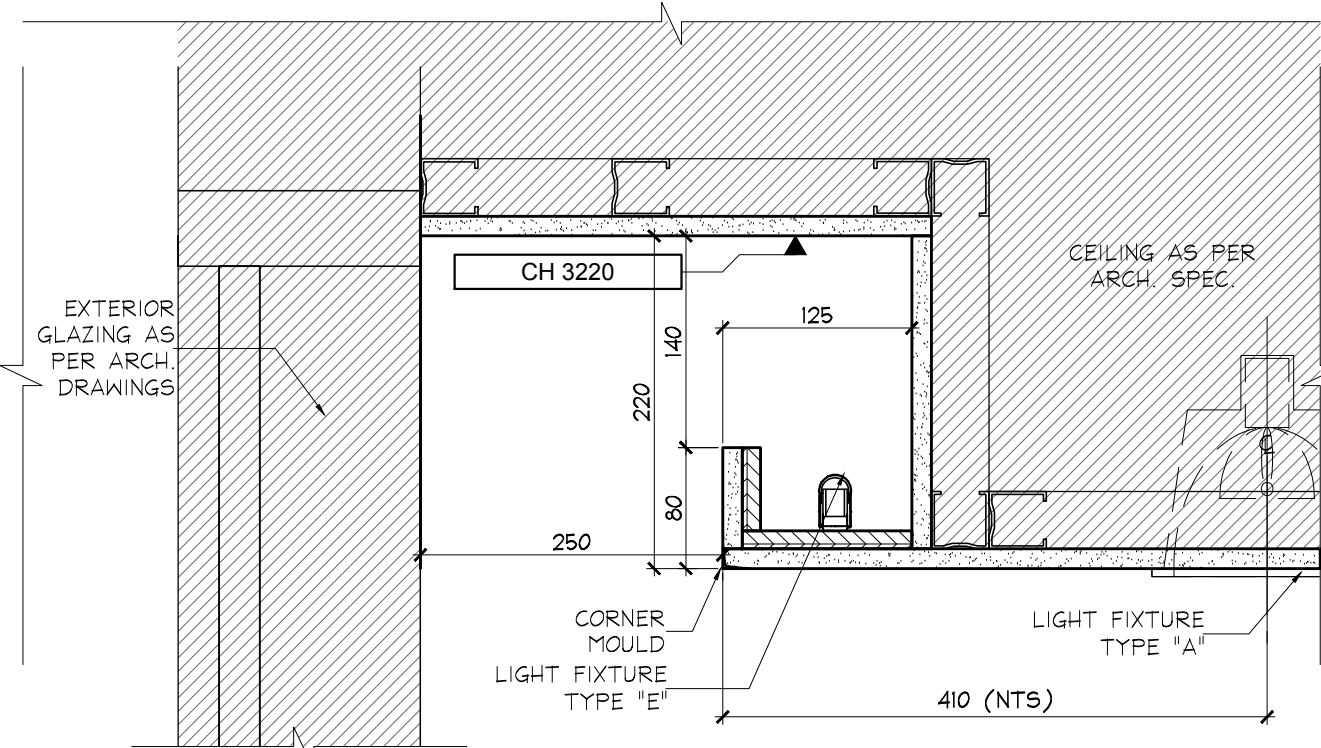


1 CEILING SECTION
EAST VESTIBULE
1ST FLOOR
SCALE 1:5

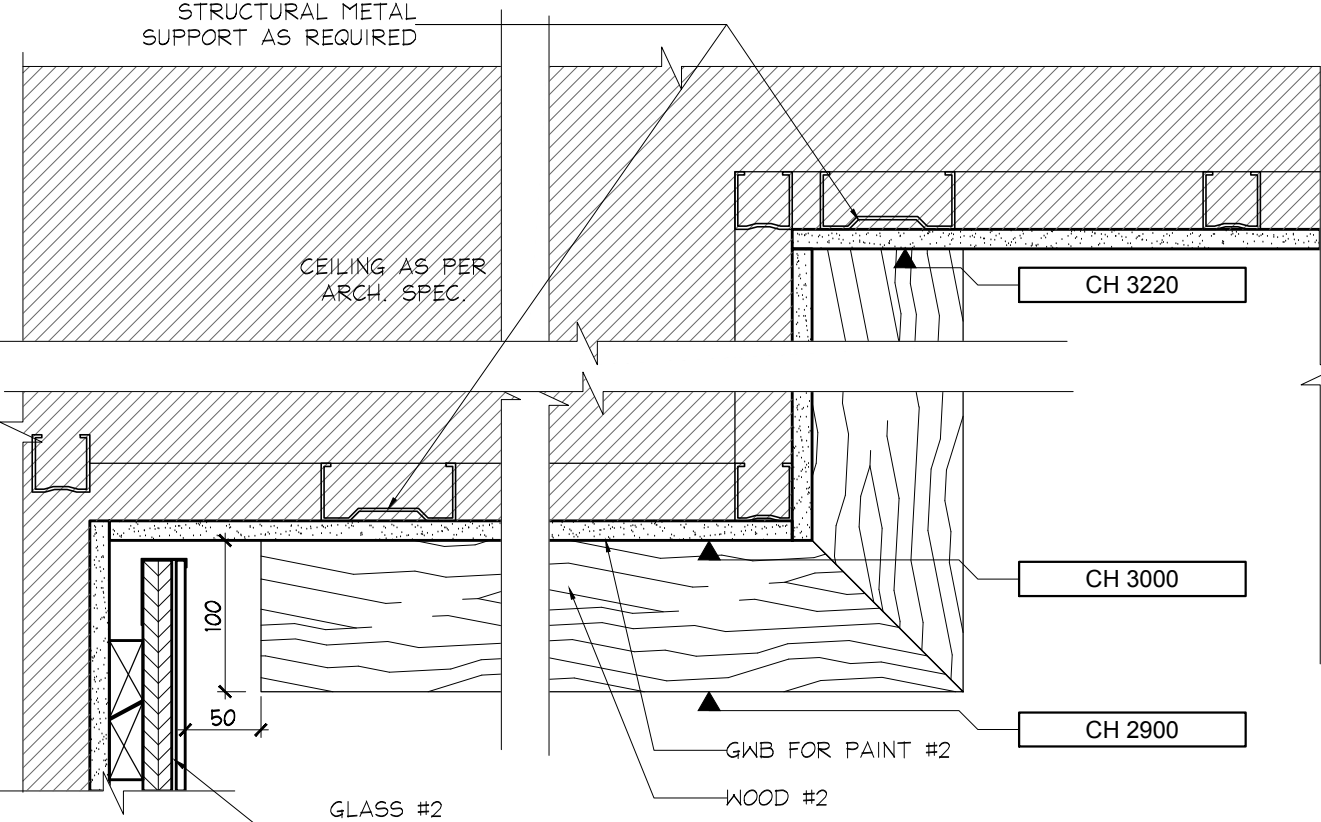


6 BULKHEAD □ CONCIERGE
1ST FLOOR
SCALE 1:5

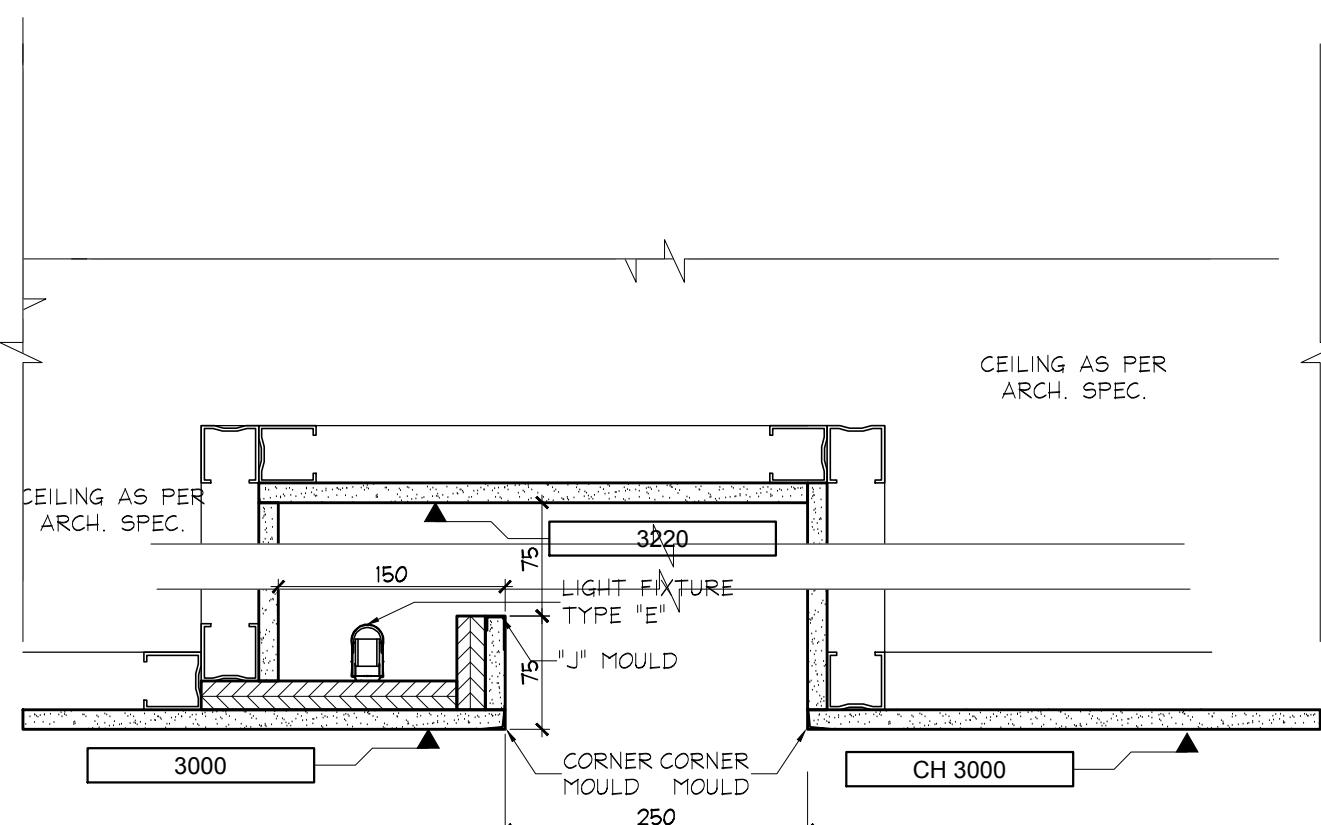


11 SECTION
1ST FLOOR
SCALE 1:5

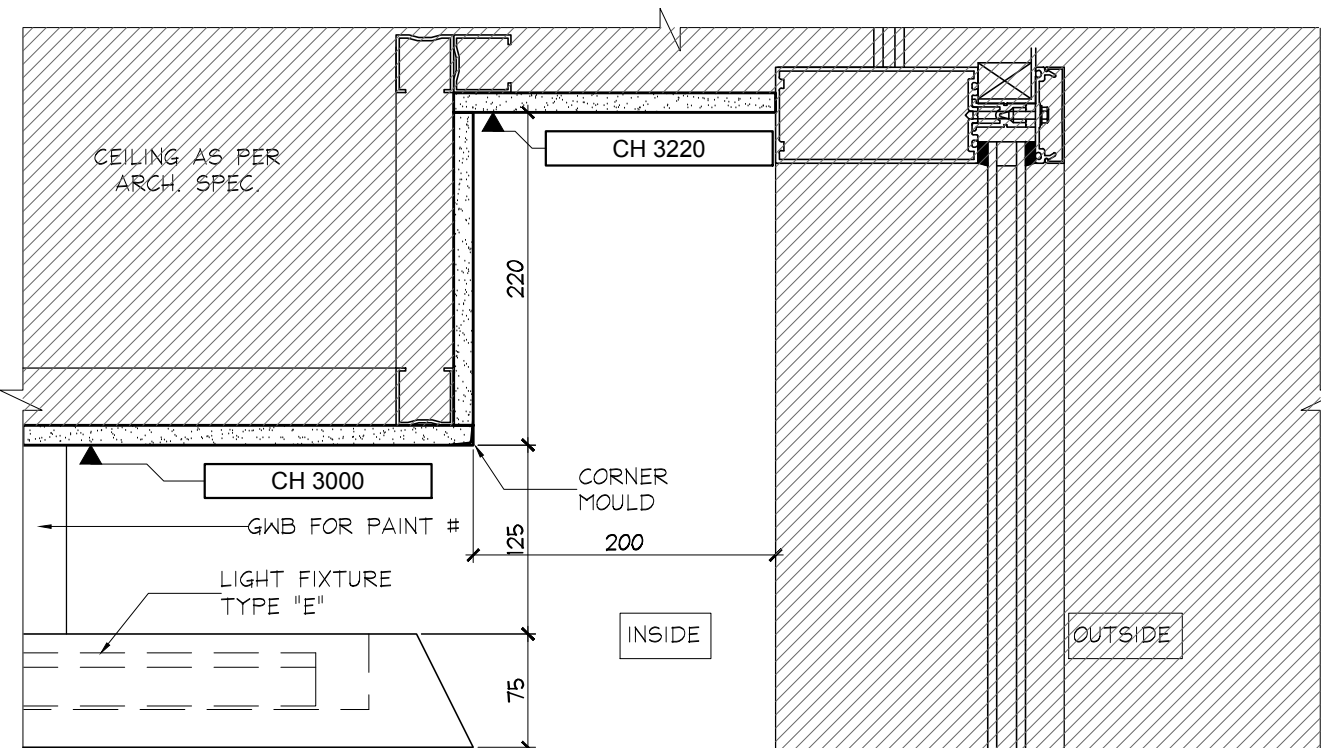


16 CEILING SECTION
PARTY ROOM
1ST FLOOR
SCALE 1:5

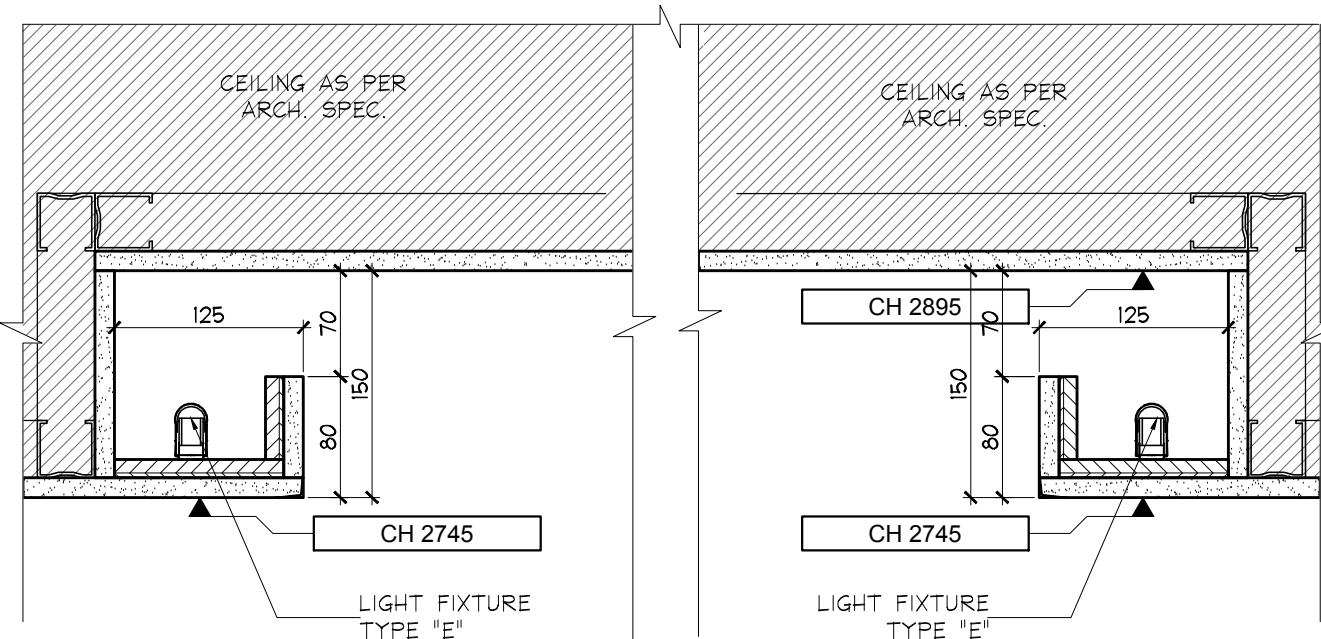


21 CEILING SECTION
PROPERTY MANAGEMENT OFFICE
1ST FLOOR
SCALE 1:5

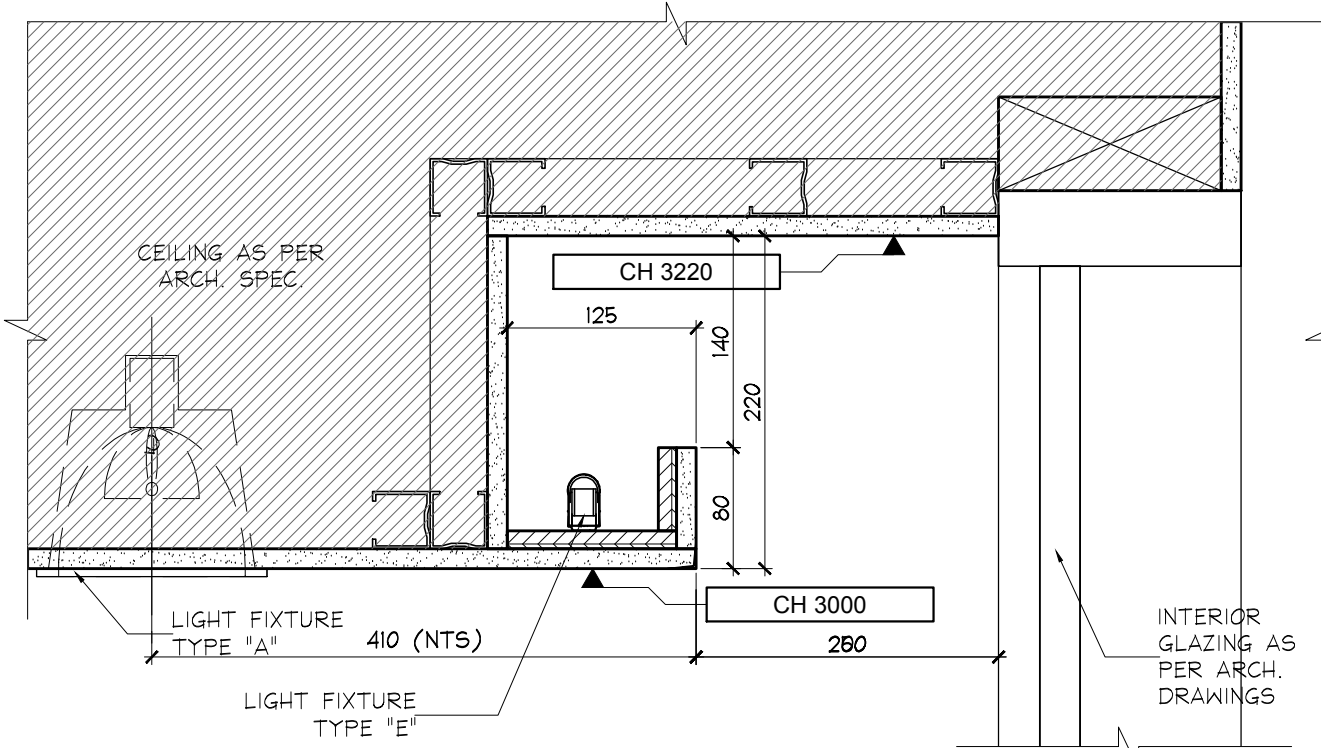


2 CEILING SECTION
EAST VESTIBULE
1ST FLOOR
SCALE 1:5

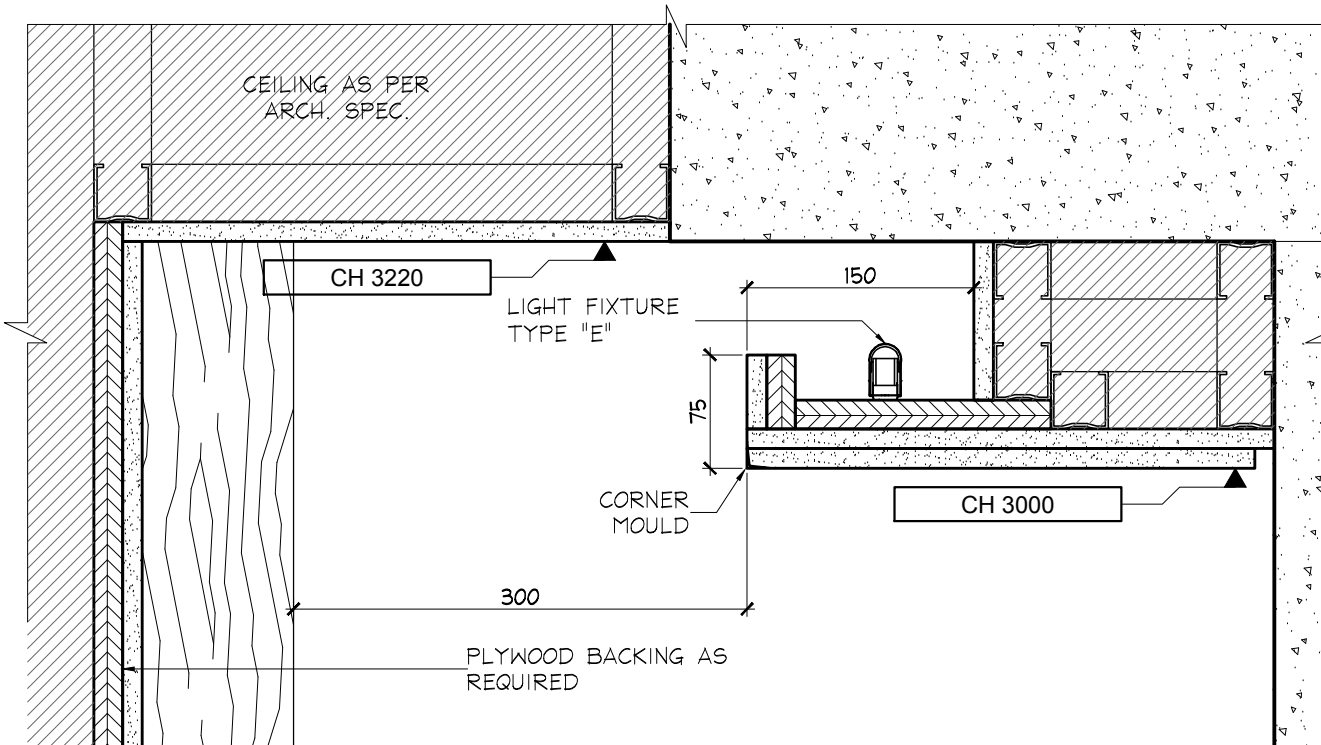


7 BULKHEAD □ CONCIERGE
1ST FLOOR
SCALE 1:5

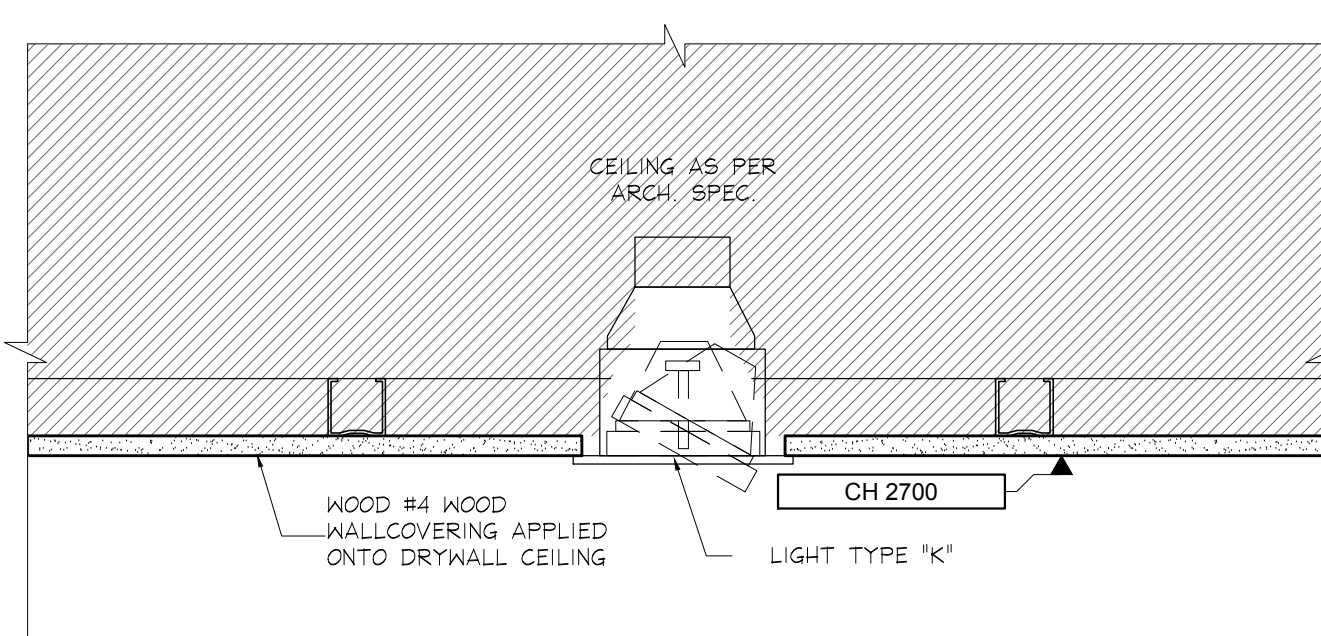


12 LIGHT DETAIL
ELEVATOR LOBBY
1ST FLOOR
SCALE 1:5

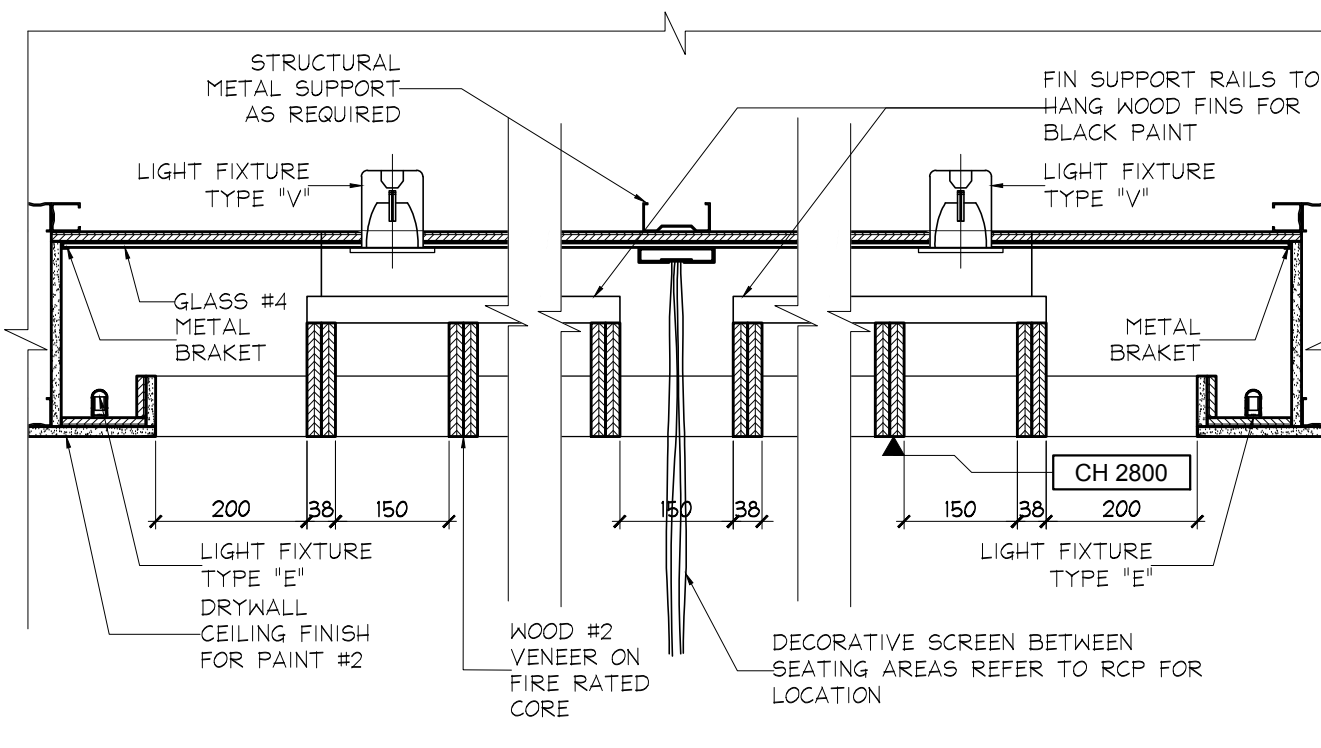


17 CEILING SECTION
PARTY ROOM
1ST FLOOR
SCALE 1:10

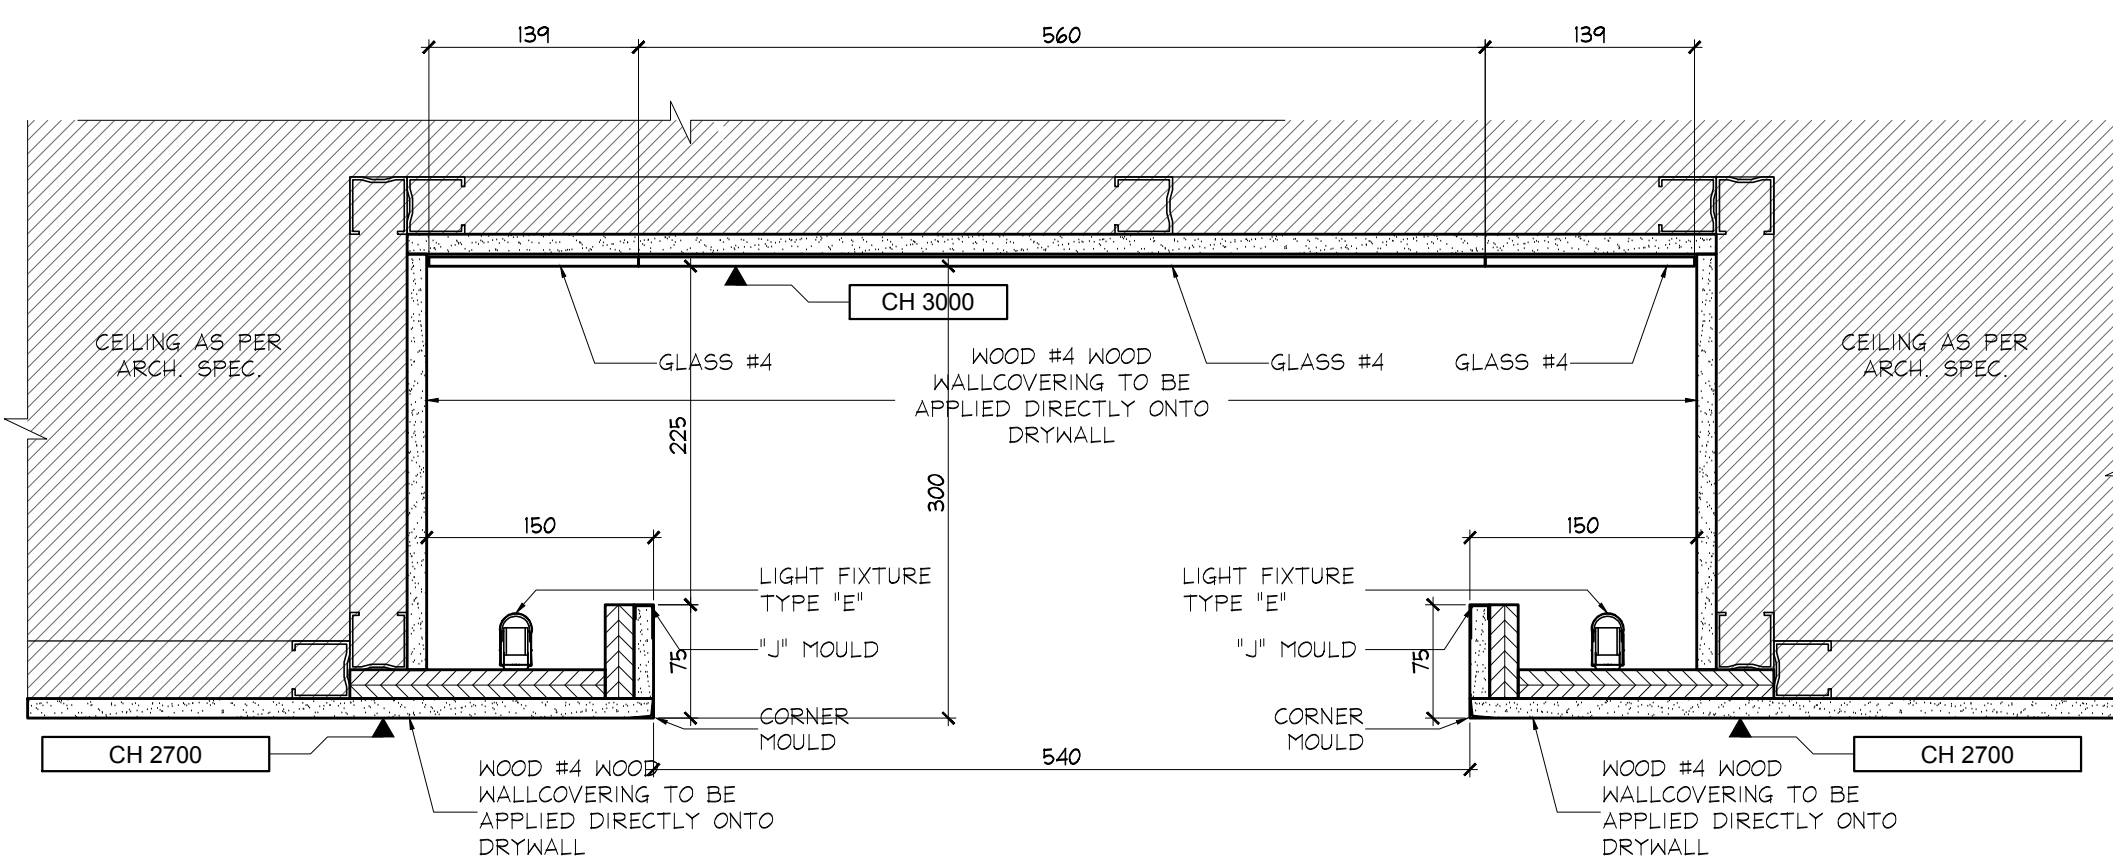


22 SECTION □ CORRIDOR D COVE
1ST FLOOR
SCALE 1:5

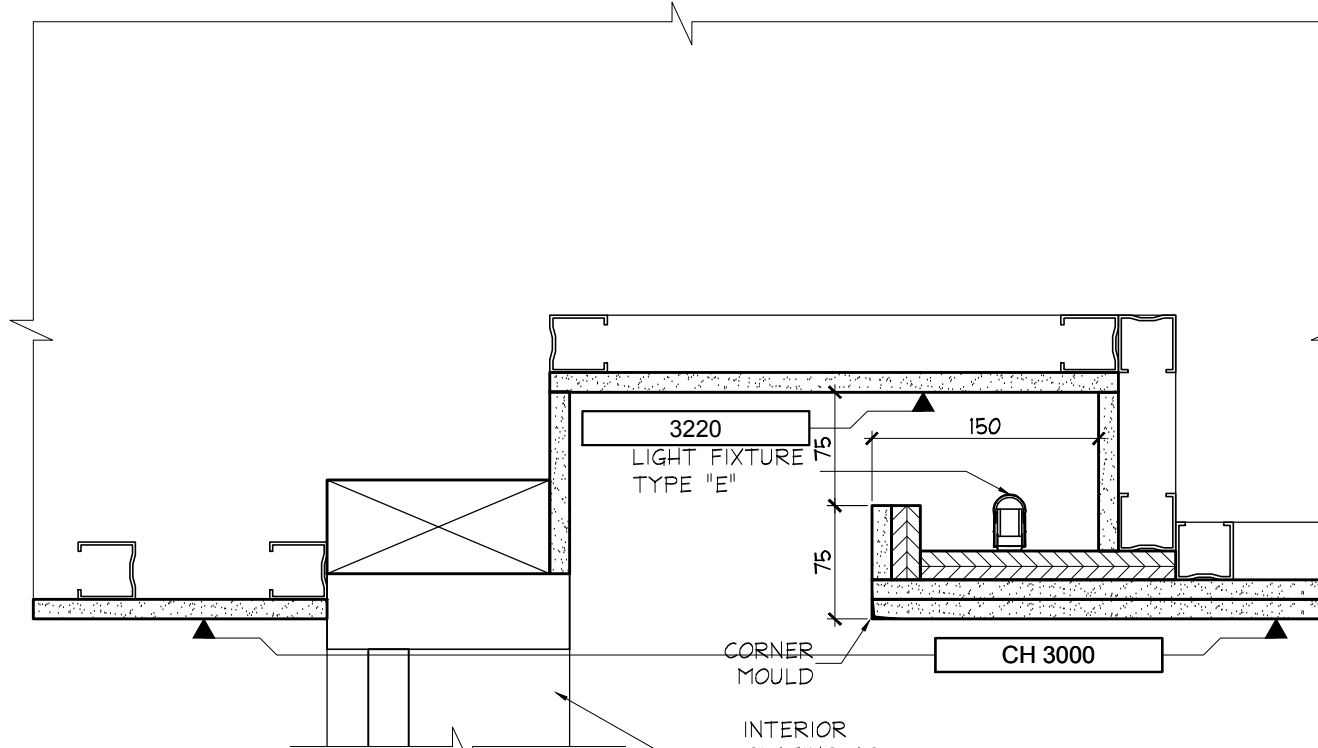


3 CEILING SECTION
EAST VESTIBULE
1ST FLOOR
SCALE 1:5

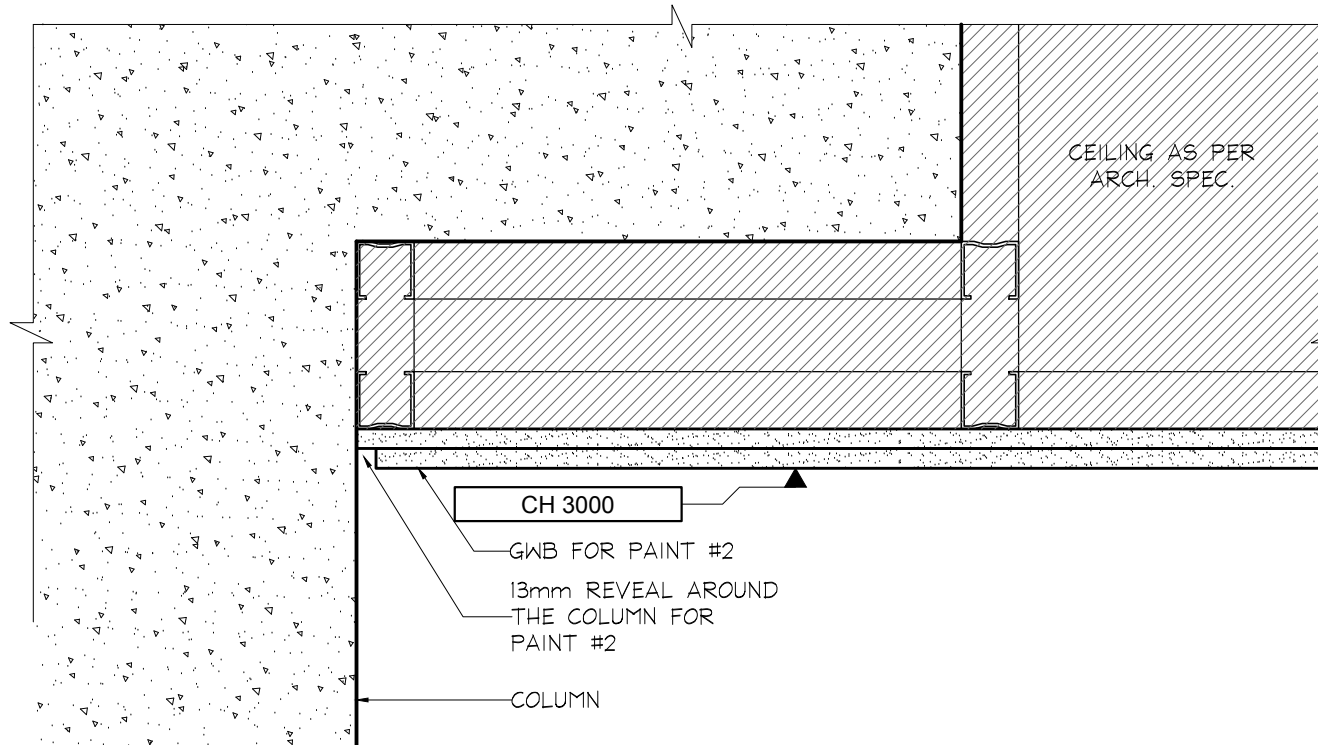


8 BULKHEAD □ CONCIERGE
1ST FLOOR
SCALE 1:5

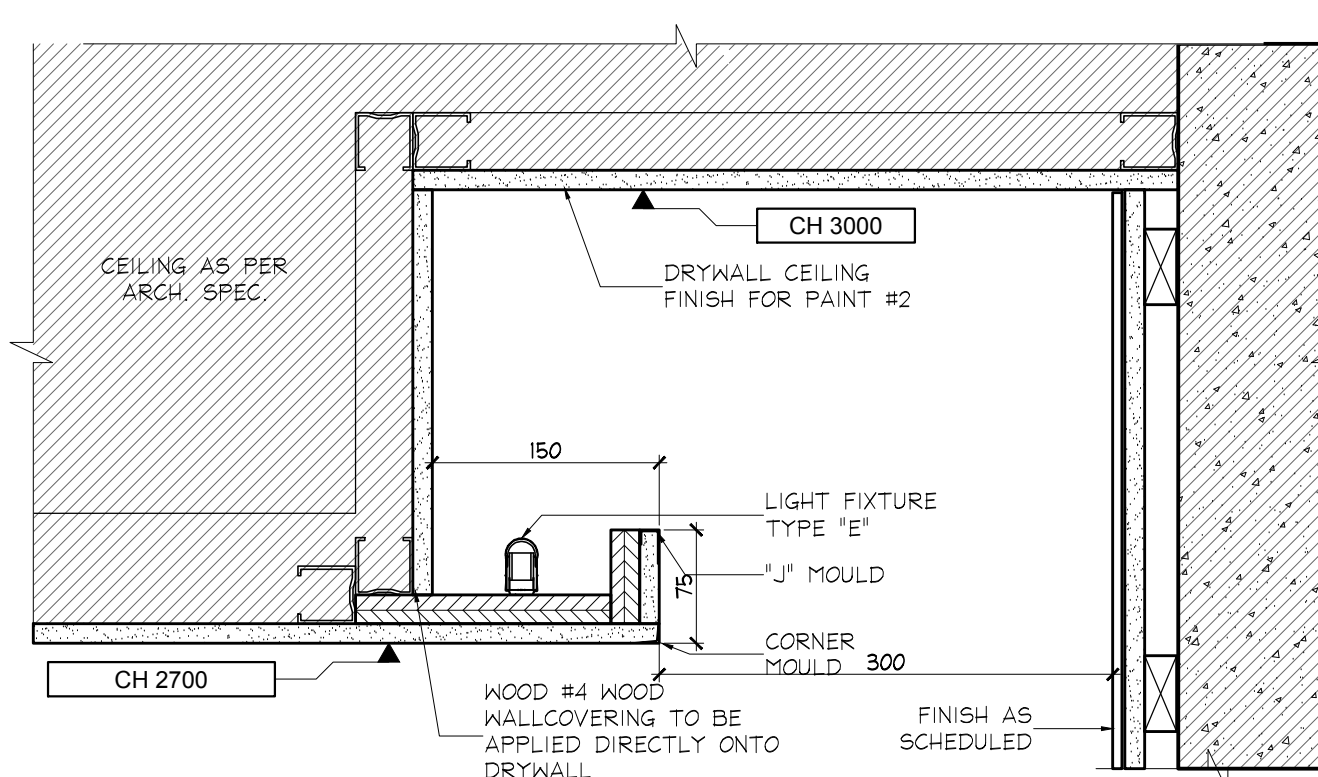


13 SECTION □ ELEVATOR COVE
1ST FLOOR
SCALE 1:5

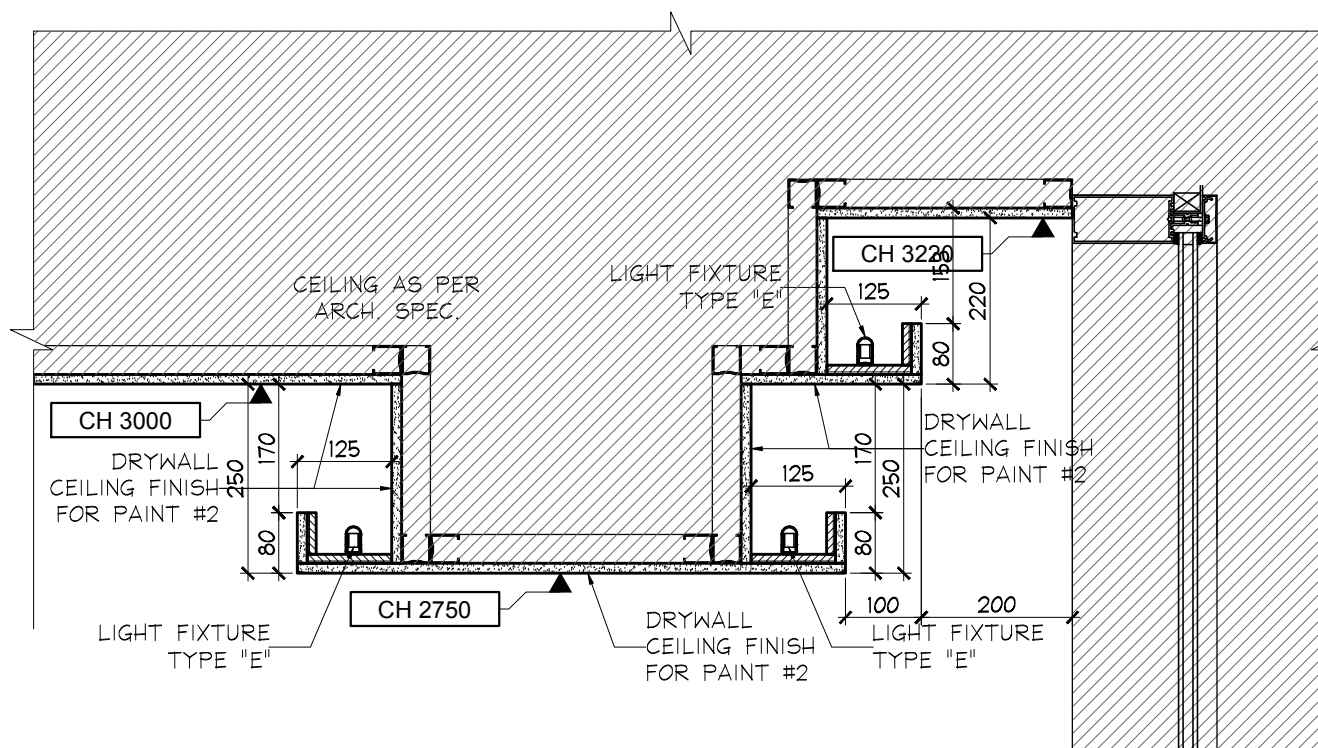


18 CEILING SECTION
FITNESS AREA
1ST FLOOR
SCALE 1:10

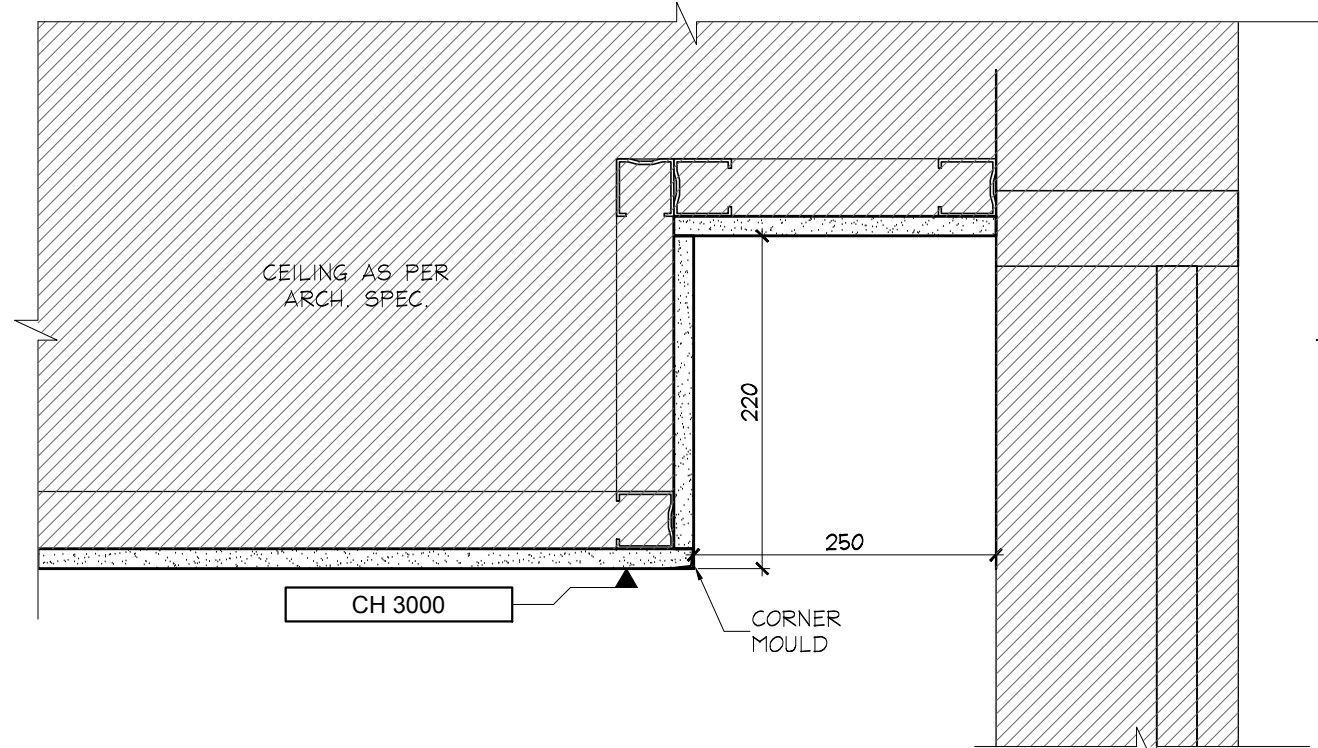


4 SECTION □ EXTERIOR GLAZING
1ST FLOOR
SCALE 1:5

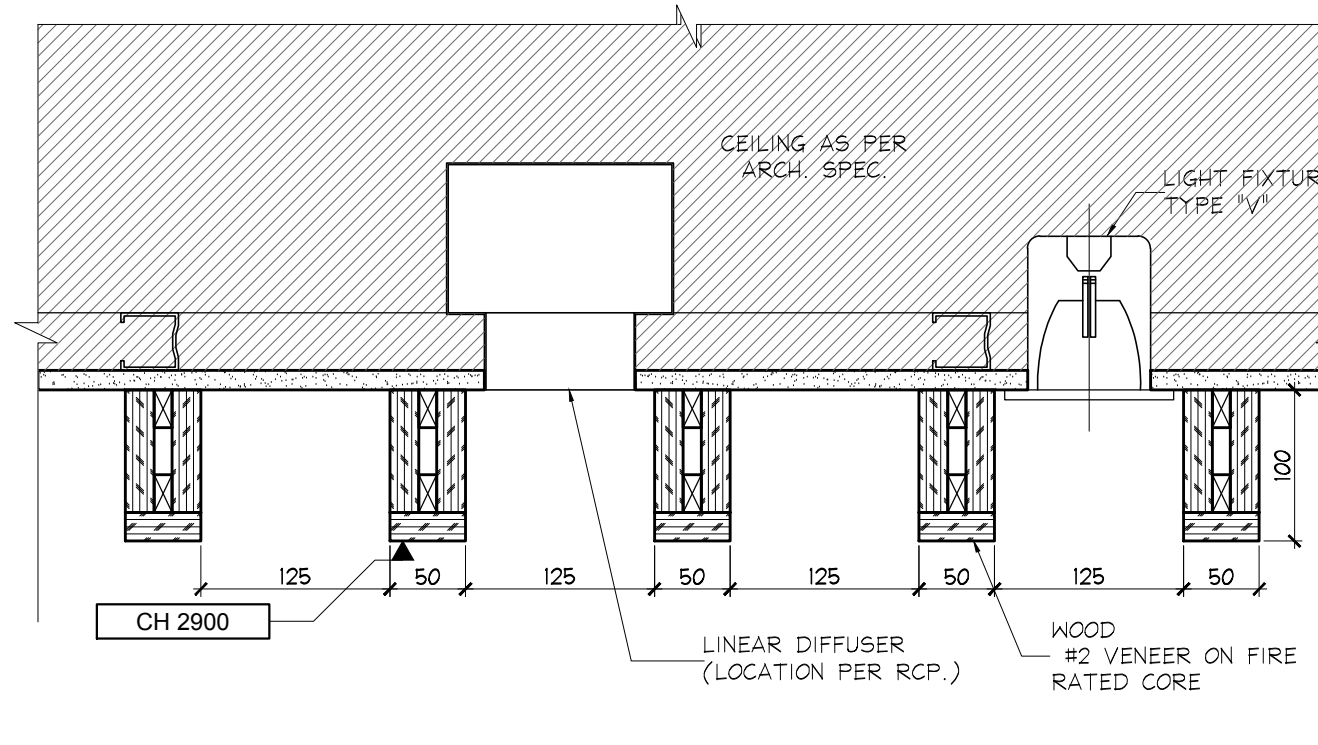


9 SECTION
CEILING DETAIL □ CONCIERGE
1ST FLOOR
SCALE 1:5

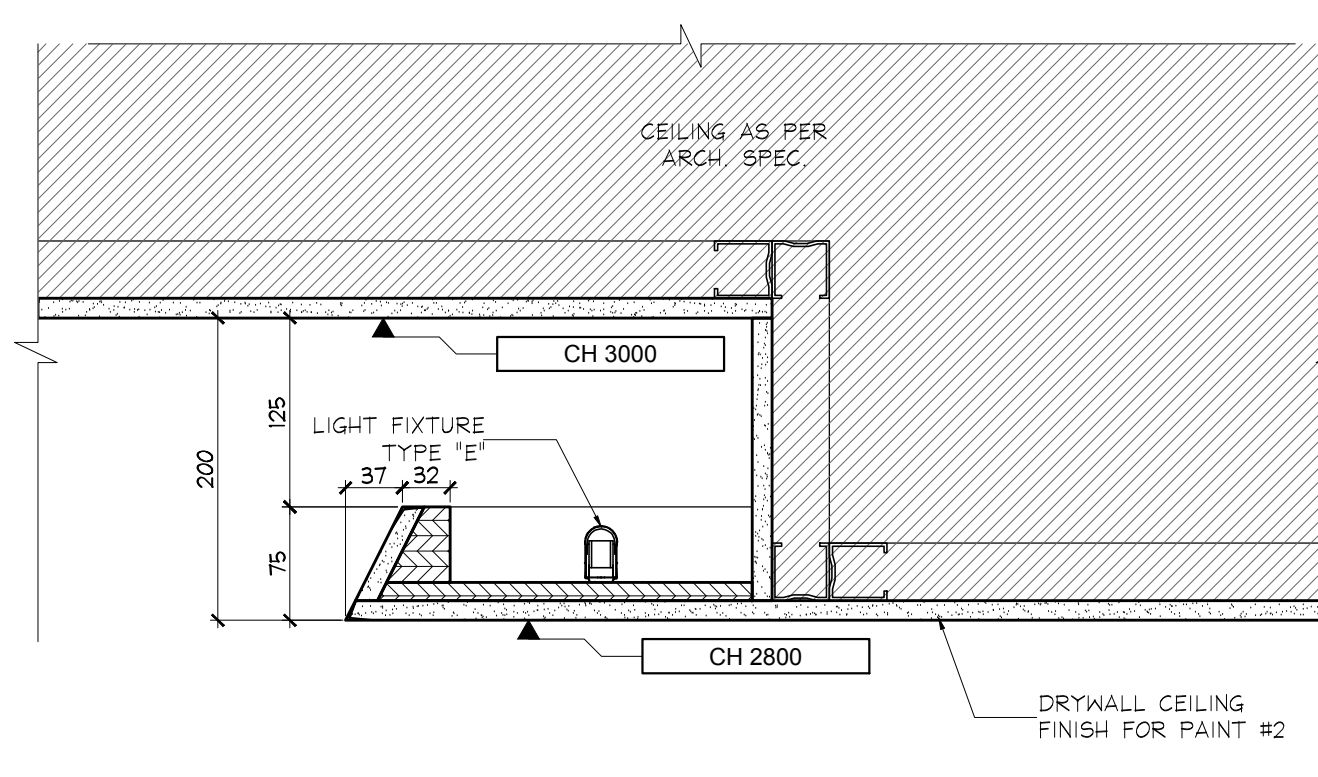


14 CEILING SECTION
PARTY ROOM
1ST FLOOR
SCALE 1:5

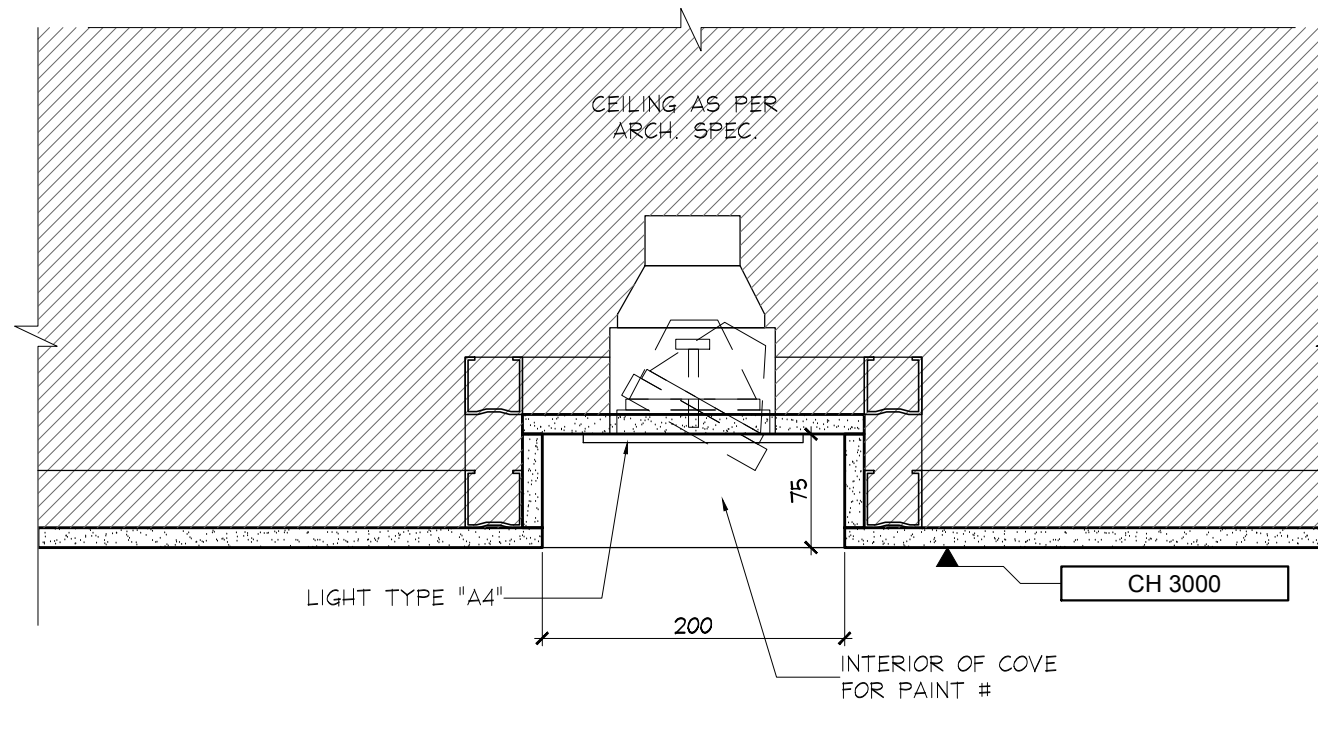


19 CEILING SECTION
FITNESS AREA
1ST FLOOR
SCALE 1:5

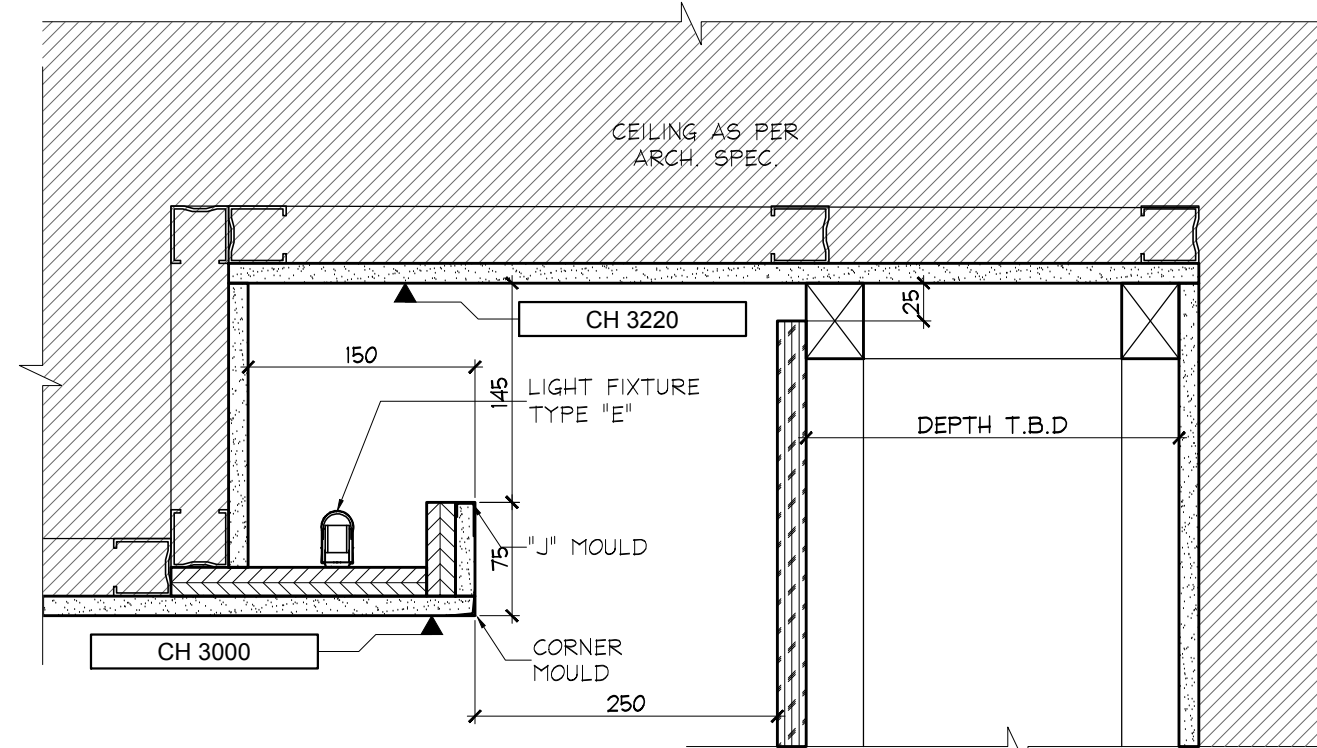


5 SECTION □ FIREPLACE
1ST FLOOR
SCALE 1:5

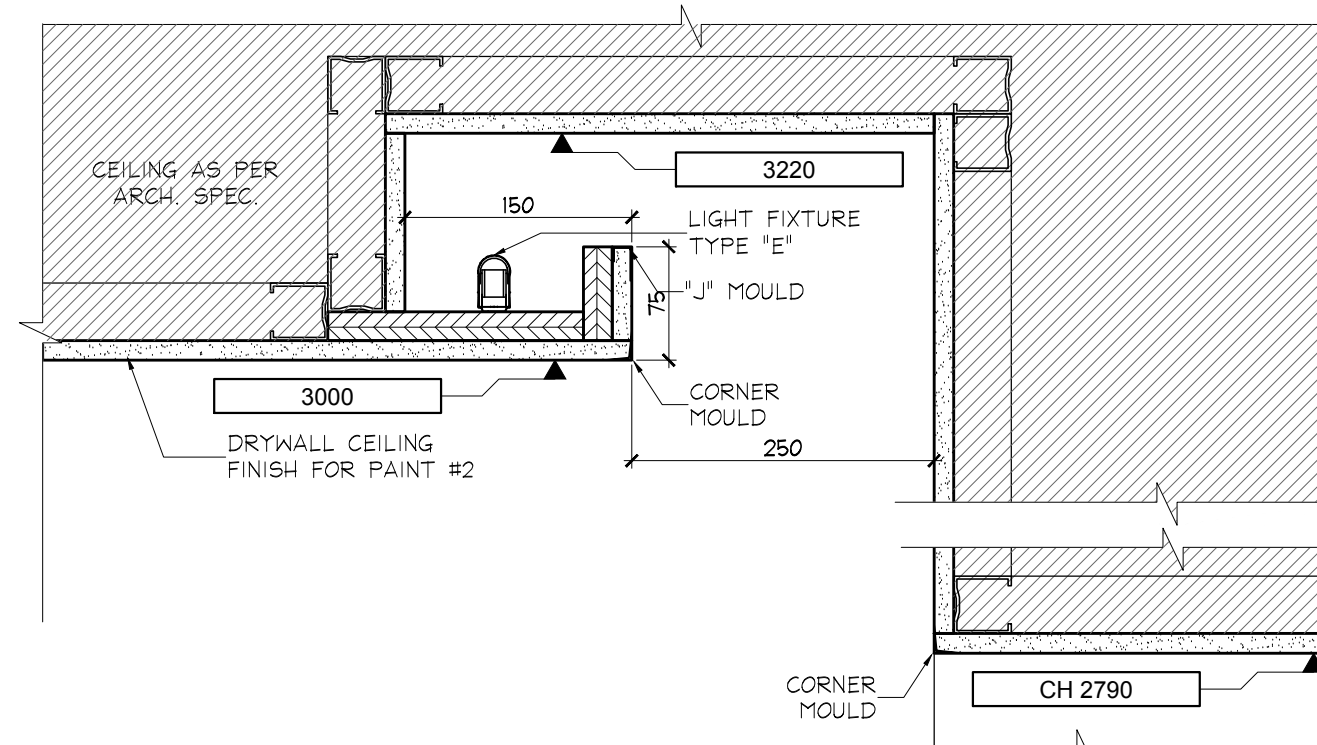

10 SECTION
1ST FLOOR
SCALE 1:5

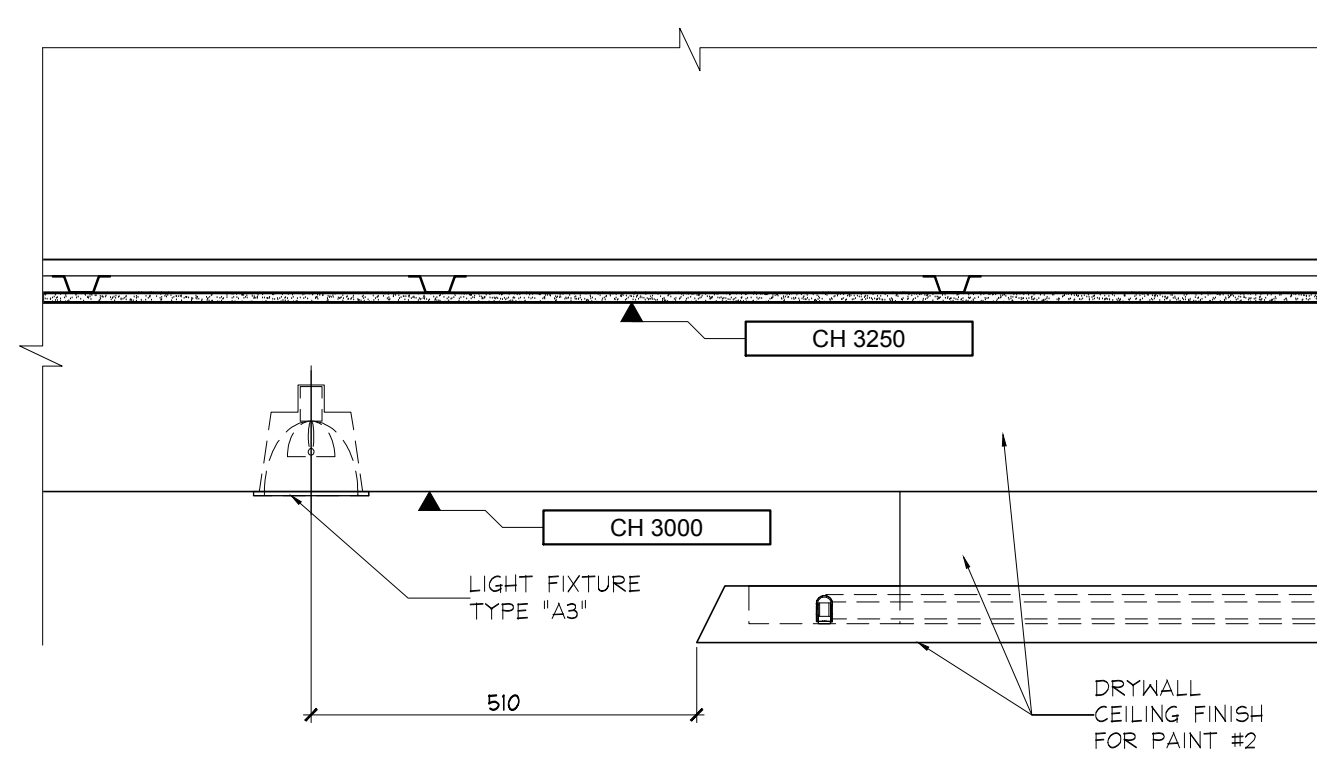

15 CEILING SECTION
PARTY ROOM
1ST FLOOR
SCALE 1:10

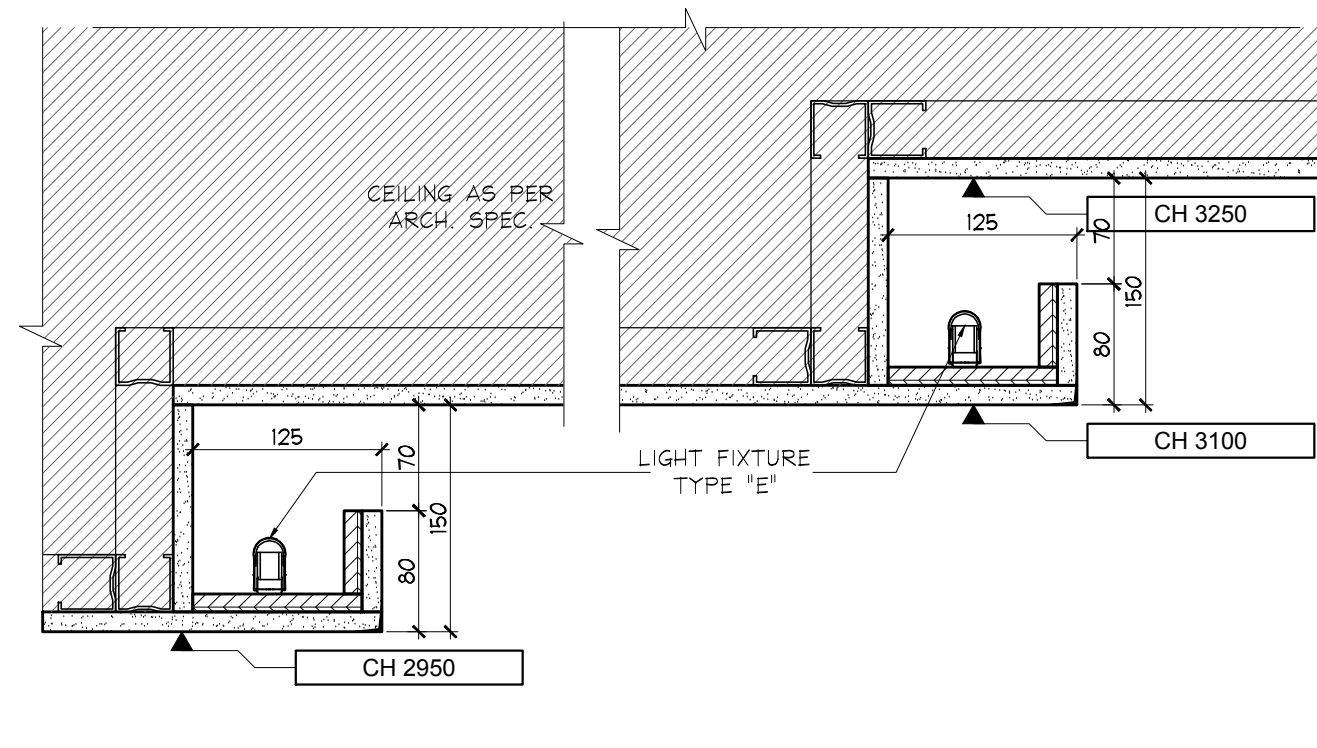

20 CEILING SECTION
THEATRE
1ST FLOOR
SCALE 1:5

DO NOT SCALE DRAWINGS.

CONTRACTOR MUST VERIFY ALL DRAWINGS, DIMENSIONS, DETAILS AND SPECIFICATIONS. AND REPORT ANY DISCREPANCIES TO UNION 31 INC. BEFORE PROCEEDING WITH WORK. MATERIALS MAY NOT BE SUBSTITUTED WITHOUT WRITTEN APPROVAL FROM UNION 31 INC.

ALL DRAWINGS AND SPECIFICATIONS ARE INSTRUMENTS OF SERVICE AND THE PROPERTY OF UNION 31 INC. WHICH MUST BE RETURNED AT THE COMPLETION OF THE WORK.

PRINTED: 30-May-17

ISSUED FOR
AS-BUILT

01	31 MAY / 17	ISSUED FOR AS-BUILT	SV
NO.	DATE	COMMENTS	INI


REVISIONS:

UNION 31


UNION31 INC.
183 BATHURST STREET, STE. 201
TORONTO, ON, M5T 2R7, CANADA
TEL: 416-597-1576 FAX: 416-597-2139

PROJECT NAME:	ALEXANDRA PARK MAIN BUILDING
BLOCK 11	ON, Canada
PROJECT NO.:	13-949
DRAWINGS:	CEILING DETAILS

DATE STARTED:	07 AUG / 13	DRAWING NO.:	ID
SCALE:	AS NOTED		3.1.0
DRAWN BY:	GG		
APPROVED BY:	KC		

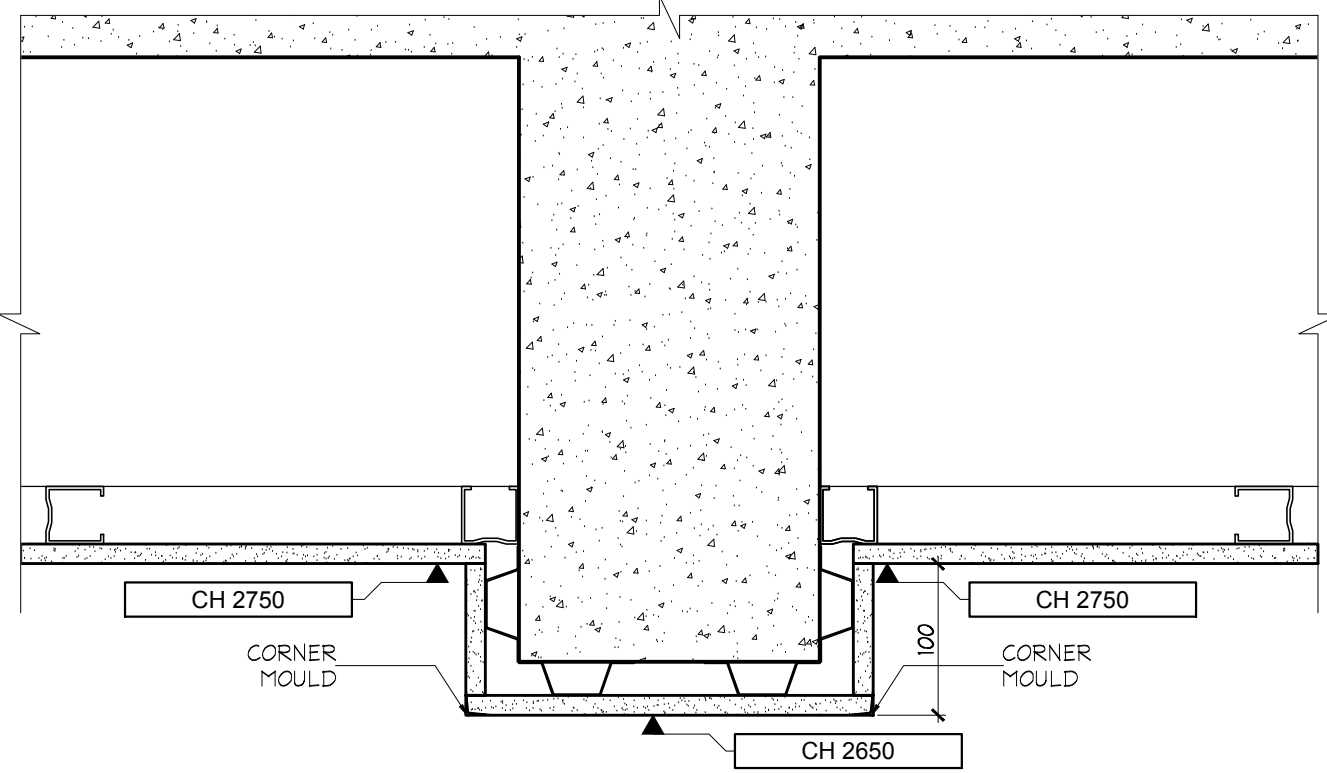

1
03.1.1 CEILING SECTION
CORRIDOR A □ GRIDLINE H □ SCALE 1:5
2ND FLOOR

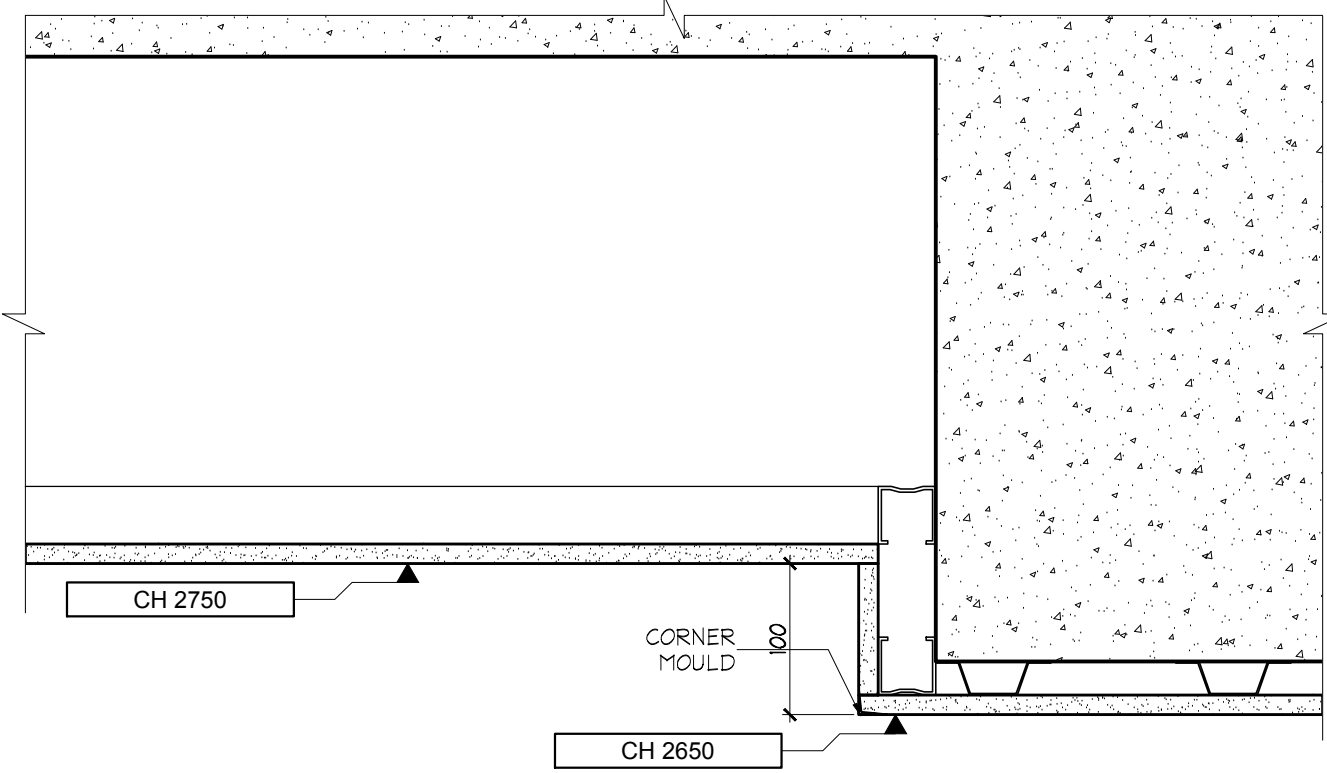

2
03.1.1 CEILING SECTION
CORRIDOR B □ GRIDLINE B □ SCALE 1:5
2ND FLOOR

DO NOT SCALE DRAWINGS.

CONTRACTOR MUST VERIFY ALL DRAWINGS, DIMENSIONS, DETAILS AND SPECIFICATIONS AND REPORT ANY DISCREPANCIES TO UNION 31 INC. BEFORE PROCEEDING WITH WORK. MATERIALS MAY NOT BE SUBSTITUTED WITHOUT WRITTEN APPROVAL FROM UNION 31 INC.


ALL DRAWINGS AND SPECIFICATIONS ARE INSTRUMENTS OF SERVICE AND THE PROPERTY OF UNION 31 INC. WHICH MUST BE RETURNED AT THE COMPLETION OF THE WORK.

PRINTED: 30-May-17

ISSUED FOR
AS-BUILT

01	31 MAY / 17	ISSUED FOR AS-BUILT	SV
NO.	DATE	COMMENTS	INI

REVISIONS:

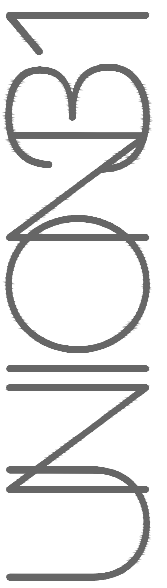

UNION31 INC.
183 BATHURST STREET, STE. 201
TORONTO, ON, M5T 2R7, CANADA
TEL: 416-597-1576 FAX: 416-597-2139

PROJECT NAME:	ALEXANDRA PARK MAIN BUILDING
BLOCK 11	ON, Canada
PROJECT NO.:	13-949
DRAWING'S:	

CEILING DETAILS

DATE STARTED:	07 AUG / 13	DRAWING NO.:	ID
SCALE:	AS NOTED		3.1.1
DRAWN BY:	GG		
APPROVED BY:	KC		


DO NOT SCALE DRAWINGS.

CONTRACTOR MUST VERIFY ALL DRAWINGS, DIMENSIONS, DETAILS AND SPECIFICATIONS AND REPORT ANY DISCREPANCIES TO UNION 31 INC. BEFORE PROCEEDING WITH WORK. MATERIALS MAY NOT BE SUBSTITUTED WITHOUT WRITTEN APPROVAL FROM UNION 31 INC.

ALL DRAWINGS AND SPECIFICATIONS ARE INSTRUMENTS OF SERVICE AND THE PROPERTY OF UNION 31 INC. WHICH MUST BE RETURNED AT THE COMPLETION OF THE WORK.

PRINTED: 30-M8-17

ISSUED FOR
AS-BUILT

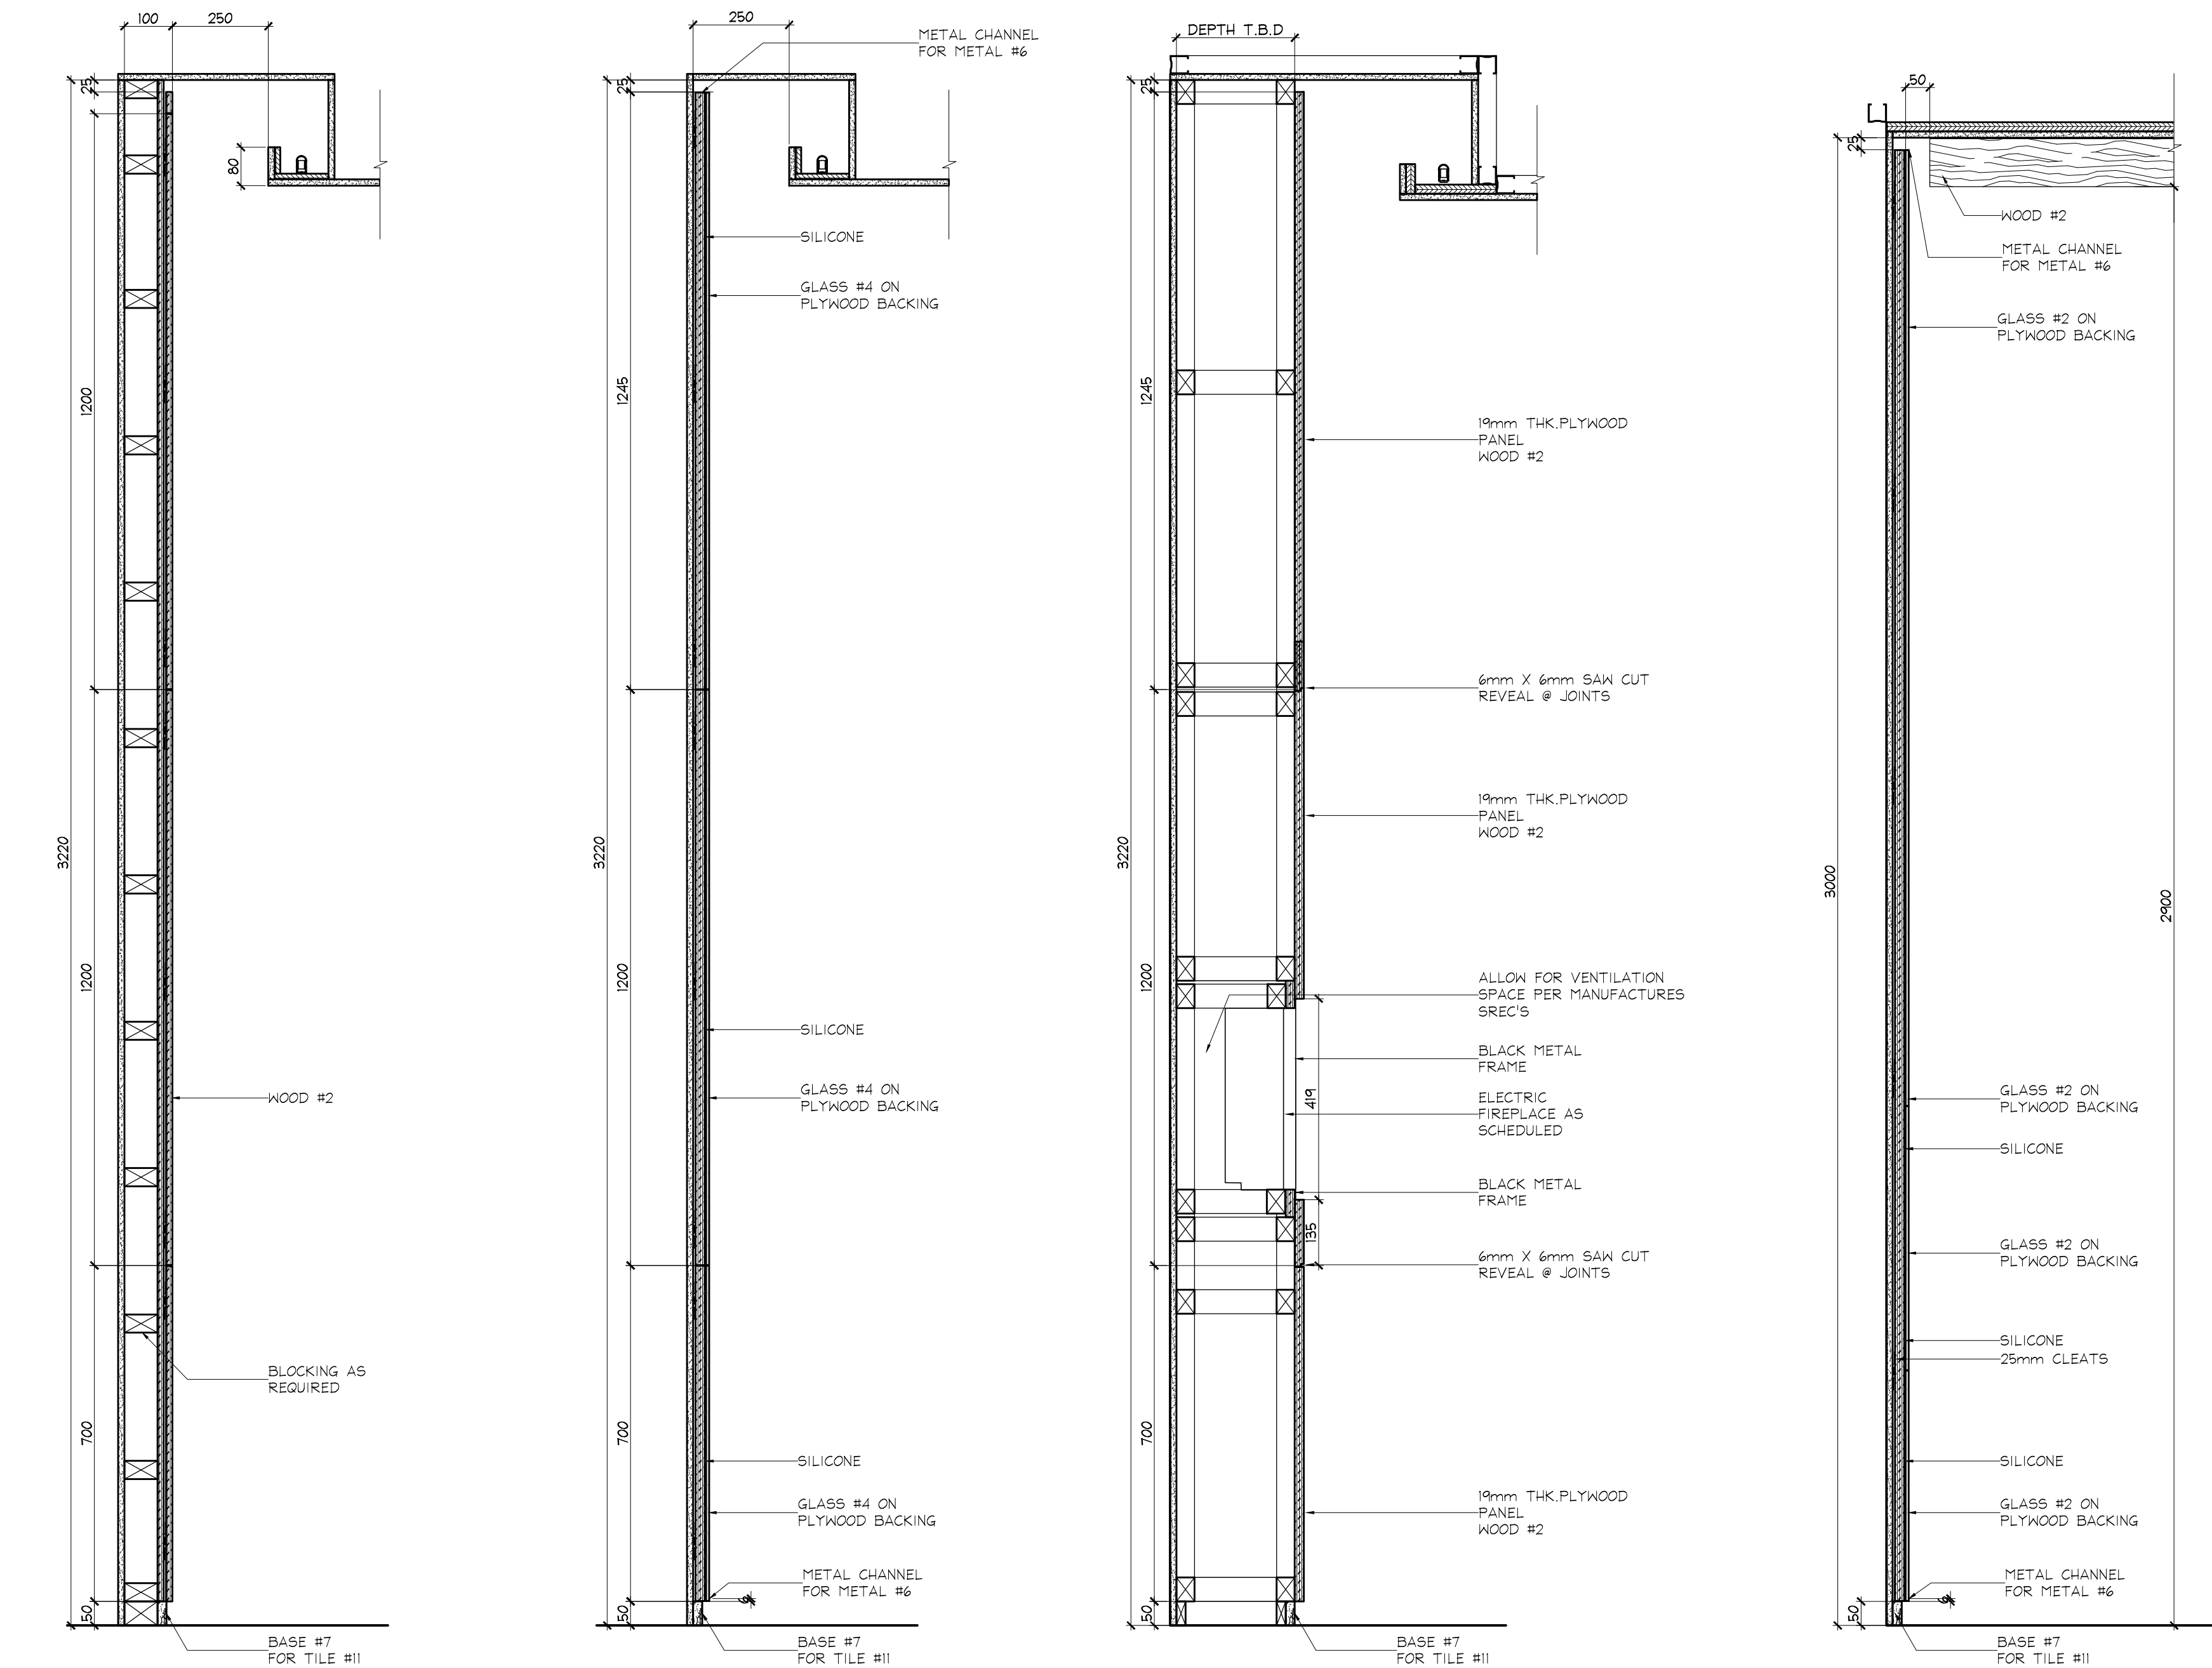

1 WALL SECTION
1ST FLOOR LOBBY
SCALE 1:10

2 WALL SECTION
1ST FLOOR LOBBY
SCALE 1:10

3 WALL SECTION □ LOBBY FIREPLACE
1ST FLOOR LOBBY
SCALE 1:10

4 WALL SECTION
1ST FLOOR LOBBY
SCALE 1:10



5 WALL SECTION □ TV BEHIND CONCERGE
1ST FLOOR LOBBY
SCALE 1:10

6 WALL SECTION
1ST FLOOR MAILROOM
SCALE 1:10

7 WALL SECTION
1ST FLOOR MAILROOM
SCALE 1:10


OMITTED

OMITTED

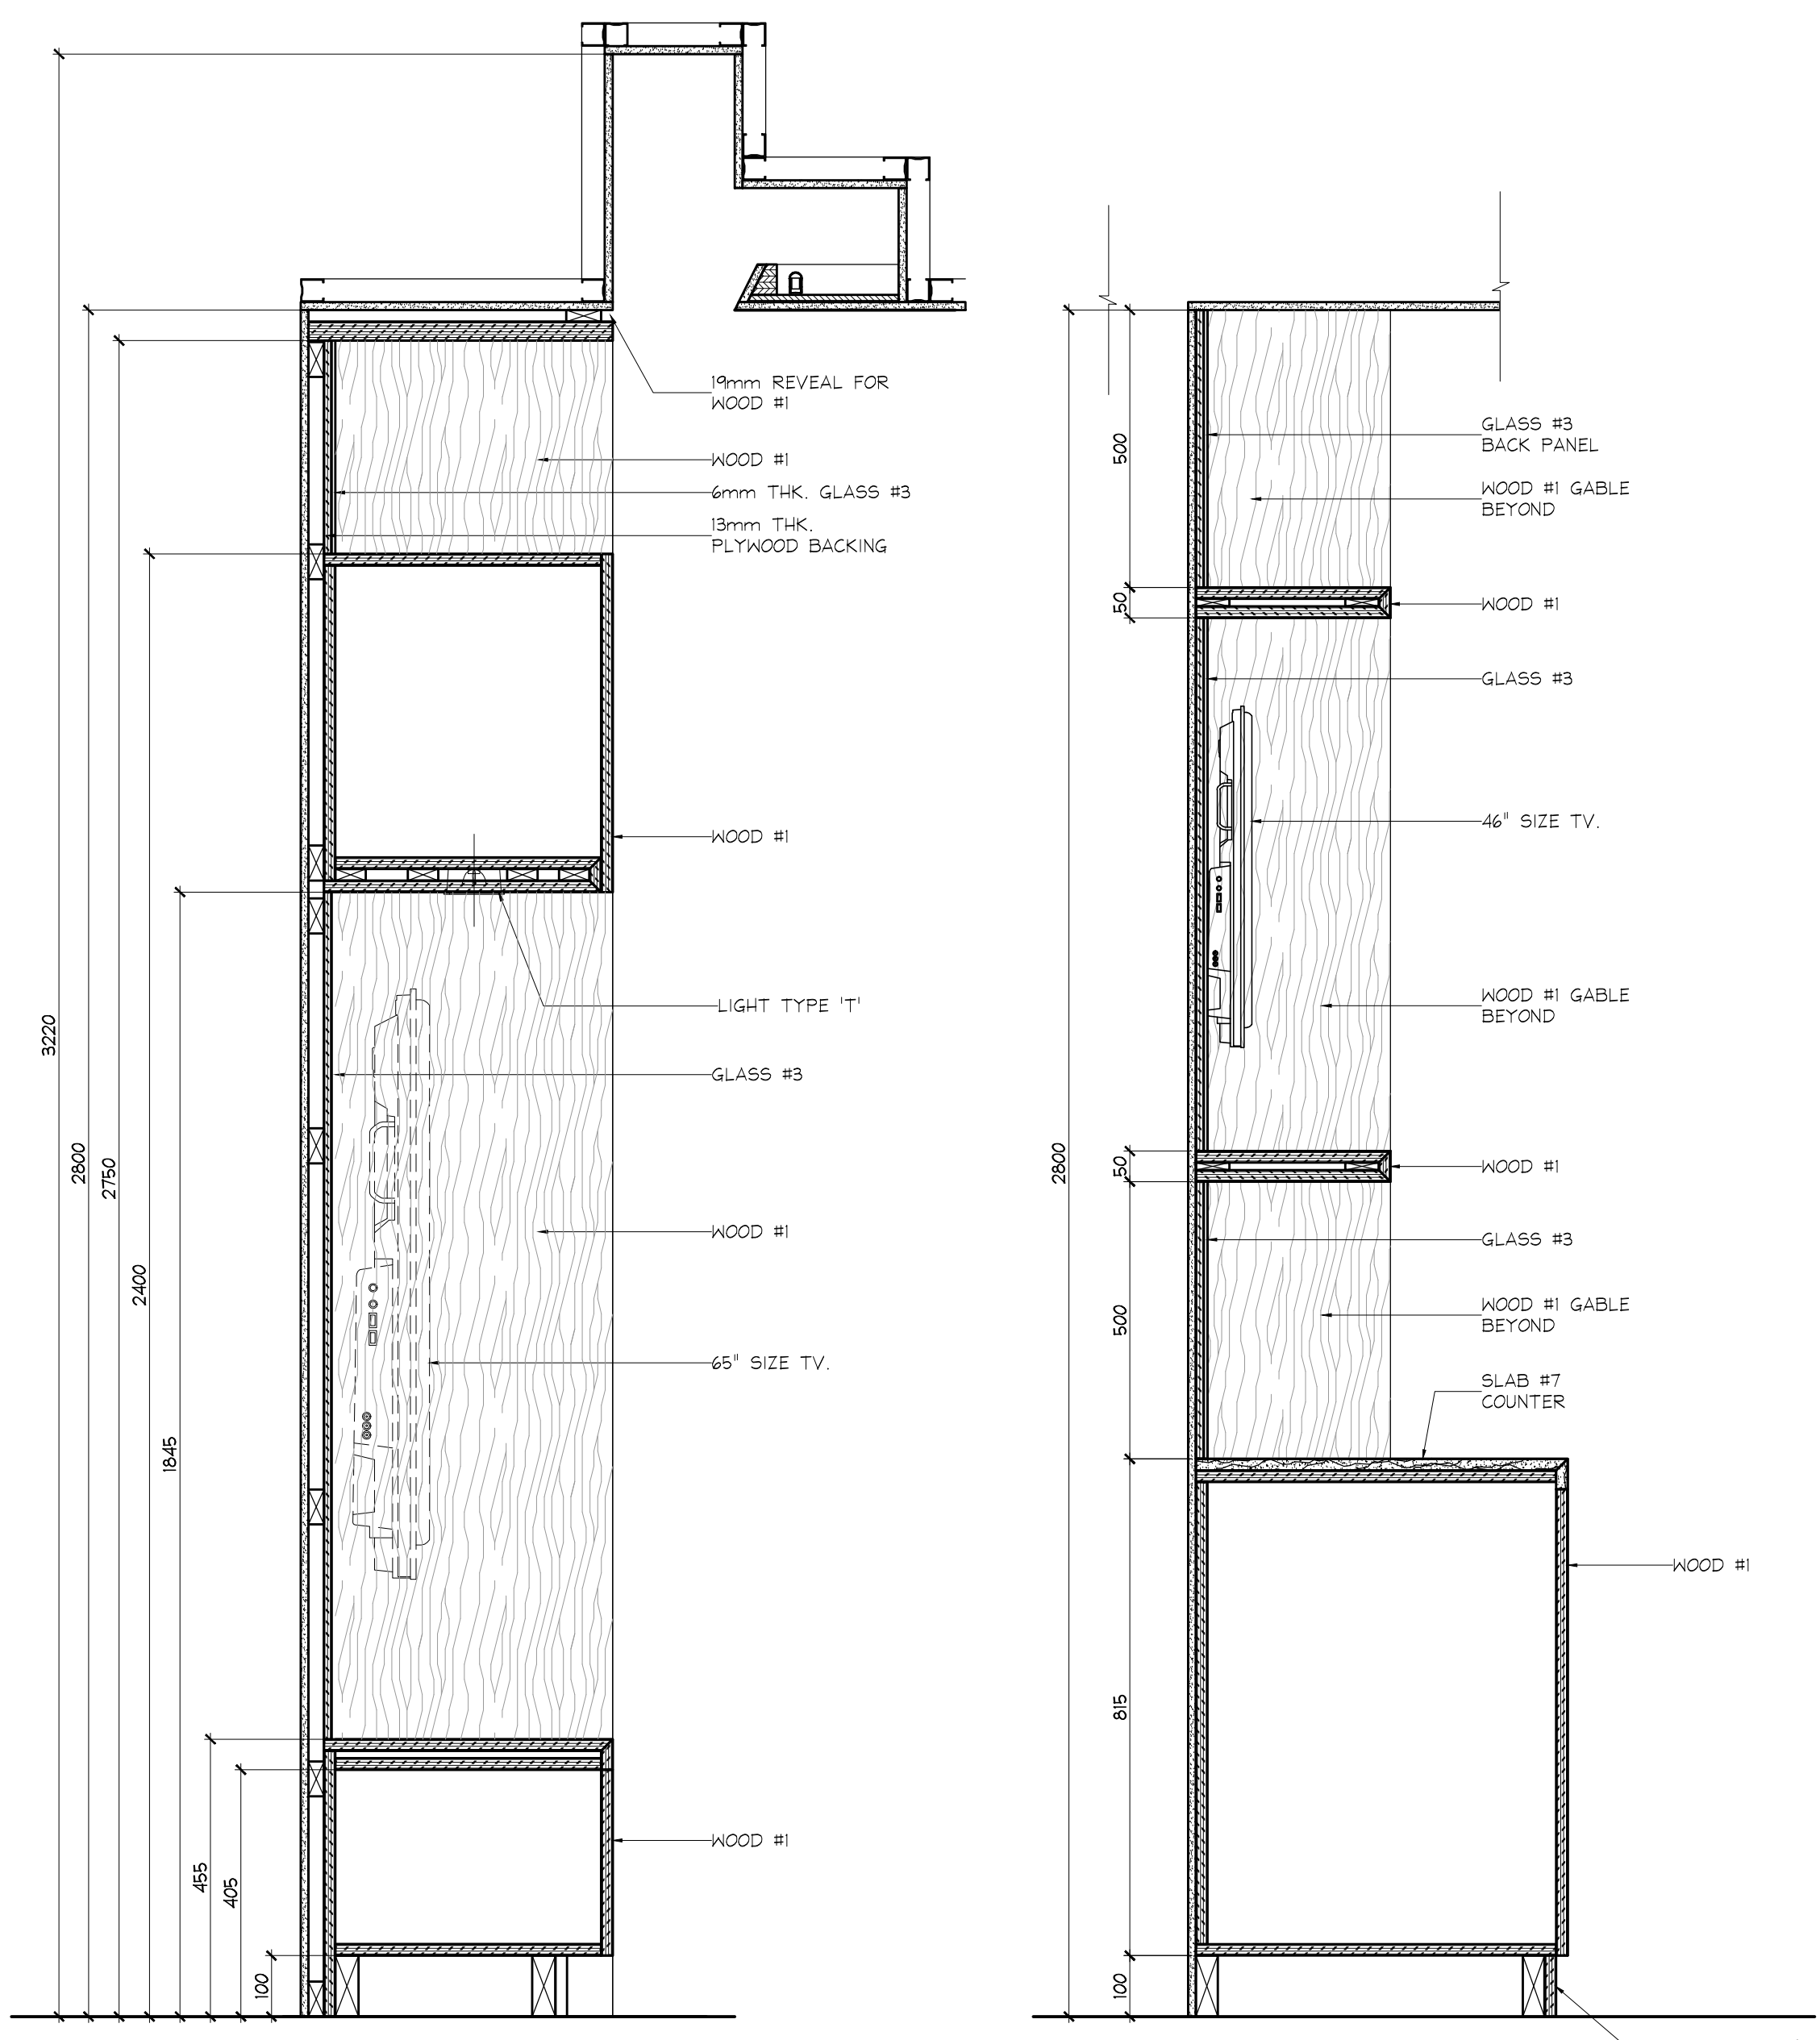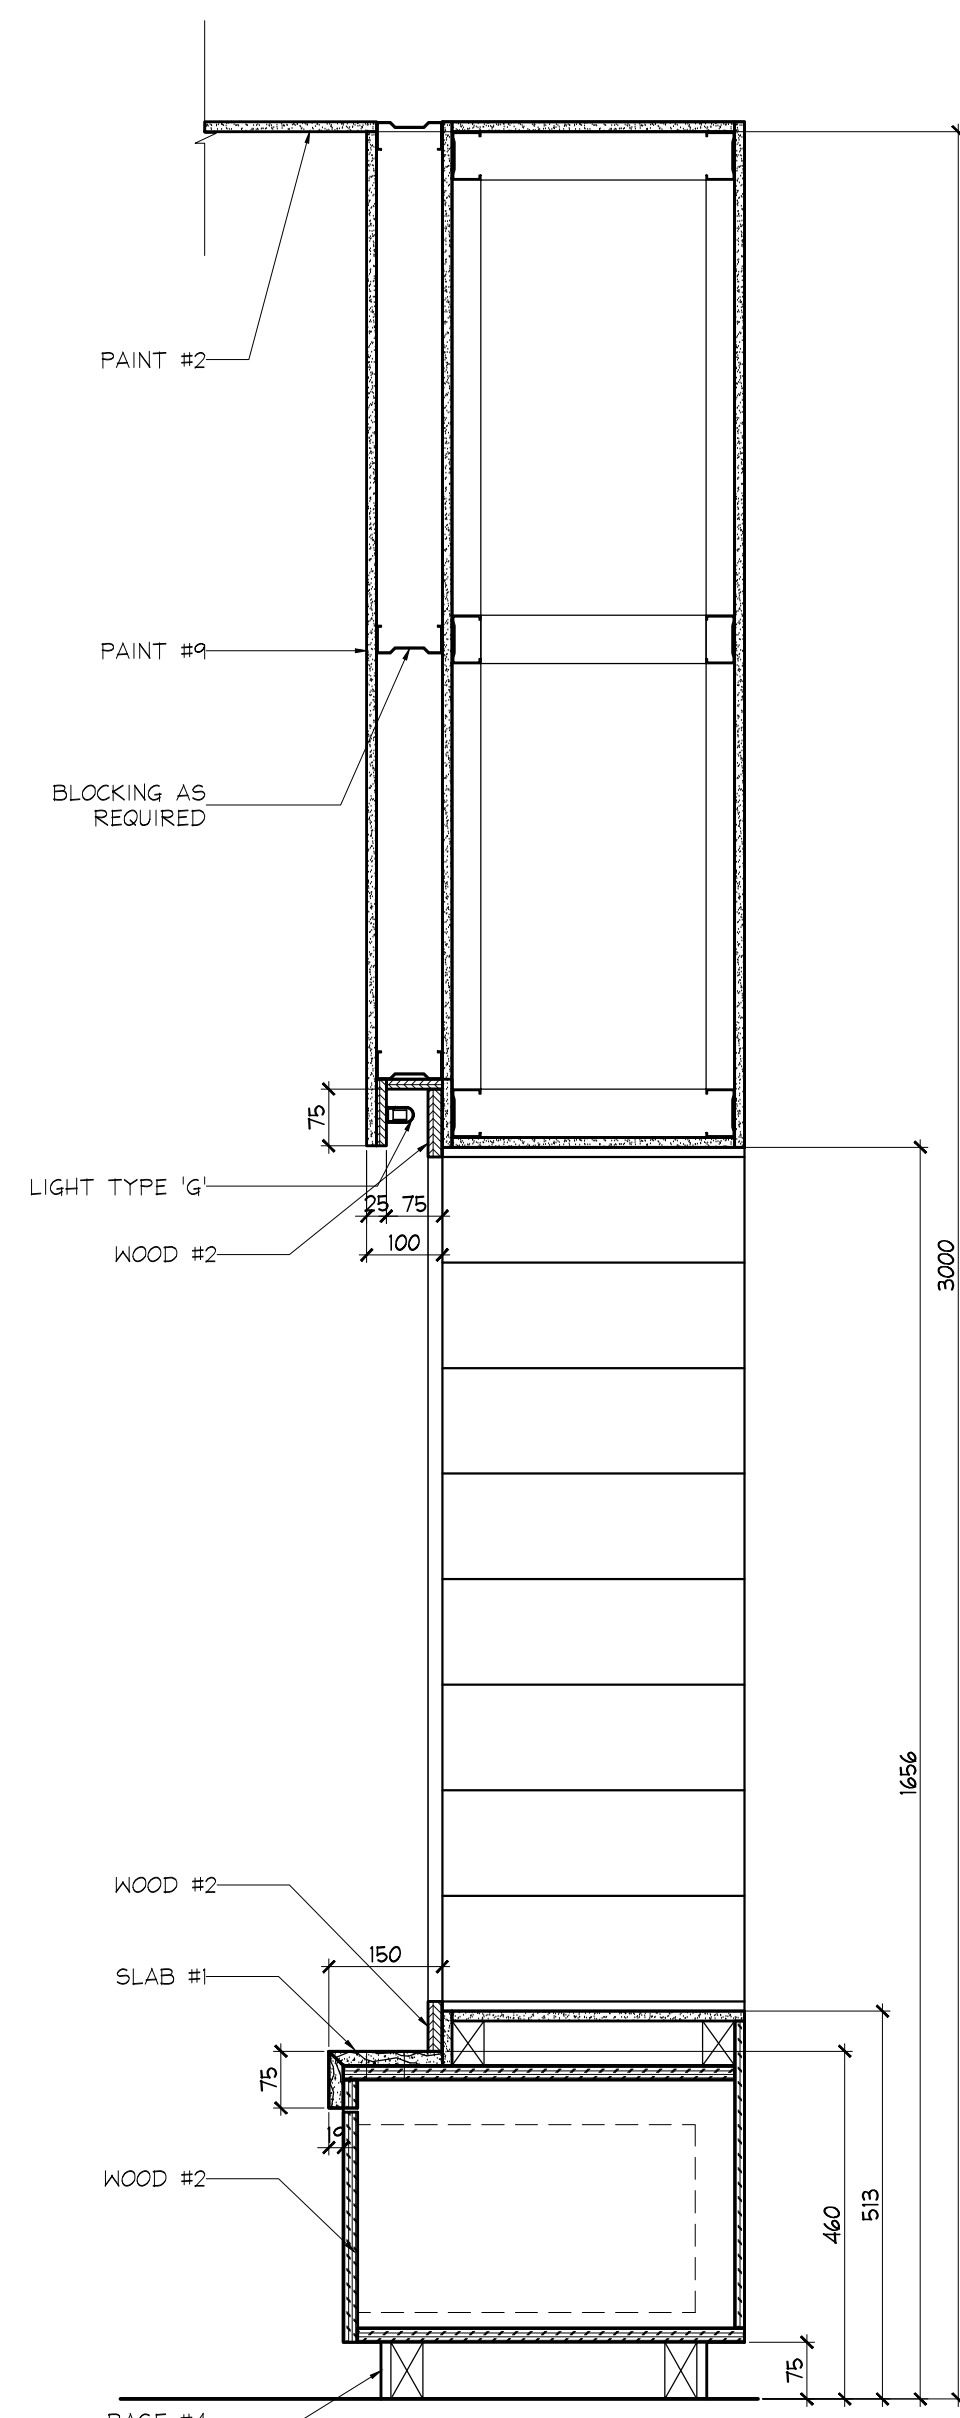


8 WALL SECTION
1ST FLOOR PARTY ROOM
SCALE 1:10


9 WALL SECTION □ TV
1ST FLOOR PARTY ROOM
SCALE 1:10

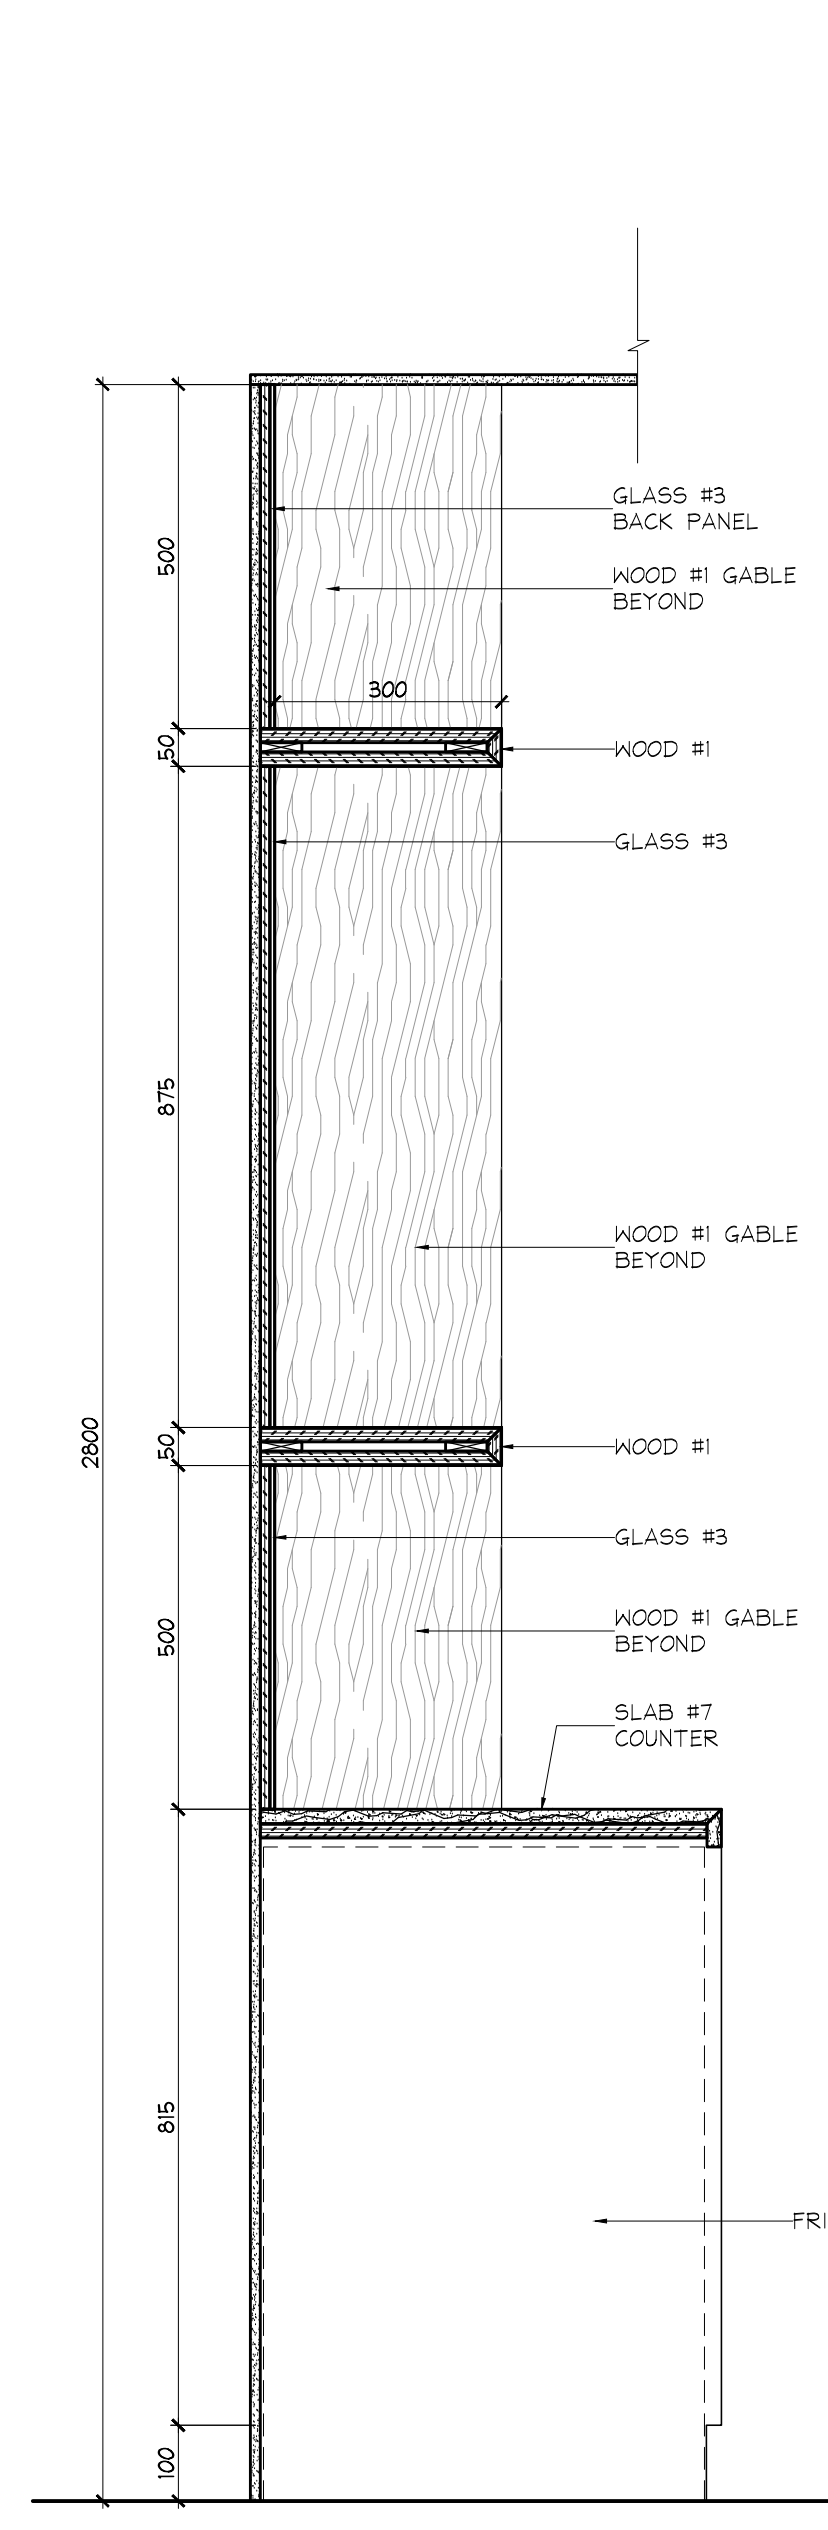

10 WALL SECTION
1ST FLOOR PARTY ROOM
SCALE 1:10

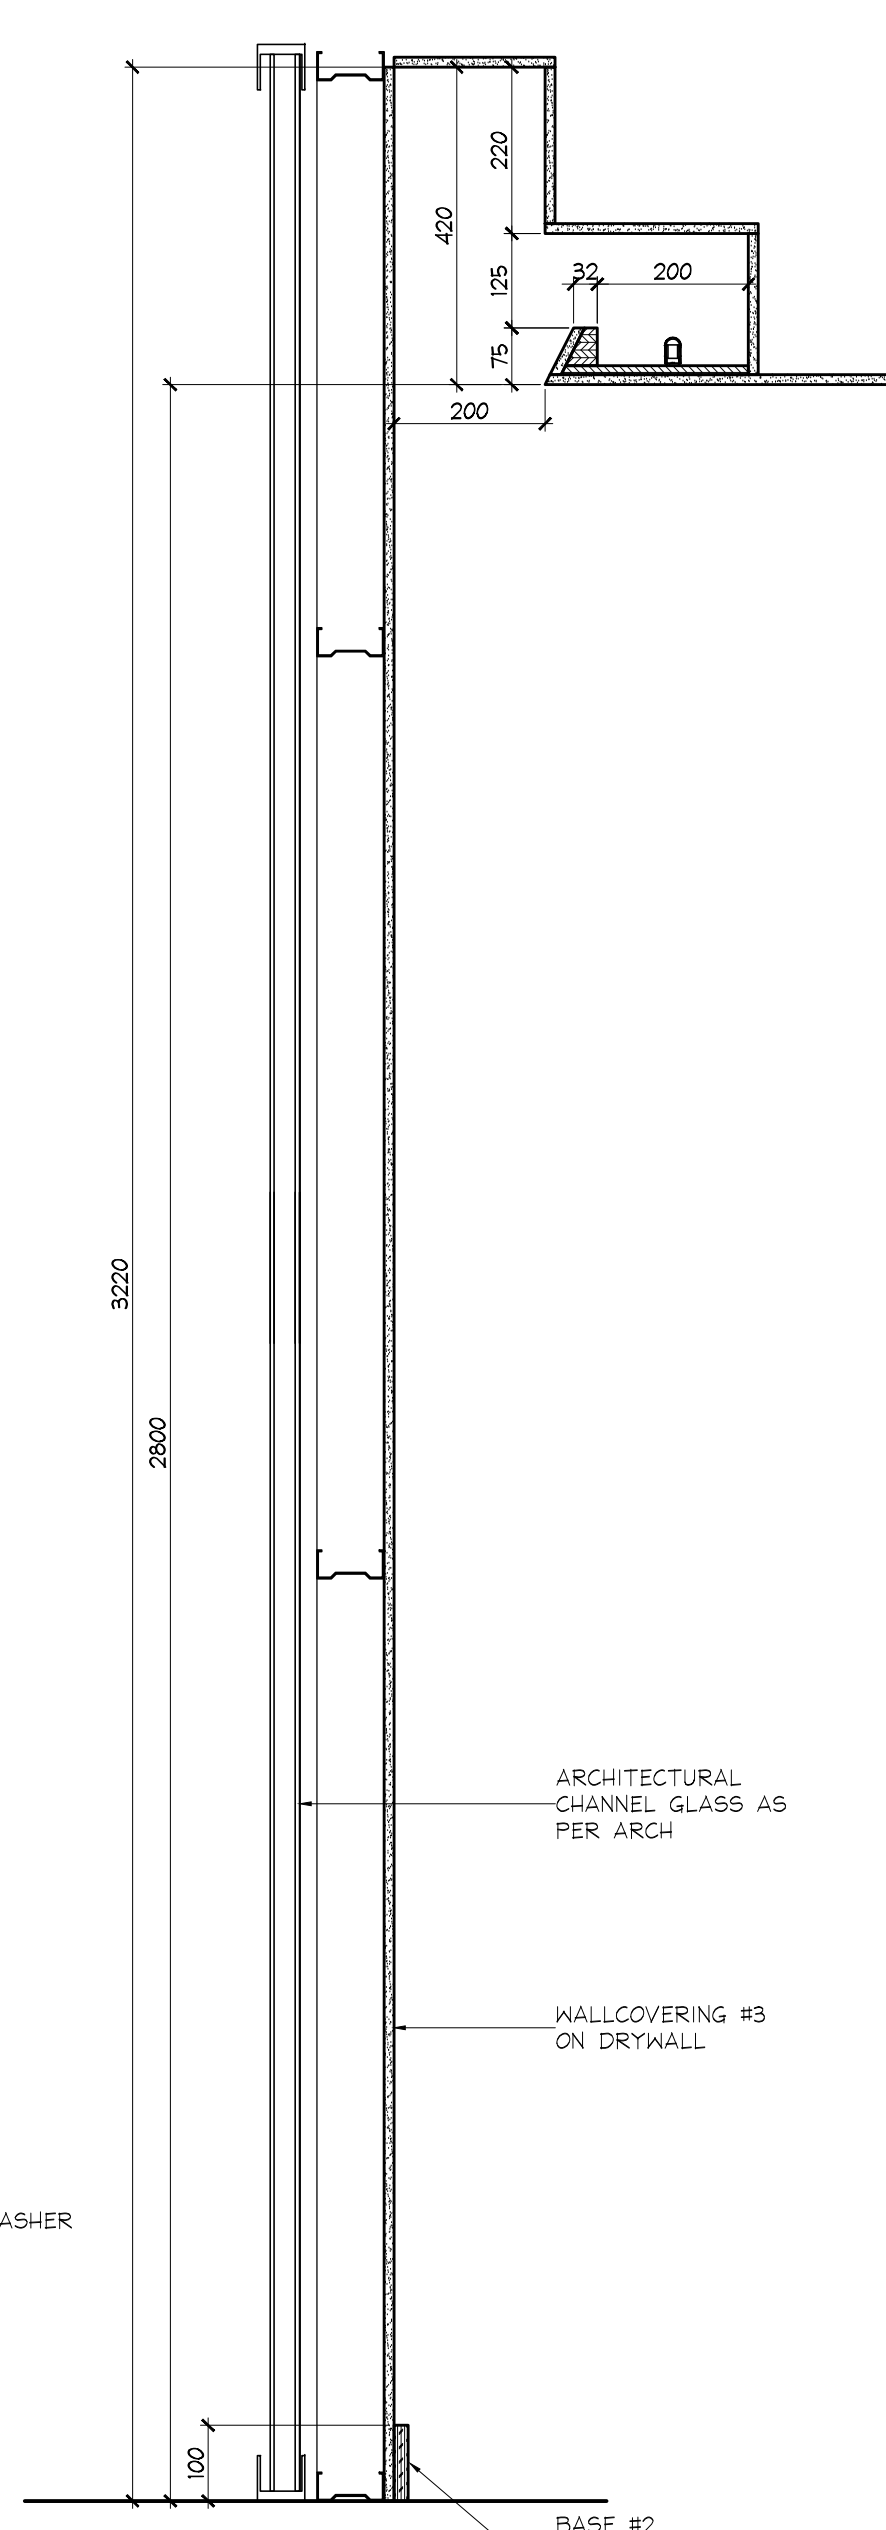


11 WALL SECTION
1ST FLOOR PARTY ROOM
SCALE 1:10

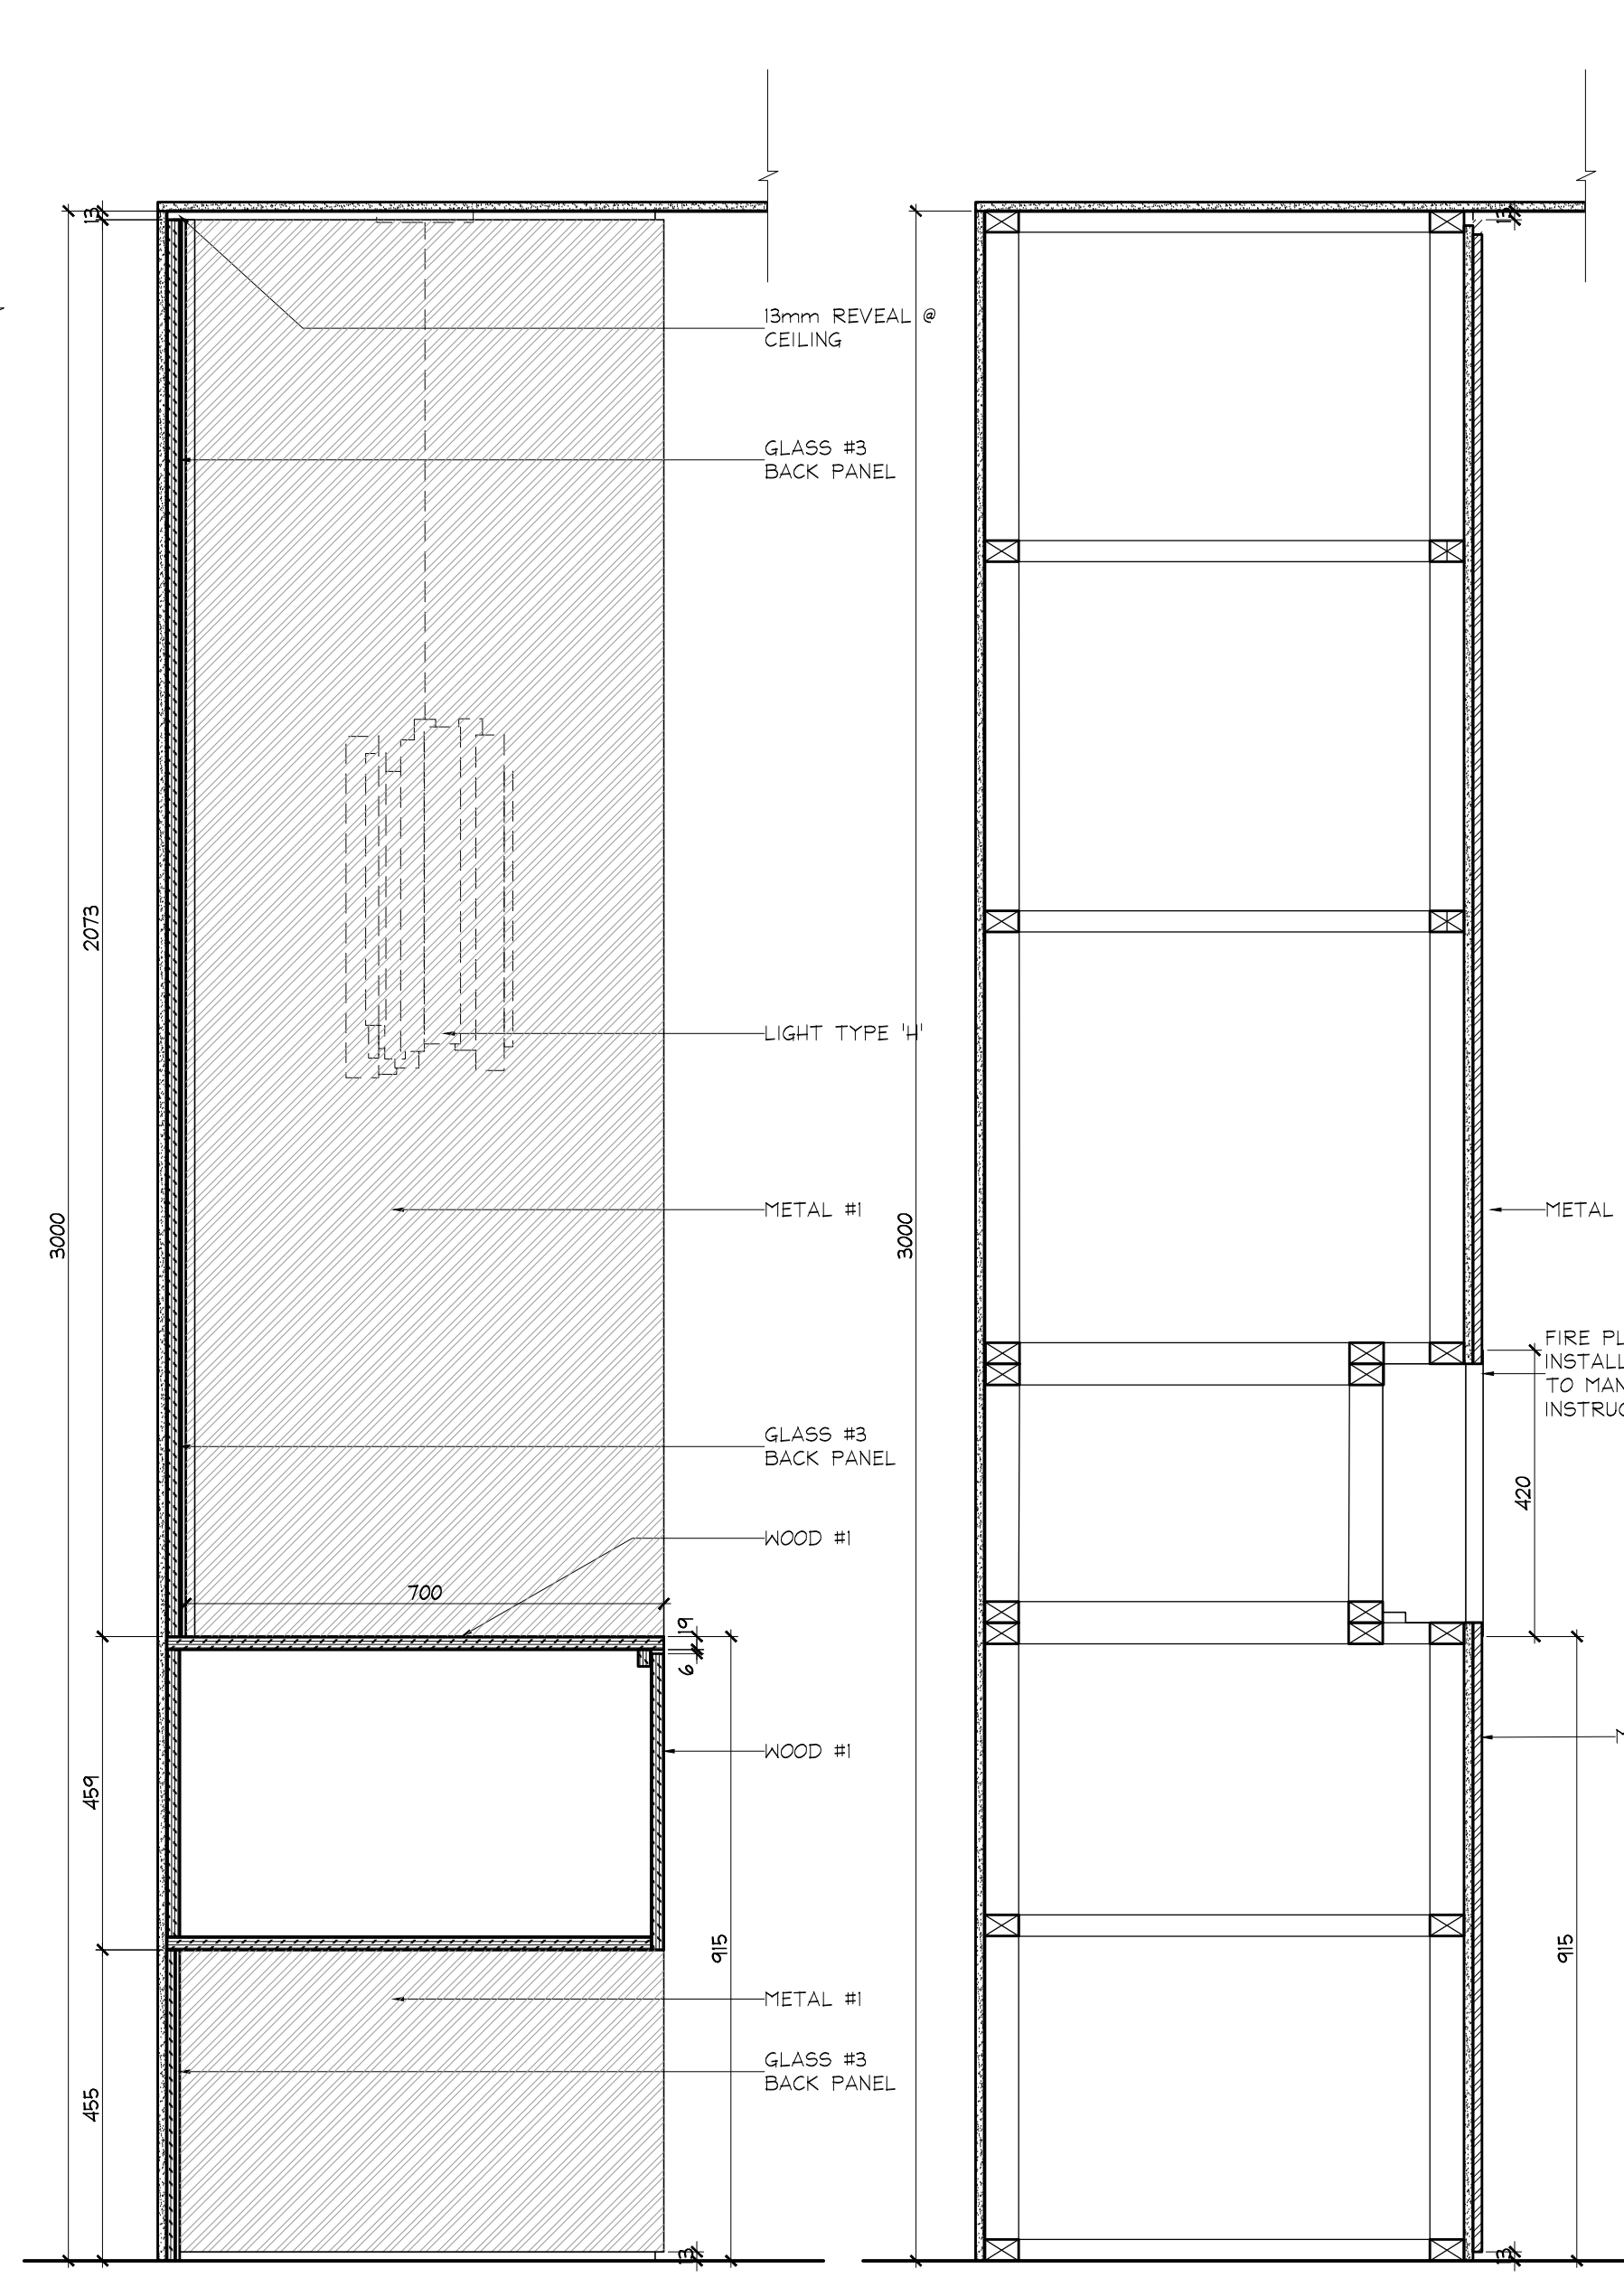

12 SECTION □ MIRROR
1ST FLOOR DINING ROOM
SCALE 1:10

13 SECTION □ FIRE PLACE
1ST FLOOR DINING ROOM
SCALE 1:10

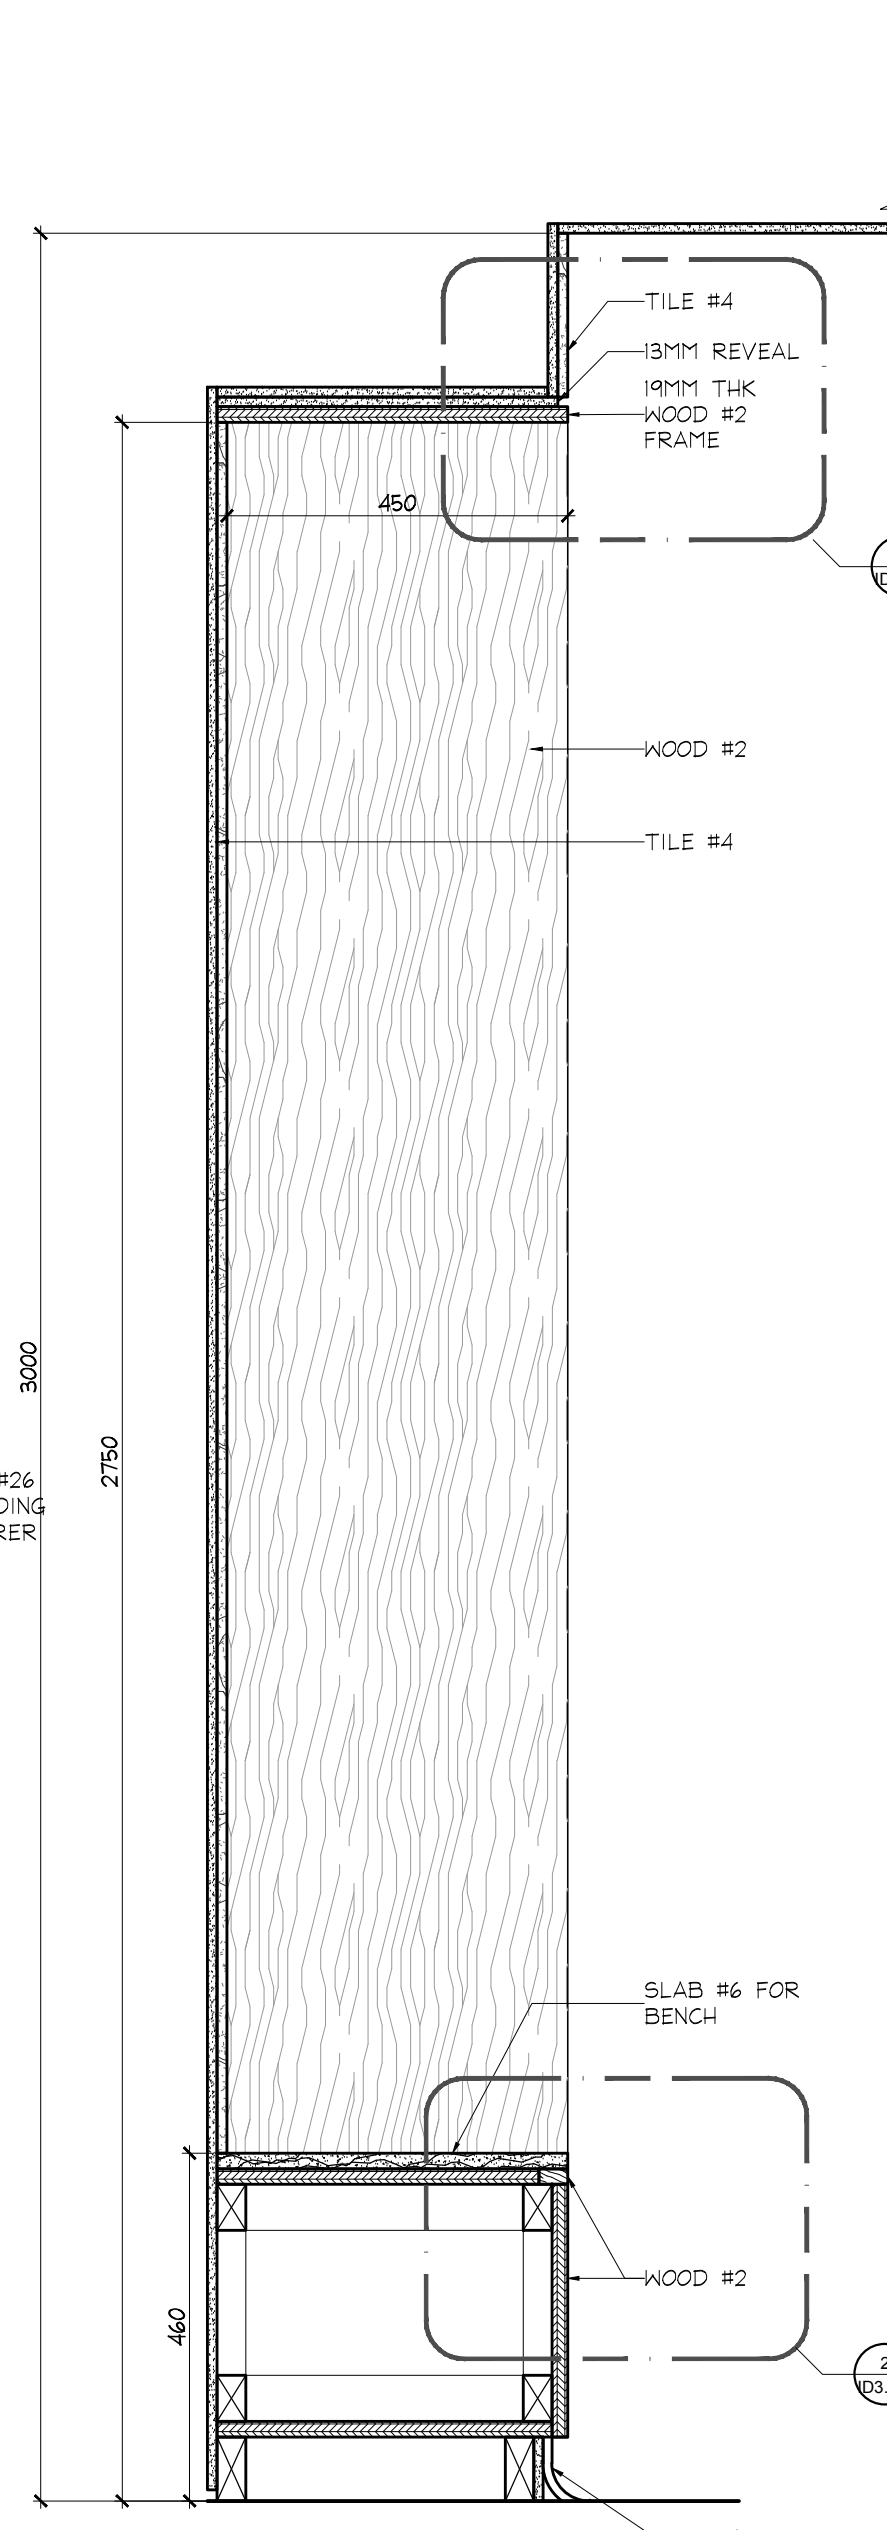

14 SECTION □ BENCH
1ST FLOOR CHANGE ROOMS
SCALE 1:10

15 SECTION □ BENCH
1ST FLOOR CHANGE ROOMS
SCALE 1:10

OMITTED

01	31 MAY / 17	ISSUED FOR AS-BUILT	SV
NO.	DATE	COMMENTS	INI
REVISIONS:			


UNION31

UNION31 INC.
183 BATHURST STREET, STE. 201
TORONTO, ON, M5T 2R7, CANADA
TEL: 416-597-1576 FAX: 416-597-2139


PROJECT NAME:	
ALEXANDRA PARK MAIN BUILDING	
BLOCK 11 ON, Canada	
PROJECT NO.:	13-949
DRAWINGS:	
WALL SECTIONS	

DATE STARTED:	07 AUG / 13	DRAWING NO.:	
SCALE:	AS NOTED	ID	3.2.0
DRAWN BY:	SM		
APPROVED BY:	KC		


1
ID3.2.1
DETAIL
BENCH
CHANGE ROOMS
SCALE 1:5

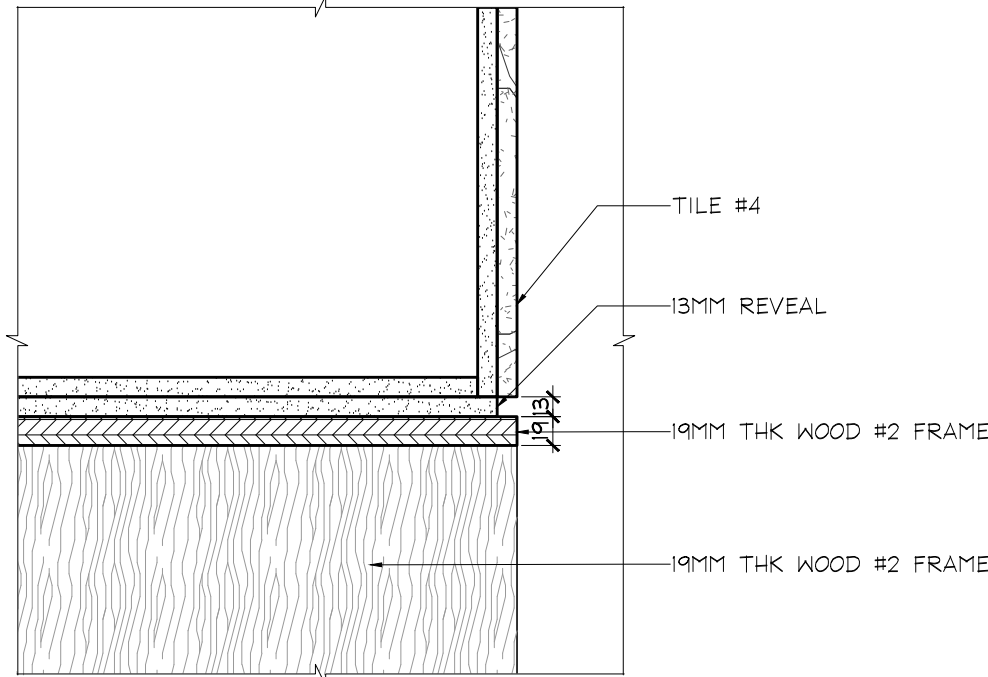


2
ID3.2.1
DETAIL
BENCH
CHANGE ROOMS
SCALE 1:5

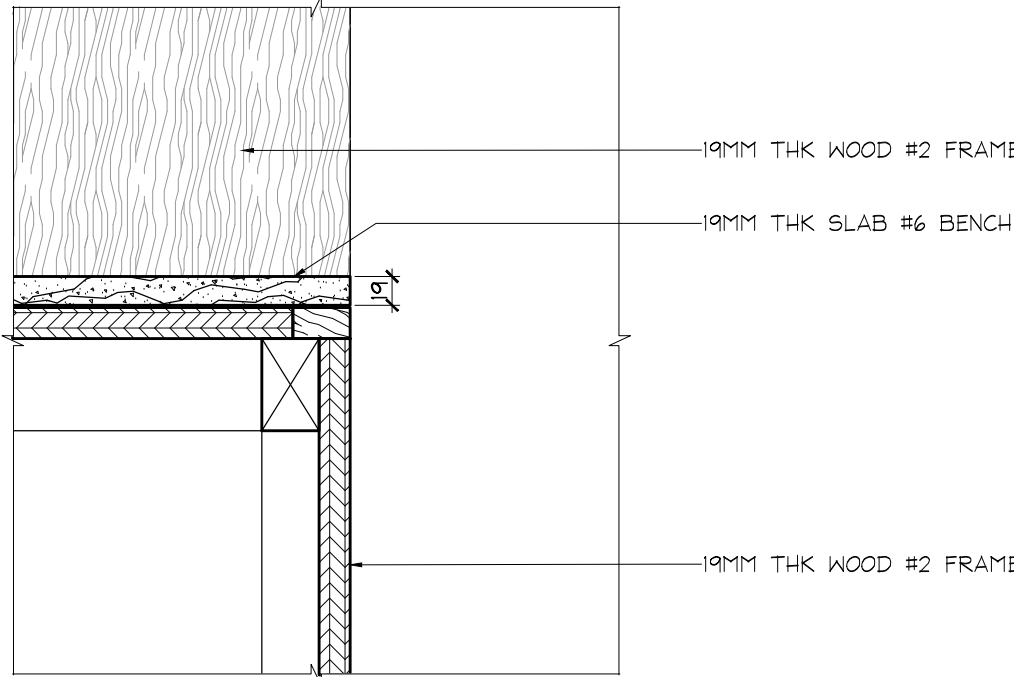

3
ID3.2.1
DETAIL
BENCH
FITNESS
SCALE 1:5

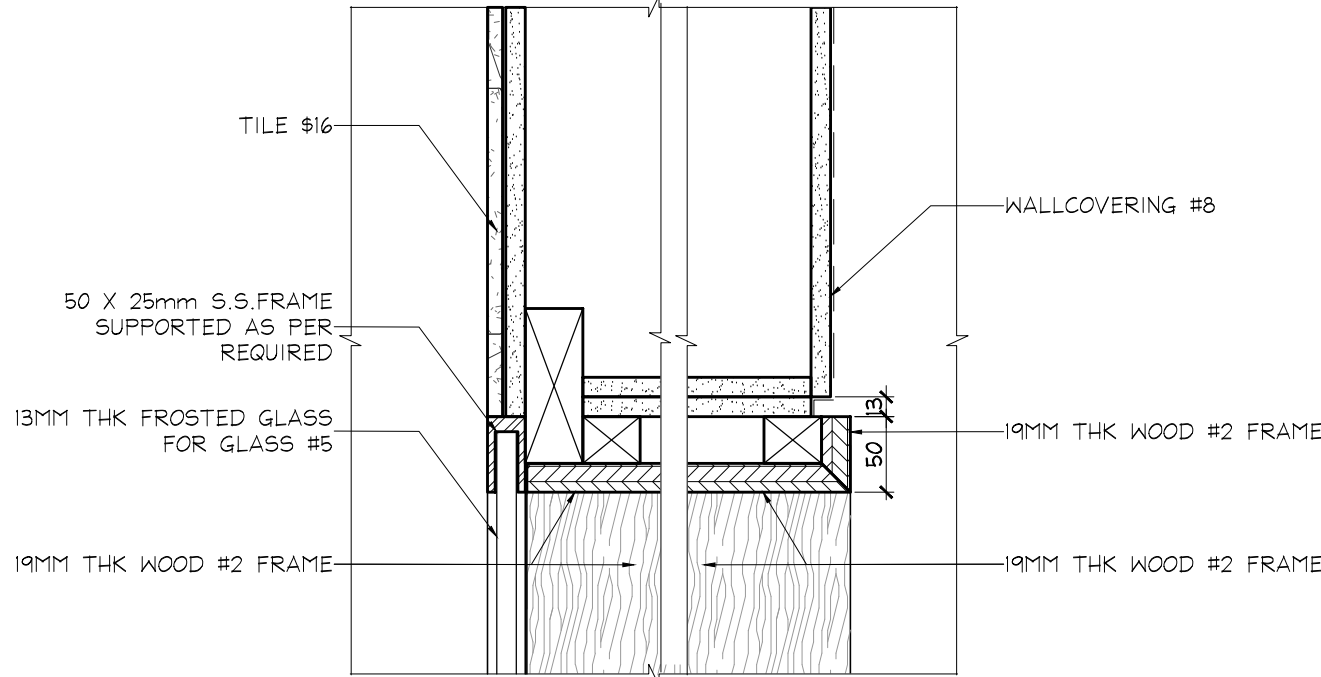

4
ID3.2.1
DETAIL
MEDIA DISPLAY
THEATRE
SCALE 1:5

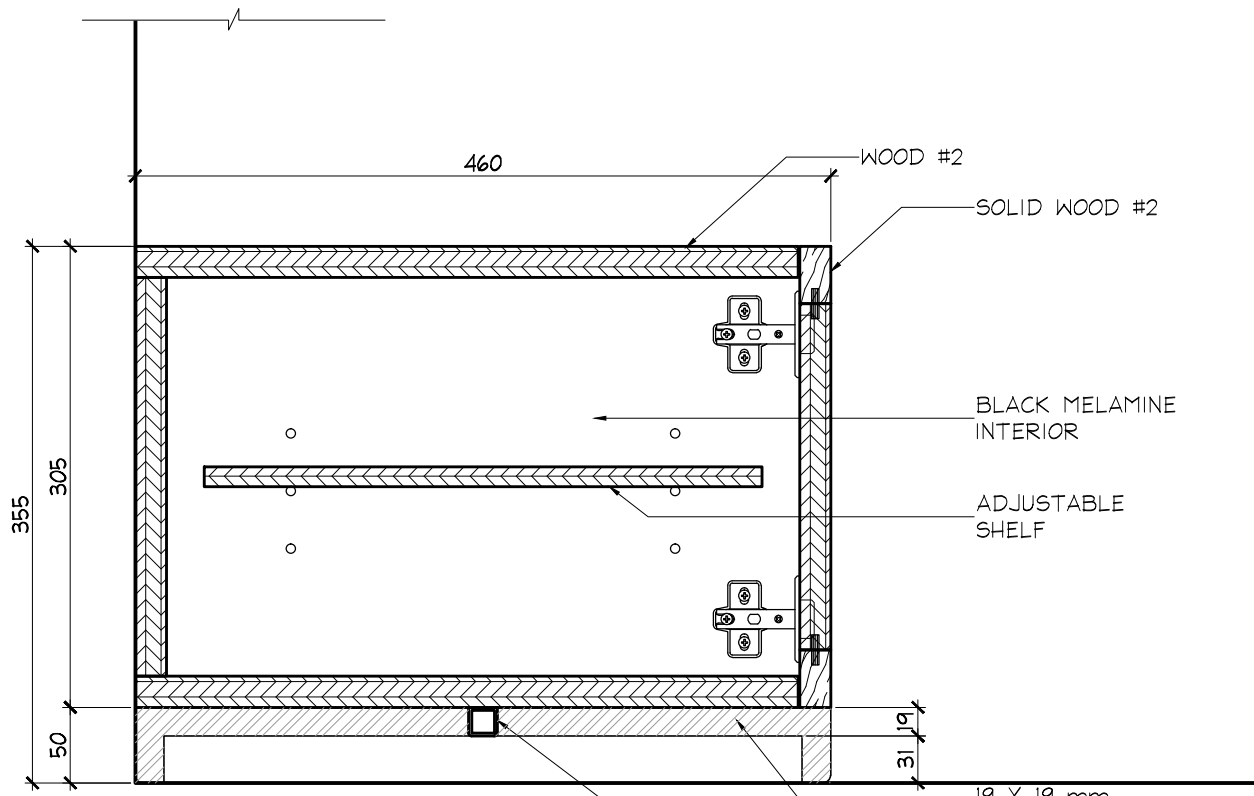

DO NOT SCALE DRAWINGS.

CONTRACTOR MUST VERIFY ALL DRAWINGS, DIMENSIONS, DETAILS AND SPECIFICATIONS AND REPORT ANY DISCREPANCIES TO UNION 31 INC. BEFORE PROCEEDING WITH WORK. MATERIALS MAY NOT BE SUBSTITUTED WITHOUT WRITTEN APPROVAL FROM UNION 31 INC.

ALL DRAWINGS AND SPECIFICATIONS ARE INSTRUMENTS OF SERVICE AND THE PROPERTY OF UNION 31 INC. WHICH MUST BE RETURNED AT THE COMPLETION OF THE WORK.

PRINTED: 30-MAY-17

ISSUED FOR
AS-BUILT








01	31 MAY / 17	ISSUED FOR AS-BUILT	SV
NO.	DATE	COMMENTS	INI

REVISIONS:

UNION31

UNION31 INC.
183 BATHURST STREET, STE. 201
TORONTO, ON, M5T 2R7, CANADA
TEL: 416-597-1576 FAX: 416-597-2139

PROJECT NAME: ALEXANDRA PARK MAIN BUILDING BLOCK 11 ON, Canada	
PROJECT NO.: 13-949	
DRAWINGS: WALL SECTIONS	
DATE STARTED: 07 AUG / 13	DRAWING NO.: ID 3.2.1
SCALE: AS NOTED	
DRAWN BY: SM	
APPROVED BY: KC	

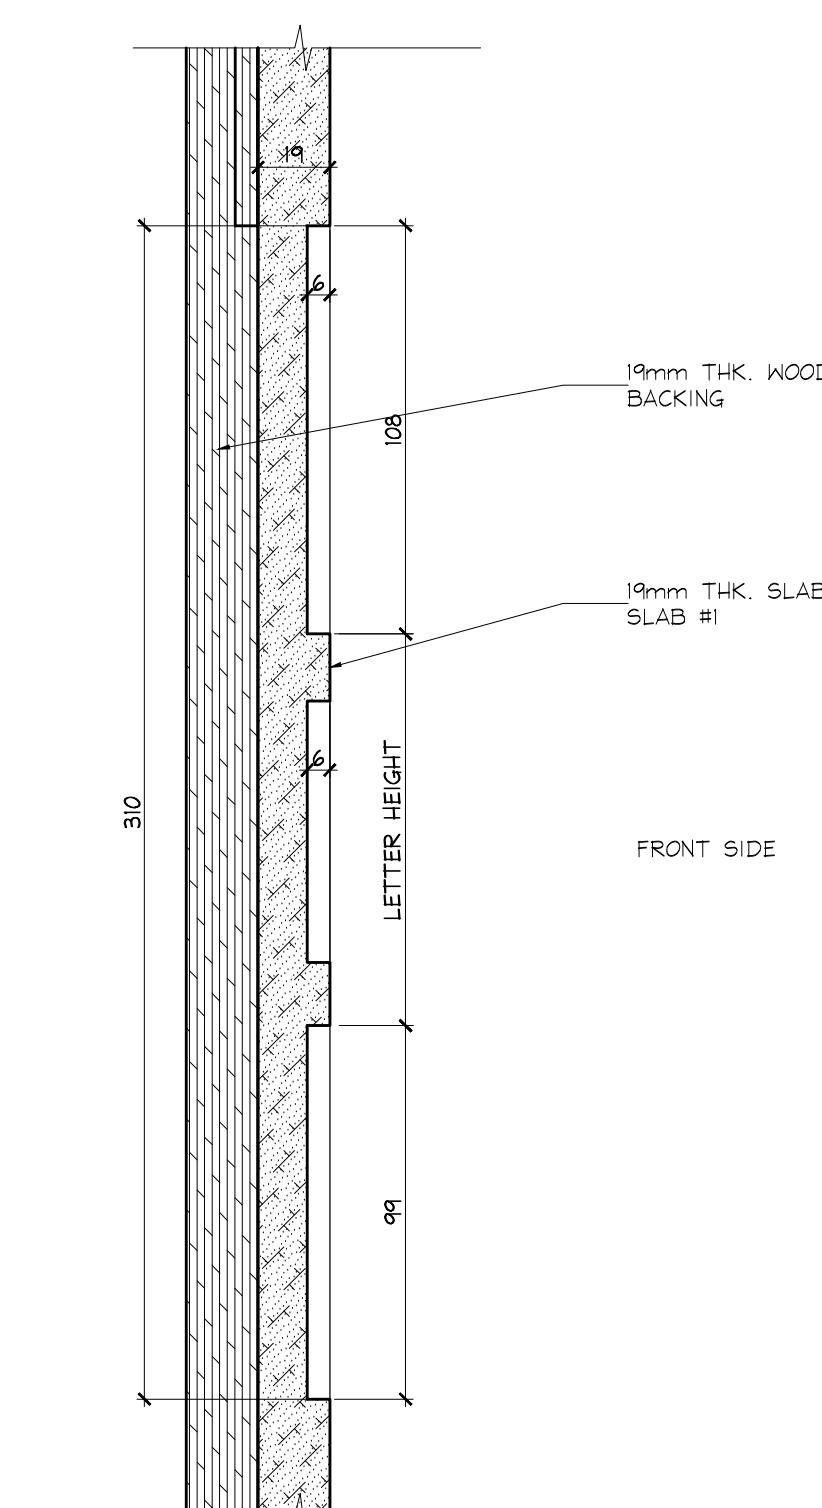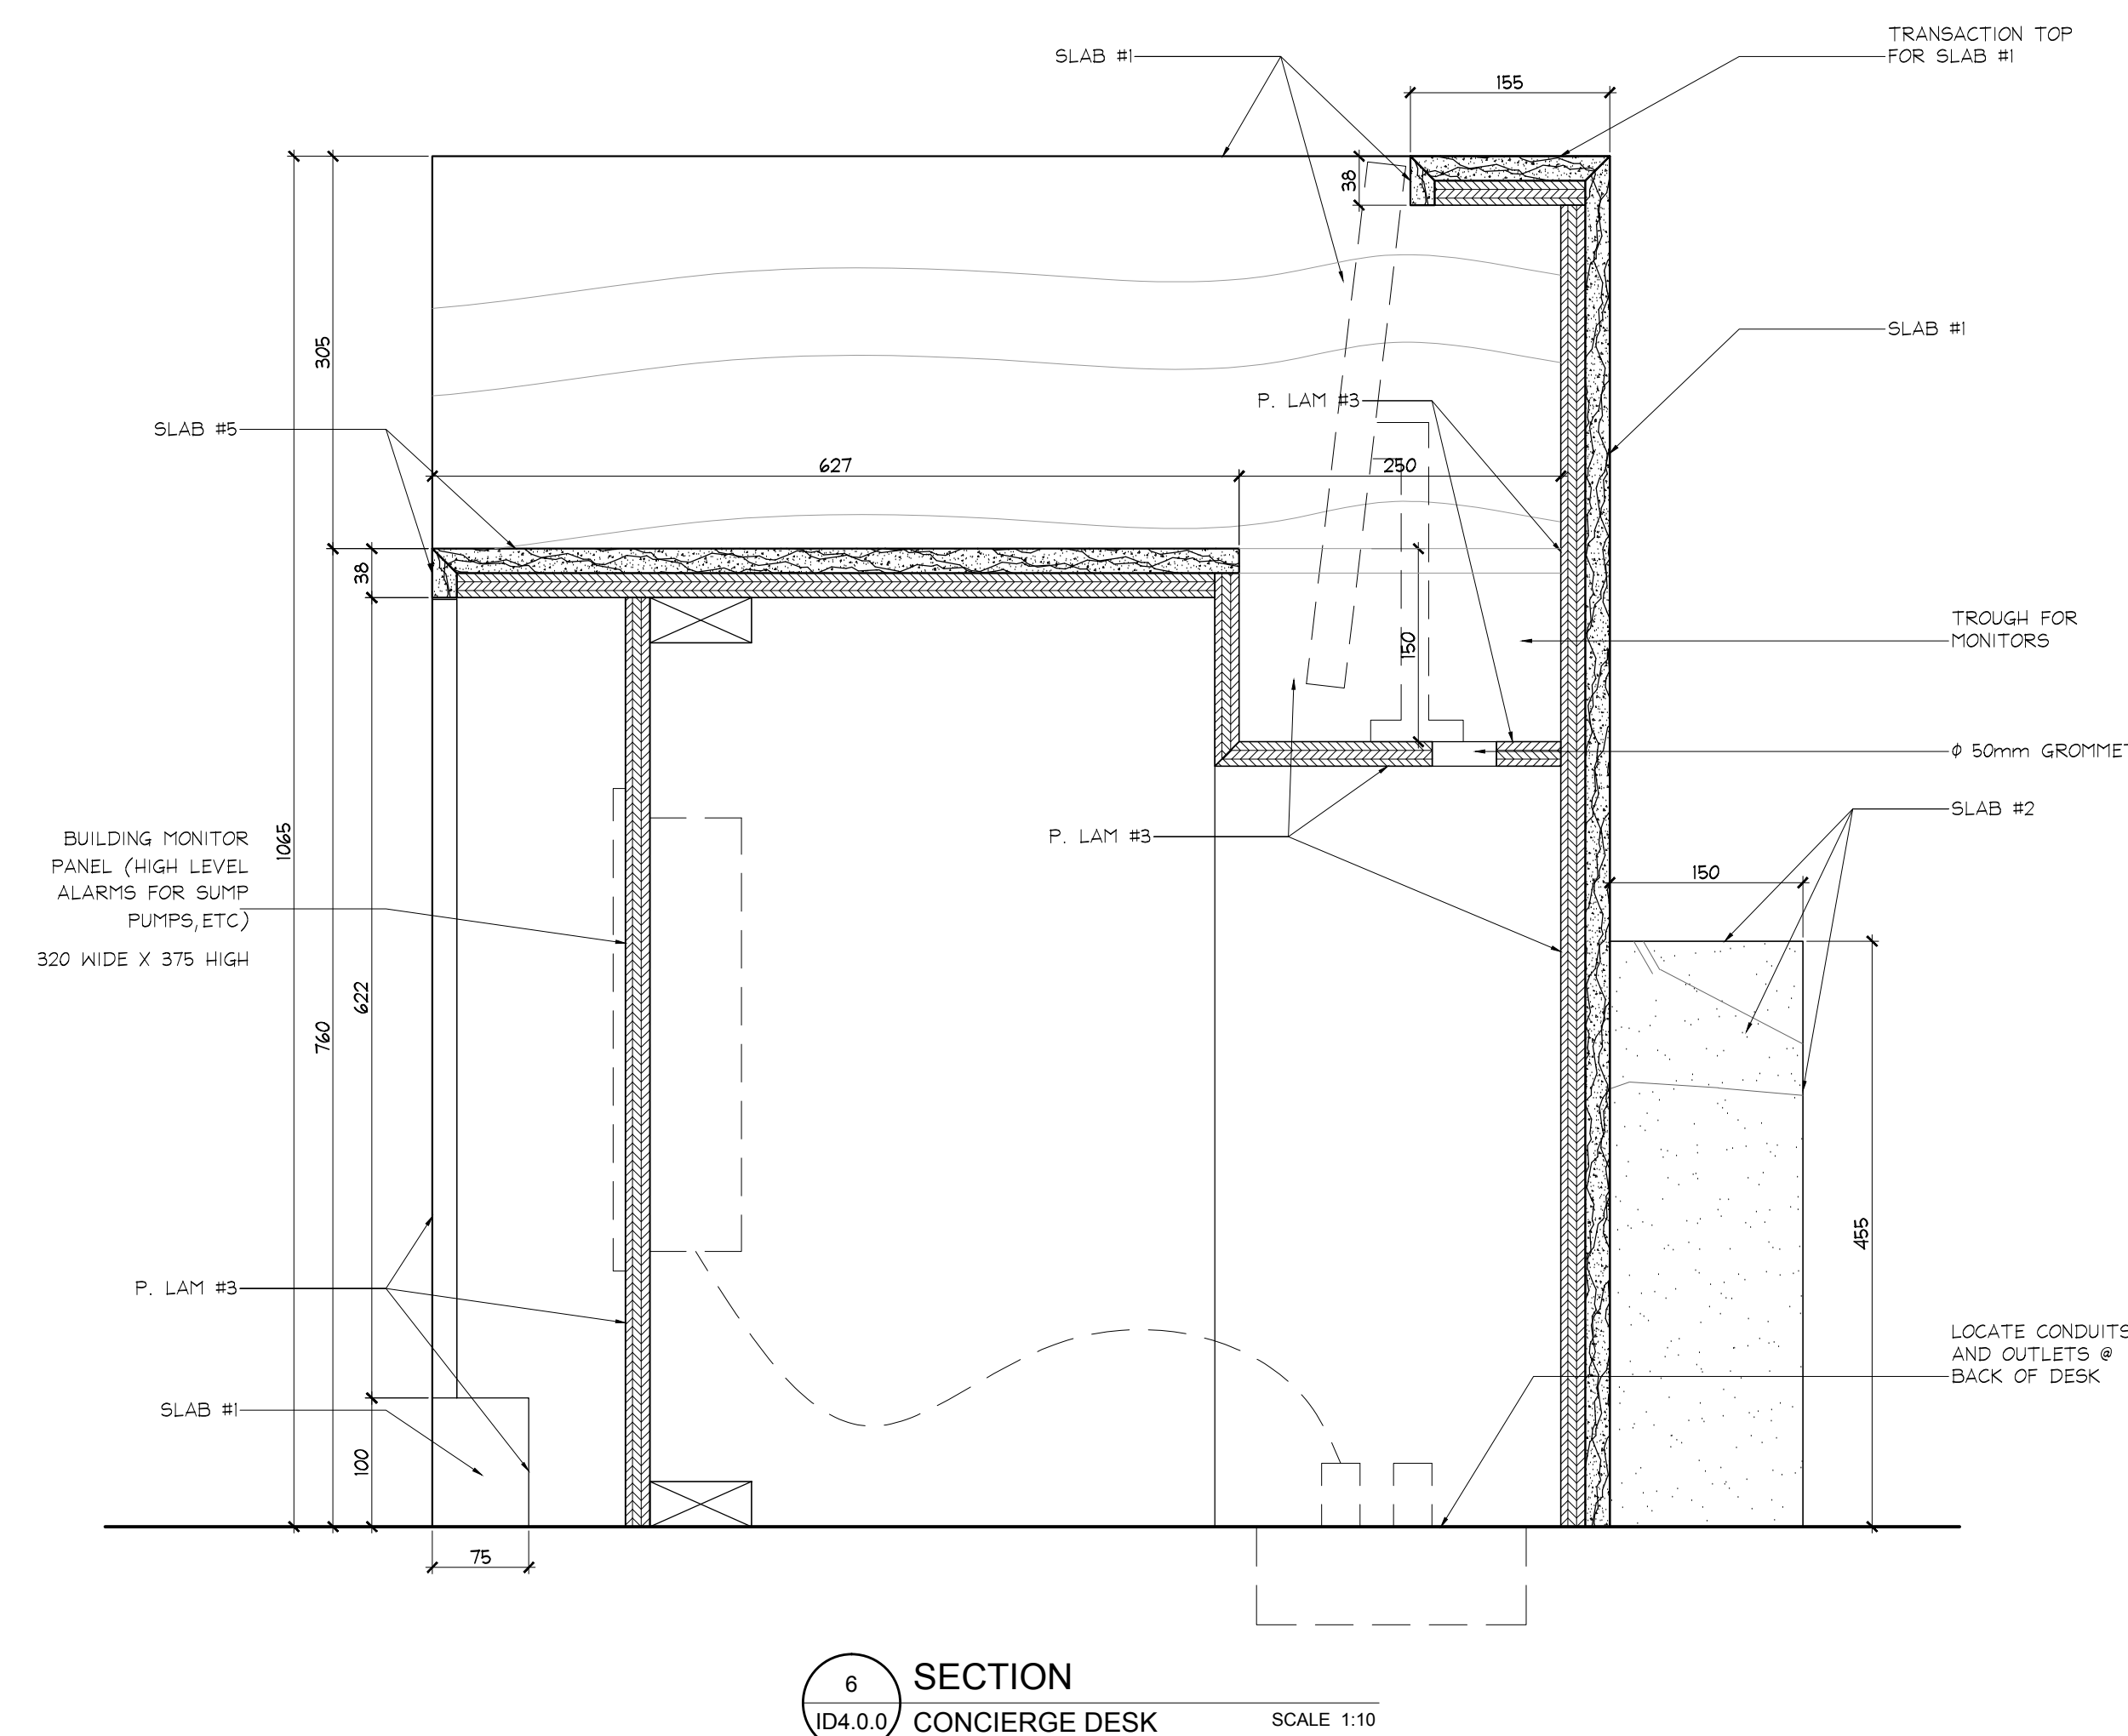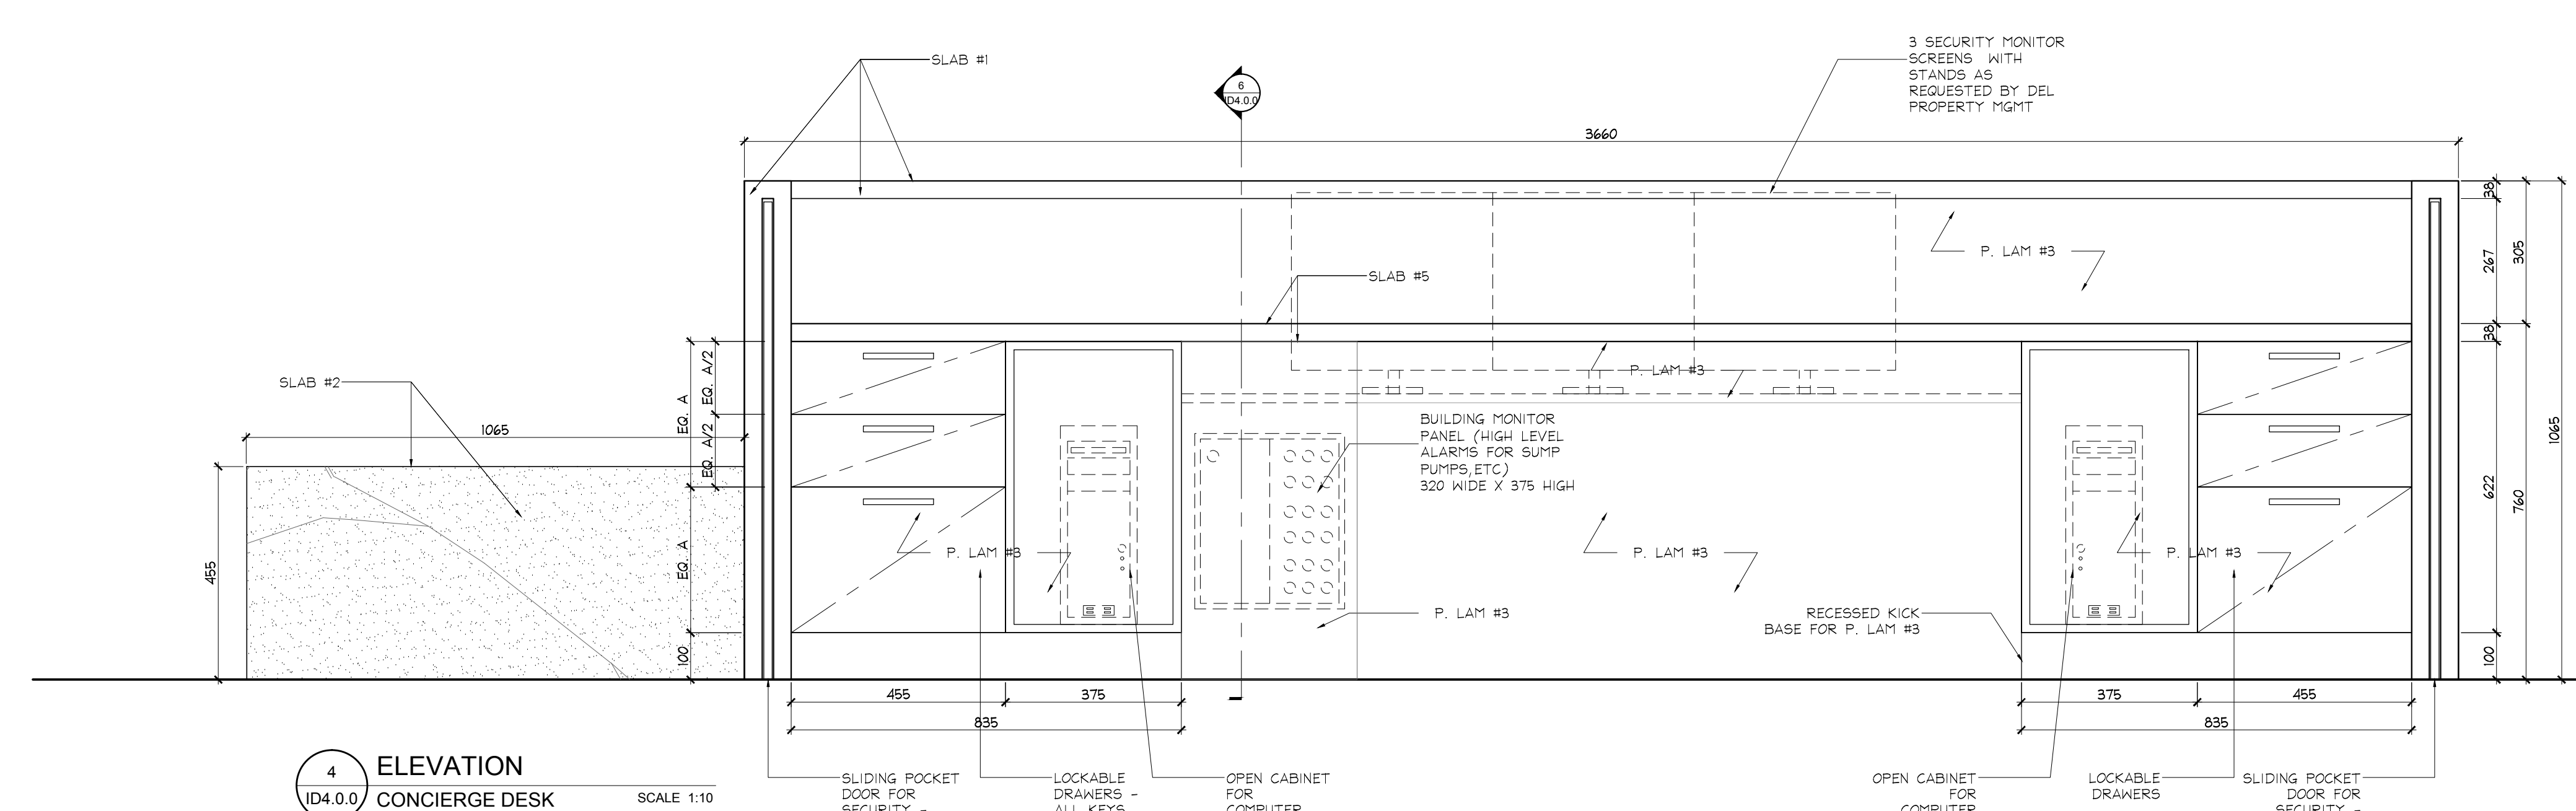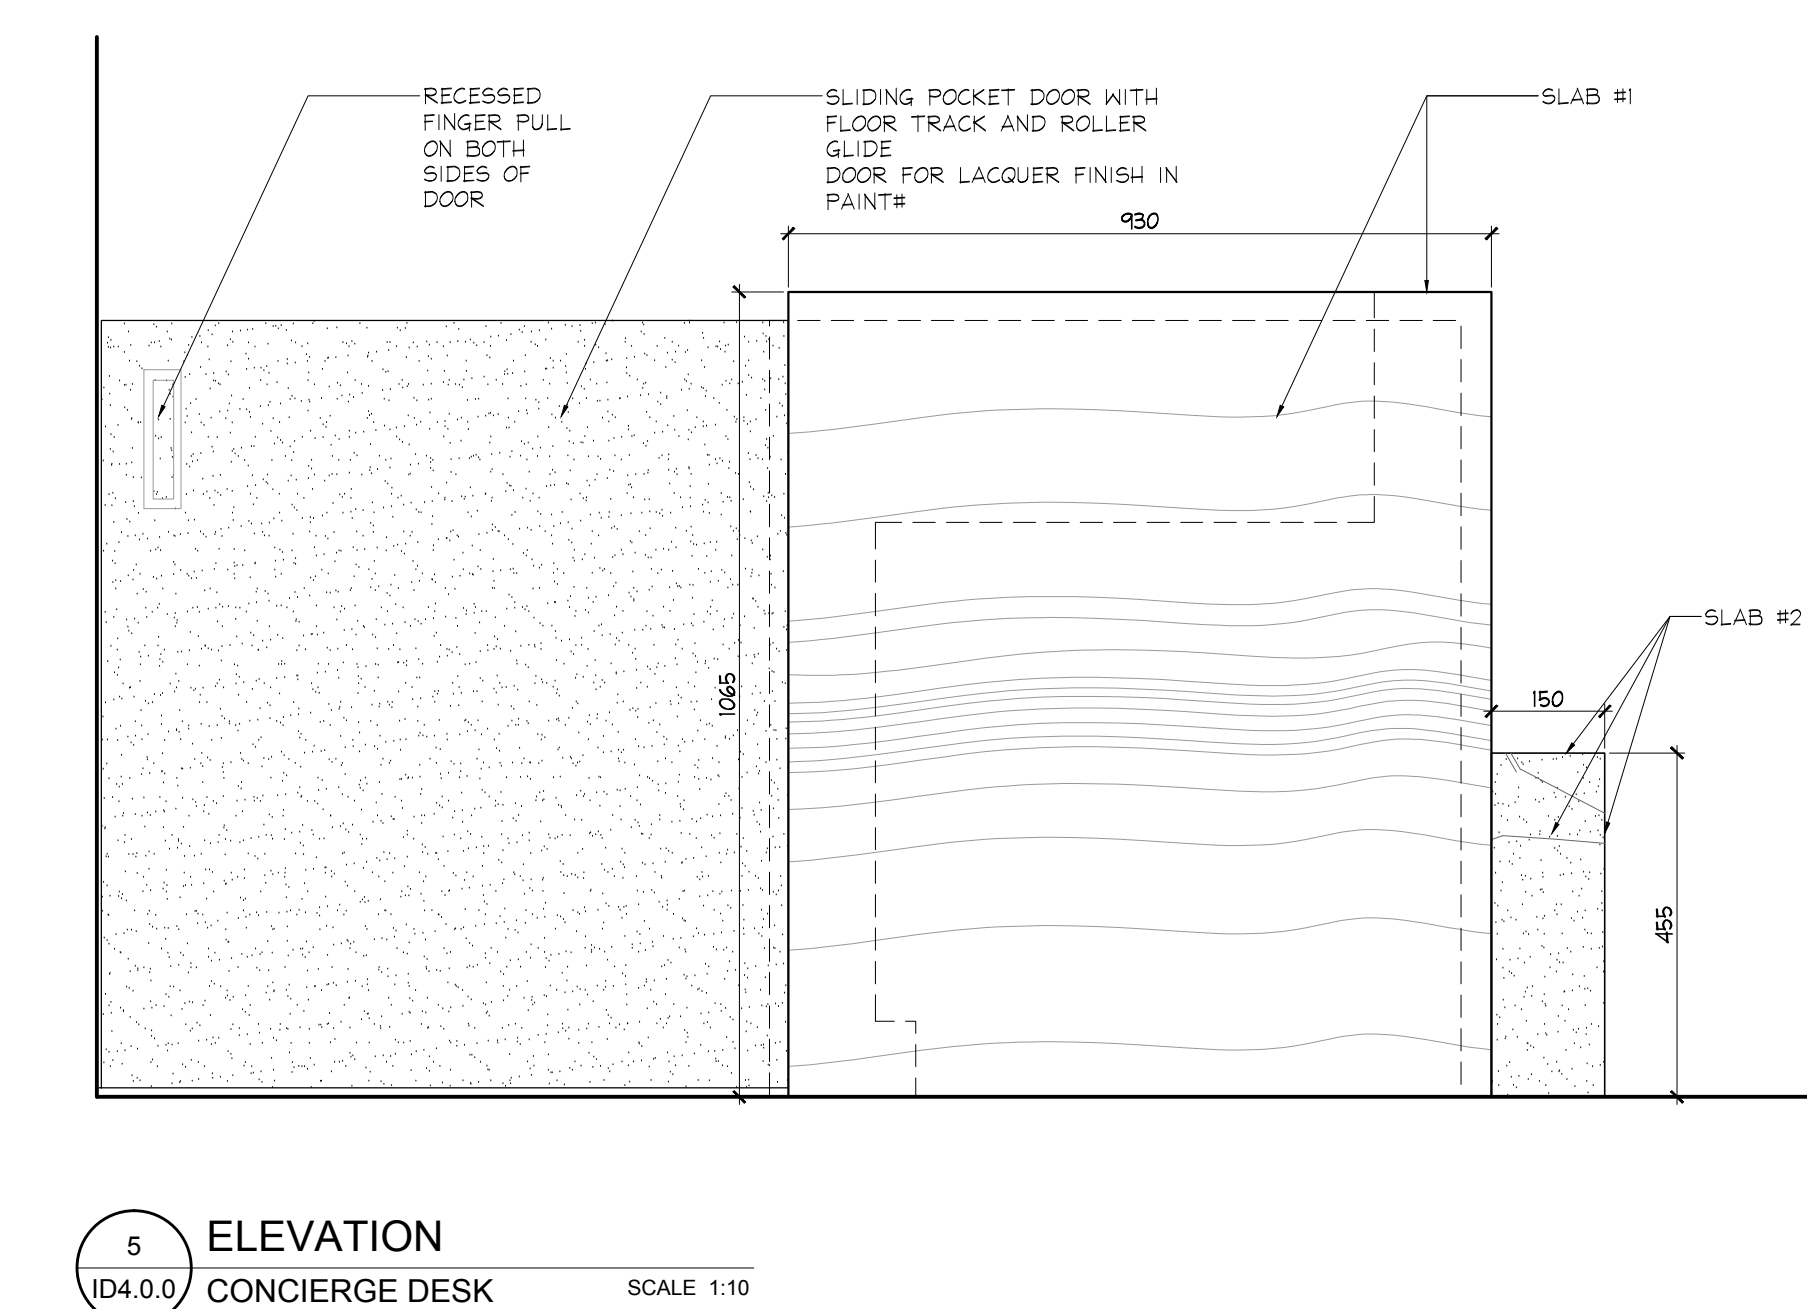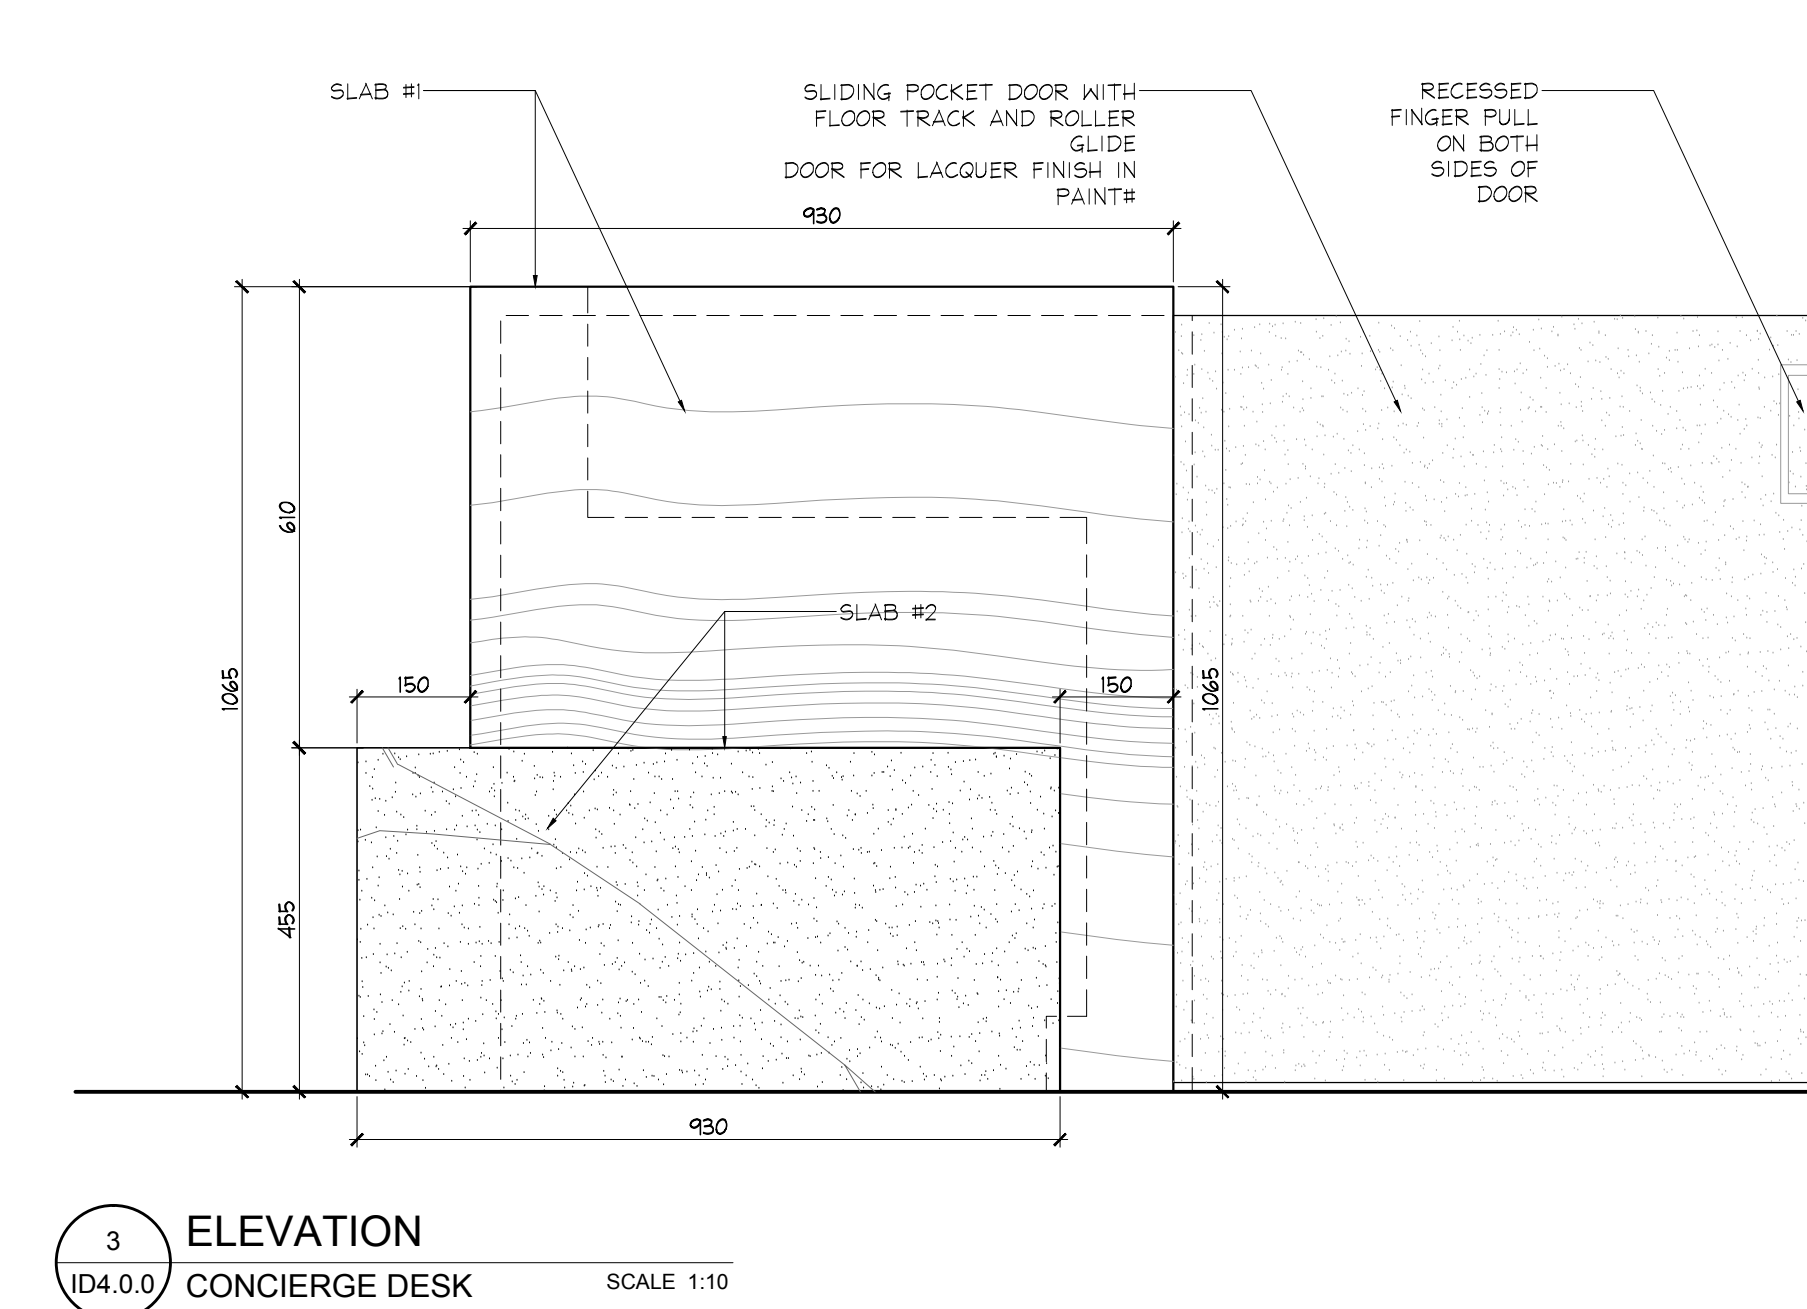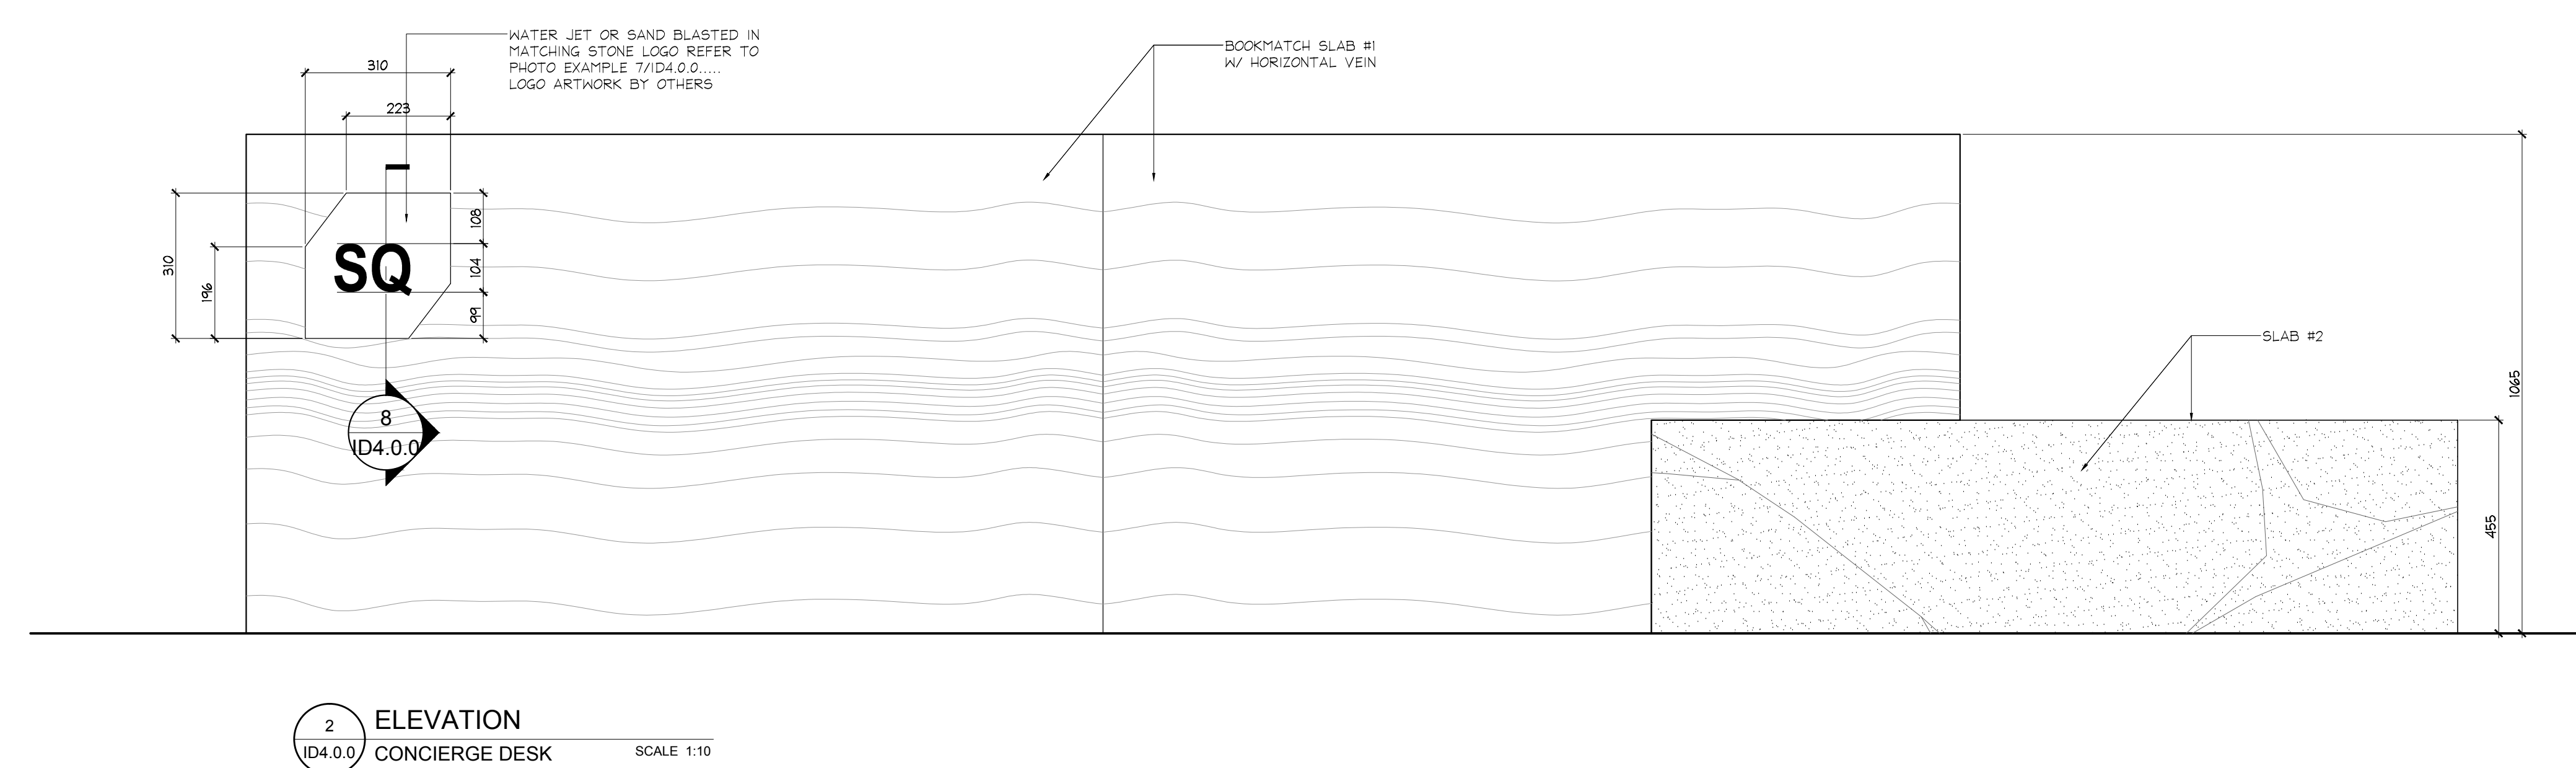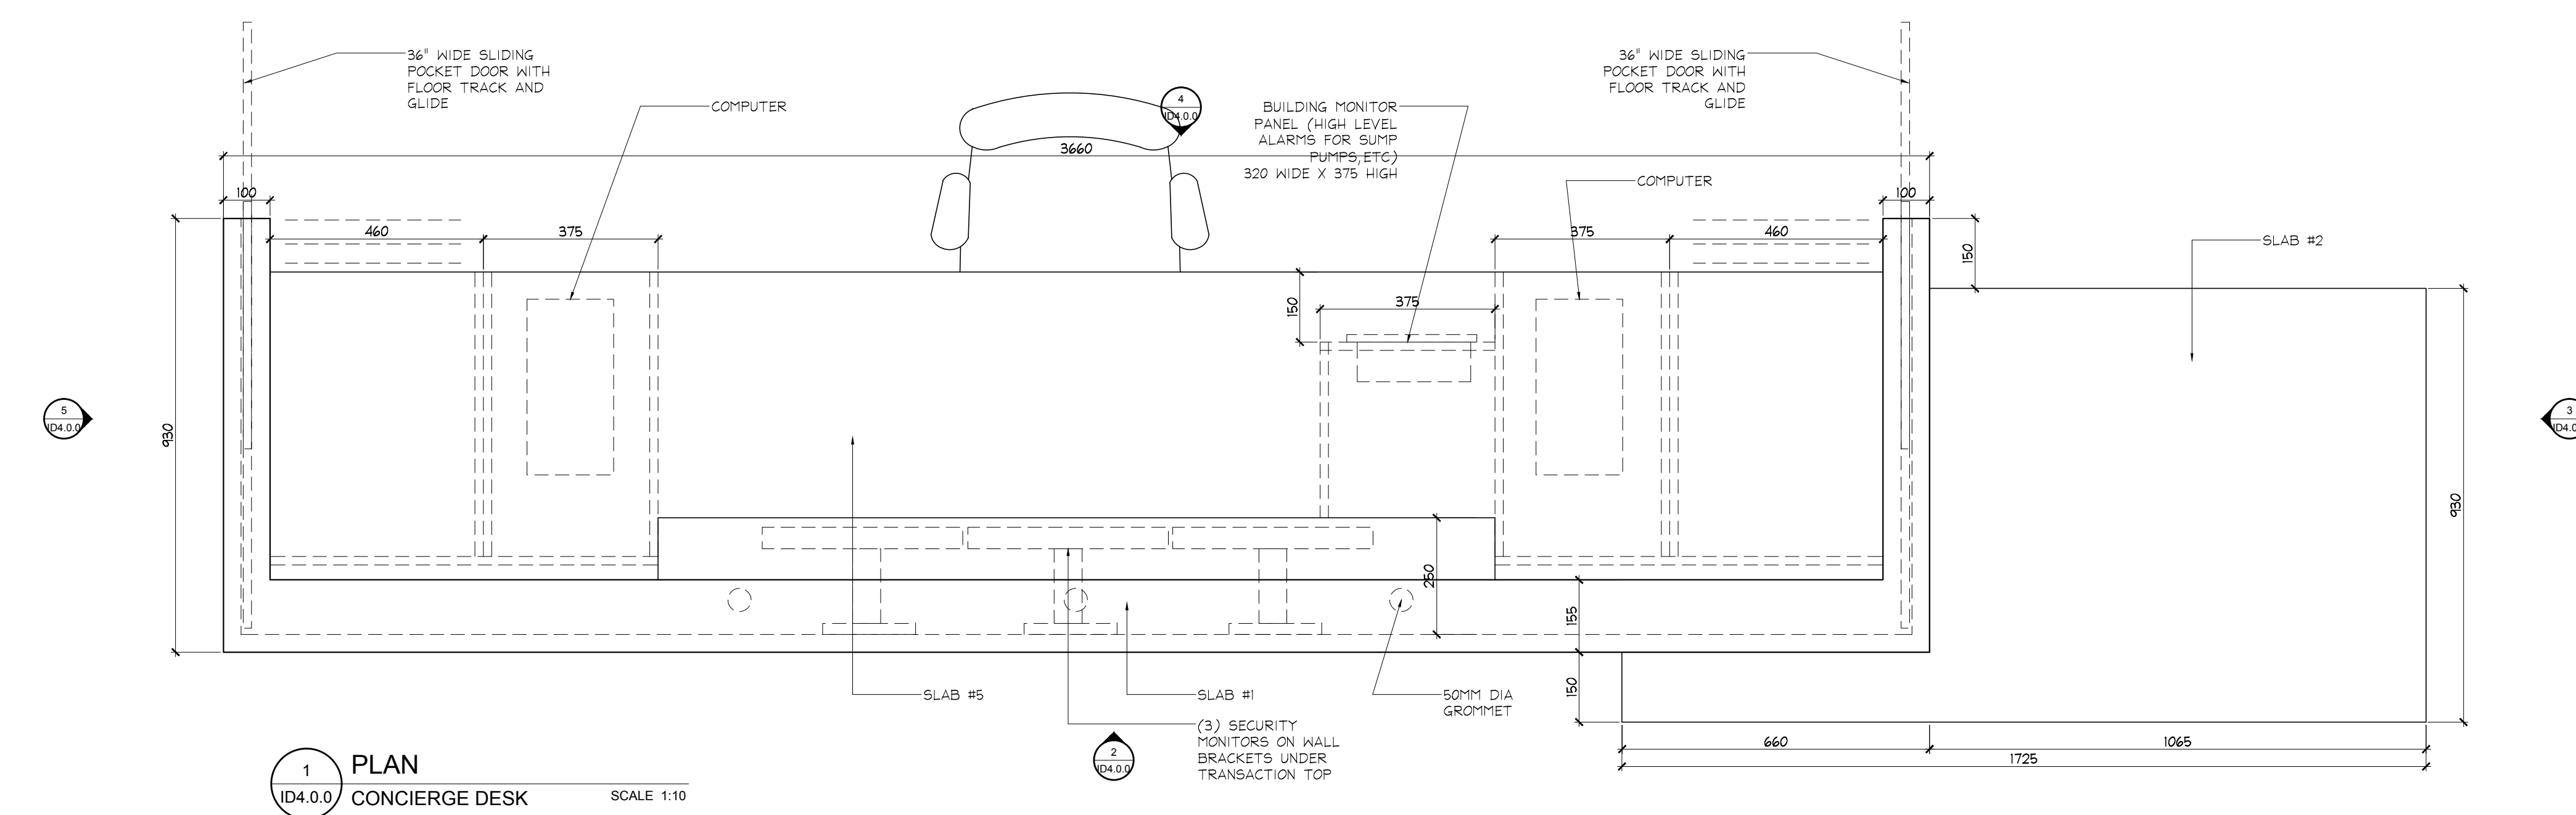

DO NOT SCALE DRAWINGS.

CONTRACTOR MUST VERIFY ALL DRAWINGS, DIMENSIONS, DETAILS AND SPECIFICATIONS, AND REPORT ANY DISCREPANCIES TO UNION 31 INC. BEFORE PROCEEDING WITH WORK. MATERIALS MAY NOT BE SUBSTITUTED WITHOUT WRITTEN APPROVAL FROM UNION 31 INC.

ALL DRAWINGS AND SPECIFICATIONS ARE INSTRUMENTS OF SERVICE AND THE PROPERTY OF UNION 31 INC. WHICH MUST BE RETURNED AT THE COMPLETION OF THE WORK.

PRINTED: 30-May-17

ISSUED FOR
AS-BUILT





01	31 MAY / 17	ISSUED FOR AS-BUILT	:
NO.	DATE	COMMENTS	II
REVISIONS:			

NOV 2003

UNION31 INC.
183 BATHURST STREET, STE 201
TORONTO, ON, M5T 2R7, CANADA
TEL: 416-597-1576 FAX: 416-597-2139

PROJECT NAME:
**ALEXANDRA PARK
MAIN BUILDING**
BLOCK 11
ON, Canada
PROJECT NO.: 13-949
DRAWING(S):

DATE STARTED: 07 AUG / 13	DRAWING NO.: ID 4.0.0
SCALE: AS NOTED	
DRAWN BY: SM	
APPROVED BY: KC	

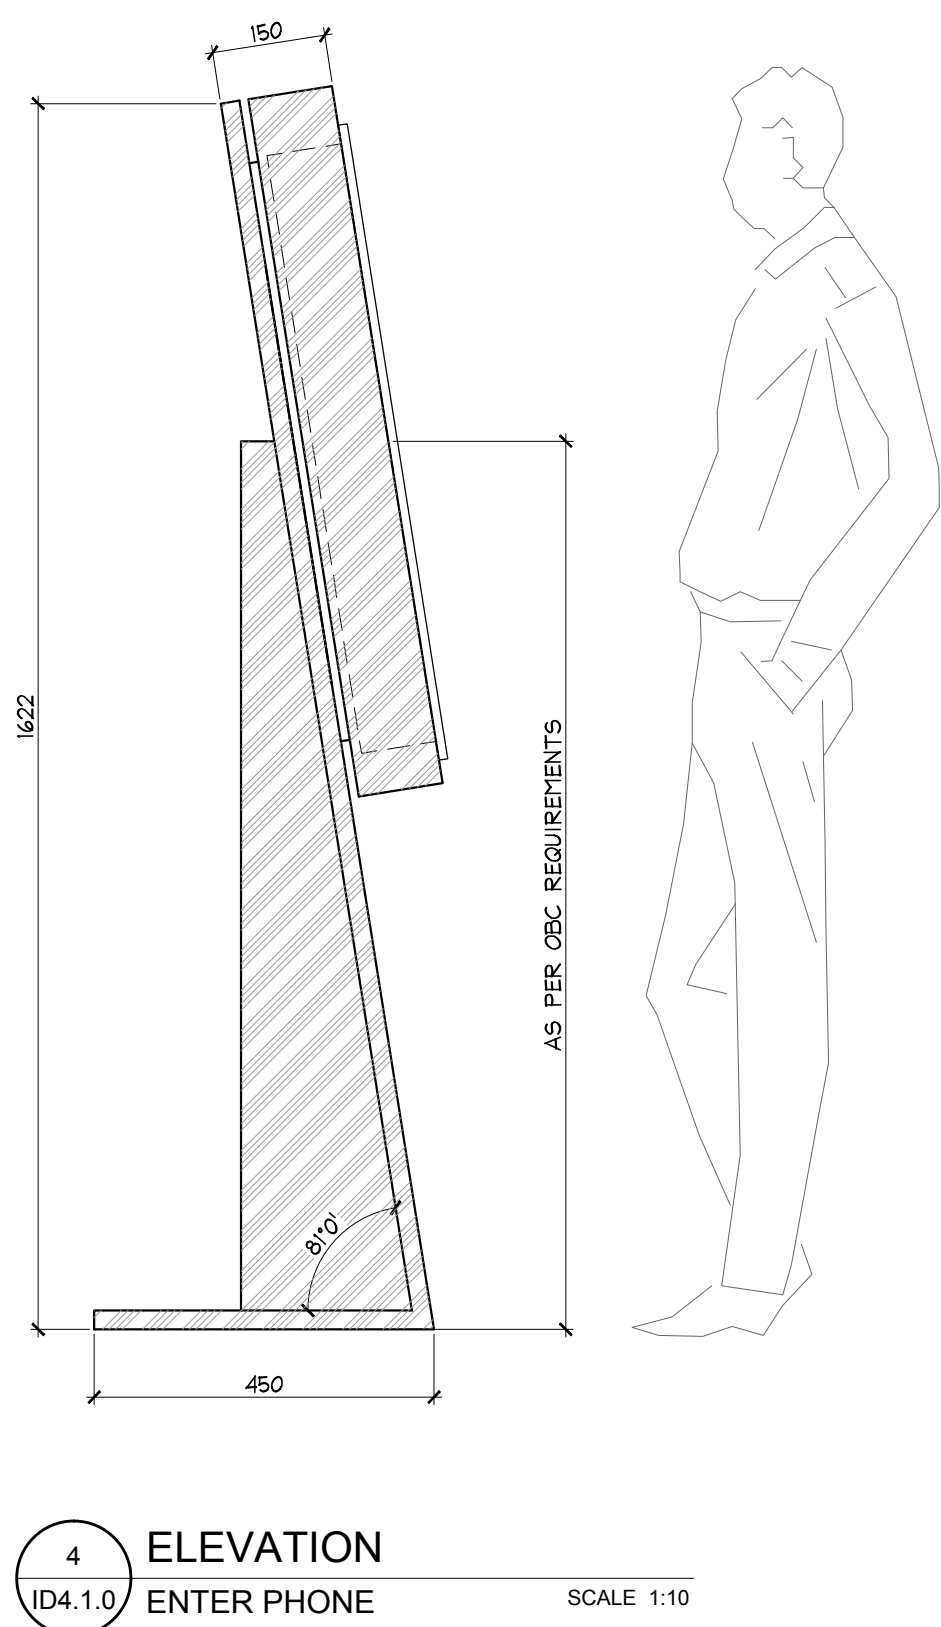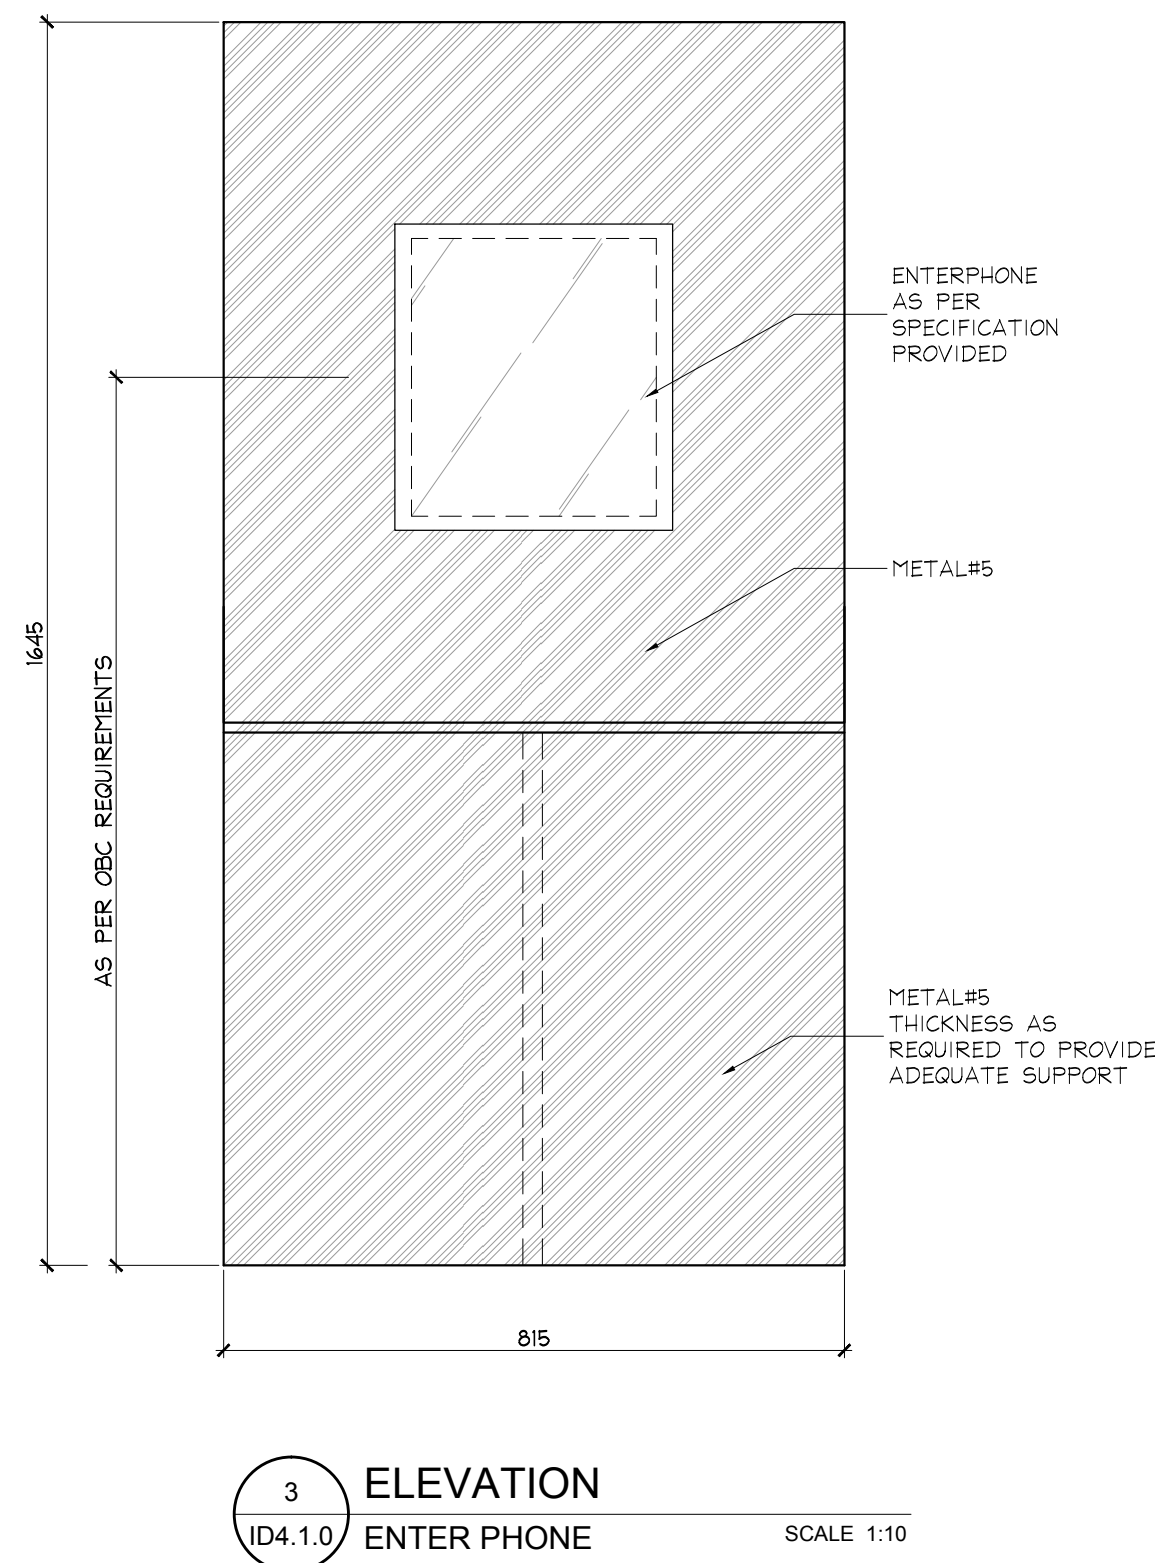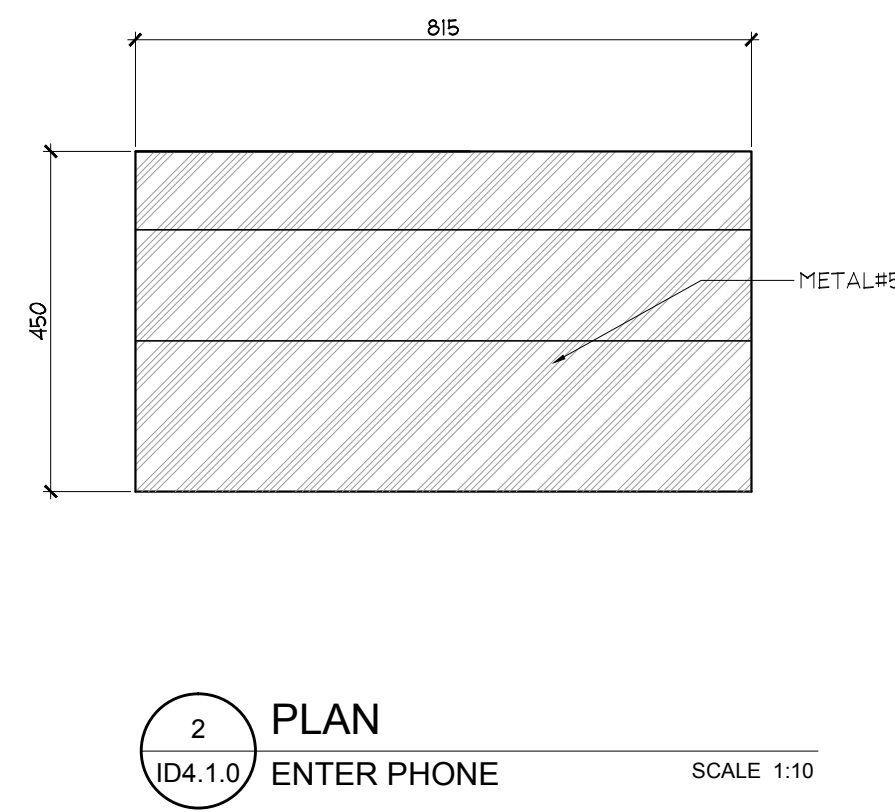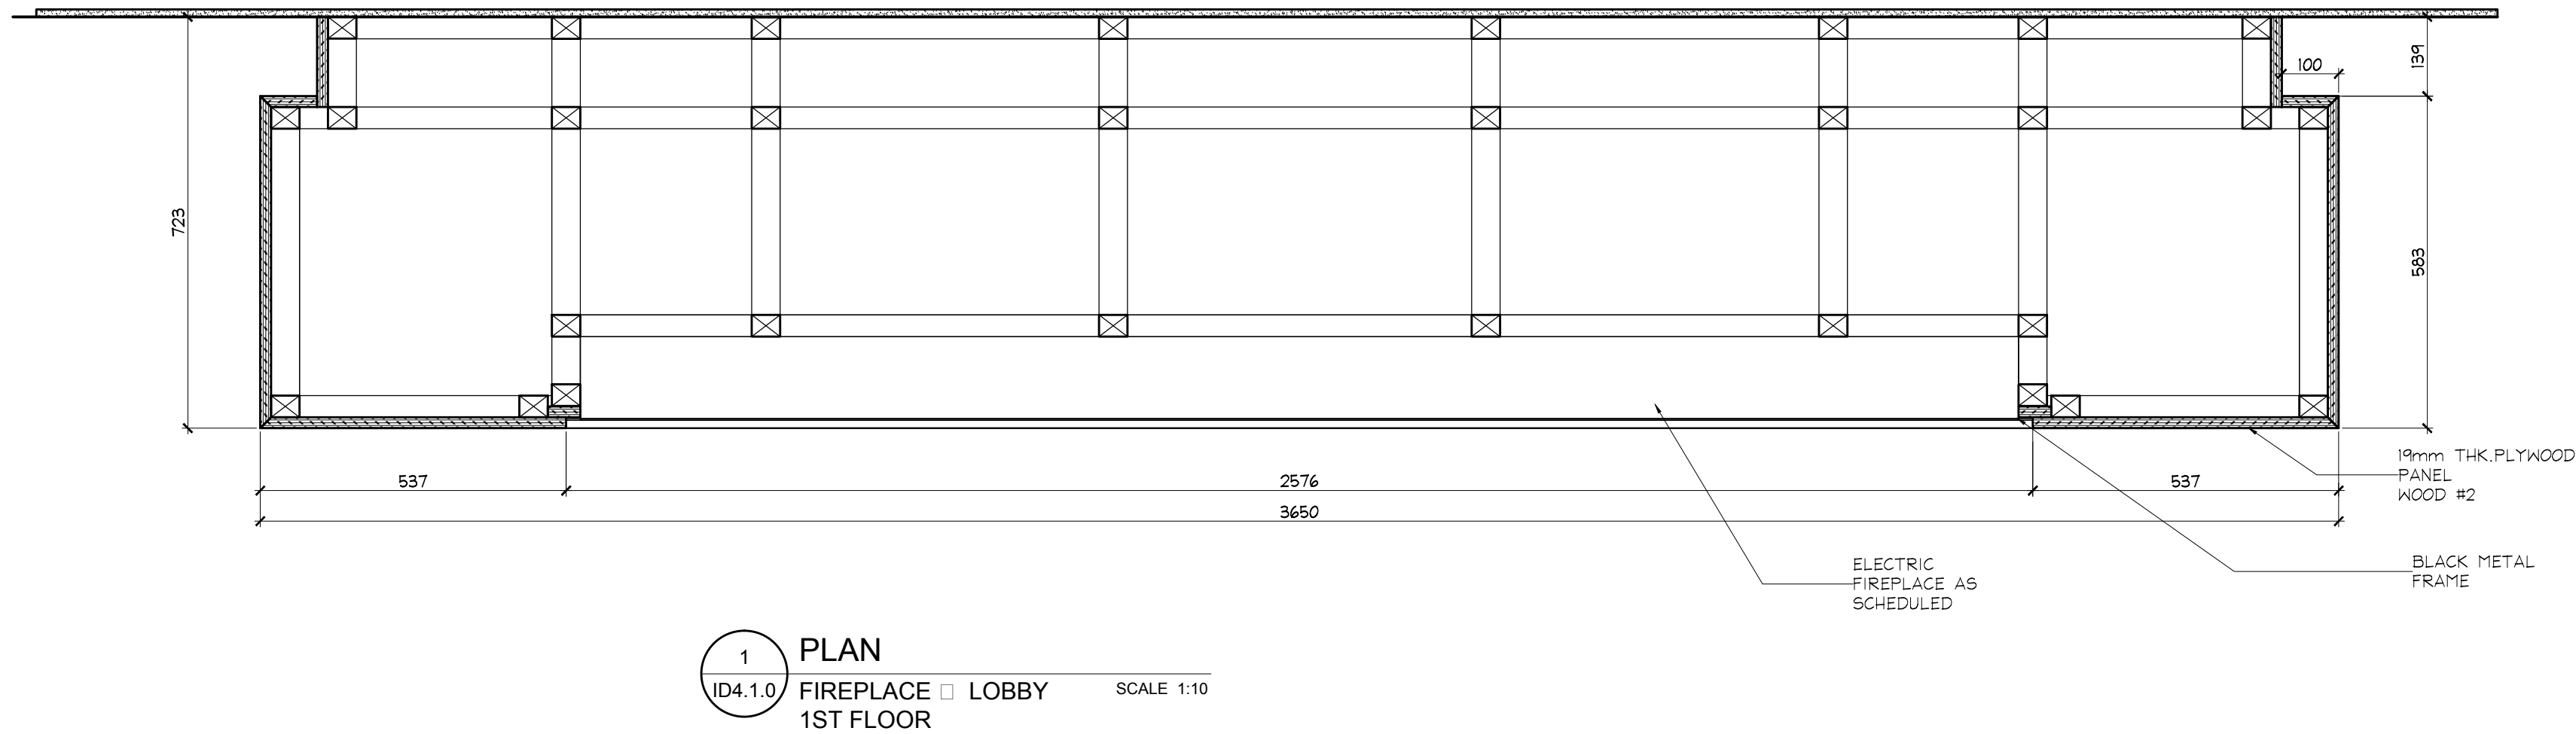

DO NOT SCALE DRAWINGS.

CONTRACTOR MUST VERIFY ALL DRAWINGS, DIMENSIONS, DETAILS AND SPECIFICATIONS AND REPORT ANY DISCREPANCIES TO UNION 31 INC. BEFORE PROCEEDING WITH WORK. MATERIALS MAY NOT BE SUBSTITUTED WITHOUT WRITTEN APPROVAL FROM UNION 31 INC.

ALL DRAWINGS AND SPECIFICATIONS ARE INSTRUMENTS OF SERVICE AND THE PROPERTY OF UNION 31 INC. WHICH MUST BE RETURNED AT THE COMPLETION OF THE WORK.

PRINTED: 30-MAY-17

ISSUED FOR
AS-BUILT

01	31 MAY / 17	ISSUED FOR AS-BUILT	SV
NO.	DATE	COMMENTS	INI


REVISIONS:

UNION31

UNION31 INC.
183 BATHURST STREET, STE. 201
TORONTO, ON, M5T 2R7, CANADA
TEL: 416-597-1576 FAX: 416-597-2139

PROJECT NAME: ALEXANDRA PARK MAIN BUILDING BLOCK 11 ON, Canada	
PROJECT NO.: 13-949	
DRAWINGS: MILLWORK DETAILS	
DATE STARTED: 07 AUG / 13	DRAWING NO.: ID
SCALE: AS NOTED	4.1.0
DRAWN BY: SM	
APPROVED BY: KC	

CONTRACTOR MUST VERIFY ALL DRAWINGS, DIMENSIONS, DETAILS AND SPECIFICATIONS, AND REPORT ANY DISCREPANCIES TO UNION 31 INC. BEFORE PROCEEDING WITH WORK. MATERIALS MAY NOT BE SUBSTITUTED WITHOUT WRITTEN APPROVAL FROM UNION 31 INC.

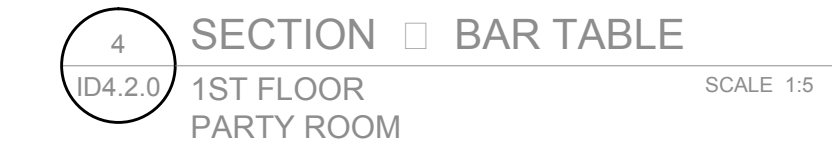

1	31 MAY / 17	ISSUED FOR AS-BUILT	SV
0	DATE	COMMENTS	INI

REVISIONS:

UNION31 INC.
183 BATHURST STREET, STE 201
TORONTO, ON, M5T 2R7, CANADA
TEL: 416-597-1576 FAX: 416-597-2139

DATE STARTED: 07 AUG / 13	DRAWING NO.: ID 4.2.0
SCALE: AS NOTED	
DRAWN BY: SM	
APPROVED BY: KC	


DO NOT SCALE DRAWINGS.

CONTRACTOR MUST VERIFY ALL DRAWINGS, DIMENSIONS, DETAILS AND SPECIFICATIONS, AND REPORT ANY DISCREPANCIES TO UNION 31 INC. BEFORE PROCEEDING WITH WORK. MATERIALS MAY NOT BE SUBSTITUTED WITHOUT WRITTEN APPROVAL FROM UNION 31 INC.


ALL DRAWINGS AND SPECIFICATIONS ARE INSTRUMENTS OF SERVICE AND THE PROPERTY OF UNION 31 INC. WHICH MUST BE RETURNED AT THE COMPLETION OF THE WORK.

PRINTED: 30-May-17


ISSUED FOR
AS-BUILT

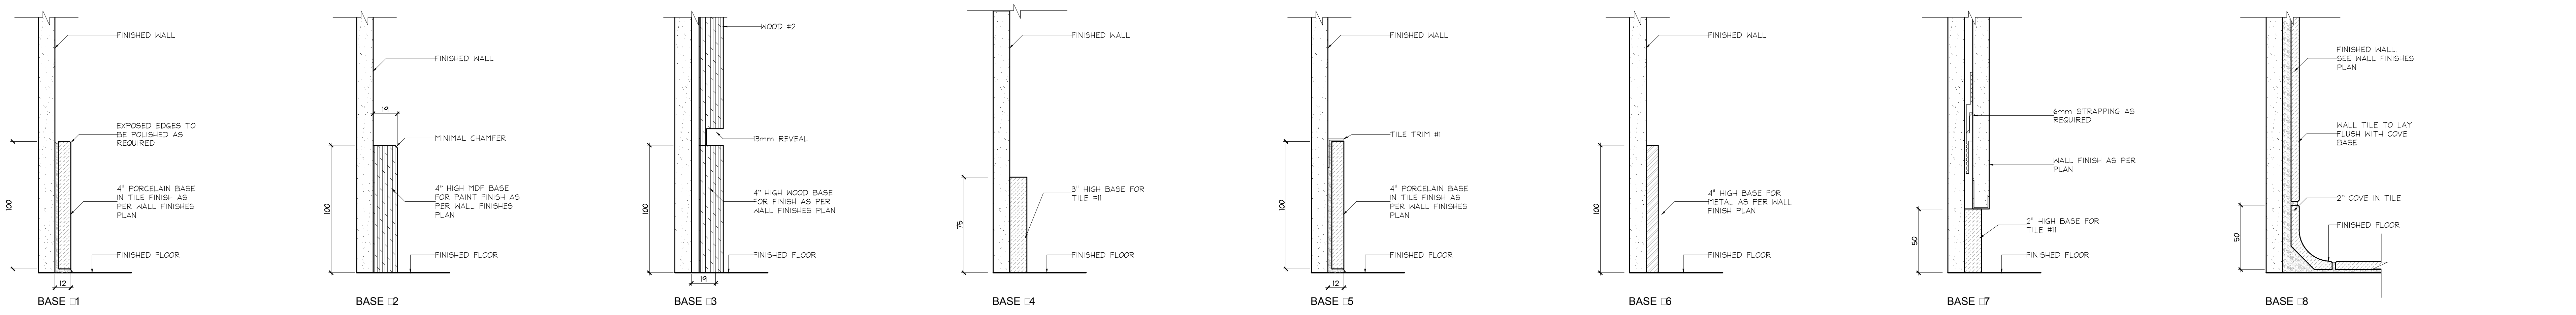


1 BASE DETAILS
TYPICAL SCALE 1:2

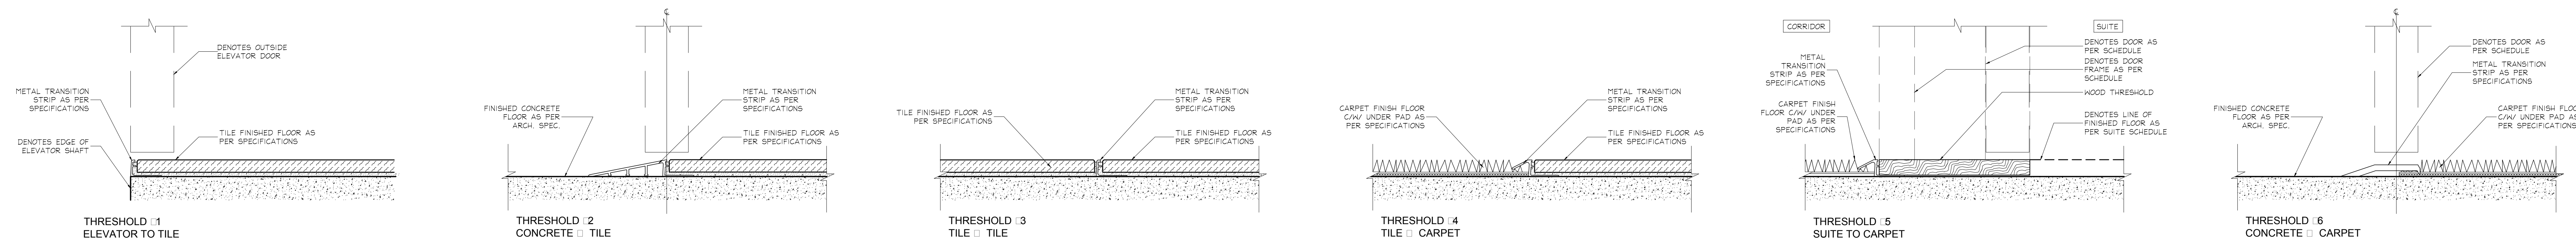


2 THRESHOLD DETAILS
TYPICAL SCALE 1:2

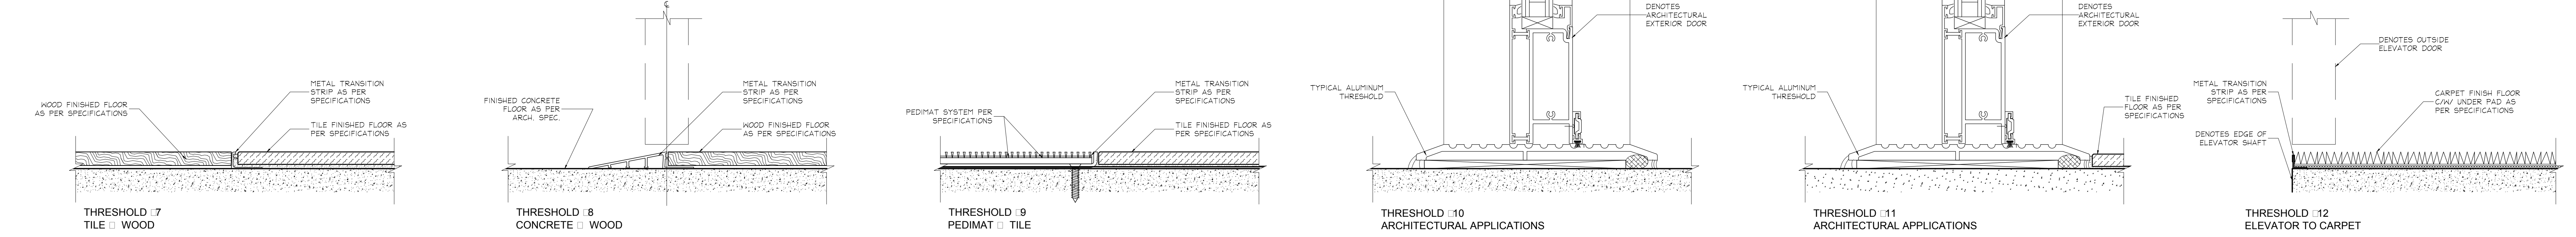

3 THRESHOLD DETAILS
TYPICAL SCALE 1:2

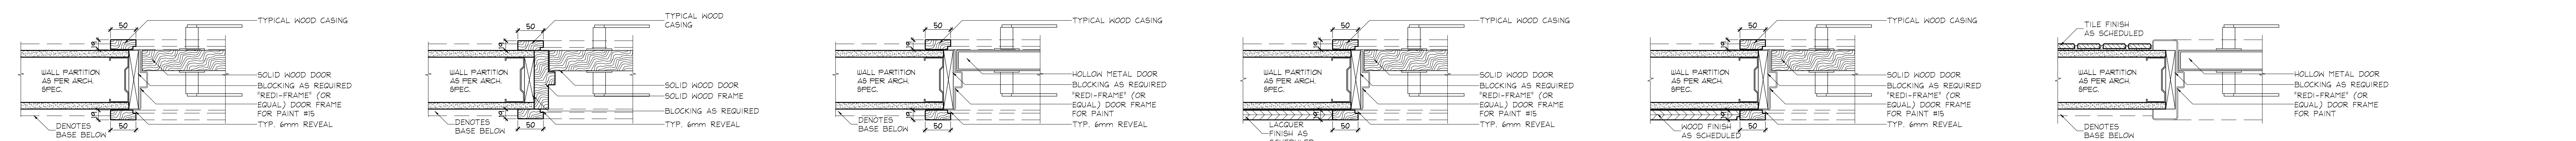

4 TYP. CASING
HORIZONTAL SECTION - DETAIL SCALE 1:5

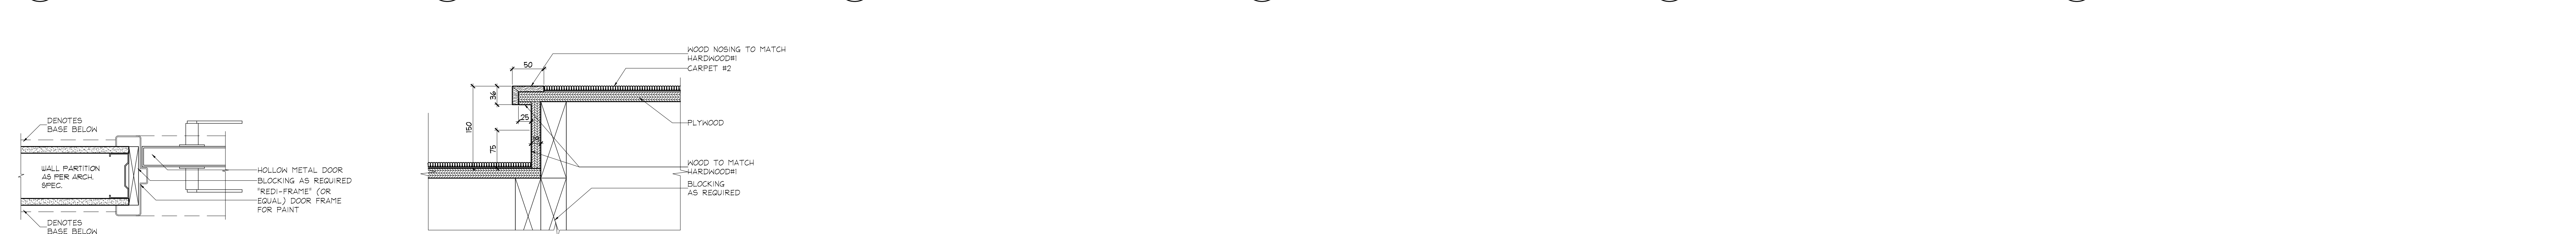

5 TYP. CASING
HORIZONTAL SECTION - DETAIL SCALE 1:5



6 TYP. CASING
HORIZONTAL SECTION - DETAIL SCALE 1:5

7 SECTION - STEP
AMENITY - THEATRE ROOM
GROUND FLOOR SCALE 1:5

01	31 MAY / 17	ISSUED FOR AS-BUILT	SV
NO.	DATE	COMMENTS	INI

UNION 31 INC.

183 BATHURST STREET, STE. 201
TORONTO, ON, M5T 2R7, CANADA
TEL: 416-597-1576 FAX: 416-597-2139

PROJECT NAME:	ALEXANDRA PARK MAIN BUILDING
BLOCK 11 ON, Canada	
PROJECT NO.:	13-949
DRAWINGS:	
TYPICAL DETAILS BASES, THRESHOLDS & CASINGS	
DATE STARTED: 07 AUG / 13	DRAWING NO.:
SCALE: AS NOTED	ID
DRAWN BY: GG	5.0.0
APPROVED BY: KC	