
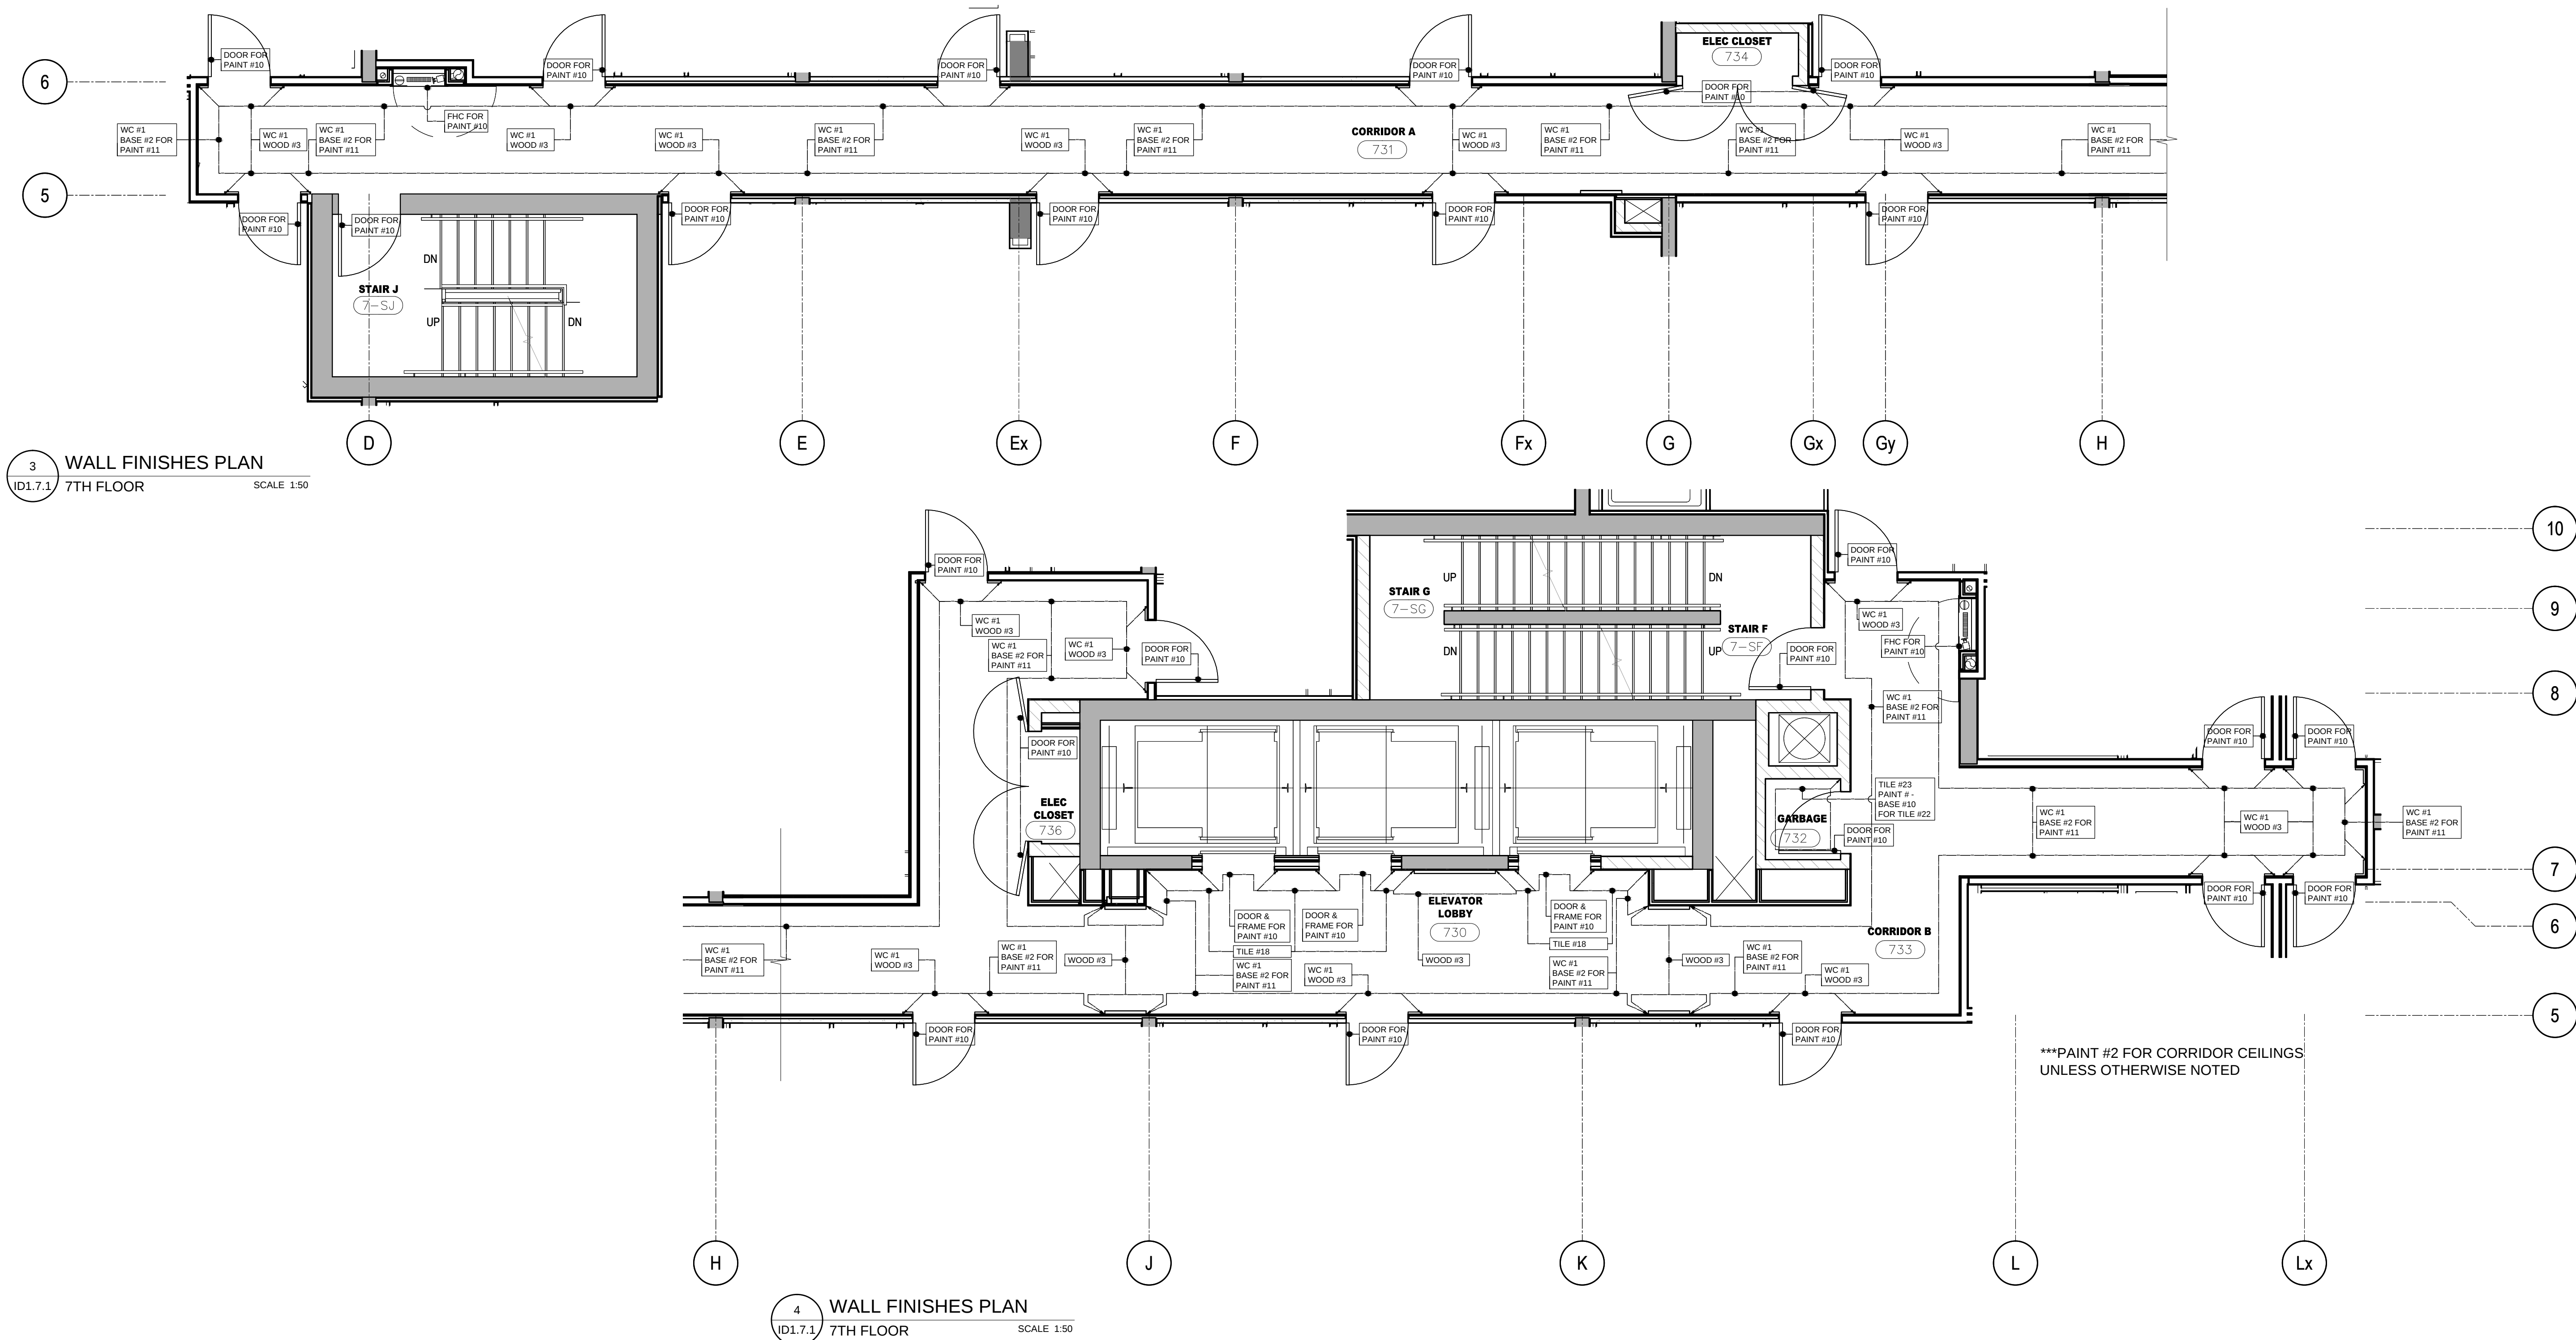


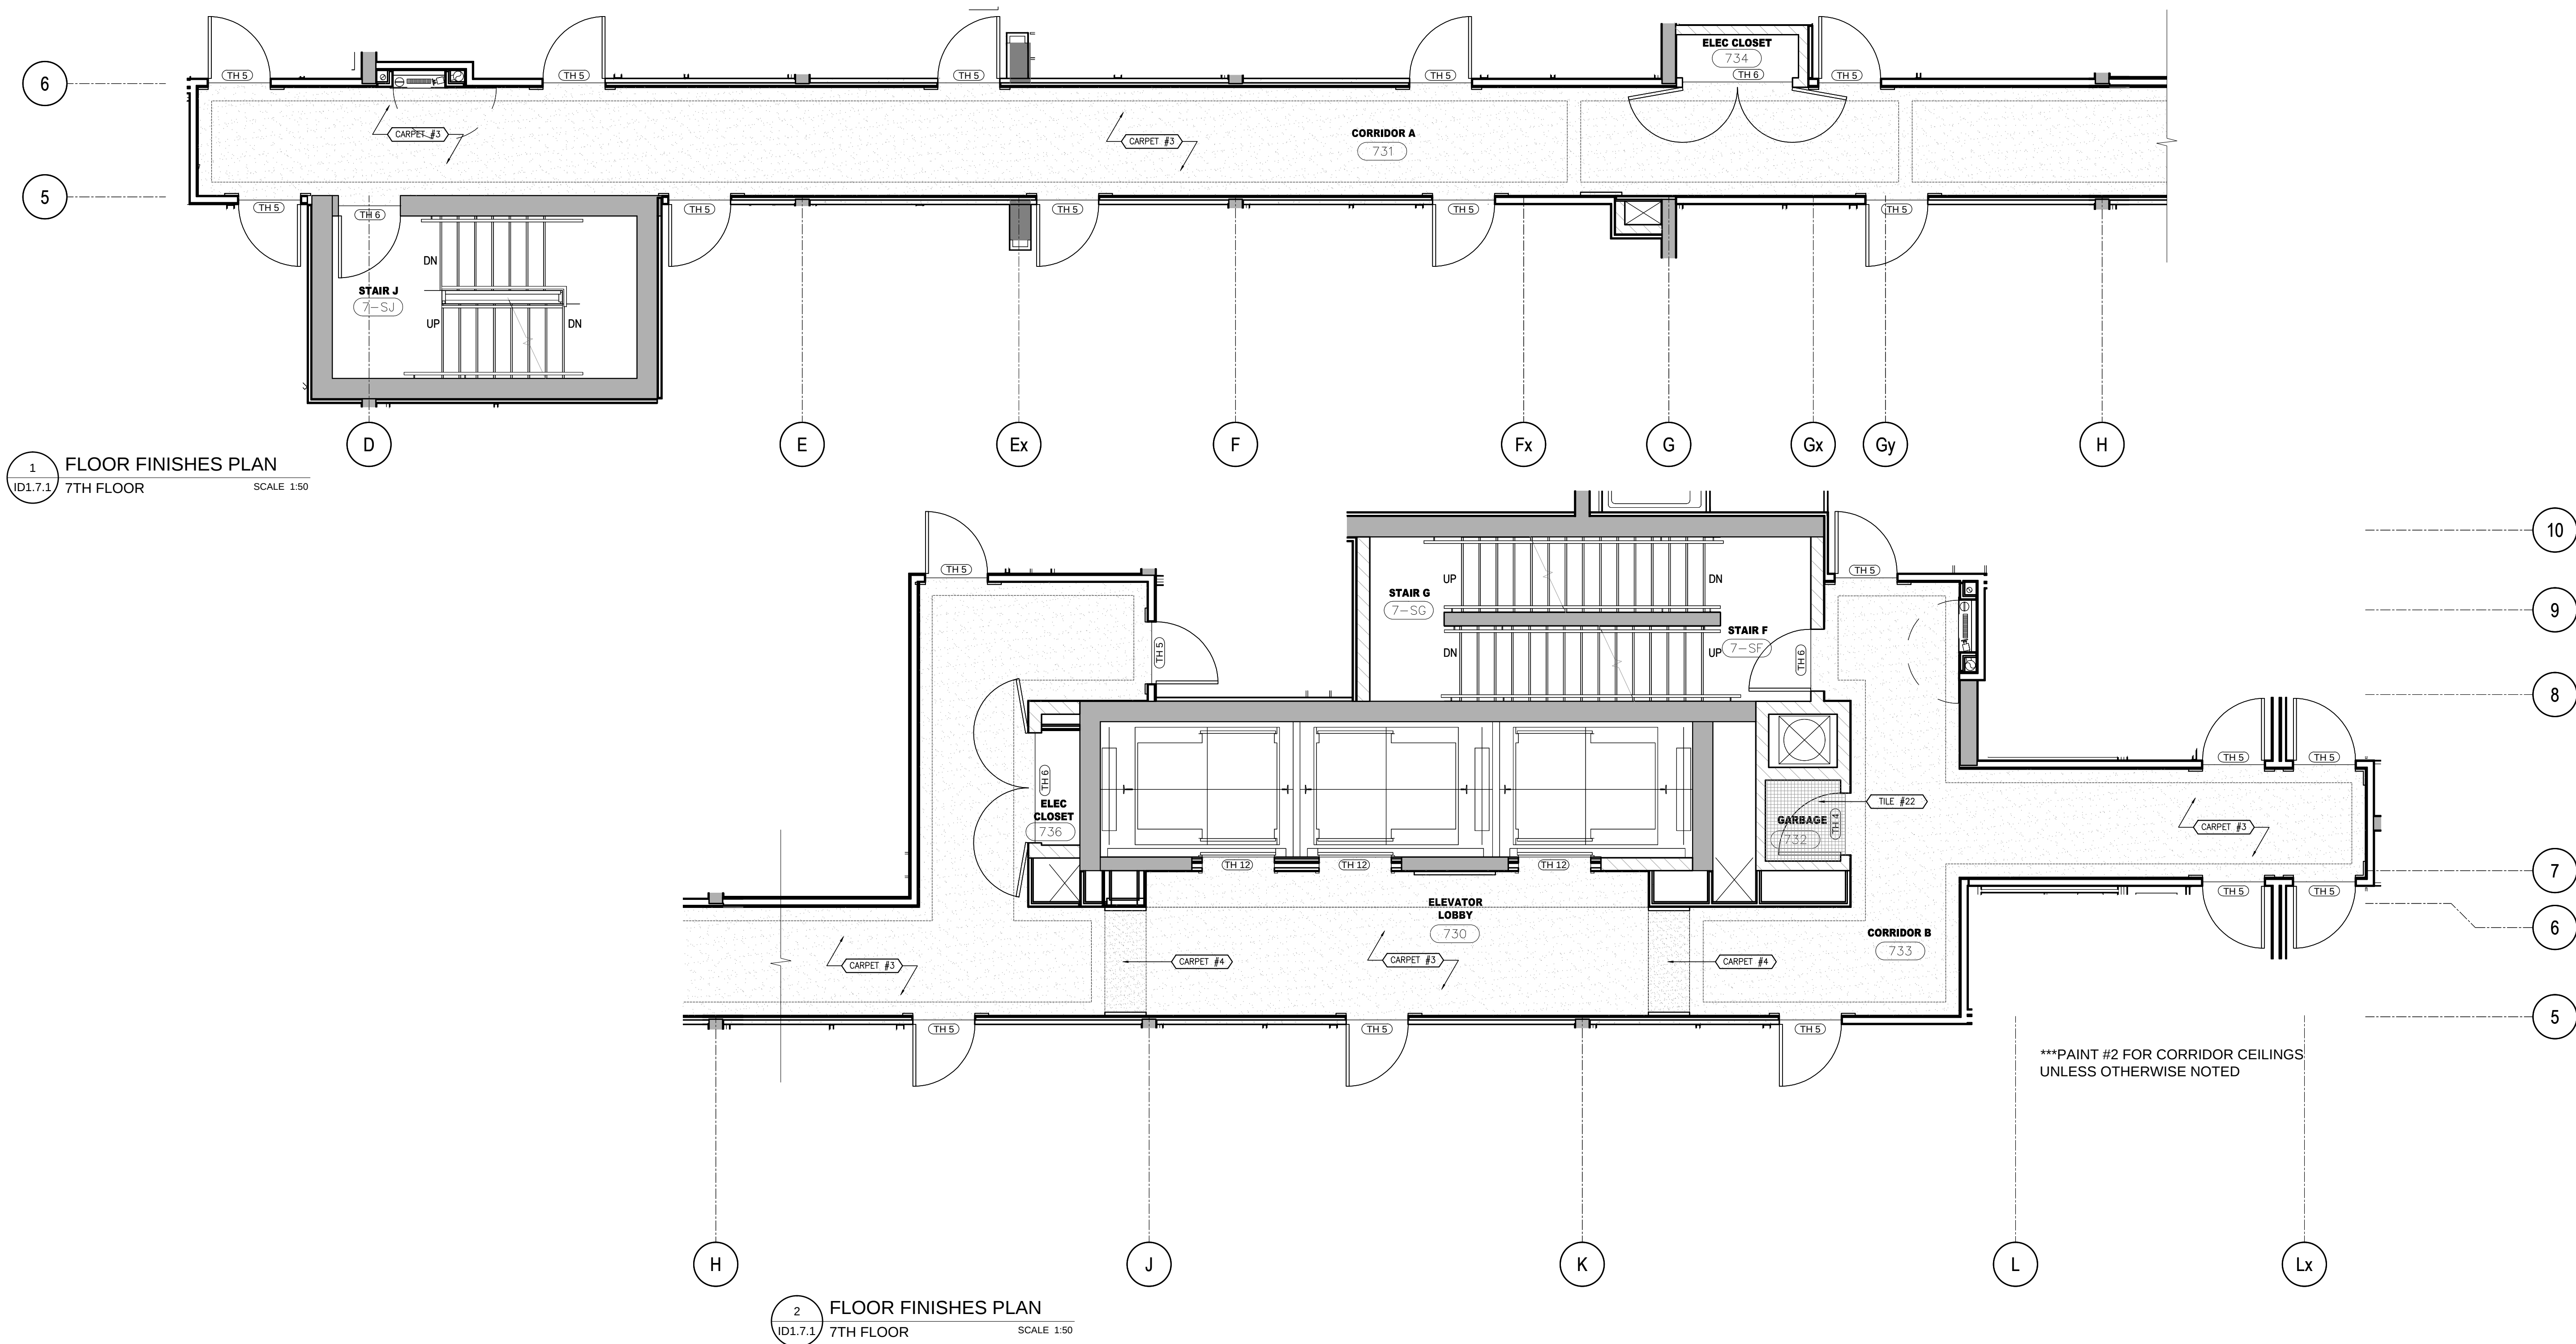

DO NOT SCALE DRAWINGS.

CONTRACTOR MUST VERIFY ALL DRAWINGS, DIMENSIONS, DETAILS AND SPECIFICATIONS. AND REPORT ANY DISCREPANCIES TO UNION 31 INC. BEFORE PROCEEDING WITH WORK. MATERIALS MAY NOT BE SUBSTITUTED WITHOUT WRITTEN APPROVAL FROM UNION 31 INC.

ALL DRAWINGS AND SPECIFICATIONS ARE INSTRUMENTS OF SERVICE AND THE PROPERTY OF UNION 31 INC. WHICH MUST BE RETURNED AT THE COMPLETION OF THE WORK.

PRINTED: 30 May 17

ISSUED FOR
AS-BUILT

01	31 MAY 17	ISSUED FOR AS-BUILT	SV
NO	DATE	COMMENTS	INI

REVISIONS:

UNION 31

PROJECT NAME:
ALEXANDRA PARK
MAIN BUILDING
BLOCK 11
ON, Canada
PROJECT NO.:
13-949
DRAWING NO.:
7TH FLOOR
FLOOR FINISHES PLAN &
WALL FINISHES PLAN
DATE STARTED: 07 AUG / 13
SCALE: 1 : 50
DRAWN BY: AP
APPROVED BY: KC
DRAWING NO.: ID
1.7.1