


DO NOT SCALE DRAWINGS.

CONTRACTOR MUST VERIFY ALL DRAWINGS, DIMENSIONS, DETAILS AND SPECIFICATIONS. AND REPORT ANY DISCREPANCIES TO UNION 31 INC. BEFORE PROCEEDING WITH WORK. MATERIALS MAY NOT BE SUBSTITUTED WITHOUT WRITTEN APPROVAL FROM UNION 31 INC.




















ALL DRAWINGS AND SPECIFICATIONS ARE INSTRUMENTS OF SERVICE AND THE PROPERTY OF UNION 31 INC. WHICH MUST BE RETURNED AT THE COMPLETION OF THE WORK.

PRINTED: 30 May 17


ISSUED FOR
AS-BUILT

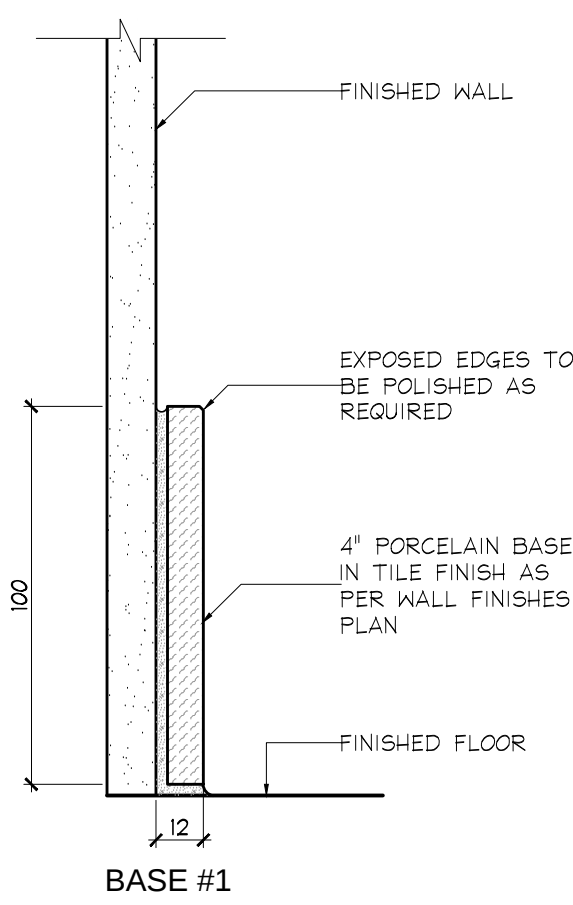


1 BASE DETAILS
TYPICAL SCALE 1:2

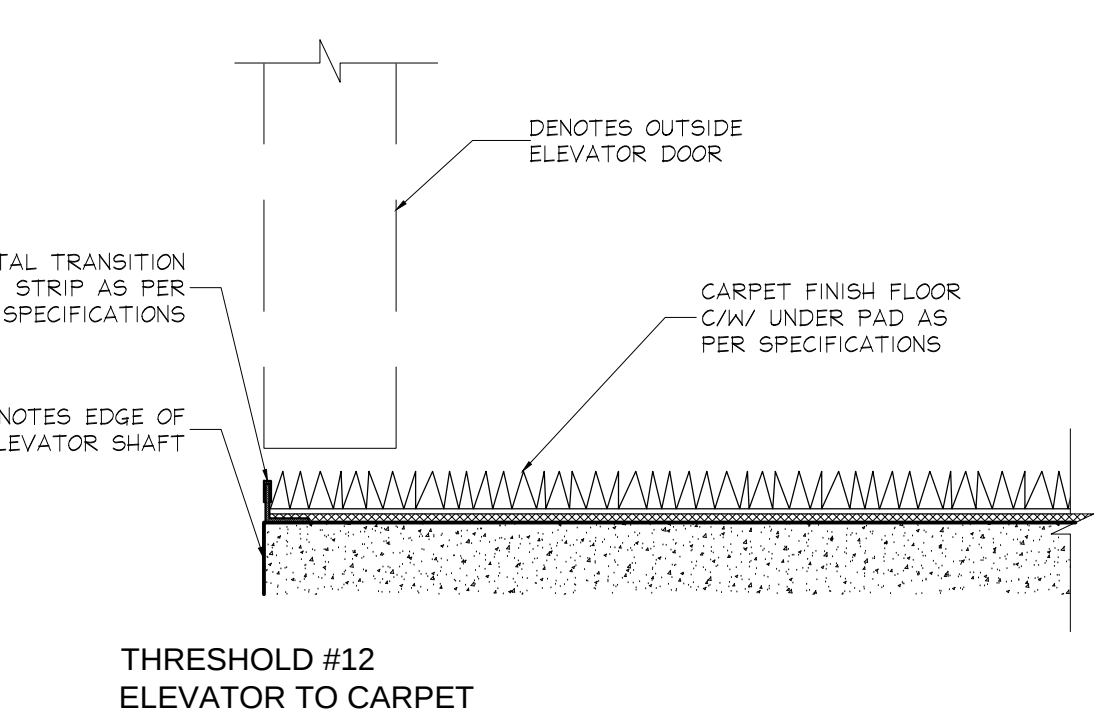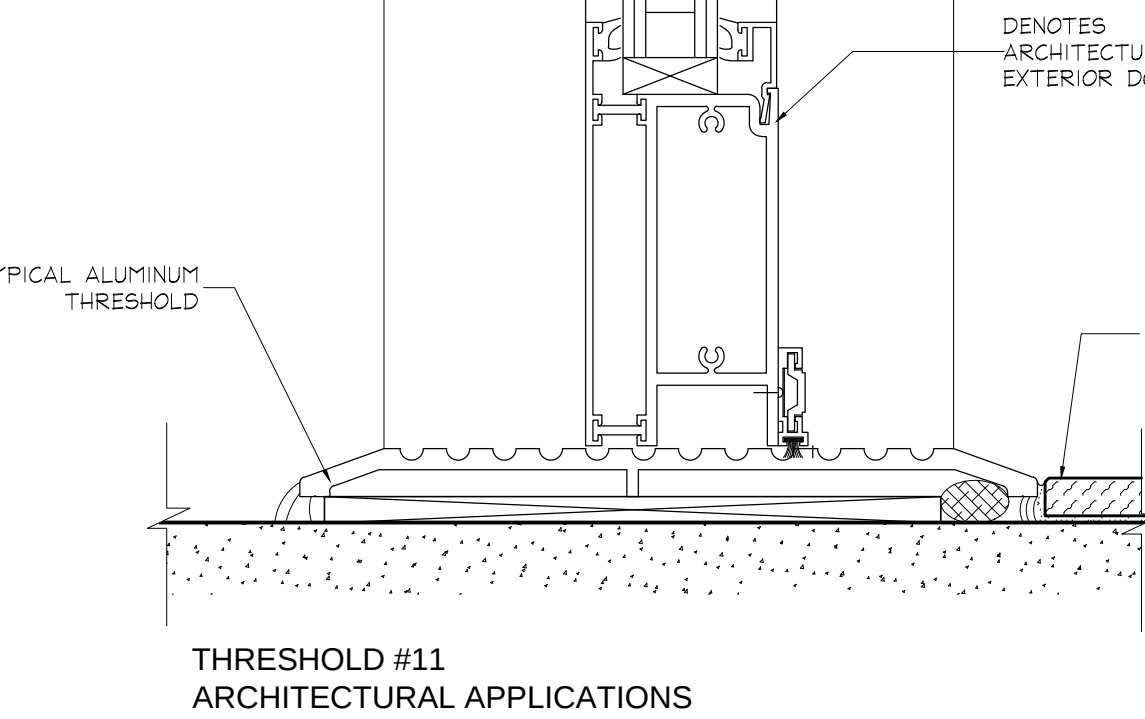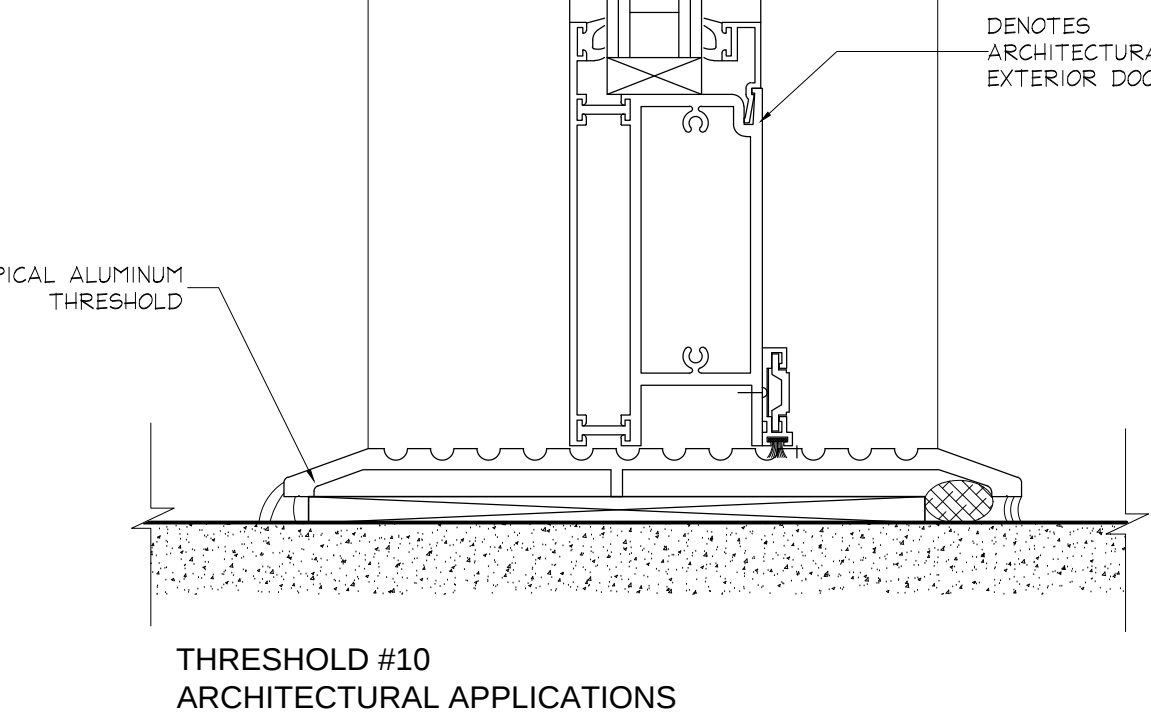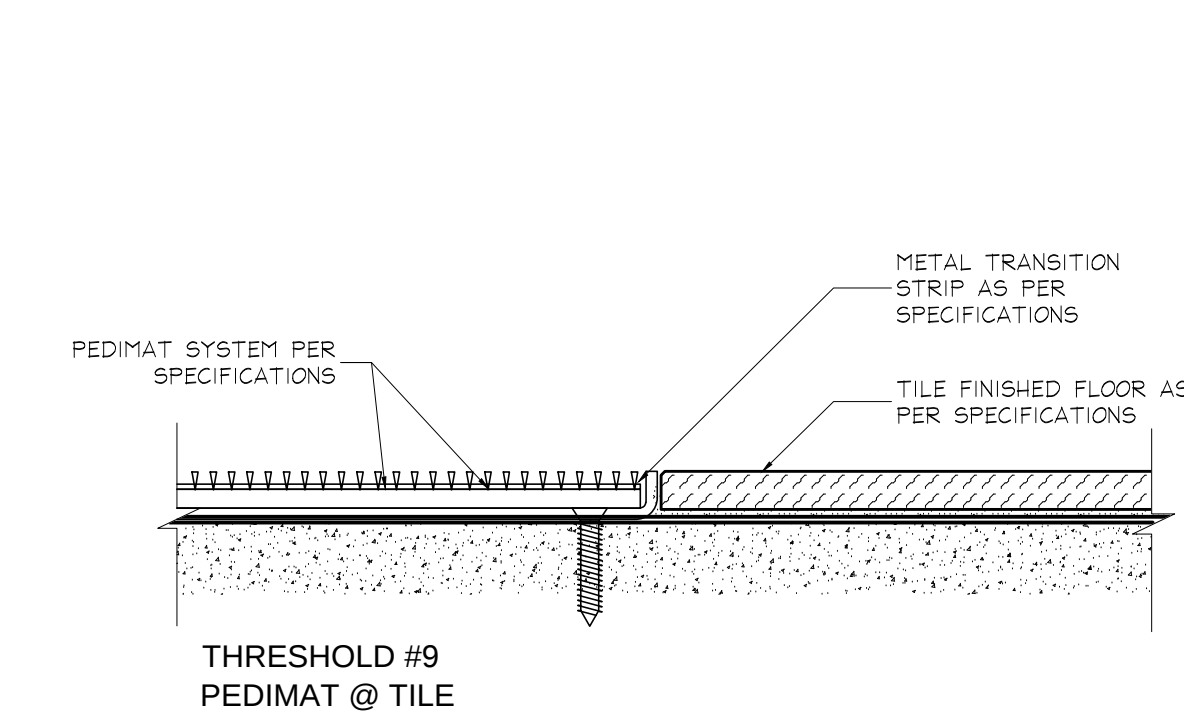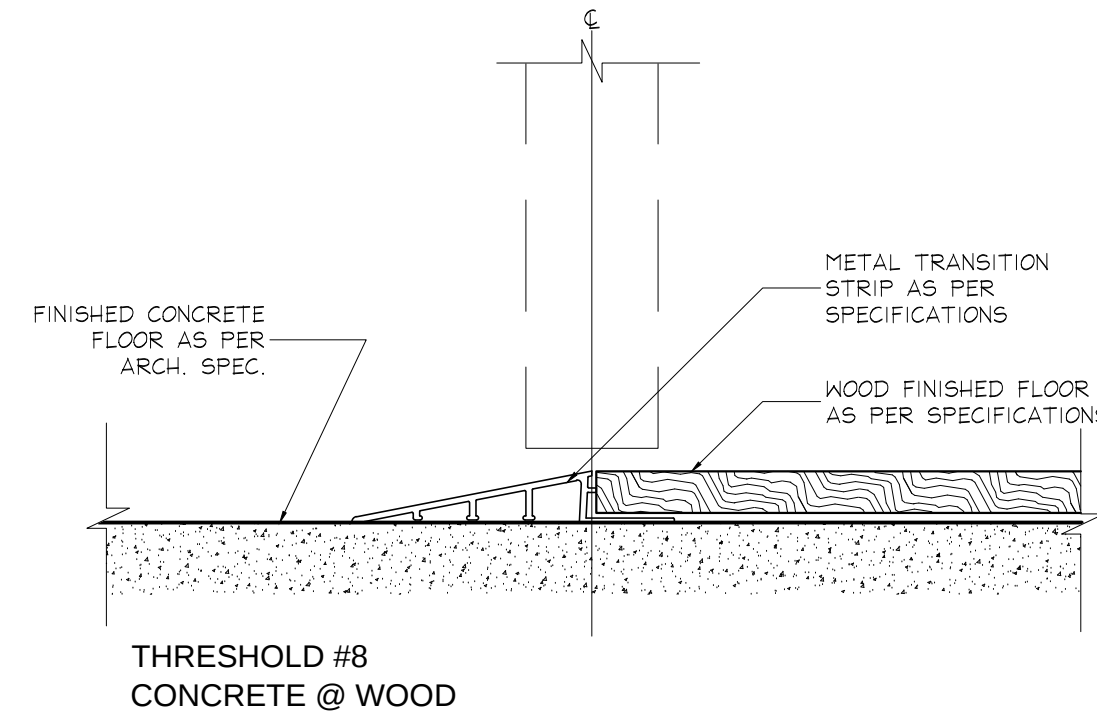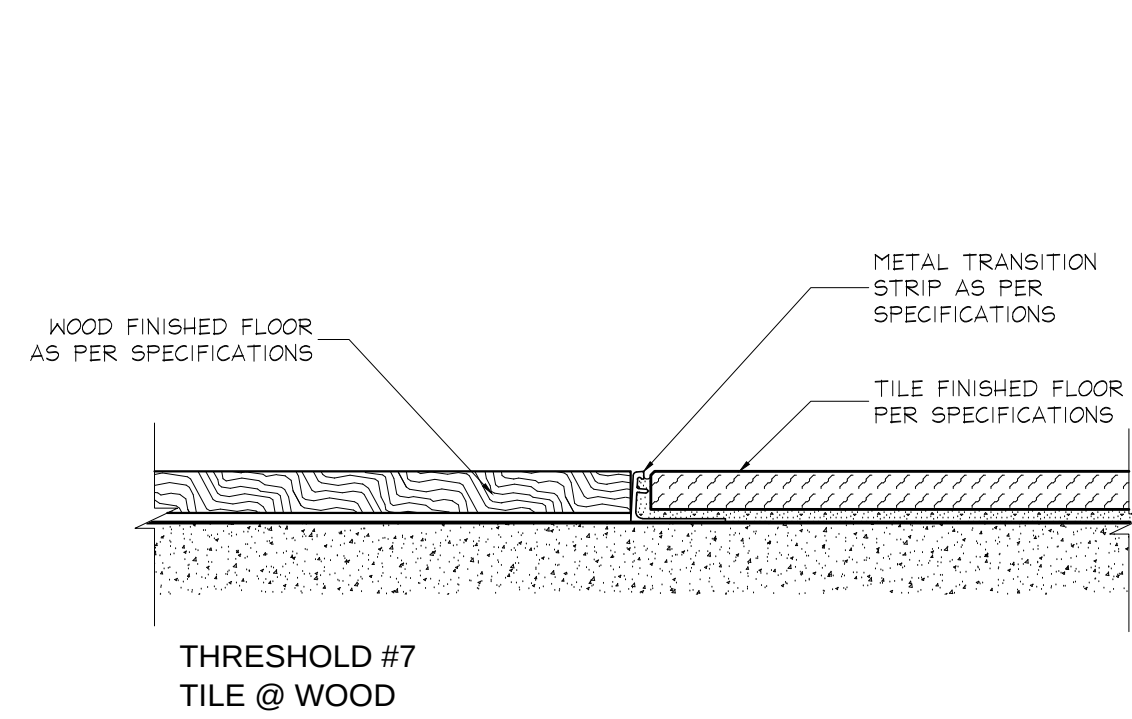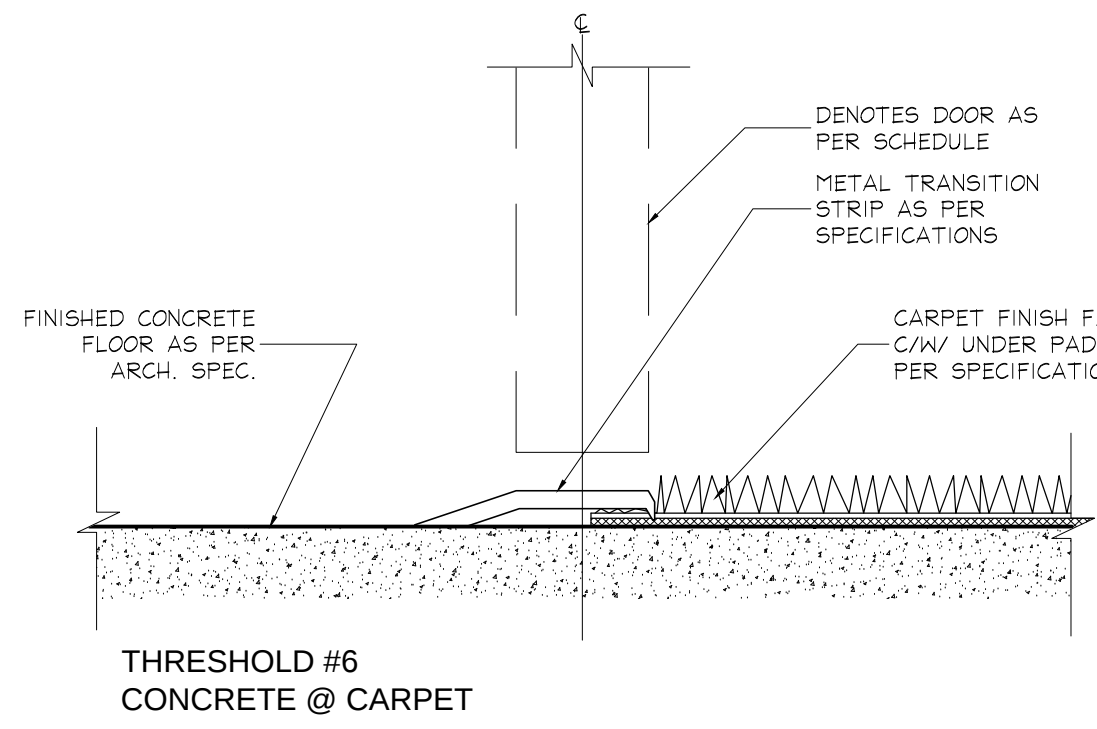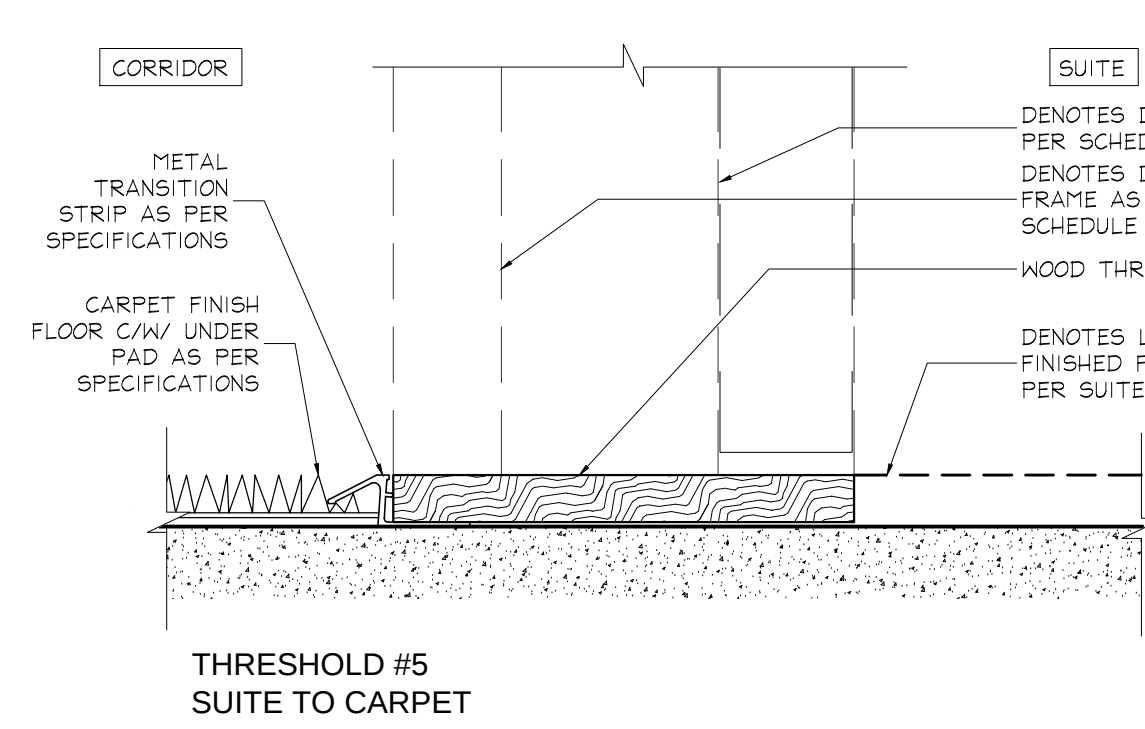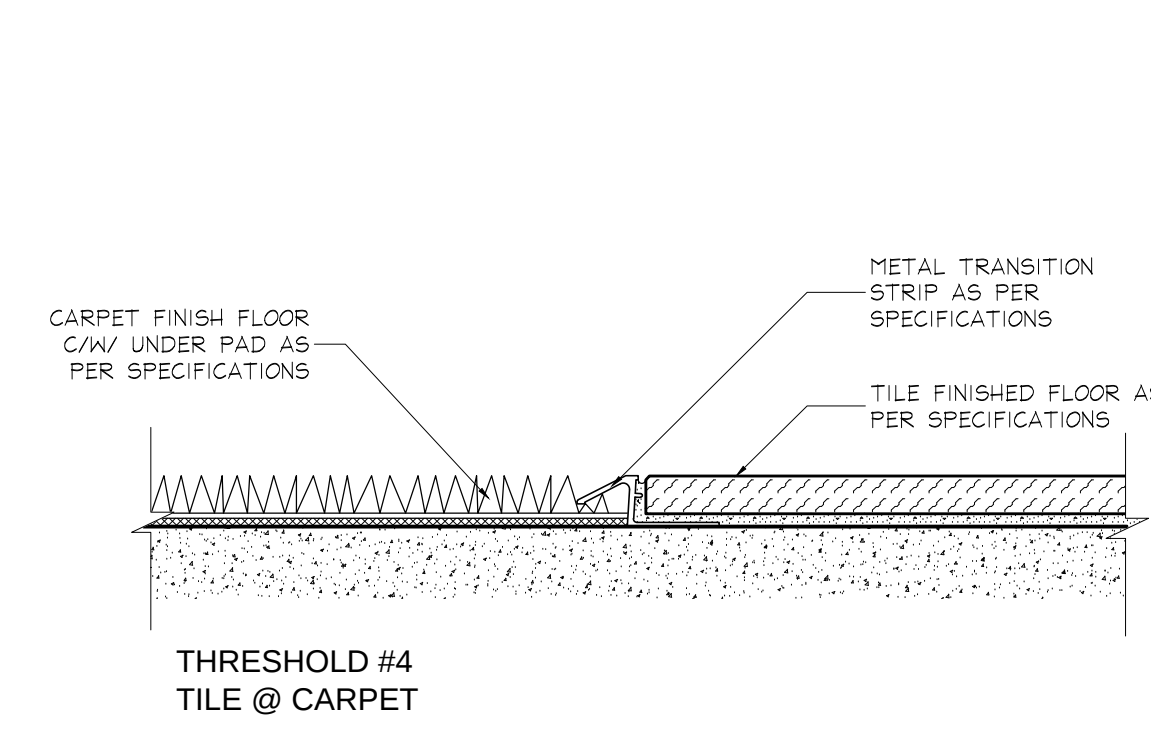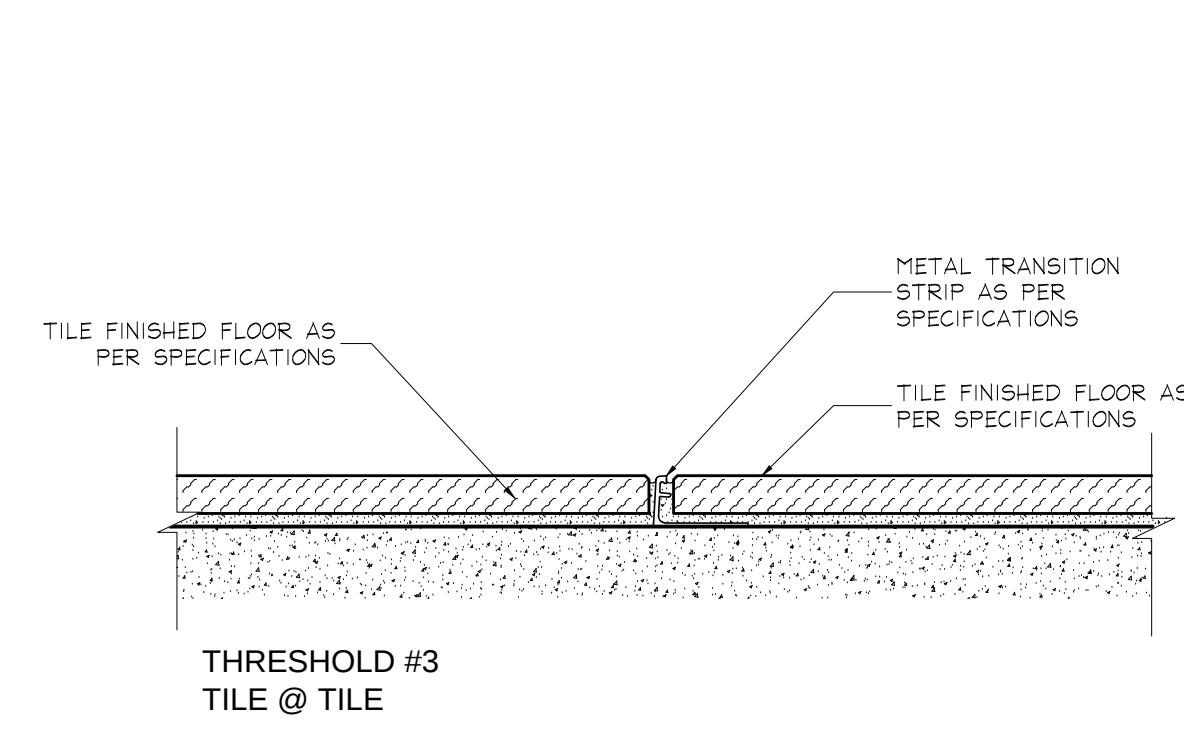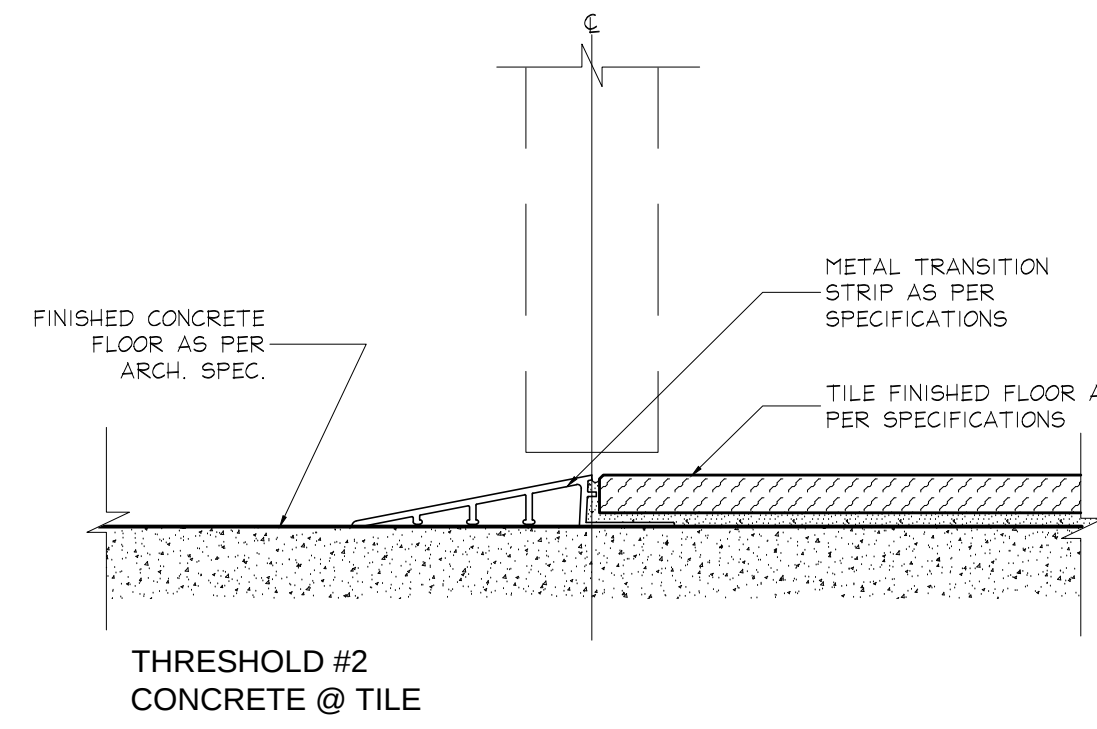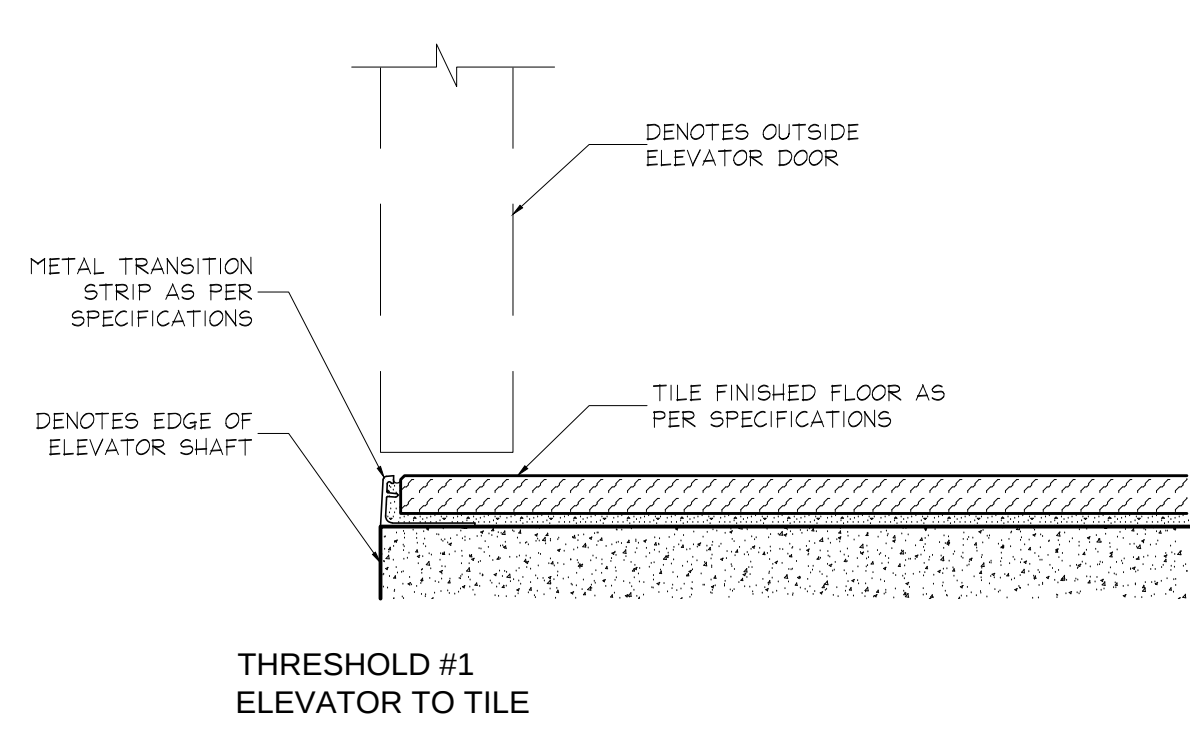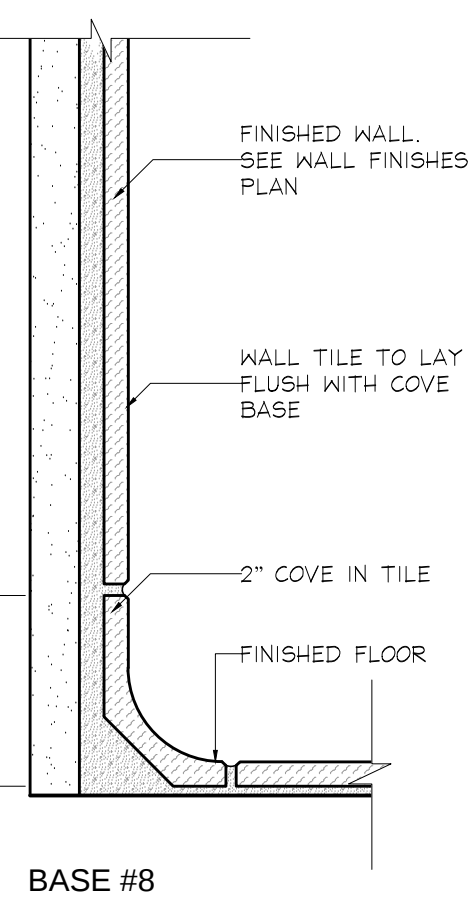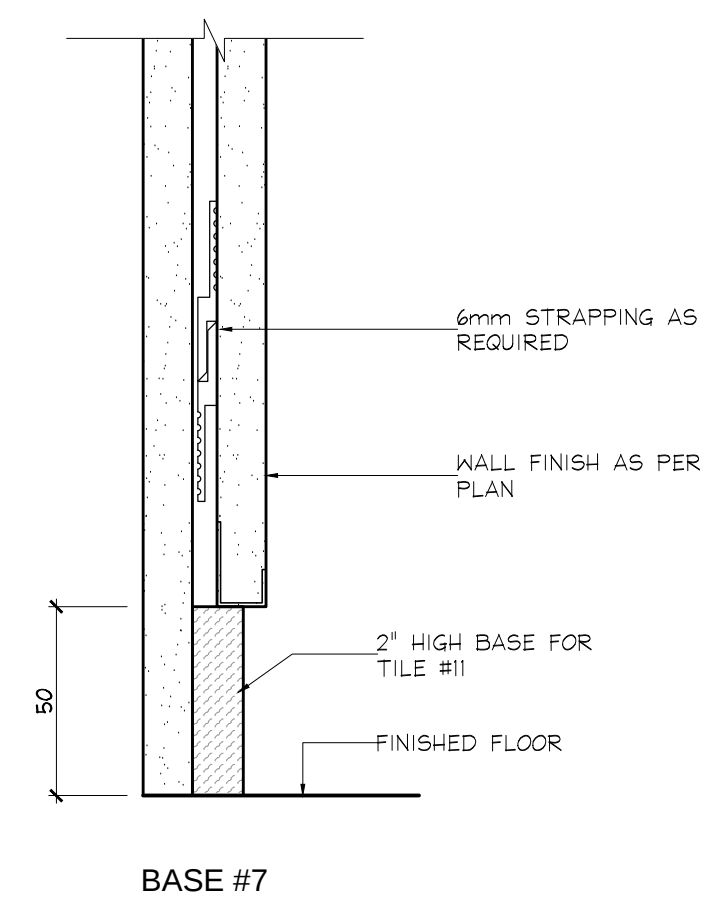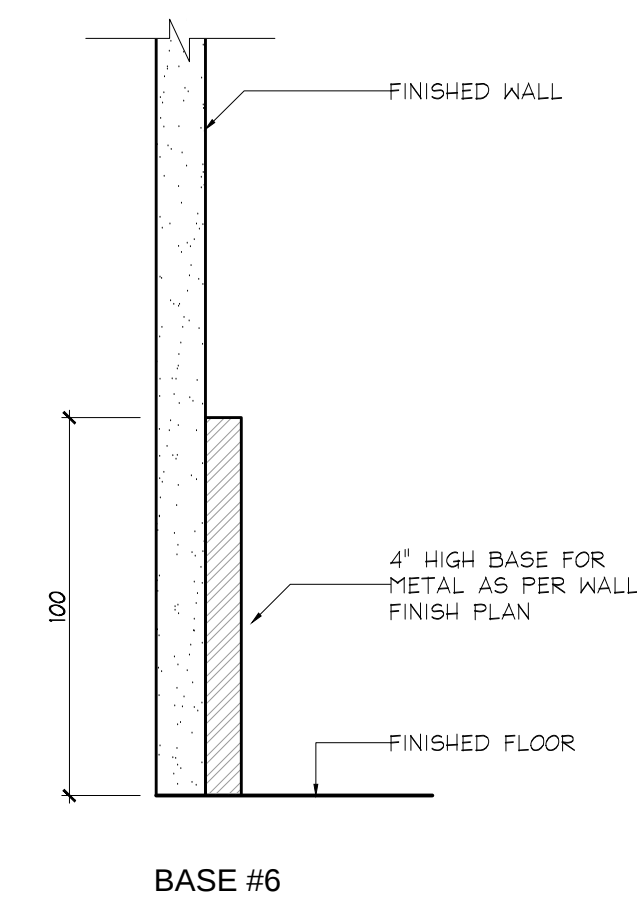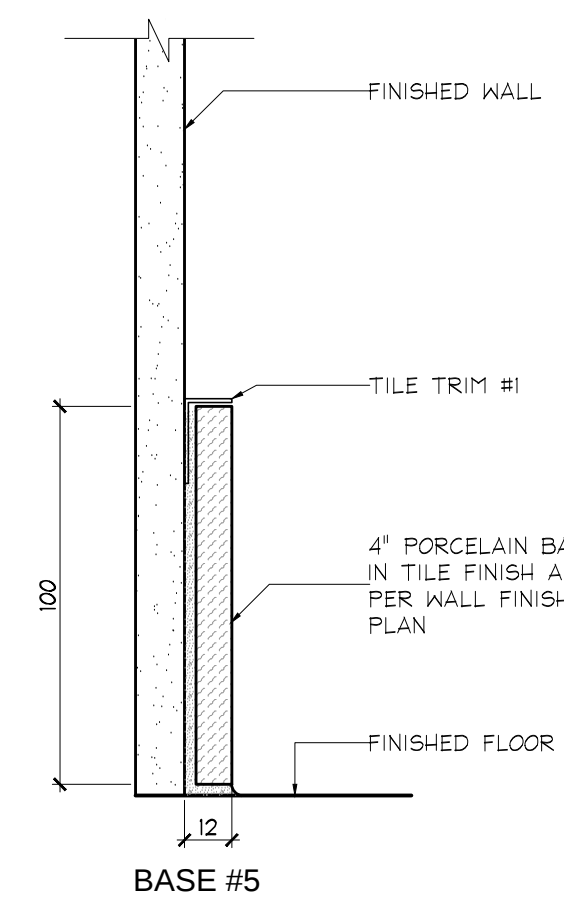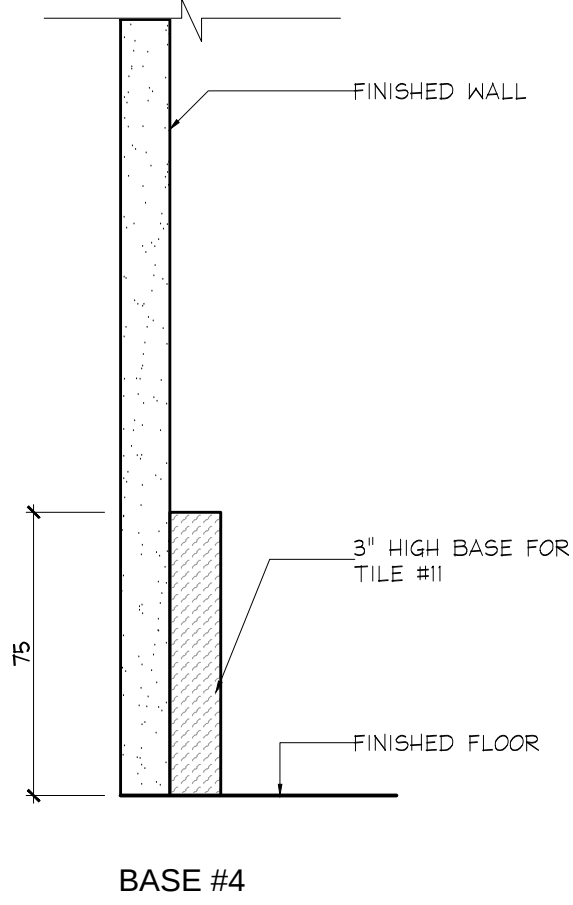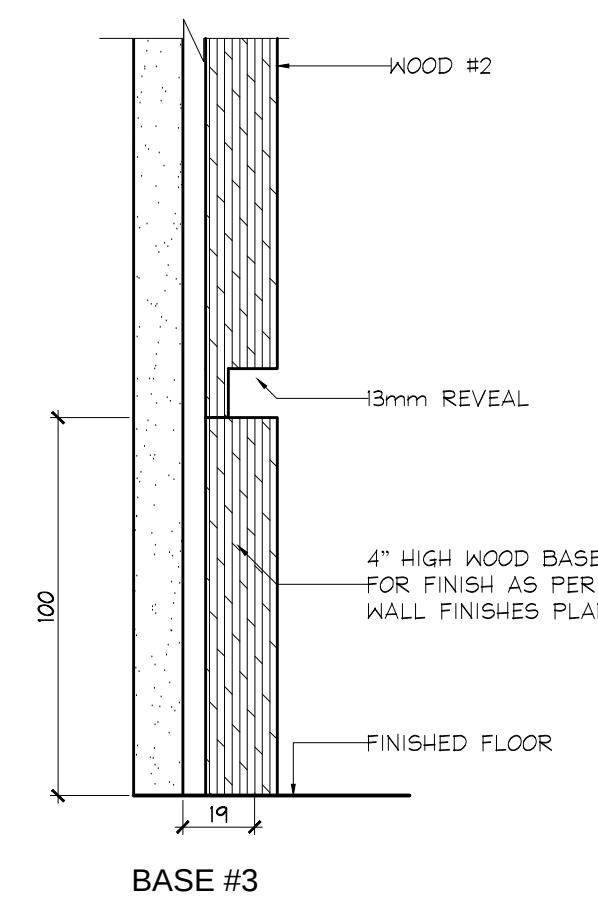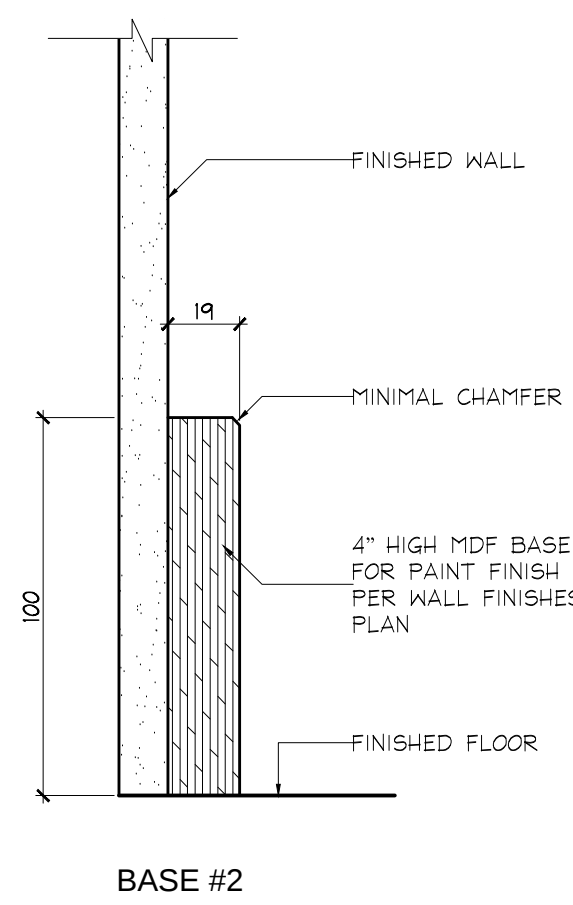


2 THRESHOLD DETAILS
TYPICAL SCALE 1:2

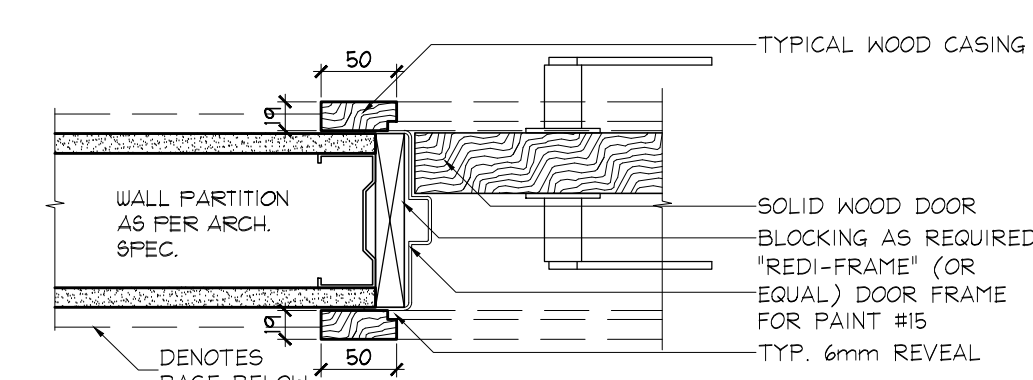


3 TYP. CASING
HORIZONTAL SECTION - DETAIL SCALE 1:5

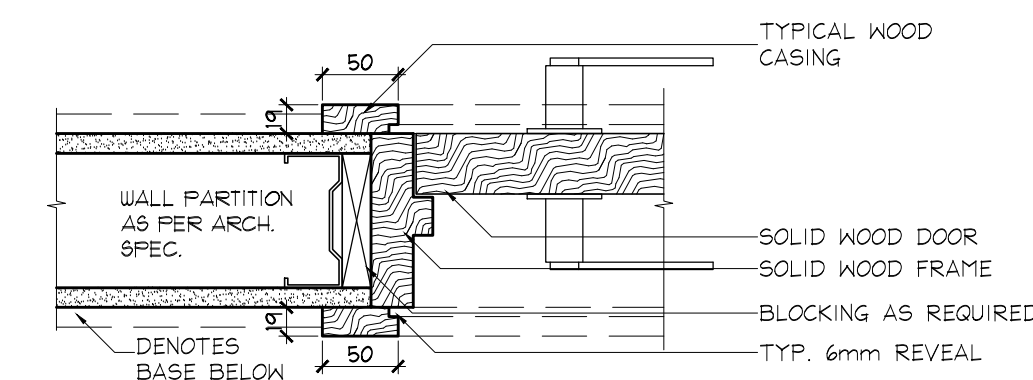


4 TYP. CASING
HORIZONTAL SECTION - DETAIL SCALE 1:5

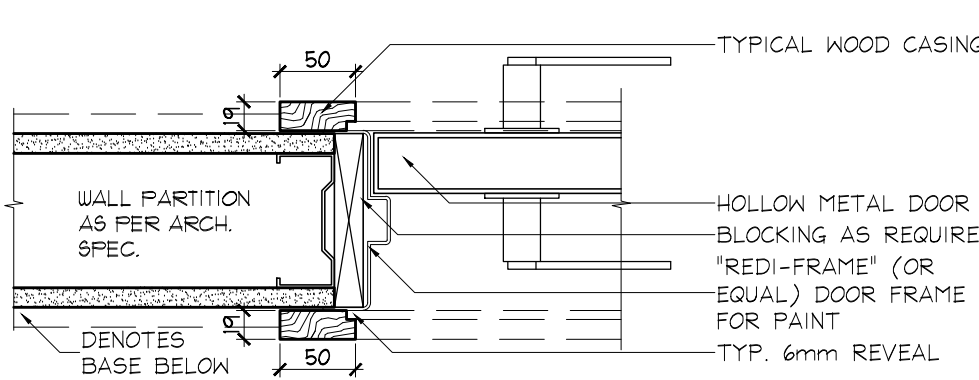


5 TYP. CASING
HORIZONTAL SECTION - DETAIL SCALE 1:5

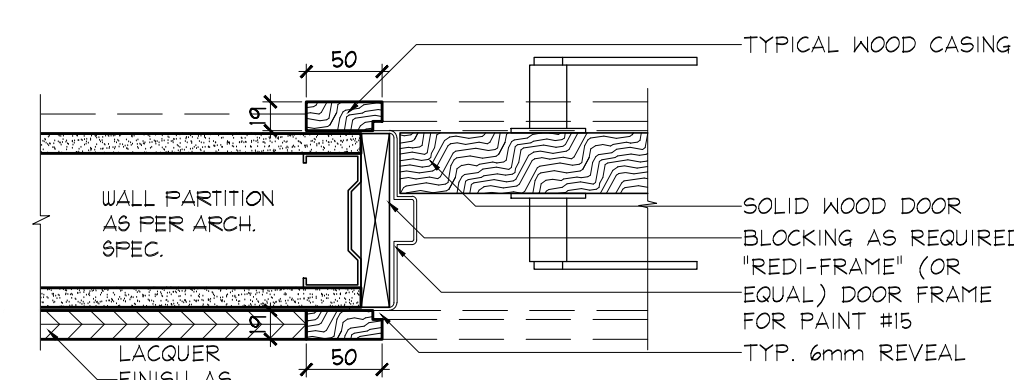


6 TYP. CASING @ TILE WALL
HORIZONTAL SECTION - DETAIL SCALE 1:5

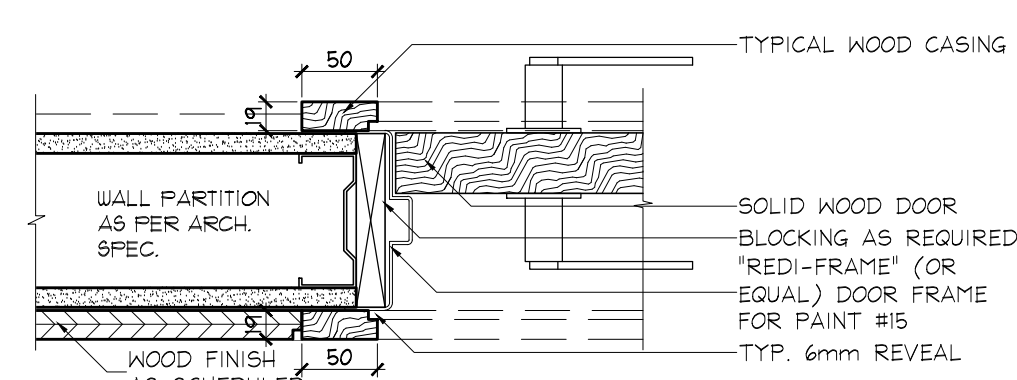


7 TYP. CASING @ WOOD
HORIZONTAL SECTION - DETAIL SCALE 1:5

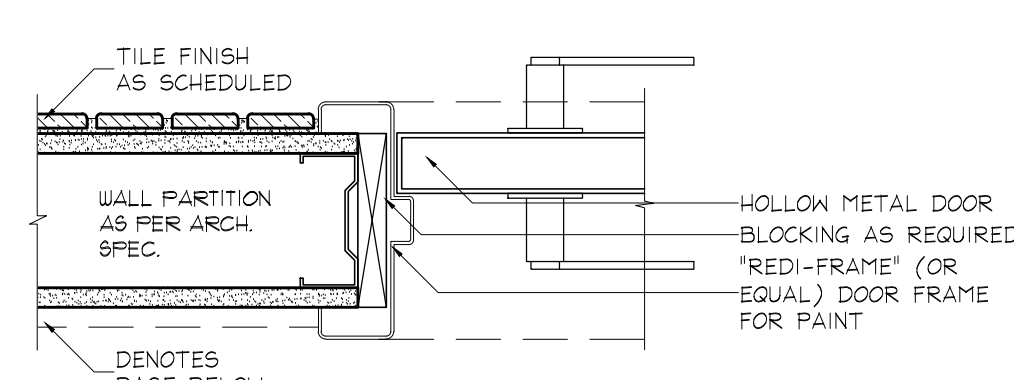

8 TYP. CASING @ TILE WALL
HORIZONTAL SECTION - DETAIL SCALE 1:5

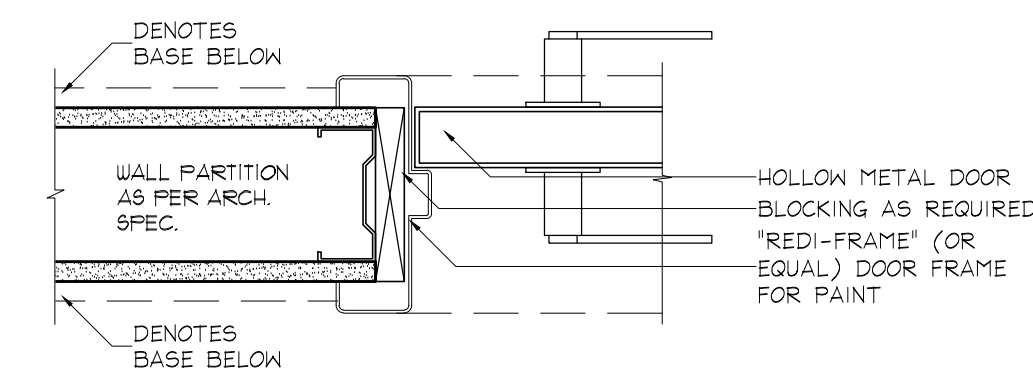

9 TYP. CASING
HORIZONTAL SECTION - DETAIL SCALE 1:5

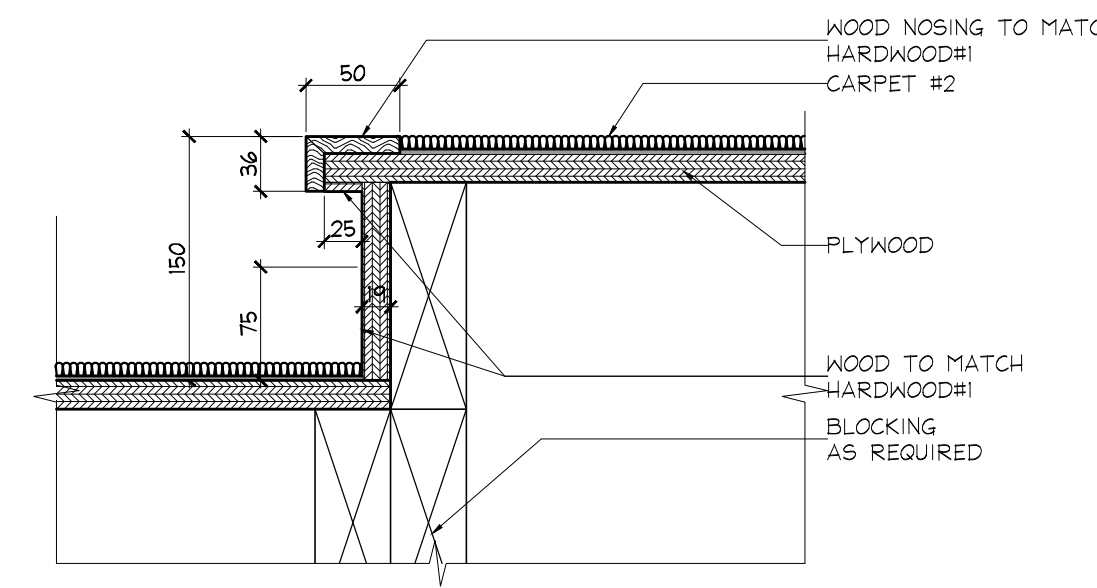

10 SECTION -
STEP SCALE 1:5

01	31 MAY / 17	ISSUED FOR AS-BUILT	SV
NO.	DATE	COMMENTS	INI
REVISIONS:			

UNION 31

UNION31 INC.
183 BATHURST STREET, STE. 201
TORONTO, ON, M5T 2R7, CANADA
TEL: 416-597-1576 FAX: 416-597-2139

PROJECT NAME:		ALEXANDRA PARK MAIN BUILDING	
PROJECT NO.:		13-949	
DRAWINGS:		TYPICAL DETAILS BASES, THRESHOLDS & CASINGS	
DATE STARTED:	07 AUG / 13	DRAWING NO.:	ID
SCALE:	AS NOTED		5.0.0
DRAWN BY:	GG		
APPROVED BY:	KC		