


**7TH FLOOR FRAMING PLAN**

SCALE 1 : 100

- TOP OF SLAB IS AT ELEVATION AS SHOWN ON ARCH. DRAWINGS EXCEPT AS CROSSED AND NOTED ON PLAN.
- CONCRETE STRENGTH AT 28 DAYS SHALL BE:  
FOR WALLS AND COLUMNS ..... SEE SCHEDULE  
FOR EXT. SLABS ..... 35 MPa  
FOR INTERIOR SLABS ..... 25 MPa  
FOR BEAMS ..... 35 MPa  
CONCRETE EXPOSED TO ELEMENTS SHALL BE 35 MPa WITH 6% TO 8% ENTRAINED AIR.
- FLOOR SLABS ARE DESIGNED FOR FOLLOWING LOADING CONDITIONS :
 

	S.I.D.	LL.
STAIRS & BALCONIES	0.50 KPa	4.80 KPa
LOCKERS & STORAGE *	1.30 KPa	4.80 KPa
RESIDENTIAL	1.3 KPa	1.9 KPa
TOILETS	1.30 KPa	2.40 KPa
TERRACES	5.0 KPa	4.80 KPa
- MINIMUM YIELD STRESS FOR REINFORCING STEEL SHALL BE 400 MPa.
- TEMPERATURE REINFORCING FOR : 200 SLAB IS 10@250, 210 SLAB IS 10@230.
- NO OPENINGS LARGER THAN 300mm x 300mm ARE ALLOWED IN SLAB OTHER THAN THOSE SHOWN ON DRAWINGS.
- SEE TYPICAL DETAILS ON DRAWINGS S-001 TO S-006.
- SEE GENERAL NOTES ON DRAWING S-001.
- REFER TO ARCH. DRAWINGS FOR SLOPES OF SLAB.
- FOR COLUMN & WALL SCHEDULE SEE DRAWINGS S-301 TO S-306.
- COORDINATE BEAM DEPTH AT DOOR OPENINGS WITH ARCH. DRAWINGS.
- EXTEND TEMP. REINF. TO END OF BALCONIES/OVERHANGS.
- TOP BARS TERMINATING AT EDGE OF SLAB TO HAVE 180° HOOK.

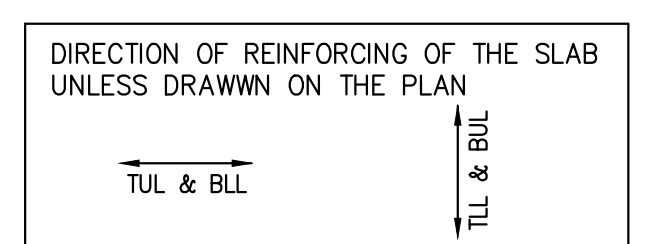

**Jablonsky, Ast and Partners**  
CONSULTING ENGINEERS  
1120 LESLIE STREET  
DON MILLS, ON, M3C 2K5  
TEL: 416-447-7400  
FAX: 416-447-2771  
E-mail: jsp@ast.on.ca



FIRST FLOOR ELEV. 93.60m

NO.	ISSUED / REVISED	DATE
1	ISSUED FOR PERMIT	2014-09-23
2	RE ISSUED FOR PERMIT	2014-07-01
3	ISSUED FOR FORMING TRENCH	2014-08-27
4	CONSTRUCTION REVIEW	2014-03-21
5	RE ISSUED FOR PERMIT	2014-01-07
6	ISSUED FOR CONSTRUCTION	2013-03-14
7	UPDATED - P.C.	2013-04-23
8	UPDATED - P.C.	2013-02-21
9	ISSUED FOR S.P.	2013-07-23
11	ISSUED FOR B.I.I	2015-11-04

**ALEXANDRA PARK - BLOCK 11**  
TORONTO, ONTARIO

project no: 13015  
scale: 1:100  
drawn by: H.W.  
checked by: H.P.  
date stamped: MARCH 2014