


11TH FLOOR FRAMING PLAN
SCALE 1 : 100

- TOP OF SLAB IS AT ELEVATION AS SHOWN ON ARCH. DRAWINGS EXCEPT AS CROSSED AND NOTED ON PLAN.
- CONCRETE STRENGTH AT 28 DAYS SHALL BE:
FOR WALLS AND COLUMNS SEE SCHEDULE
FOR EXT. SLABS 35 MPa
FOR INTERIOR SLABS 25 MPa
FOR BEAMS 35 MPa
CONCRETE EXPOSED TO ELEMENTS SHALL BE 35 MPa WITH 6% TO 8% ENTRAINED AIR.
- FLOOR SLABS ARE DESIGNED FOR FOLLOWING LOADING CONDITIONS :

	S.I.D.	L.L.
STAIRS & BALCONIES	0.50 KPa	4.80 KPa
LOCKERS & STORAGE *	1.30 KPa	4.80 KPa
RESIDENTIAL	1.3 KPa	1.9 KPa
TOILETS	1.30 KPa	2.40 KPa
TERRACES	5.0 KPa	4.80 KPa

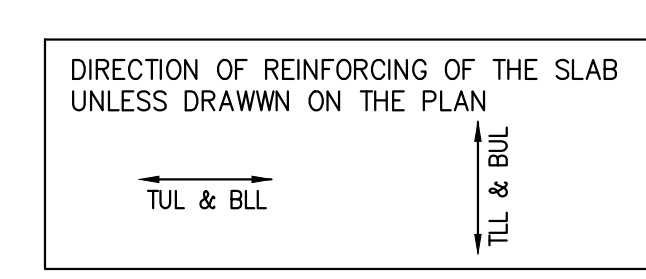

Jablonsky, Ast and Partners
CONSULTING ENGINEERS
1128 LESLIE STREET
DOR MILLS, ON, M3C 2K5
TEL: 416-447-7400
FAX: 416-447-2711
E-mail: jsp@ast.on.ca



FIRST FLOOR ELEV. 93.60m

NO.	ISSUED / REVISED	DATE
1	ISSUED FOR PERMIT	2014-09-03
2	RE ISSUED FOR PERMIT	2014-07-01
3	ISSUED FOR FORMING TRENCH	2014-08-27
4	CONSTRUCTION REVIEW	2014-03-03
5	RE ISSUED FOR PERMIT	2014-01-07
6	ISSUED FOR CONSTRUCTION	2013-01-14
7	UPDATED - P.C.	2013-04-04
8	UPDATED - P.C.	2013-04-01
9	ISSUED FOR B.P.	2013-07-01
11	ISSUED FOR B.P.	2013-11-04

ALEXANDRA PARK - BLOCK 11
TORONTO, ONTARIO

project no: 13015
scale: 1:100
drawn by: H.W.
reviewed by: P.F.
date stamped: MARCH 2014